

DOCUMENT 00 90 00

ADDENDUM

ADDENDUM NO. [1] Date: February 16, 2018

**RE: HO-CHUNK NATION
INDEPENDENT LIVING FACILITY
BRANCHED ANTLER AVE
BLACK RIVER FALLS, WISCONSIN 54615
HSR PROJECT NO. 15027**

**FROM: HSR Associates, Inc
100 Milwaukee Street
La Crosse, WI 54603
(608) 784-1830**

To: Prospective Bidders

This addendum forms a part of the Contract Documents and modifies the original Bidding Documents dated February 2018. Acknowledge receipt of this Addendum in the space provided on the bid form. Failure to do so may subject the Bidder to disqualification.

This Addendum consists of [1] page, and [7] 30 x 42 drawings.

CHANGES TO DRAWINGS

1. Sheet P001R PLUMBING GENERAL NOTES 30 x 42 attached hereto
 - a. Revisions clouded on Drawing
2. Sheet P101R - UNDERFLOOR PLAN SEGMENT A 30 x 42 attached hereto
 - a. Revisions clouded on Drawing.
3. Sheet P102R - UNDERFLOOR PLAN SEGMENT B 30 x 42 attached hereto
 - a. Revisions clouded on Drawing.
4. Sheet P103R - UNDERFLOOR PLAN – ALTERNATE 30 x 42 attached hereto
 - a. Revisions clouded on Drawing
5. Sheet P112R FIRST FLOOR PLAN-SEGMENT B 30 x 42 attached hereto
 - a. Revisions clouded on Drawing.
6. Sheet P200 DWV RISER DIAGRAMS 30 x 42 attached hereto
 - a. Document added to the Contract documents.
7. Sheet P201 WATER RISER DIAGRAMS 30 x 42 attached hereto
 - a. Document added to the Contract documents

PRIOR APPROVALS

1. Section 23 52 33 CONDENSING AND NON-CONDENSING BOILERS
 - a. IBC Technologies: Model SL Condensing Boilers.

END OF DOCUMENT 00 90 00


Page Intentionally Left Blank




No.	Description	Date
A1	Addendum #1	2/16/2018

Graphic Scale: **VARIES**

Last Update: **2/16/2018 10:58:56 AM**

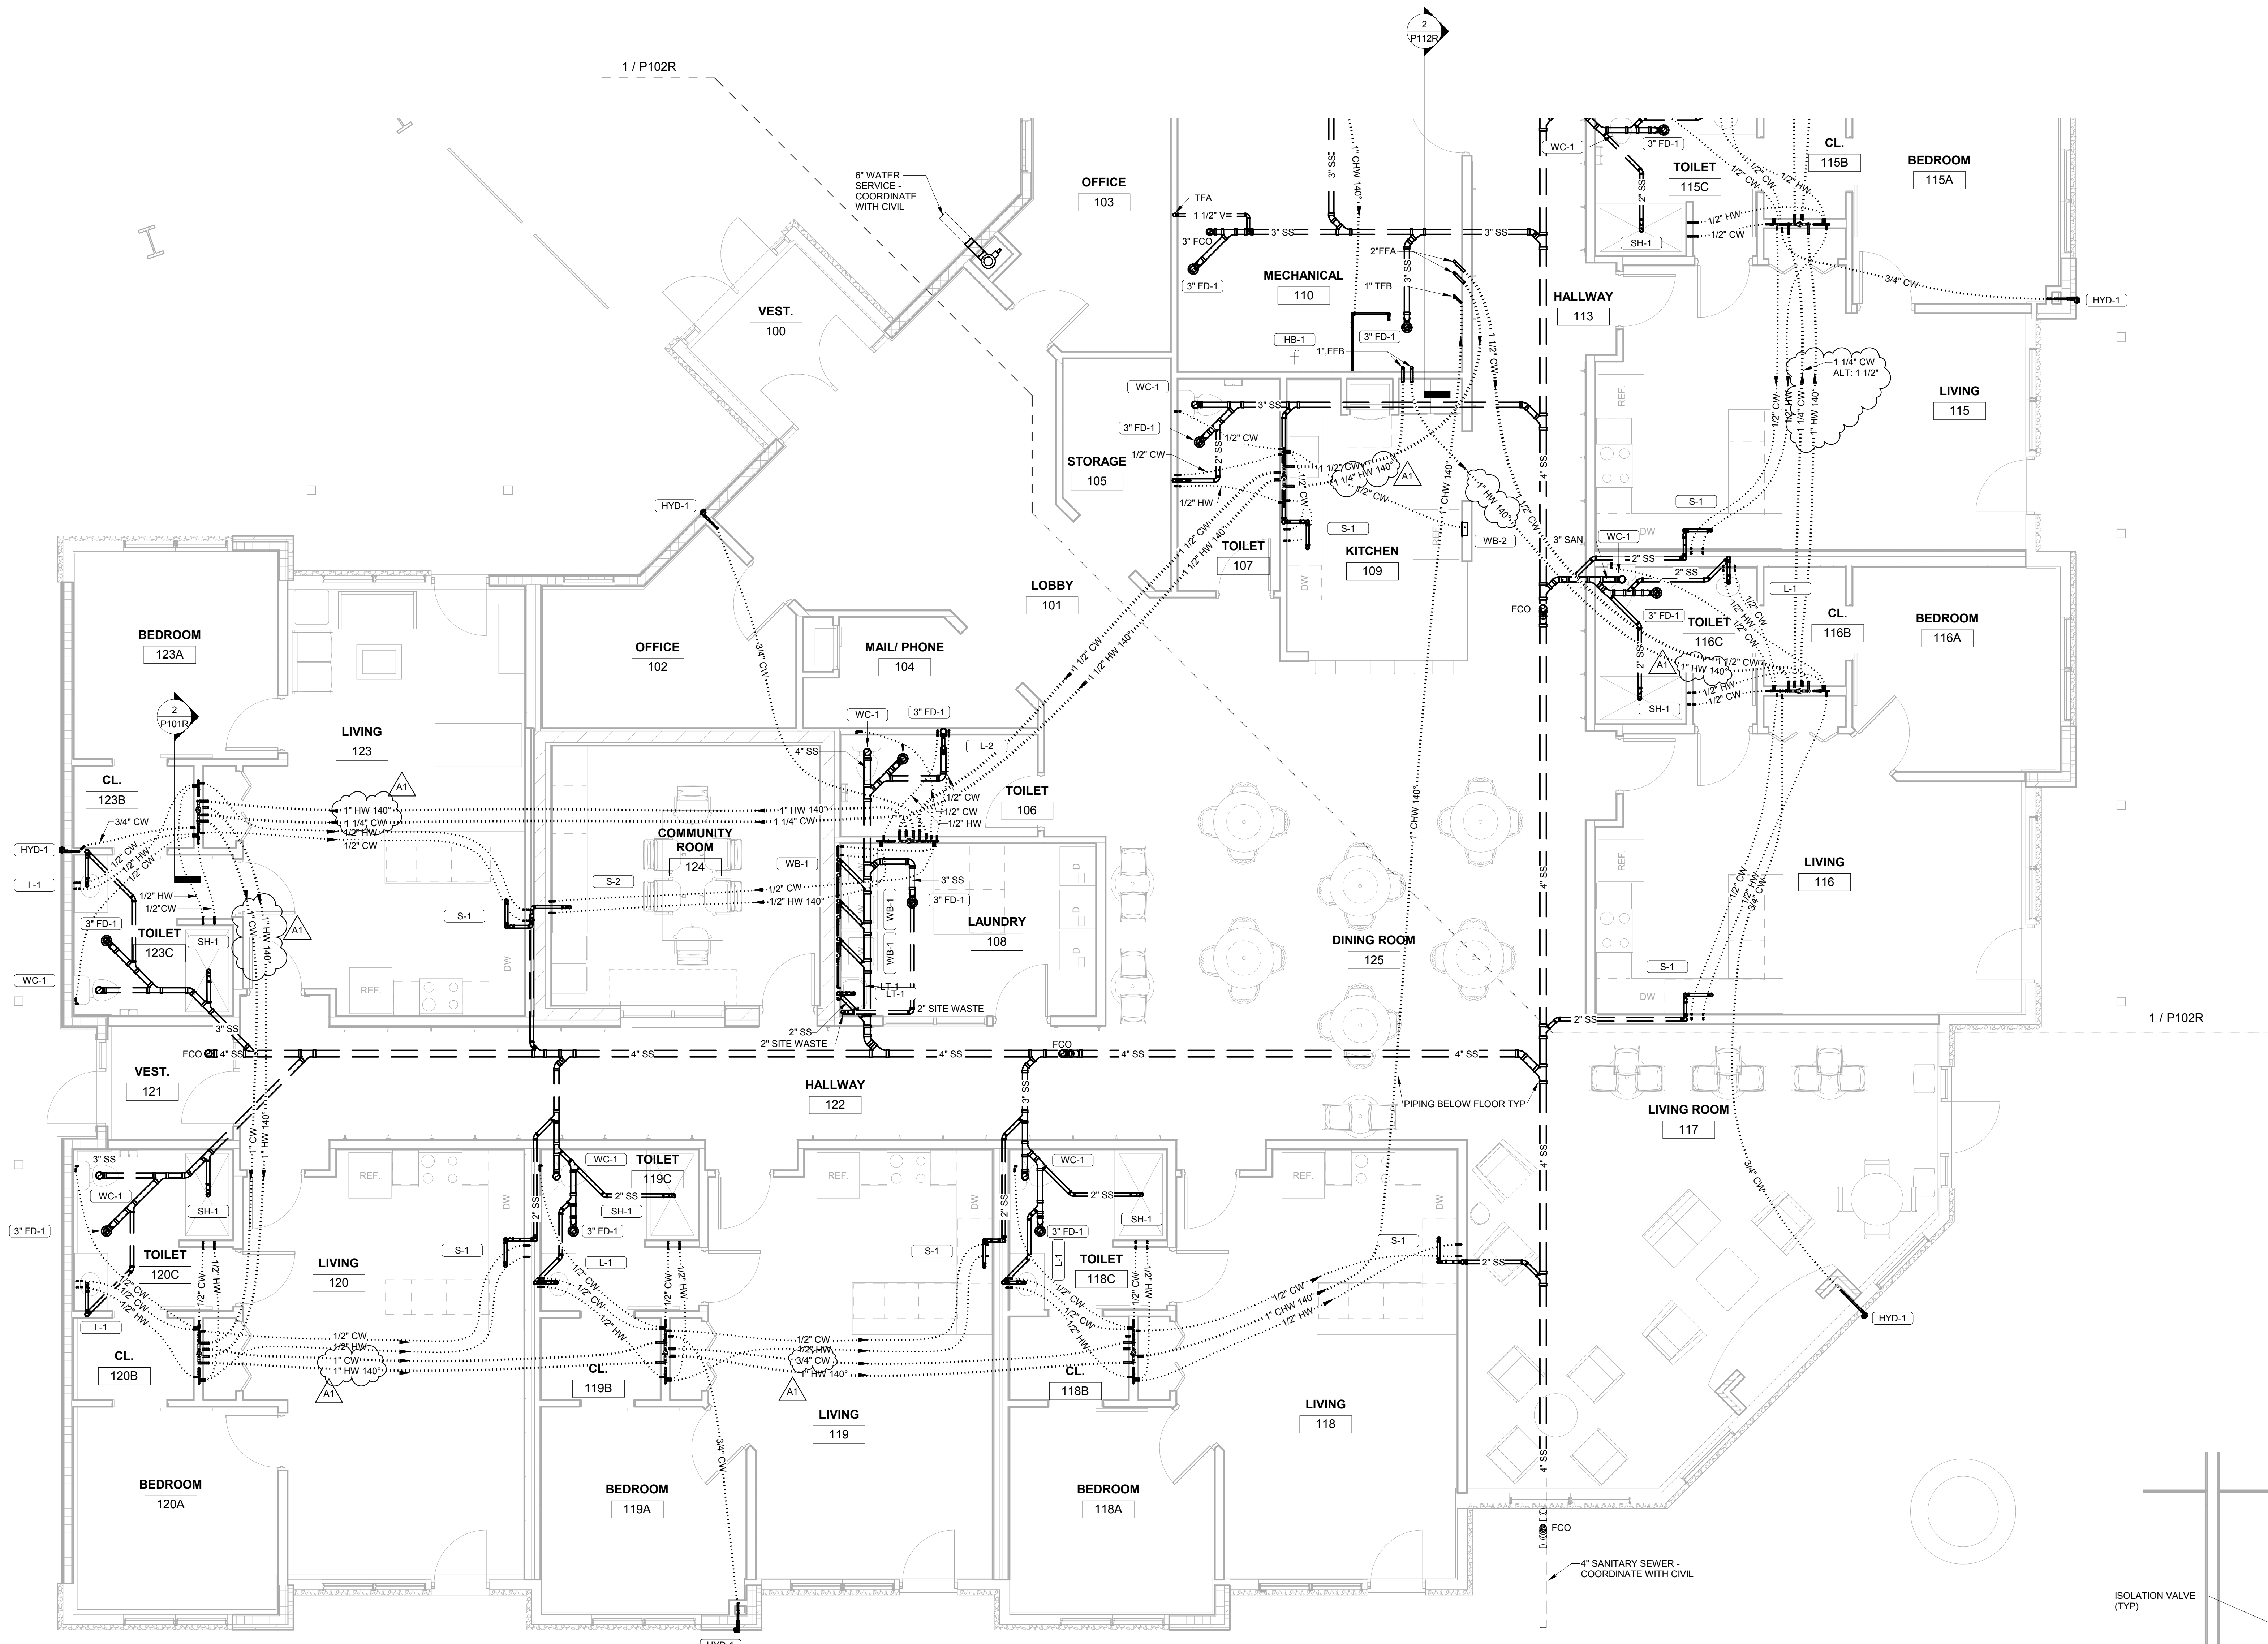


1 UNDERFLOOR PLAN - SEGMENT A
1/4" = 1'-0"

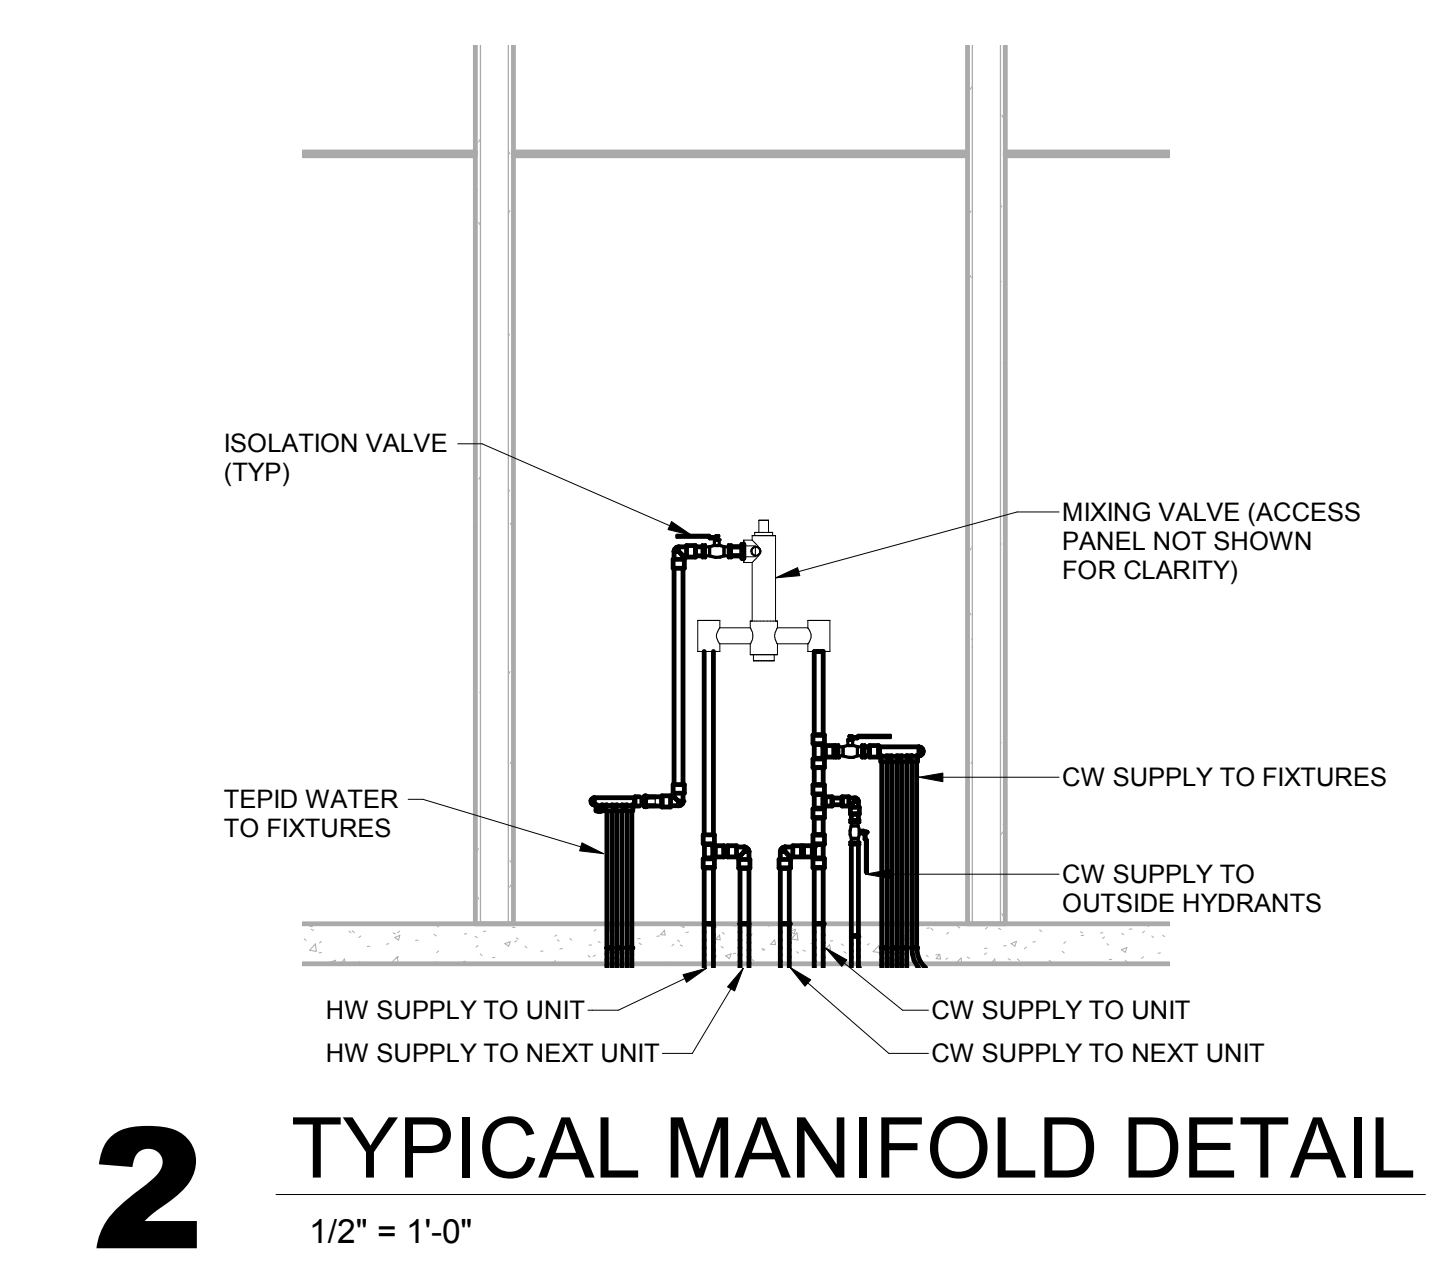

2 TYPICAL MANIFOLD DETAIL
1/2" = 1'-0"



Consultant:

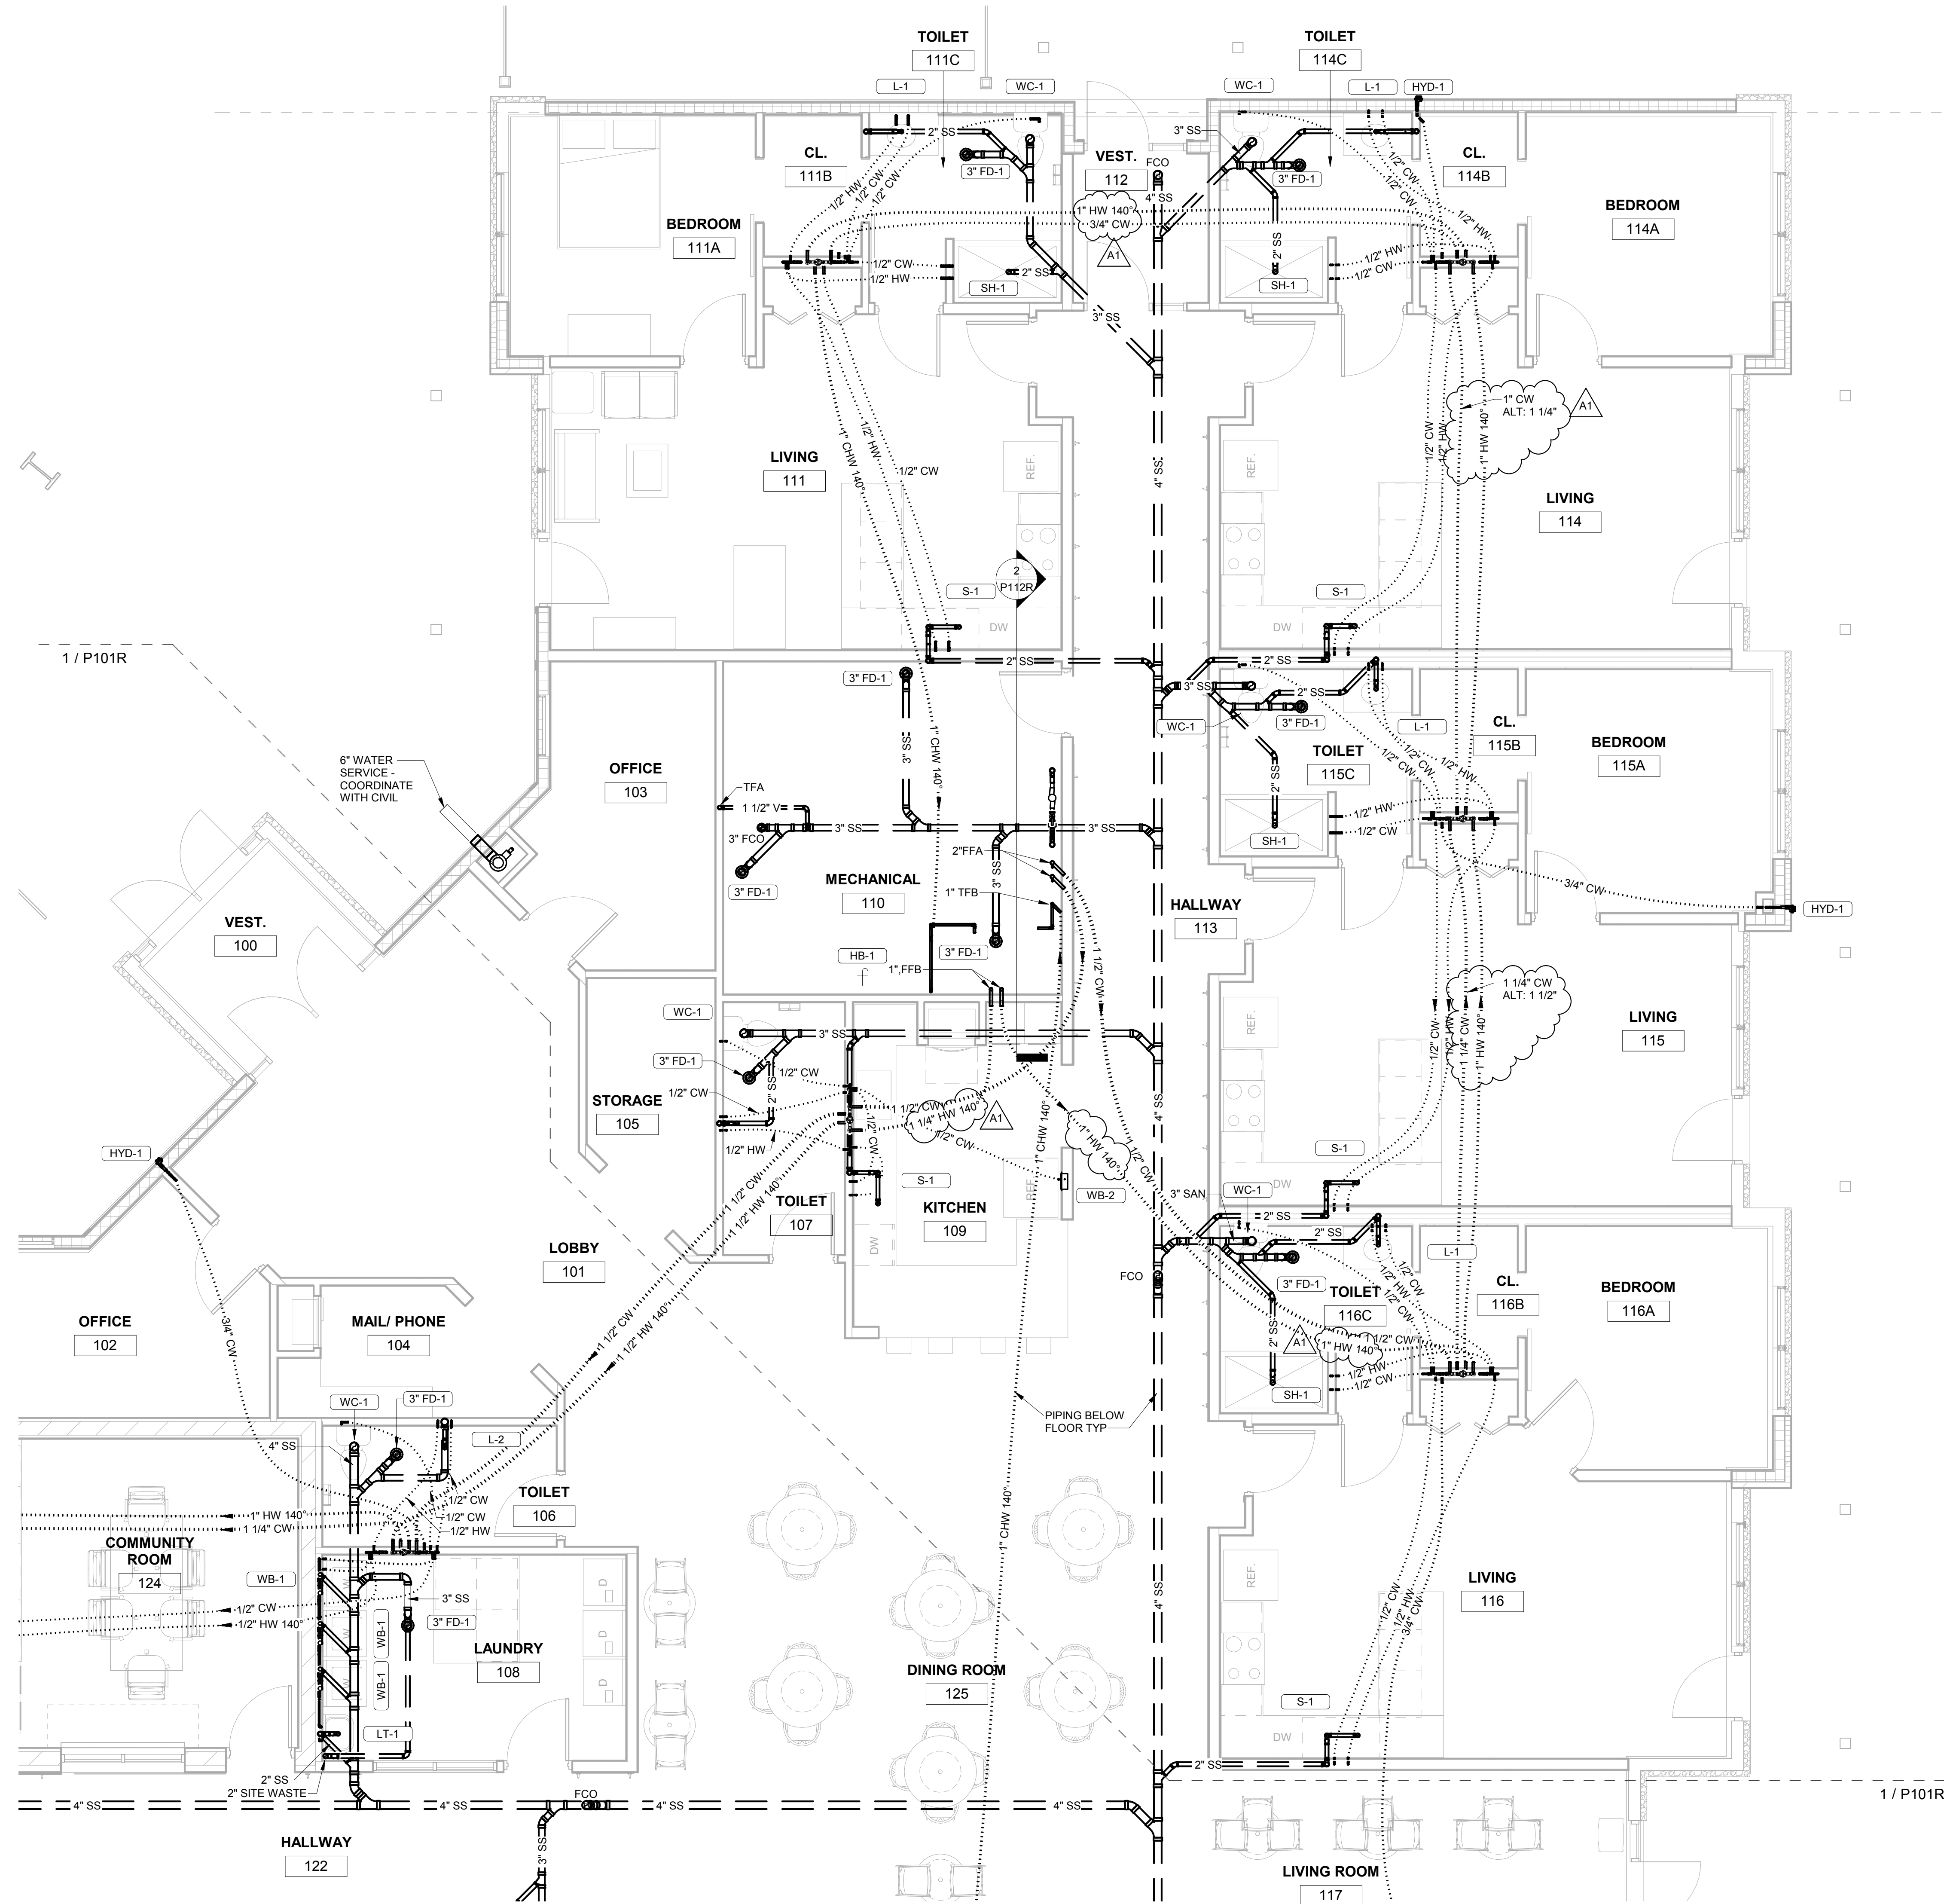

Project Title: **HO-CHUNK NATION
INDEPENDENT LIVING FACILITY**
Project Location: **BRANCHED ANTLER AVE.
BLACK RIVER FALLS, WI 54615**
Sheet Title: **UNDERFLOOR PLAN SEGMENT B**

HSR Project Number: **15027**

Project Date: **FEBRUARY 2018**

Drawn By: **RGJ/MSG**

Key Plan:

No.	Description	Date
A1	Addendum #1	2/16/2018

Graphic Scale: **VARIES**

Last Update: **2/16/2018 10:59:00 AM**

1 UNDERFLOOR PLAN - SEGMENT B
1/4" = 1'-0"

P102R



Consultant:

Project Title: **HO-CHUNK NATION
INDEPENDENT LIVING FACILITY**
Project Location: **BRANCHED ANTLER AVE.
BLACK RIVER FALLS, WI 54615**
Sheet Title: **UNDERFLOOR PLAN - ALTERNATE**

HSR Project Number: **15027**

Project Date: **FEBRUARY 2018**

Drawn By: **RGJ/MSG**


Key Plan:

No.	Description	Date
A1	Addendum #1	2/16/2018


Graphic Scale: **VARIES**

Last Update: **2/16/2018 10:59:04 AM**

P103R

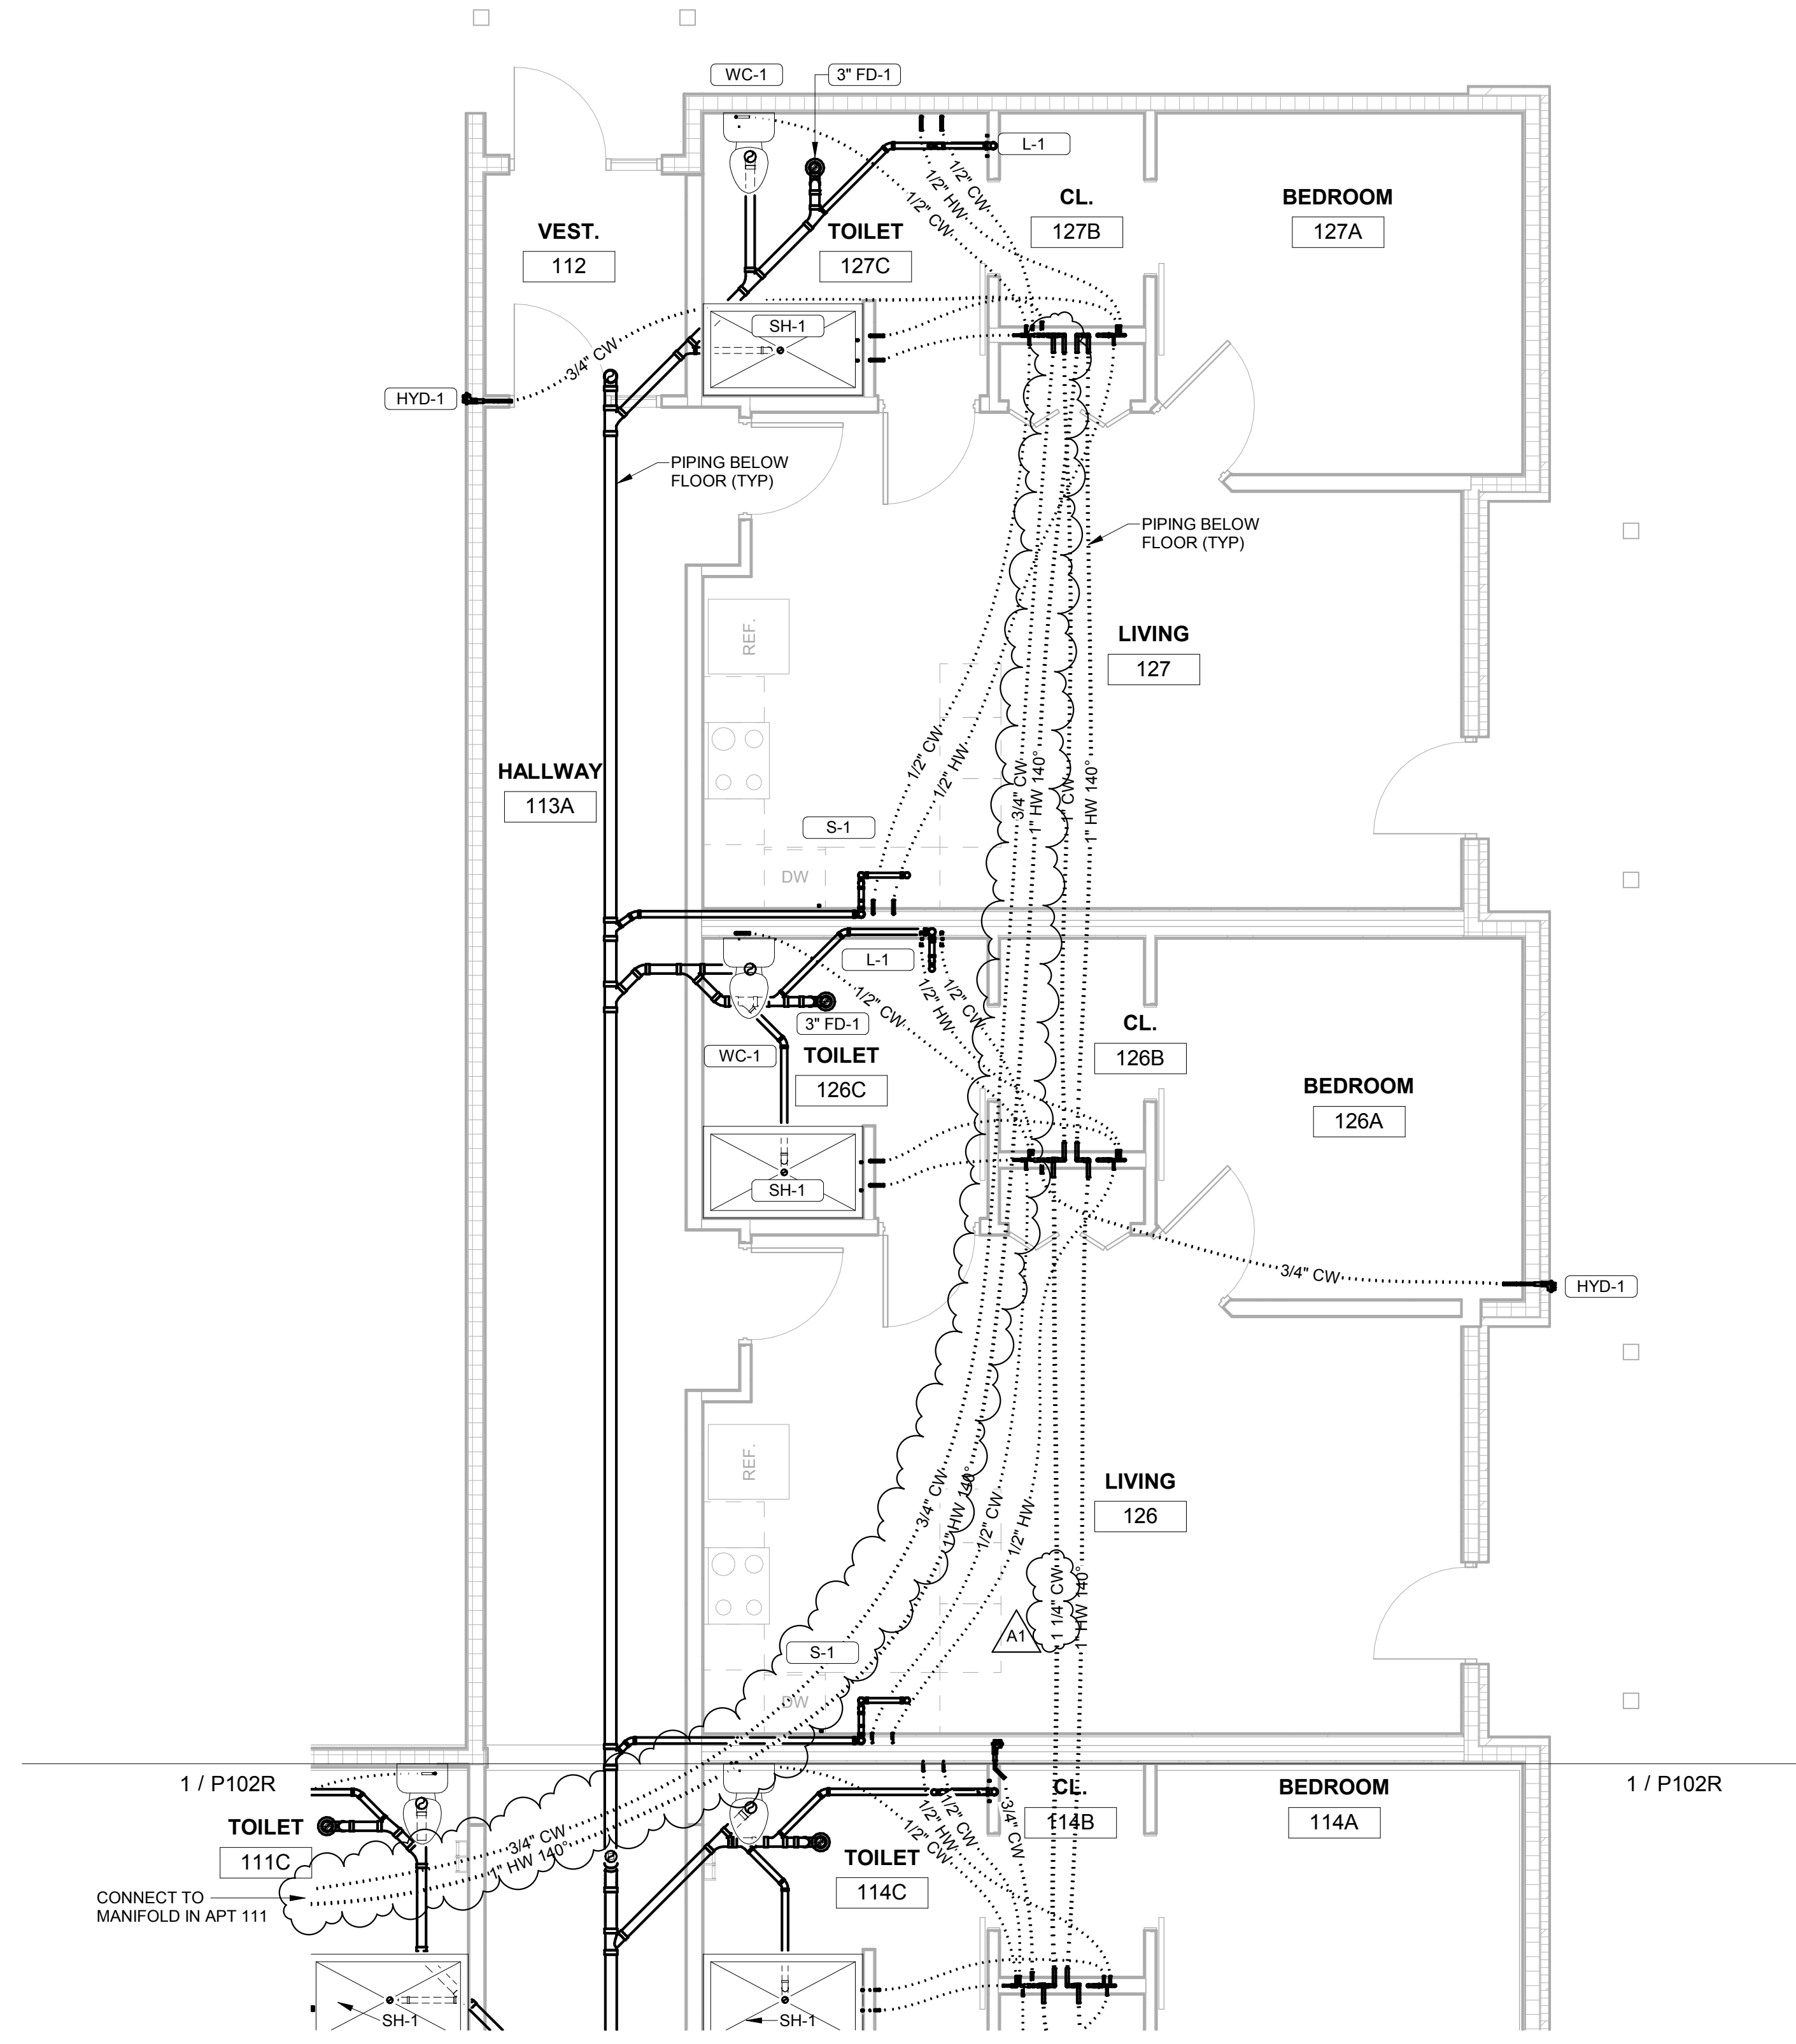

1 UNDERFLOOR REMODEL - ALTERNATE
1/4" = 1'-0"

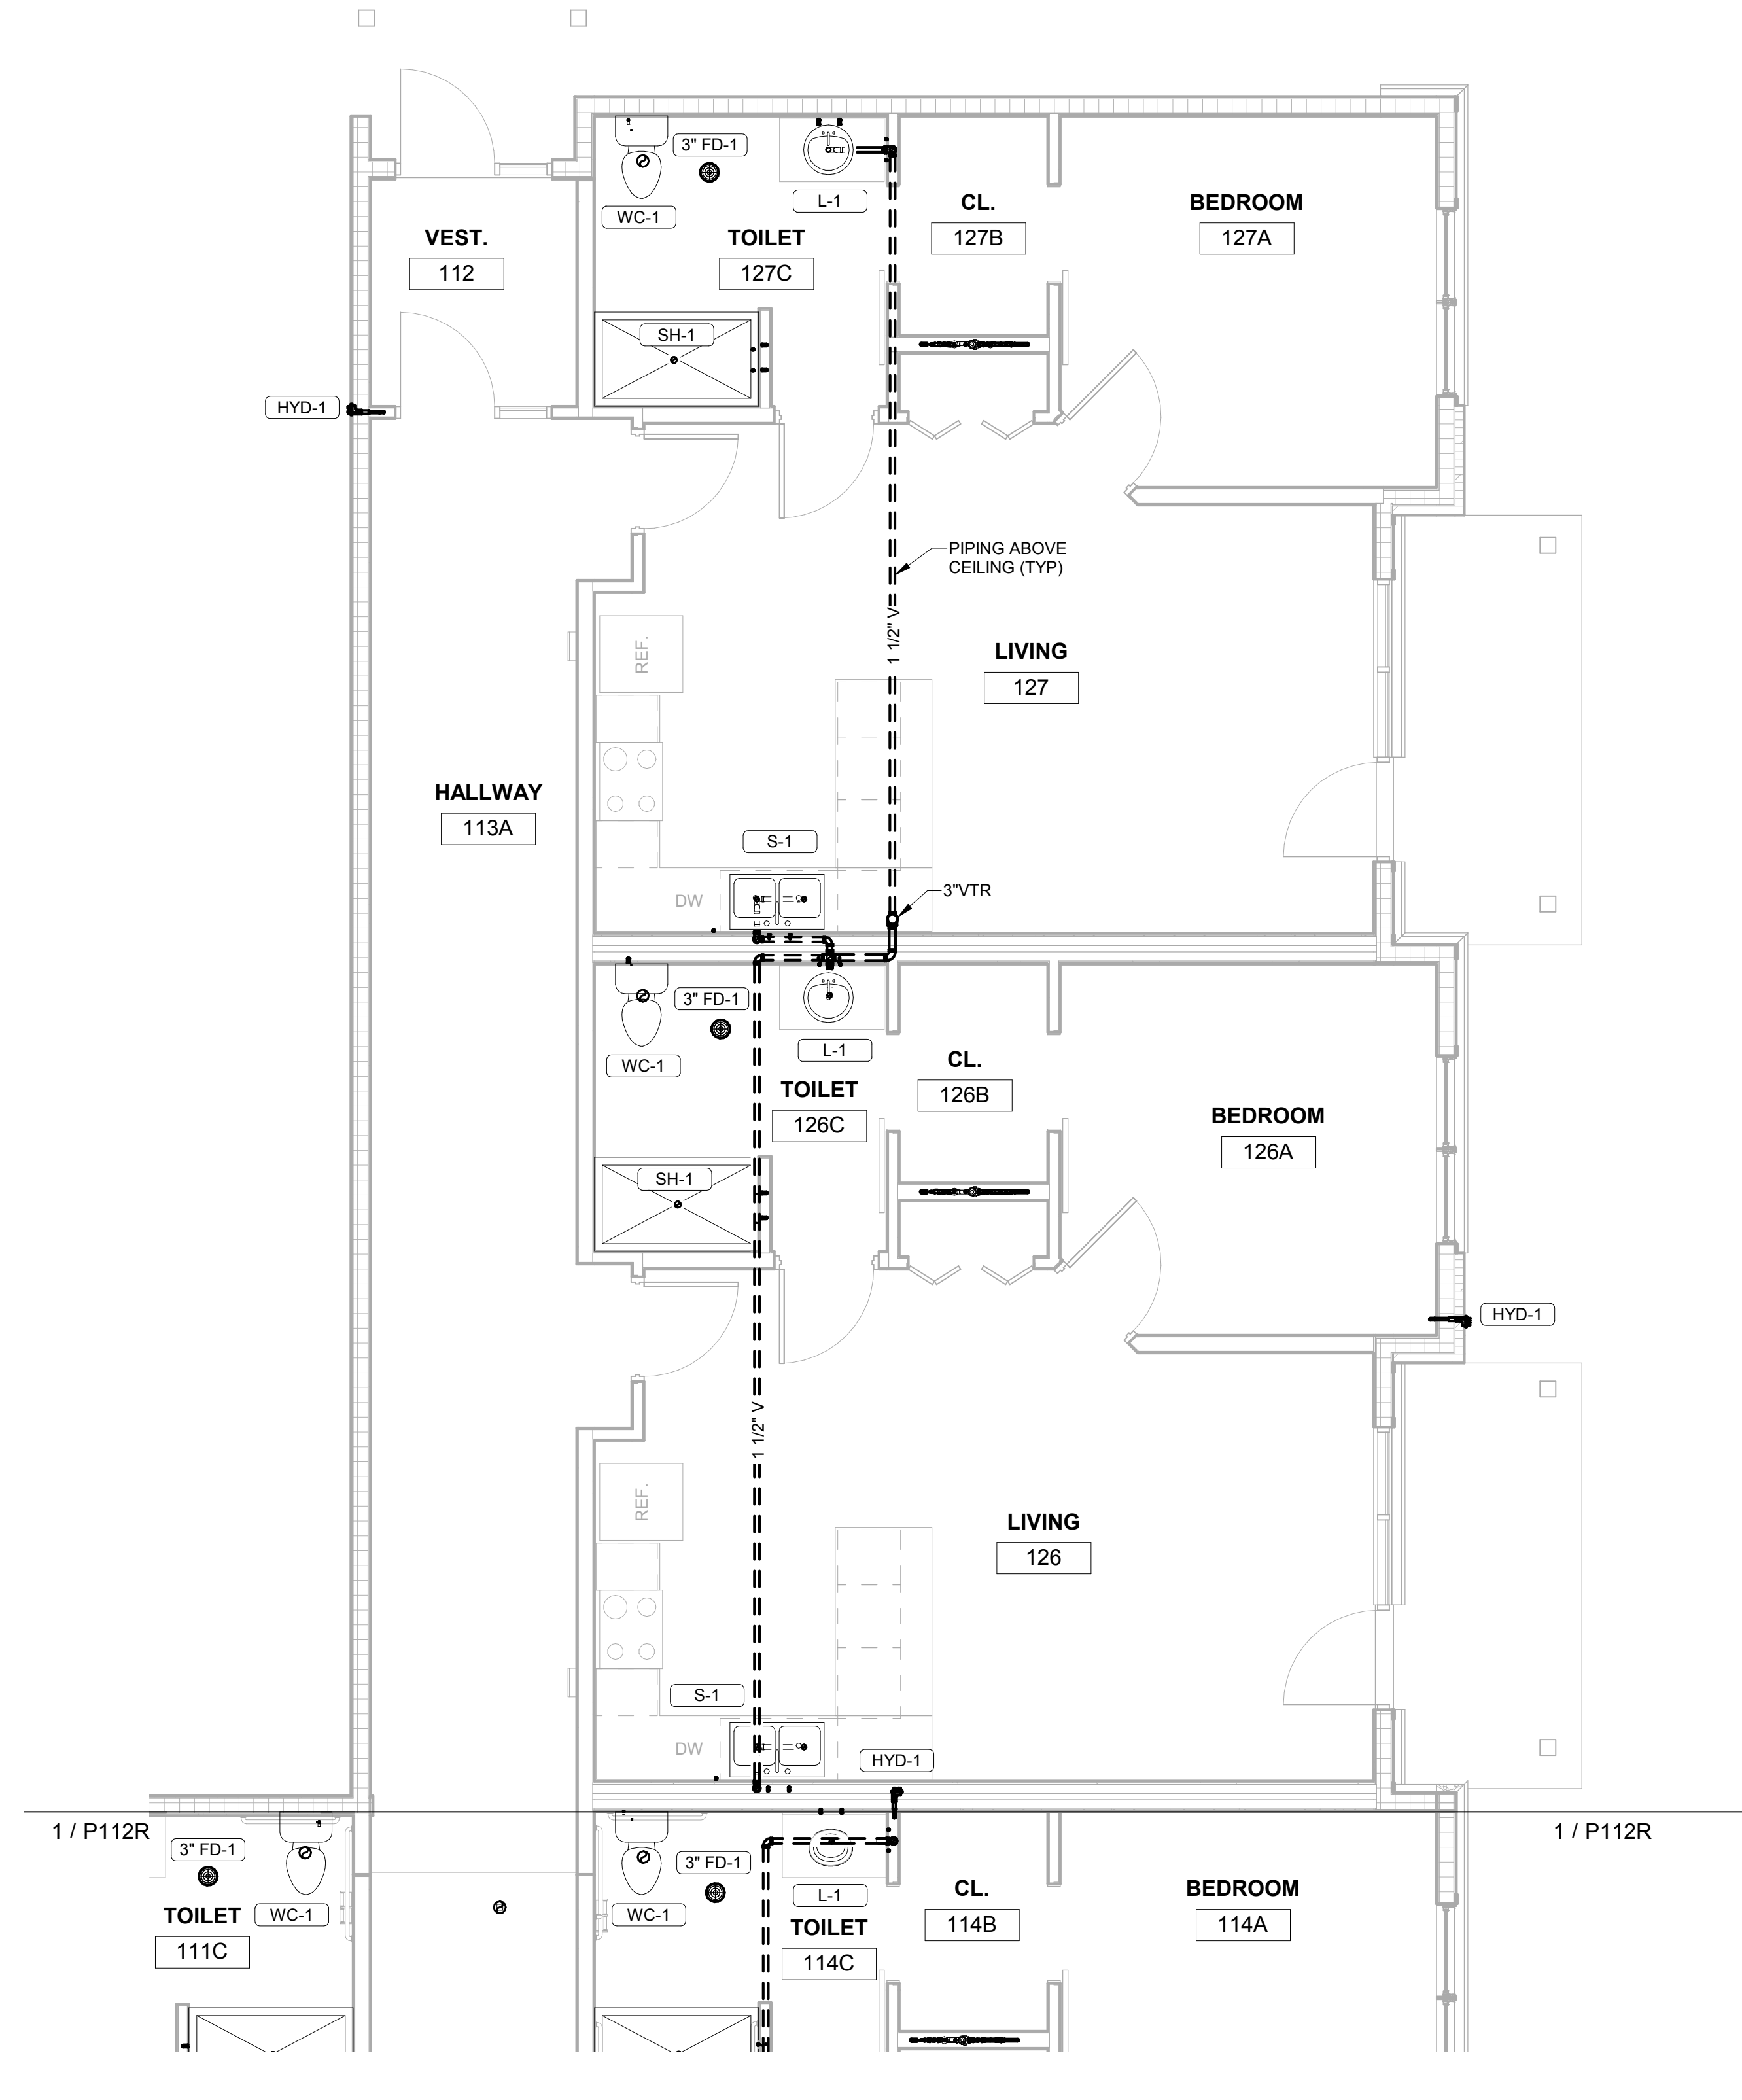

2 FIRST FLOOR REMODEL - ALTERNATE
1/4" = 1'-0"



Consultant:

Project Title:
**HO-CHUNK NATION
INDEPENDENT LIVING FACILITY**

Project Location:
BRANCHED ANTLER AVE.
BLACK RIVER FALLS, WI 54615

Sheet Title:
FIRST FLOOR PLAN - SEGMENT B

HSR Project Number:
15027

Project Date:
FEBRUARY 2018

Drawn By:
RGJ/MSG


Key Plan:

No.	Description	Date
A1	Addendum #1	2/16/2018


Graphic Scale:
VARIES

Last Update:
2/16/2018 10:59:11 AM

P112R

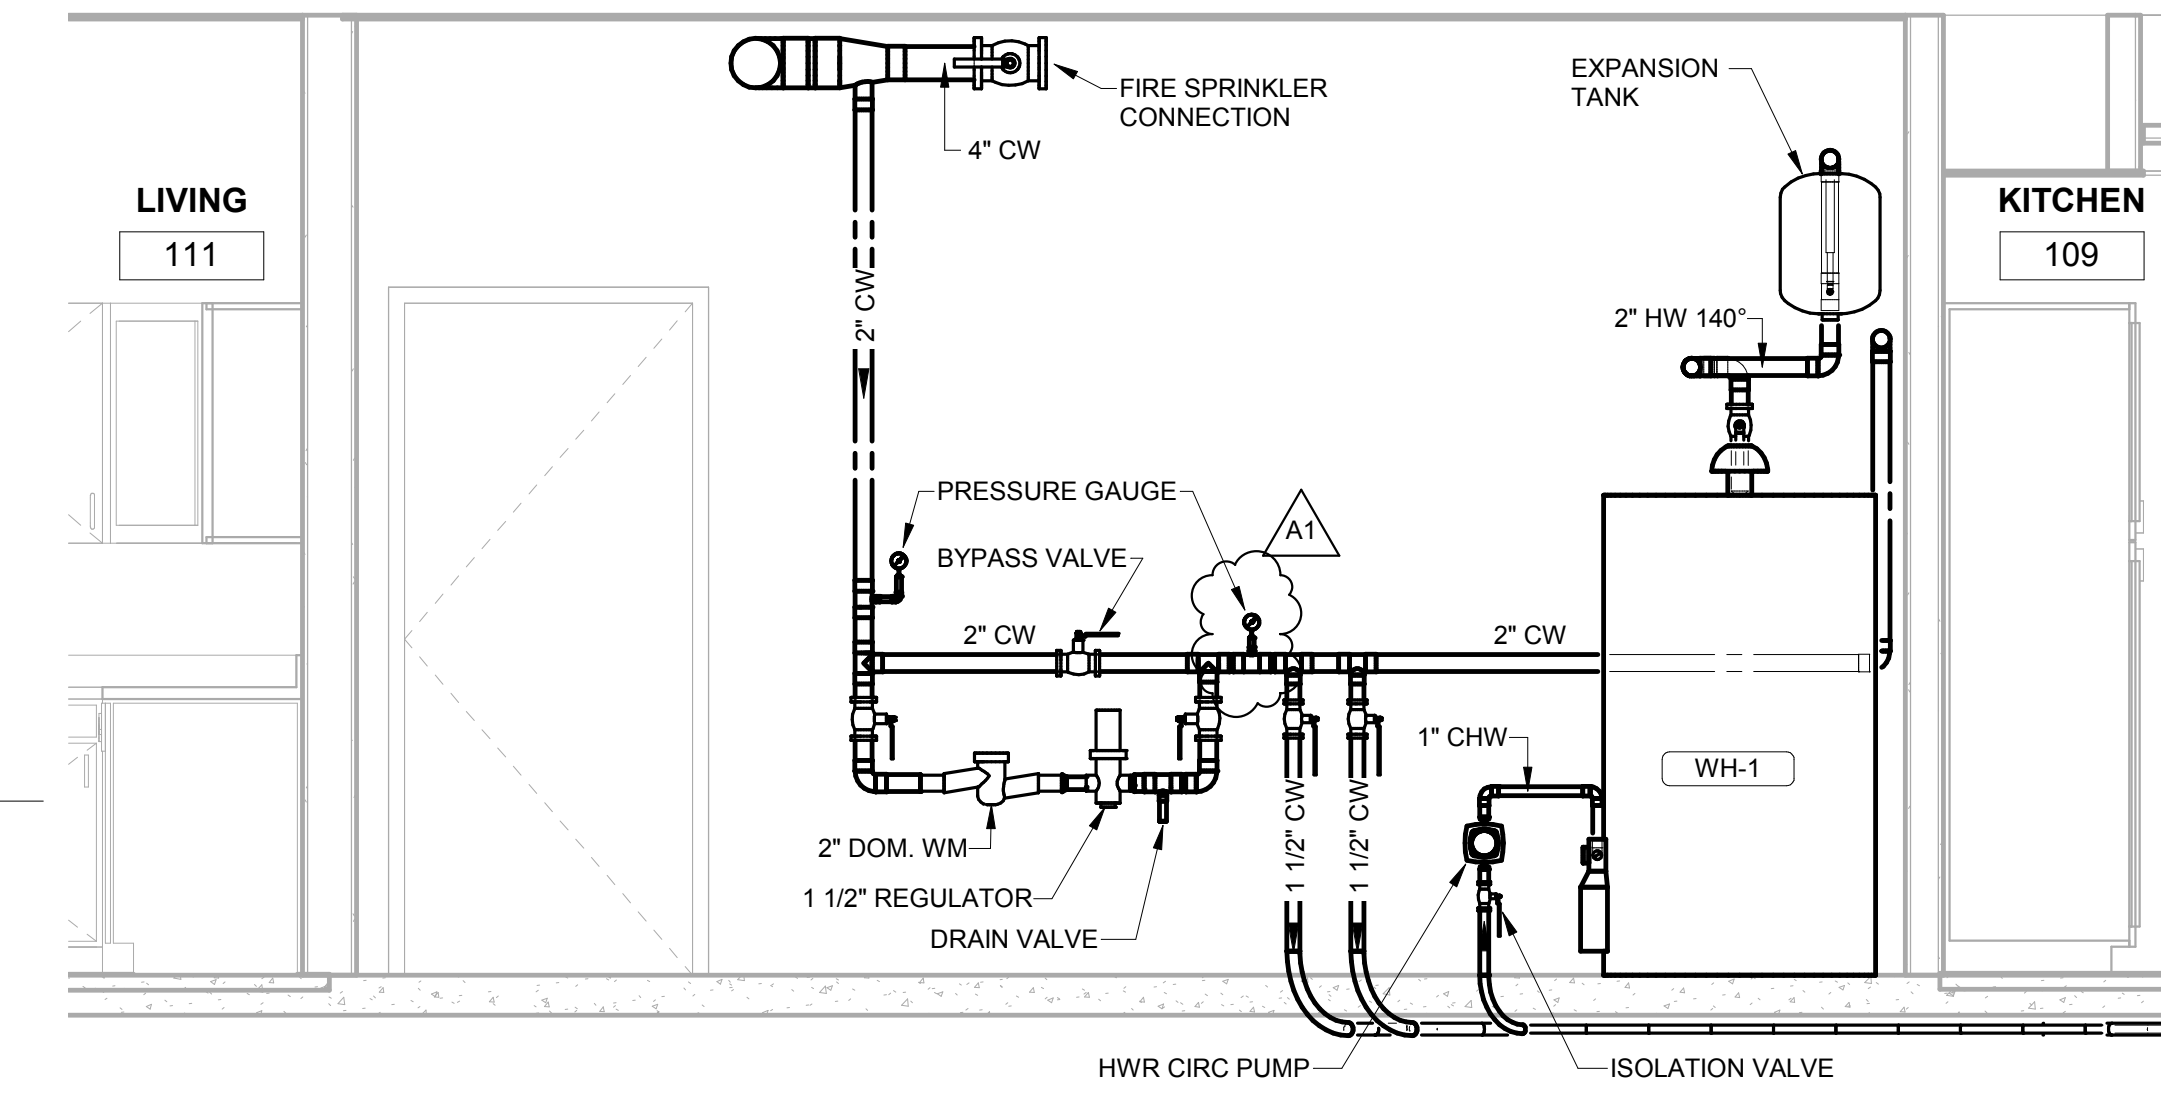


2 WATER METER DETAIL
1/2" = 1'-0"

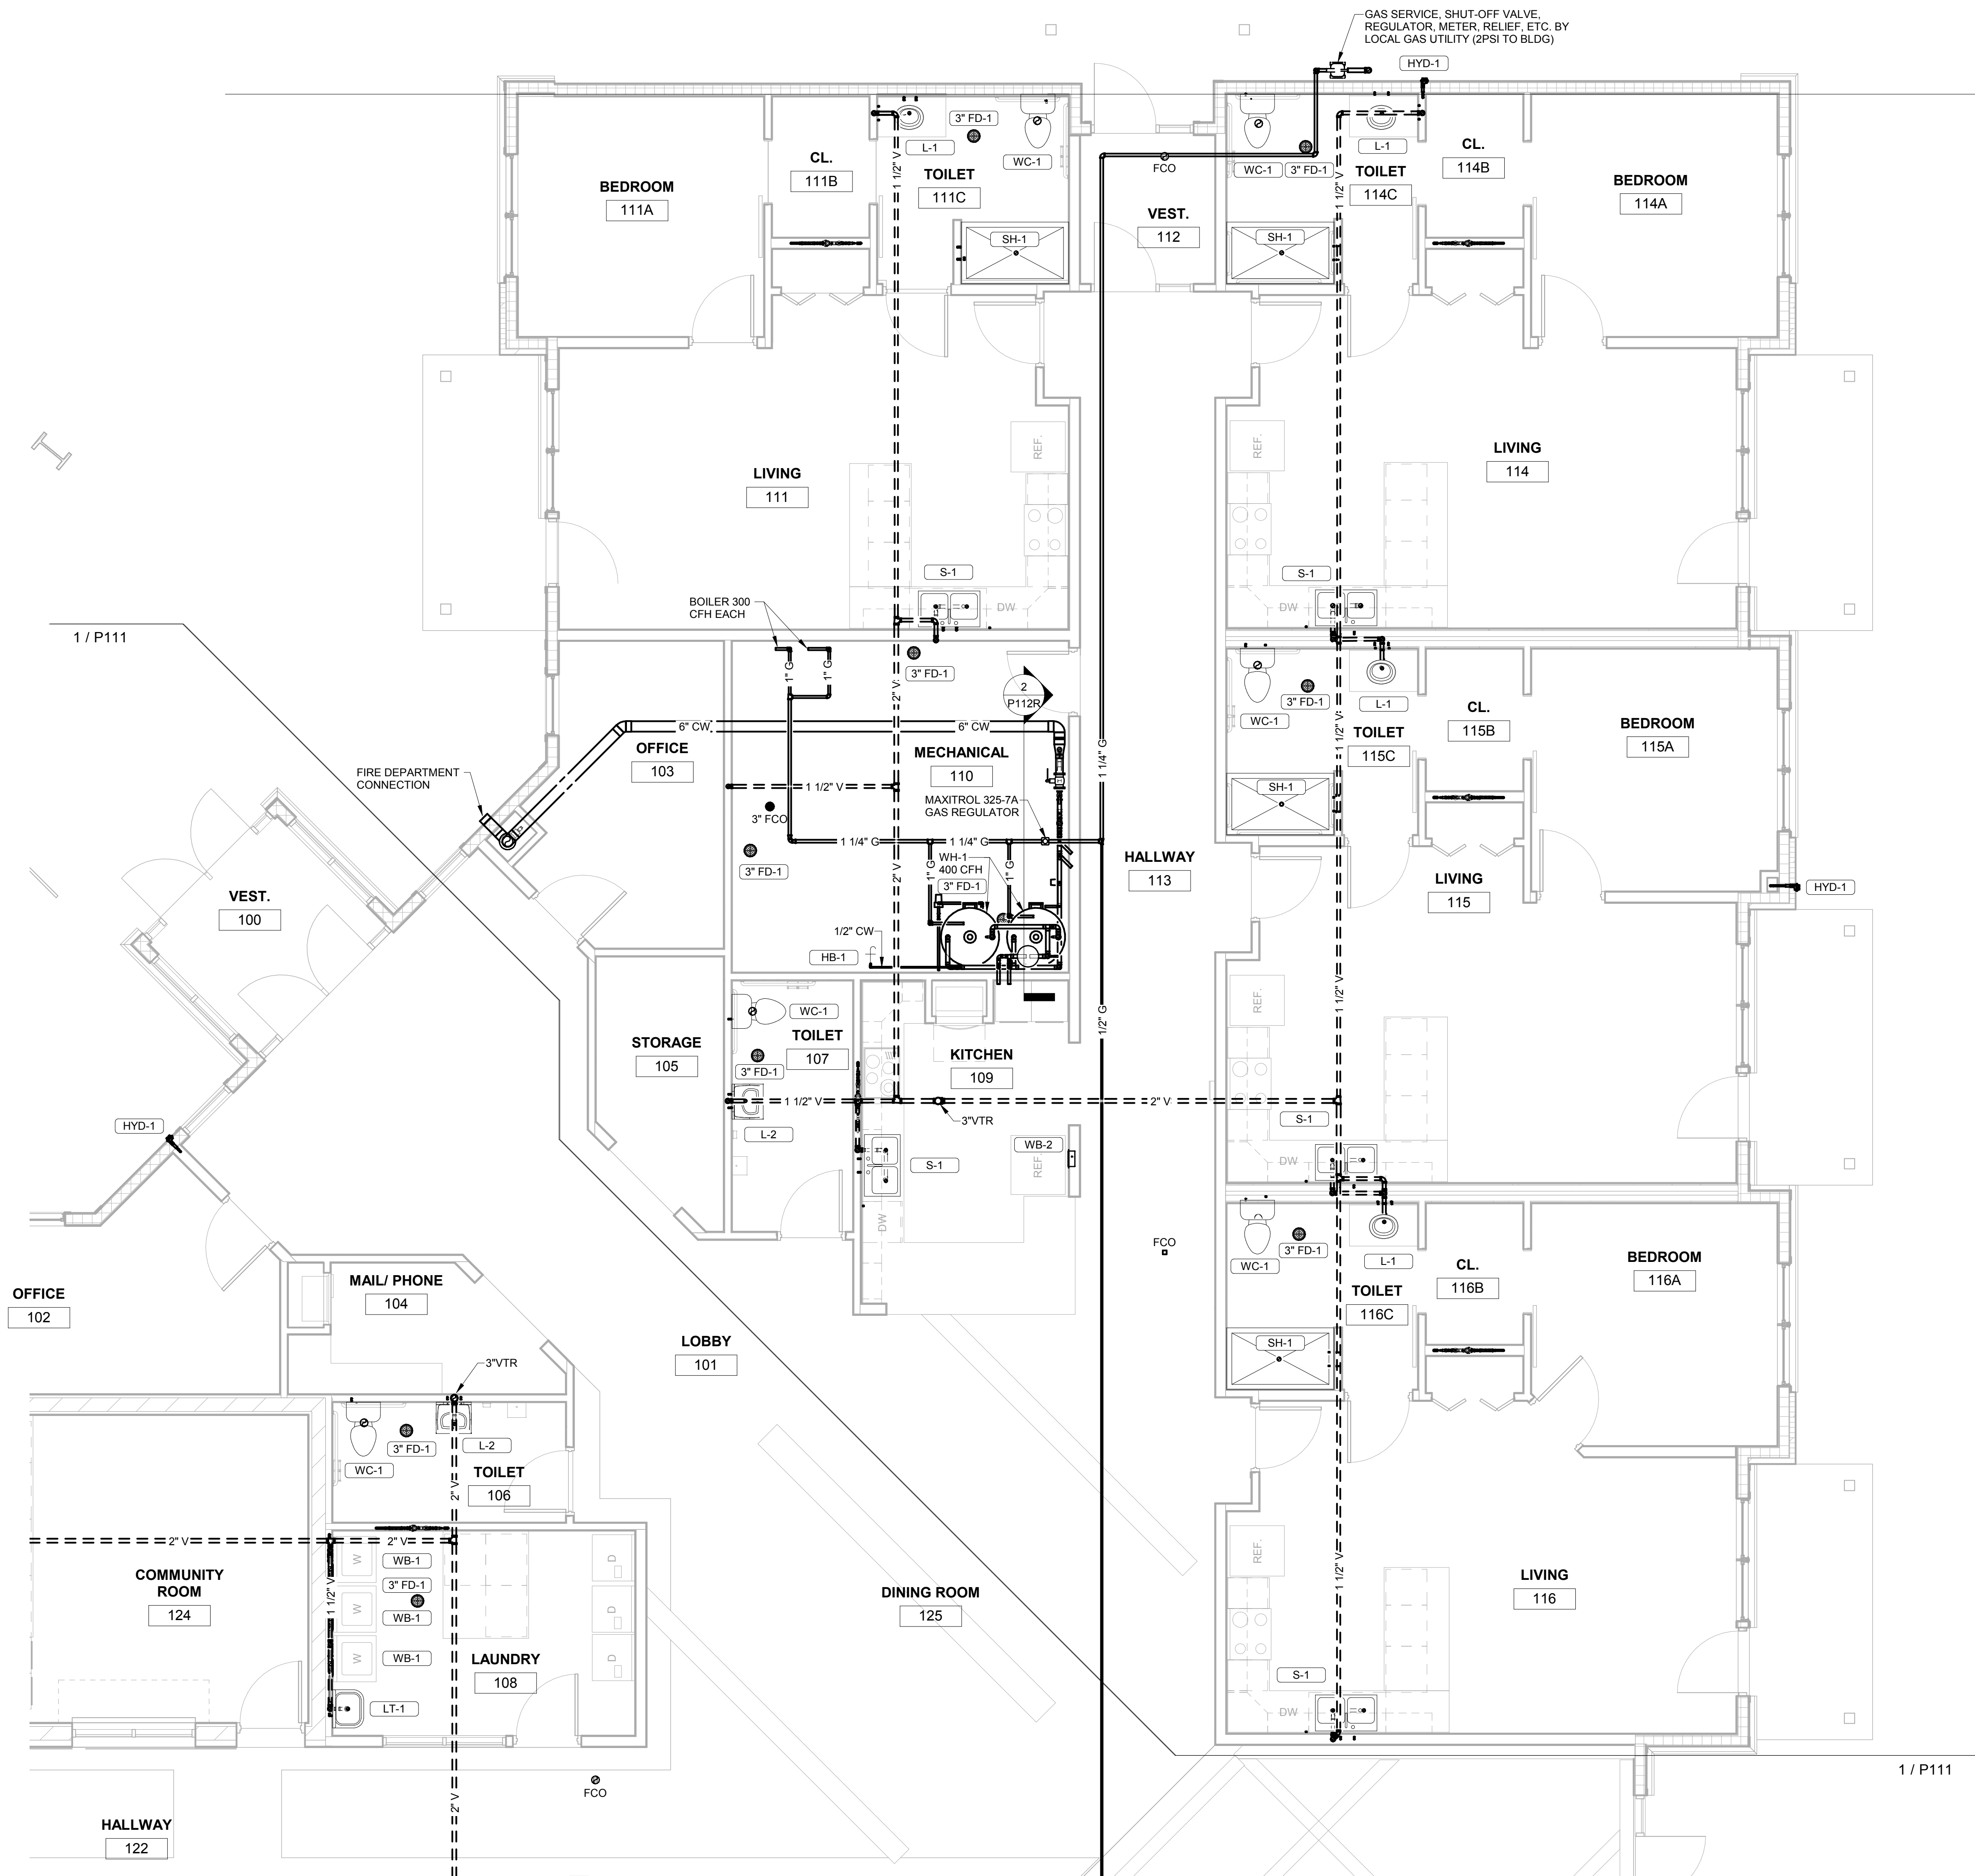


1 FIRST FLOOR PLAN - SEGMENT B
1/4" = 1'-0"




Consultant:

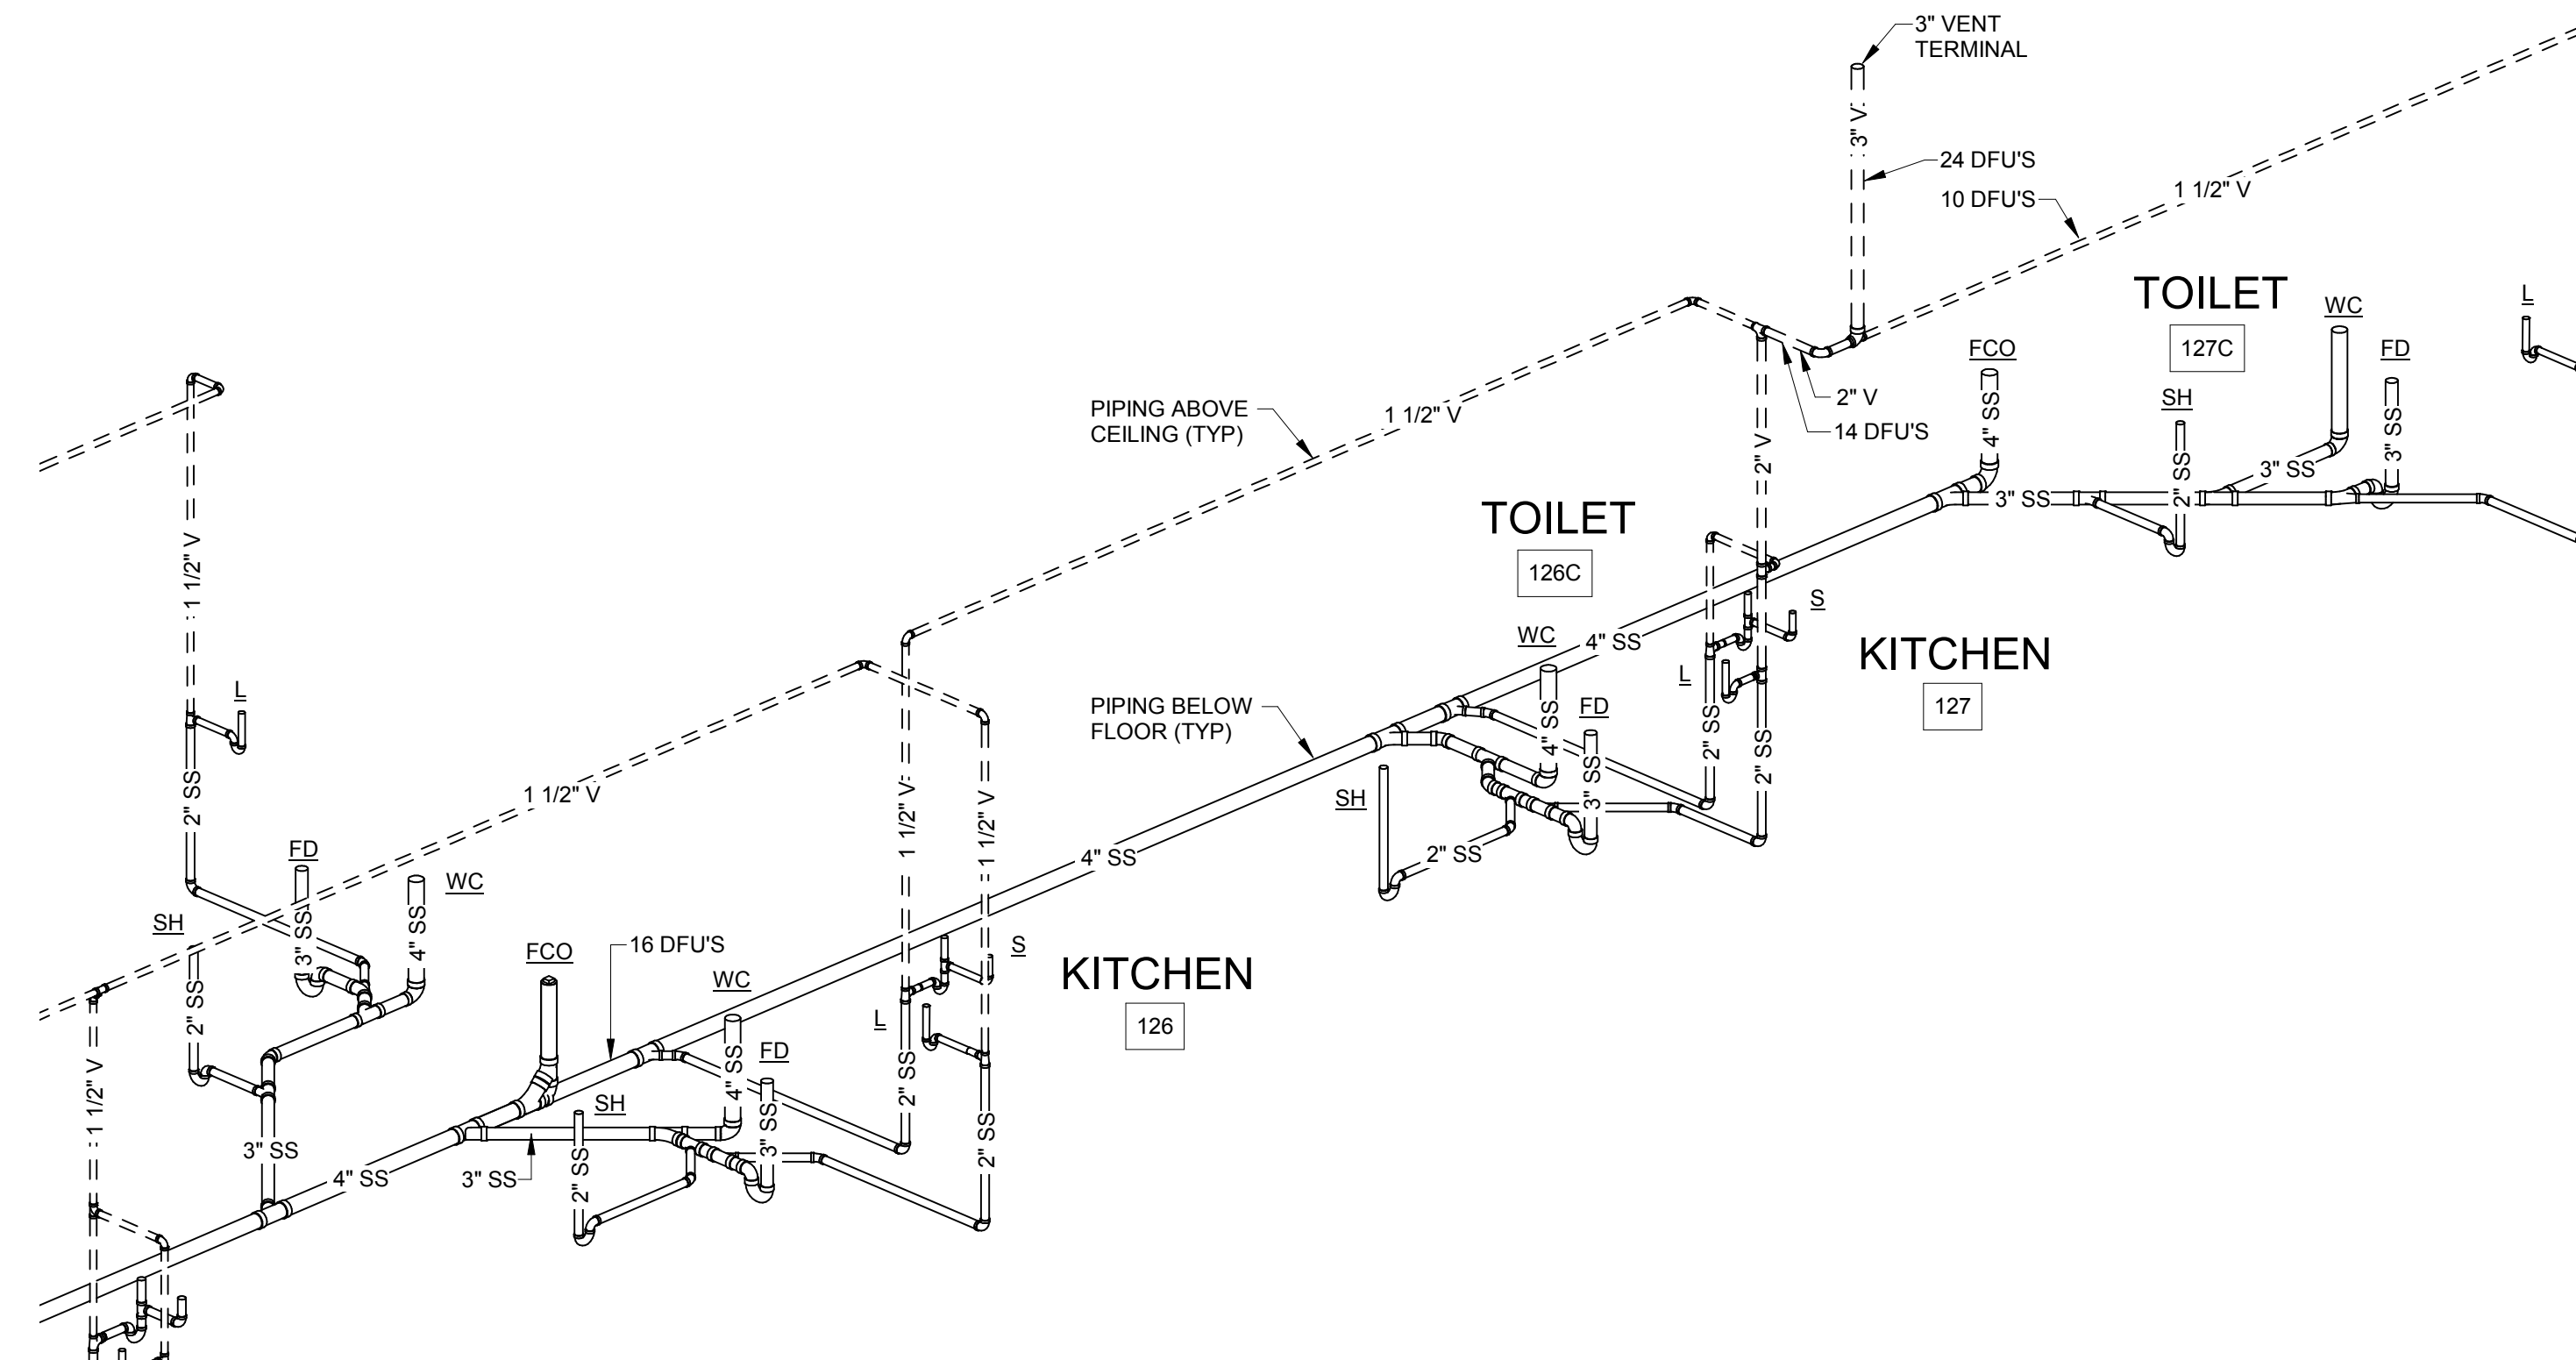

2 WASTE & VENT RISER DIAGRAM - ALTERNATE

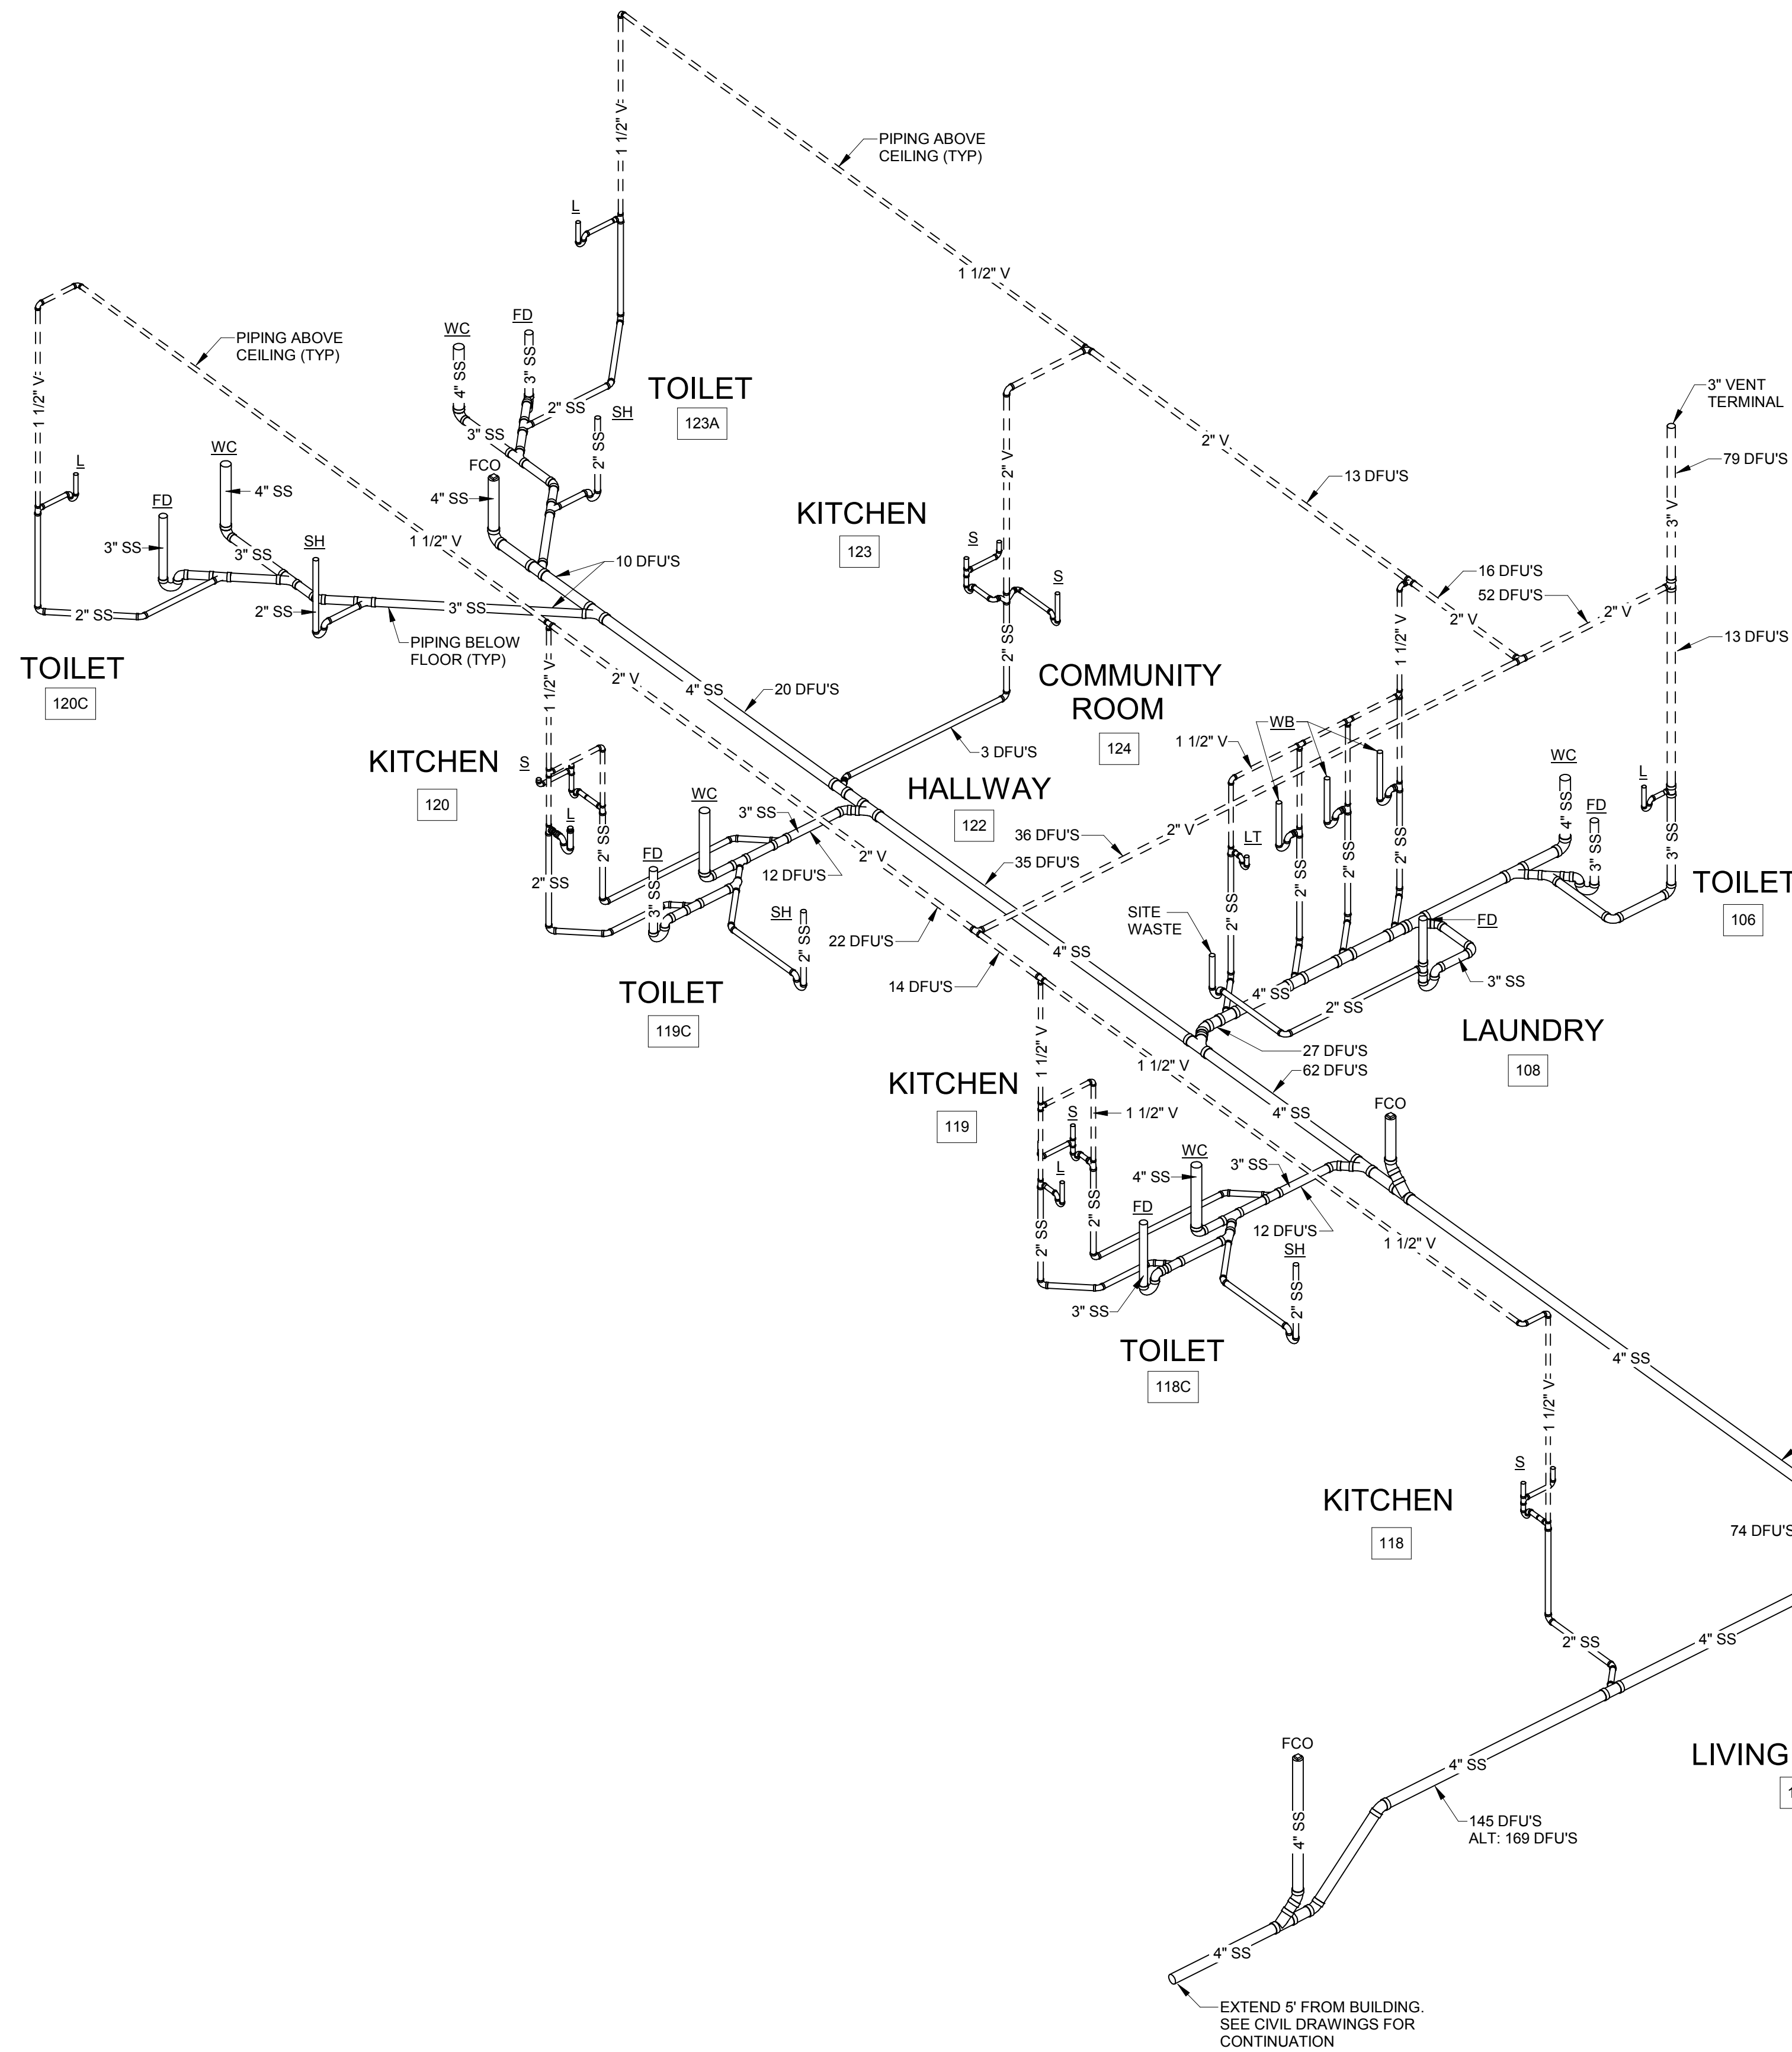

1 WASTE & VENT RISER DIAGRAM - SEG A

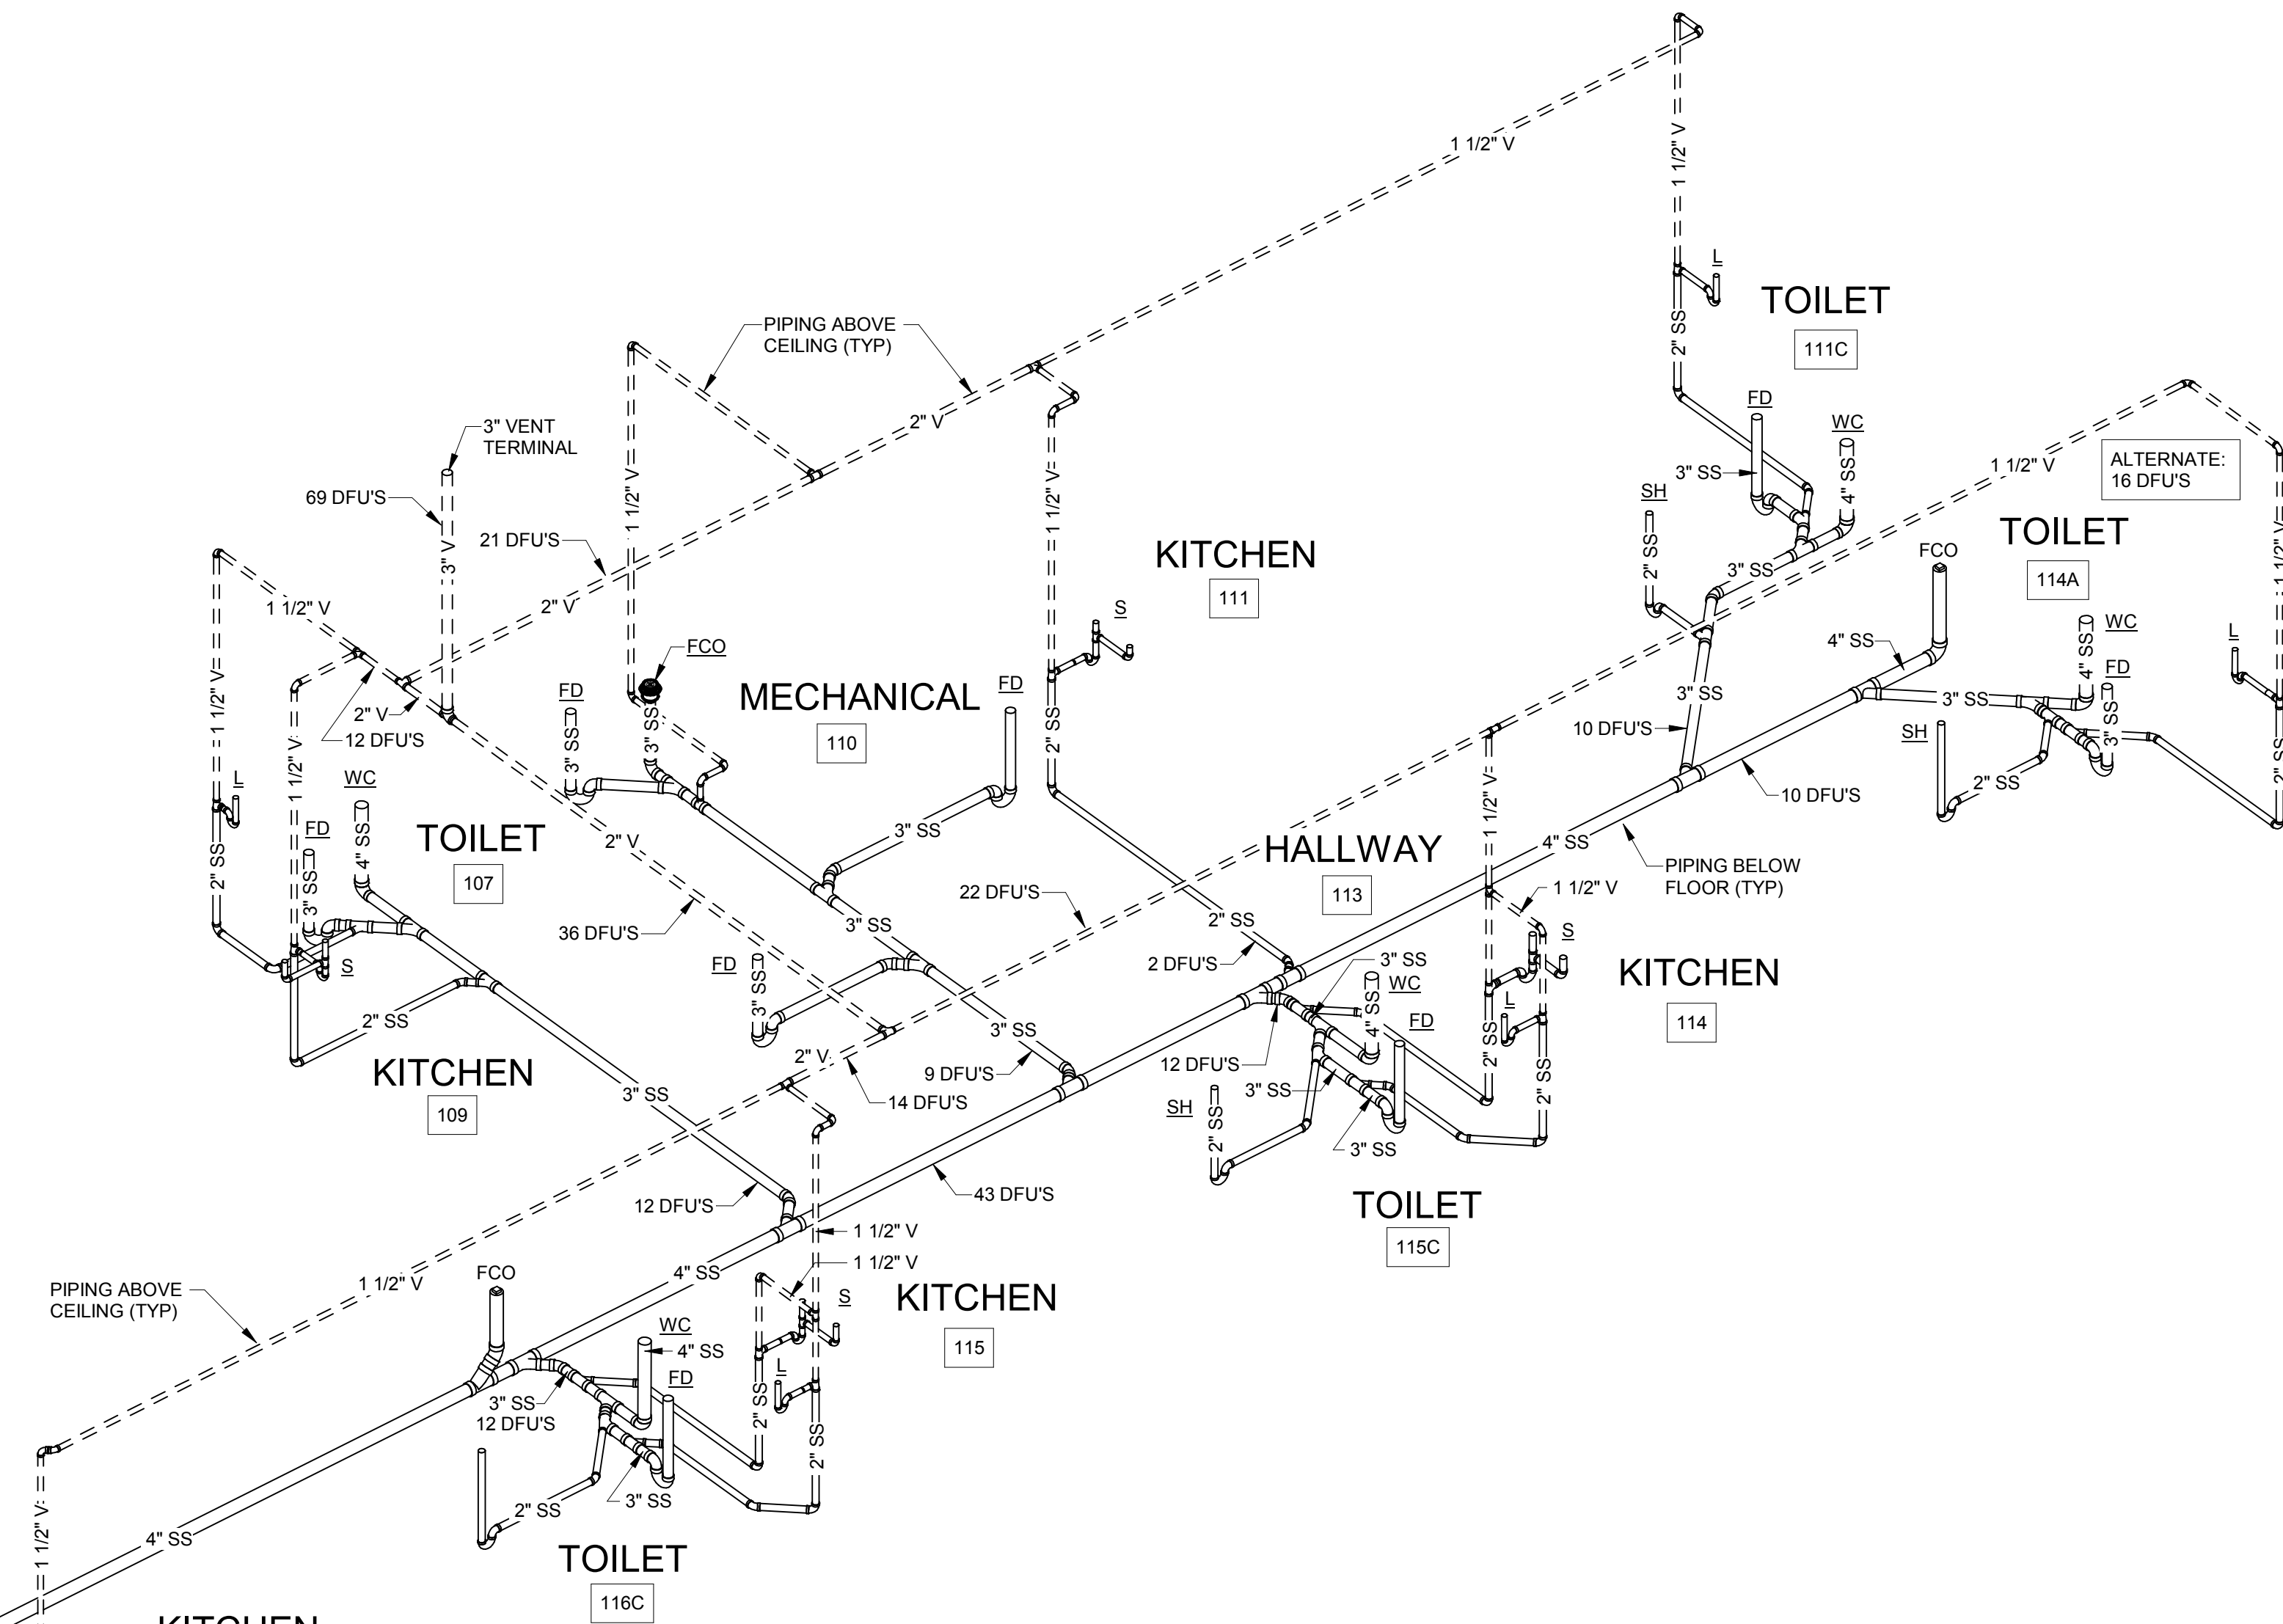

Project Title: **HO-CHUNK NATION
INDEPENDENT LIVING FACILITY**

HSR Project Number: **15027**

Project Date: **FEBRUARY 2018**

Drawn By: **RGJ/MSG**

Key Plan:

No.	Description	Date
A1	Addendum #1	2/16/2018


Graphic Scale: **VARIES**

Last Update: **2/16/2018 10:59:14 AM**


P200



Consultant:

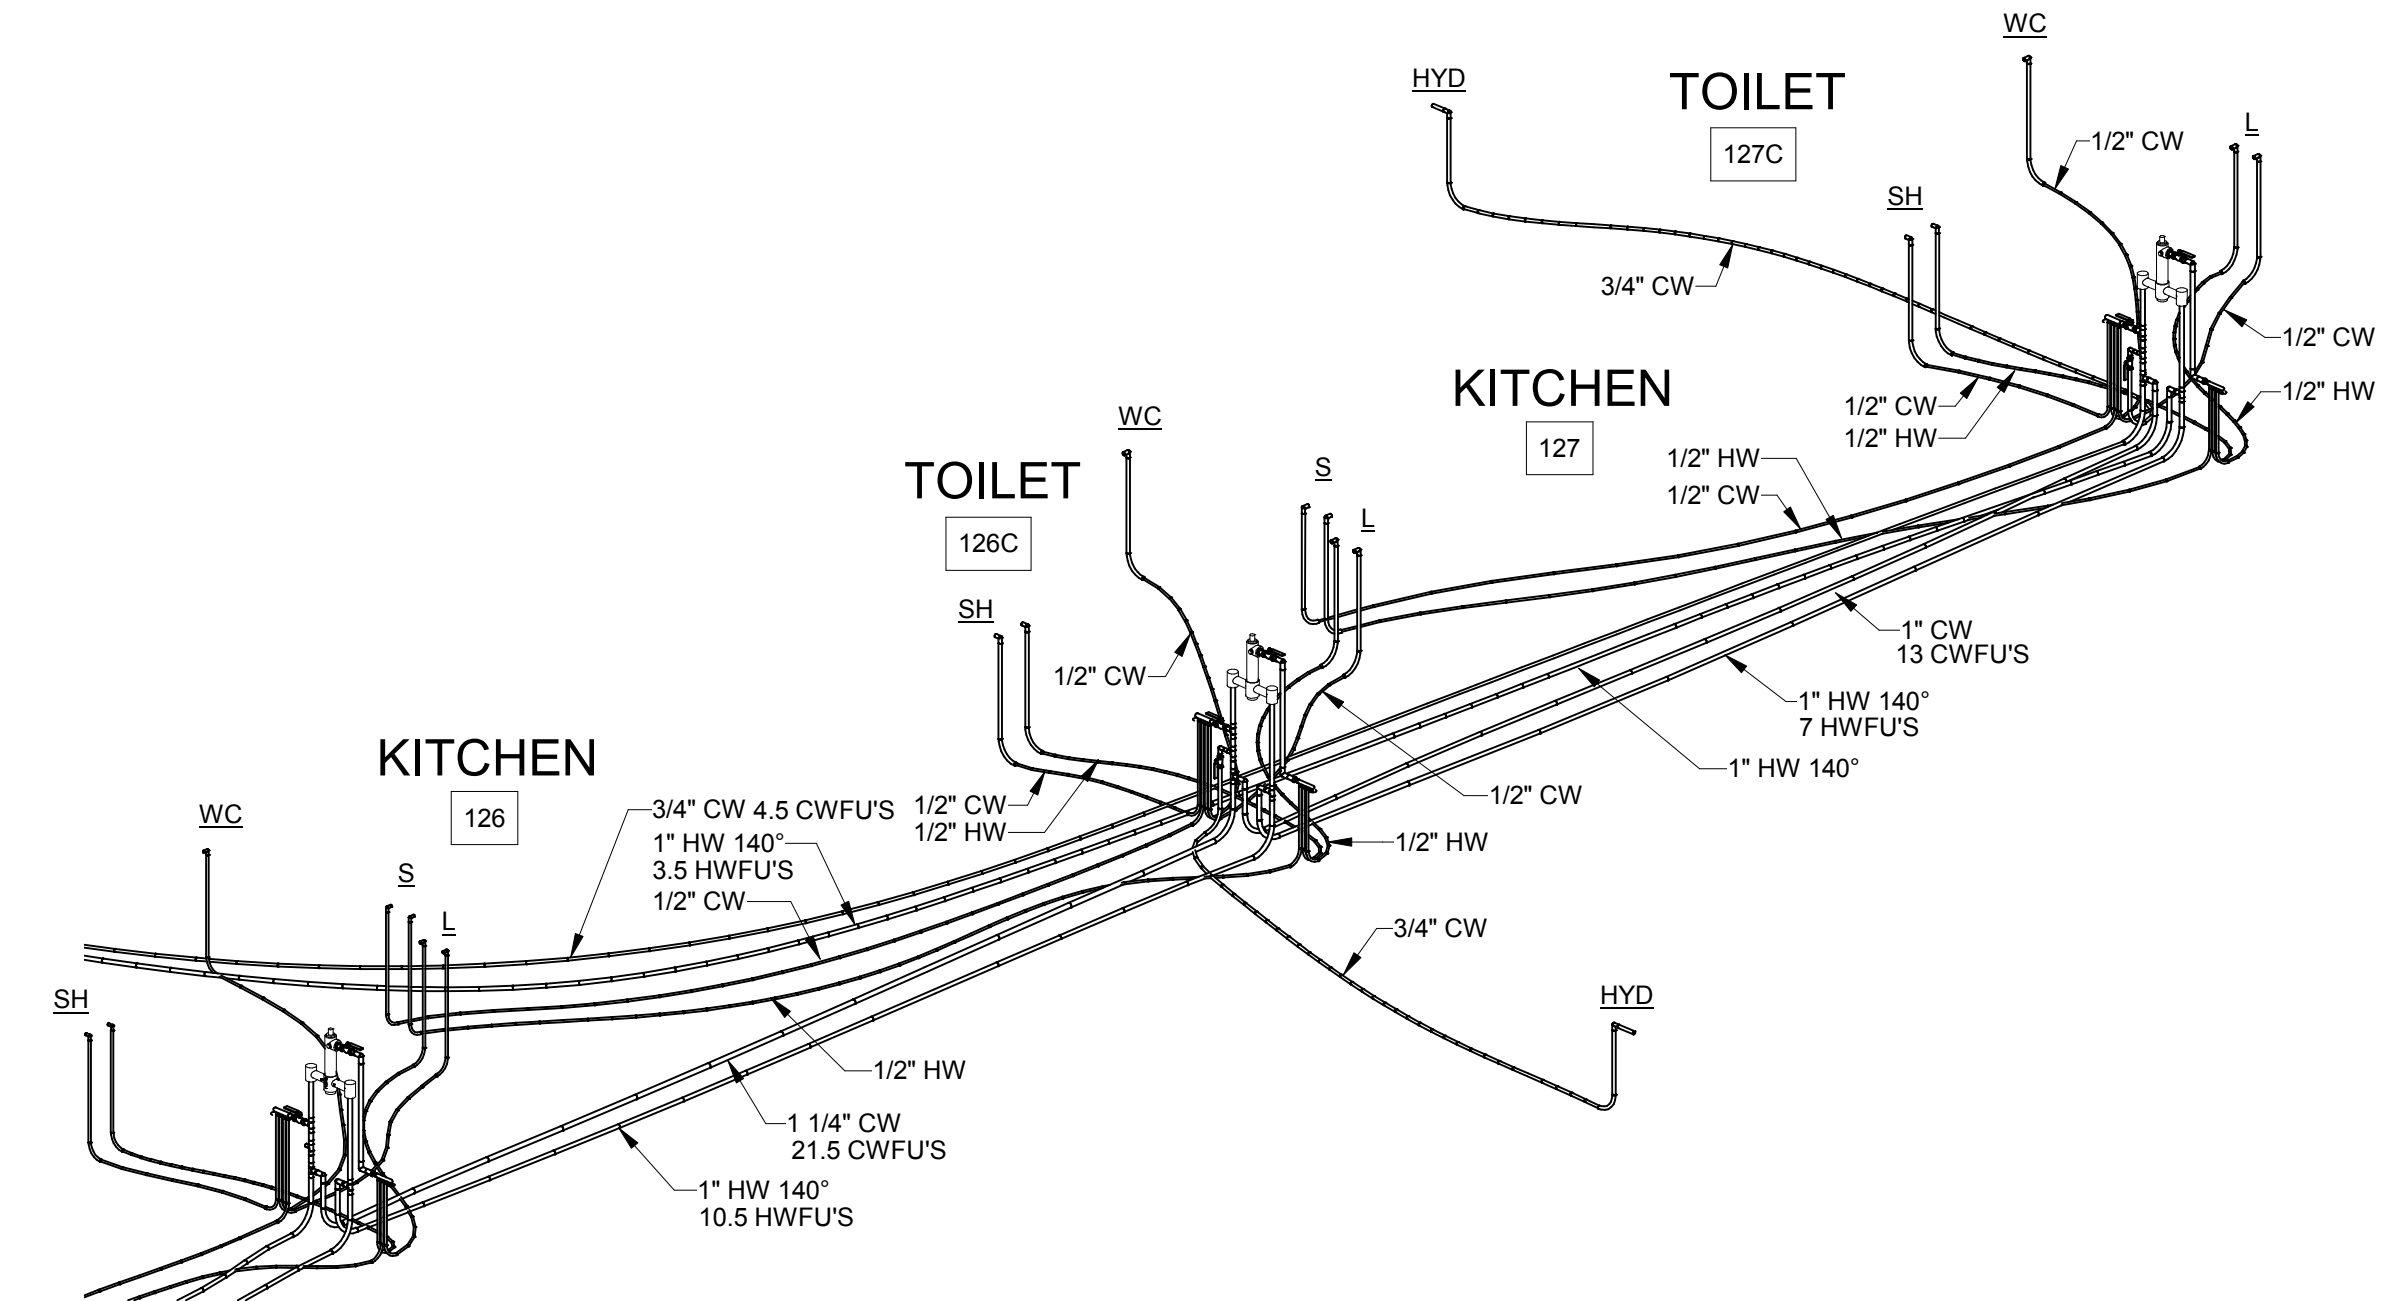

2 DOMESTIC WATER RISER DIAGRAM - ALTERNATE

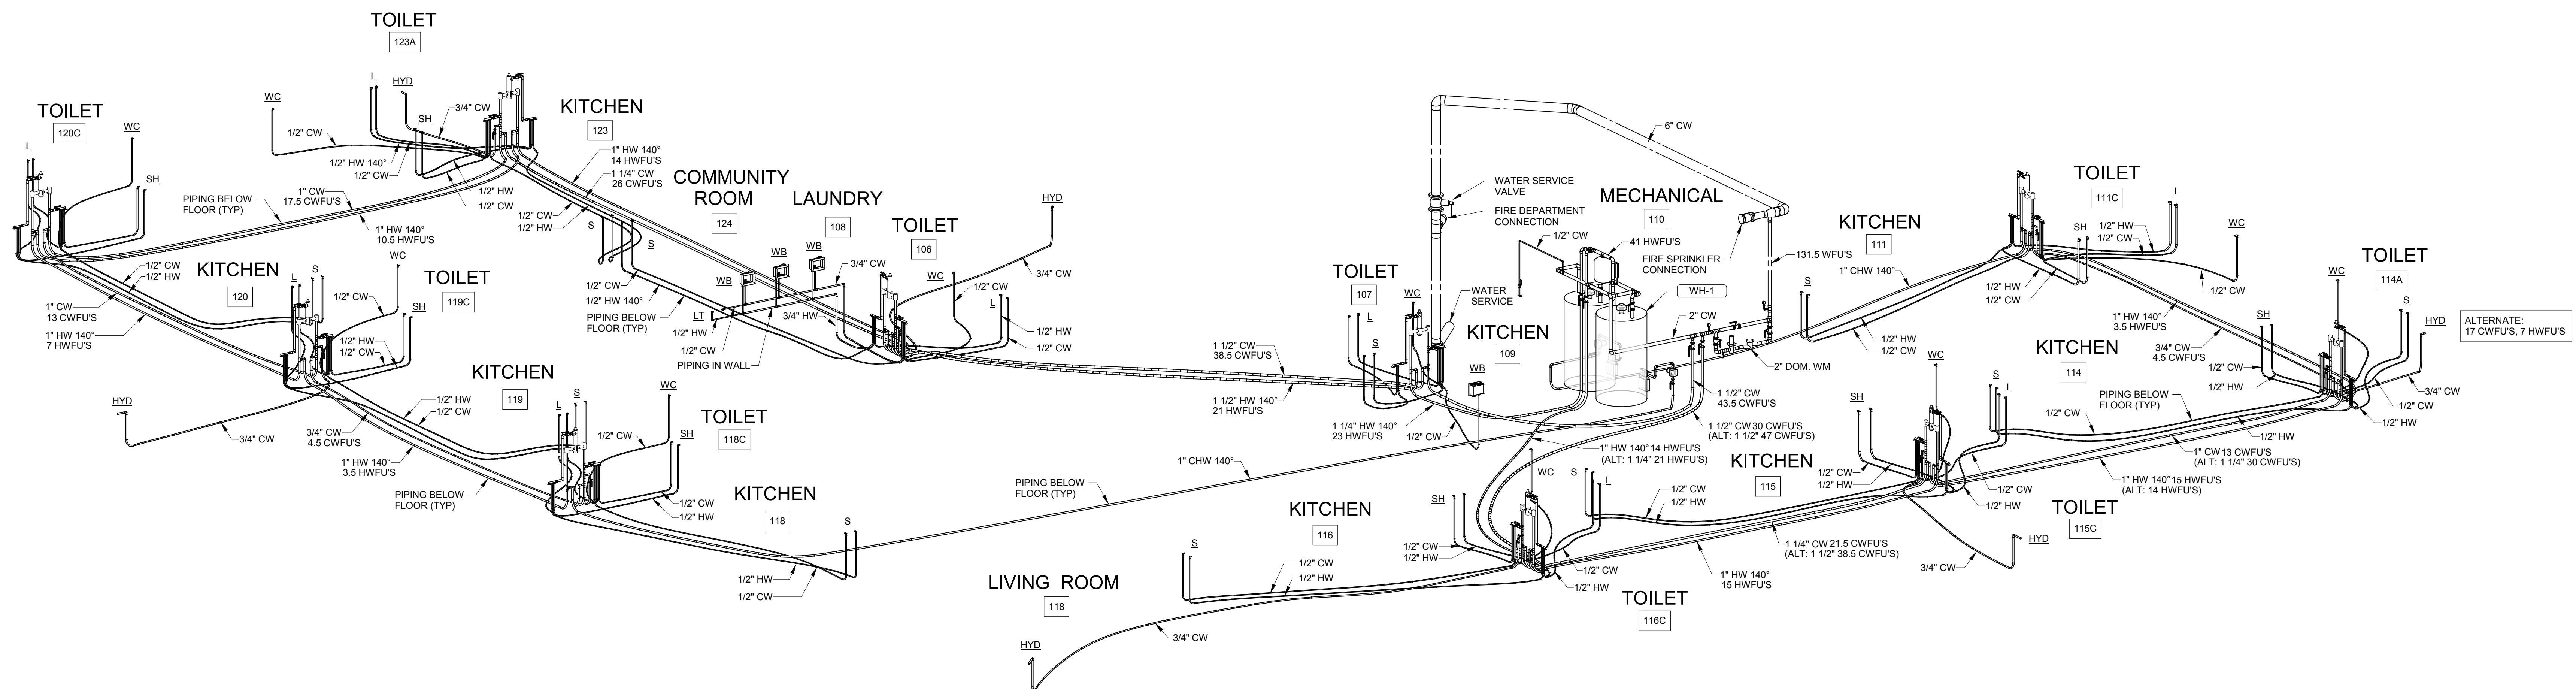

1 DOMESTIC WATER RISER DIAGRAM

Project Title:
**HO-CHUNK NATION
INDEPENDENT LIVING FACILITY**

Project Location:
**BRANCHED ANTLER AVE.
BLACK RIVER FALLS, WI 54615**

Sheet Title:
WATER RISER DIAGRAMS

HSR Project Number:
15027

Project Date:
FEBRUARY 2018

Drawn By:
RGJ/MSG

Key Plan:

ALTERNATE:
17 CWFUS, 7 HWFUS

No.	Description	Date
A1	Addendum #1	2/16/2018

Graphic Scale:
VARIES

Last Update:
2/16/2018 10:59:17 AM

P201