

**DOCUMENT 00 90 00
ADDENDUM**

ADDENDUM NO. [5] Date: March 1, 2018

**RE: HO-CHUNK NATION
 INDEPENDENT LIVING FACILITY
 BRANCHED ANTLER AVE
 BLACK RIVER FALLS, WISCONSIN 54615
 HSR PROJECT NO. 15027**

**FROM: HSR Associates, Inc
 100 Milwaukee Street
 La Crosse, WI 54603
 (608) 784-1830**

To: Prospective Bidders

This addendum forms a part of the Contract Documents and modifies the original Bidding Documents dated February 2018. Acknowledge receipt of this Addendum in the space provided on the bid form. Failure to do so may subject the Bidder to disqualification.

This Addendum consists of [1] page, and [5] 30 x 42 drawings

CHANGES TO DRAWINGS


1. Sheet P001R1 PLUMBING GENERAL NOTES 30 x 42 attached hereto
 - a. Revisions clouded on Drawing.
2. Sheet P101R1 UNDERFLOOR PLAN SEGMENT A 30 x 42 attached hereto
 - a. Revisions clouded on Drawing.
3. Sheet P102R1 UNDERFLOOR PLAN SEGMENT B 30 x 42 attached hereto
 - a. Revisions clouded on Drawing.
4. Sheet P103R1 UNDERFLOOR PLAN ALTERNATE 30 x 42 attached hereto
 - a. Revisions clouded on Drawing.
5. Sheet P201R WATER RISER DIAGRAMS 30 x 42 attached hereto
 - a. Revisions clouded on Drawing.

PRIOR APPROVALS


1. Section 08 54 13 Fiberglass Windows and French Door: Pella Fiberglass Windows and Fiberglass Door.

END OF DOCUMENT 00 90 00

Page Intentionally Left Blank

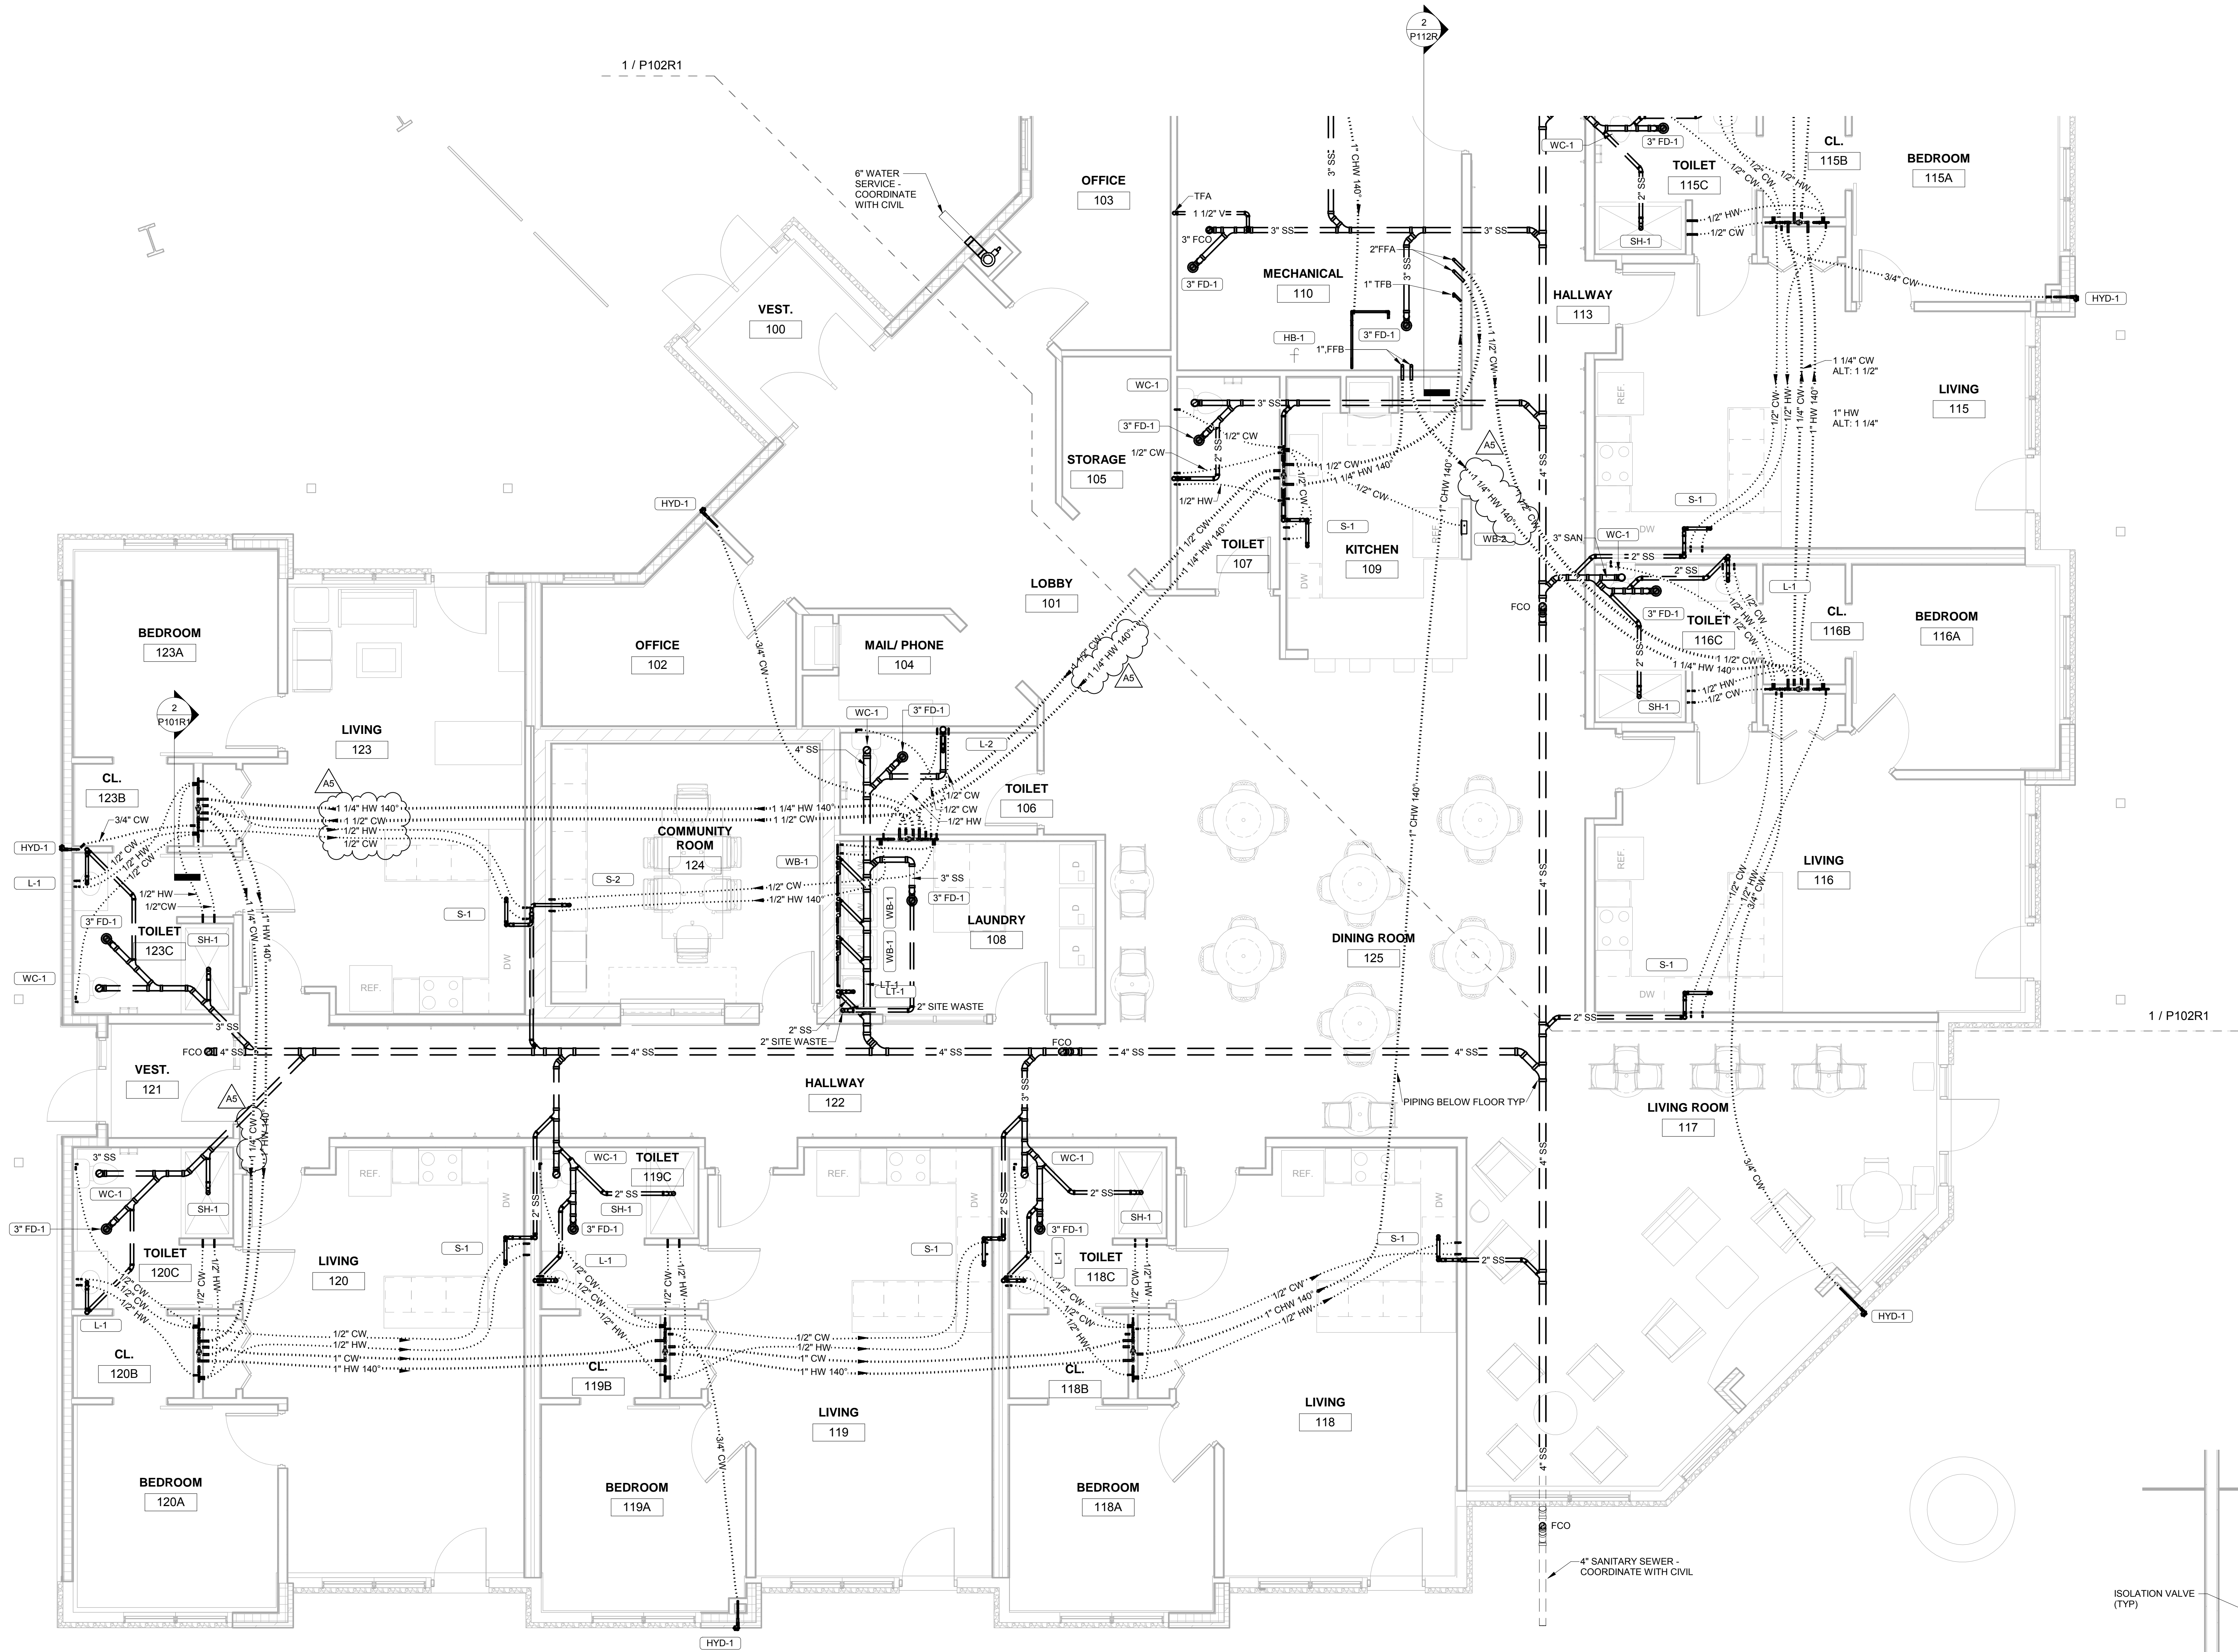

1 UNDERFLOOR PLAN - SEGMENT A
1/4" = 1'-0"

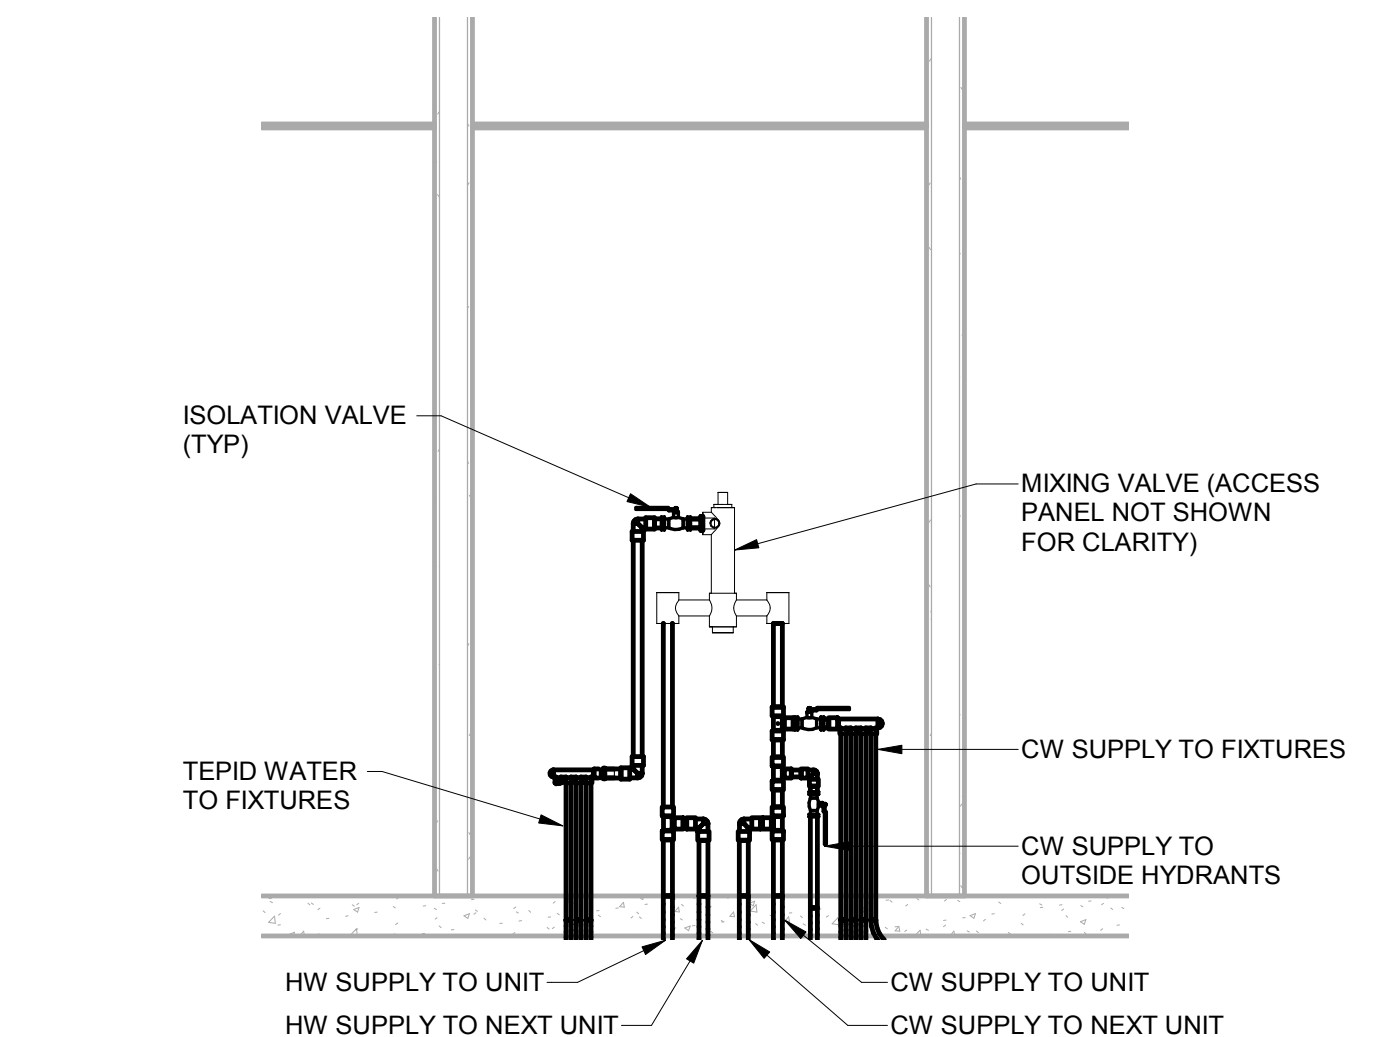

2 TYPICAL MANIFOLD DETAIL
1/2" = 1'-0"

**HO-CHUNK NATION
INDEPENDENT LIVING FACILITY
UNDERFLOOR PLAN SEGMENT A**

Project Title:
Project Location: BRANCHED ANTLER AVE., BLACK RIVER FALLS, WI 54615

HSR Project Number: 15027

Project Date: FEBRUARY 2018

Drawn By: RGJ/MSG

Key Plan:


No.	Description	Date
A1	Addendum #1	2/16/2018
A5	Addendum #5	3/1/2018

Graphic Scale: VARIES

Last Update: 2/28/2018 9:34:55 AM



Consultant:

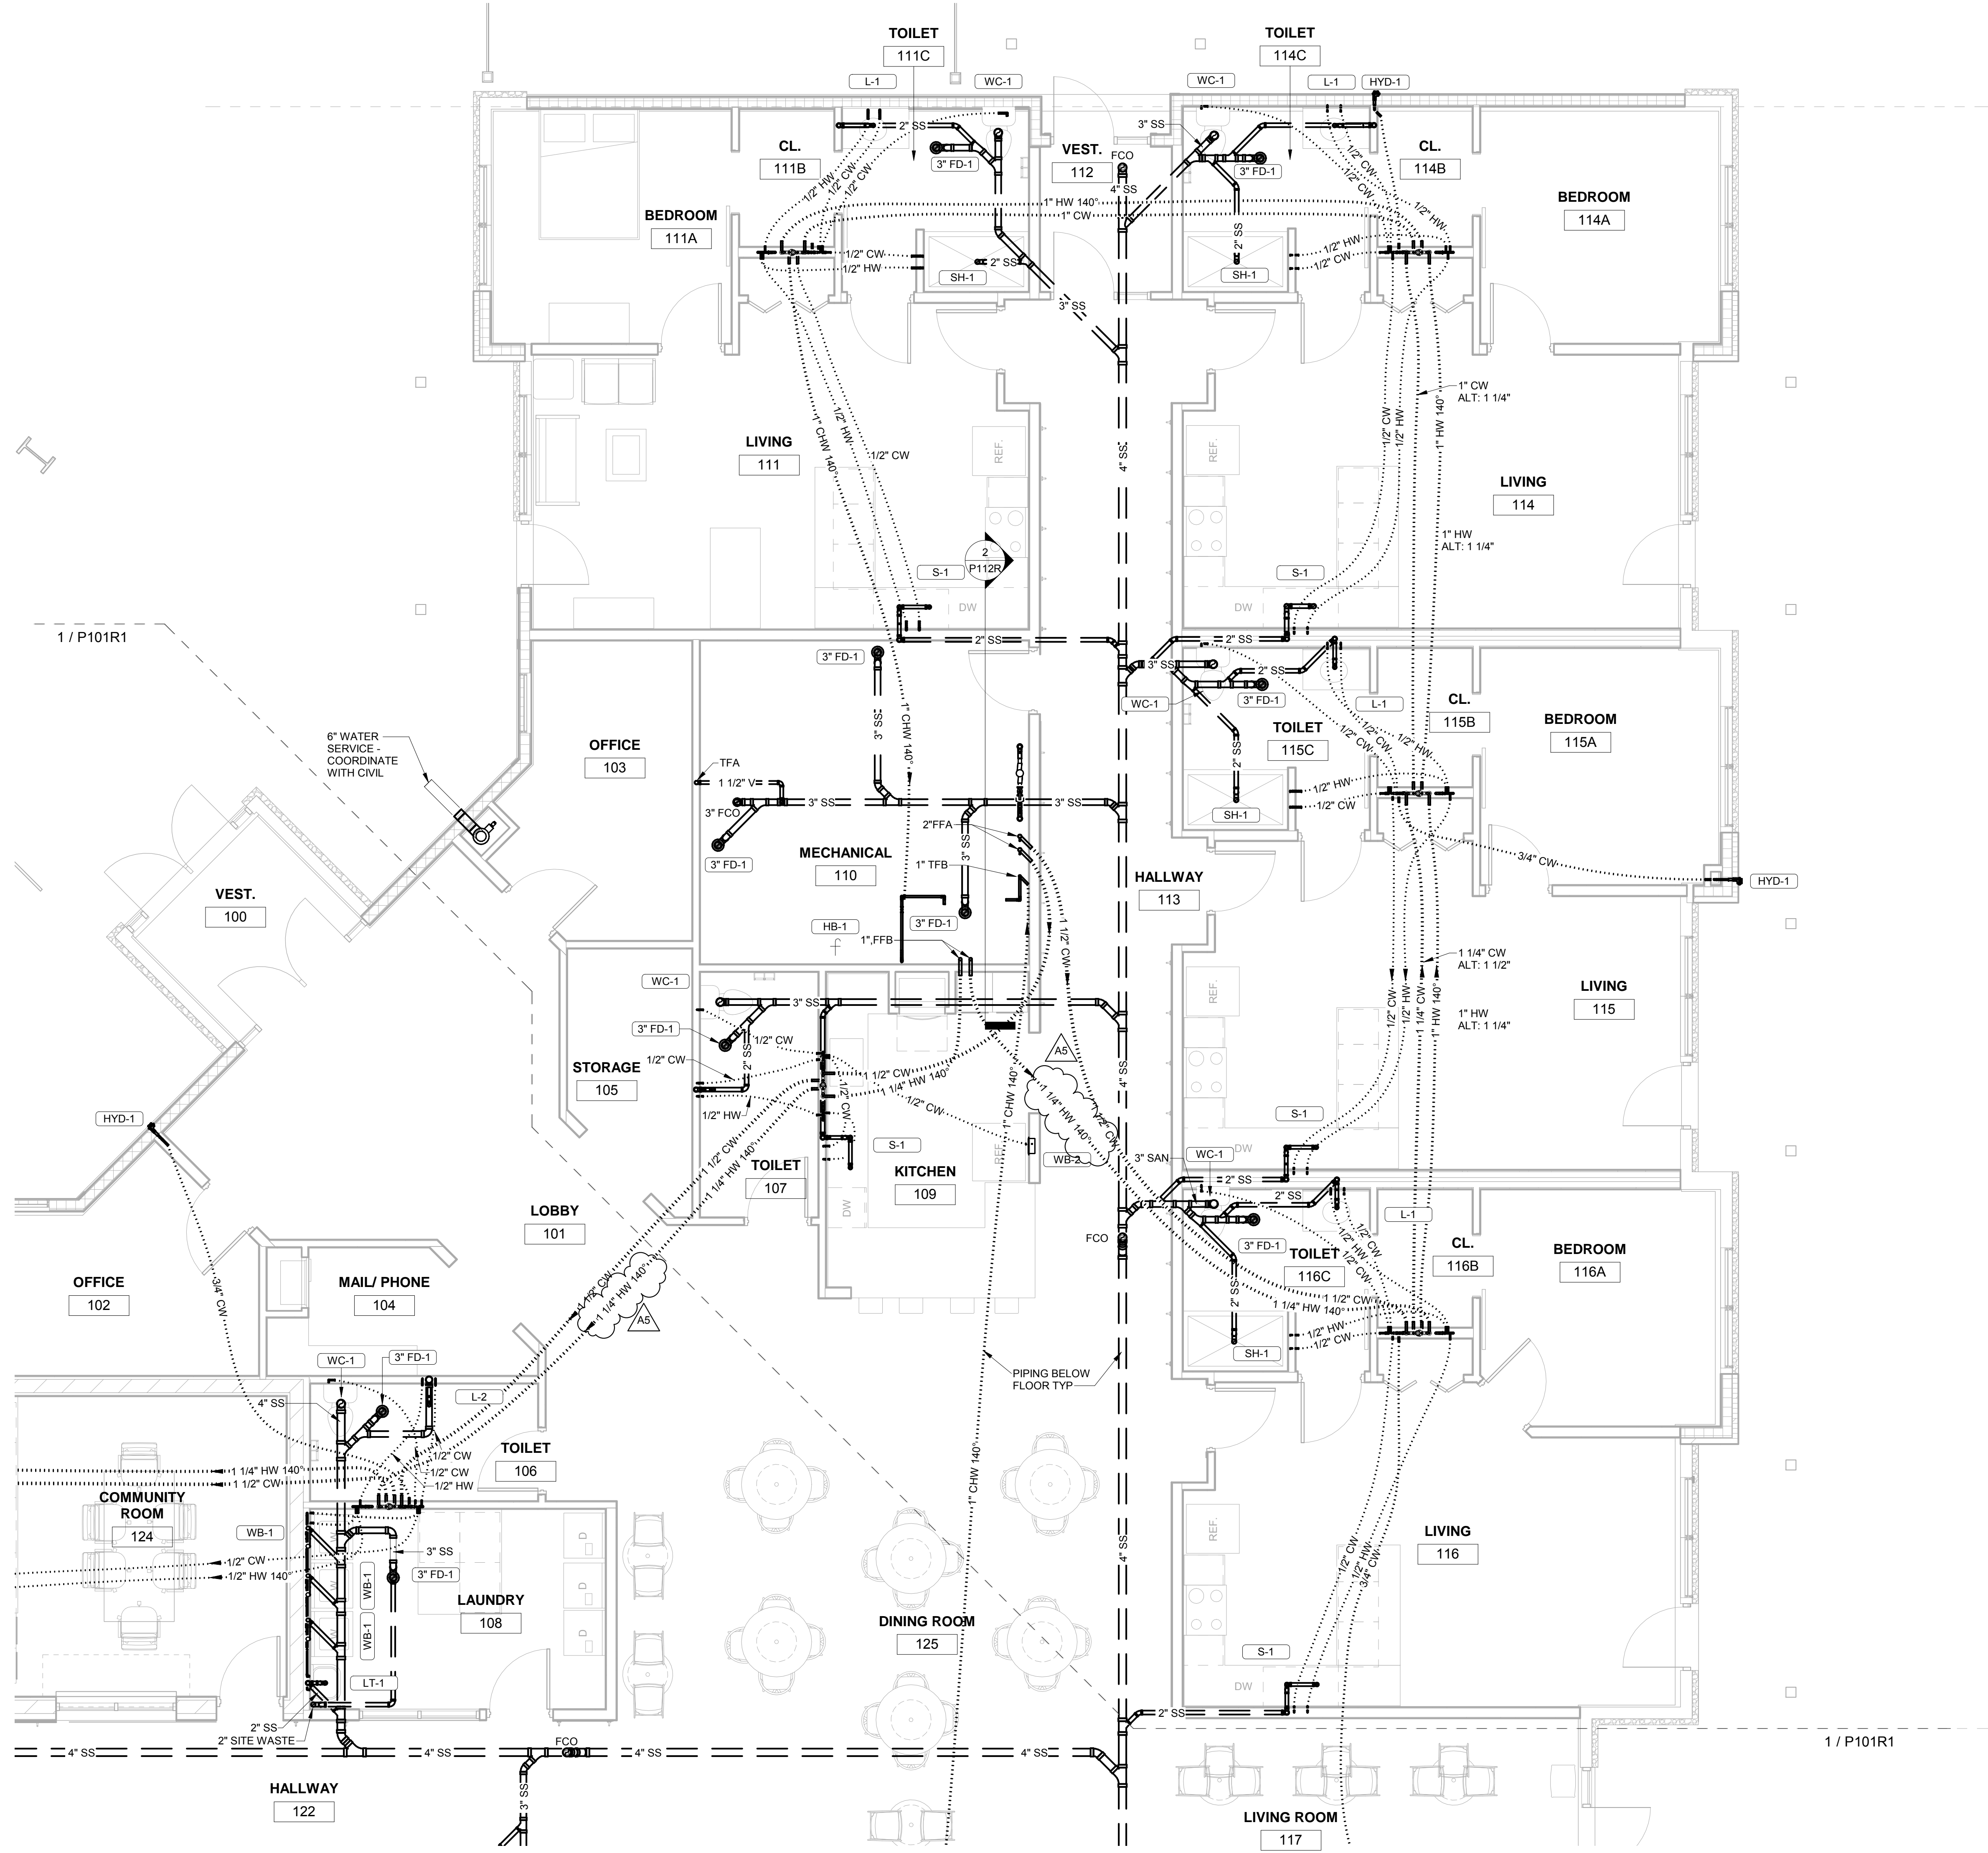

HO-CHUNK NATION
INDEPENDENT LIVING FACILITY
UNDERFLOOR PLAN SEGMENT B

Project Title: HO-CHUNK NATION INDEPENDENT LIVING FACILITY
Project Location: BRANCHED ANTLER AVE., BLACK RIVER FALLS, WI 54615

HSR Project Number: 15027

Project Date: FEBRUARY 2018

Drawn By: RGJ/MSG

Key Plan:

No.	Description	Date
A1	Addendum #1	2/16/2018
A5	Addendum #5	3/1/2018

Graphic Scale: VARIES

Last Update: 2/28/2018 9:35:08 AM

1 UNDERFLOOR PLAN - SEGMENT B
1/4" = 1'-0"

P102R1



Consultant:

Project Title: **HO-CHUNK NATION
INDEPENDENT LIVING FACILITY**
Project Location: **BRANCHED ANTLER AVE.
BLACK RIVER FALLS, WI 54615**
Sheet Title: **UNDERFLOOR PLAN - ALTERNATE**

HSR Project Number: **15027**

Project Date: **FEBRUARY 2018**

Drawn By: **RGJ/MSG**


Key Plan:

No.	Description	Date
A1	Addendum #1	2/16/2018
A5	Addendum #5	3/1/2018


Graphic Scale: **VARIES**

Last Update: **2/28/2018 9:35:14 AM**

P103R1

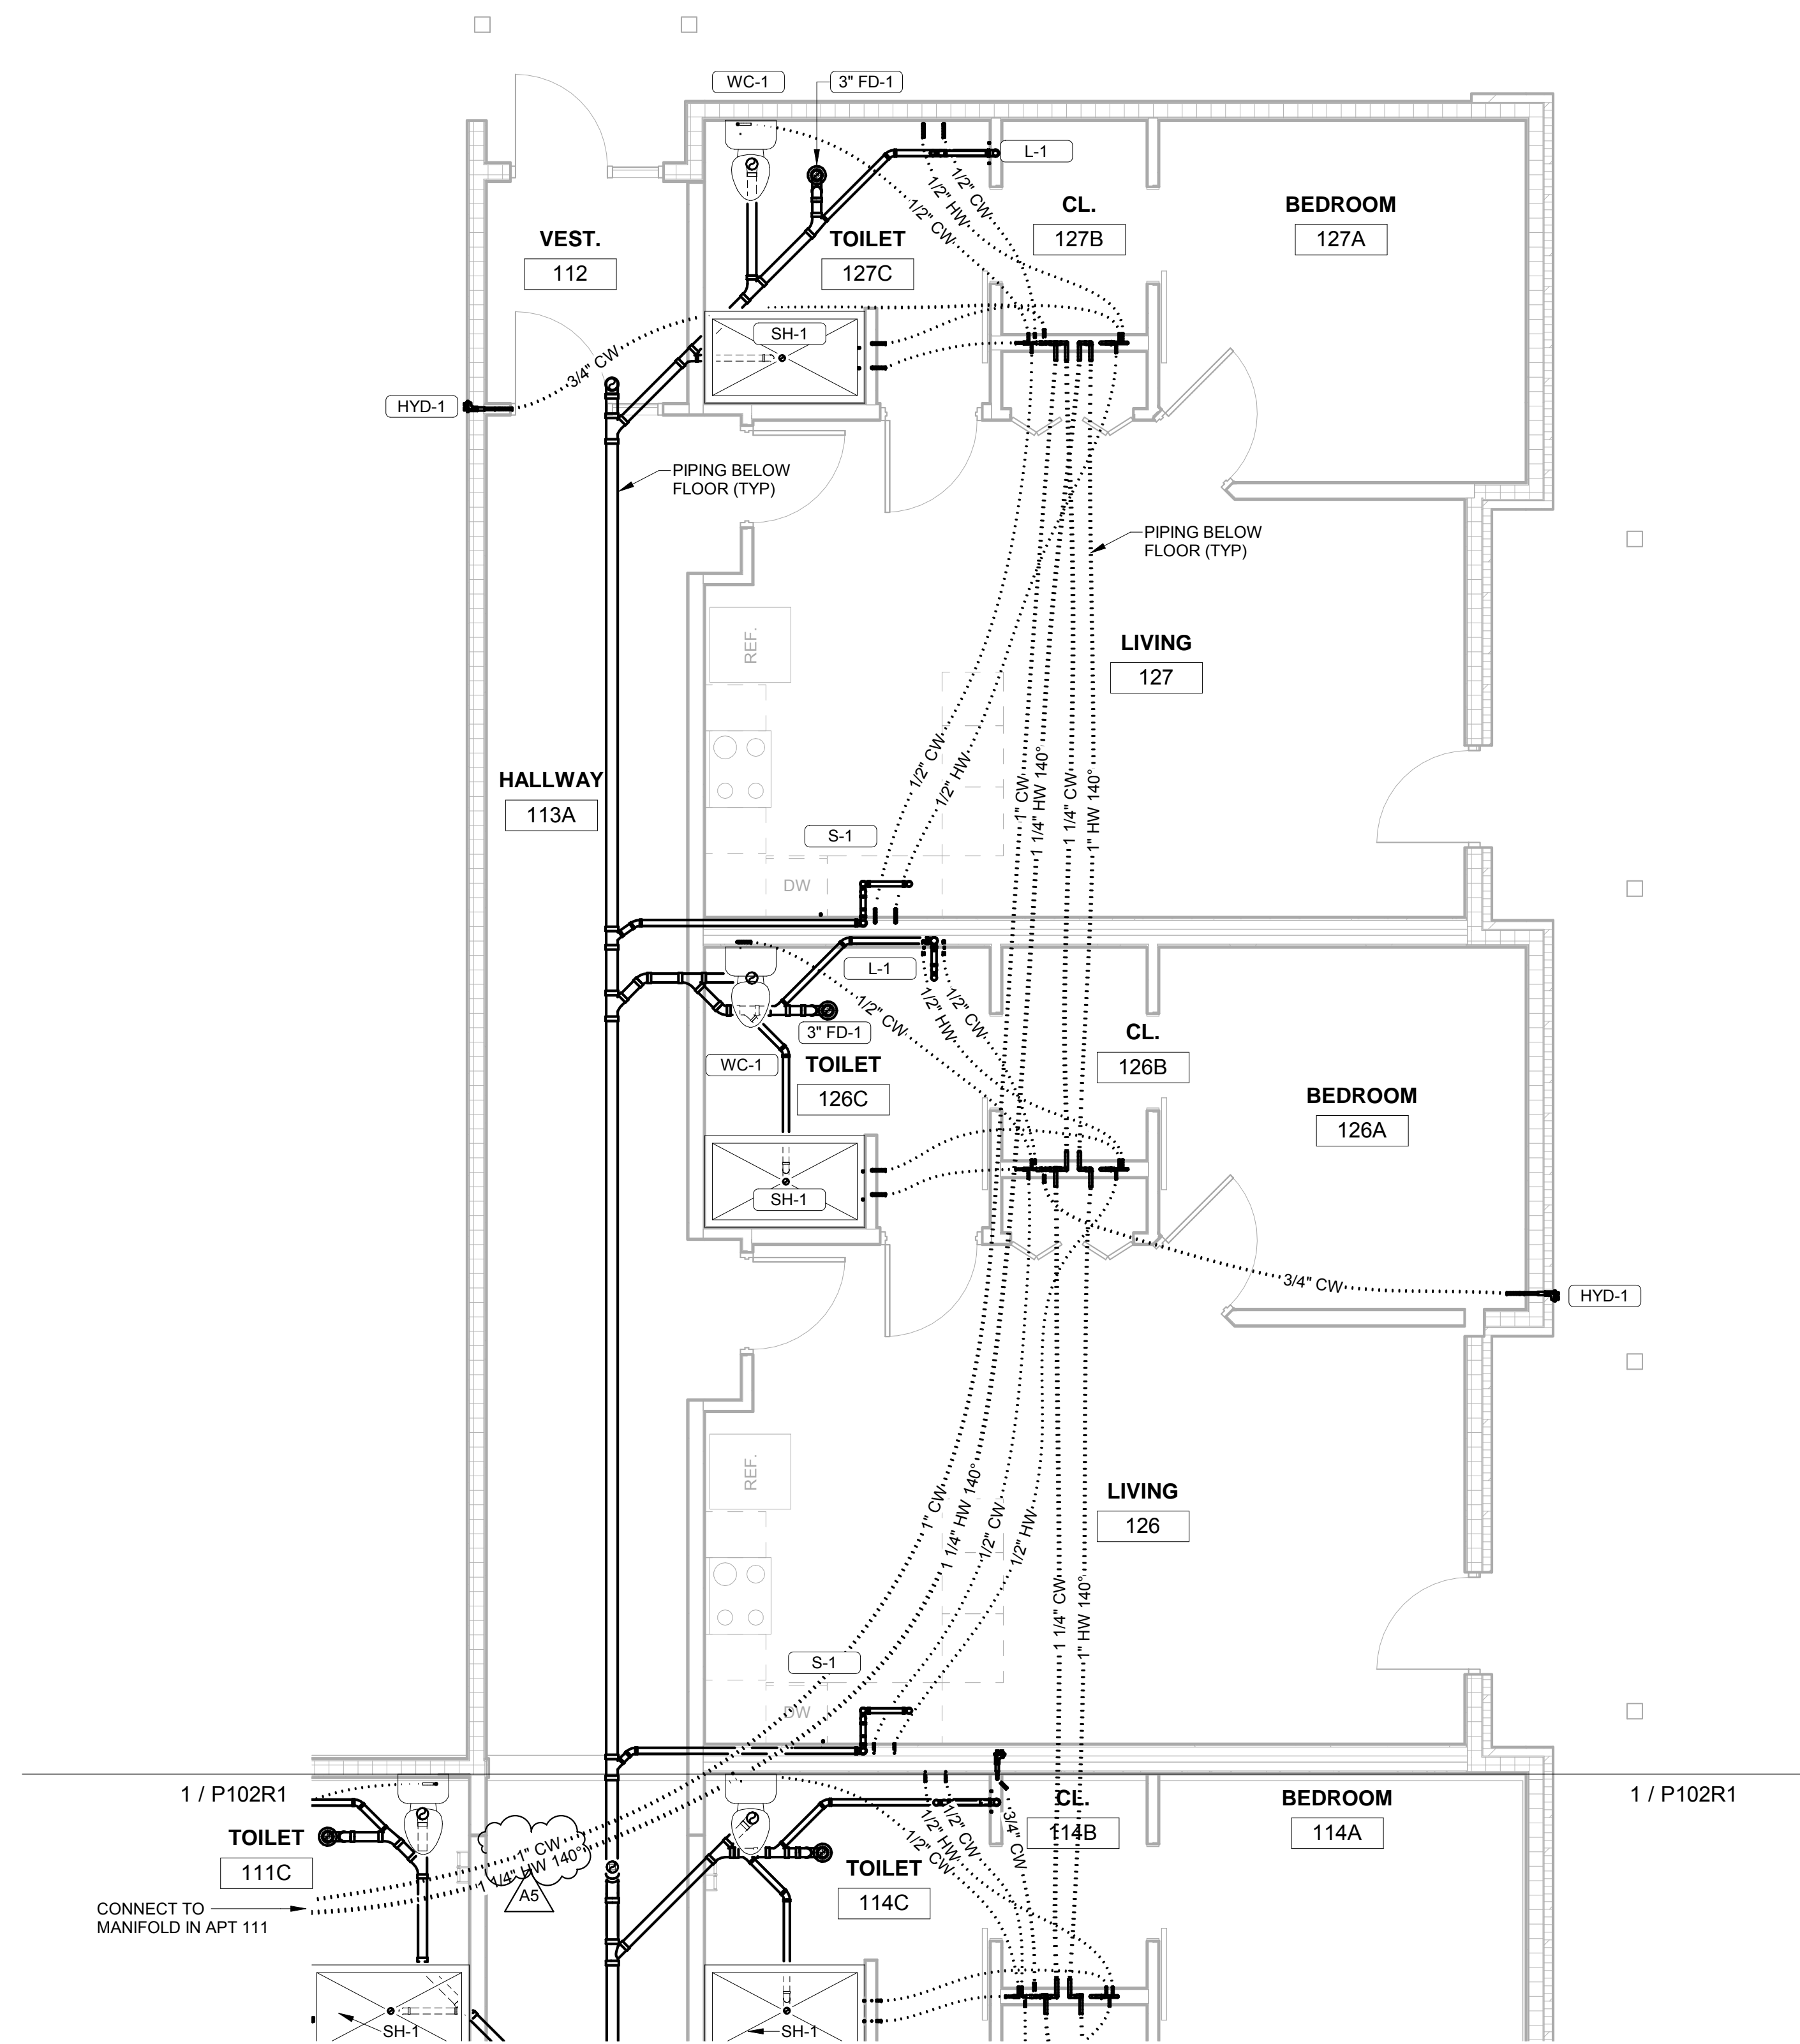


1 UNDERFLOOR REMODEL - ALTERNATE
1/4" = 1'-0"

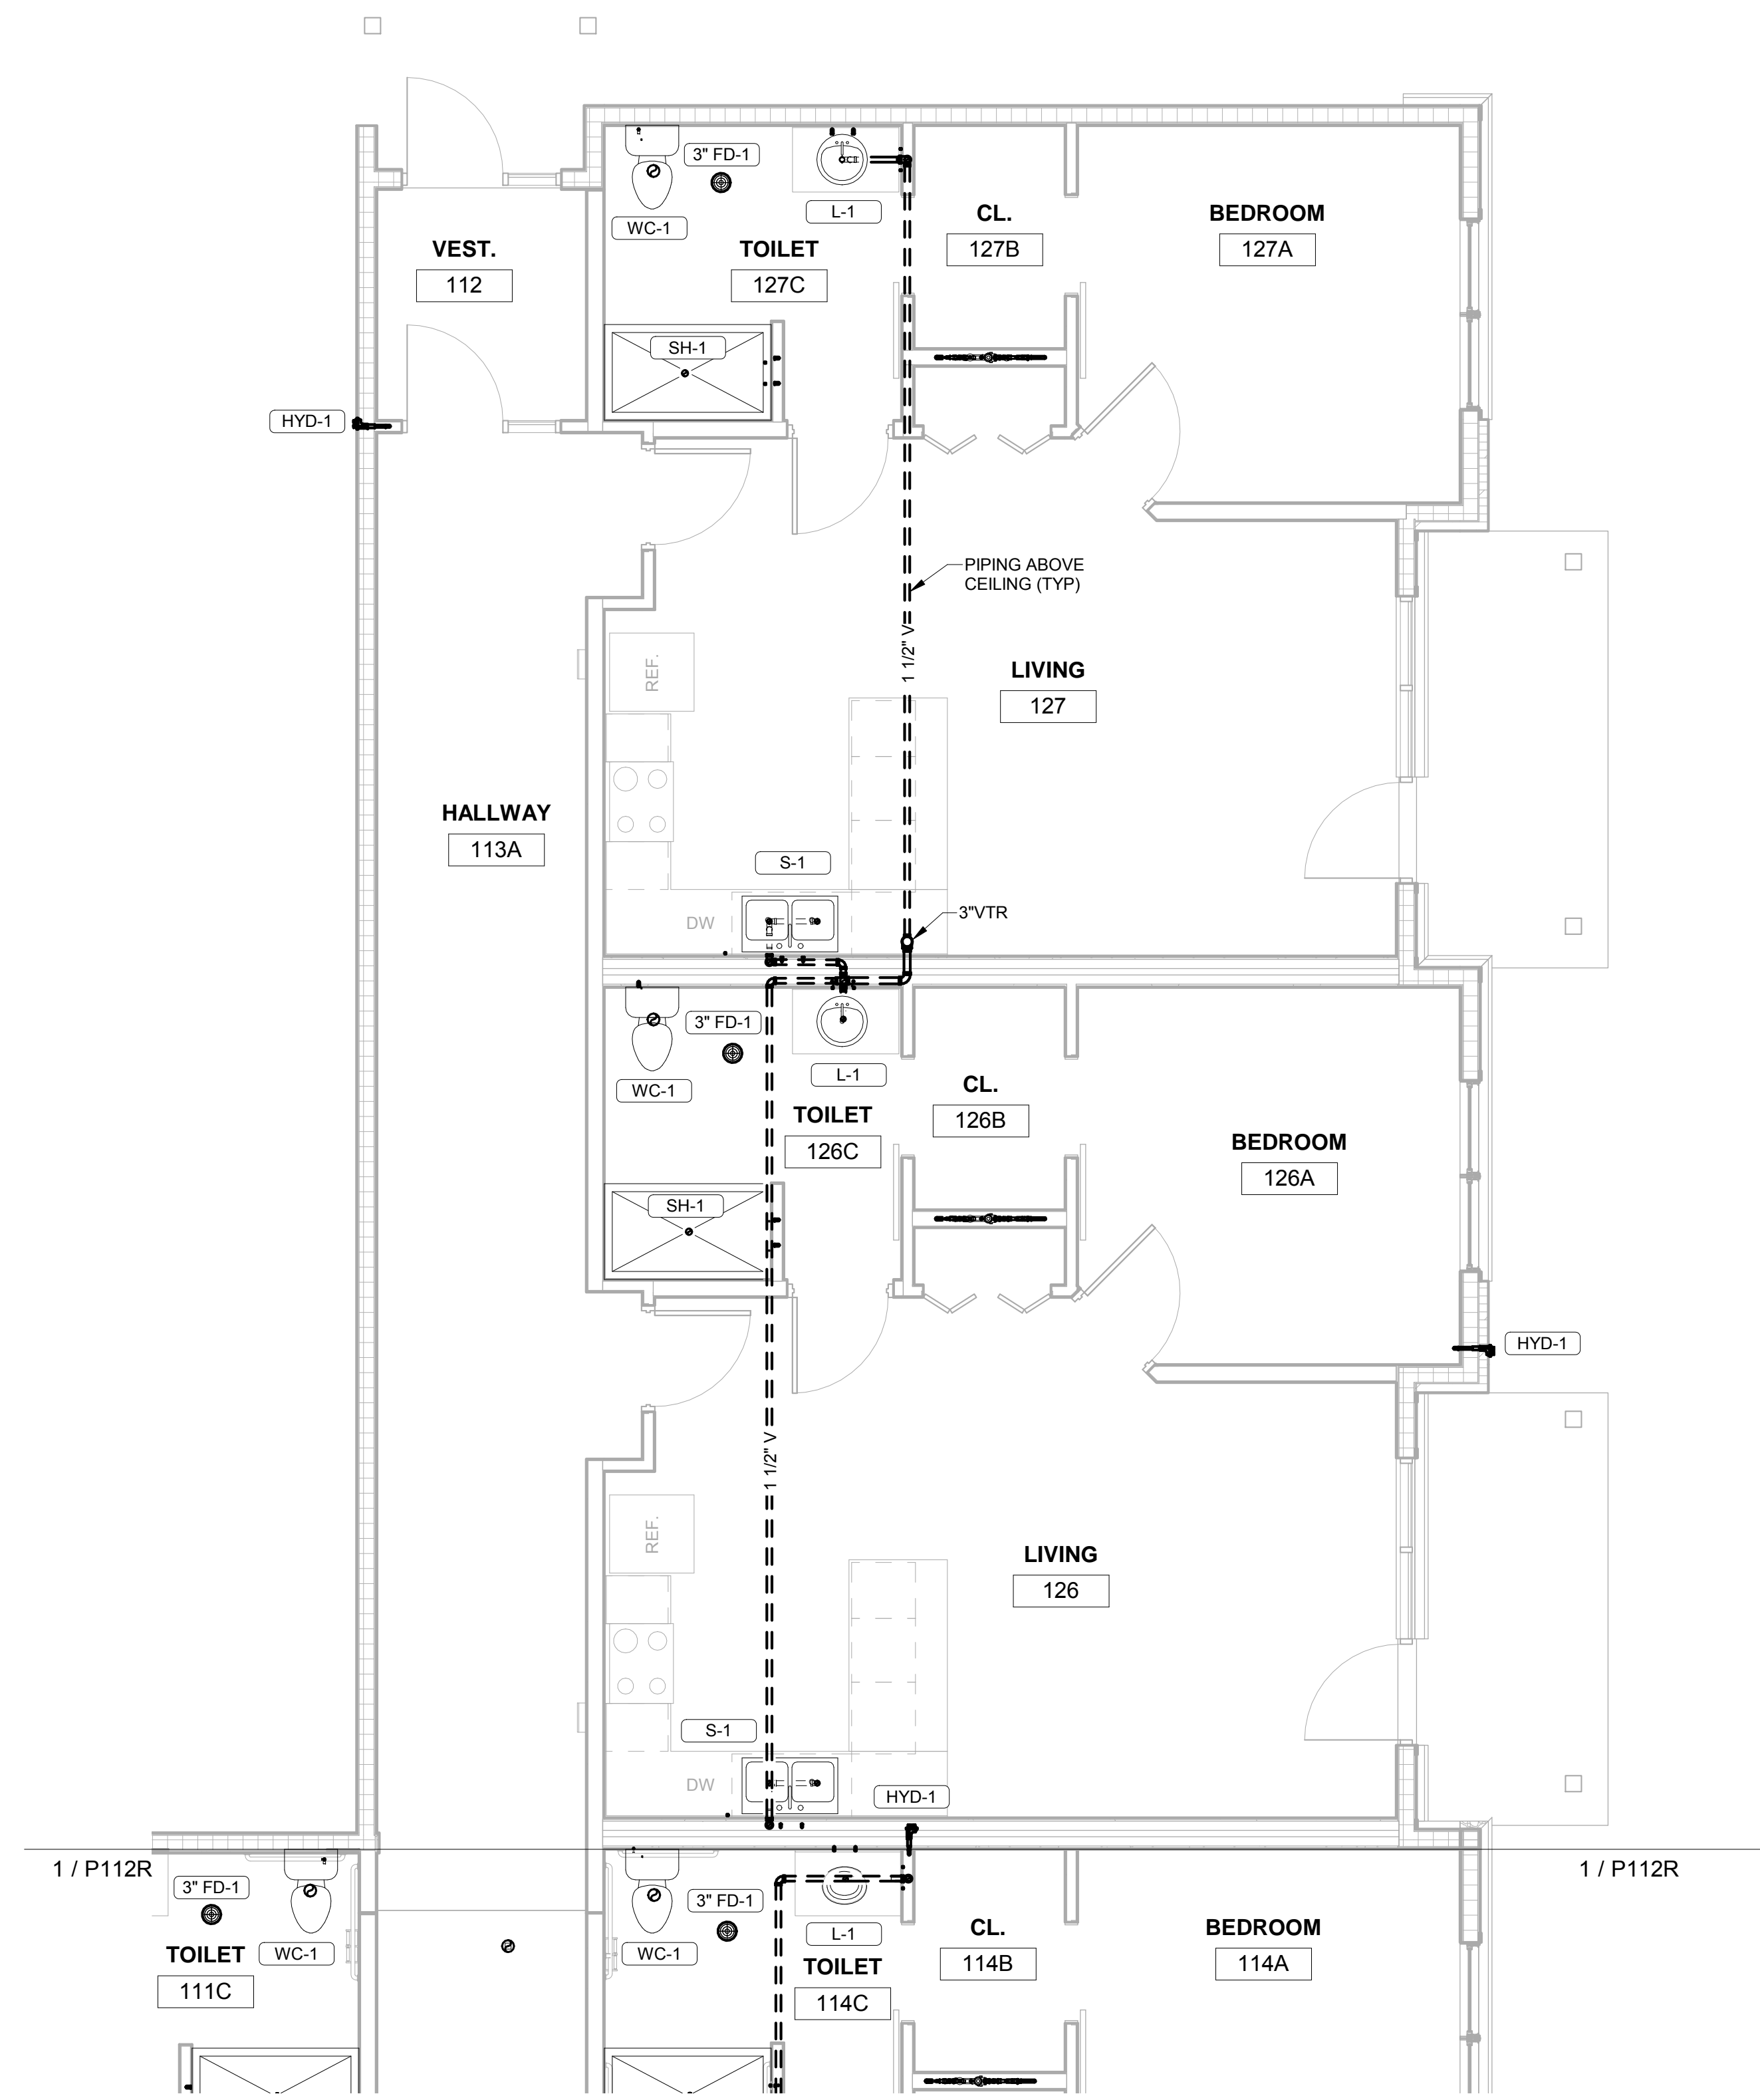


2 FIRST FLOOR REMODEL - ALTERNATE
1/4" = 1'-0"



Consultant:

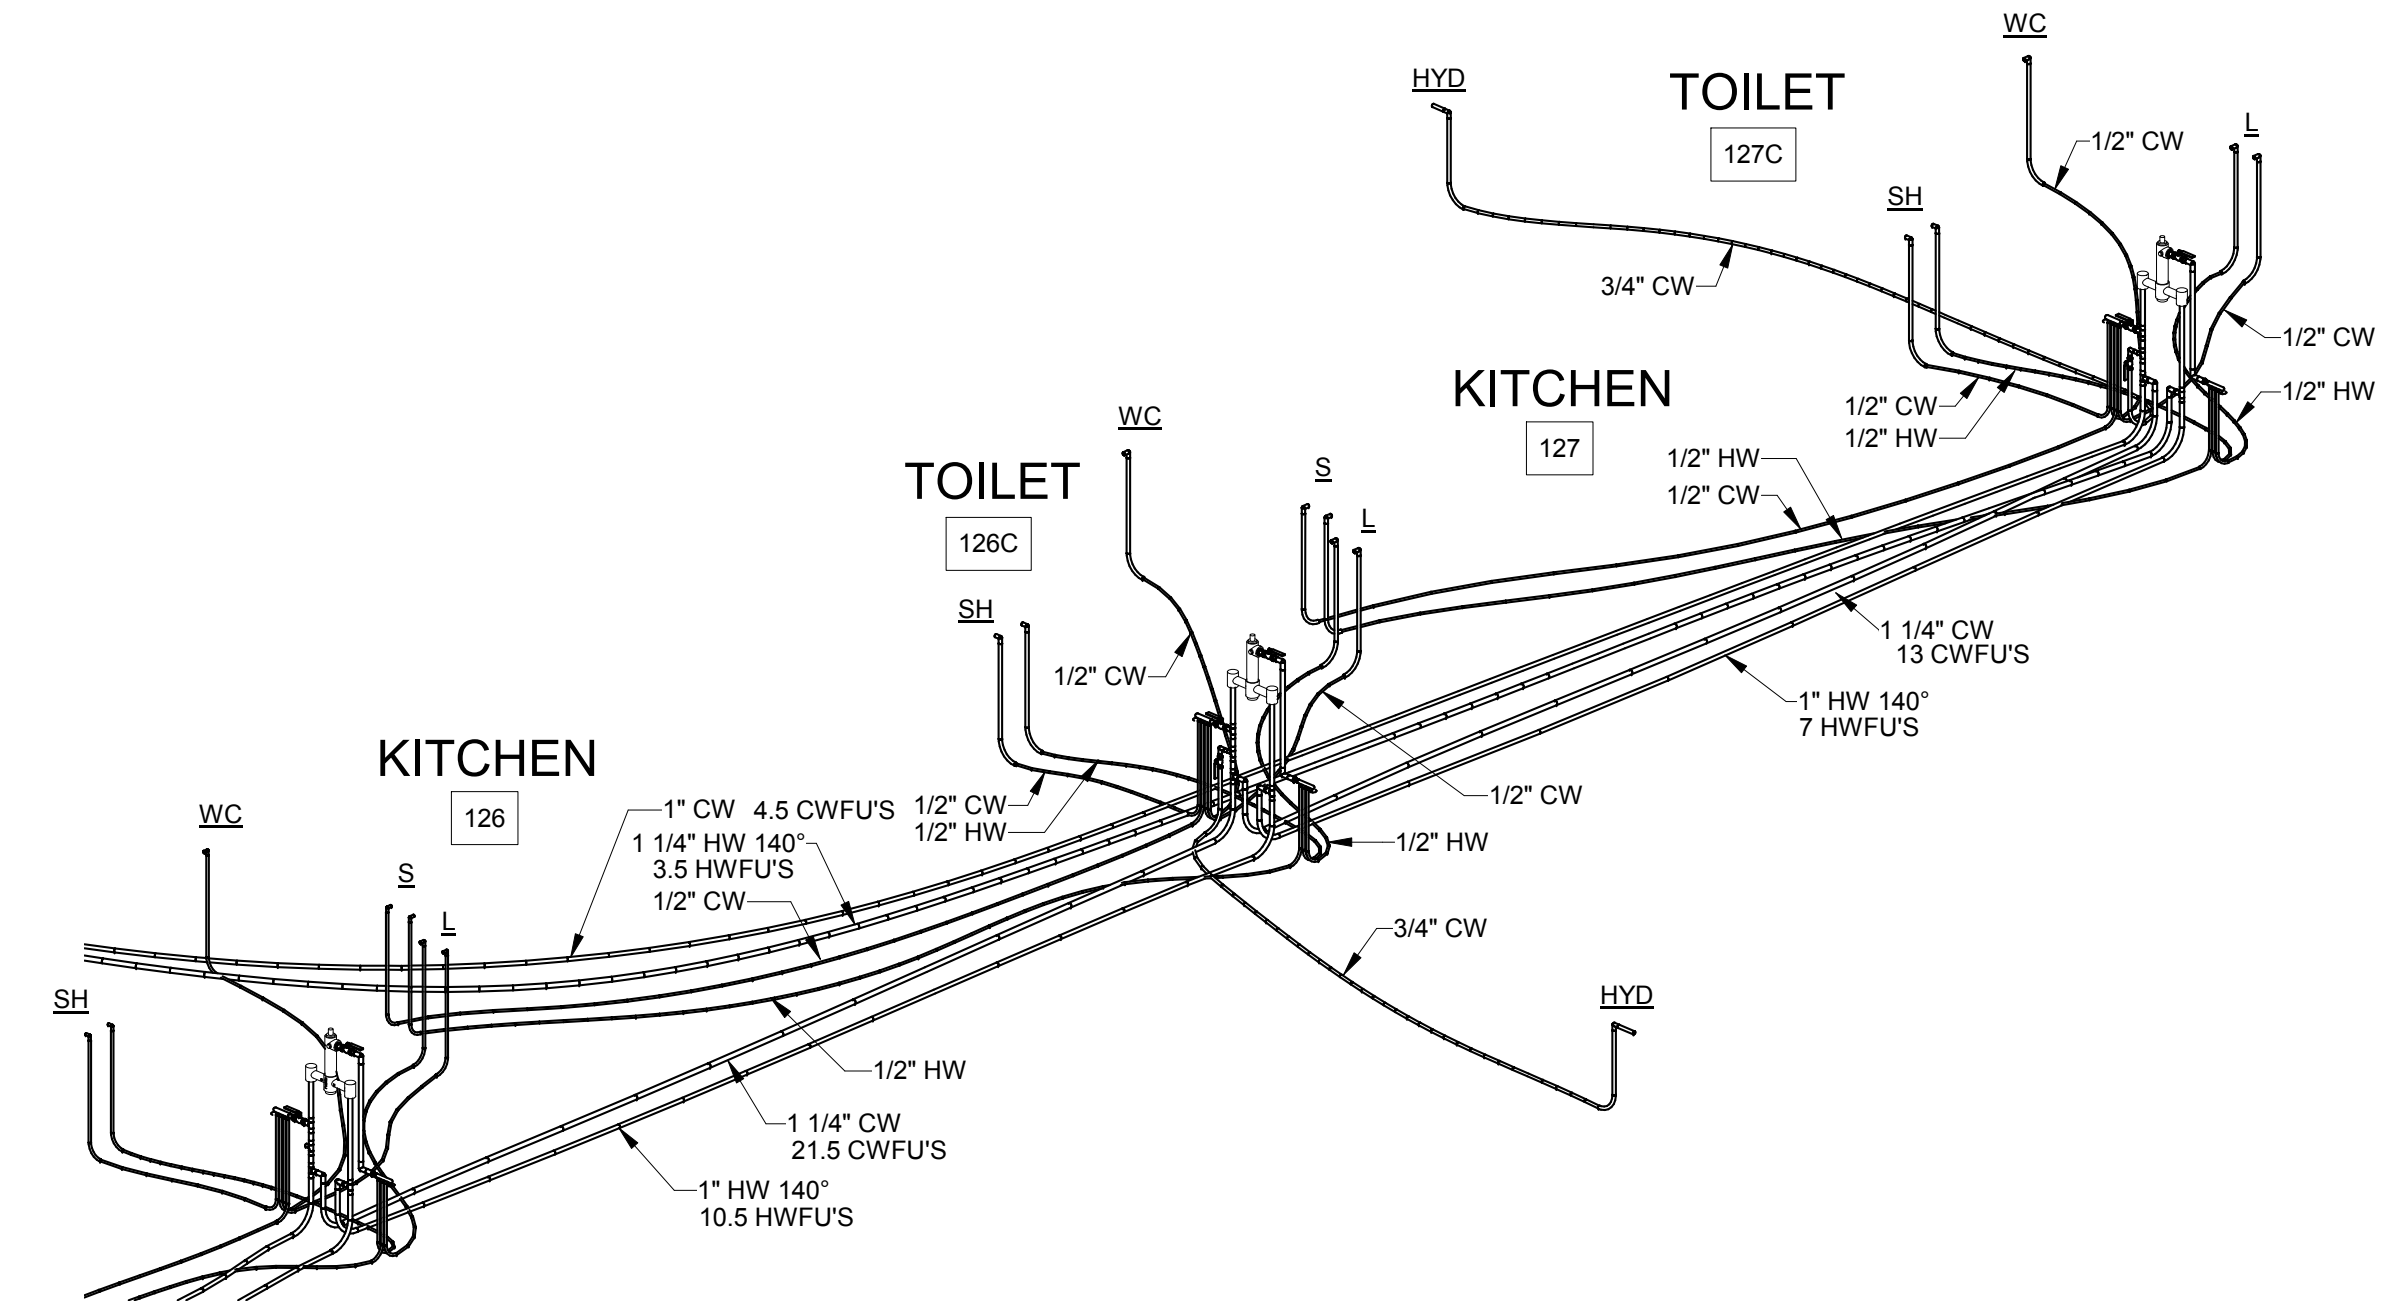

2 DOMESTIC WATER RISER DIAGRAM - ALTERNATE

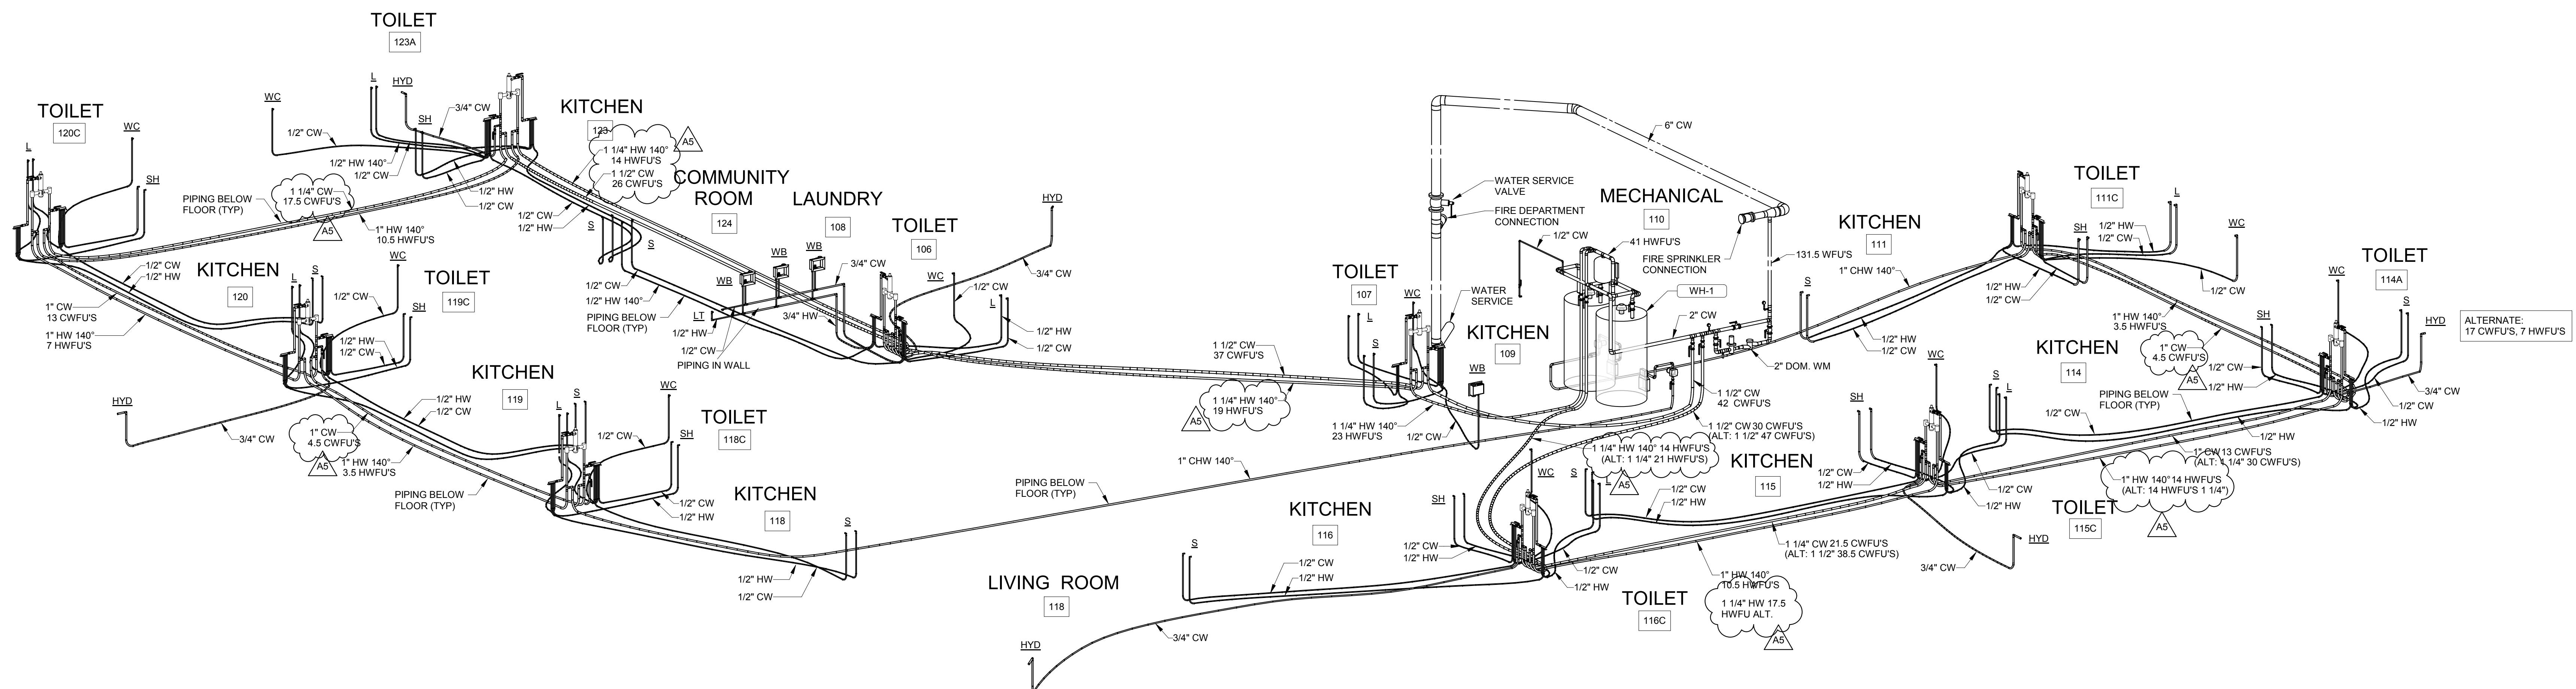

1 DOMESTIC WATER RISER DIAGRAM

HO-CHUNK NATION
INDEPENDENT LIVING FACILITY

BRANCHED ANTLER AVE.
BLACK RIVER FALLS, WI 54615

WATER RISER DIAGRAMS

Project Title: HSR Project Number: 15027

Project Date: FEBRUARY 2018

Drawn By: RGJ/MSG

Key Plan:

Key Plan:

No.	Description	Date
A1	Addendum #1	2/16/2018
A5	Addendum #5	3/1/2018

Graphic Scale: VARIES

Last Update: 2/28/2018 9:35:31 AM

P201R