

**DOCUMENT 00 90 00**  
**ADDENDUM**

**ADDENDUM NO. [2]                      Date: March 21, 2018**

**RE:                      EAU CLAIRE AREA SCHOOL DISTRICT  
McKINLEY CHARTER SCHOOL  
1266 McKINLEY RD  
EAU CLAIRE, WISCONSIN 54701  
HSR PROJECT NO. 17057**

**FROM:                  HSR Associates, Inc  
100 Milwaukee Street  
La Crosse, WI 54603  
(608) 784-1830**

**To:                      Prospective Bidders**

This addendum forms a part of the Contract Documents and modifies the original Bidding Documents dated March 2018. Acknowledge receipt of this Addendum in the space provided on the bid form. Failure to do so may subject the Bidder to disqualification.

This Addendum consists of [2] pages, Pre-bid attendance, and [9] 30 x 42 drawings.

1. Pre-bid attendance attached hereto.

**CHANGES TO PREVIOUS ADDENDUM: Addendum 1**

2. Sheet E001R ELECTRICAL SITE PLAN
  - a. Delete connection and branch circuit wiring to heat tape equipment connection.
3. Sheet E100R ELECTRICAL POWER PLAN
  - a. Classroom 109: Provide 120 volt branch circuit from Panel A to feed new exhaust fan PV4. Electrical to install speed controller furnished with unit

**CHANGES TO SPECIFICATIONS:**

4. Section 22 10 06 PLUMBING SPECIALTIES
  - a. At sink S-2, provide plaster trap per spec section 22 10 06

**CHANGES TO DRAWINGS**

5. C100R DEMOLITION PLAN 30 x 42 attached hereto
  - a. Revisions clouded on Drawing
6. C101R LAYOUT PLAN 30 x 42 attached hereto
  - a. Revisions clouded on Drawing
7. Sheet A090 REMOVAL PLAN 30 x 42 attached hereto
  - a. Revisions clouded on Drawing.
8. Sheet A100R1 FIRST FLOOR 30 x 42 attached hereto
  - a. Revisions clouded on Drawing.

9. Sheet A300 SECTIONS
  - a. 5 and 6A300: At roof ladders the pieces tying the top of the ladder back to the parapet shall be 2" x 3/8" flat stock, same as the side rails. Bend bottom legs 90°, minimum 3 inches to allow for securing to roof edge blocking. Refer to Section 05 50 00 for breakdown of ladder parts.
  
10. Sheet S110R FOUNDATION PLAN 30 x 42 attached hereto
  - a. Revisions clouded on Drawing
  
11. Sheet M090R MECHANICAL REMOVAL PLANS 30 x 42 attached hereto
  - a. Revisions clouded on Drawing
  
12. Sheet M100R MECHANICAL VENTILATION REMODEL PLAN 30 x 42 attached hereto
  - a. Revisions clouded on Drawing
  
13. Sheet M600R1 MECHANICAL SCHEDULES 30 x 42 attached hereto
  - a. Revisions clouded on Drawing.
  
14. Sheet E101R1 REVISED LIGHTING PLAN 30 x 42 attached hereto
  - a. Revisions clouded on Drawing.

**END OF DOCUMENT 00 90 00**

# "SIGN-IN" SHEET

PROJECT: Eau Claire School District-McKinley Charter School


HSR NO.: 17057 DATE: March 16, 2018



PLEASE PRINT ALL INFORMATION CLEARLY

NAME	COMPANY	E-MAIL ADDRESS	TELEPHONE
Wayne Brown	R.J. Jurowski	wayneb@rjjurowskiconstruction.com	(715) 226-2808
HOLLY KITCHELL	ECASD	HKITCHELL@ECASD.US	715-579-9500
Aaron VanHorn	bartingale Mechanical	aaronvanhorn@bartingalemech.com	715 894-7177
MARK JOHNSON	Roshell Electric	MARKJOHNSON@ROSHELLELECTRIC.COM	715 723-2881
LUCAS KRAMER	QUALITY ROOFING INC	LUCAS@QROOF.COM	715 384 8881
Jason Pelke	Pelke Plumbing	jason@pelkeplumbing.com	715 495-2756
Nick Schuch	Brick Bros	nschuch@bricklbros.com	608-769-9267
Brian Bejia	Certified Inc.	briamb@certified-plumbing-heating.com	715-834-5409
Troy Ellis	Hudson Electric	troy@hudsonelectric.com	715-723-3661
Jon Keiser	NETTEL COMM	Jon.Keiser@nettel.us	715-456-8295
Nic Sonderfoot	Miron Construction	estimating@miron-construction.com	715-598-5711
Travis Turawski	Northwest Roofing	nwroof@chibardun.net	715-924-3644
ERIC STOLP	M & J	estolp@market-johnson.com	715 577-2065
Jeremy Drake	M+J	jdrake@market-johnson.com	715-577-0836
Taylor Mathison	RTS Roofing	Taylor@RTS Roofing.com	715-832-1910
Andy Rosenbater	RTS Roofing, Inc.	andy@rtsroofing.com	715-832-1910
Russ Ryan	CERTIFIED INC	russ@certified-plumbing-heating.com	715-834-5409
Damian Prince	Chippewa Valley Excavating	chippewavalleyexcavating@bloomer.net	715-559-0443
Craig Schuebel	Hagen Decorators	craig@hagendecorators.com	715 579 6956




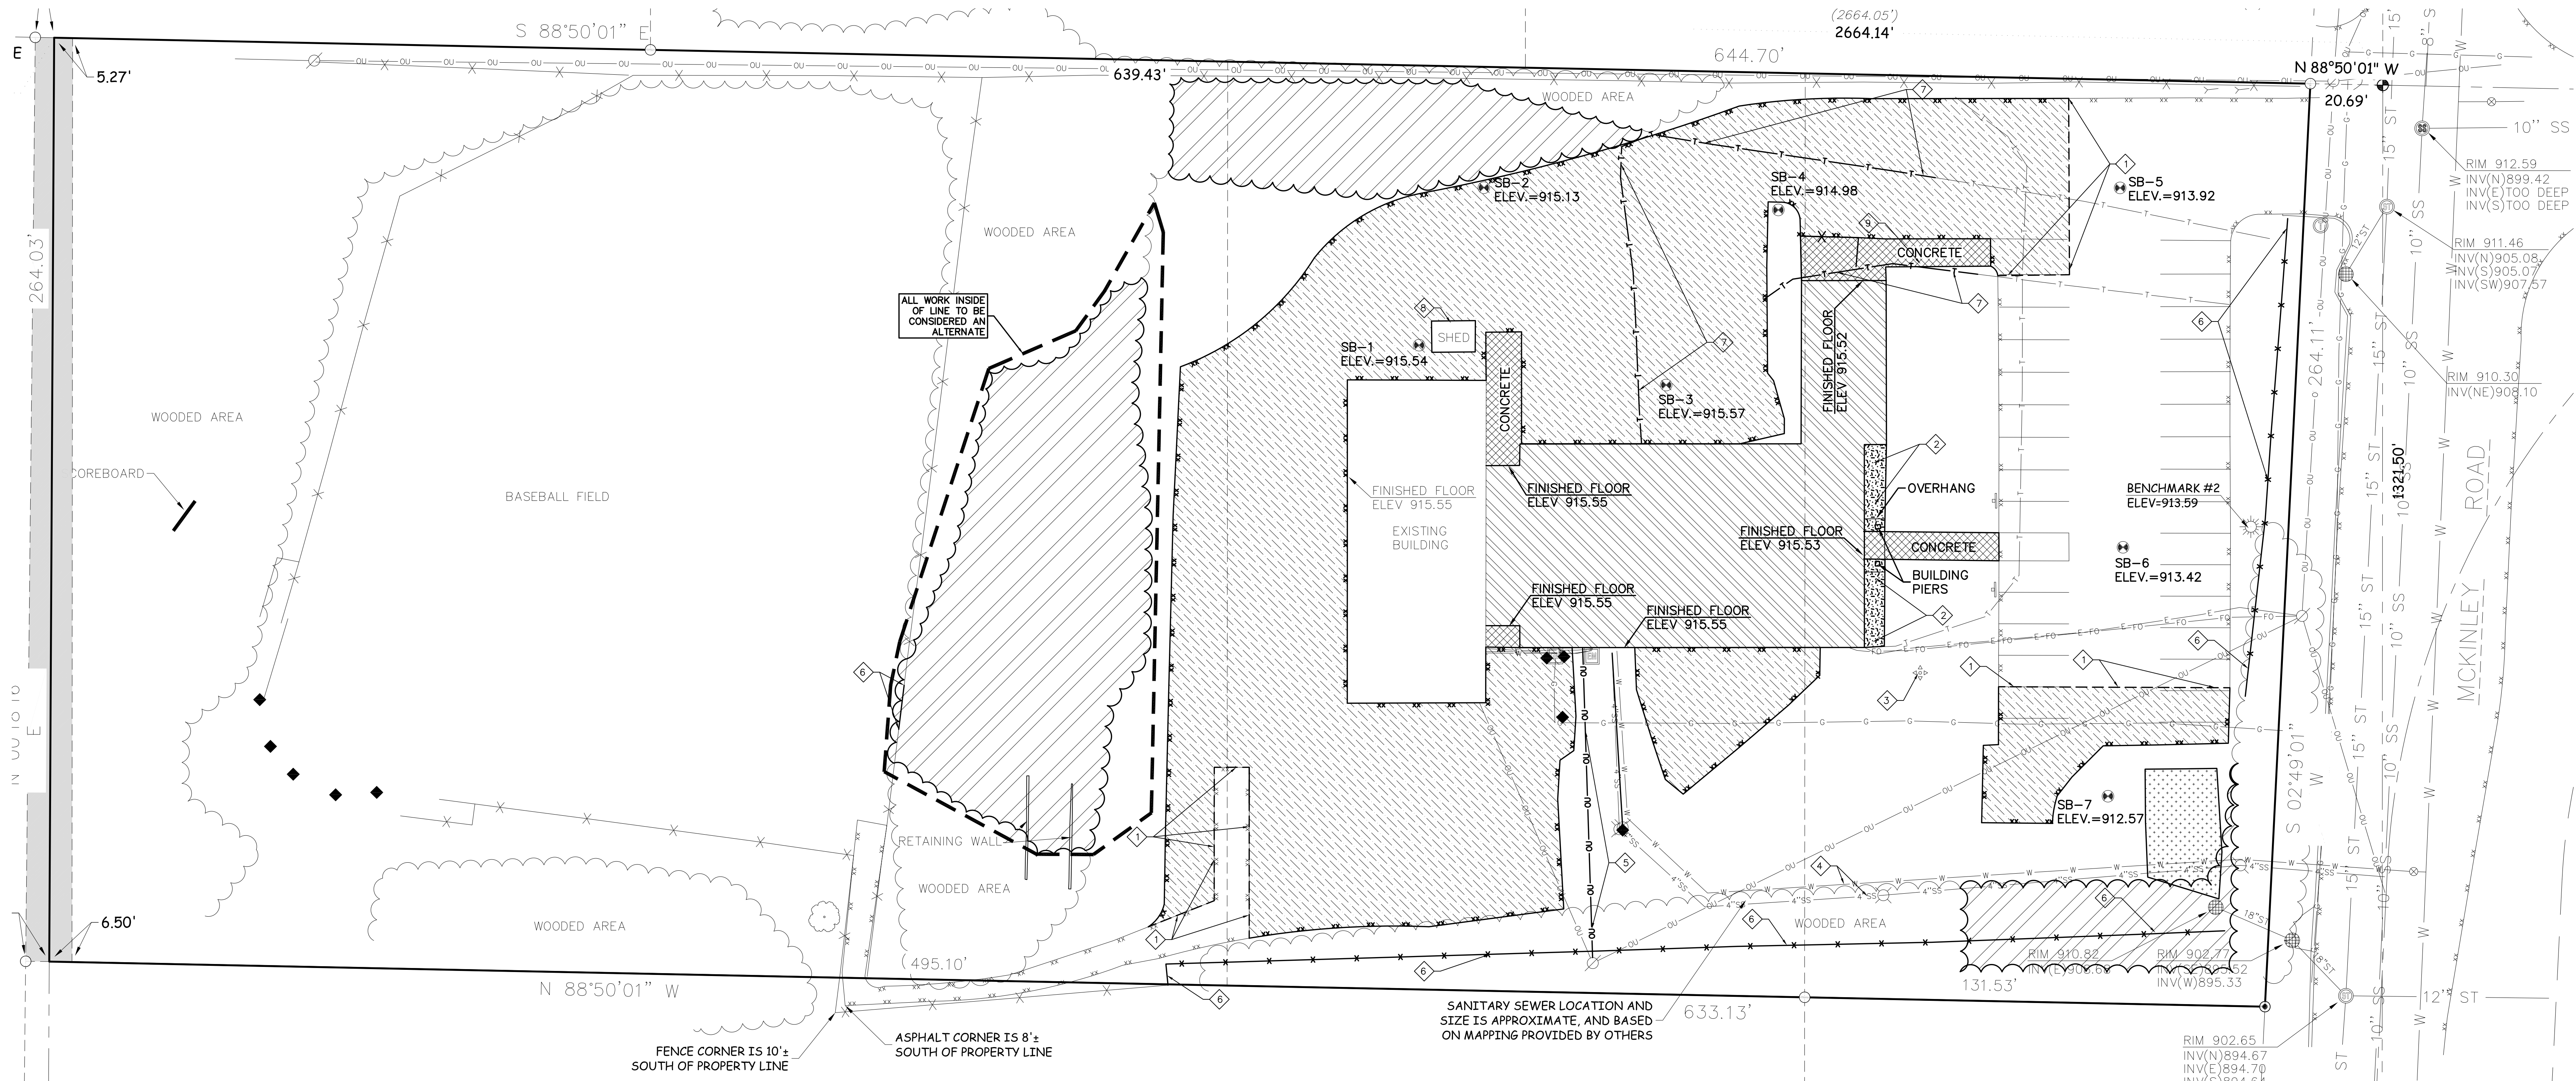

**GENERAL NOTES:**

- CONTACT DIGGER'S HOTLINE 5 WORKING DAYS PRIOR TO THE START OF DEMOLITION/CONSTRUCTION.
- ALL DEMOLITION MATERIALS SHALL BE REMOVED FROM THE SITE AND DISPOSED OF IN A LEGAL MANNER EXCEPT FOR THOSE ITEMS NOTED TO BE SALVAGED, WHICH SHOULD BE TURNED OVER TO THE OWNER.
- INSTALL AND MAINTAIN ALL REQUIRED EROSION CONTROL MEASURES FOR PERIMETER PROTECTION PRIOR TO THE START OF DEMOLITION/CONSTRUCTION, IN ACCORDANCE WITH THE LOCAL AND STATE GOVERNING AUTHORITIES.
- ALL BIDDERS PLANNING ON SUBMITTING A BID SHALL VISIT THE SITE AND REVIEW THE EXISTING CONDITIONS PRIOR TO THE BID DATE.
- COORDINATE WITH THE OWNER AND LOCAL UTILITY COMPANIES TO LOCATE ANY EXISTING UTILITIES ON SITE PRIOR TO THE START OF WORK.
- ANY EXISTING UTILITIES NOT SHOWN ON THIS DOCUMENT WHICH NEED TO BE REMOVED, RELOCATED AND OR ADJUSTED SHALL BE THE RESPONSIBILITY OF THE SITE GRADING CONTRACTOR AND INCLUDED IN THE BASE BID CONTRACT.
- STRIP TOPSOIL WITHIN THE PROJECT LIMITS IN ACCORDANCE WITH THE PROJECT MANUAL SPECIFICATIONS.
- IF STRIPPED TOPSOIL IS STOCKPILED ON SITE, SILT FENCE SHALL BE INSTALLED AROUND THE BASE OF THE STOCKPILE TO PREVENT SEDIMENT TRANSPORT. STOCKPILE LOCATION TO BE DETERMINED BY SITE CONTRACTOR.
- PRIOR TO PERFORMING WORK WITHIN PUBLIC RIGHT OF WAYS, NOTIFY AND COORDINATE WORK WITH THE LOCAL MUNICIPALITY.
- EXISTING BUILDING TO REMAIN UNTIL PROPOSED ADDITION IS COMPLETED AND OPERATIONAL.

**DEMOLITION HATCH PATTERNS:**

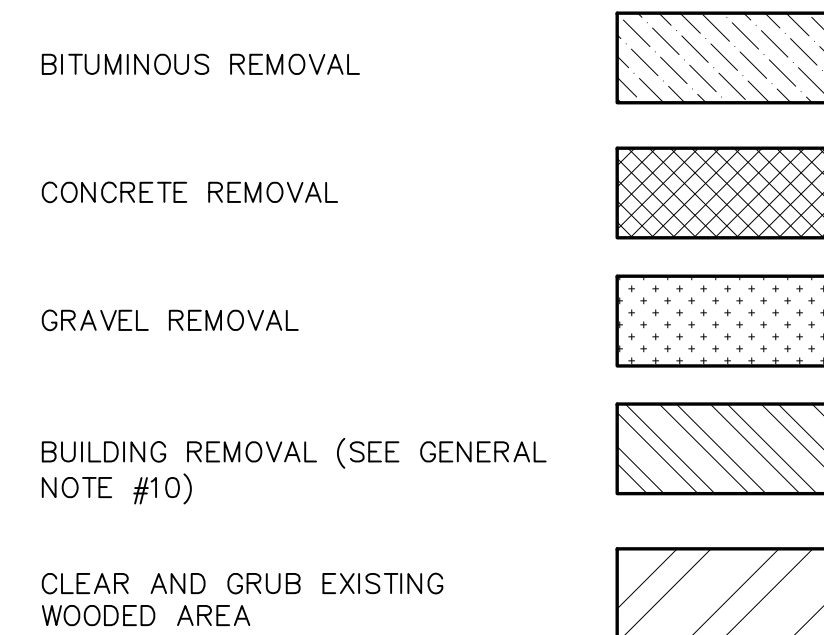

**EXISTING SITE STATISTICS**

ZONING = P-PUBLIC PROPERTIES DISTRICT		TOTAL AREA = 3.872 Acres	
TOTAL IMPERVIOUS & PERVIOUS SURFACES			
BUILDING	CONCRETE WALKS & BITUMINOUS PAVEMENT	GREEN SPACE (GRASS)	GREEN SPACE (WOODS)
0.256 Acre	0.956 Acre	1.475 Acre	1.185 Acre
OR 7% OF TOTAL AREA	OR 25% OF TOTAL AREA	OR 38% OF TOTAL AREA	OR 30% OF TOTAL AREA

**KEYNOTES:**

- SAWCUT EXISTING BITUMINOUS PAVEMENT
- REMOVE LANDSCAPE AREA
- REMOVE FLAG POLE
- MAINTAIN WATER AND SEWER SERVICE LATERAL
- REMOVE OVERHEAD SERVICE LINE AT TIME OF BUILDING REMOVAL
- REMOVE EXISTING FENCE
- REMOVE TELEPHONE LINE
- SHED TO BE RELOCATED BY OWNER (SEE LAYOUT PLAN FOR LOCATION)
- SALVAGE BIKE RACK (SEE LAYOUT PLAN FOR RELOCATION)

**BENCH MARK**

ELEVATIONS ARE REFERENCED TO NAVD 88 DATUM.  
**BENCHMARK #1**  
 BURY 10" IN FIRE HYDRANT LOCATED IN THE NORTHEAST QUADRANT OF MCKINLEY ROAD AND TOWER DRIVE. ELEVATION = 916.04  
**BENCHMARK #2**  
 600' SET IN POWER POLE LOCATED ON THE WEST SIDE OF MCKINLEY ROAD, APPROXIMATELY 100 FEET SOUTH OF TOWER DRIVE. ELEVATION = 913.59

**DESCRIPTION**

BEING A PART OF THE NORTHEAST ¼ OF THE NORTHWEST ¼ OF SECTION 15, TOWNSHIP 27 NORTH, RANGE 9 WEST, CITY OF EAU CLAIRE, EAU CLAIRE COUNTY, WISCONSIN, DESCRIBED AS FOLLOWS:

COMMENCING AT THE NORTH ¼ CORNER OF SECTION 15, TOWNSHIP 27 NORTH, RANGE 9 WEST, THENCE N 88°50'01" W ALONG THE NORTH LINE OF THE NORTHWEST ¼ OF SAID SECTION 15, 264.03 FEET TO THE EAST LINE OF MCKINLEY ROAD AND THE POINT OF BEGINNING (POB) OF THE PARCEL TO BE DESCRIBED; THENCE S 02°49'01" W ALONG THE EAST LINE OF MCKINLEY ROAD, 264.11 FEET; THENCE N 88°50'01" W, 633.13 FEET TO A POINT ON THE WEST LINE OF THE NORTHEAST ¼ OF THE NORTHWEST ¼ OF SAID SECTION 15; THENCE N 00°18'16" E ALONG SAID WEST LINE, 264.03 FEET TO THE NORTH LINE OF THE NORTHWEST ¼ OF SAID SECTION 15; THENCE S 88°50'01" E ALONG THE NORTH LINE OF THE NORTHWEST ¼ OF SAID SECTION 15, 644.70 FEET TO THE POINT OF BEGINNING.

CONTAINING: 168,673 SQUARE FEET, 3.872 ACRES

POINT OF BEGINNING, INC. HOLDS THE RIGHTS TO COPYRIGHT IN AND TO THESE PLANS, DRAWINGS AND DOCUMENTS. NO REPRODUCTION, COPYING, ALTERATION, MODIFICATION, REUSE, INCORPORATION INTO OTHER DOCUMENTS OR ASSIGNMENT OF THE SAME MAY OCCUR WITHOUT THE PRIOR WRITTEN PERMISSION OF POINT OF BEGINNING, INC.  
 © 2018 POINT OF BEGINNING, INC.



HSR ASSOCIATES INC.  
 100 MILWAUKEE STREET  
 LA CROSSE, WISCONSIN  
 PHONE: 608.784.1830  
 FAX: 608.782.5844  
 WEB SITE: www.hsrassociates.com

Consultant:

Civil Engineering  
Land Surveying  
Landscape Architecture  
 5709 Windy Drive, Suite D  
 Stevens Point, WI 54482  
 715.344.9999 (Ph) 715.344.9922 (Fax)



MCKINLEY CHARTER SCHOOL  
EAU CLAIRE AREA SCHOOL DISTRICT

1266 MCKINLEY RD  
EAU CLAIRE, WI 54703  
DEMOLITION PLAN

Project Title:  
 POB Project Number:  
 Project Location:  
 Sheet Title:

17.124

MARCH 2018

Drawn By:  
 JJJ


Certification Stamp:


No.	Description	Date
2	ADDENDUM #2	3/21/18

Graphic Scale: 1"=20'

Last Update: 03/8/2018

C100R

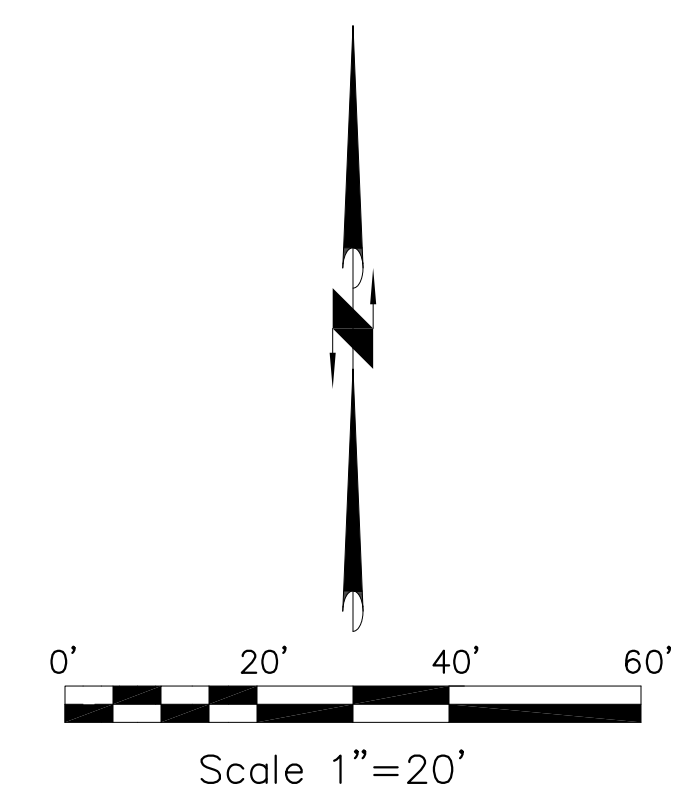


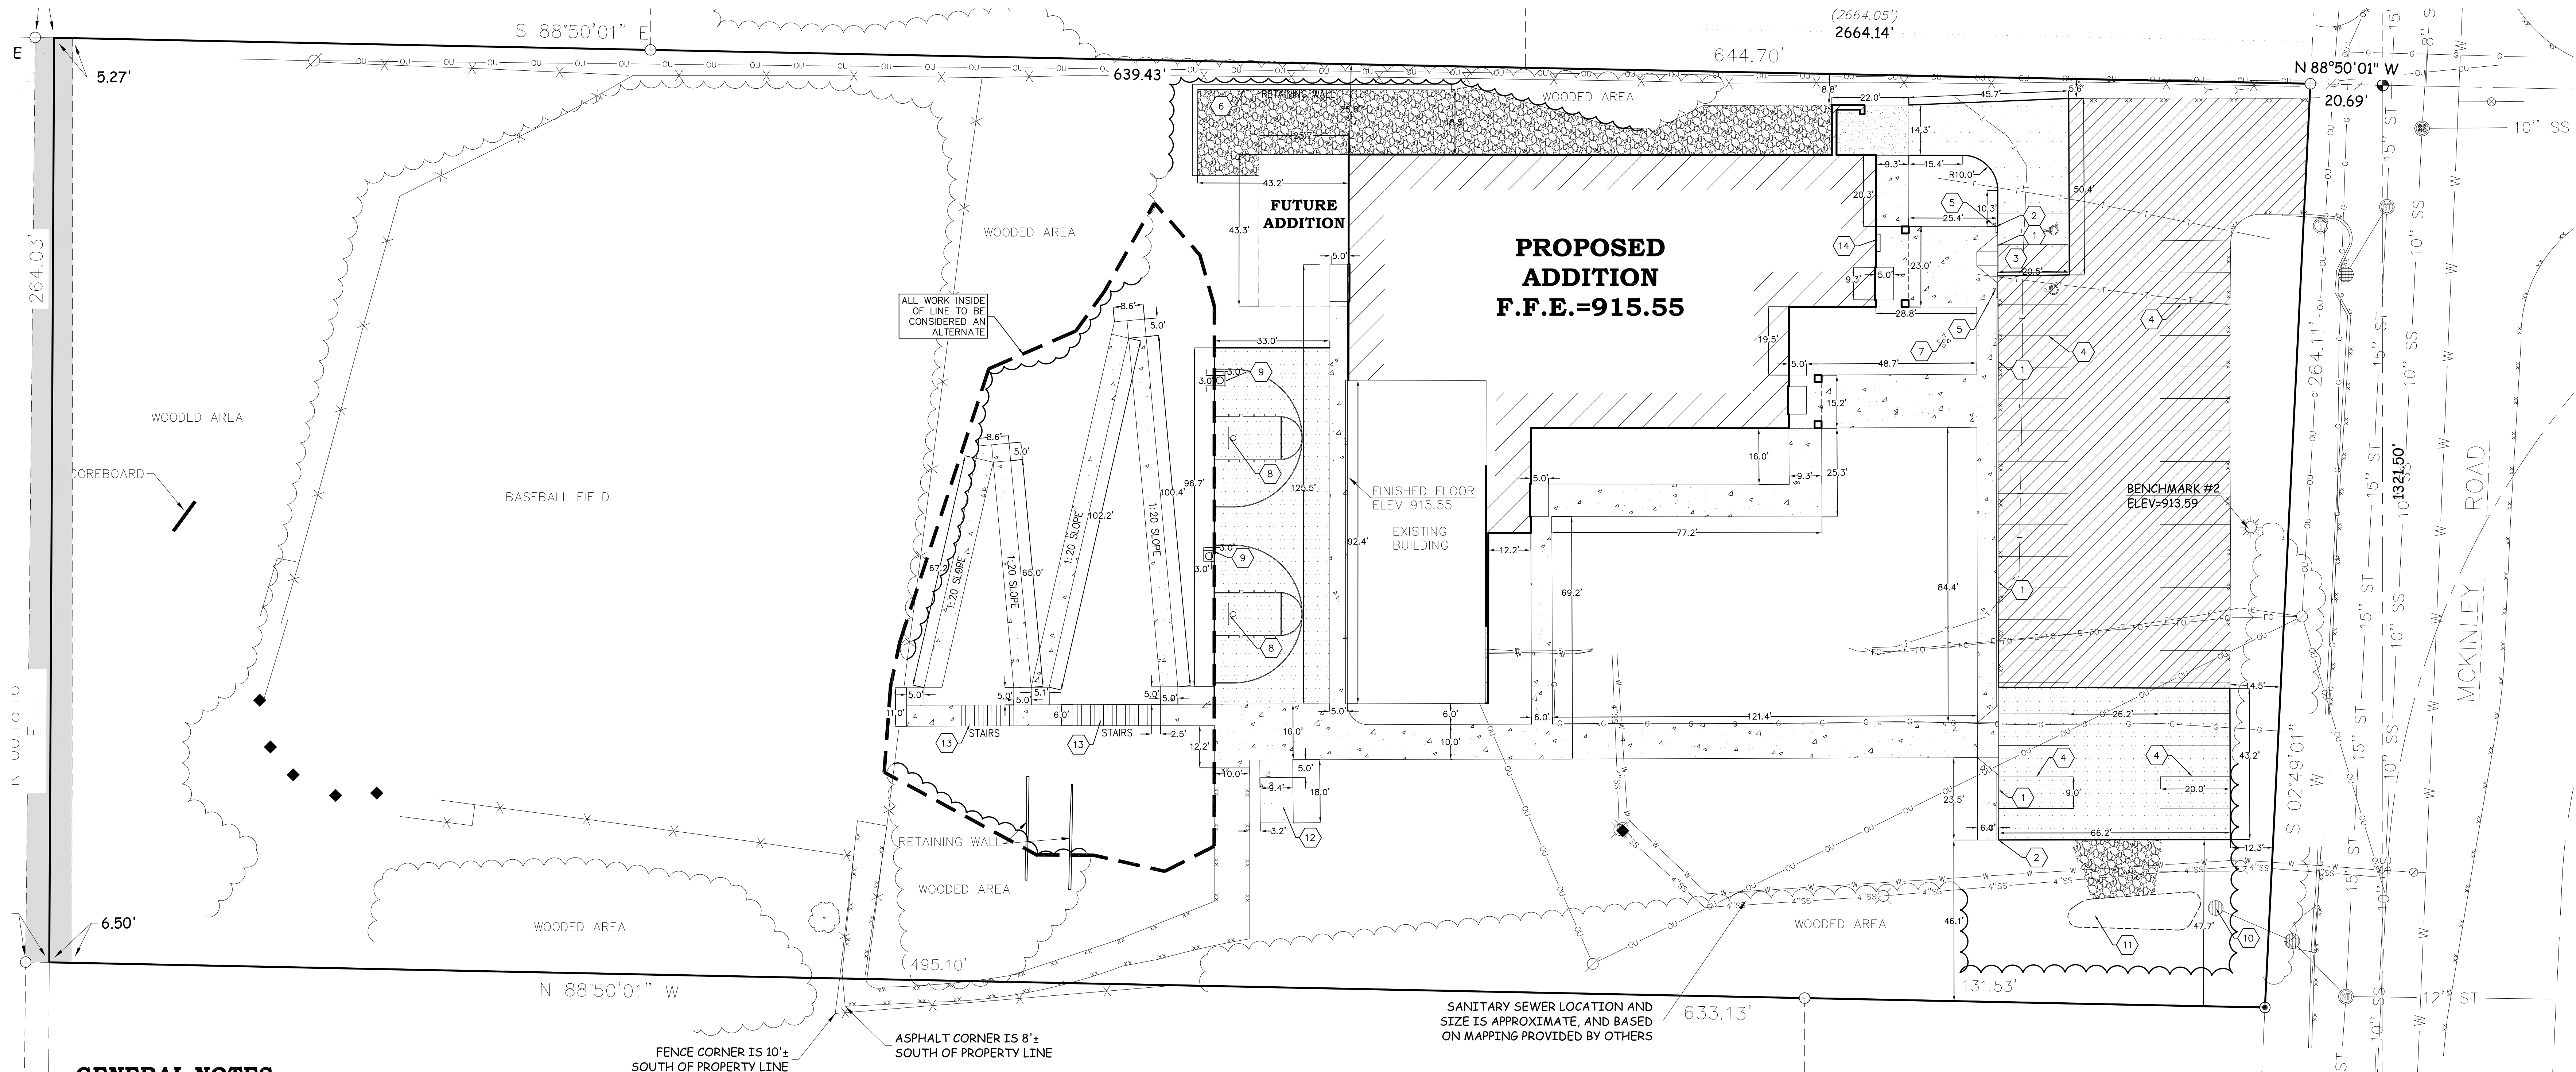

**GENERAL NOTES:**

- CONTACT DIGGER'S HOTLINE 5 WORKING DAYS PRIOR TO THE START OF DEMOLITION/CONSTRUCTION.
- GRADE, LINE, AND LEVEL TO BE REVIEWED IN THE FIELD BY THE CONTRACTOR.
- ALL REQUIRED EROSION CONTROL MEASURES ARE TO BE INSTALLED AND MAINTAINED IN ACCORDANCE WITH LOCAL MUNICIPAL AND DEPARTMENT OF NATURAL RESOURCES REGULATIONS.
- SEE SHEET C103 FOR ALL REQUIRED EROSION CONTROL ELEMENTS.
- ANY EXISTING UTILITIES NOT SHOWN ON THIS DOCUMENT WHICH NEED TO BE REMOVED, RELOCATED AND OR ADJUSTED SHALL BE THE RESPONSIBILITY OF THE SITE GRADING CONTRACTOR AND INCLUDED IN THE BASE BID CONTRACT.
- VERIFY THE LOCATION OF ALL EXISTING UTILITIES PRIOR TO THE START OF DEMOLITION/CONSTRUCTION.
- ALL BIDDERS PLANNING ON SUBMITTING A BID SHALL VISIT THE SITE AND REVIEW THE EXISTING CONDITIONS PRIOR TO THE BID DATE.
- PRIOR TO THE START OF WORK VERIFY WITH THE LOCAL AUTHORITIES THAT ALL REQUIRED PERMITS HAVE BEEN ACQUIRED.
- COORDINATE CONSTRUCTION IN THE RIGHT OF WAY WITH THE LOCAL AUTHORITIES.
- PROVIDE PROPER BARRICADES, SIGNS AND TRAFFIC CONTROL TO MAINTAIN THRU TRAFFIC ALONG ADJACENT STREETS IN ACCORDANCE WITH LOCAL MUNICIPAL REQUIREMENTS.
- SIDEWALK JOINTS TO BE AS INDICATED OR AS APPROVED BY CONSTRUCTION ADMINISTRATOR.
- ALL GENERAL LANDSCAPE AREAS SHALL BE SEEDED/FERTILIZED/ CRIMP HAY MULCHED IN ACCORDANCE WITH THE PROJECT SPECIFICATIONS.

**PAVEMENT HATCH PATTERNS:**

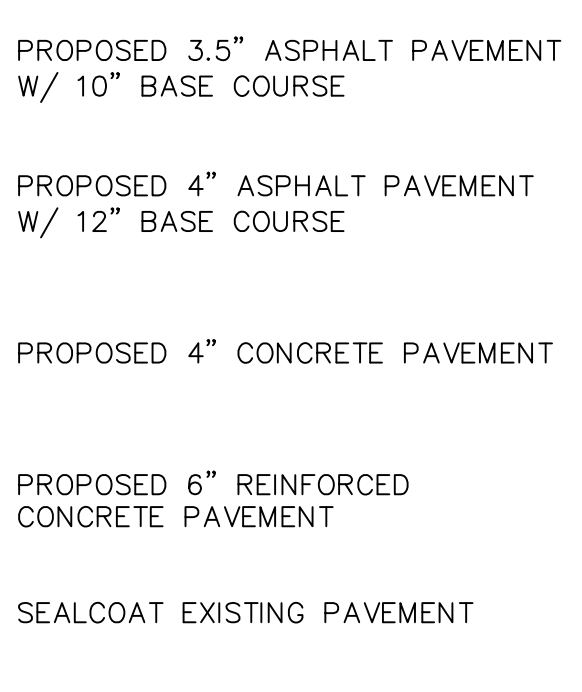

**DESCRIPTION**

BEING A PART OF THE NORTHEAST 1/4 OF THE NORTHWEST 1/4 OF SECTION 15, TOWNSHIP 27 NORTH, RANGE 9 WEST, CITY OF EAU CLAIRE, EAU CLAIRE COUNTY, WISCONSIN, DESCRIBED AS FOLLOWS:

COMMENCING AT THE NORTH 1/4 CORNER OF SECTION 15, TOWNSHIP 27 NORTH, RANGE 9 WEST, THENCE N 88°50'01\"/>

**KEYNOTES:**

- THICKENED EDGE WALK
- END OF PROPOSED THICKENED EDGE WALK
- ADA ACCESS ROUTE
- PARKING LOT STRIPING
- HANDICAP PARKING SIGN
- PROPOSED MODULAR BLOCK RETAINING WALL
- PROPOSED FLAG POLE
- PROPOSED BASKETBALL HOOP WITH BACKBOARD AND POLE
- CONCRETE COLLAR LOCATION FOR STORM DRAIN INLETS (SEE UTILITY PLAN)
- RAISE STORM SEWER RIM TO PROPOSED GRADE (SEE GRADING PLAN)
- PROPOSED BIO RETENTION AREA
- PROPOSED SHED RELOCATION (BY OWNER) (CONCRETE PAD BY CONTRACTOR)
- CONCRETE STAIRS
- APPROXIMATE BIKE RACK LOCATION (COORDINATE WITH OWNER)

**BENCH MARK**

ELEVATIONS ARE REFERENCED TO NAVD 88 DATUM.

**BENCHMARK #1**  
BURY BOLT ON FIRE HYDRANT LOCATED IN THE NORTHEAST QUADRANT OF MCKINLEY ROAD AND TOWER DRIVE. ELEVATION = 916.04


**BENCHMARK #2**  
600 SET IN POWER POLE LOCATED ON THE WEST SIDE OF MCKINLEY ROAD, APPROXIMATELY 100 FEET SOUTH OF TOWER DRIVE. ELEVATION = 913.59

**PROPOSED SITE STATISTICS**


ZONING = P-PUBLIC PROPERTIES DISTRICT		TOTAL AREA = 3.872 ACRES	
TOTAL IMPERVIOUS & PERVIOUS SURFACES			
BUILDING	CONCRETE WALKS & BITUMINOUS PAVEMENT	GREEN SPACE (GRASS)	GREEN SPACE (WOODS)
0.365 Acre	0.676 Acre	1.947 Acre	0.884 Acre
9% OF TOTAL AREA	18% OF TOTAL AREA	50% OF TOTAL AREA	23% OF TOTAL AREA

**SITE PARKING STATISTICS**


ZONING DISTRICT	STUDENTS	MIN REQ STALLS	MAX REQ STALLS	PROPOSED STALLS	PROPOSED BIKE STALLS
PUBLIC PROPERTIES	100	34	43	38	5+

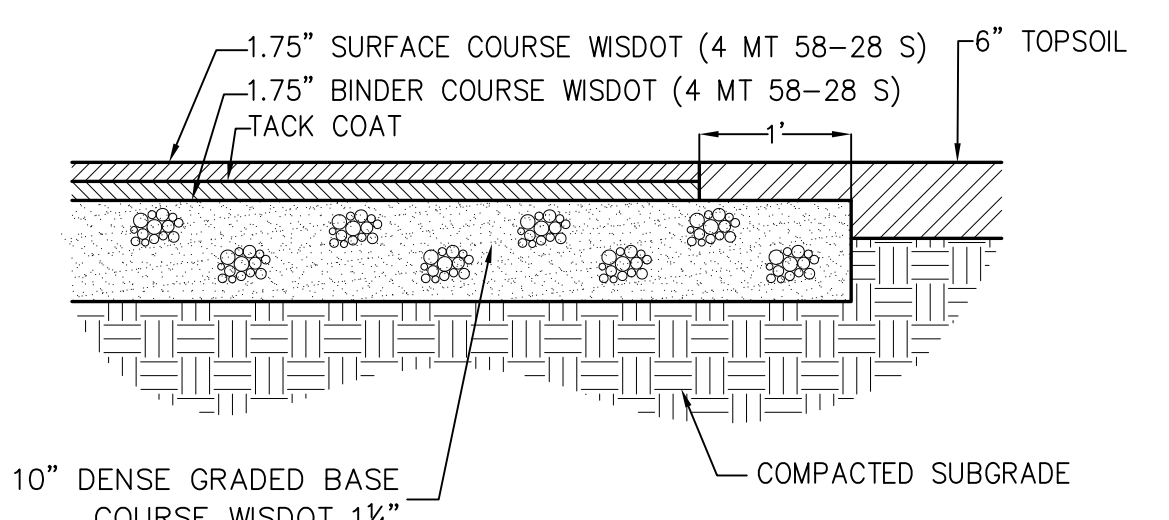


**3.5\"/>**

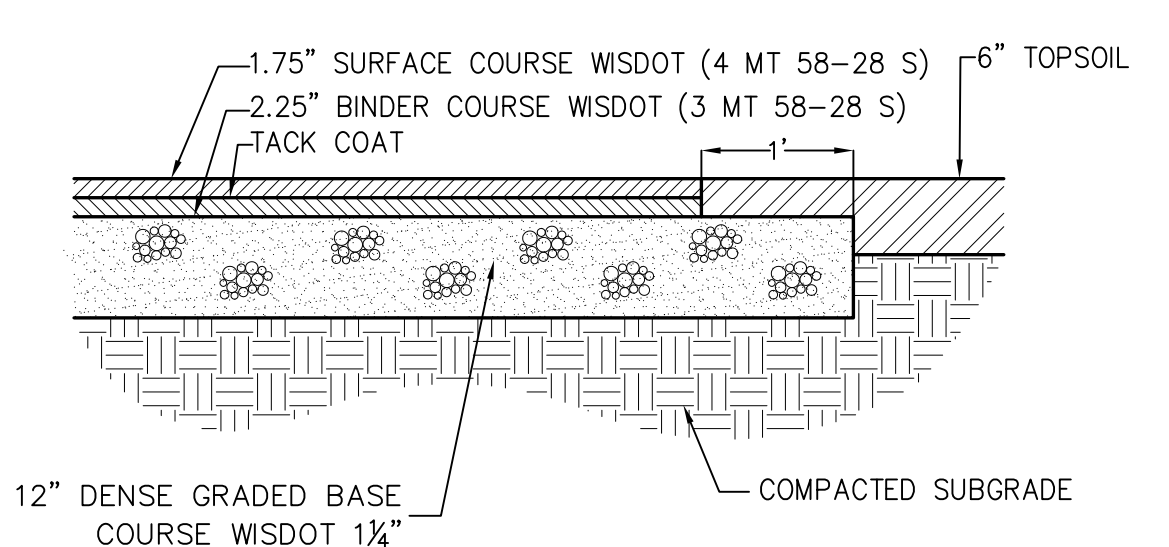


**4\"/>**

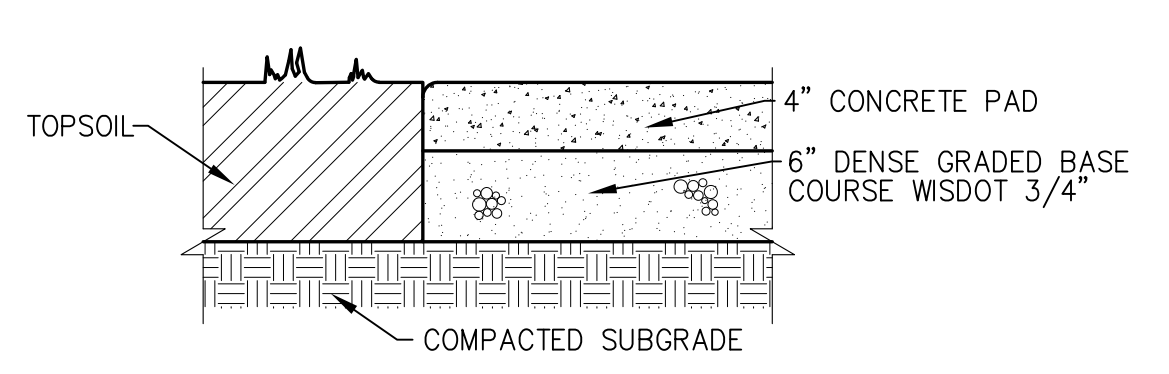


**4\"/>**

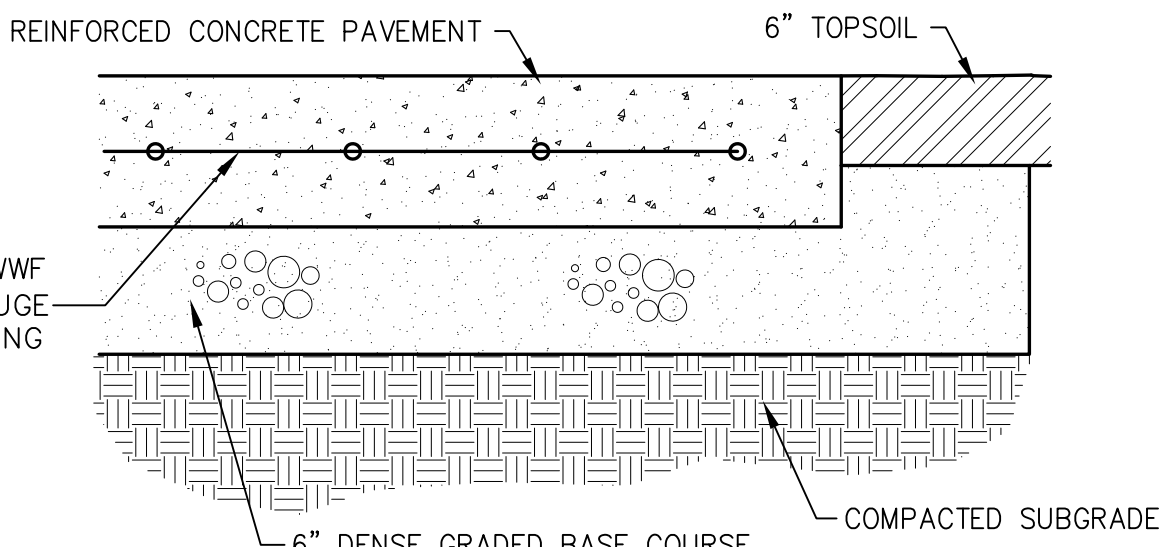


**6\"/>**

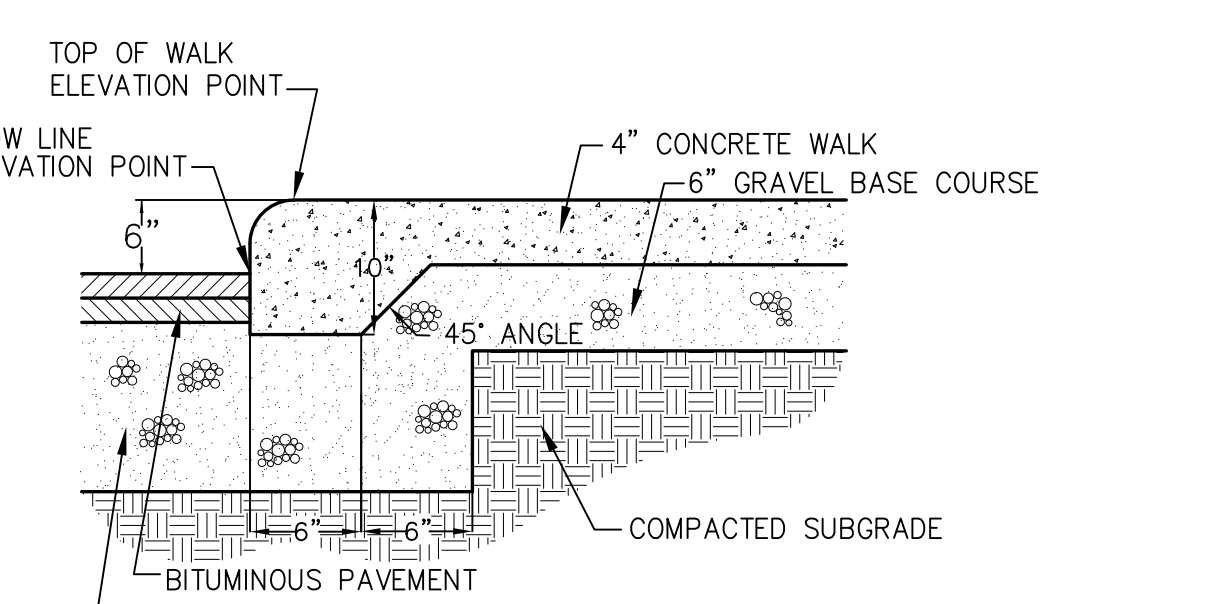

**THICKENED EDGE WALK**

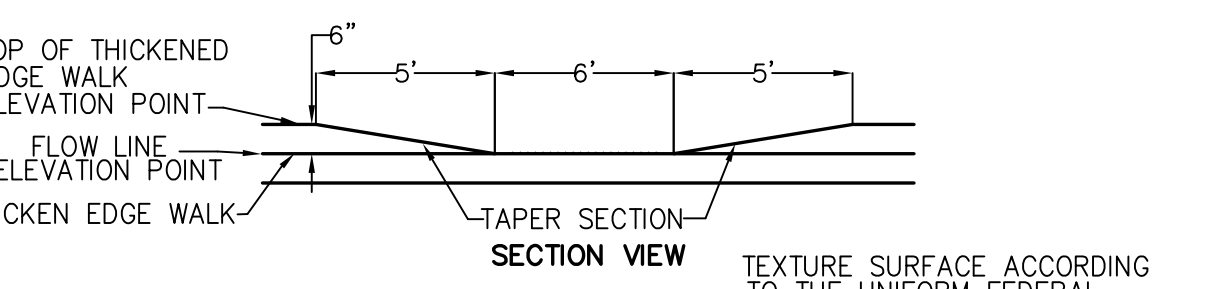


**SECTION VIEW**

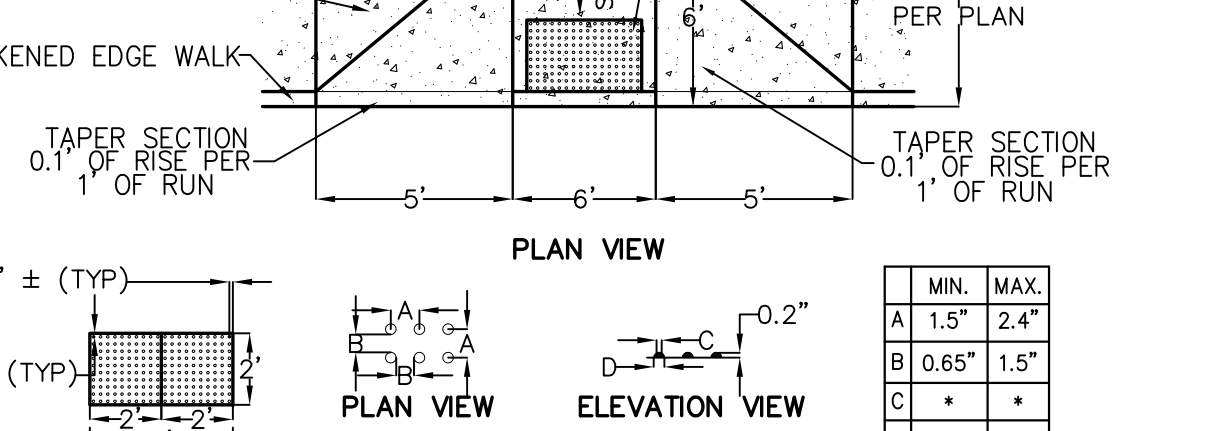


**PLAN VIEW**

**ADA CURB RAMP**

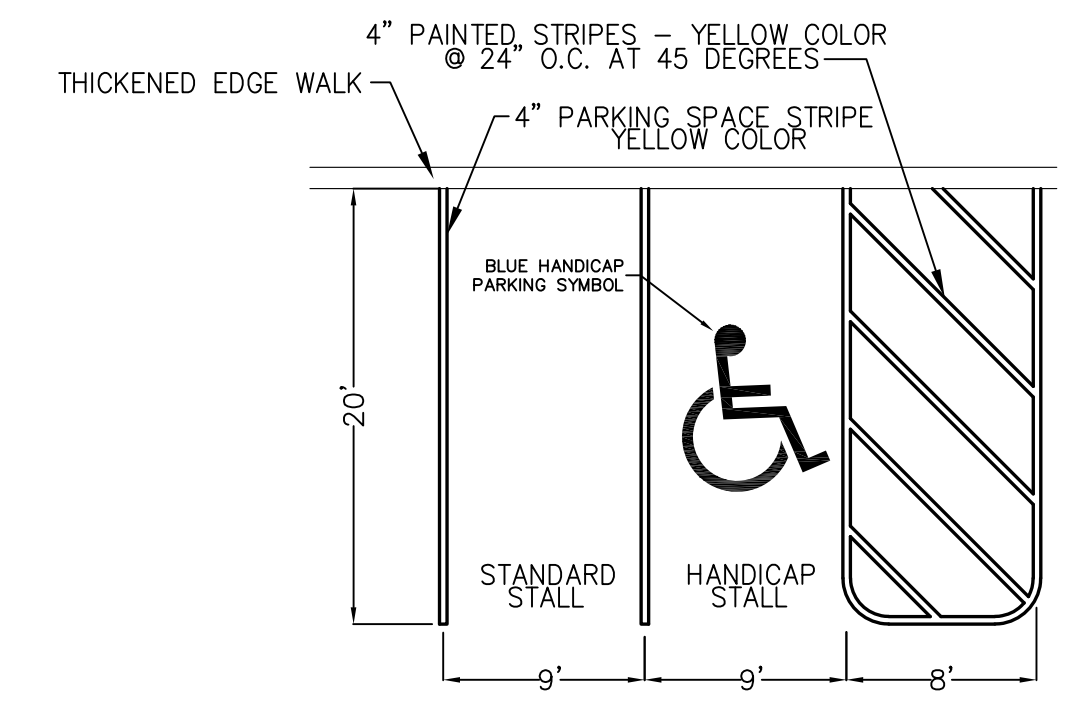

**PARKING LOT STRIPING**

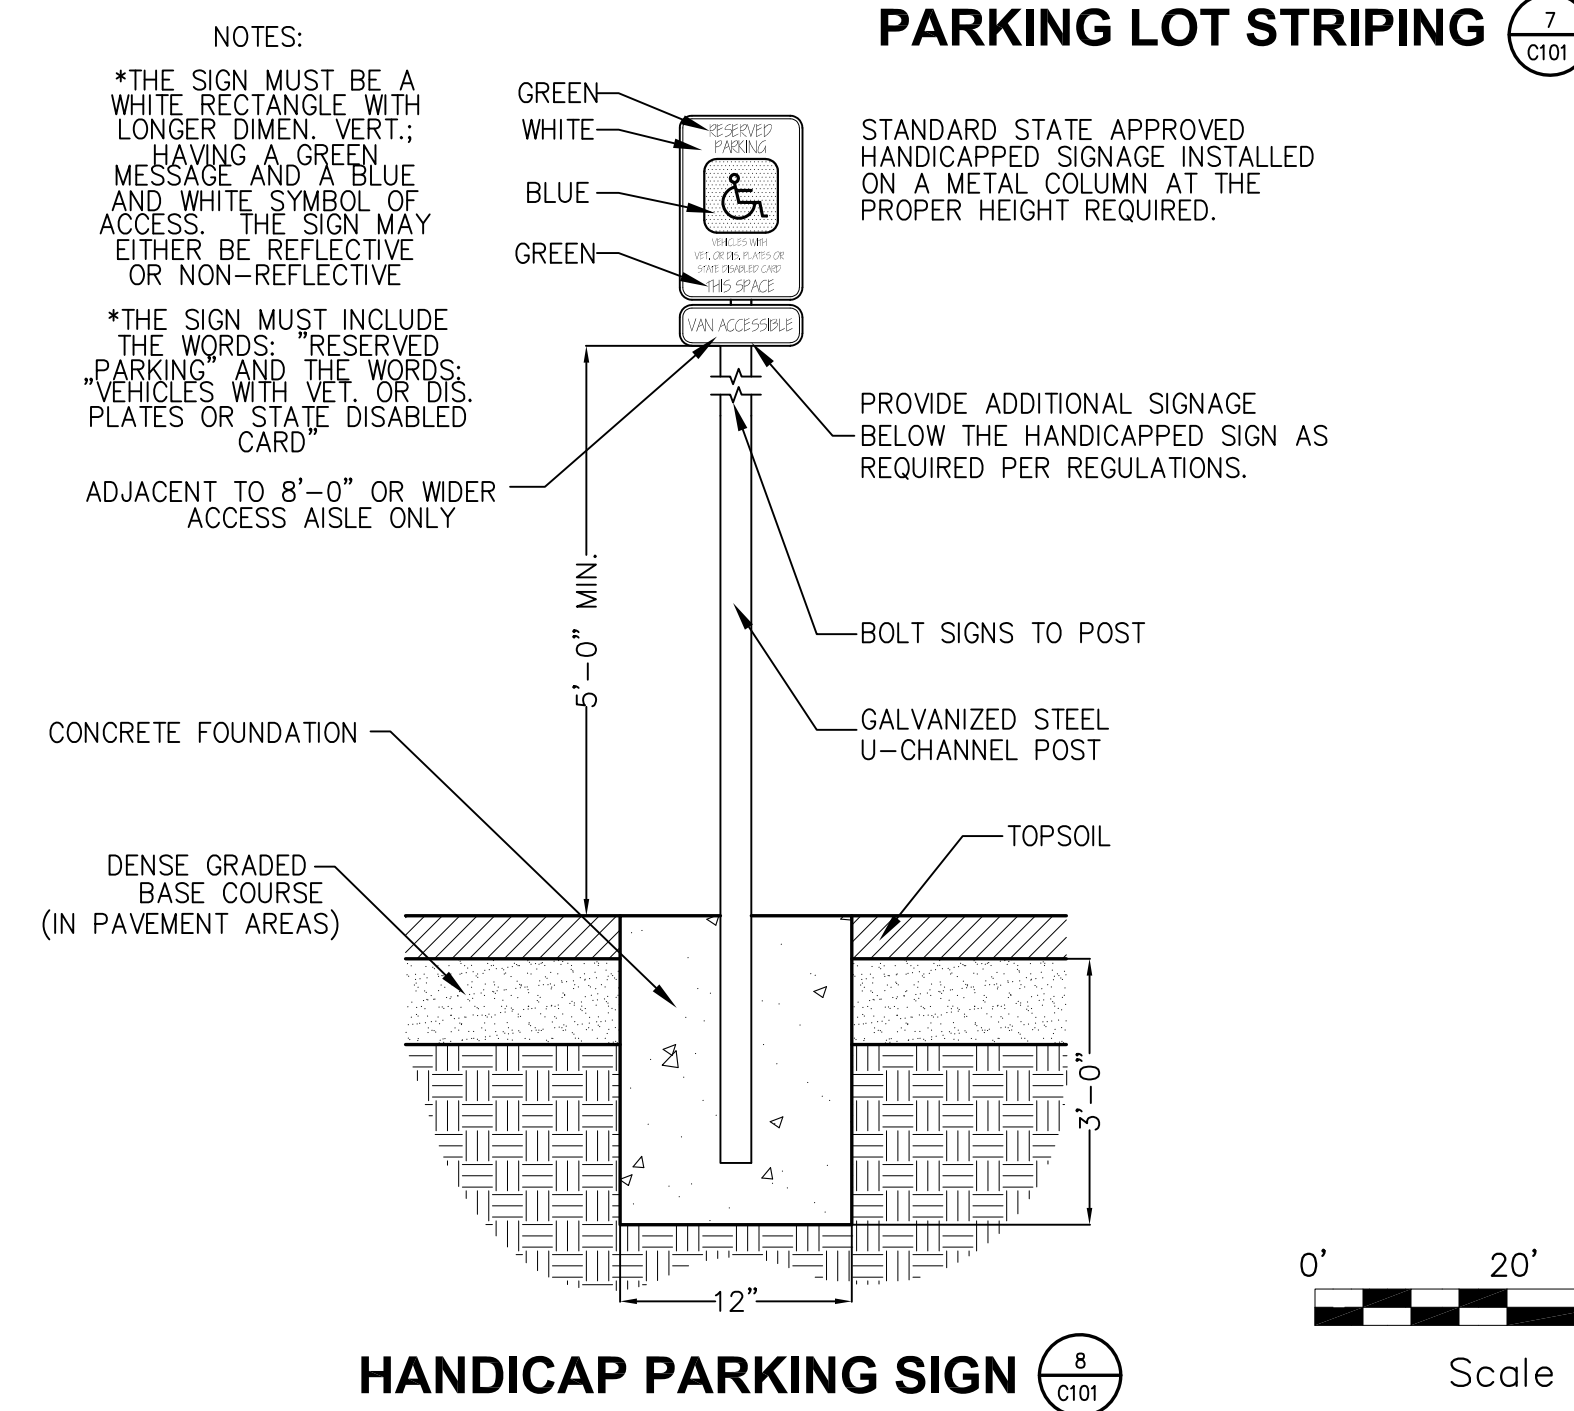


**HANDICAP PARKING SIGN**



HSR ASSOCIATES INC.  
100 MILWAUKEE STREET  
LA CROSSE, WISCONSIN  
PHONE: 608.784.1830  
FAX: 608.782.5844  
WEB SITE: www.hsrassociates.com

Consultant:

Civil Engineering  
Land Surveying  
Landscape Architecture  
5709 Windy Drive, Suite D  
Stevens Point, WI 54482  
715.344.9999 (Ph) 715.344.9922 (Fax)

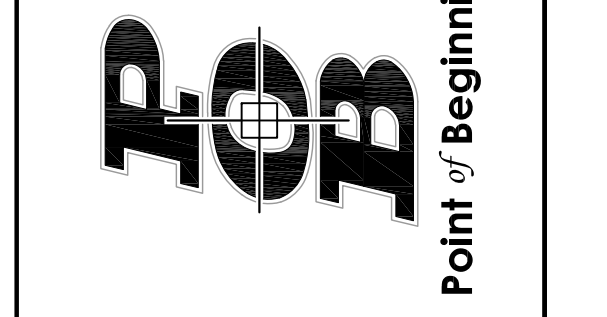

**MCKINLEY CHARTER SCHOOL  
EAU CLAIRE AREA SCHOOL DISTRICT**

Project Title:  
Project Number:  
Project Location:  
Sheet Title:

POB Project Number:  
Project Date:

Drawn By:  
Certification Stamp:

Revisions:

No.	Description	Date
2	ADDENDUM #2	3/21/18


Graphic Scale: 1"=20'

Last Update: 03/8/2018

**C101R**



Consultant:

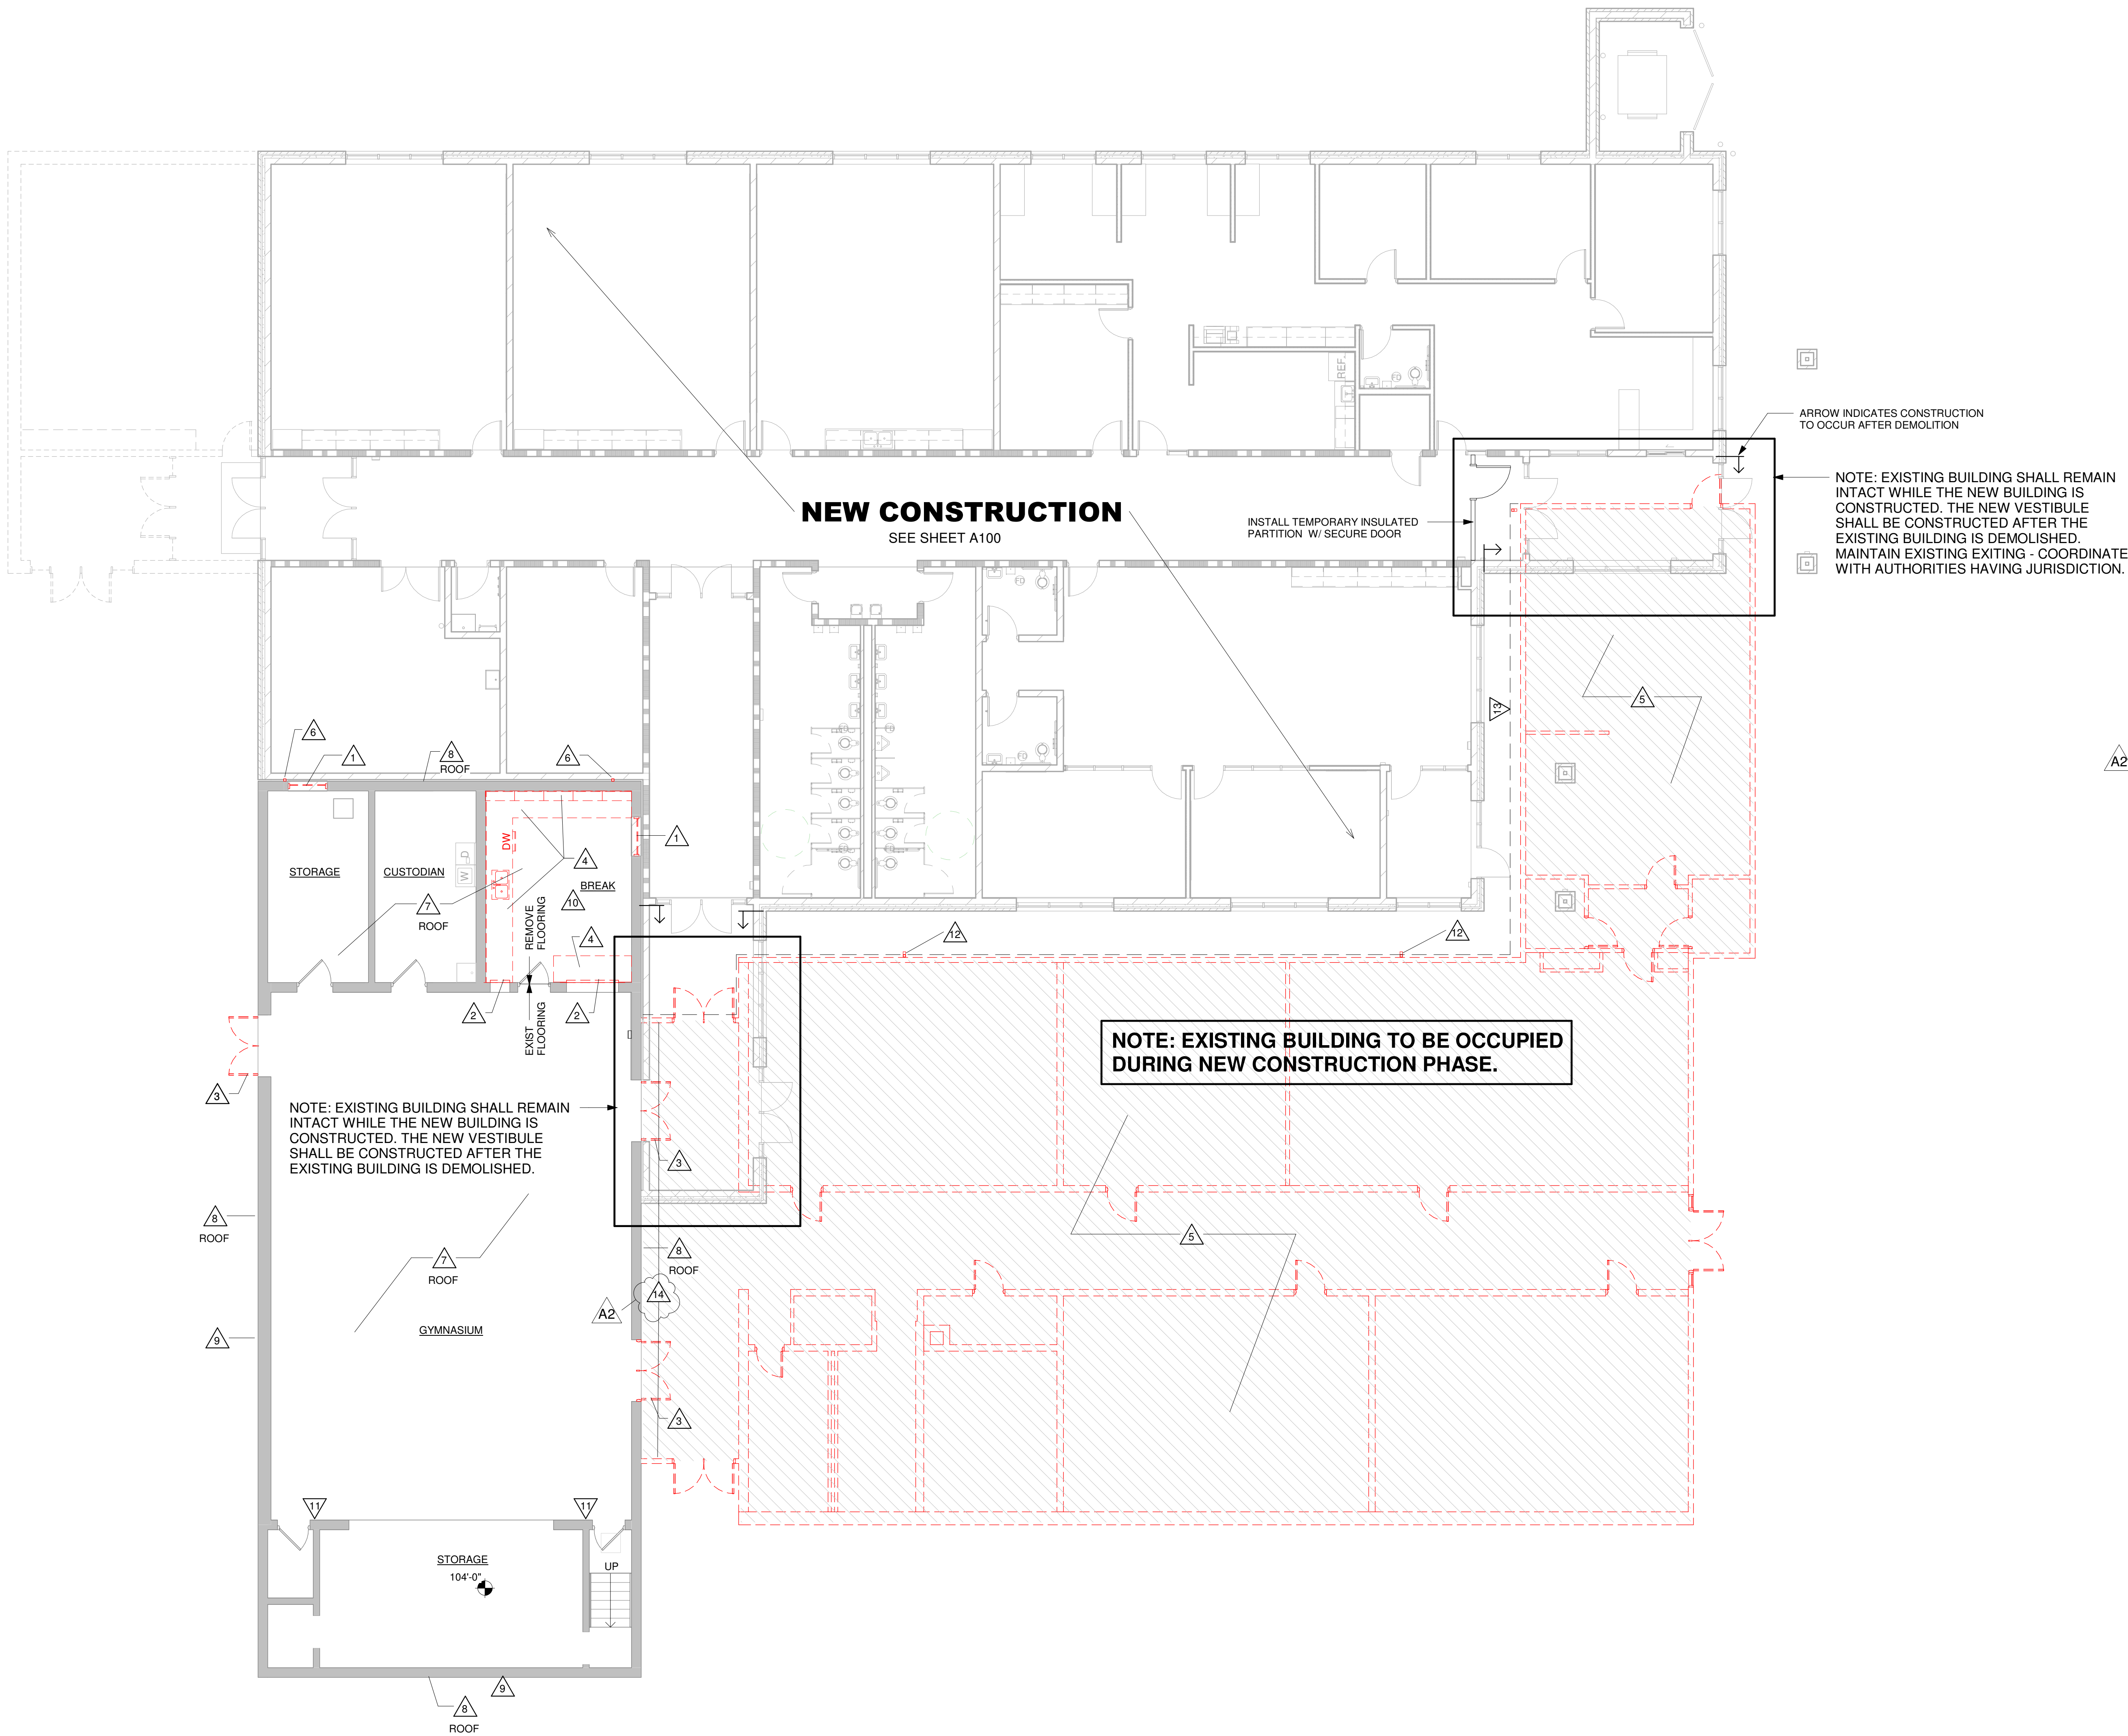

**ASBESTOS ABATEMENT:**

UNDER SEPARATE CONTRACT BY THE OWNER'S ABATEMENT CONTRACTOR ACM ABATEMENT WILL BE FULLY COMPLETED PRIOR TO WORK COMMENCING IN AFFECTED AREAS. SEE FULL ACM ABATEMENT REPORT FOR ADDITIONAL INFORMATION.

**REMOVAL GENERAL NOTES:**

- A ALL STRUCTURES NOTED TO BE REMOVED ON THIS PLAN SHALL BE COMPLETELY REMOVED FROM THE SITE AND DISPOSED OF BY THE CONTRACTOR UNLESS NOTED OTHERWISE.
- B ITEMS NOTED FOR SALVAGE SHALL BE TURNED OVER TO BUILDING OWNER UNLESS INDICATED TO BE REUSED IN THE NEW LAYOUT.
- C SEE ME/P SHEETS TO COORDINATE REMOVAL WORK.
- D PREPARATION FOR NEW FINISHES SHALL INCLUDE BUT NOT BE LIMITED TO REMOVAL OF EXISTING FINISHES, TAPES, GLUES (MASTIC, NAILS, ETC. AND PATCHING OF HOLES, CRACKS AND APPLICATION OF LEVELING COMPOUND ON FLOOR TO PROVIDE AN ACCEPTABLE SURFACE FOR NEW FINISH INSTALLATION.
- E ALL LOOSE FURNISHINGS WILL BE REMOVED FROM THE WORK AREAS BY THE OWNER PRIOR TO CONSTRUCTION START.
- F COORDINATE POWER, COMMUNICATIONS, WATER, HEATING & AIR CONDITIONING INTERRUPTIONS WITH OWNER.

**REMOVAL LEGEND:**

- EXISTING
- - - EXISTING TO BE REMOVED
- △ SYMBOL INDICATES REMOVAL KEY NOTE.

**KEY NOTES REMOVAL**

- 1 REMOVE WINDOW AND FRAME. PREPARE OPENING FOR CMU INFILL.
- 2 REMOVE COILING COUNTER DOOR.
- 3 REMOVE H.H. DOOR AND FRAME. PREPARE OPENING FOR NEW WORK.
- 4 REMOVE ALL CASEWORK AND COUNTERS. INCLUDE SINK AND DISHWASHER.
- 5 REMOVE ENTIRE BUILDING INCLUDING FOUNDATION WALLS & FOOTINGS. NOTE: EXISTING BUILDING TO BE OCCUPIED DURING NEW CONSTRUCTION PHASE.
- 6 REMOVE EXISTING ROOF SCUPPER / DOWNSPOUT.
- 7 REMOVE EXISTING ROOFING AND EQUIPMENT. PREPARE FOR NEW TAPERED INSULATION AND ROOF DRAINS.
- 8 REMOVE GRAVEL STOPS AT ENTIRE PERIMETER OF HIGH AND LOW ROOFS. PREPARE AS REQUIRED FOR NEW BLOCKING AND GRAVEL STOPS.
- 9 REMOVE BACKBOARDS, ALARMS AND SPEAKERS AS REQUIRED FOR NEW EXTERIOR FINISHES. COORDINATE REINSTALLATION.
- 10 REMOVE ACOUSTIC TILE CEILING & GRID.
- 11 SAWCUT OPENING AT TOP OF EXISTING NON-LOAD BEARING CMU WALL FOR HVAC DUCTWORK / GRILLE. COORDINATE WITH MECH.
- 12 CONNECT EXISTING ROOF SCUPPER / DOWNSPOUT TO ABOVE GROUND TEMPORARY DRAINAGE PIPING DURING CONSTRUCTION. REFER TO CIVIL DRAWINGS FOR ADDITIONAL INFO.
- 13 INSTALL GUTTER WITH DOWNSPOUT ON WEST SIDE OF EXISTING SLOPED ROOF. CONNECT DOWNSPOUT TO TEMPORARY DRAINAGE PIPING DURING CONSTRUCTION.
- 14 CUT EXISTING CONCRETE BEAMS FLUSH WITH EXISTING LOAD BEARING WALL TO PREPARE FOR BUILDING ADDITION. DURING PARTIAL BUILDING REMOVAL STRUCTURAL INTEGRITY OF THE EXISTING WALL NEEDS TO BE MAINTAINED.

**1 DEMO PLAN**  
1/8" = 1'-0"

Project Title: **MCKINLEY CHARTER SCHOOL  
EAU CLAIRE AREA SCHOOL DISTRICT**

Project Location: **1266 MCKINLEY RD  
EAU CLAIRE, WI 54703**

Sheet Title: **REMOVAL PLAN**

HSR Project Number: **17057**

Project Date: **3-8-18**

Drawn By: **HSR**

Key Plan:

**BID DOCUMENTS**

Revisions:

No.	Description	Date
A2	ADDENDUM 2	3-21-18

Graphic Scale: **VARIES**

Last Update: **3/21/2018 9:45:00 AM**

**A090R**



Consultant:

Project Title: **MCKINLEY CHARTER SCHOOL  
EAU CLAIRE AREA SCHOOL DISTRICT**  
Project Location: 1266 MCKINLEY RD  
EAU CLAIRE, WI 54703  
Sheet Title: **FIRST FLOOR**

HSR Project Number: **17057**  
Project Date: **3-8-18**  
Drawn By: **HSR**  
Key Plan:

**BID  
DOCUMENTS**

No.	Description	Date
A1	ADDENDUM 1	3-14-18
A2	ADDENDUM 2	3-21-18

Graphic Scale: **VARIES**


Last Update: **3/21/2018 10:11:48 AM**

**A100R1**


- GENERAL NOTES:**
- SEE ID SHEETS FOR FLOOR AND WALL FINISH LAYOUTS.
  - LOOSE FURNISHINGS EXCEPT AS NOTED SHALL BE PROVIDED AND INSTALLED BY THE OWNER.
  - VERIFY EXACT SIZE AND LOCATION OF ALL MECHANICAL, PLUMB AND ELEC. OPENINGS - GENERAL CONTRACTOR SHALL BE RESPONSIBLE FOR FINISH AT ALL VISIBLE AREAS. ALL OPENINGS SHALL BE SEALED AFTER UTILITY INSTALLATION.
  - PAINT ALL EXPOSED STEEL LINTELS.
  - INSTALL BULLNOSE CMU AT ALL OUTSIDE CORNERS TWO TIE AND AT DOOR JAMBS AS DETAILED. NO BULLNOSE AT WINDOW JAMBS.
  - SEE STRUCTURAL FOR SLAB CONTROL JOINTS AND CMU CONTROL JOINTS IN LOAD BEARING CMU WALLS.
  - SEE THIS PLAN FOR CONTROL JOINTS IN NON-LOAD BEARING CMU WALLS. SEE A501 FOR CONTROL JOINT DETAILS. CJ = CONTROL JOINTS
  - REFER TO CODE PLANS FOR FIRE RATING LOCATIONS AND ACCESSIBILITY ROUTES.
  - EXTEND ALL WALLS TO DECK UNLESS NOTED OTHERWISE. SEE S4400 FOR TOP OF WALL DETAIL.
  - UNLESS NOTED OTHERWISE RESTROOM FLOORS SHALL BE TO A MIN. 1/16" 12" TO FLOOR DRAINS - TO CENTER. IF NO FLOOR DRAINS.
  - SEE A500 FOR TYPICAL HEAD FLASHING ISOMETRIC DETAIL.
  - GEN. CONTRACTOR TO PROVIDE CONC. EQUIP. PADS / CURBS AS REQUIRED FOR MECH / ELECTRICAL EQUIP. - VERIFY SIZE / PROFILE / LOCATION WITH MECH / ELECTRICAL.
  - ALL CASEWORK - BY OWNER. GC TO PROVIDE BLOCKING IN STUD WALLS AS REQUIRED.

- LEGEND:**
- (A) SYMBOL INDICATES WALL TYPE - SEE SHEET A400 FOR WALL TYPE DETAILS.
  - (B) SYMBOL INDICATES WINDOW TYPE. SEE SHEET A600 FOR WINDOW FRAME ELEVATIONS.
  - (C) SYMBOL INDICATES CONSTRUCTION NOTE THIS SHEET
  - 1 HOUR WALL
  - 2 HOUR WALL
  - FEC FIRE EXTINGUISHER CABINET- SURFACE MOUNTED
  - FE FIRE EXTINGUISHER- BRACKET MOUNTED
  - TB 4" X 4" TACKBOARD MOUNTED @ 84" A.F.F. TO TOP CONTRACTOR FURNISHED / INSTALLED
  - MB 4" X 8" WHITEBOARD MOUNTED @ 84" A.F.F. TO TOP CONTRACTOR FURNISHED / INSTALLED


- KEY NOTES PLAN**
- CONCRETE STOOP - SEE STRUCTURAL.
  - LINE OF CANOPY ABOVE.
  - PROVIDE A 1'-0" LONG FULL HEIGHT WALL @ END OF PARTIAL HEIGHT WALL FOR POWER / DATA & TO BRACE WALL - SEE S4200 & S4501
  - ALIGN NEW OPENING WITH EXISTING DOOR LOCATION.
  - RAINWATER LEADER - SEE PLUMBING. ENCLOSE W/ WALL TYPE 'B1'.
  - SLIDING WINDOW.
  - INFILL EXISTING WINDOWS WITH CMU.
  - UTILITY SINK - SEE PLUMBING.
  - LINE OF BULKHEAD ABOVE - SEE S2110
  - CONCRETE FILLED PIPE BOLLARD - SEE S4501
  - EXISTING PIPE TUNNEL BELOW
  - POWER DOOR ACTUATOR PUSH BUTTON
  - EXISTING PIPE TUNNEL ACCESS DOOR
  - NOT USED
  - COMPOSITE WINDOW STOOL - ADHESIVE APPLIED - SEAL PERIMETER
  - STEEL TRASH ENCLOSURE GATES - SEE DETAIL S401
  - INFILL EXISTING CMU WALL AT FORMER HVAC OPENINGS (SEE MECH) PAINT TO MATCH ADJACENT WALL SURFACE
  - 4" HIGH CONCRETE HOUSEKEEPING PADS AT HVAC EQUIPMENT - COORDINATE SIZE AND LOCATION WITH MECH
  - CABINETS AND APPLIANCES (RANGE, REFRIGERATOR AND DISHWASHER) IN BREAK 132 ARE N.I.C. - OCCASION A117.1 SEC. 804 - KITCHENS AND KITCHENETTES ARE REQUIRED TO HAVE ACCESS TO AND COMPLIANT REACH RANGES AT APPLIANCES, WORK SURFACES WHICH ARE COMPLIANT WITH SEC. 802. TURNING SPACE, SINKS WITH A FRONT APPROACH AND STORAGE SPACE ACCESSIBLE AND COMPLIANT WITH REACH RANGES OF SECTIONS 804 AND 808. THOSE SPACES WITH A COOKTOP OR CONVENTIONAL RANGE SHALL BE REQUIRED TO ADDRESS 804.2, 804.3 & 804.4. THE LATTER REQUIRES KNEE CLEARANCE UNDER THE SINK FOR A FRONT APPROACH.
  - RECESSED KNOX BOX (N.I.C.)

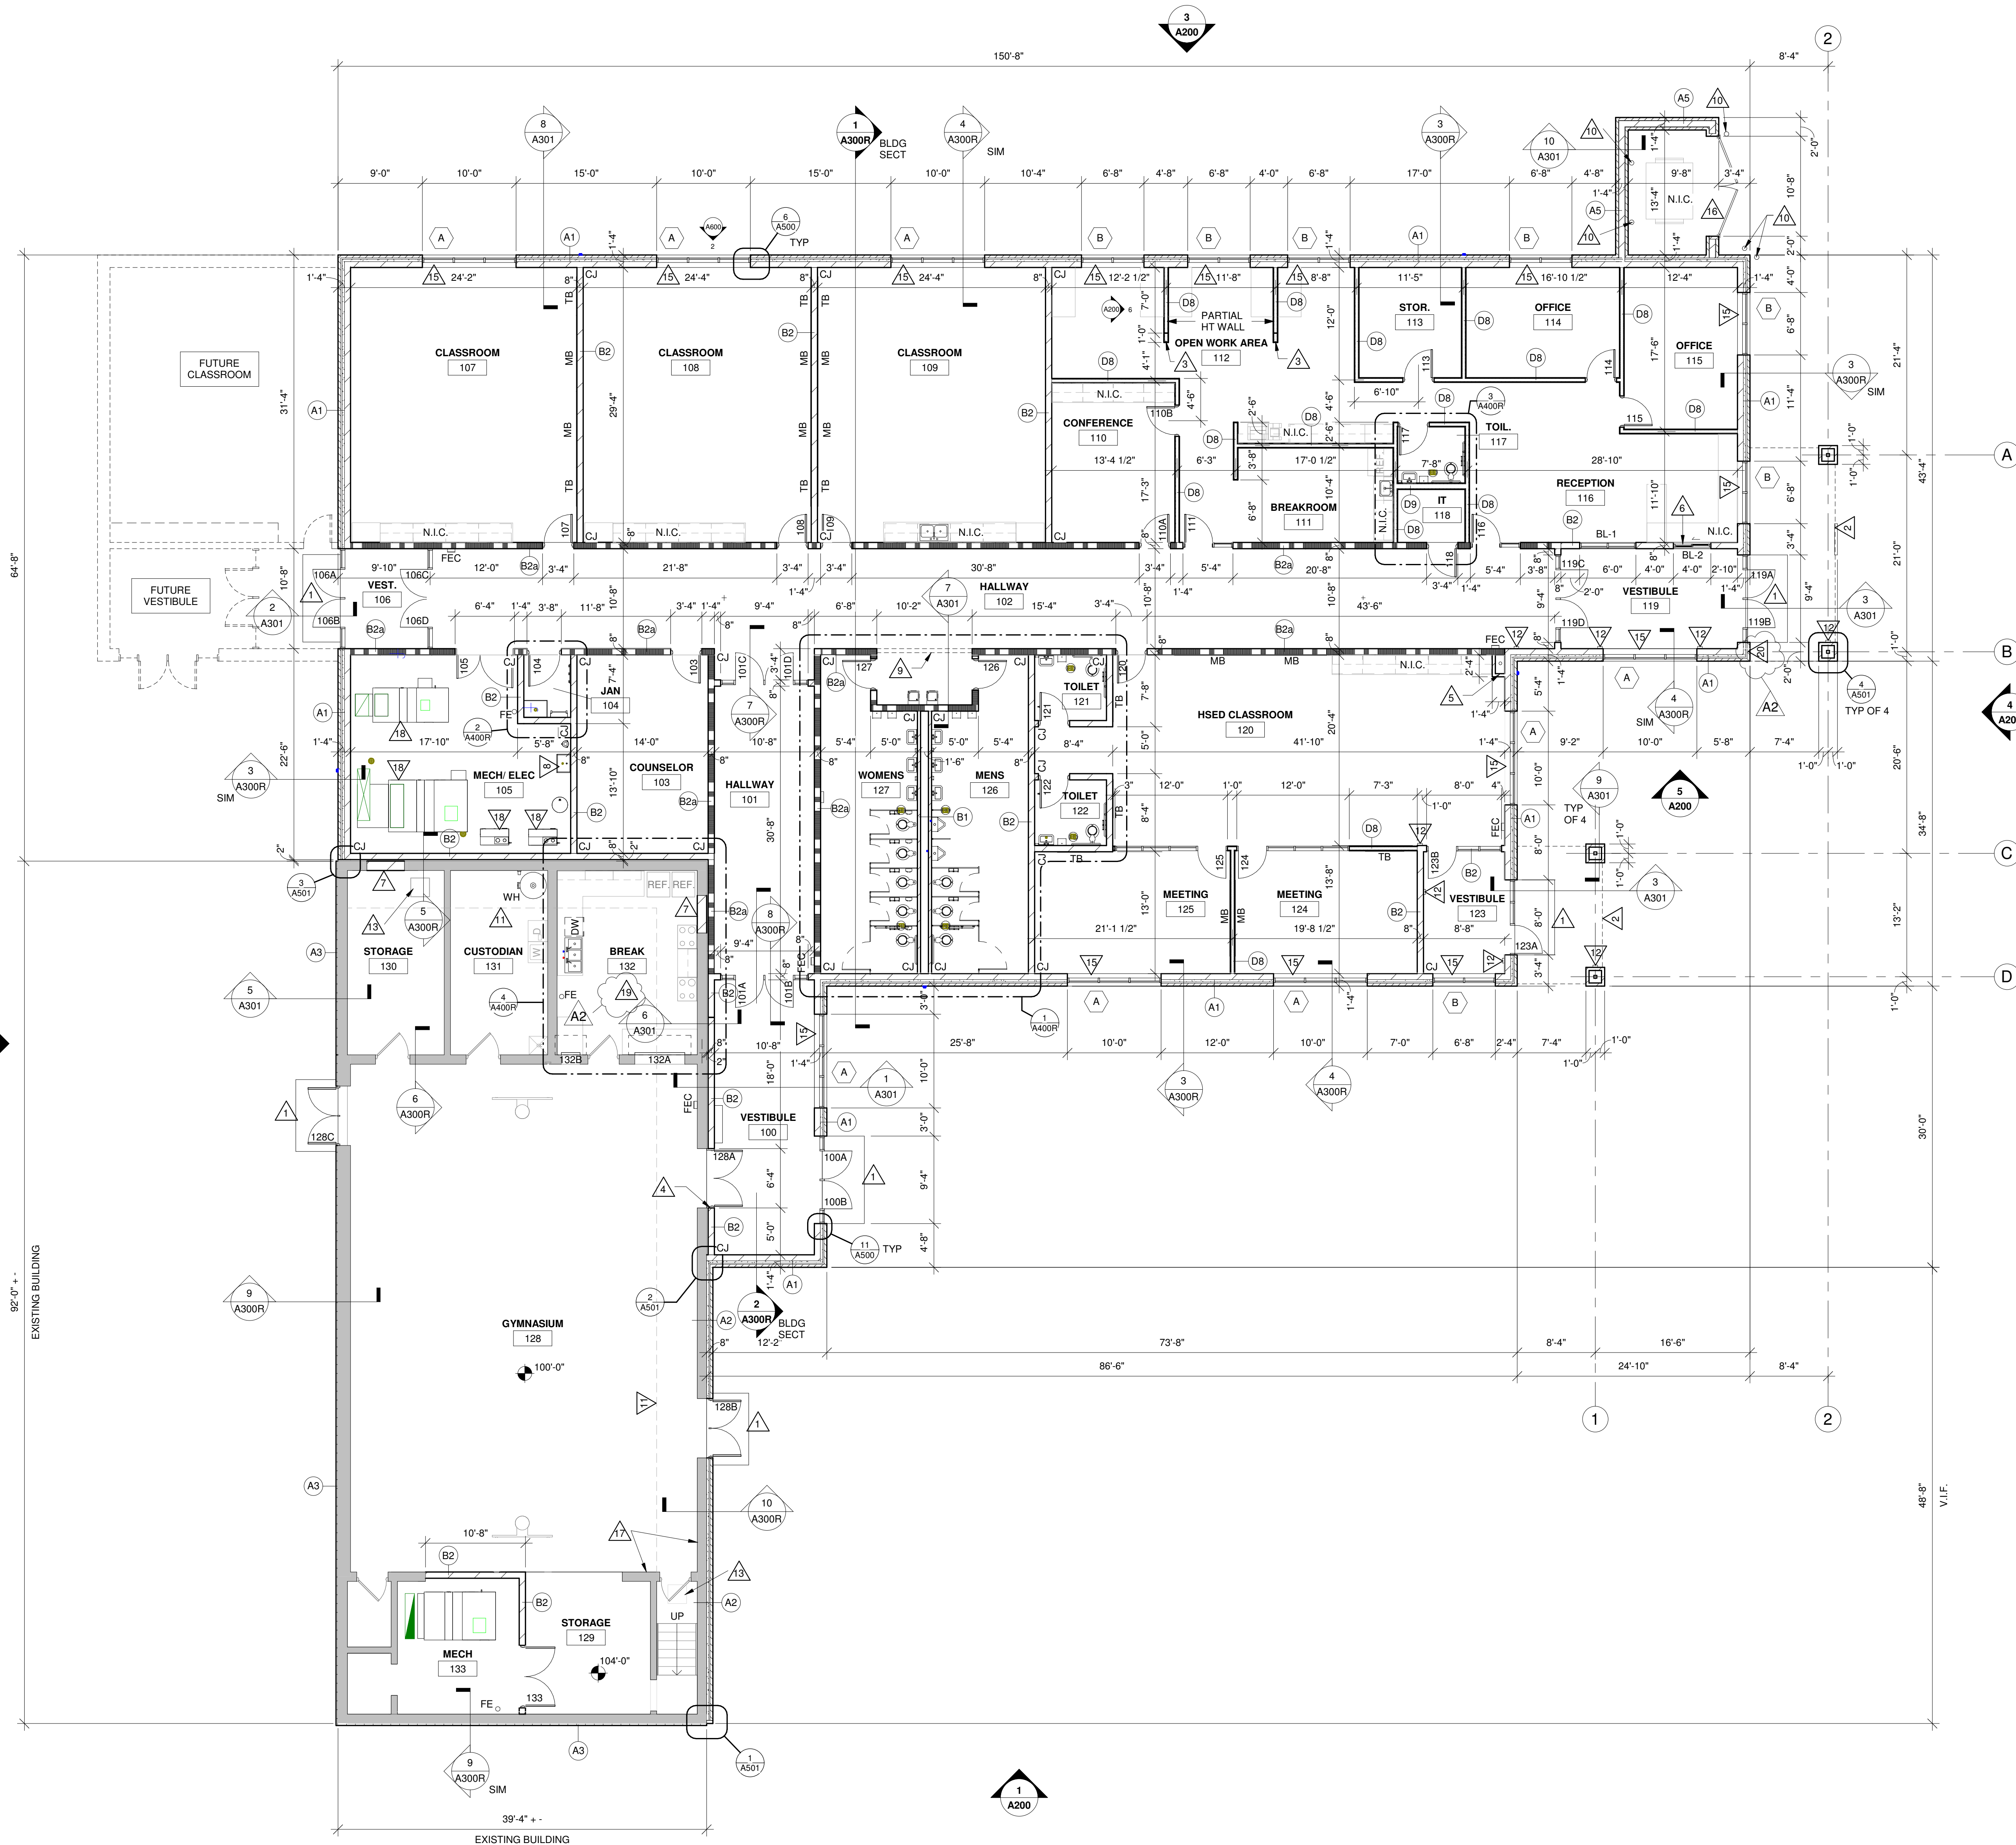

**1 FLOOR PLAN**  
1/8" = 1'-0"

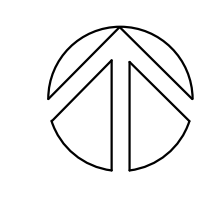



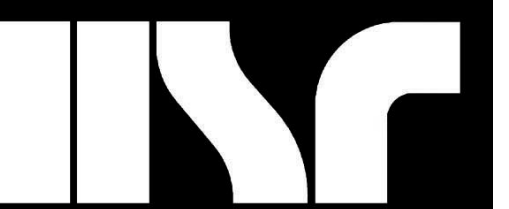

**FOUNDATION PLAN SHEET NOTES**

**A. General**

1. See Cover Sheet for structural sheet index defining sheet name, sheet number and issue status.
2. See Cover Sheet for Structural Abbreviations, Typical Marks & Symbols and Plan Legends.
3. Review General Structural Notes and typical details in conjunction with applicable plans. See sheet index on Cover Sheet.
4. Coordinate stoop sizes and locations with Architectural and Civil. See typical details for stoop construction.
5. If present, coordinate the sizes and locations of tunnels, electrical cells, pits, pipes, floor drains, trenches and floor recesses with Architectural, Structural, Mechanical, Civil, and Electrical drawings.
6. Frost protection is required for all foundations if winter conditions are present.
7. Contractor shall coordinate all embedded items required for precast connections. Embedded items shall be provided by precast supplier and installed by concrete contractor.
8. Dimensions shown with +/- indicate dimensions that have been rounded to the nearest 1/16 of an inch.

**B. Footings**

1. "F-" denotes footing mark. See schedule for size and reinforcing.  
"WF-" denotes wall footing mark. See schedule for size and reinforcing.
2. Top of footing elevation (TFE) is shown on plan. See typical detail sheets for stepped footing detail.
3. Locations of footing steps on plan are approximate. Contractor shall verify all step locations with Civil grade elevations to maintain minimum frost depths and all Mechanical, Electrical and Plumbing pipe elevations prior to pouring footings. Coordinate footing step locations with precaster if applicable. See typical detail sheets for pipes perpendicular and parallel to footing.
4. All footings shall be centered below walls, columns and piers unless dimensioned otherwise.
5. Provide dowels to walls, columns and piers above. Hooked dowels shall be tied to footing reinforcing prior to pouring concrete.

**F. Concrete Piers**

1. "CP-" denotes concrete pier mark. See pier schedule for size and reinforcing.
2. Top of pier elevation (TFE =) is shown on plan.
3. All concrete piers shall be centered on grid intersections unless dimensioned otherwise on plan.

**H. Slab On Grade**

1. Top of slab elevation (TOSL =) is shown on plan.
2. See Architectural drawings for depressions, slab slopes, finishes and drains.
3. Concrete slab thickness shall be as noted on plan. See Architectural drawings for vapor barrier requirements and geotech report for slab sub-base thickness and material specification.
4. Unless noted otherwise, reinforce slab with 3.0 pounds of macro fiber per cubic yard of concrete. Coordinate finishing requirements with owner. Contractor may substitute 6 x 6 - M1.4 x M1.4 WFP chaired in place 1" below top of slab in lieu of macro fiber.
5. Provide control joints (CJ) and construction joints (CONST JT) in slab. See typical foundation details.
6. Concrete Contractor shall submit location of slab construction joints for review three weeks minimum prior to slab pour.

**I. Steel Columns**


1. "SC-" denotes steel column mark. See column schedule for size, base plate and anchor bolt information.
2. All steel columns shall be centered on grid intersections unless dimensioned otherwise on plan.
3. Steel columns, base plates, and anchor bolts below grade exposed to soil shall be coated with two heavy coats of bitumastic paint.

**L. CMU Walls**

1. "CMU-" denotes CMU wall reinforcing mark. See schedule and typical detail sheets for additional reinforcing requirements.
2. See Architectural for masonry control joint spacing. Locate control joints a minimum of 24" from the edges of all openings.
3. See Architectural drawings for non-load bearing CMU wall thickness and locations. See typical detail sheets for non-load bearing CMU details.
4. Coordinate all exterior wall finish ledge elevations for brick, stone, etc. with architectural drawings.

**M. Concrete Walls**


1. See wall schedule for reinforcing. Provide additional reinforcing per typical details.
2. See typical details for concrete wall construction joint spacing requirements.
3. See shear wall elevation sheets and details for reinforcing required.
4. Coordinate all exterior wall finish ledge elevations for brick, stone, etc. with architectural drawings.

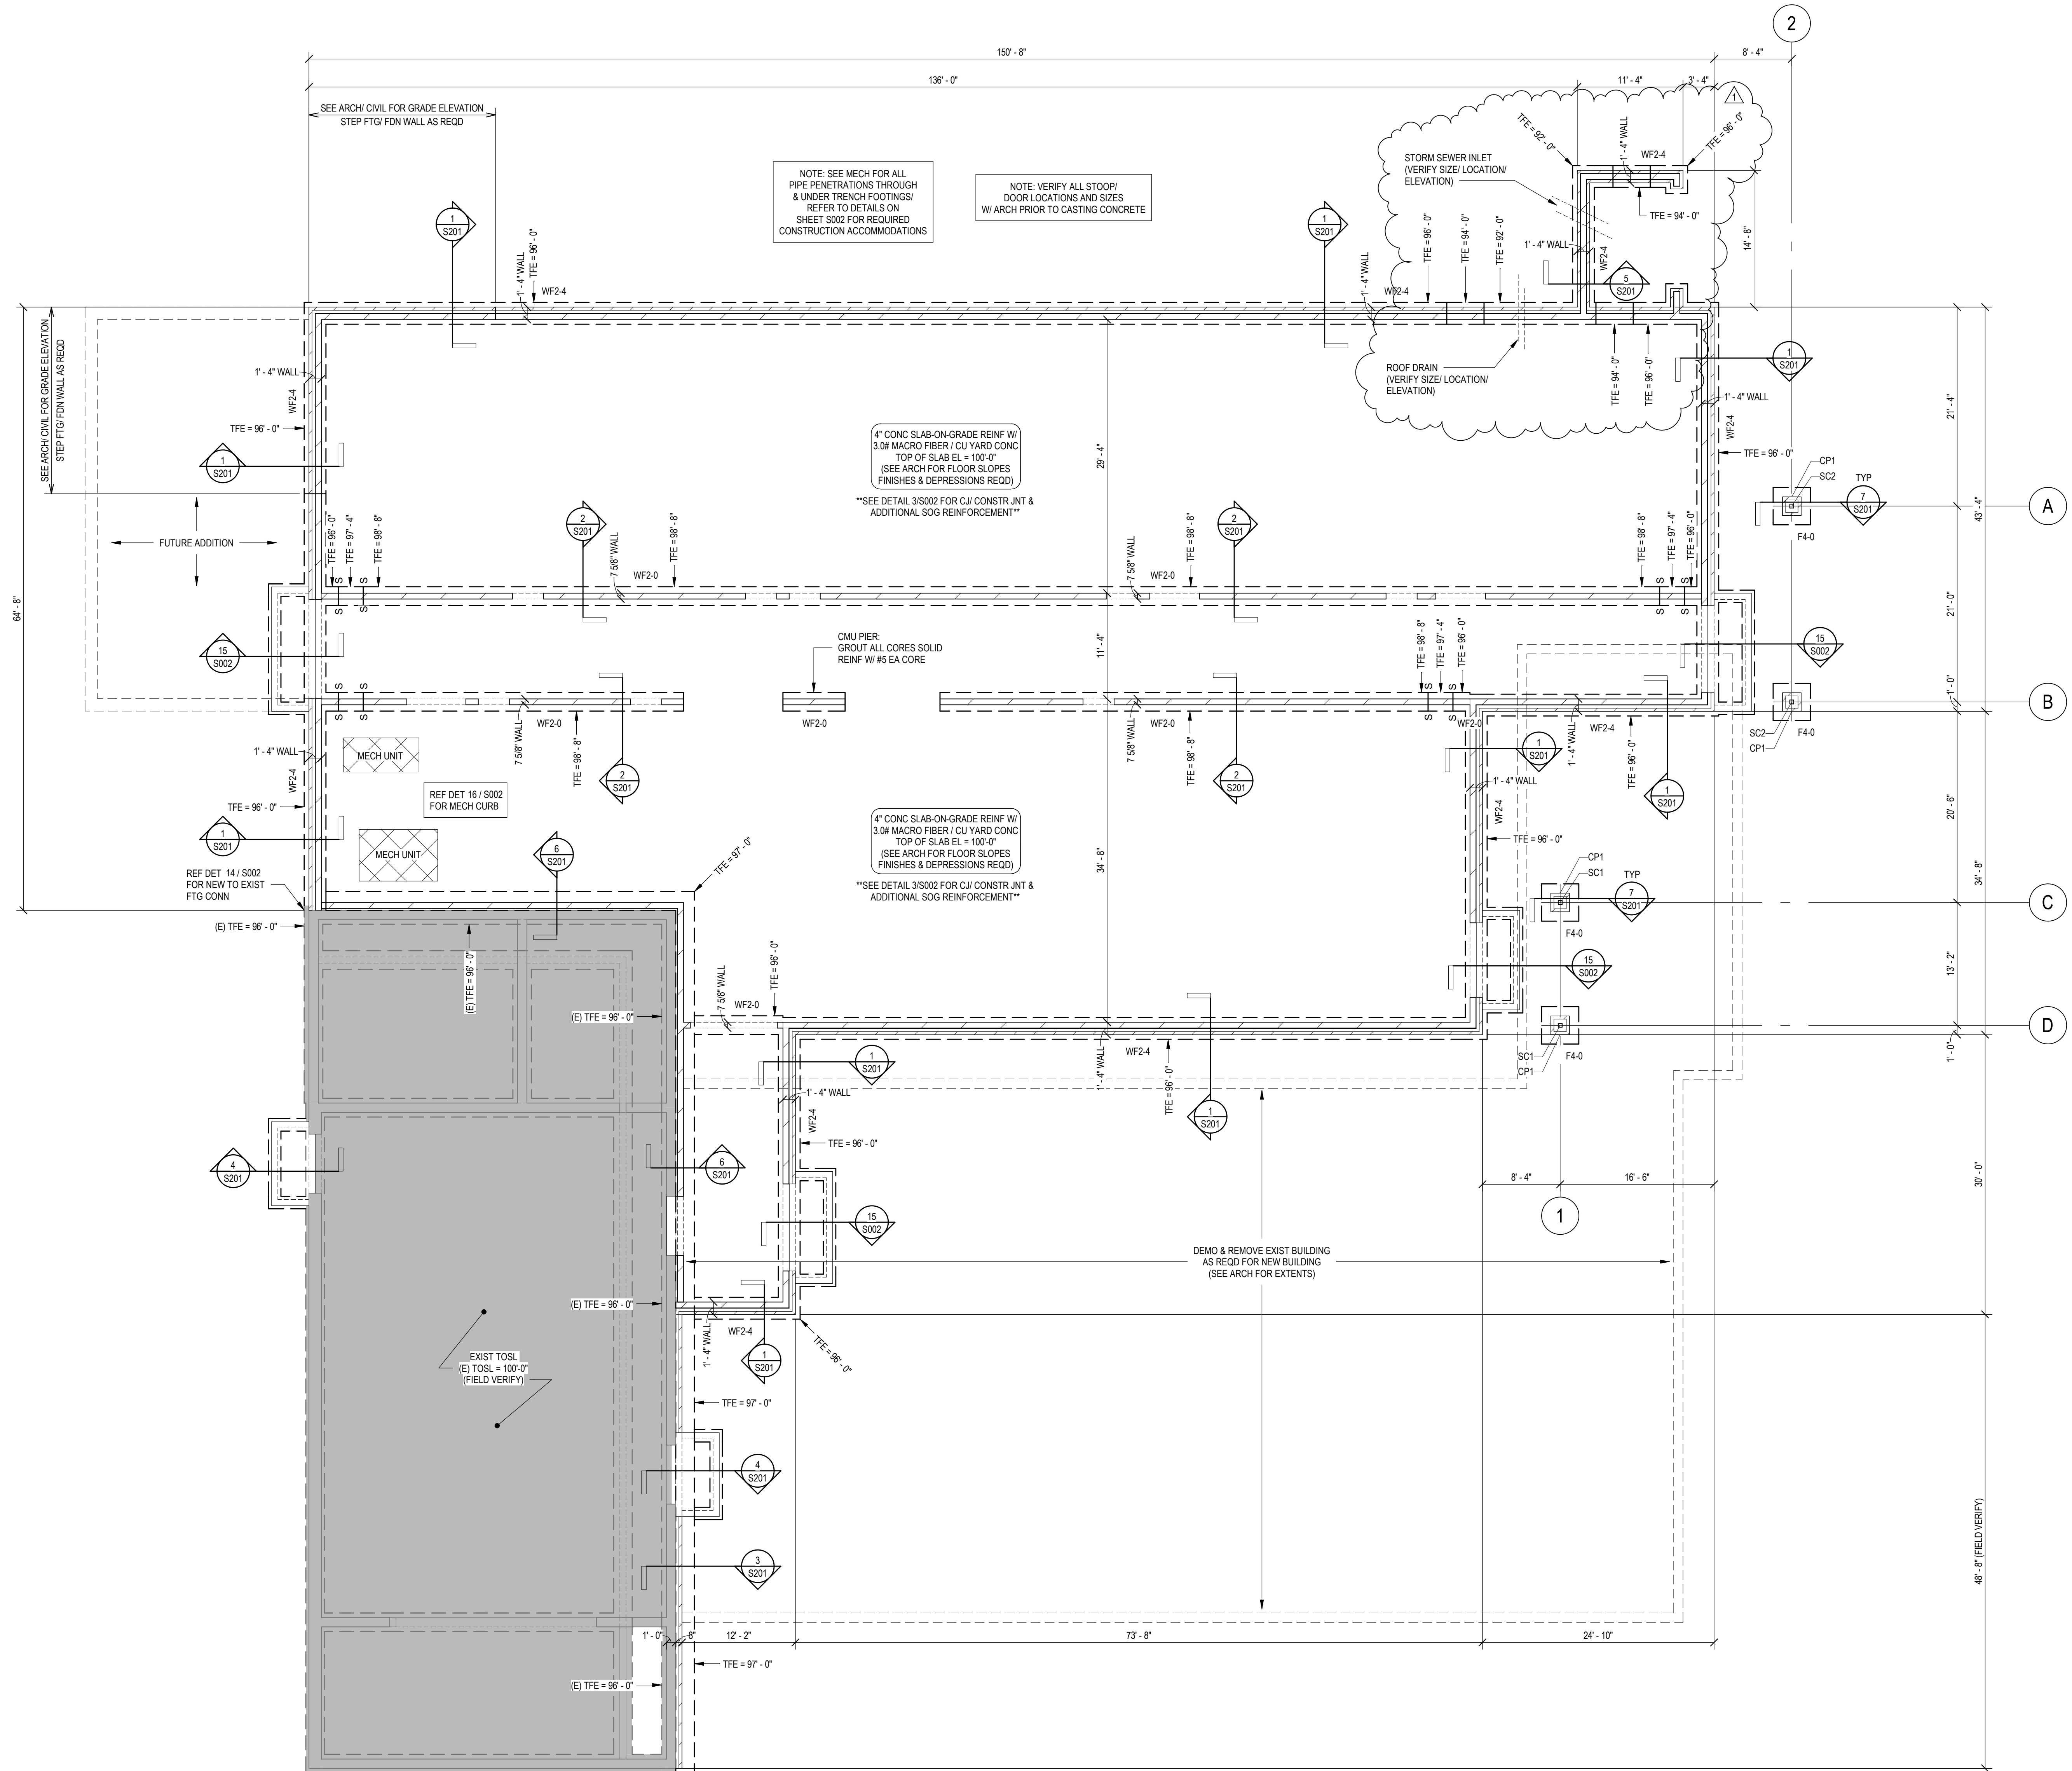


**FOUNDATION PLAN**  
1/8" = 1'-0"

NOTES:  
1. SEE S200 SERIES SHEETS FOR GENERAL STRUCTURAL NOTES, TYPICAL DETAILS, NOTES & SCHEDULES.

INFORMATION ON THIS PLAN REGARDING EXISTING STRUCTURE WAS TAKEN FROM EXISTING CONSTRUCTION DOCUMENTS. ACTUAL FIELD CONDITION MAY VARY FROM WHAT IS SHOWN. ALL DIMENSIONS, ELEVATIONS AND CONDITIONS OF EXISTING STRUCTURE TO BE FIELD VERIFIED PRIOR TO FABRICATION.

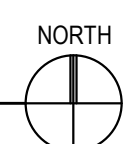



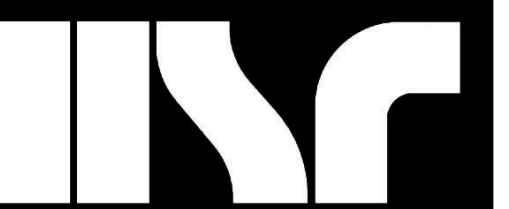


**BID DOCUMENTS**


No.	Description	Date
A2	Revision 2	3-21-2018

Graphic Scale: VARIES  
Last Update: 3/21/2018 10:16:44 AM

**M100R**

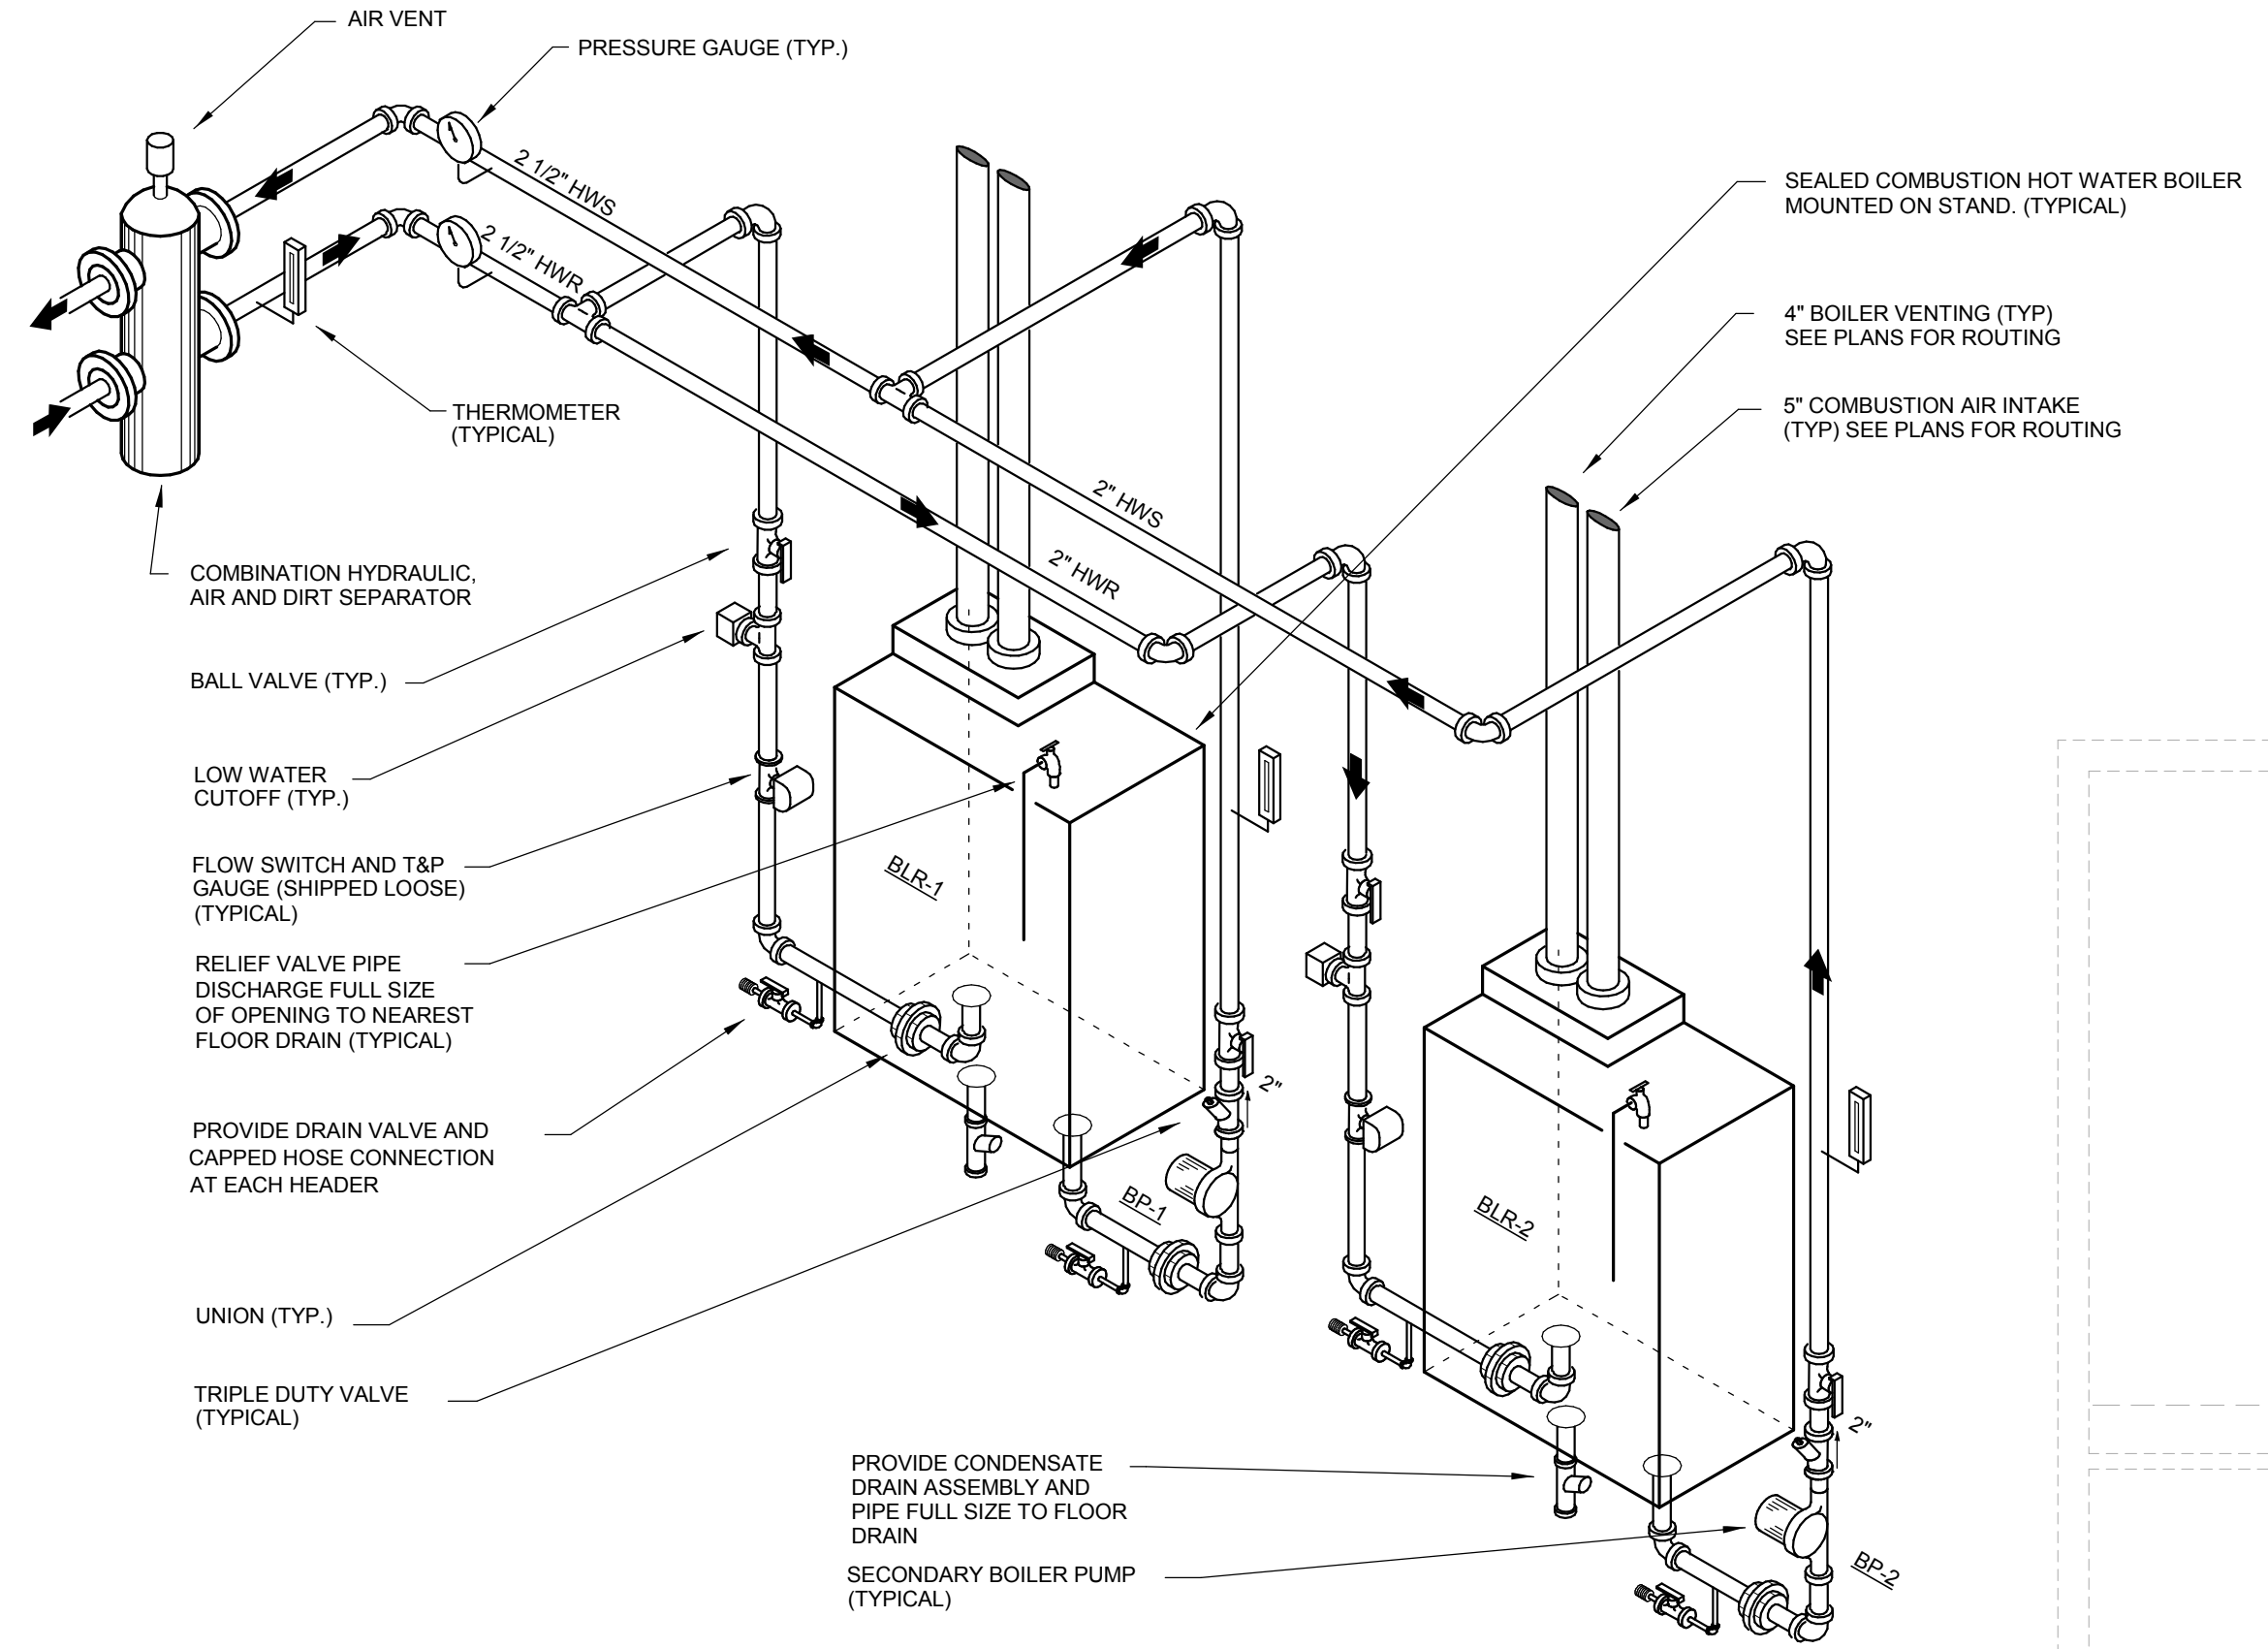

**3 BOILER PIPING ISOMETRIC**  
N.T.S.

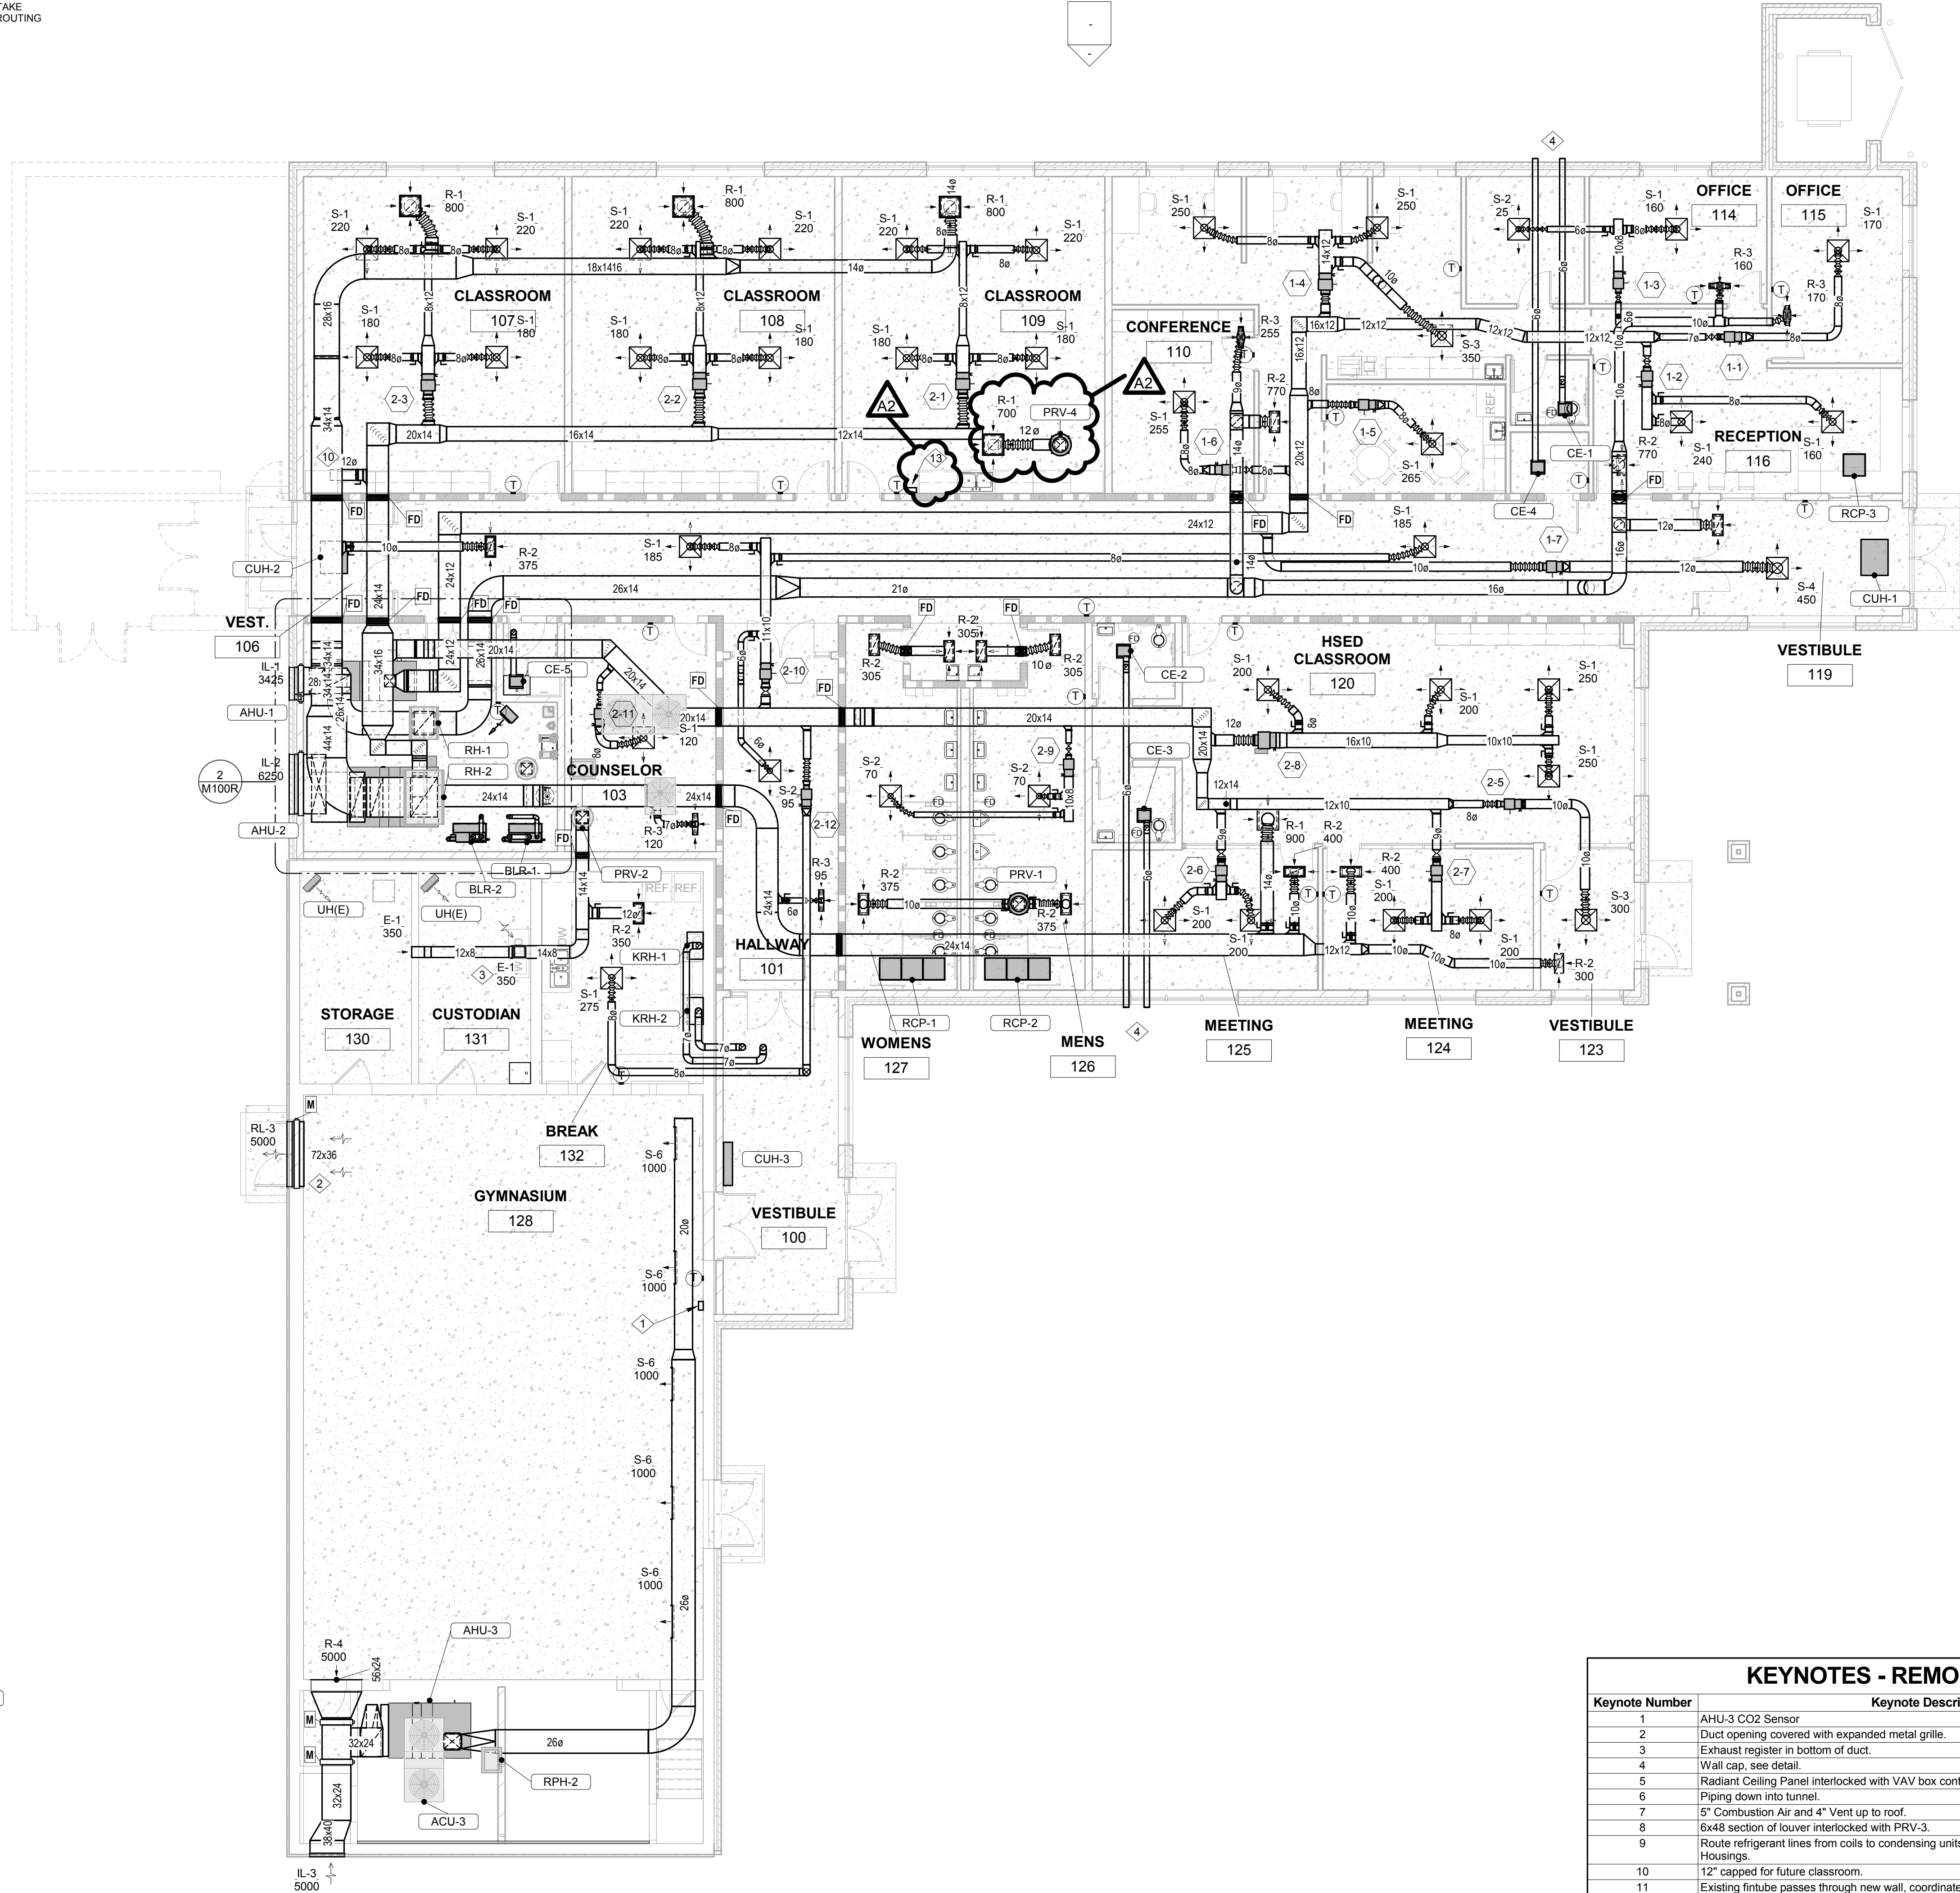

Keynote Number	Keynote Description
1	AHU-3 CO2 Sensor
2	Duct opening covered with expanded metal grille.
3	Exhaust register in bottom of duct.
4	Wall cap, see detail.
5	Radiant Ceiling Panel interlocked with VAV box controls.
6	Piping down into tunnel.
7	5" Combustion Air and 4" Vent up to roof.
8	6x48 section of louver interlocked with PRV-3.
9	Route refrigerant lines from coils to condensing units up through Roof Penetration
10	12" capped for future classroom.
11	Existing fin tube passes through new wall, coordinate with GC.
12	Extend coil condensate drain to outside.
13	PRV-4 speed control switch.

**2 ENLARGED MECHANICAL ROOM PLAN**  
1/4" = 1'-0"

**1 MECHANICAL VENTILATION REMODEL PLAN**  
1/8" = 1'-0"

### AHU WATER HEATING COILS (237500)

MARK	COIL SIZE	UNIT	CFM	MAX. P.D. "	MAX. FV	EAT	LAT	TOT.	30% PG WATER	COIL	ACCESSORIES/	REMARKS			
MARK	MODEL NO.	SERVING	WIDTH	LENG.	YWD.	LENG.	SF	APPL.	CFM	HOOD	THROAT	MAX P.D. "	CONSTR.	ACCESSORIES/	REMARKS
RH-1	Fabra Hood - Gully	AHU-1	22	26	32	36	4.03	RELIEF	2575	609	648	0.06	Aluminum	2, 3, 4, 5	A, B
RH-2	Fabra Hood - Gully	AHU-2	30	44	44	60	9.17	RELIEF	6250	682	682	0.06	Aluminum	2, 3, 4, 5	A, C

Based on products by GREENHECK.  
Equal products by Penn and Cesco are acceptable.  
ACCESSORIES/OPTIONS:  
1. Insect Screen.  
2. Bird Screen and 0.5" Internal Insulation.  
3. 12" Roof Curb.  
4. Motorized damper in throat.  
5. 6" base.

REMARKS:  
A. Color selected by owner.  
B. Approximately 105 lbs.  
C. Approximately 155 lbs.

### RADIANT CEILING PANELS (238101)

MARK	MANUFACTURER'S	MODEL NO.	QUANTITY	PANEL	ROOM	BTUH	MIN.	WATER	ACCESSORIES/	REMARKS		
MARK	MODEL NO.	LOCATION	STYLE	CFM	MBH	EAT	LAT	TEMP	30% PG WATER	COIL	ACCESSORIES/	REMARKS
RCP-1	HPH	3	24"x24"	Regular	70	615	0.5	160	152	0.36	1, 2, 3, 4	A, B
RCP-2	HPH	3	24"x24"	Regular	70	615	0.5	160	152	0.36	1, 2, 3, 4	A, B
RCP-3	HPH	1	24"x24"	Regular	70	615	0.5	160	157	0.12	1, 2, 3, 4	A, B

Based on products by AIRTEK.  
Equal products by Aero-Tech and Sterling are acceptable.  
ACCESSORIES/OPTIONS:  
1. Provide isolation valves, P/T plugs on each circuit.  
2. Provide control valve and calibrated balancing valve on each circuit.  
3. Backs of all panels shall be covered with 1" of 5/8" density fiberglass insulation.  
4. Silkscreen panel to match adjacent acoustic tile.

REMARKS:  
A. Capacity based on perimeter location and 155 deg. F mean water temperature.  
B. See piping detail on plans.

### CABINET HEATER - HOT WATER (238101)

MARK	MANUFACTURER'S	MODEL NO.	LOCATION	STYLE	CFM	MBH	EAT	LAT	TEMP	30% PG WATER	ELECT.	ACCESSORIES/	REMARKS		
MARK	MODEL NO.	LOCATION	STYLE	CFM	MBH	EAT	LAT	TEMP	30% PG WATER	ELECT.	ACCESSORIES/	REMARKS			
CUH-1	FFEB-040	West 110	Horiz. Recessed	338	19.4	70	123	160	134	1.5	5.6	3.1	115/1	1, 3, 4, 5	A, B
CUH-2	FFEB-030	West 106	Horiz. Recessed	193	15.8	70	146	160	144	2	3.3	3.1	115/1	2, 3, 4, 5	A, B
CUH-3	FFBB-060	West 100	Vert. Cabinet	403	28.8	70	136	160	146	4	3.2	3.1	115/1	1, 3, 4, 5	A, B

Based on products by TRANE.  
Equal products by Airtherm and Vulcan are acceptable.  
ACCESSORIES/OPTIONS:  
1. 3-row Hot Water coil.  
2. 4-row Hot Water coil.  
3. Piping Package.  
4. Free Discharge ECM Motor.  
5....

REMARKS:  
A. Sized at high fan speed.  
B. Color selected by Owner.

### UNIT HEATERS - HOT WATER (238101)

MARK	MANUFACTURER'S	MODEL NO.	LOCATION	TYPE	CFM	MBH	EAT	LAT	TEMP	30% PG WATER	ELECT.	ACCESSORIES/	REMARKS	
MARK	MODEL NO.	LOCATION	STYLE	CFM	MBH	EAT	LAT	TEMP	30% PG WATER	ELECT.	ACCESSORIES/	REMARKS		
UH-1	S-18	Mech/Elec 105	Horizontal	500	11.0	60	81	1.5	160	145	2	16	115/1	

Based on products by TRANE.  
Equal products by Sterling and Airtherm are acceptable.  
ACCESSORIES/OPTIONS:  
1.  
2.  
3.

REMARKS:  
A.  
B.

### AIR DISTRIBUTION DEVICES (233713)

MARK	MANUFACTURER'S	MODEL NO.	APPL'N	SIZE (W x H)	MAXIMUM	THROW *	TYPE	CONSTR.	DAMPER	ACCESSORIES/	REMARKS			
MARK	MODEL NO.	LOCATION	STYLE	CFM	MBH	EAT	LAT	TEMP	30% PG WATER	ELECT.	ACCESSORIES/	REMARKS		
S-1	FLC	Supply	8"	24x24	280	0.07	17	6	4-Way	Arch. Ceiling Diff.	Steel	No	1	B
S-2	FLC	Supply	8"	24x24	170	0.05	17	4	4-Way	Arch. Ceiling Diff.	Steel	No	1	B
S-3	FLC	Supply	10"	24x24	420	0.1	19	8	4-Way	Arch. Ceiling Diff.	Steel	No	1	B
S-4	FLC	Supply	12"	24x24	550	0.12	19	10	4-Way	Arch. Ceiling Diff.	Steel	No	1	B
S-5	(not used)													
S-6	DMGDU	Supply	36x8	39x9	1020	0.084	29	32	22.5 Deg	Univ. Spiral Duct	Aluminum	Extractor	1	A, D
R-1	EGC-15	Ret/Exh	22x22	24x24	1600	0.04	21	---	---	Eggrate	Aluminum	No	1, 3	B, C
R-2	EGC-15	R/T/E	22x10	24x12	800	0.05	22	---	---	Eggrate	Aluminum	No	1, 3	B, C
R-3	EGC-15	Return	22x6	24x8	350	0.03	14	---	---	Eggrate	Aluminum	No	1, 3	B, C
R-4	S80	Return	56x24	56x26	5000	0.024	24	---	0 deg. Dnf.	3/4" single deflect.	Steel	No	1	A
E-1	EGC-15	Exhaust	12x12	14x14	530	0.05	18	---	---	Eggrate	Aluminum	Yes	1, 3	A

Based on products by KRUEGER.  
Equal products by Titus and PRICE are acceptable.  
ACCESSORIES/OPTIONS:  
1. Standard White Finish.  
2. Aluminum Finish.  
3. Plenum with bellmouth takeoff, see detail.  
4. Universal edgcap with foam seals.

REMARKS:  
A. Surface Mounted.  
B. T-bar lay-in.  
C. Plenum with bellmouth takeoff, see detail.  
D. Universal edgcap with foam seals.

### ROOF HOODS (233723)

MARK	MANUFACTURER'S	MODEL NO.	SERVING	WIDTH	LENG.	YWD.	LENG.	SF	APPL.	CFM	HOOD	THROAT	MAX P.D. "	CONSTR.	ACCESSORIES/	REMARKS
RH-1	Fabra Hood - Gully	AHU-1	22	26	32	36	4.03	RELIEF	2575	609	648	0.06	Aluminum	2, 3, 4, 5	A, B	
RH-2	Fabra Hood - Gully	AHU-2	30	44	44	60	9.17	RELIEF	6250	682	682	0.06	Aluminum	2, 3, 4, 5	A, C	

Based on products by GREENHECK.  
Equal products by Penn and Cesco are acceptable.  
ACCESSORIES/OPTIONS:  
1. Insect Screen.  
2. Bird Screen and 0.5" Internal Insulation.  
3. 12" Roof Curb.  
4. Motorized damper in throat.  
5. 6" base.

REMARKS:  
A. Color selected by owner.  
B. Approximately 105 lbs.  
C. Approximately 155 lbs.

### WALL LOUVERS (233101)

MARK	MANUFACTURER'S	MODEL NO.	SERVING	WIDTH	HGT.	DEPTH	SQ FT	APPL.	CFM	MAX P.D. "	CONSTR.	ACCESSORIES/	REMARKS
IL-1	ESD-635	AHU-1 & PRV-3	36	48	6	6.91	Intake	3425	0.04	Aluminum	1, 3, 4, 5	A, B	
IL-2	ESD-635	AHU-2	66	48	6	12.84	Intake	6250	0.04	Aluminum	1, 3, 4, 5	A	
IL-3	ESD-435	AHU-3	38	40	4	5.60	Intake	5000	0.04	Aluminum	1, 3, 4, 5	A	
RL-3	ESD-635	AHU-3	72	36	6	10.14	Relief	5000	0.03	Aluminum	1, 3, 4, 5	A	

Based on products by GREENHECK.  
Equal products by American Warning and Ventilating, Arrow and Cesco are acceptable.  
ACCESSORIES/OPTIONS:  
1. Bird Screen.  
2. Flange Frame  
3. Channel Frame  
4. Baked enamel finish  
5. Weather proof with downspouts and gutters.

REMARKS:  
A. Color selected by owner.  
B. 30x48 serves AHU-1, 6x48 serves PRV-3.

### KITCHEN RANGE HOODS - RESIDENTIAL (233813)

MARK	MANUFACTURER'S	CFM	SONES	TYPE	LOCATION	DIST. ABOVE SURFACE	DIMENSIONS	EXHAUST	ACCESSORIES/	REMARKS		
MARK	MODEL NO.	LOCATION	STYLE	CFM	MBH	EAT	LAT	TEMP	30% PG WATER	ELECT.	ACCESSORIES/	REMARKS
KRH-1	Braun EVOLUTION QP130SS	110/300	0.8/5	Under Cab.	Break Room 132	30"	6-3/4" x 20-1/8" x 7" Dia.	1 thru 5	5	A		
KRH-2	Braun EVOLUTION QP130SS	110/300	0.8/5	Under Cab.	Break Room 132	30"	6-3/4" x 20-1/8" x 7" Dia.	1 thru 5	5	A		

Based on products by BROAN.  
Equal products by Broan and Vulcan are acceptable.  
ACCESSORIES/OPTIONS:  
1. Stainless Steel Construction.  
2. Four 35W Halogen lamps, two-level control.  
3. Aluminum micro-mesh filters filters.  
4. Two speed fan.  
5. Ducted / non-ducted convertible.

REMARKS:  
A. Single fan, 120V/1 2.3 amps.

### BOILERS - HIGH EFFICIENCY (235233)

MARK	MANUFACTURER	TOTAL MBH	MINIMUM	% EFF	PIPE CONN. SIZE	VENT SIZE	GAS PRESSURE	ACCESS/	REMARKS		
MARK	MODEL NO.	INPUT	OUTPUT	GPM * RET. TEMP.	EFF	SUP. RET.	Intake Exhaust	Min. Max.	TYPE	OPTIONS	REMARKS
BLR-1	CM-500	500.0	460.0	31	92	1-1/2"	1-1/2"	5" 4" 4"	6"	14"	A, B, C
BLR-2	CM-500	500.0	460.0	31	92	1-1/2"	1-1/2"	5" 4" 4"	6"	14"	A, B, C

Based on products by PK MACH.  
Equal products by other manufacturers are acceptable.  
ACCESSORIES/OPTIONS:  
1. ASME Boiler Certification.  
2. Flow Switch  
3. Temperature/Pressure gauge.

REMARKS:  
A. Burner gas train and control wiring shall be the responsibility of the Mechanical Contr.  
B. 120V, 15 amp electrical power required.  
C. Operating weight 313 Lbs. 1.58 gallon water content.

### AIR COOLED CONDENSING UNITS (236213)

MARK	MODEL No.	SERVING SYSTEM	TOTAL MBH	MAX. SST	O.A.T. TEMP.	STEPS/ SPEEDS	NO. COMP	REFRIG TYPE	MIN. EER	ELECT. KW	MCA	VOL/TPH	ACCESSORIES/	REMARKS
ACU-1	TTA-073	AHU-1	77	45	95	2	2	R-410a	12.5	24	208/3	1 thru 8	A, B, C, F	
ACU-2	TTA-240	AHU-2	256	45	95	2	2	R-410a	12.1	98	208/3	1 thru 8	A, B, D, F	
ACU-3	TTA-240	AHU-3	256	42	95	2	2	R-410a	12.1	98	208/3	1 thru 8	A, B, E, G	

Based on products by TRANE.  
Equal products by Aeon, Daikin and Carrier are acceptable.  
ACCESSORIES/OPTIONS:  
1. (not used)  
2. Time delay timer on compressor start.  
3. Low ambient kit to allow operation down to 45 deg.  
4. Refrigerant line set.  
5. Refrigerant service valves, high and low pressure switches.  
6. Condenser coil half guard.  
7. Route refrigerant circuit piping up through roof through RPH-1.  
8. Separate insulated compressor compartment.

REMARKS:  
A. Unit mounted on equipment rails on roof.  
B. System IER 11.1, MOP 125 A weight 762 lb.  
C. System IER 11.1, MOP 125 A weight 762 lb.  
D. System IER 11.1, MOP 125 A weight 762 lb.  
E. System IER 11.1, MOP 125 A weight 762 lb.  
F. Route refrigerant circuit piping up through roof through RPH-1.  
G. Route refrigerant circuit piping up through roof through RPH-2.

### CENTRAL STATION AIR HANDLING UNITS (237323)

MARK	MANUFACTURER'S	MODEL NO.	LOCATION	CFM	EXT S.P.	% O.A.	FAN RPM	SIZE	TYPE	DRIVE	COILS	MOTOR HP	VOL/TPH	ACCESSORIES/	REMARKS
AHU-1	CSAA-06	Office Area	2575	2	14	1761	10"	FC	Belt	HC-1	DX-1	3	208/3	1, 2, 3, 4, 5	A
AHU-2	CSAA-12	Classrooms	6250	2	28	2399	15"	AF	Belt	HC-2	DX-2	7 1/2	208/3	1, 2, 3, 4, 5	B
AHU-3	CSAA-10	Gym	5000	1.5	46	1362	15"	FC	Belt	HC-3	DX-3	7 1/2	208/3	1, 2, 3, 5	C

Based on products by TRANE.  
Equal products from other manufacturers are acceptable.  
ACCESSORIES/OPTIONS:  
1. Angled filter section with 2" pleated 95% filters.  
2. Mixing box section, opposed blade dampers less actuator.  
3. Coil and access section.  
4. VAV fan with VFD shipped loose for field mounting.  
5. Disconnect.

REMARKS:  
A. Vertical Unit, fan discharge - Top Back, 18.0 MCA, Fuse size 30 A.  
B. Vertical Unit, fan discharge - Top Back, 35 MCA, Fuse size 60 A.  
C. Vertical Unit, fan discharge - Top Back, 28 MCA, Fuse size 50 A.

### AHU DX COOLING COILS (237500)

MARK	COIL SIZE	AIR UNIT	COND. UNIT	CFM	MAX. PD "	MAX. FV	EAT	LAT	TEMP	30% PG WATER	ELECT.	ACCESSORIES/	REMARKS					
MARK	MODEL NO.	LOCATION	STYLE	CFM	MBH	EAT	LAT	TEMP	30% PG WATER	ELECT.	ACCESSORIES/	REMARKS						
DX-1	26" x 34"	AHU-1	ACU-1	2575	0.412	426	77.0	64.7	56.2	54.9	76.2	88.68	R-410a	45	115	3F	113	4
DX-2	32" x 60"	AHU-2	ACU-2	6250	0.488	516	78.9	66.4	56.5	54.8	223.3	155.57	R-410a	45	115	3F	99	4
DX-3	26" x 50"	AHU-3	ACU-3	5000	0.648	514	79.3	66.7	53.8	52.8	210.7	140.05	R-410a	45	115	3F	88	4

Based on products by TRANE.  
Equal products from other manufacturers are acceptable.  
ACCESSORIES/OPTIONS:  
1.  
2.  
3.

REMARKS:  
A.  
B.

Entering Air Temps. are based on:  
DB WB  
RAT 75 63  
OAT 89 75

### EXPANSION TANK SYSTEMS (232117)

MARK	SYSTEM	APPROX. SYS. VOL. GAL.	SYSTEM TEMP.	PSIG	MAX. PRESS.	MIN. VOL. TANK	RELIEF VALVE	MAX. TANK	ACCEPT. GAL.	AIR SEPARATOR	PIPE SIZE	REMARKS	
ETS-1	Heating	300	60	140	15.5	12	30	33.5	25.8	12	3"	90	1

Based on products by BELL & GOSSETT and CALEFFI.  
Equal tanks by WESSELS, ARMSTRONG, TACO or AMTROL are acceptable.  
Equal air separators by TACO, ARMSTRONG, WESSELS or SPIROVERE are acceptable.  
REMARKS:  
1. Bladder Type Expansion Tank B&G Model # B-130LA. Tank to include: charging valve and drain. ASME with replaceable bladder. Caleffi 549 HYDICAL combination hydraulic, air and dirt separator. Automatic air release valve, drain valve and insulation.

### GLYCOL SYSTEM FEEDERS (232123)

MARK	MODEL No.	SYSTEM	CIRC. FLUID	FREE FLOW	GPM @ 50 PSI	MAX. TEMP	TANK SIZE	ELECTRICAL	OPTIONS/	REMARKS	
GFS-1	MF300	Heating Water	30% P.G.	0.7			17 Gallon	50	110/1	1 thru 6	A, B

Based on products by AXIOM.  
Equal products by Wessels, J.L. Wingert and Neptune are acceptable.  
OPTIONS/ACCESSORIES:  
1. Pump suction hose with strainer.  
2. Pressure pump with thermal cut-out.  
3. Integral pressure switch and check valve.  
4. Adjustable pressure regulating valve.  
5. Pre-charged accumulator tank with EPDM diaphragm.  
6. Pressure gauge and pressure switch with dry contact.

REMARKS:  
A. High impact polystyrene mixing and storage tank and lid.  
B. 3-prong plug and cord.

### HVAC PUMPS (232123)


MARK	MODEL NO.	SYSTEM	TYPE	CIRCULATING FLUID
------	-----------	--------	------	-------------------







HSR ASSOCIATES INC.  
100 MILWAUKEE STREET  
LA CROSSE, WISCONSIN  
PHONE: 608.784.1830  
FAX: 608.782.5844  
WEB SITE: www.hsrasociates.com  
Consultant:

CONSTRUCTION NOTES: REMODEL

- GENERAL NOTES:**
- ALL ELECTRICAL DEVICES SHOWN TO BE NEW, UNLESS INDICATED OTHERWISE.
  - PROVIDE FIRE STOPPING AND SMOKE DRAFT STOPPING AT ALL CONDUIT PENETRATIONS. REFER TO SPECIFICATION SECTION 07840 FOR FIRE RESISTIVE AND NON-FIRE RESISTIVE ASSEMBLIES.
  - PROVIDE SEPARATE NEUTRAL CONDUCTORS FOR EACH BRANCH CIRCUIT. (NO COMMON NEUTRALS)
  - PROVIDE GROUND CONDUCTOR IN ALL NEW CONDUITS.
- SPECIFIC NOTES:**
- STEP DIMMING LIGHT FIXTURE TO BE ACTIVATED BY KEY SWITCH TO 40% OUTPUT. TOGGLE SWITCH TO ACTIVATE LIGHT FIXTURE TO 100% LIGHT OUTPUT (TYPICAL).
  - ROOM OCCUPANCY SENSOR TO CONTROL ROOM LIGHTING: TYPE "C" FIXTURES TO TURN ON AND OFF AT 100%; TYPE "CE" FIXTURE TO REMAIN AT 40% DURING UNOCCUPIED TIMES.
  - INTERLOCK ROOM OCCUPANCY SENSORS SO THAT EITHER ONE MAINTAIN BRANCH CIRCUIT TO LIGHT SWITCHES.
  - PROVIDE 2 POLE RELAY TO CONTROL BOTH LIGHTS CIRCUITS IN ROOM VIA LIGHTING OCCUPANCY SENSORS.

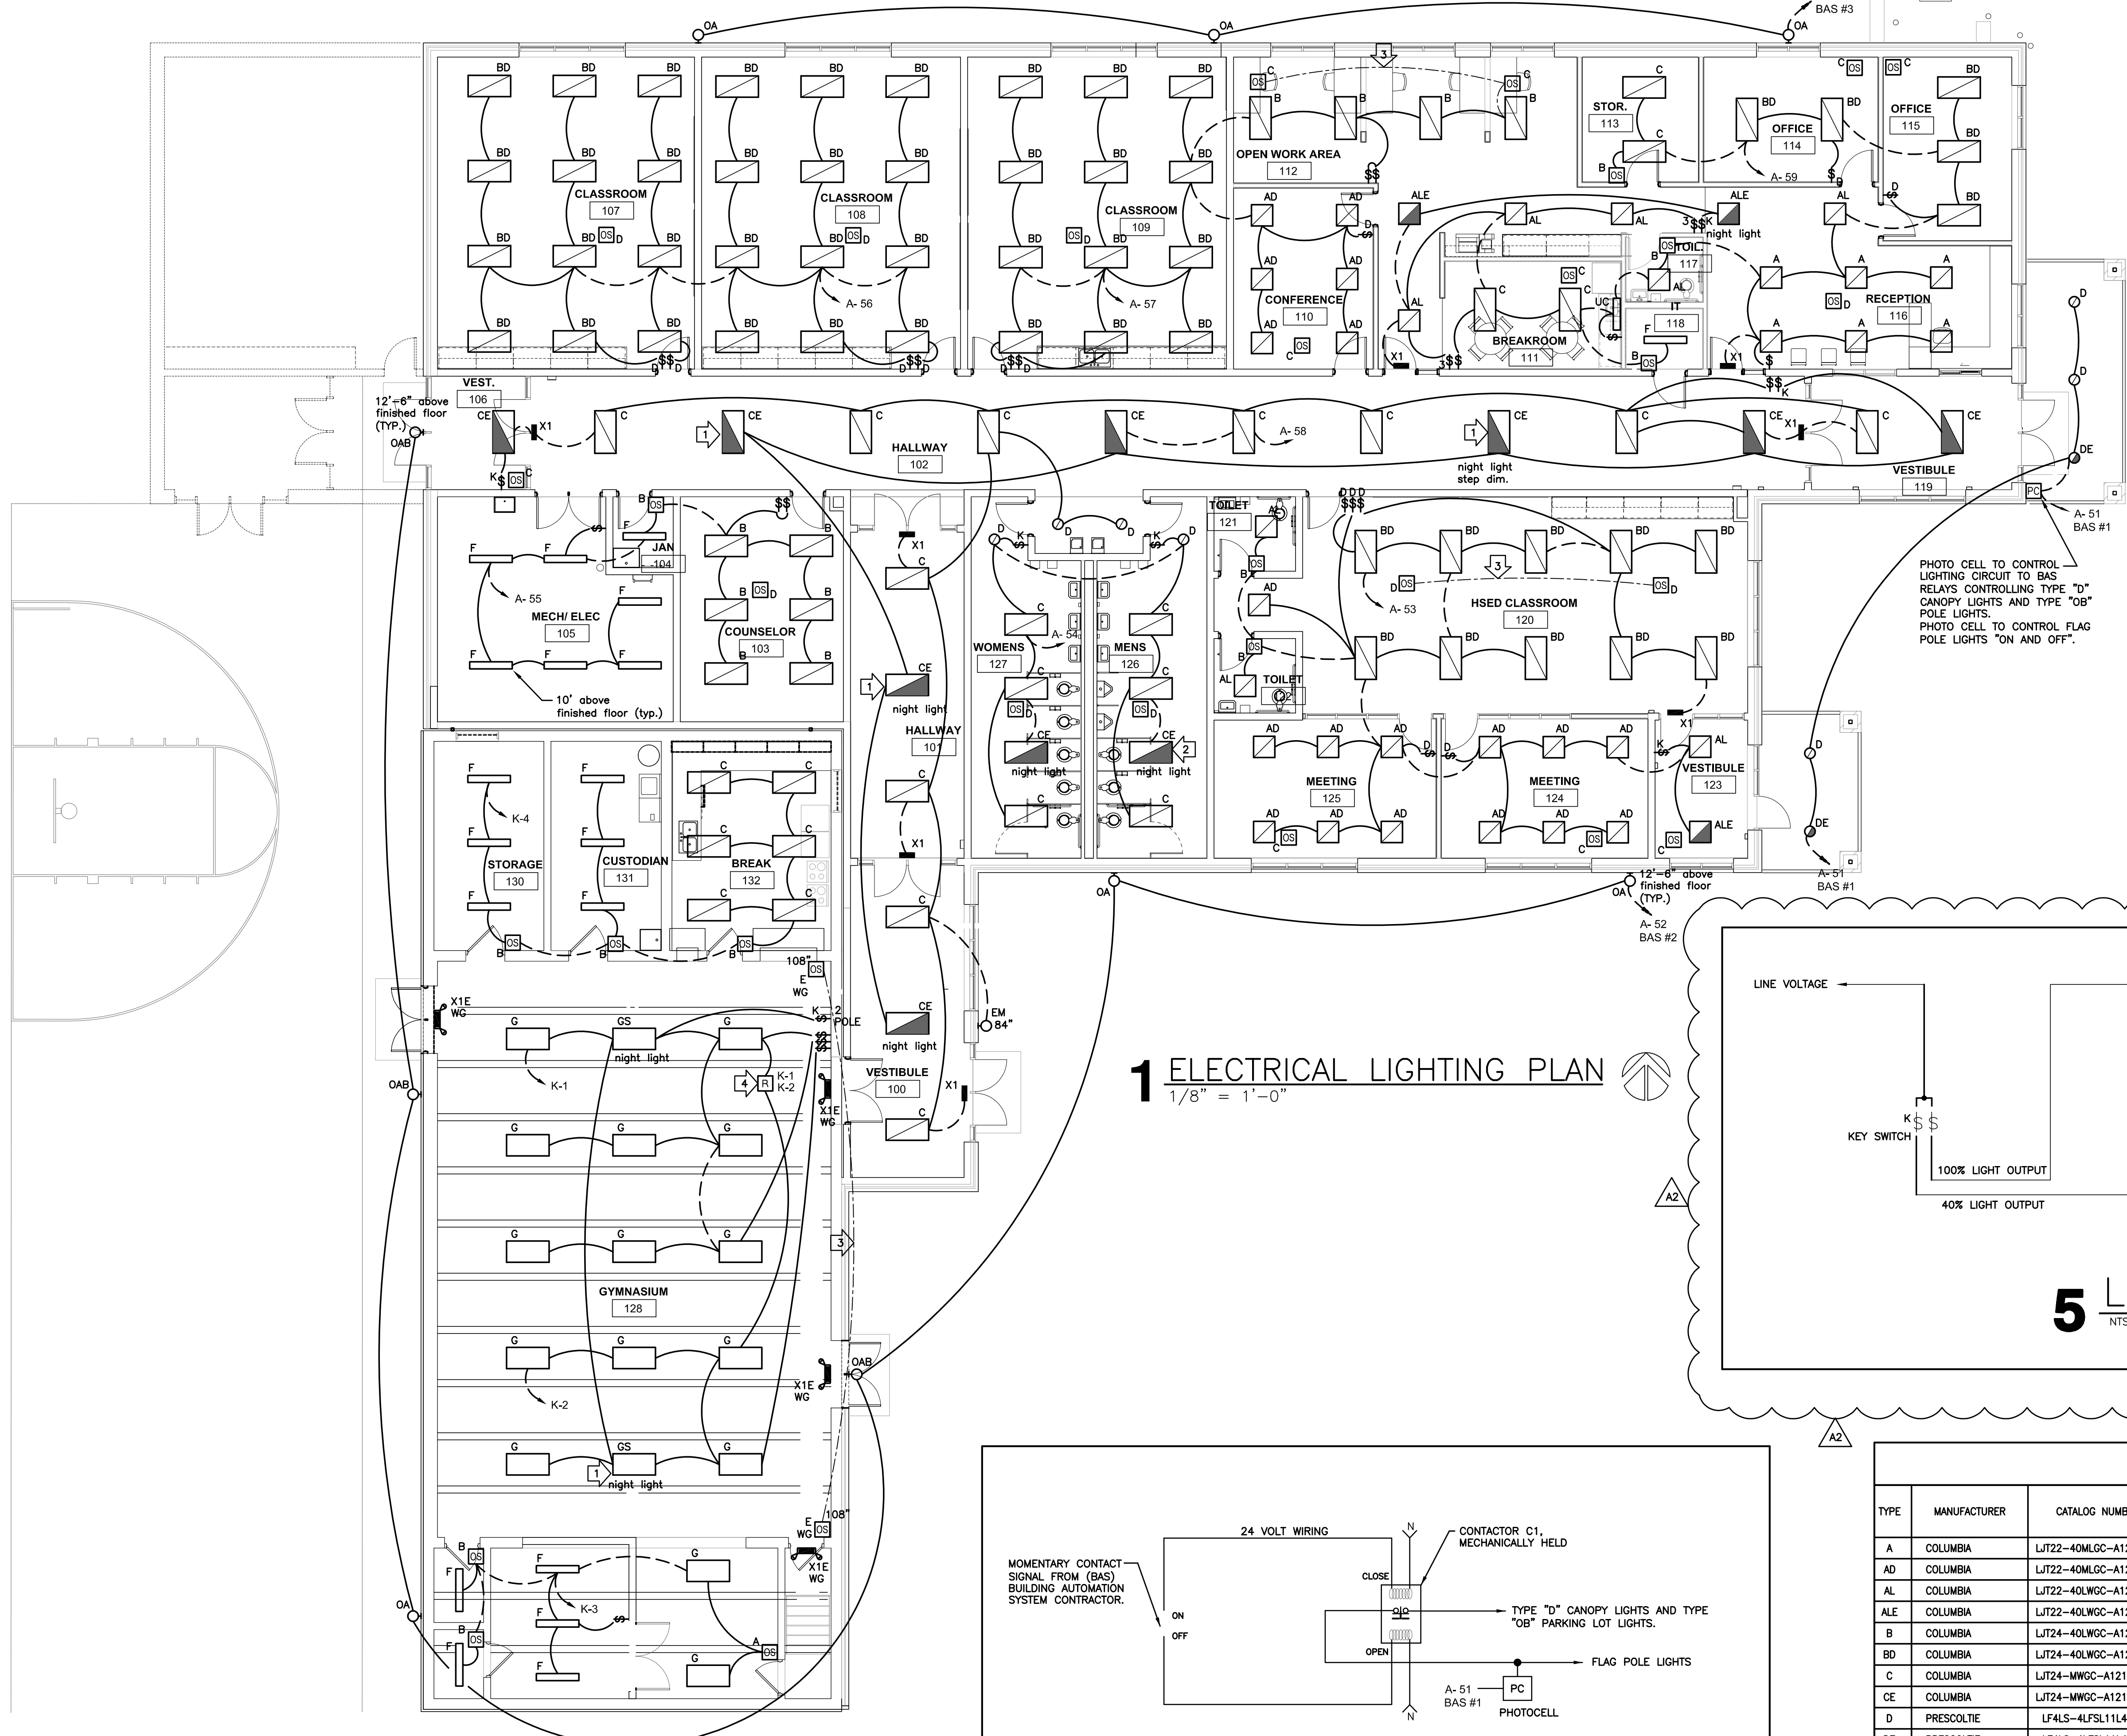

**1 ELECTRICAL LIGHTING PLAN**  
1/8" = 1'-0"

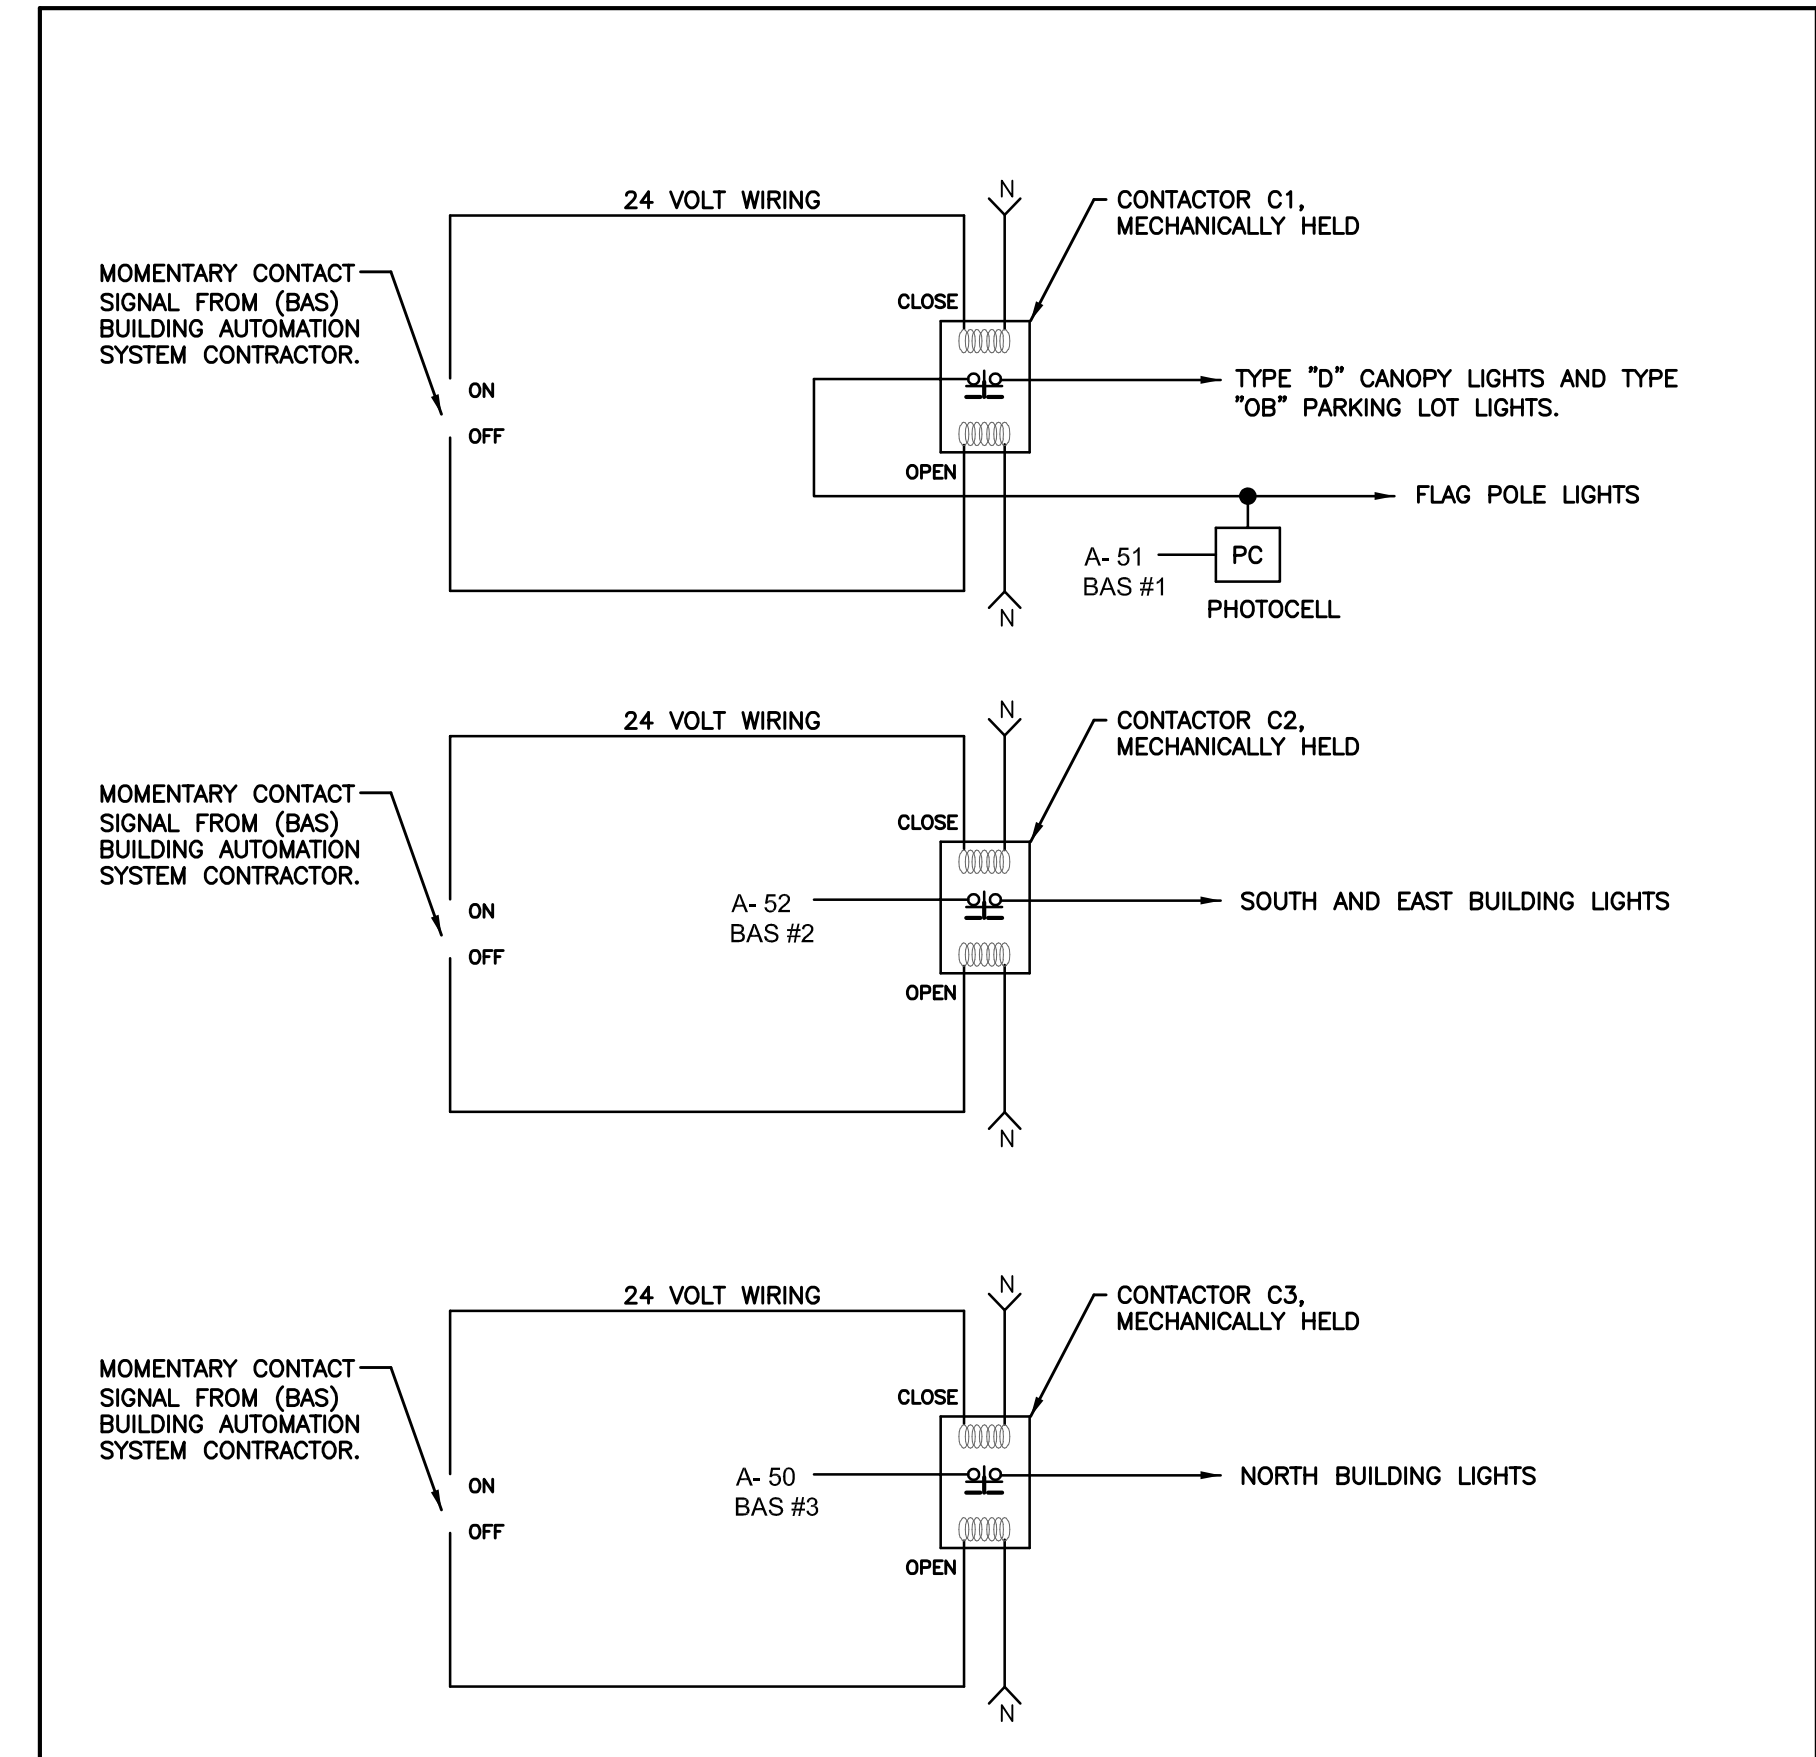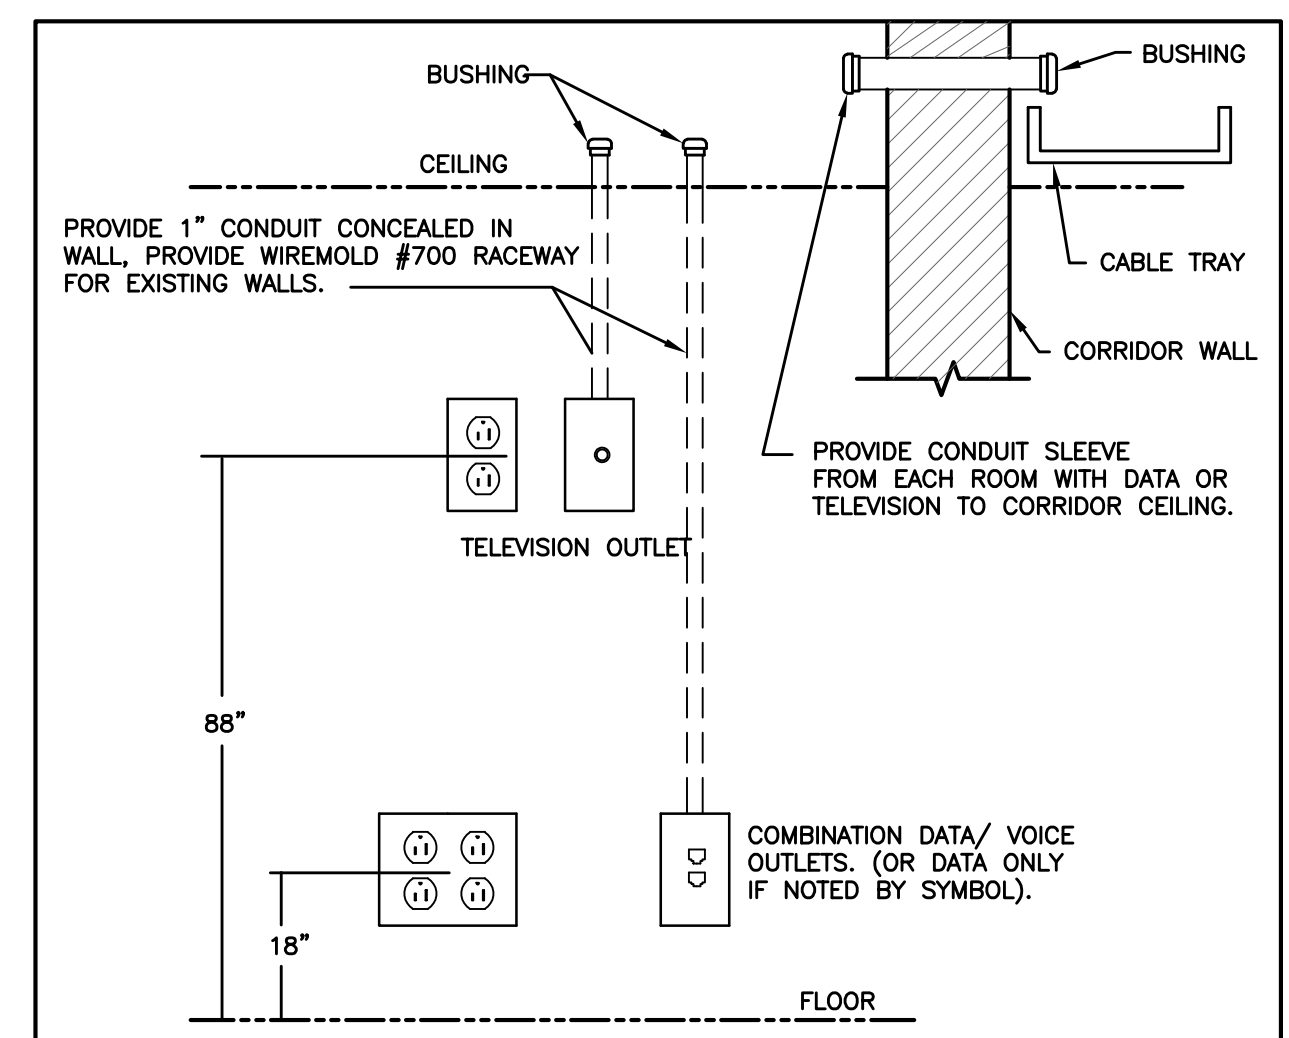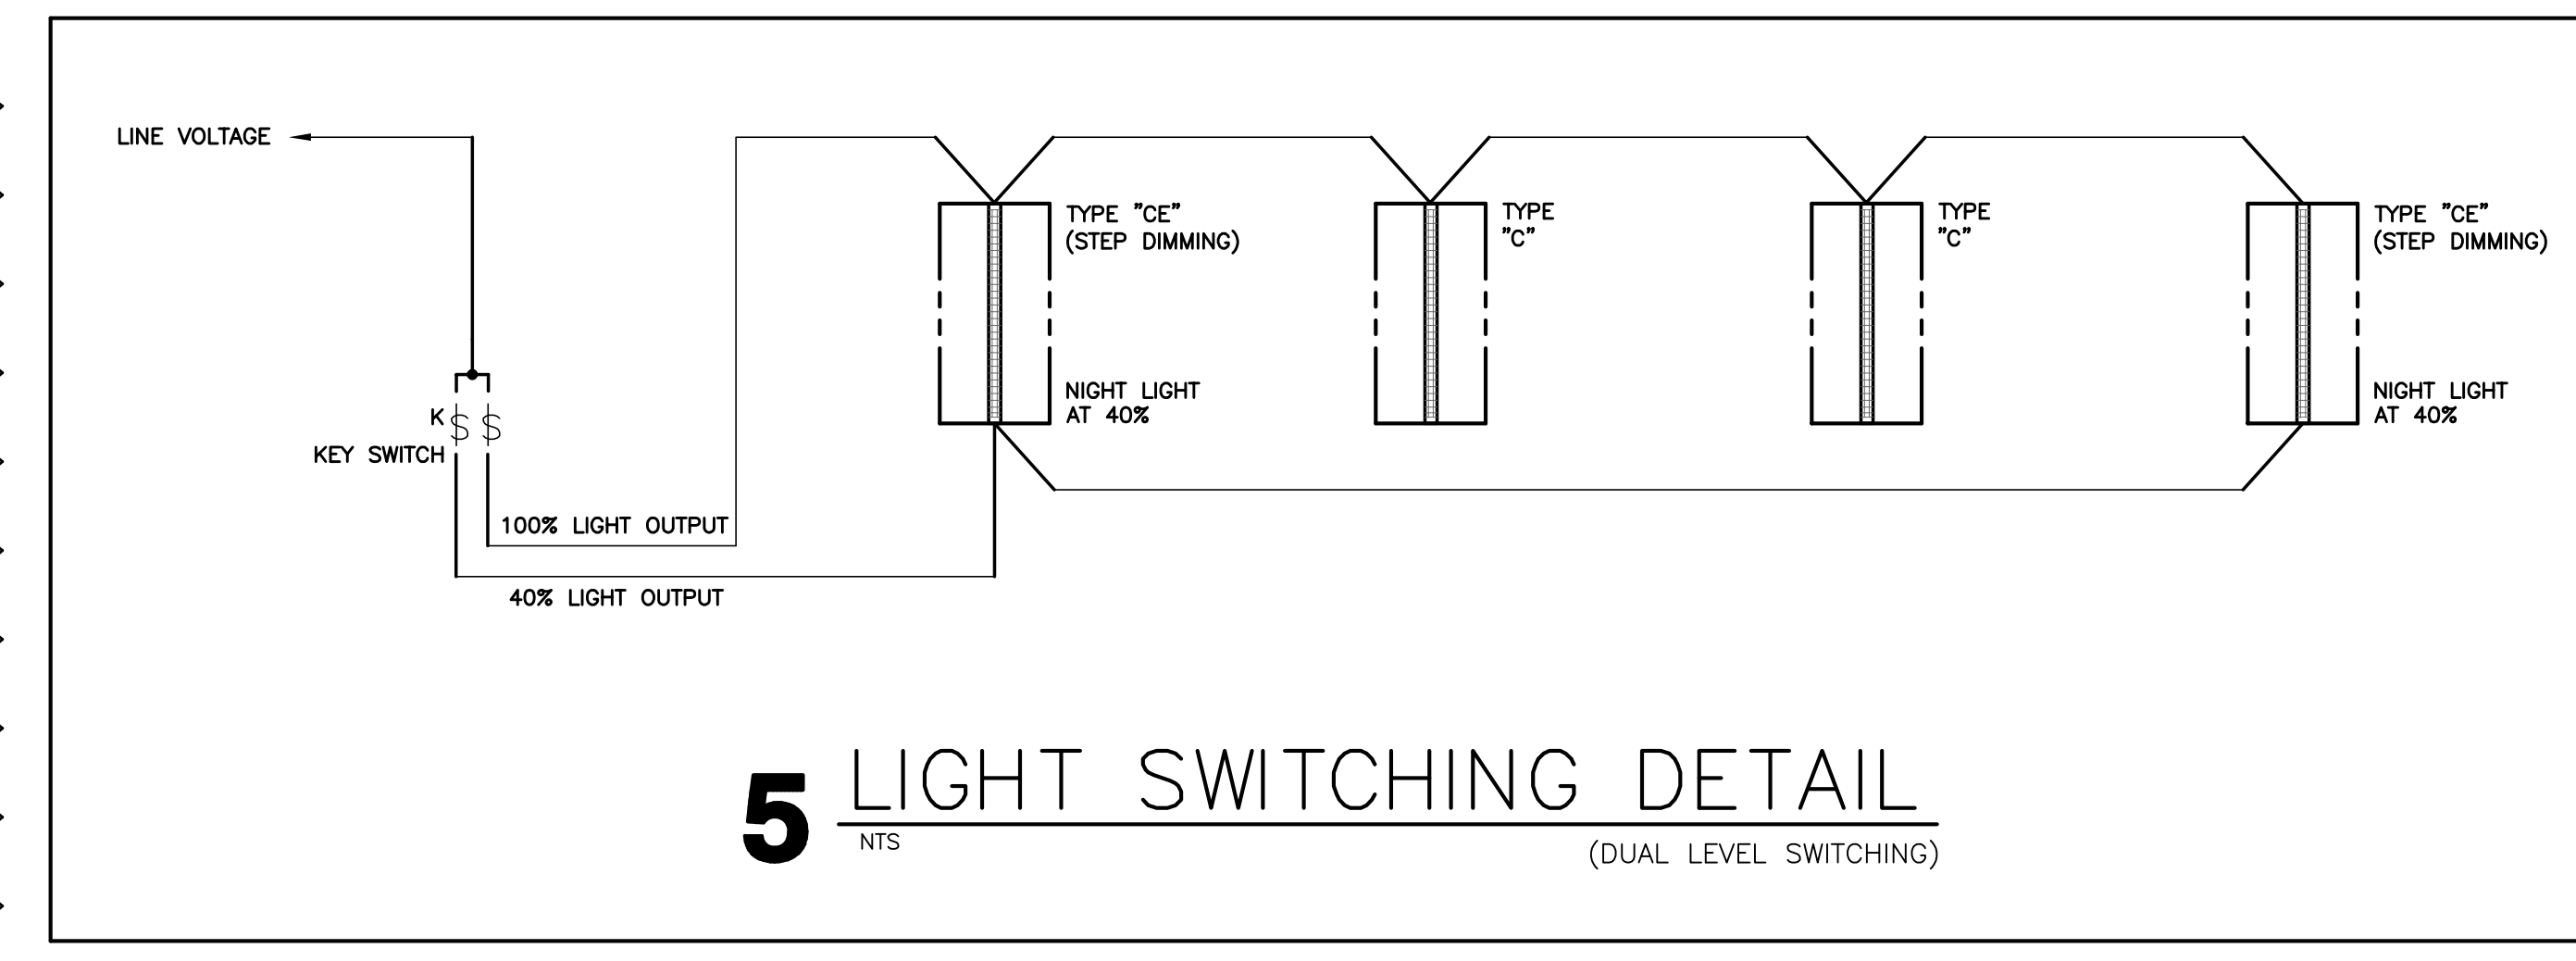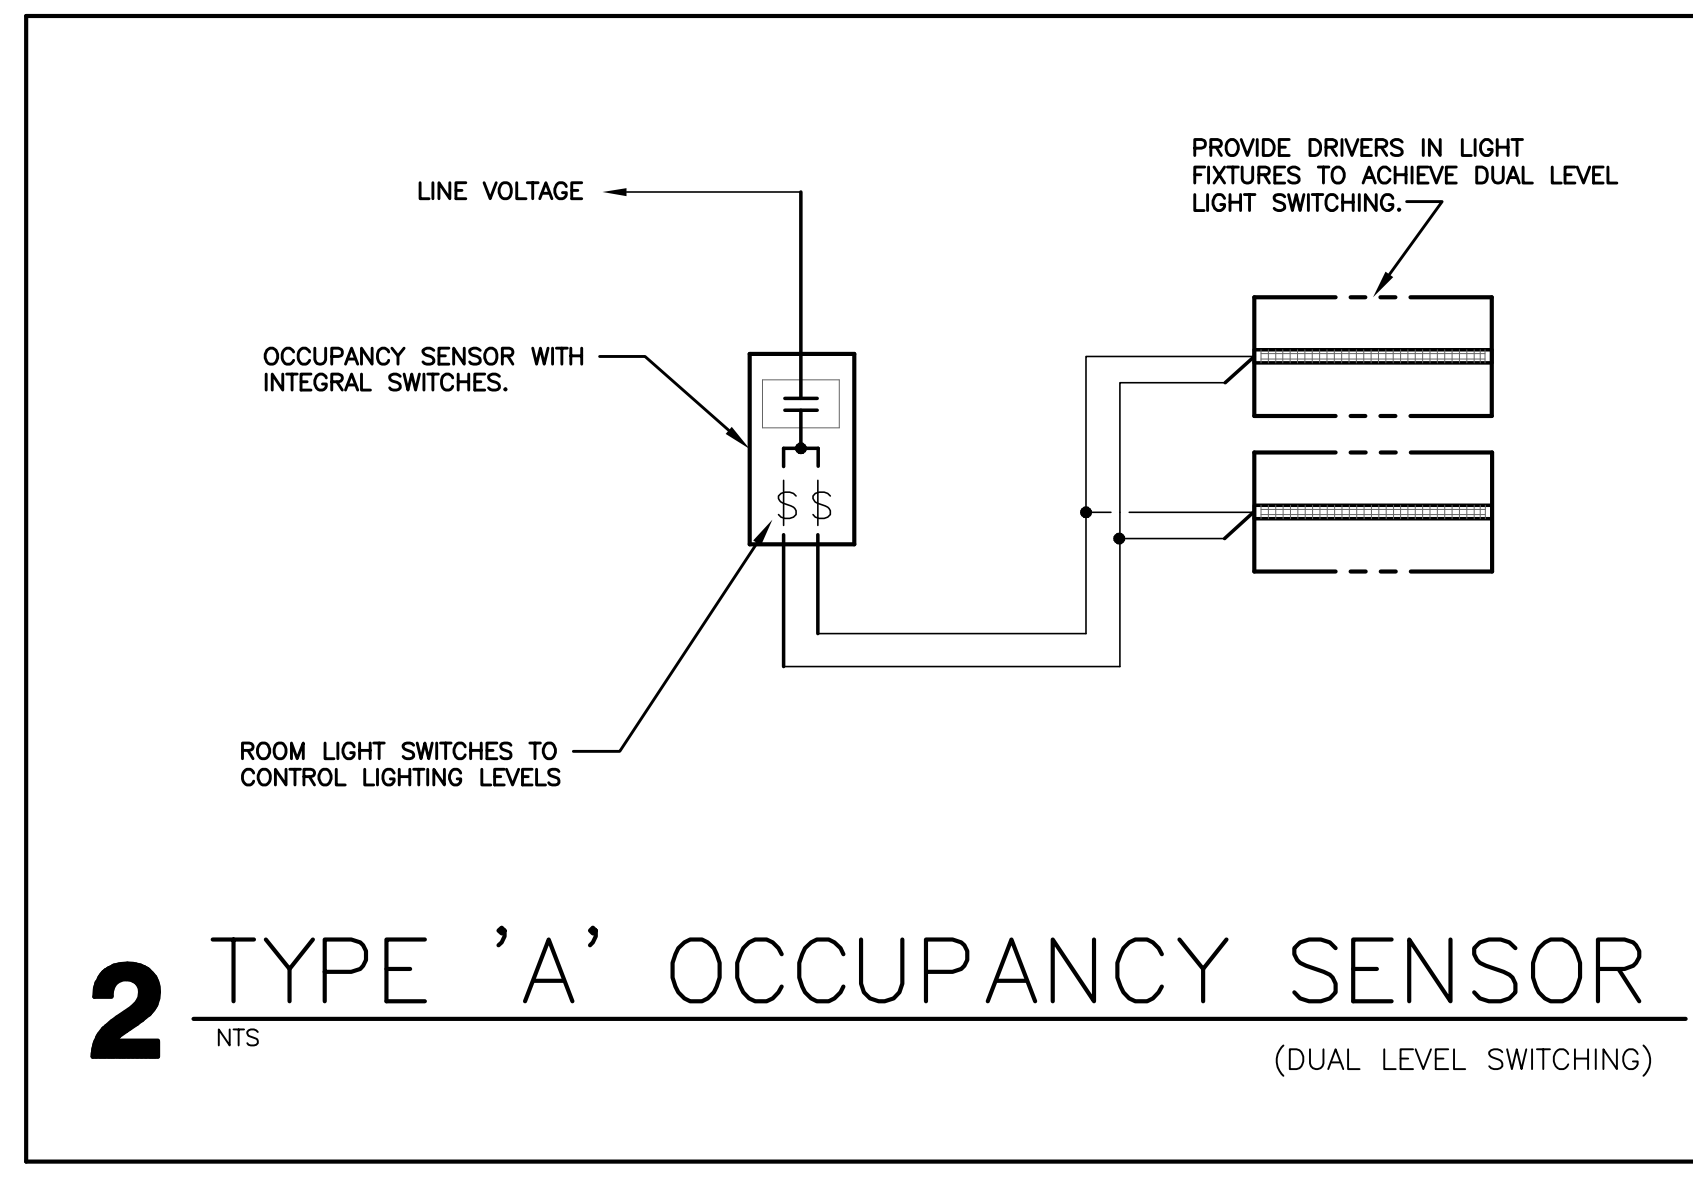

**LIGHTING FIXTURE SCHEDULE**

TYPE	MANUFACTURER	CATALOG NUMBER	DESCRIPTION	VOLT	MOUNTING **				NO.	WATT	LAMPS	REMARK NUMBER
					F	S	P	O				
A	COLUMBIA	LIT22-40MLCC-A12125-E	2' X 2' LAY IN TROFFER,	MVOLT	*				-	31	LED 4000K	1
AD	COLUMBIA	LIT22-40MLCC-A12125-ED1	2' X 2' LAY IN TROFFER, DIMMING TO 1%	MVOLT	*				-	31	LED 4000K	1,4
AL	COLUMBIA	LIT22-40LWCC-A12125-E	2' X 2' LAY IN TROFFER,	MVOLT	*				-	24	LED 4000K	1
ALE	COLUMBIA	LIT24-40LWCC-A12125-E-ELL14	2' X 2' LAY IN TROFFER, EMERGENCY BATTERY	MVOLT	*				-	24	LED 4000K	1
B	COLUMBIA	LIT24-40LWCC-A12125-ESD	2' X 4' LAY IN TROFFER, STEP DIMMING	MVOLT	*				-	34	LED 4000K	2,3
BD	COLUMBIA	LIT24-40LWCC-A12125-ES1	2' X 4' LAY IN TROFFER, DIMMING TO 1%	MVOLT	*				-	34	LED 4000K	2,4
C	COLUMBIA	LIT24-MWCC-A12125-E	2' X 4' LAY IN TROFFER	MVOLT	*				-	31	LED 4000K	2
CE	COLUMBIA	LIT24-MWCC-A12125-ESD-ELL14	2' X 4' LAY IN TROFFER, EMERGENCY BATTERY	MVOLT	*				-	31	LED 4000K	2,3
D	PRESCOLITE	LF4LS-4LFL11L40K	4" LED DOWNLIGHT	MVOLT	*				-	15.5	4000K	6
DE	PRESCOLITE	LF4LS-4LFL11L40K-EMG	4" LED DOWNLIGHT, WITH EMERGENCY BATTERY	MVOLT	*				-	15.5	4000K	6
F	COLUMBIA	LCL4-40ML-E	LED STRIP LIGHT	MVOLT	*				-	48	4000K	
G	COLUMBIA	LIT24-40VLSM-A12125-E	2' X 4' SURFACE FIXTURE	MVOLT	*				-	59	LED 4000K	5
GS	COLUMBIA	LIT24-40VLSM-A12125-ESD	2' X 4' SURFACE FIXTURE, STEP DIMMING	MVOLT	*				-	59	LED 4000K	5
EM	DUAL-LITE	PCZ-HTR	EXTERIOR EMERGENCY LIGHT	MVOLT	*				-	15.2	LED 4000K	8
X1	COMPASS	CER	EXIT LIGHT, RED LETTERS AND BATTERY	120	*				-	2.6	LED	7
X1E	COMPASS	CCR-WGEL	EXIT LIGHT, RED LETTERS, LIGHTING HEADS	120	*				-	2.6	LED	7
OA	DUAL-LITE	RD14KUDB	EXTERIOR BUILDING LIGHT	MVOLT	*				-	32	LED 4000K	9
OAB	DUAL-LITE	RD14KUDB-EH	EXTERIOR BUILDING AND EMERGENCY LIGHT	MVOLT	*				-	50	LED 4000K	10
OB	SPALDING	CL1-A-80L1-4K-3-DB	PARKING LOT LIGHTS, WITH 20' 4" SQUARE POLES	120	*				-	135	LED 4000K	11

- \* SEE REMARKS  
\*\* (F) FLUSH MOUNT; (S) SURFACE MOUNT; (P) PENDANT HUNG; (O) OTHER-SEE REMARKS IN REGARDS TO FIXTURE MOUNTING.
- LIGHTING FIXTURE SCHEDULE REMARKS:**
- 2' X 2' LENSED LED LAY-IN TROFFER.
  - 2' X 4' LENSED LED LAY-IN TROFFER.
  - PROVIDE WITH STEP DIMMING DRIVER.
  - PROVIDE WITH DIMMING DRIVER DOWN TO 1%.
  - SURFACE 2' X 4' LED LIGHT WITH AMERICAN TIME #G2081 WIRE GUARD.
  - 4" LED DOWNLIGHT.
  - EXIT LIGHT, WITH EMERGENCY BATTERY, RED LETTERS, WHITE FINISH.
  - EXTERIOR EGRESS LIGHT.
  - EXTERIOR BUILDING MOUNTED LIGHT.
  - EXTERIOR BUILDING MOUNTED LIGHT WITH BATTERY.
  - PARKING LOT LIGHT WITH 20' POLE 4" SQUARE STEEL POLE PAINTED TO MATCH LUMINARIE. PROVIDE CONCRETE BASE.
- EQUAL FIXTURES BY COOPER LIGHTING, HUBBELL LIGHTING AND DAY-BRITE ARE ACCEPTABLE.

McKINLEY CHARTER SCHOOL  
EAU CLAIRE AREA SCHOOL DISTRICT

Project Location: 1266 MCKINLEY RD  
EAU CLAIRE, WI 54703

Project Number: 17057  
Project Date: 3-8-18  
Drawn By: scott gerzisk  
Key Plan:

Revisions:

No.	Description	Date
A1	ADDENDUM #1	03/15/2018
A2	ADDENDUM #2	03/21/2018

Graphic Scale: VARIES  
Last Update: 03/21/18

E101R1