### DOCUMENT 00 90 00 ADDENDUM

ADDENDUM NO. [3] Date: March 29, 2018

RE: WESTERN TECHNICAL COLLEGE

ARC LIBRARY REMODELING & VETERAN'S CENTER ADDITION

400 SEVENTH STREET NORTH LA CROSSE, WISCONSIN 54601 HSR PROJECT NO. 17026

FROM: HSR Associates, Inc.

100 Milwaukee Street La Crosse, WI 54603 (608) 784-1830

**To:** Prospective Bidders

This addendum forms a part of the Contract Documents and modifies the original Bidding Documents dated March 2018. Acknowledge receipt of this Addendum in the space provided on the bid form. Failure to do so may subject the Bidder to disgualification.

This Addendum consists of [2] pages and [5] 30 x 42 drawings.

#### **CHANGES TO DRAWINGS**


- 1. Sheet M100R HVAC REMODEL PLAN 30 x 42 attached hereto
  - a. Revisions clouded on Drawing.
- 2. Sheet M600R HVAC SCHEDULES AND DETAILS 30 x 42 attached hereto
  - a. Revisions clouded on Drawing.
- 3. Sheet E102R PARTIAL SECOND FLOOR LIGHTING PLAN 30 x 42 attached hereto
  - a. In classroom #209, provide a Wattstopper, model # LMIO-101 digital input/output interface relay. This relay will be used by the Temperature Control Contractor to control HVAC fan powered FVAV 4-6 Box. Refer to clouded change.
  - b. In Reception #210, move low voltage light switch from West wall adjacent to entrance door to North wall adjacent to group of four (4) low-voltage switches. Refer to clouded change.
- 4. <u>Sheet E202R PARTIAL SECOND FLOOR POWER PLAN & MOTOR AND EQUIPMENT SCHEDULE</u> 30 x 42 attached hereto
  - a. In Learning Commons 202 provide a double duplex receptacle on East wall. Refer to clouded change.
  - b. In Study 5 delete note #23 pointing at existing poke thru floor outlet. This is an existing poke thru junction box with receptacles. Feed receptacles with two branch-circuits for copy machines to be installed in this area.
  - c. In Classroom 209 Make final connection to 1/3HP, 120VAC, HVAC Fan Powered FVAV Box 4-6. Refer to clouded change.
  - d. Refer to keyed note #2: Add the following to the note: "Coordinate clock backbox installation with acoustic wall placement".
  - e. Refer to Keyed Note #18: Change wiremold size from 6000 to 4000.


- f. Keyed note #23:
  - The 'Thread' underfloor raceway system shall be provided and installed by 'Steelcase Inc.' furniture provider. The Electrical Contractor is responsible to make 120VAC line voltage connection only. Coordinate with Steelcase Inc.
  - ii. Manufacturer's: Connectrac (https:connectrac.com/products/under-carpet-wireway/). Or comparable.
- g. For the Electric Water Cooler located on the North-East end of the Library, install GFCI receptacle outside of drinking fountain housing. Do not conceal inside housing.
- h. Panel Board Schedule:
  - i. Circuit number #27 shall be connected to FV V 3-11. Refer to clouded change.
  - ii. Circuit number #LB-26 and #LB-28 shall be connected to wiremold #4000. Refer to clouded change.
- i. Equipment/Motor Schedule: Fan powered FV V 3-11 added to the schedule, refer to clouded change.
- 5. Sheet E302R1 SECOND FLOOR REMODEL LOW VOLTAGE PLAN 30 x 42 attached hereto
  - a. One (1) 1-port data jack is added on the West Wall in Study #9 in the Library #201. Refer to clouded change.
  - b. Keyed note #6 shall change from 2-port data jack to 1-port data jack. Refer to clouded change.

**END OF DOCUMENT 00 90 00** 

## HVAC PIPE SIZING CHART

REQUIRED PIPE SIZE	COPPER PIPE GPM	IRON PIPE GPM
1/2"	0 - 1.1	
3/4"	1.2 - 3.0	
1"	3.1 - 6.6	
1-1/4"	6.7 - 11.3	6.8 - 14.0
1-1/2"	11.4 - 18.0	14.1 - 21.0
2"	18.1 - 38.0	21.1 - 41.0
2-1/2"	38.1 - 69.0	41.1 - 66.0
3"	69.1 - 109.0	66.1 - 119.0
4"		119.1 - 242.0
5"		242.1 - 440.0
6"		440.1 - 710.0

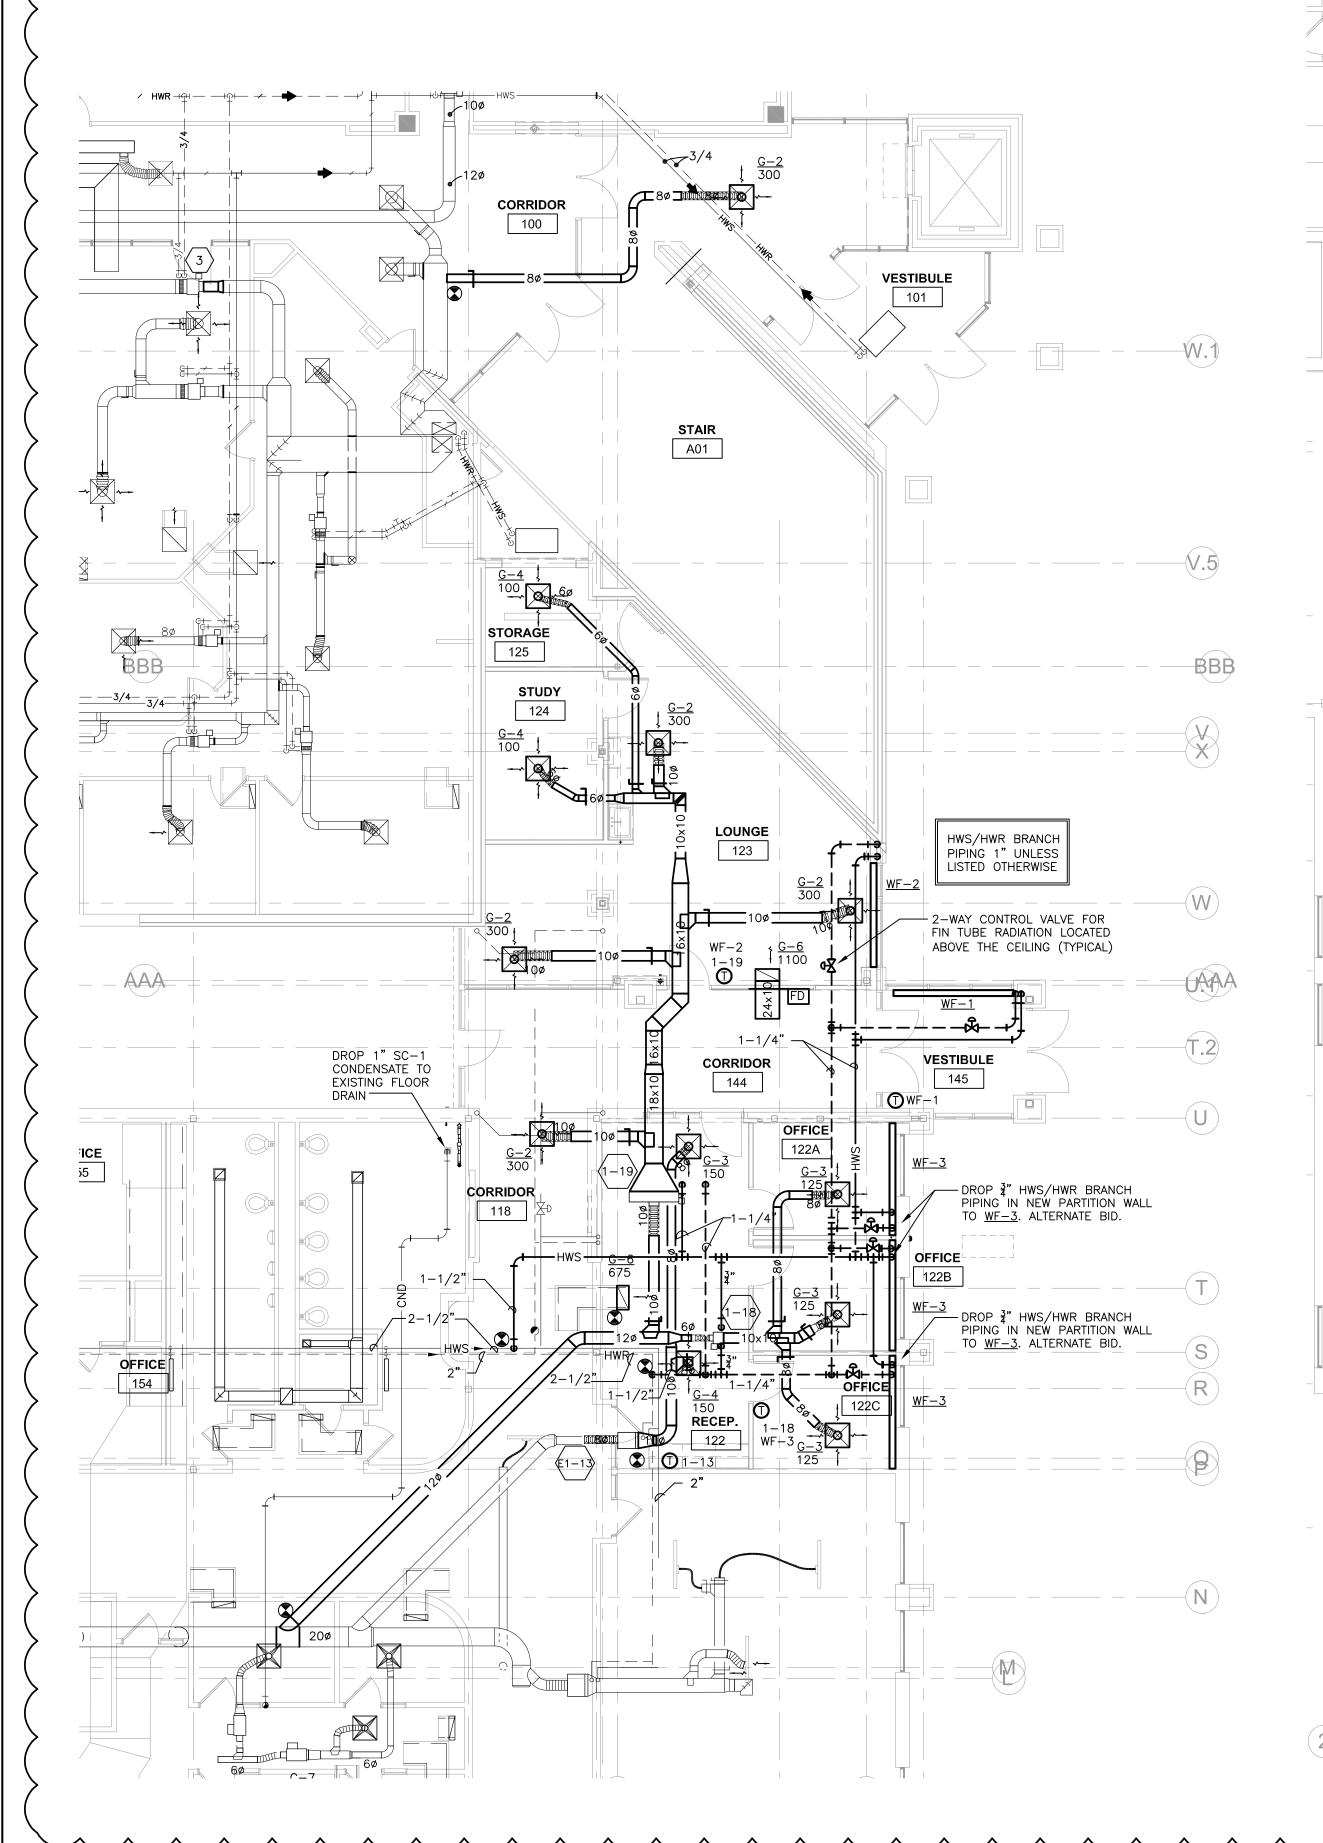

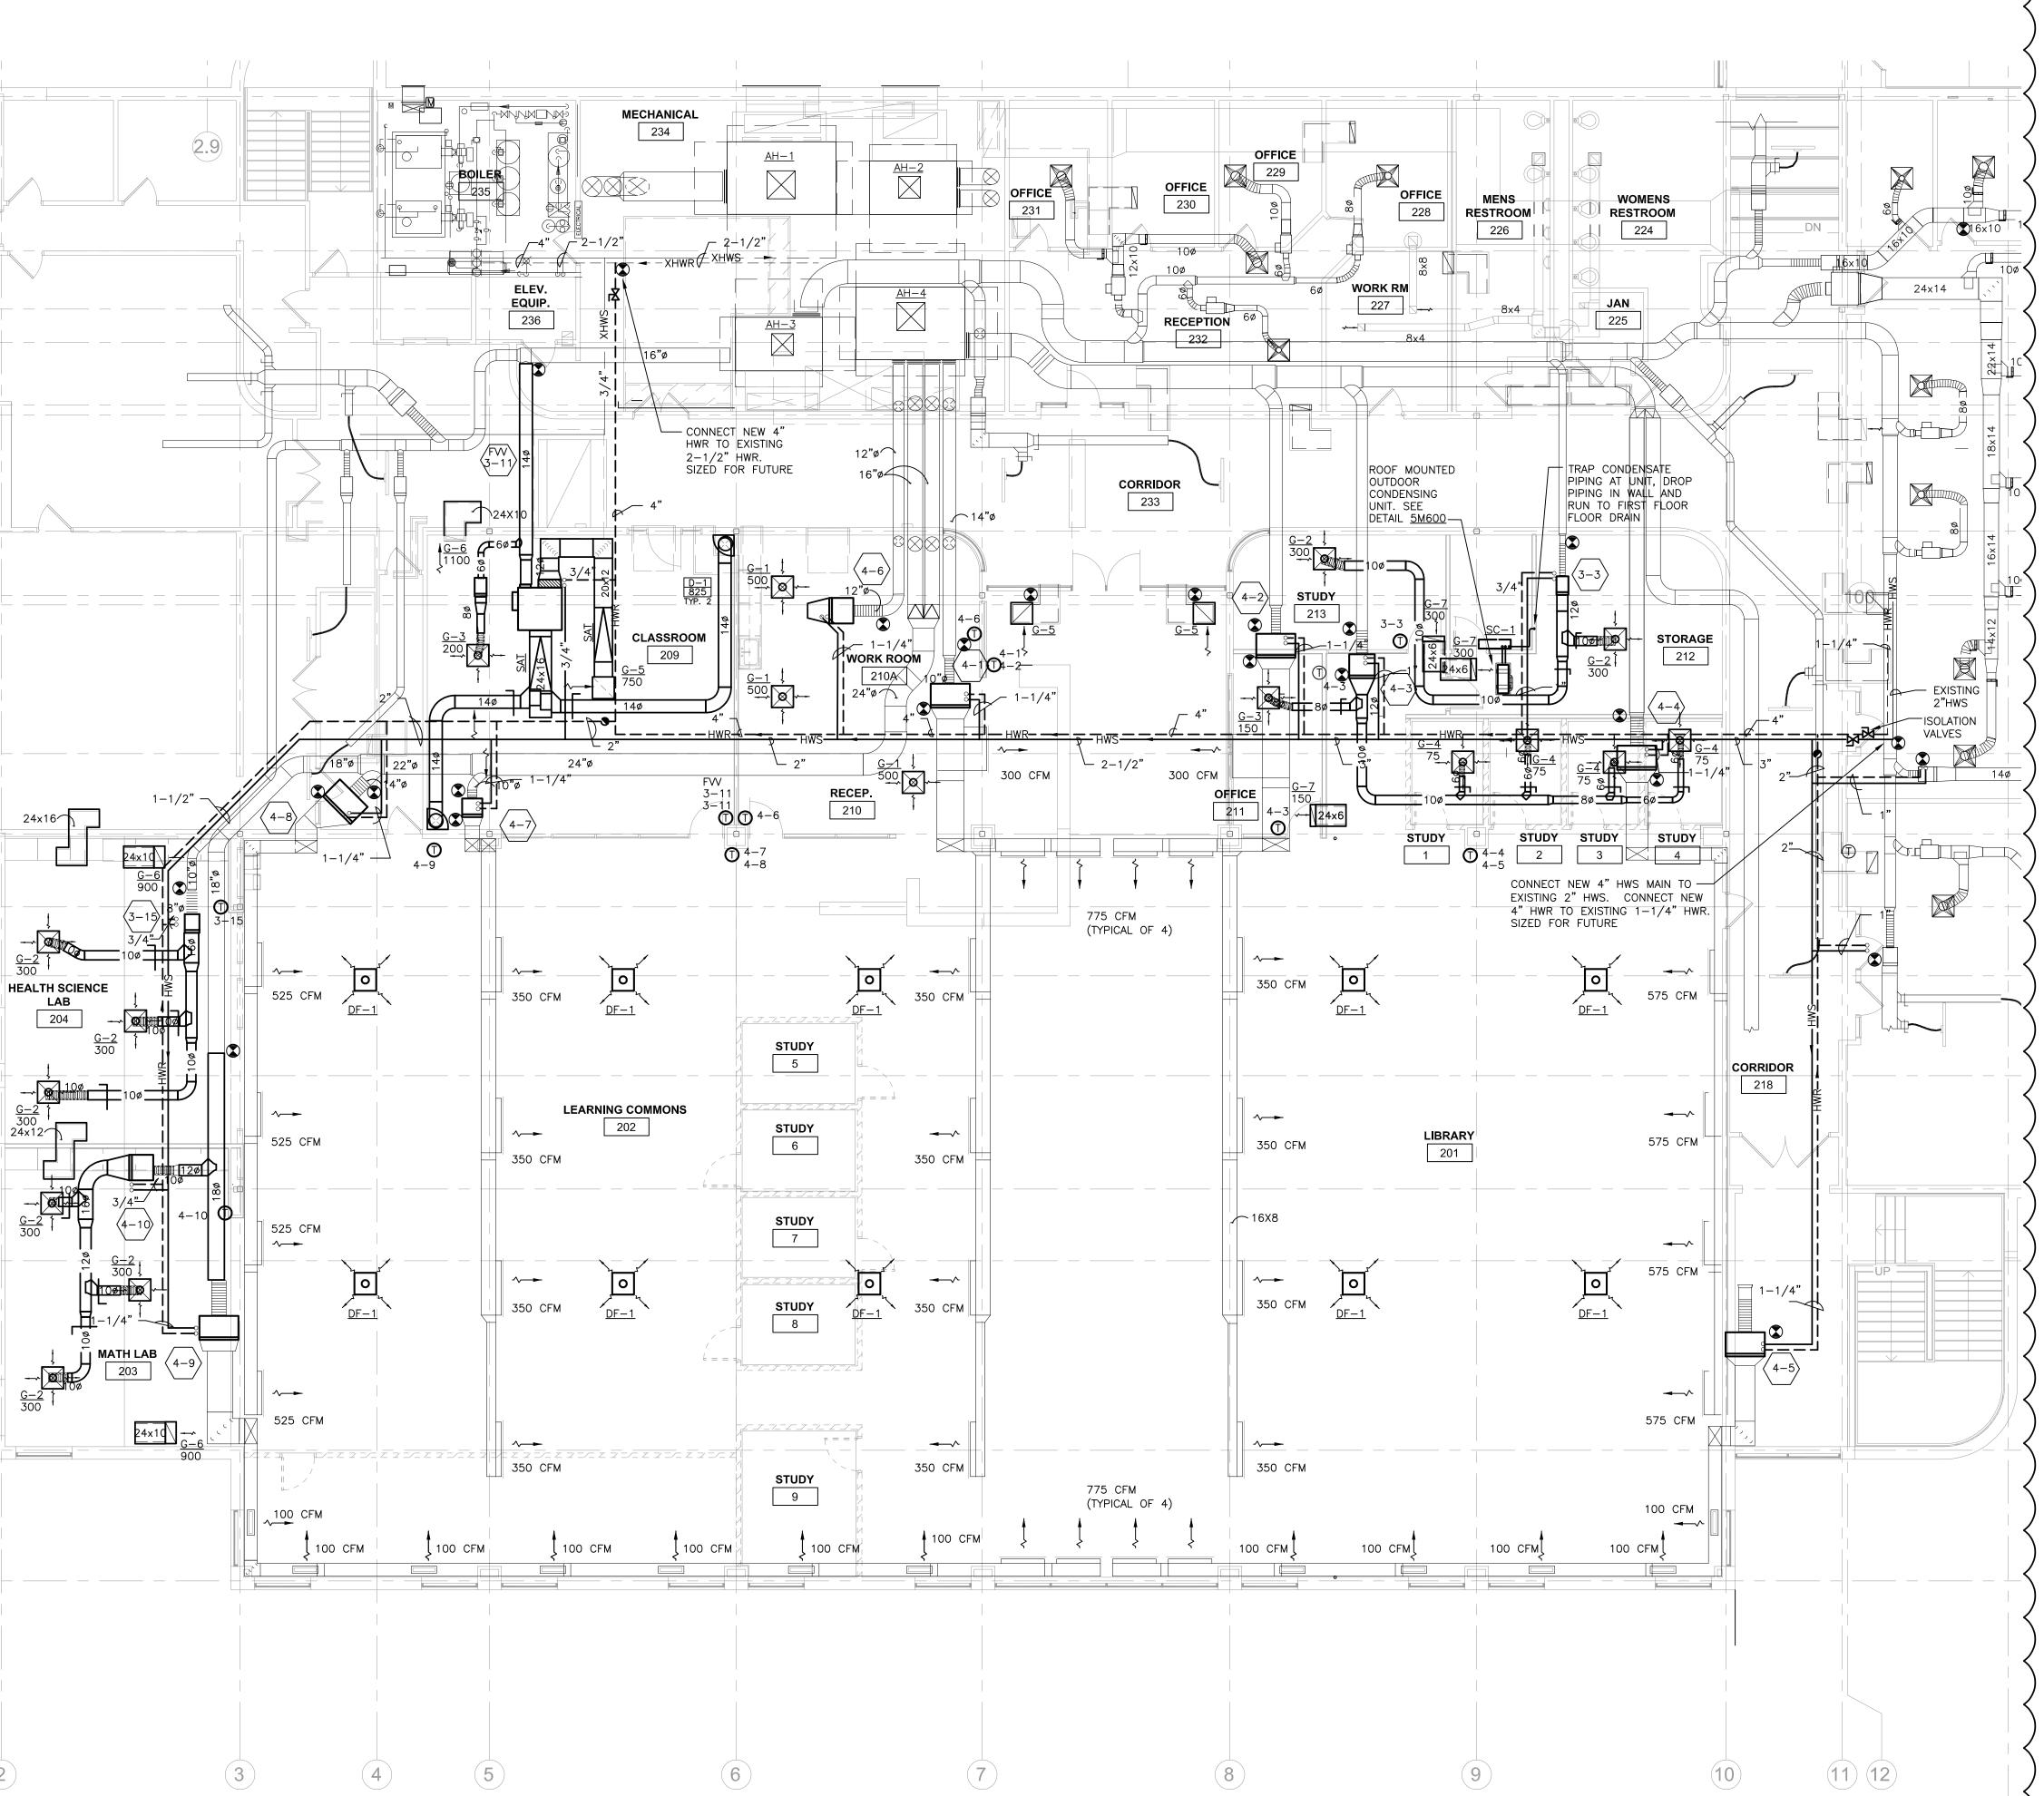

ARCHITECTURE
ENGINEERING
INTERIOR DESIGN

HSR ASSOCIATES INC.
100 MILWAUKEE STREET
LA CROSSE, WISCONSIN
PHONE: 608.784.1830
FAX: 608.782.5844
WEB SITE: www.hsrassociates.com
Consultant:

WESTERN TECHNICAL COLLEGE
ARC LIBRARY REMODELING &
VETERANS CENTER ADDITION

Project Number:

LA CROSSE, WI

Project Date:

3/13/2018

Drawn By:

kkl

Key Plan:

Description Date
ADDENDUM #3 03/29/2018

c Scale:

M100R

3/28/2018

# DESTRATIFICATION FANS

UNIT	SERVES ROOM	LOCATION	MODEL NO.	SOUNND (DB)	C.F.M.	MOTOR	AMPS (VOLTAGE)	REMARKS REF. NO.
DF-	1 LIBRARY 201 LEARNING 202	201,202	AIR PEAR S-25-EC	51	620	ECM	0.4 (120/1)	1, 2, 3

REMARKS:

- 1. BASED ON PRODUCT BY AIRIUS.
- 2. PROVIDE HEAT SENSOR AND INTEGRATE WITH BAS. 3. PROVIDE 2'X2' LAY-IN MOUNTING.

# AIR DISTRIBUTION DEVICES

UNIT REF.	FIXTURE TYPE			INLET SIZE	MODEL NUMBER	MOUNTING	REMARKS REF. NO.	
G-1	SUPPLY	24 X 24	CEILING	RADIAL	12 <b>"</b> ø	SERIES PLQ 4-WAY	LAY-IN	1,2,3
G-2	SUPPLY	24 X 24	CEILING	RADIAL	10"ø	SERIES PLQ 4-WAY	LAY-IN	1,2,3
G-3	SUPPLY	24 X 24	CEILING	RADIAL	8"ø	SERIES PLQ 4-WAY	LAY-IN	1,2,3
G-4	SUPPLY	24 X 24	CEILING	RADIAL	6"ø	SERIES PLQ 4-WAY	LAY-IN	1,2,3
G-5	TRANSFER	24 X 24	CEILING	NO	N/A	EGC-5 1/2" EGG CRATE	LAY-IN	1,4
G-6	TRANSFER	24 X 12	CEILING	NO	N/A	EGC-5 1/2" EGG CRATE	LAY-IN	1,4
G-7	TRANSFER	24 X 6	CEILING	NO	N/A	EGC-5 1/2" EGG CRATE	LAY-IN	1,4
~~~	<	$\sim\sim$	~~~	~~~	<	~~~~~	~~~	~~
D-1	DISPLACEMENT	24" PADILIS	CEILING	NO	1.4."ø	TITUS DVVC - 14-24V48	WALL	5.6

1. BASED ON PRODUCT BY KRUEGER


- 2. DIFFUSERS SHALL BE STEEL CONSTRUCTION
- 3. INCLUDE DIRECTIONAL BLOW PATTERN CONTROL TABS FOR DIFFUSERS SHOWN OTHER THAN 4-WAY THROW

5. BASED ON PRODUCT BY HALTON 6. PROVIDE CONTINUOUS PERFORATED COVER THAT MATCHES THE DIFFUSER PATTERN

# FIN TUBE RADIATION

UNIT	TOTAL	TYPE		TEMP.	REMARKS			
NO.	MBH INSTALLED		LENGTH	DEPTH	HEIGHT	PIPING CONNECTIONS	CONTR.	REF. NO.
WF-1	19.0	R3F-10	10'-0"	4.8"	29"	SAME RIGHT	2-WAY	1,2,3,5
WF-2	14.3	R3F-6	10'-0"	4.8"	17.25"	SAME RIGHT	2-WAY	1,2,3,5
WF-3	3.4	R3F-2	5'-0"	4.8"	8.62"	SAME RIGHT	2-WAY	1,2,3,4,

REMARKS: 1. BASED ON PRODUCT BY RUNTAL RADIATORS 2. UNIT SHALL BE PANEL TYPE WITH FLOOR POSTS FOR MOUNTING 3. UNIT SIZE WITH AVERAGE WATER TEMPERATURE 130°F 30% PROPYLENE GLYCOL 4. ALERNATE BID 5. SEE DETAIL <u>4M600</u>

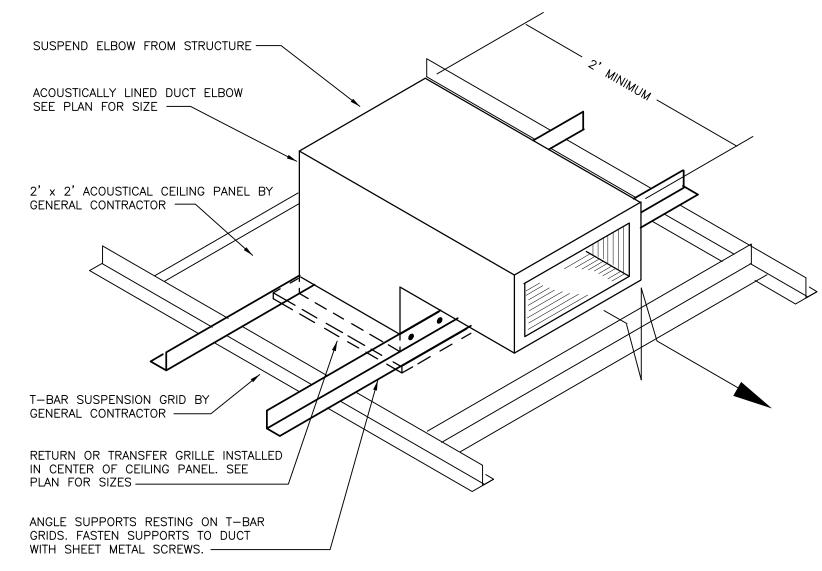

TYPICAL RETURN / TRANSFER GRILLE DETAIL

HIGH EFFICIENCY TAKEOFF

2-WAY VALVE (TYPICAL)

PIPING AND DUCTWORK SHALL BE

INSULATED PER STATE CODE REQUIREMENTS.

3 DETAIL @ TYPICAL TAKE-OFF TO VAV BOX

BALANCING STATION

MEDIUM PRESSURE FLEXIBLE DUCT

-VAV BOX WITH HEATING COIL

ACCESS PANEL IN BOTTOM OF VAV BOX

REFER TO SCHEDULE FOR UNITS

WITH 3-WAY CONTROL VALVES.

PROVIDE VIEWING WINDOW IN PANEL (FIELD CONVERTED)

-HEATING COIL SHALL BE COMPLETELY REMOVABLE WITHOUT REMOVING VAV BOX,

PIPING OR DUCTWORK (FIELD CONVERTED)

DO NOT INSTALL NEW VAV BOX ABOVE

NEW WALLS OR PARTITIONS. LOCATE VAV BOX, CONTROL AND SHUTOFF VALVES AND

ALL OTHER SERVICEABLE COMPONENTS SO

PROVIDE ADEQUATE CLEARANCE TO REMOVE


REHEAT COIL WITHOUT DISRUPTING VAV

THEY ARE COMPLETELY ACCESSIBLE.


BOX, DUCTWORK OR PIPING.

- ACCESS PANEL WITH VIEWING WINDOW


- BRANCH SUPPLY DUCTWORK

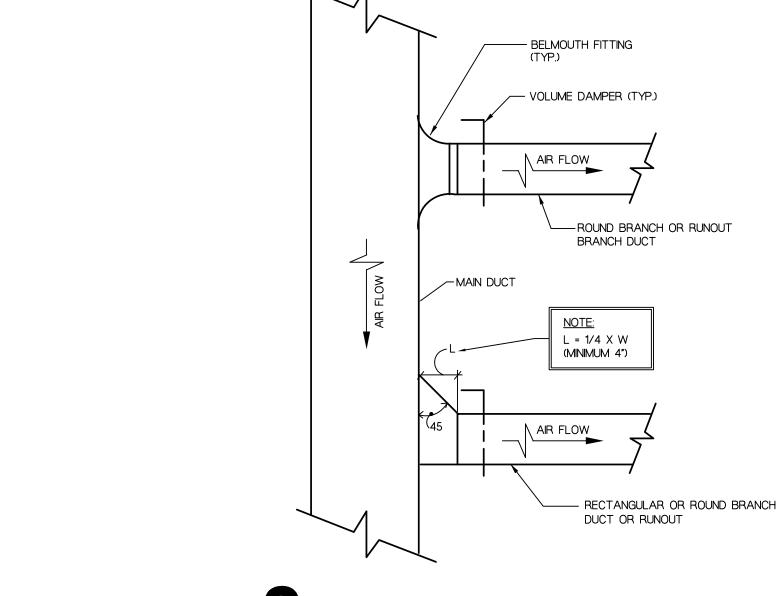


2 TYPICAL BRANCH TAKE-OFF

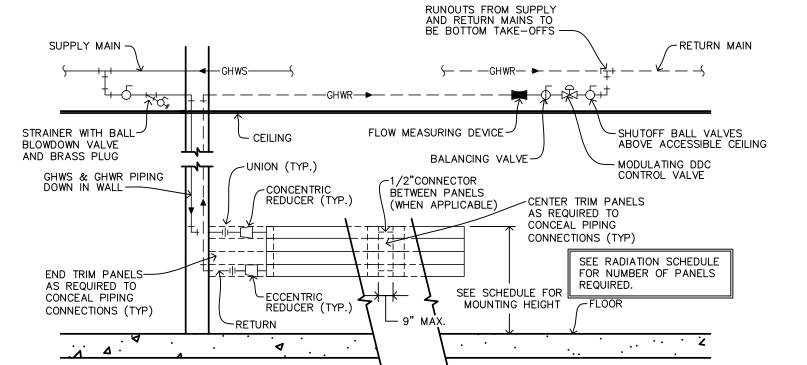

4 WALL PANEL RADIATION DETAIL

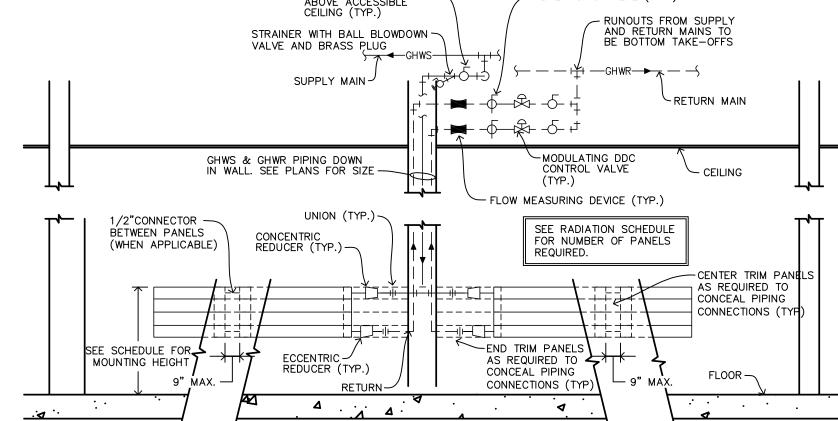

6 BACK TO BACK WALL PANEL RADIATION DETAIL

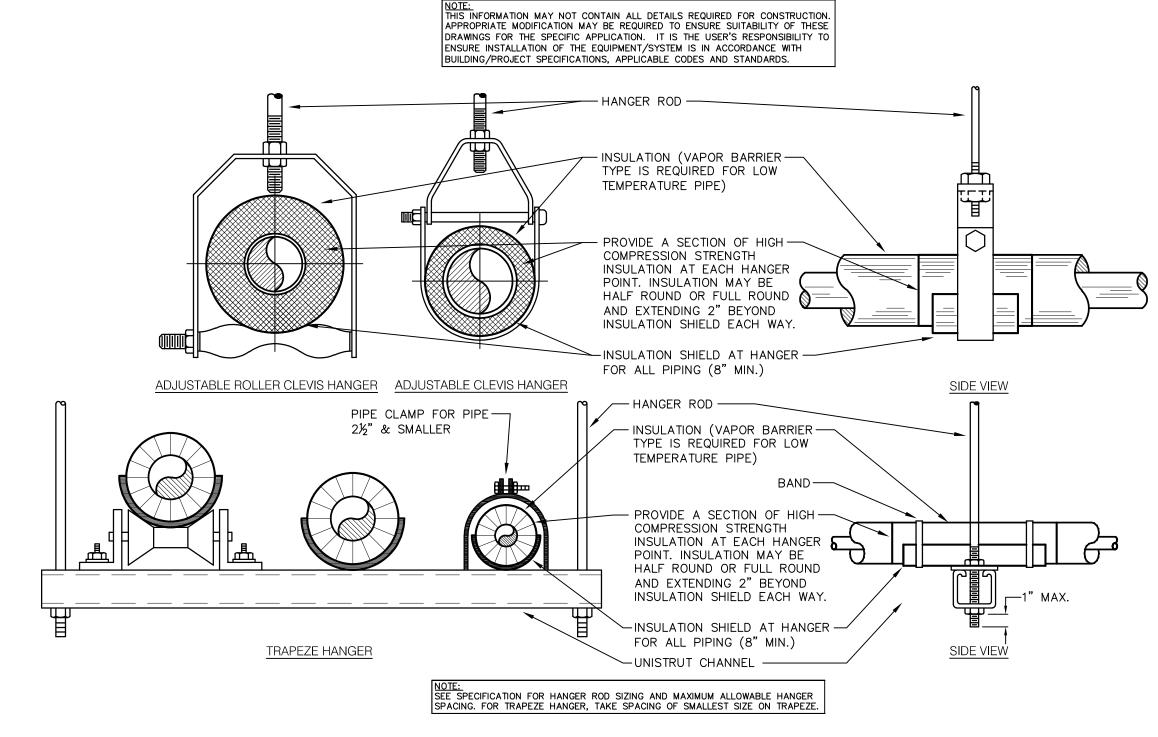

7 TYPICAL PIPE HANGER DETAIL
N.T.S.

**VAV BOXES** 

(	UNIT	SERVES ROOM	MODEL	INLET	MAX	MIN	MIN	AVAILABLE DESIGN	MAX UNIT	DOWNSTREAM UNIT	NC	со	L SIZING	AND C	APACIT'	Y DATA				REMARK
NO.	NO.		NO.	DUCT SIZE	CFM	COOLING CFM	HEATING CFM	INLET S.P. NOTE: 1	S.P. DROP NOTE: 2	S.P. DROP	LEVEL (BOX) RADIATED	MAIN COIL TYPE	HTG FLOW RATE	P.D.	ENT. H.W. TEMP.	LVG H.W. TEMP.	ENT. AIR TEMP.	ROOM HTG SETPOINT	TOTAL MBH NOTE: 3	REF NO.
NG 1	<b>-13</b>	122 RECEPTION	VCWF	12	300	150	150	1.0	<0.4"	0.25	27	1-ROW	GPM 1	<b>FT H20</b> 3.2	140	120	50.0	75	6.5	+
	-18	122A,122B,122C	SDR	8	375	150	300	1.0	<0.4"	0.25	<20	2-ROW	1.8	<5.0	140	120	50.0	75	13.3	1.2.
H	-19	VET CENTER	SDR	12	1100	400	800	1.0	<0.4"	0.25	<20	3-ROW	5.0	<5.0	140	120	50.0	75	39.1	1.2.
F		,,	JUK	12	1100	100	000	1.0	70.1	0.25	\20	3 10W	0.0	\0.0	1+0	120	30.0	/3	39.1	11.2.
3	5–3	212 STORAGE 213 STUDY	SDR	8	600	200	500	1.0	<0.4"	0.25	<20	2-ROW	2.9	<5.0	140	120	50.0	75	19.0	1.2.
3	5-11	209 CLASSROOM	SDR	6	200	70	N/A	1.0	<0.4"	0.25	<20	N/A	N/A	N/A	N/A	N/A	N/A	N/A	N/A	1.
3	5–15	204 HEALTH SCIENCE	SDR	10	900	270	500	1.0	<0.4"	0.25	<20	2-ROW	2.3	<5.0	140	120	50.0	75	19.0	1.2.
4	<b>-</b> 1	201/202	SDR	16	3250	975	975	1.0	<0.4"	0.25	<20	4-ROW	12	<5.0	140	120	50.0	75	68.2	1.2.
4	-2	201/202	SDR	16	3250	975	975	1.0	<0.4"	0.25	<20	4-ROW	12	<5.0	140	120	50.0	75	68.2	1.2.
4	<del>-</del> 3	STUDY 1,2,3,4	SDR	6	300	200	300	1.0	<0.4"	0.25	<20	3-ROW	1.5	<5.0	140	120	50.0	75	11.4	1.2.
4	-4	201	SDR	14	2300	690	1000	1.0	<0.4"	0.25	<20	4-ROW	9.4	<5.0	140	120	50.0	75	54.1	1.2.
4	<b>-</b> 5	201	SDR	14	2050	650	900	1.0	<0.4"	0.25	<20	4-ROW	12.5	<5.0	140	120	50.0	75	52.8	1.2.
4	-6	210A WORKROOM	SDR	12	1500	500	750	1.0	<0.4"	0.25	<20	2-ROW	4.1	<5.0	140	120	50.0	75	17.9	1.2.
4	<b>-</b> -7	201	SDR	12	1400	420	600	1.0	<0.4"	0.25	<20	3-ROW	5.4	<5.0	140	120	50.0	75	31.5	1.2.
4	-8	201	SDR	14	2100	630	630	1.0	<0.4"	0.25	<20	2-ROW	5.2	<5.0	140	120	50.0	75	53.1	1.2.
4	-9	202	SDR	16	2925	880	880	1.0	<0.4"	0.25	<20	2-ROW	12	<5.0	140	120	50.0	75	67.0	1.2.
4	-10	203	SDR	10	900	270	500	1.0	<0.4"	0.25	<20	2-ROW	2.3	<5.0	140	120	50.0	75	19.0	1.2.
	FW																			ऻ
	<u>3–11</u>	209 CLASSROOM	VFR	12	900	650	750	1.0	<0.4"	0.25	<20	2-ROW	1.4	<5.0	140	120	50.0	75	12.2	1.3.

1. HEATING COIL CAPACITY IS DETERMINED AT MINIMUM BOX CFM AND INCLUDES SPACE HEAT LOSS PLUS REHEAT LOAD.

3. PARALLEL FAN-POWERED VAV TERMINAL UNIT WITH HOT WATER REHEAT SCHEDULE UNIT 5 MAX AIRFLOW 1650 CFM

## DATA COOLING UNIT

UNI	MODEL	TOTAL			IND	OOR UNIT		OUTDOOR UNIT (CU-1)						ECTRICAL	RFRIG.	REMARKS REF.			
NO	NO. INDOOR/OUTDOOR	COOLING BTUH	VOLTAGE	CFM	ECM FAN MOTOR	QUANTITY FANS	MCA	MAX. SOUND	AIR VOLUME	QUANTITY FANS	FAN MOTOR	COMP. TYPE	QUANTITY COMP	REFRIG TYPE	TOTAL INPUT	мса	FUSE SIZE	PIPE SIZE	NO.
SC-	PKAA18HA4/ 1 PUYA18NHA4	18,000	208/60/1	370	0.33FLA	1	1.0 A	43 dBA	1200	1	0.35 FLA	ROTARY	2	R-410A	1190 W	13A	20A	1/4" 1/2"	1,2,3,4,5,6
REN	MARKS:																		


1. BASED ON PRODUCT BY MITSUBISHI (15.3 SEER)


2. REHEAT COILS SIZE AT 140 F EWT AND 30% PROPYLENE GLYCOL.

1. BASED ON PRODUCT BY ENVIRO-TEC SDR

2. UNIT WILL HAVE 2-WAY VALVE. SEE DETAIL <u>3M600</u>



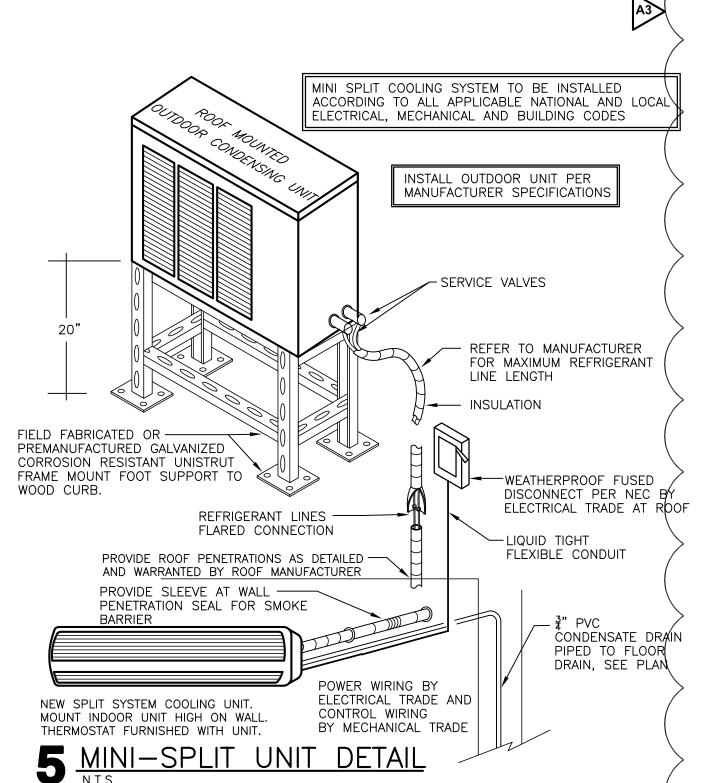

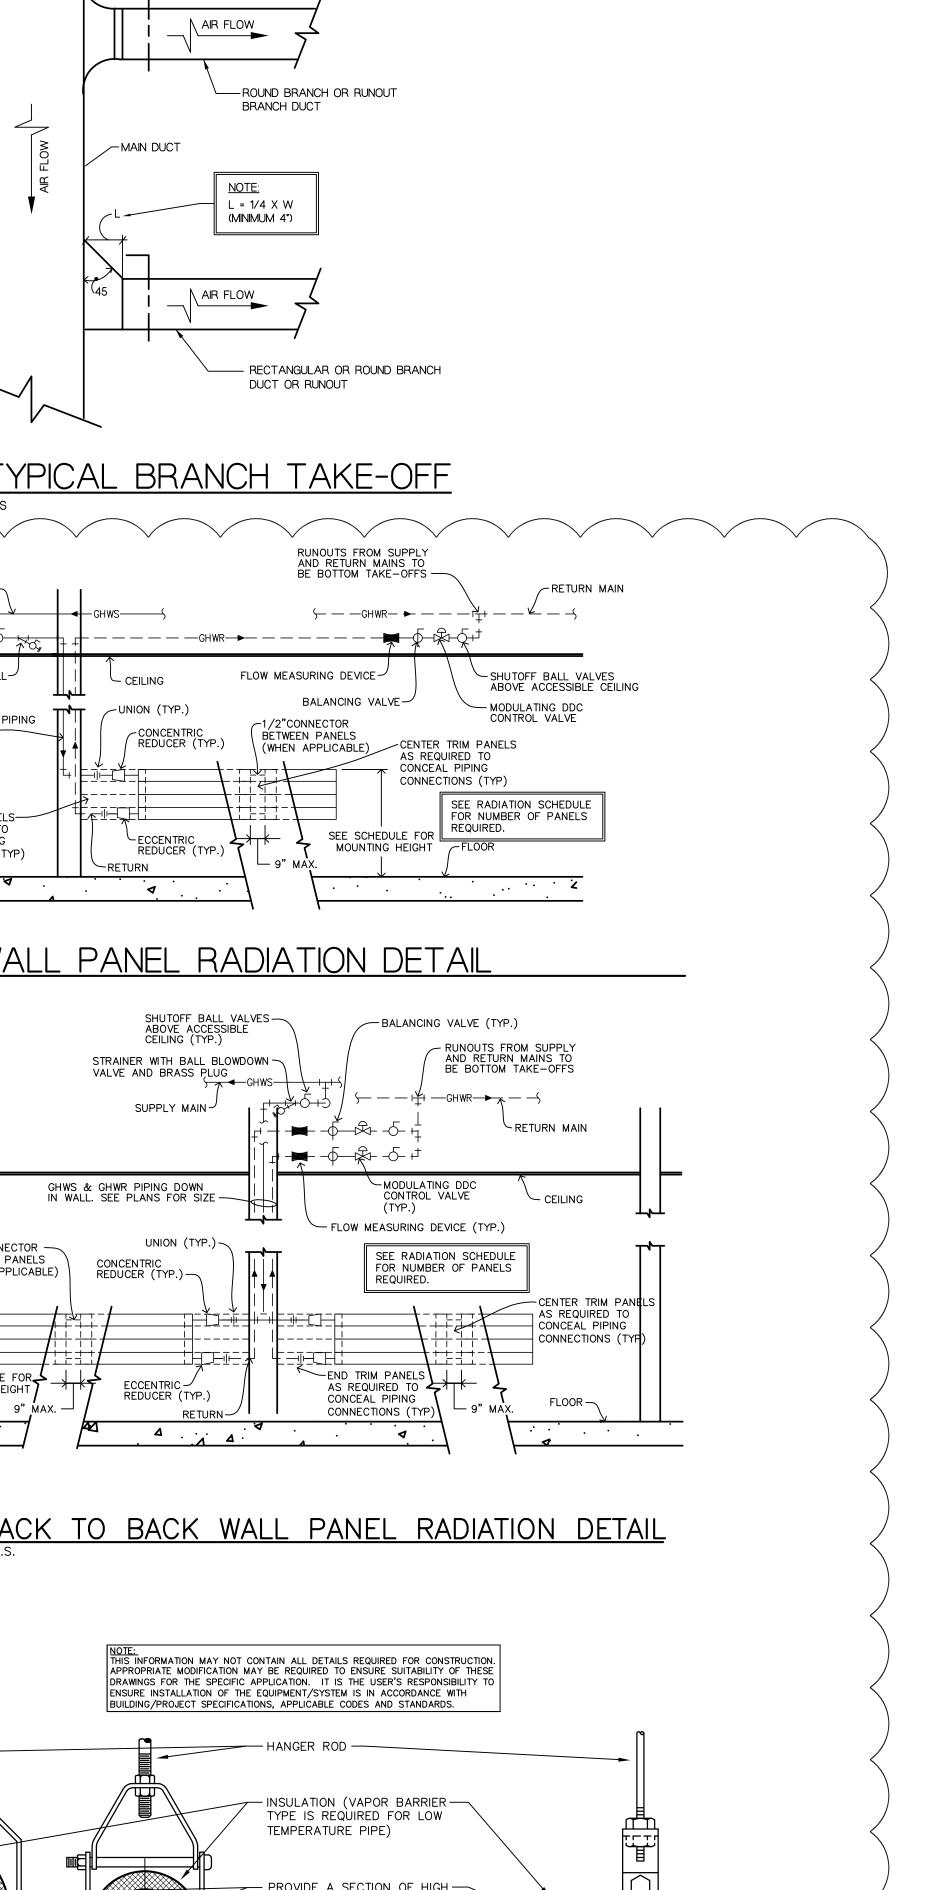

ADDENDUM #3 Graphic Scale: **VARIES** 3/28/2018

LA CROSSE, WI

3/13/2018

ARCHITECTURE

ENGINEERING

INTERIOR DESIGN


HSR ASSOCIATES INC.


LA CROSSE, WISCONSIN

PHONE: 608.784.1830

FAX: 608.782.5844 WEB SITE: www.hsrassociates.com

Consultant:

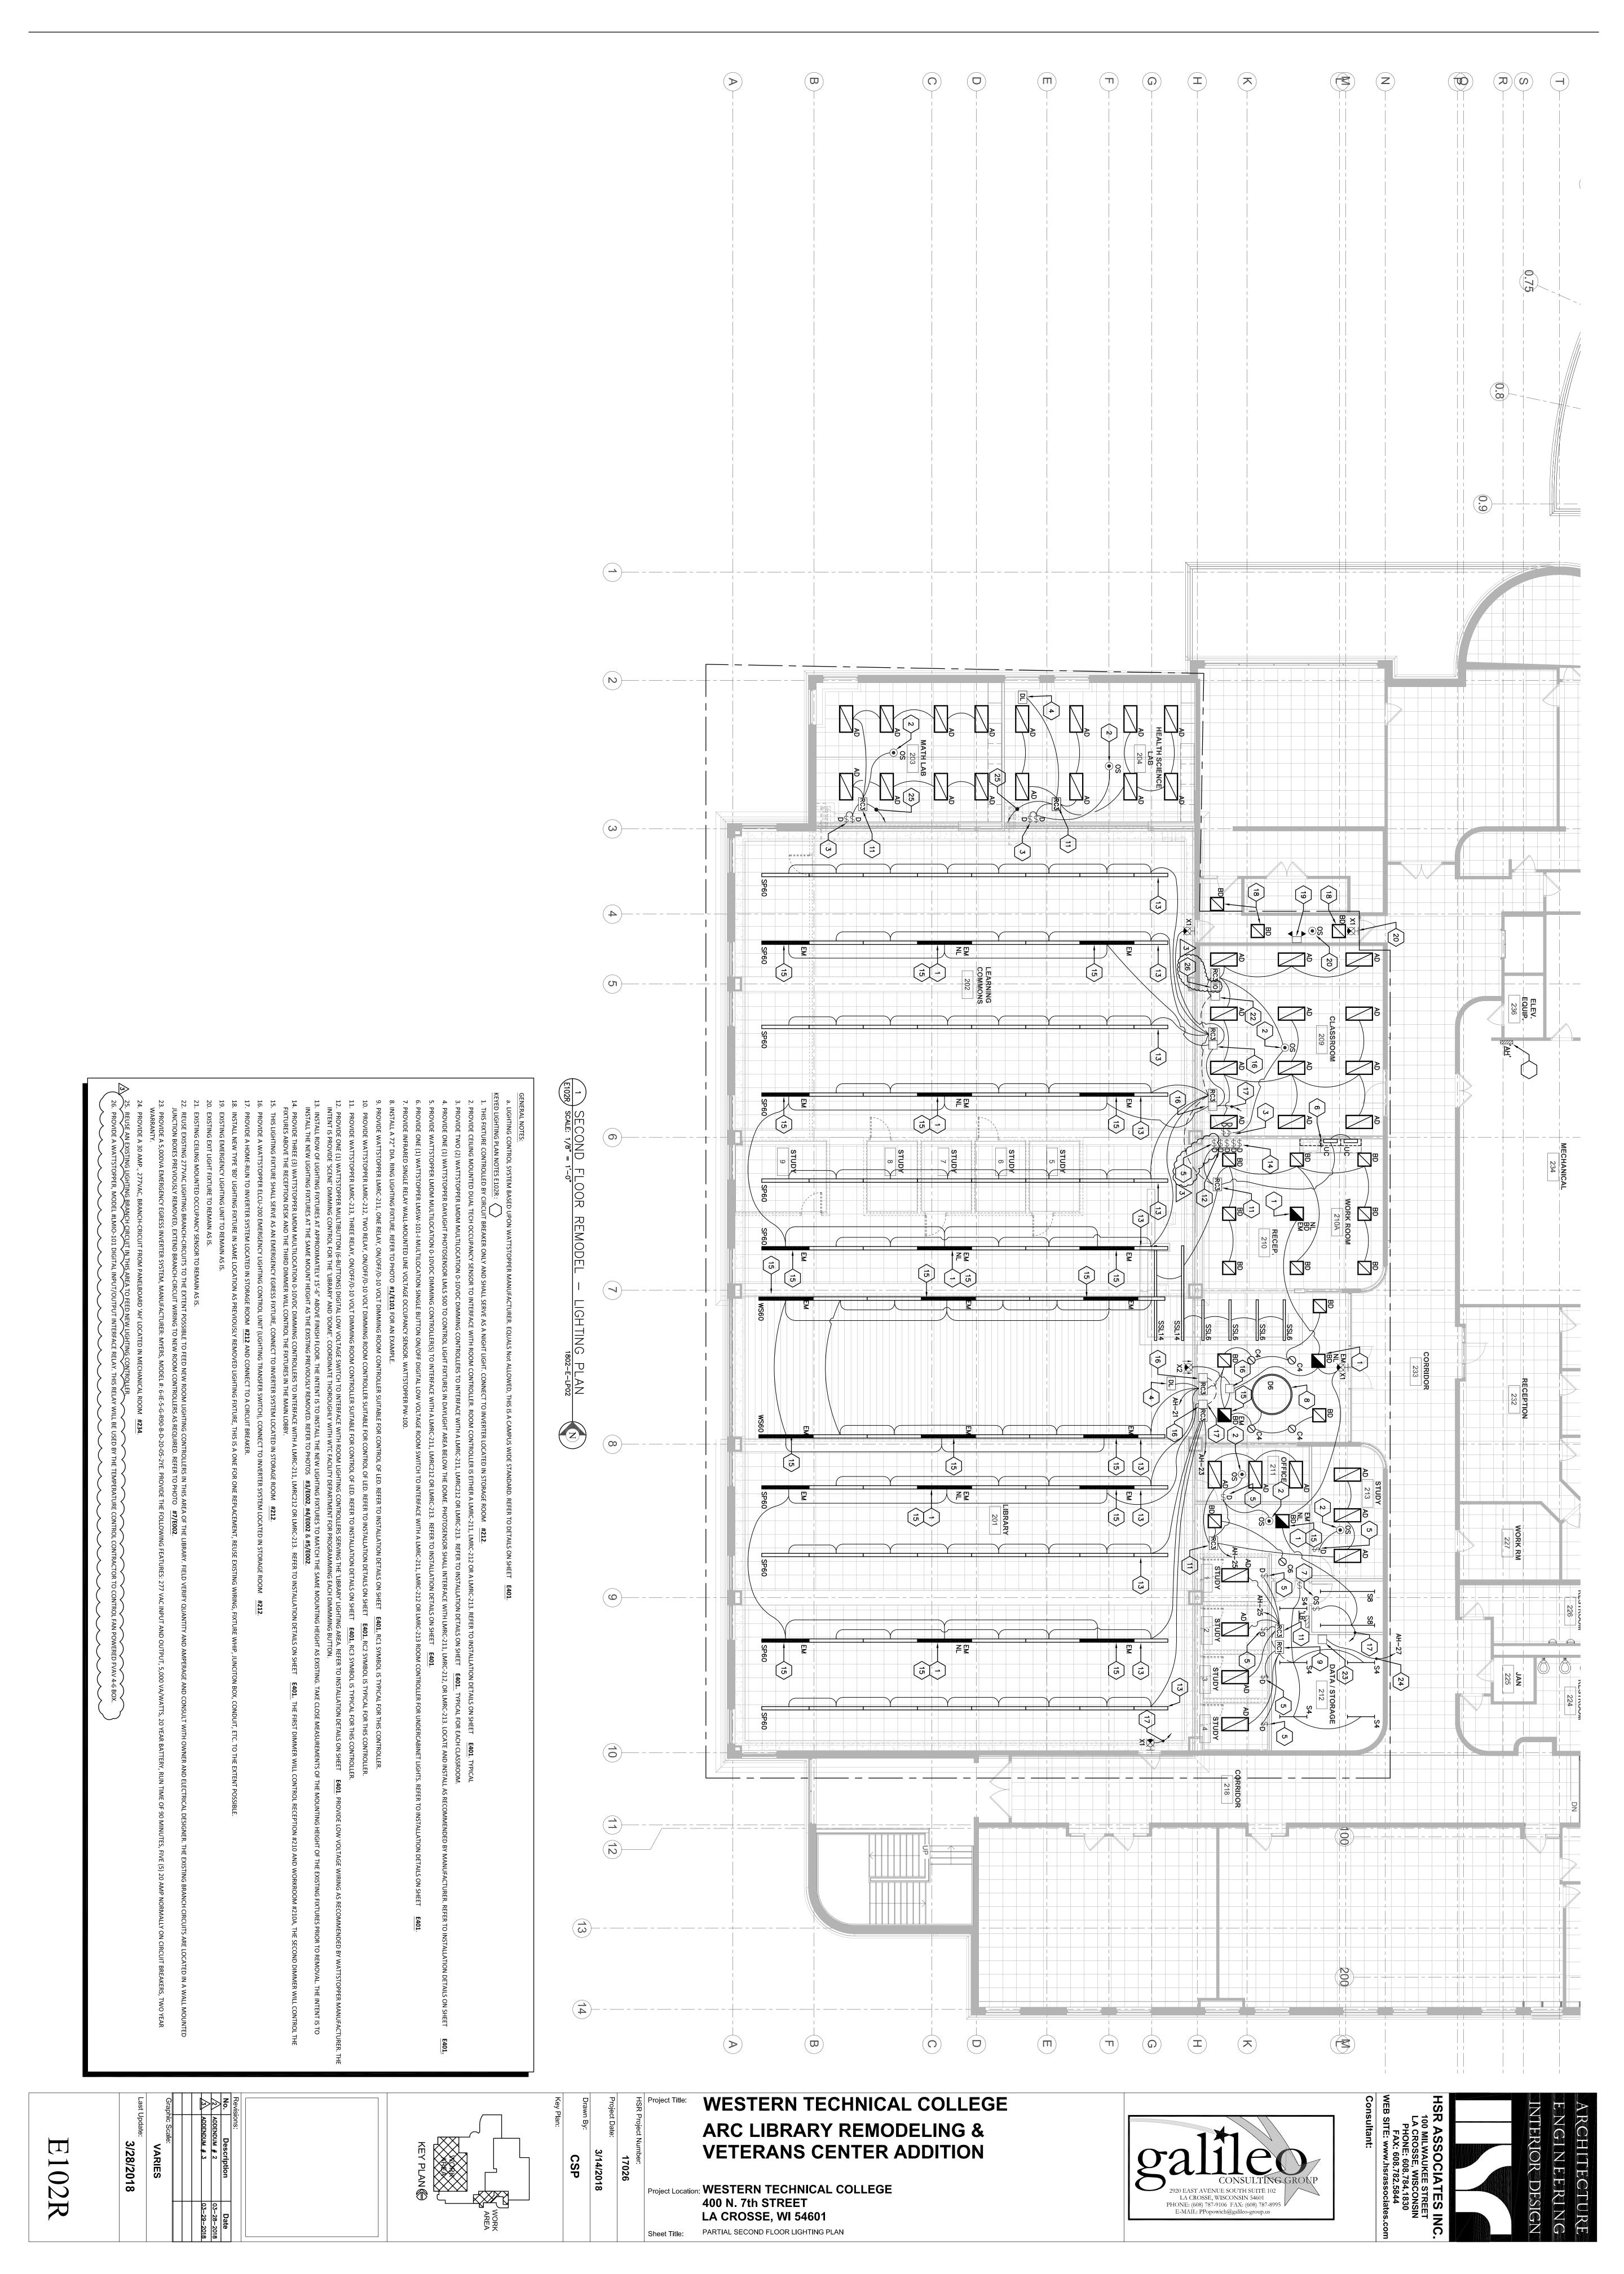

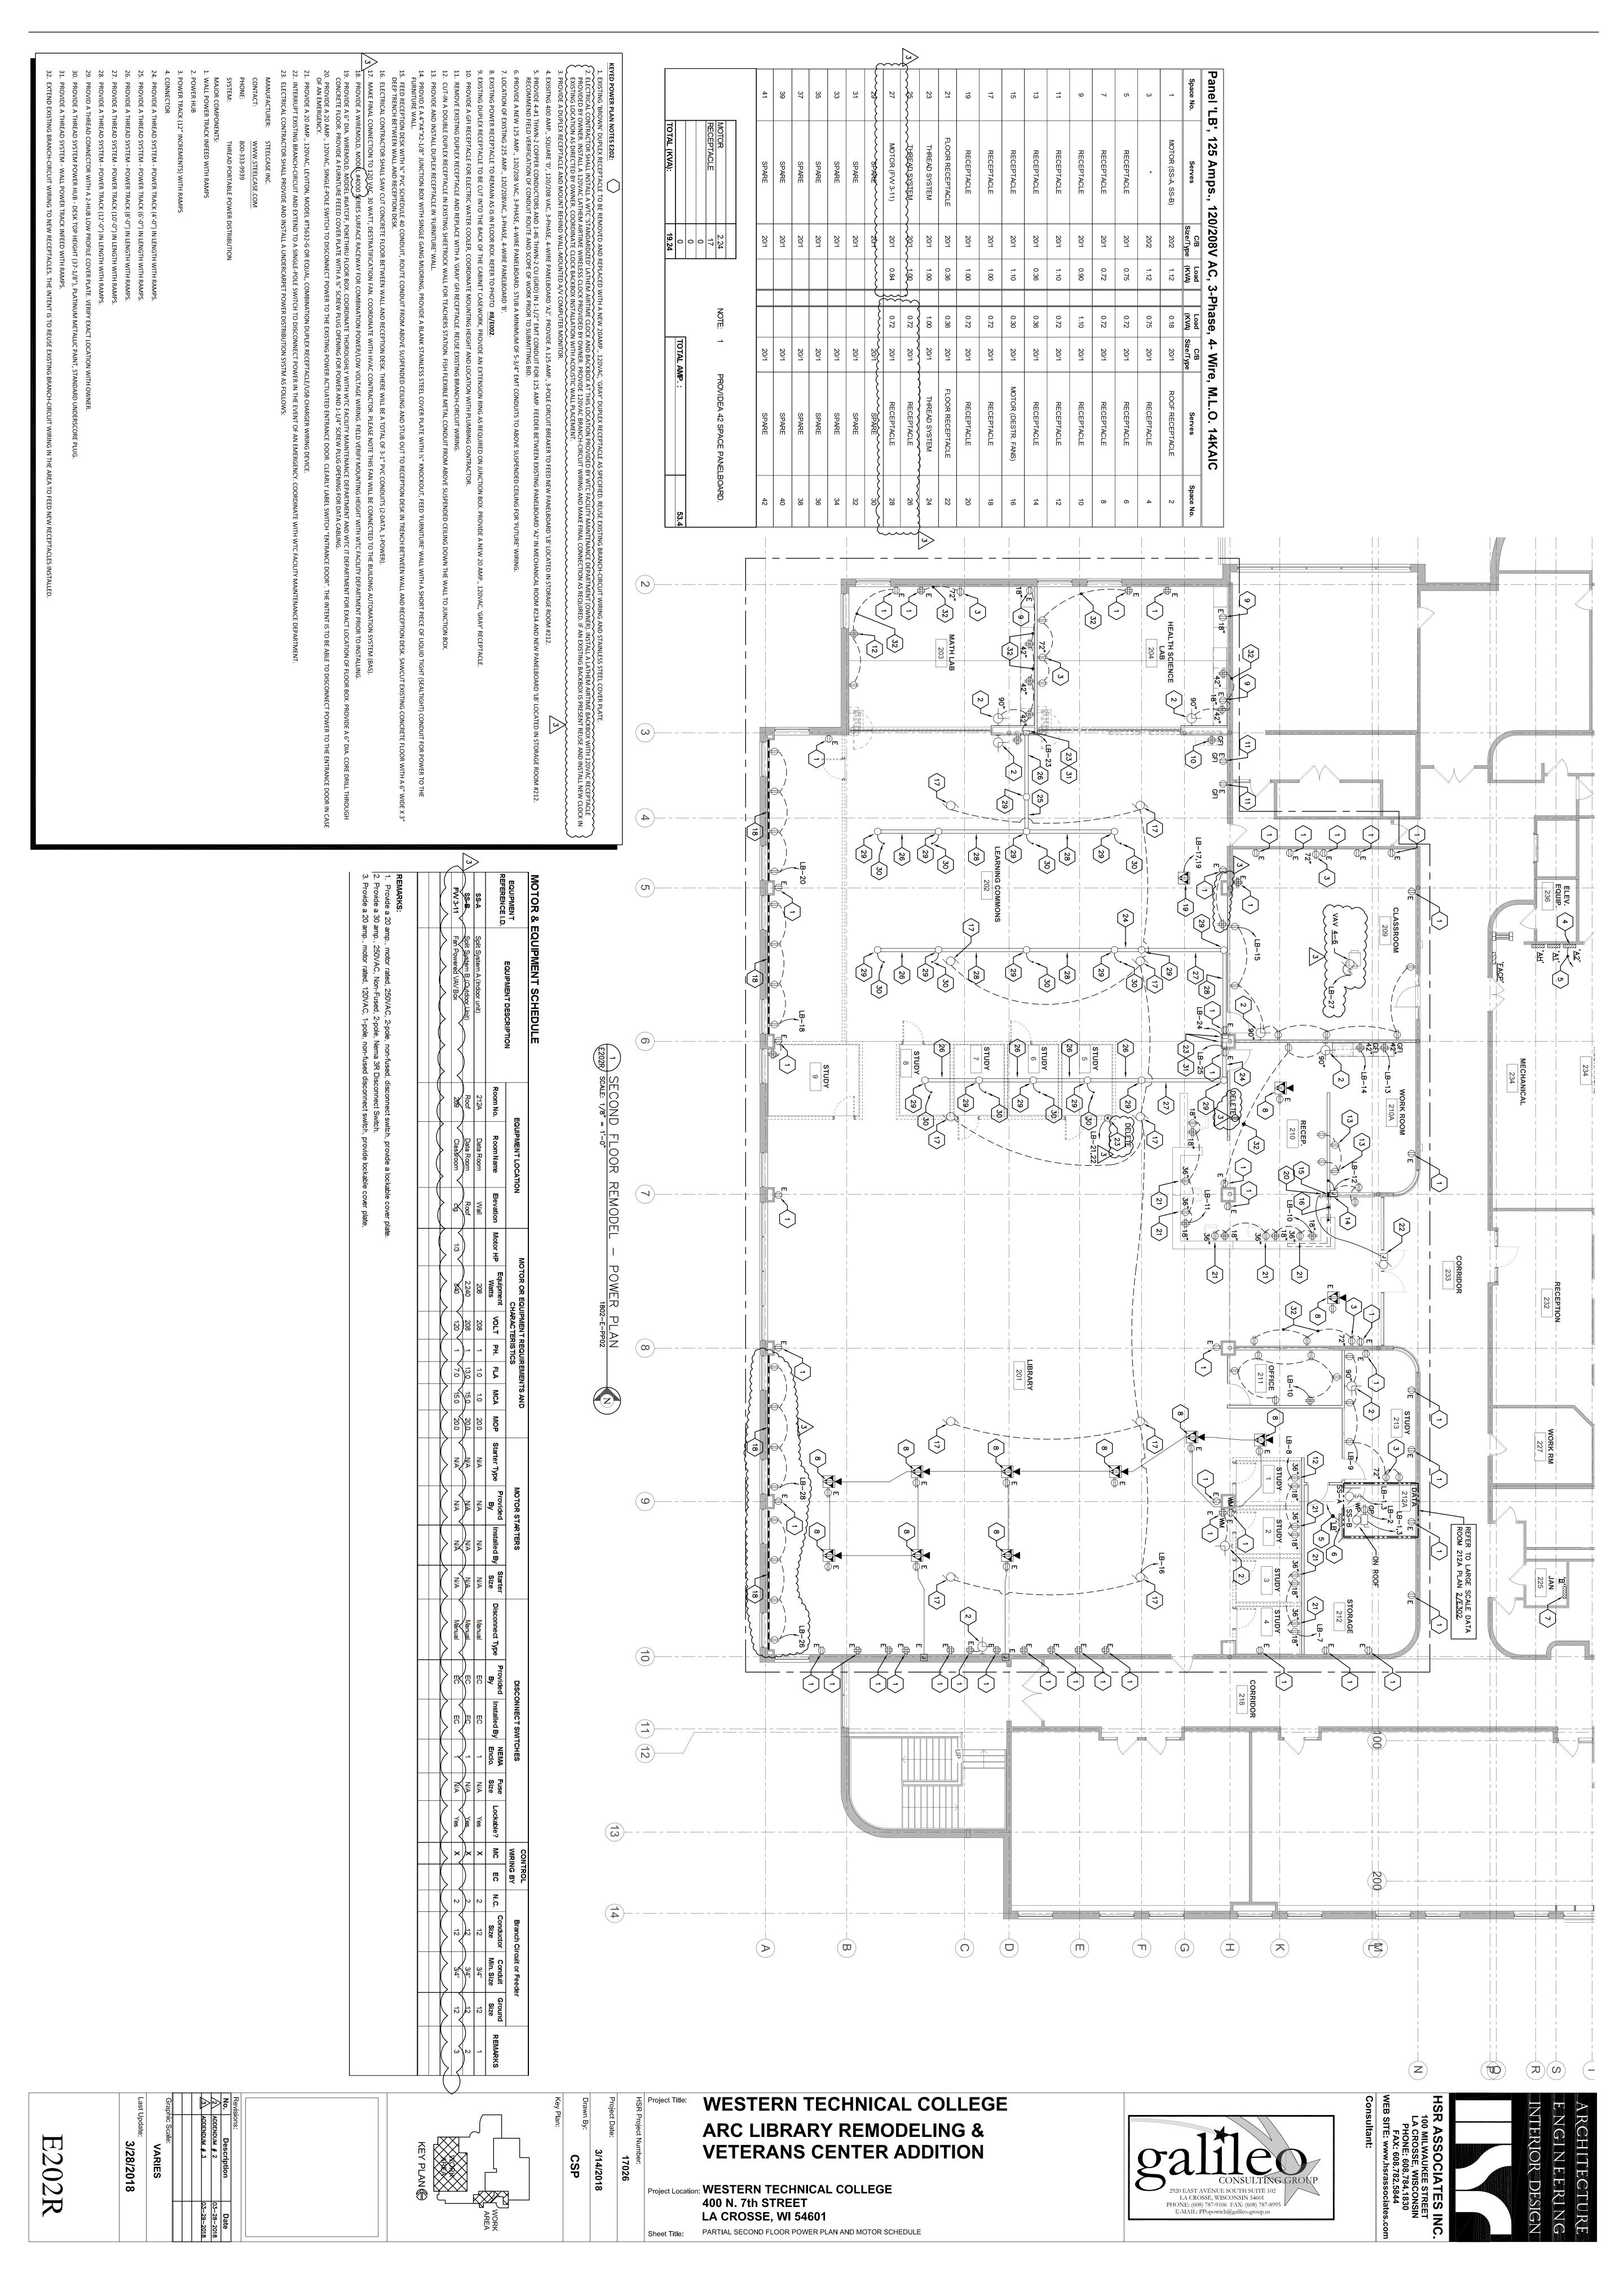



PARTIAL SECOND FLOOR LOW VOLTAGE PLAN