

**DOCUMENT 00 90 00
ADDENDUM**

ADDENDUM NO. [1] Date: October 24, 2018

**RE: PRENTICE SCHOOL DISTRICT
 ADDITION AND REMODELING BID PKG 3
 1025 TOWN ST
 PRENTICE, WI 54556
 HSR PROJECT NO. 18022**

**FROM: HSR Associates, Inc
 100 Milwaukee Street
 La Crosse, WI 54603
 (608) 784-1830**

To: Prospective Bidders

This addendum forms a part of the Contract Documents and modifies the original Bidding Documents dated October 2018. Acknowledge receipt of this Addendum in the space provided on the bid form. Failure to do so may subject the Bidder to disqualification.


This Addendum consists of [1] page, and [2] 30 x 42 drawings.

CHANGES TO DRAWINGS

1. Sheet A112R FLOOR PLAN UNIT B 30 x 42 attached hereto
 - a. Revisions clouded on Drawing. Changes to masonry openings in existing and new wall.
2. Sheet S200R ROOF & PENTHOUSE FLOOR FRAMING-UNIT C 30 x 42 attached hereto
 - a. Revisions clouded on Drawing

END OF DOCUMENT 00 90 00

Page Intentionally Left Blank

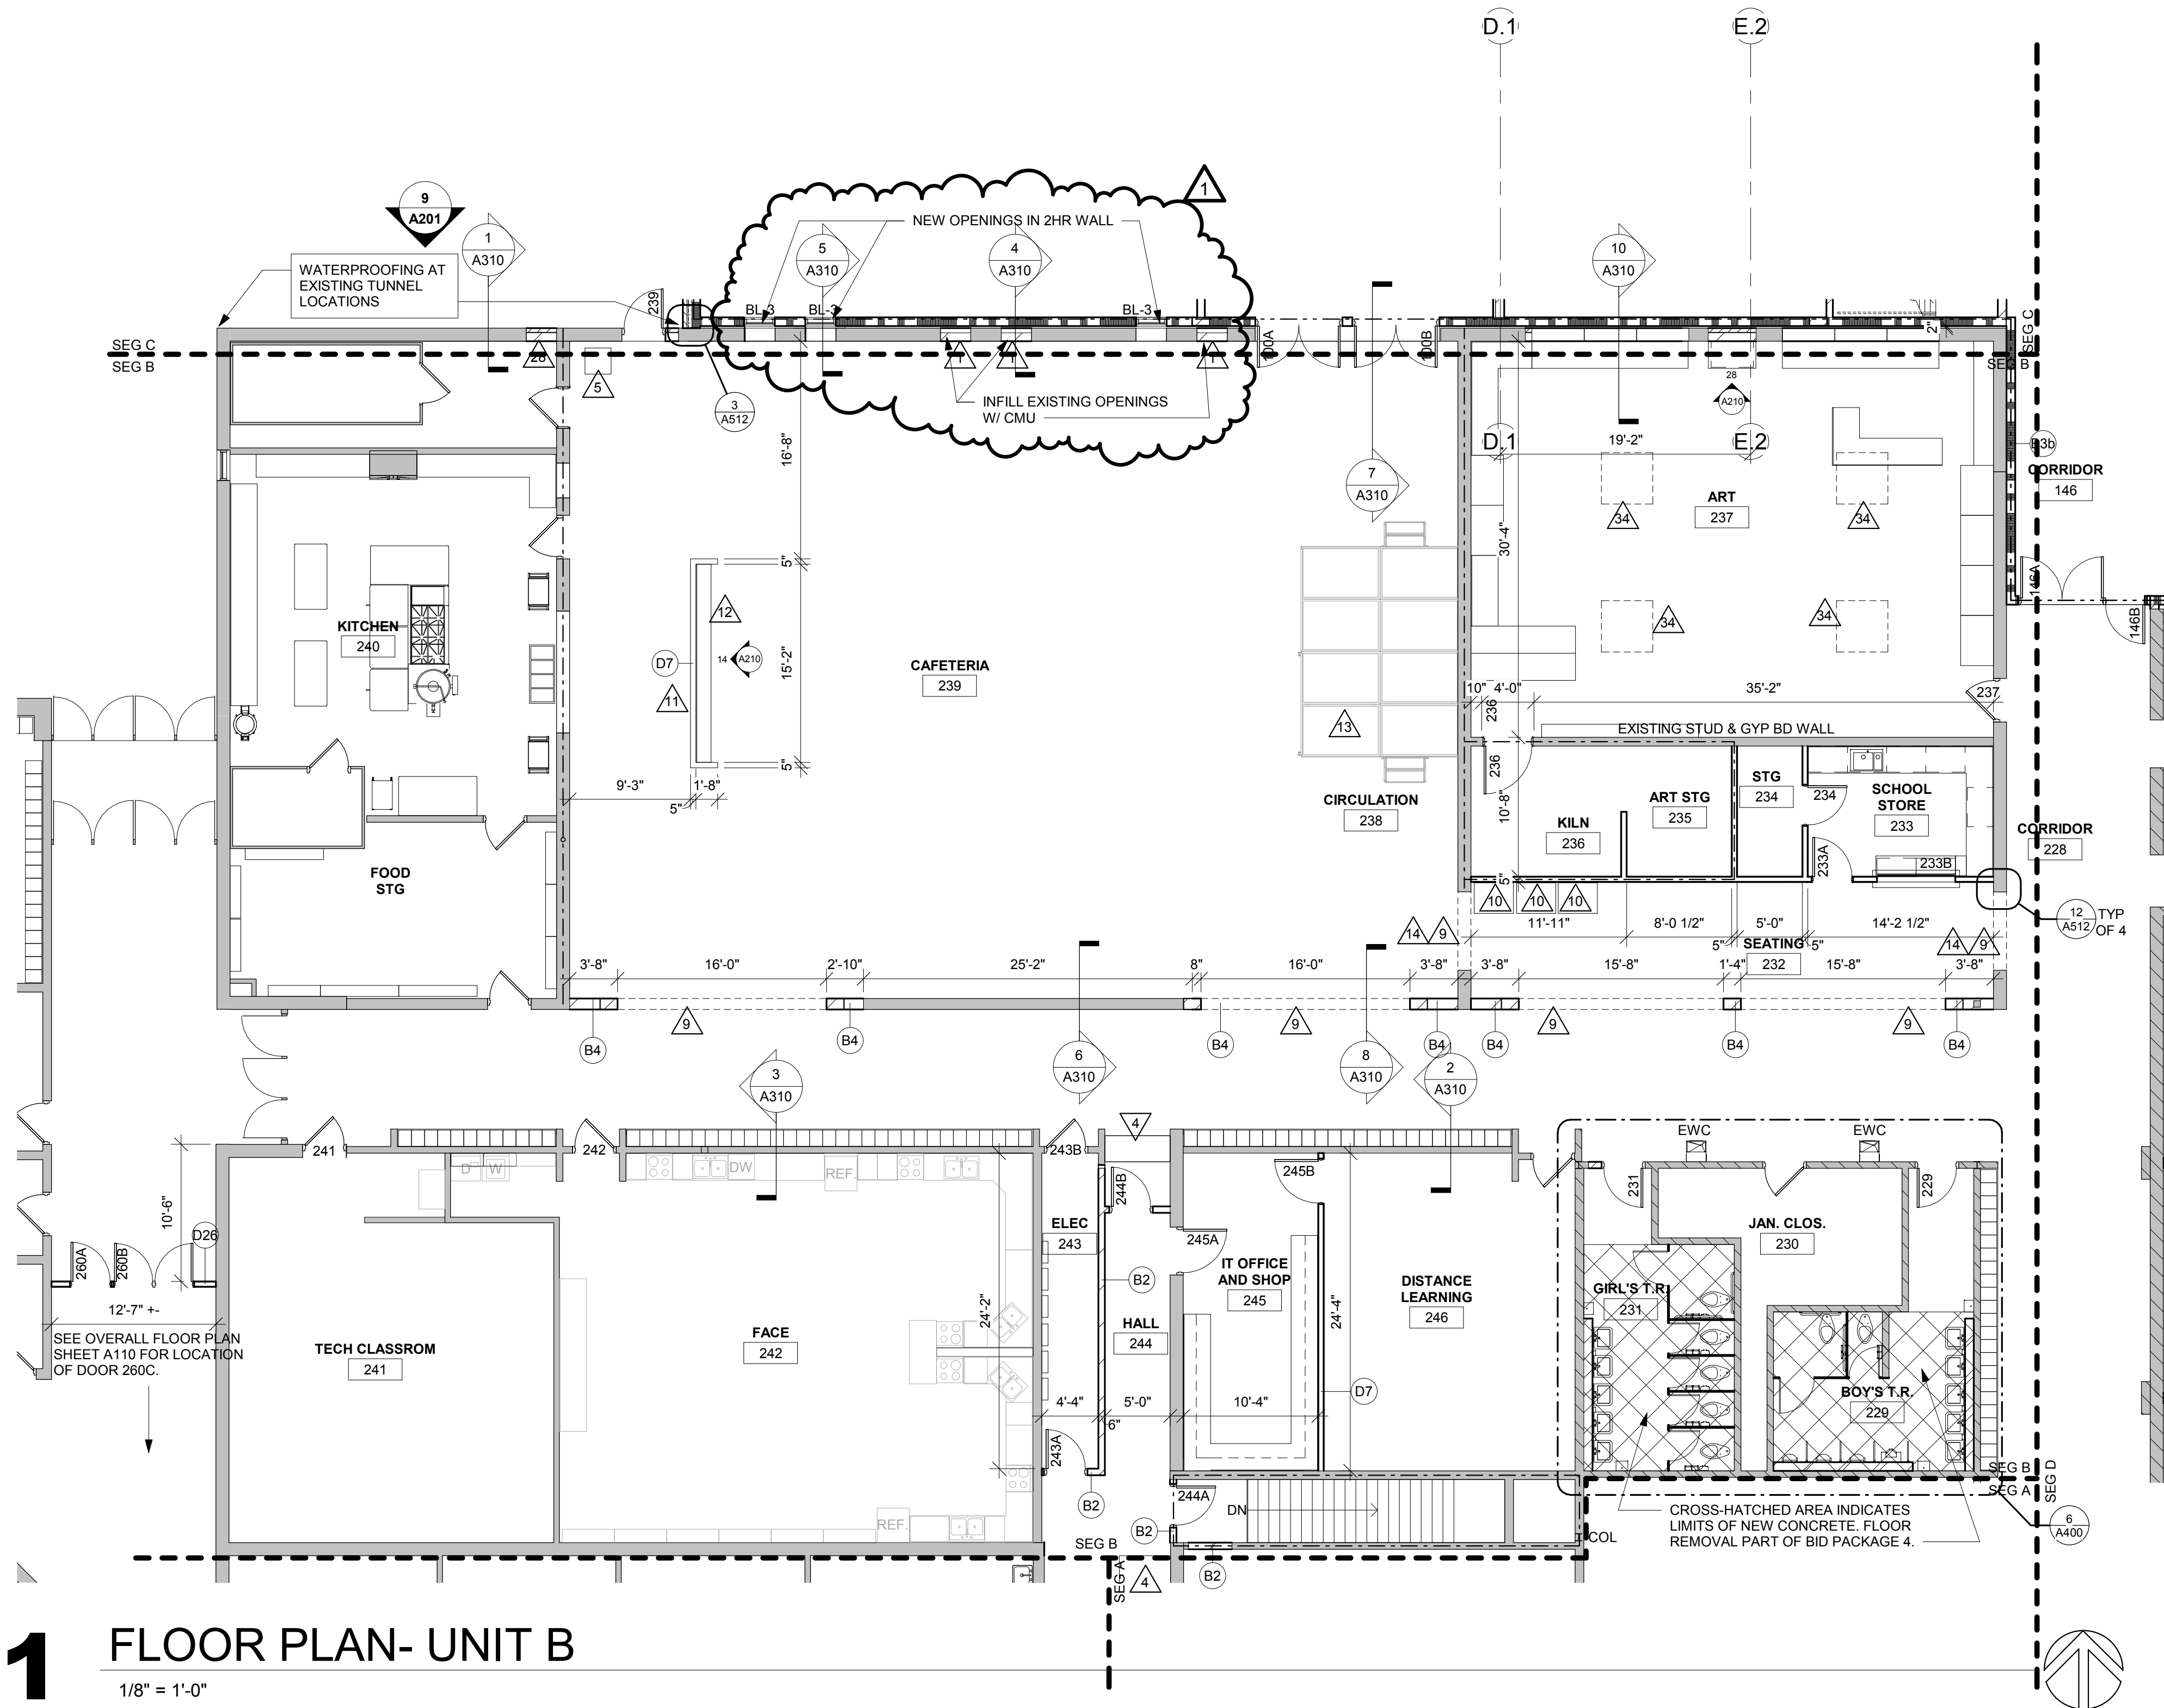

1 FLOOR PLAN- UNIT B
1/8" = 1'-0"

- GENERAL NOTES:**
- A SEE ID SHEETS FOR FLOOR AND WALL FINISH LAYOUTS.
 - B LOOSE FURNISHINGS EXCEPT AS NOTED SHALL BE PROVIDED AND INSTALLED BY THE OWNER.
 - C VERIFY EXACT SIZE AND LOCATION OF ALL MECHANICAL / PLUMB AND ELEC. OPENINGS - GENERAL CONTRACTOR SHALL BE RESPONSIBLE FOR FINISH AT ALL VISIBLE AREAS. ALL OPENING SHALL BE SEALED AFTER UTILITY INSTALLATION.
 - D PAINT ALL EXPOSED STEEL LINTELS.
 - E INSTALL BULLNOSE CMU AT ALL OUTSIDE CORNERS W/O TILE AND AT DOOR JAMBS AS DETAILED. NO BULLNOSE AT WINDOW JAMBS.
 - F SEE STRUCTURAL FOR SLAB CONTROL JOINTS.
 - G SEE A510 FOR WALL CONTROL JOINT DETAILS. SEE PLANS AND ELEVATIONS FOR CJ LOCATIONS. CJ = CONTROL JOINTS.
 - H REFER TO CODE PLANS FOR FIRE RATING LOCATIONS AND ACCESSIBILITY ROUTES.
 - I EXTEND ALL WALLS TO DECK UNLESS NOTED OTHERWISE. SEE A601 FOR TOP OF WALL DETAILS.
 - J UNLESS NOTED OTHERWISE RESTROOM FLOORS SHALL BE SLOPED A MIN. 1/16" - 1/2" TO FLOOR DRAINS - TO "CENTER", IF NO FLOOR DRAINS.
 - K SEE A512 FOR TYPICAL HEAD FLASHING AND THROUGH-WALL FLASHING ISOMETRIC DETAILS.
 - L GEN. CONTRACTOR TO PROVIDE CONC. EQUIP. PADS/CURBS AS REQUIRED FOR MECH/ELECTRICAL EQUIP. - VERIFY SIZE/PROFILE/LOCATION WITH MECH/ELECTRICAL.
 - M PLAN DIMENSIONS ARE FROM FACE OF WALL TO FACE OF WALL.
 - P ALL DOOR FRAMES TO BE 4" FROM CORNERS UNLESS NOTED OTHERWISE.

- LEGEND:**
- A SYMBOL INDICATES WALL TYPE - SEE SHEET A601 FOR WALL TYPE DETAILS.
 - A SYMBOL INDICATES WINDOW TYPE. SEE SHEET A602 FOR WINDOW FRAME ELEVATIONS.
 - SYMBOL INDICATES CONSTRUCTION NOTE THIS SHEET
 - 1 HOUR WALL
 - 2 HOUR WALL
 - COL EXISTING STEEL COLUMN
 - EWC ELECTRIC WATER COOLER
 - FE FIRE EXTINGUISHER- BRACKET MOUNTED
 - FEC FIRE EXTINGUISHER CABINET
 - MB-11" MARKER BOARD- 48" HIGH x LENGTH INDICATED ON PLAN
 - SB SMART BOARD
 - SWB SLOTTED WALL BOARD- 24" HIGH x LENGTH INDICATED ON PLAN
 - TB TACK BOARD- 48" HIGH x 48" WIDE
 - TS-11" TACK STRIPS- MOUNT (1) AT 44" AFF AND (1) AT 84" AFF x LENGTH INDICATED ON PLAN

- KEY NOTES PLAN**
- 1 INFILL EXISTING OPENING WITH CMU. MATCH ADJACENT FINISHES.
 - 2 NEW FOLDING PANEL PARTITION.
 - 3 INFILL EXISTING SLAB DEPRESSION.
 - 4 FLOOR OPENING INFILL. SEE
 - 5 PERMANENTLY SECURE EXISTING TUNNEL ACCESS PANELS.
 - 6 RELOCATED DOOR/ TRANSOM.
 - 7 LINE OF CANOPY ABOVE.
 - 8 NEW CHEM COUNTERTOP, INTEGRAL SINK, GAS VALVES AND ELECTRICAL OUTLETS. SEE CASEWORK DRAWINGS, PLUMBING AND ELECTRICAL.
 - 9 LINE OF BULKHEAD ABOVE.
 - 10 VENDING MACHINES (N.I.C.)
 - 11 PARTIAL HT WALL T.O. WALL @ 4'-0".
 - 12 PLAM CONDIMENT COUNTER @ 34" AFF.
 - 13 MOBILE STAGE (N.I.C.)
 - 14 INFILL FLOOR AS REQUIRED AFTER REMOVAL OF CMU WALL. PREPARE FOR NEW FLOORING.
 - 15 12"W x 15"D LOCKERS ON 4" CONCRETE SLAB.
 - 16 12"W x 15"D CURBIES ON 4" CONCRETE SLAB.
 - 17 PROVIDE 3/4" PLYWOOD PANEL- COORDINATE SIZE AND MOUNTING HT WITH ELECTRICAL.
 - 18 STEEL COLUMN- SEE STRUCTURAL.
 - 19 MOP SINK- SEE PLUMBING.
 - 20 ROOF DRAIN LEADER- SEE PLUMBING AND DETAIL 4/A512.
 - 21 SOLID SURFACE SILL.
 - 22 REMOVABLE RAILINGS.
 - 23 DIMENSION INDICATES PRECAST PANEL OVERHANG AT FOUNDATION BELOW. SEE DETAIL 1/A400.
 - 24 CONCRETE STOOP- SEE STRUCTURAL.
 - 25 4 3/4" FLOOR INFILL TO MATCH HEIGHT OF GYM FLOOR. SEE DETAIL 4/A512.
 - 26 STUD AND GYP BD COLUMN ENCLOSURE. SEE 8/A512.
 - 27 CHAIR LIFT
 - 28 INFILL OPENING TO MATCH EXISTING EXTERIOR WALL.
 - 29 RAMP- 15% SLOPE
 - 30 RAMP- 8.3% SLOPE
 - 31 PERFORATED WINDOW BLINDS.
 - 32 INSTALL SOUNDPROOFING FLOOR MAT AND 4 x 8 x 3/4" PLYWOOD ON EXISTING STAGE. PAINT BLACK.
 - 33 SHADED LINES INDICATE LOCATION OF IN-FLOOR HEATING. SEE 10/A512.
 - 34 LINE OF SKYLIGHT ABOVE.
 - 35 EXISTING SLOPED SILL TO REMAIN (NON ADA).
 - 36 CABINET HEATER. SEE MECH SHEETS.
 - 37 CANOPY COLUMN- SEE
 - 38 EXISTING DATA CABINET.
 - 39 ROOM DARKENING SHADES.
 - 40 PLAM SHELVES IN EXISTING WINDOW AND DOOR OPENINGS.
 - 41 LINE OF AWNING ABOVE. SEE
 - 42 PAD ALL WALLS- FLOOR TO 6'-0" AFF.
 - 43 6" STUDS CHASE AT VENT PIPE LOCATIONS- COORDINATE WITH PLUMBING.
 - 44 PLAN

ARCHITECTURE
ENGINEERING
INTERIOR DESIGN



HSR ASSOCIATES INC.
100 MILWAUKEE STREET
LA CROSSE, WISCONSIN
PHONE: 608.784.1830
FAX: 608.782.5844
www.hsrassociates.com


Consultant:

**PRENTICE SCHOOL DISTRICT
ADDITION AND REMODELING**

Project Title:
Project Location: 1025 Town Street
Prentice, WI 54556
Sheet Title:

FLOOR PLAN- UNIT B

HSR Project Number:
18022
Project Date:
OCTOBER 19, 2018
Drawn By:
MPL

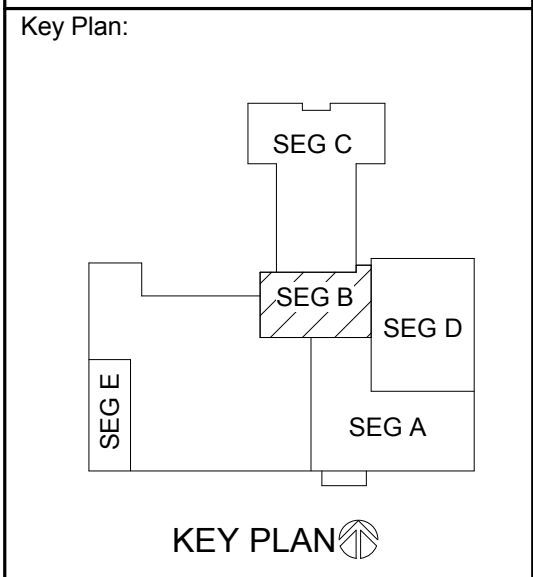


Revisions:

No.	Description	Date
1	ADD 1	10-25-18

Graphic Scale:
VARIES
Last Update:
10/24/2018 2:17:55 PM

A112R

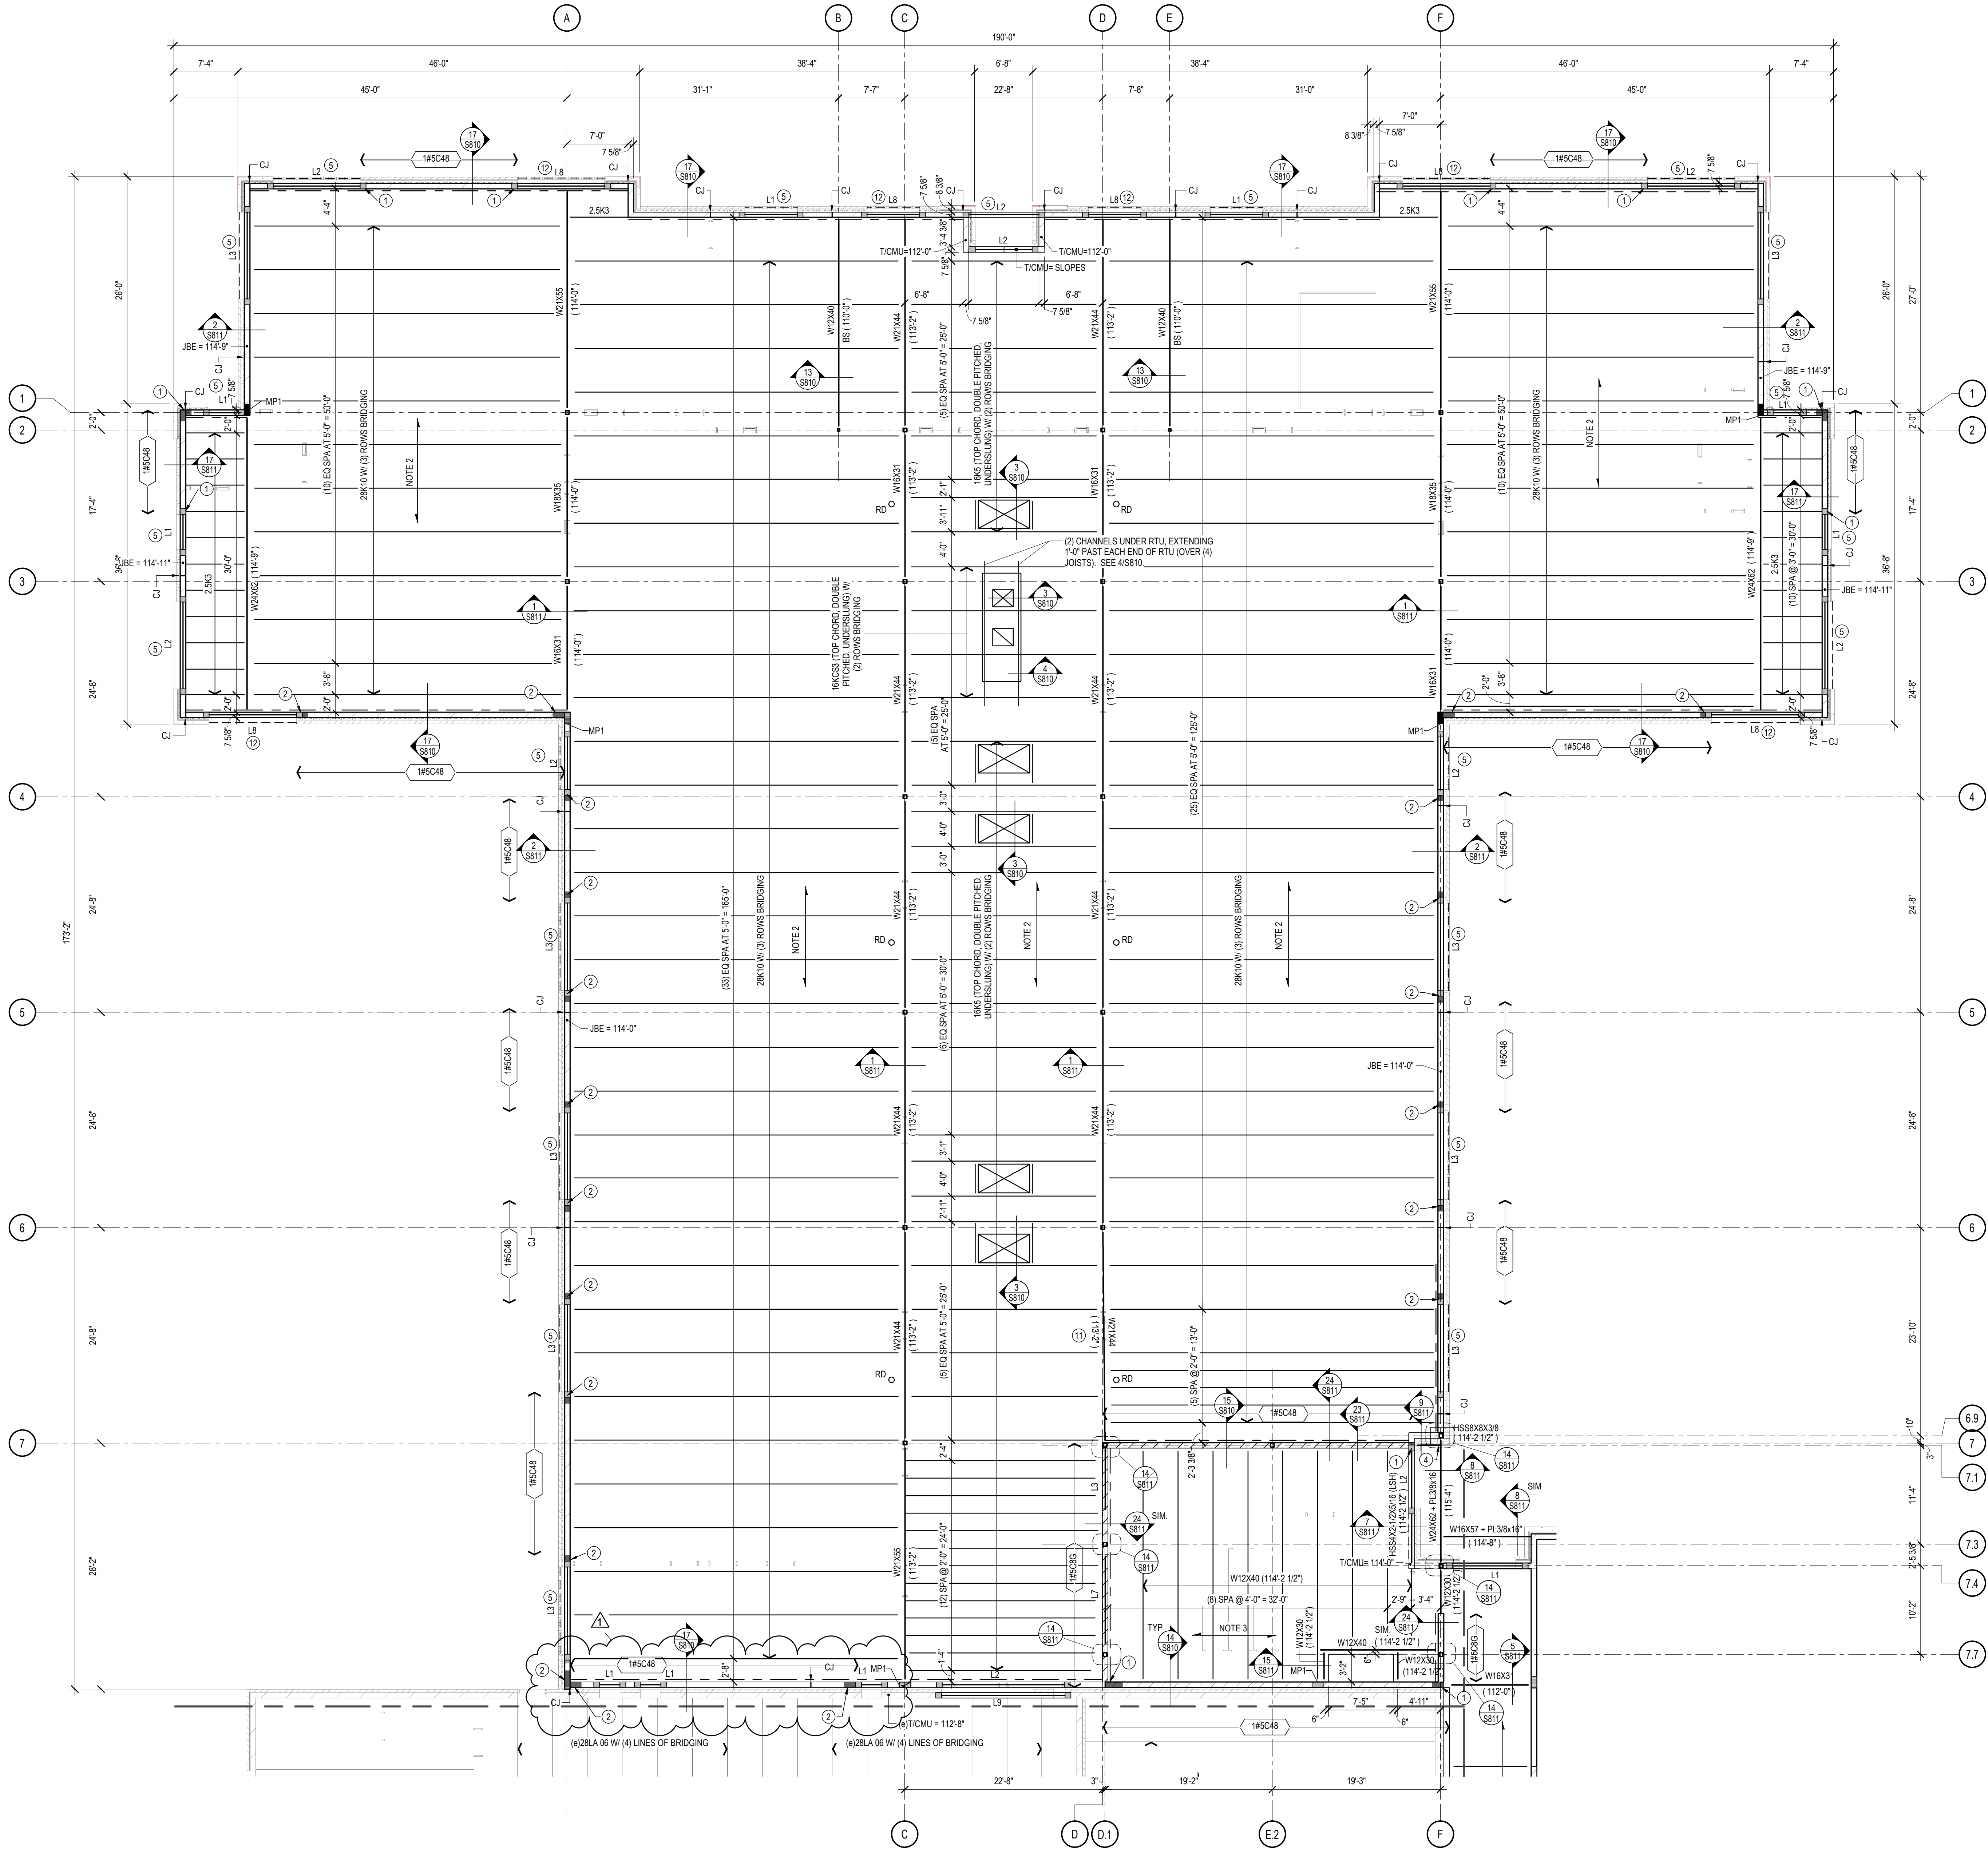

- ROOF FRAMING PLAN NOTES**
- TOP OF BASE STEEL (JOIST BEARING) ELEVATION = (XXX'X").
 - ROOF DECKING SHALL BE 1 1/2" x 20GA WIDE RIB PRIME PAINTED METAL ROOF DECK FASTENED TO SUPPORTING STRUCTURE USING 3/8" PATTERN OF ANY OF THE ATTACHMENT METHODS SHOWN IN DETAIL 15S810 WITH #10 TEK SIDELAP FASTENERS AT 18" OC. PROVIDE DECK WITH THE FOLLOWING PROPERTIES:
THICK = 0.0358 in $I_y = 0.201 \text{ in}^4$ $S_y = 0.234 \text{ in}^3$
 $F_y = 33 \text{ KSI}$ $I_x = 0.222$ $S_x = 0.247 \text{ in}^3$
 - INSTALL DECK UNDER 3 OR MORE SPAN CONDITIONS.
 - ROOF DECKING SHALL BE 1 1/2" x 20GA WIDE RIB ACOUSTIC PRIME PAINTED METAL ROOF DECK FASTENED TO SUPPORTING STRUCTURE USING 3/8" PATTERN OF ANY OF THE ATTACHMENT METHODS SHOWN IN DETAIL 15S810 WITH #10 TEK SIDELAP FASTENERS AT 18" OC. PROVIDE DECK WITH THE FOLLOWING PROPERTIES:
THICK = 0.0358 in $I_y = 0.201 \text{ in}^4$ $S_y = 0.234 \text{ in}^3$
 $F_y = 33 \text{ KSI}$ $I_x = 0.222$ $S_x = 0.247 \text{ in}^3$
 - INSTALL DECK UNDER 3 OR MORE SPAN CONDITIONS.
 - PROVIDE 8" HIGH BOND BEAM WITH (2) #4 CONTINUOUS AT AND ADJACENT TO JOIST BEARING ELEVATIONS UNLESS NOTED OTHERWISE. WHERE JOIST BEARING IS NOT AT COURSE, PROVIDE PARTIAL HEIGHT BLOCK GROUTED SOLID TO TOP OF BOND BEAM. WIDTH OF BOND BEAM TO MATCH WALL THICKNESS AND IS TO RUN CONTINUOUS THROUGH CONTROL JOINTS. PROVIDE CORNER BARS WHERE THEY OCCUR AND LAP ALL BOND BEAM STEPS A MINIMUM OF 24".
 - JOIST SUPPLIER TO PROVIDE CONTINUOUS TOP AND BOTTOM CHORD HORIZONTAL ANGLE BRIDGING AS REQUIRED. PROVIDE DIAGONAL X-BRIDGING WHERE INDICATED.
 - PROVIDE ANGLE FRAME SUPPORT AT ALL ROOF OPENINGS IN ACCORDANCE WITH DETAIL 3S810.
 - REFER TO SHEET S002 FOR COLUMN SCHEDULE.
 - BRACE TOP OF NON-LOAD BEARING CMU WALLS IN ACCORDANCE WITH DETAILS 11S810 & 12S810.
 - ALL 8" CMU WALLS SHALL BE REINFORCED WITH (1) #5 VERTICAL (FULL WALL HEIGHT GROUTED) AT 48" O.C. UNLESS NOTED OTHERWISE ON PLAN.

- ROOF FRAMING KEY NOTES**
- SEE 8A/S810 FOR REINFORCING AT BOUNDARY ELEMENTS OF THIS WALL SEGMENT
 - SEE 8B/S810 FOR REINFORCING AT BOUNDARY ELEMENTS OF THIS WALL SEGMENT
 - SEE 8C/S810 FOR REINFORCING AT BOUNDARY ELEMENTS OF THIS WALL SEGMENT
 - SHEAR TAB CONNECTION TO W24
 - REFER TO DETAIL 18S810 FOR VENER LITEL
 - COLUMN (SEE PLAN) UP TO BOTTOM OF LITEL
 - JOISTS SELECTED BASED ON FULL DRIFT FOR FULL LENGTH (SL = 116 PSF)
 - VERIFY EXISTING FRAMING CONSTRAINTS AND DIMENSIONS IN FIELD BEFORE JOIST FABRICATION
 - 5/8" PLYWOOD OVER 10" CFMF FLOOR JOISTS AT 18" O.C. FINAL MEZZANINE DESIGN BY CFMF SUPPLIER. 125 PSF LIVE LOAD. FINISH FLOOR ELEV = 108'-9.14"
 - HEADER BY CFMF DESIGNER CAPABLE OF TRANSFERRING WIND LOAD AROUND OPENING.
 - BEAM RUNS AT A SKEW (3" SKEW OVER 24'-11" COLUMN TO COLUMN LENGTH). EXTEND JOIST SEATS AS NECESSARY TO MEET MINIMUM BEARING REQUIREMENTS.
 - REFER TO DETAIL 16S811 FOR VENER LITEL
 - FOLDING PARTITION. SEE ARCHITECTURAL PLANS. STRUCTURAL BASIS OF DESIGN IS HUPCOR 630 SERIES (10 PSF WEIGHT OR LESS).
 - FOLDING GLASS PARTITION. SEE ARCHITECTURAL PLANS. STRUCTURAL BASIS OF DESIGN IS HUPCOR SERIES GA1 (10 PSF WEIGHT OR LESS).
 - MINIMIZE DEMO OF EXISTING ELEMENTS REQUIRED FOR INSTALLATION OF NEW FRAMING AND FOUNDATIONS.
 - STOP MOMENT FRAME BEAM AT FACE OF MASONRY WALL (LEAVE 1/2" GAP).
 - SEE 22S811 FOR BEAM PASSING OVER COLUMN DETAIL.
 - SEE 15S002 FOR TYPICAL BEAM TO COLUMN MOMENT CONNECTION DETAIL.

- FLOOR FRAMING PLAN NOTES**
- FINISH SLAB ELEVATION = 114'-7 1/2" UNLESS NOTED OTHERWISE.
 - SEE PLAN FOR T/STEEL ELEVATIONS.
 - TYPICAL SLAB IS 5" THICK CONSISTING OF 3 1/2" NORMAL WEIGHT (145 PCF) CONCRETE REINFORCED WITH MACRO POLYPROPYLENE FIBERS ON 1 1/2" 20 GAGE PRIME PAINTED COMPOSITE UNFURRED METAL DECK FASTENED TO SUPPORTING STRUCTURE USING A 3/8" PATTERN OF ANY OF THE ATTACHMENT METHODS SHOWN IN 15S810 WITH #10 TEK SIDELAP FASTENERS AT 18" O.C. PROVIDE DECK WITH THE FOLLOWING PROPERTIES UNDER 3 OR MORE SPANS:
THICK = 0.0358 in $I_y = 0.186 \text{ in}^4$ $S_y = 0.224 \text{ in}^3$
 $F_y = 50 \text{ ksi}$ $I_x = 0.222 \text{ in}^4$ $S_x = 0.231 \text{ in}^3$
 - VERIFY ALL OPENING DIMENSIONS AND LOCATIONS WITH ARCHITECTURAL AND MECHANICAL DRAWINGS PRIOR TO STEEL FABRICATION.
 - SEE S002 FOR COLUMN SCHEDULE.
 - BRACE TOP OF NON-LOAD BEARING CMU WALLS IN ACCORDANCE WITH DETAIL 11S810 & 12S810.
 - ALL 8" CMU WALLS SHALL BE REINFORCED WITH (1) #5 VERTICAL (FULL WALL HEIGHT GROUTED) AT 48" O.C. UNLESS NOTED OTHERWISE ON PLAN.

STRUCTURAL STEEL LEGEND

- INDICATES BEAM FRAMING OVER OR THRU HSS OR WF COLUMN
- INDICATES BEAM FRAMING INTO SIDE OF HSS OR WF COLUMN
- COLUMN MARK / COLUMN SIZE
- INDICATES BEAM-TO COLUMN MOMENT FRAME CONNECTION TOP OF STEEL ELEVATION SHOP CAMBER
- FIELD APPLIED SHEAR STUDS BETWEEN BEAM ENDS AND/OR CONCENTRATED LOADS
- BEAM DESIGNATION
- JOIST GIRDER DESIGNATION
- INDICATED LOCATION OF BEAM SPLICE
- INDICATES EXISTING BEAM / JOIST FRAMING INTO SIDE OF NEW GIRDER
- INDICATES BEAM / JOIST FRAMING INTO SIDE OF GIRDER
- INDICATES BEAM / JOIST FRAMING OVER GIRDER
- INDICATES MOMENT CONNECTION BETWEEN BEAMS ACROSS GIRDER IN SAME HORIZONTAL PLANE
- MEMBER SIZES OR MARKS WITH A PREFIX OF (W) ARE EXISTING ELEMENTS

ARCHITECTURE
ENGINEERING
INTERIOR DESIGN



HSR ASSOCIATES INC.
100 MILWAUKEE STREET
LA CROSSE, WISCONSIN
PHONE: 608.784.1830
FAX: 608.782.5844
www.hsrassociates.com

Consultant:

raSmith
CREATIVITY BEYOND ENGINEERING
raSmith.com
project number: 1180371

Contractors are responsible for the means, methods, techniques, sequences and procedures of construction including, but not limited to, temporary supports, shoring, bracing to support imposed loads and other similar items.

PRENTICE SCHOOL DISTRICT
ADDITION AND REMODELING


Project Title:
Project Location: 1025 Town Street
Prentice, WI 54556

Project Number:
18022

Project Date:
OCTOBER 19, 2018

Drawn By:
raSmith

Key Plan:

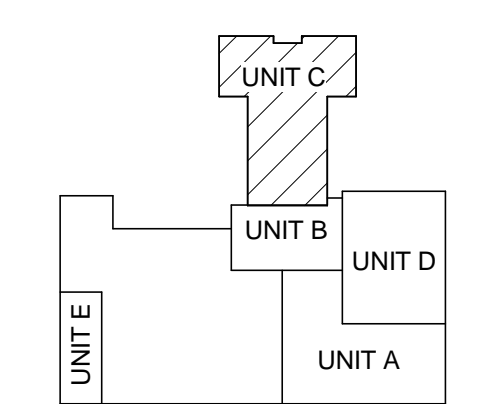

KEY PLAN

No.	Description	Date
1	BP3 ADD1	10/19/18
1	BP3 ADD1	10/25/18

Graphic Scale:
0' 2' 4' 6' 12'

Last Update:
10/24/2018 1:39:01 PM

S200R

ROOF & PENTHOUSE FLOOR FRAMING - UNIT C