

**DOCUMENT 00 90 00
ADDENDUM**

ADDENDUM NO. [7] Date: March 15, 2019

**RE: WESTERN TECHNICAL COLLEGE
 ARC & WELCOME CENTER REMODELING PHASE 2
 400 SEVENTH STREET NORTH
 LA CROSSE, WISCONSIN 54601
 HSR PROJECT NO. 18047**

**FROM: HSR Associates, Inc
 100 Milwaukee Street
 La Crosse, WI 54603
 (608) 784-1830**

To: Prospective Bidders

This addendum forms a part of the Contract Documents and modifies the original Bidding Documents dated February 2019. Acknowledge receipt of this Addendum in the space provided on the bid form. Failure to do so may subject the Bidder to disqualification.

This Addendum consists of [1] page, and [1] 30 x 42 drawings.

CHANGES TO DRAWINGS

1. Sheet M103R SECOND FLOOR HVAC PIPING REMODEL PLAN 30 x 42 attached hereto
 - a. Revisions clouded on Drawing.

END OF DOCUMENT 00 90 00



WESTERN TECHNICAL COLLEGE
ARC PHASE 2 REMODEL


Project Location: 400 N. 7TH STREET
LA CROSSE, WI 54601

Project Title:
HSR Project Number:
18047

Project Date:
FEBRUARY 2019

Drawn By:
kkl

Key Plan:

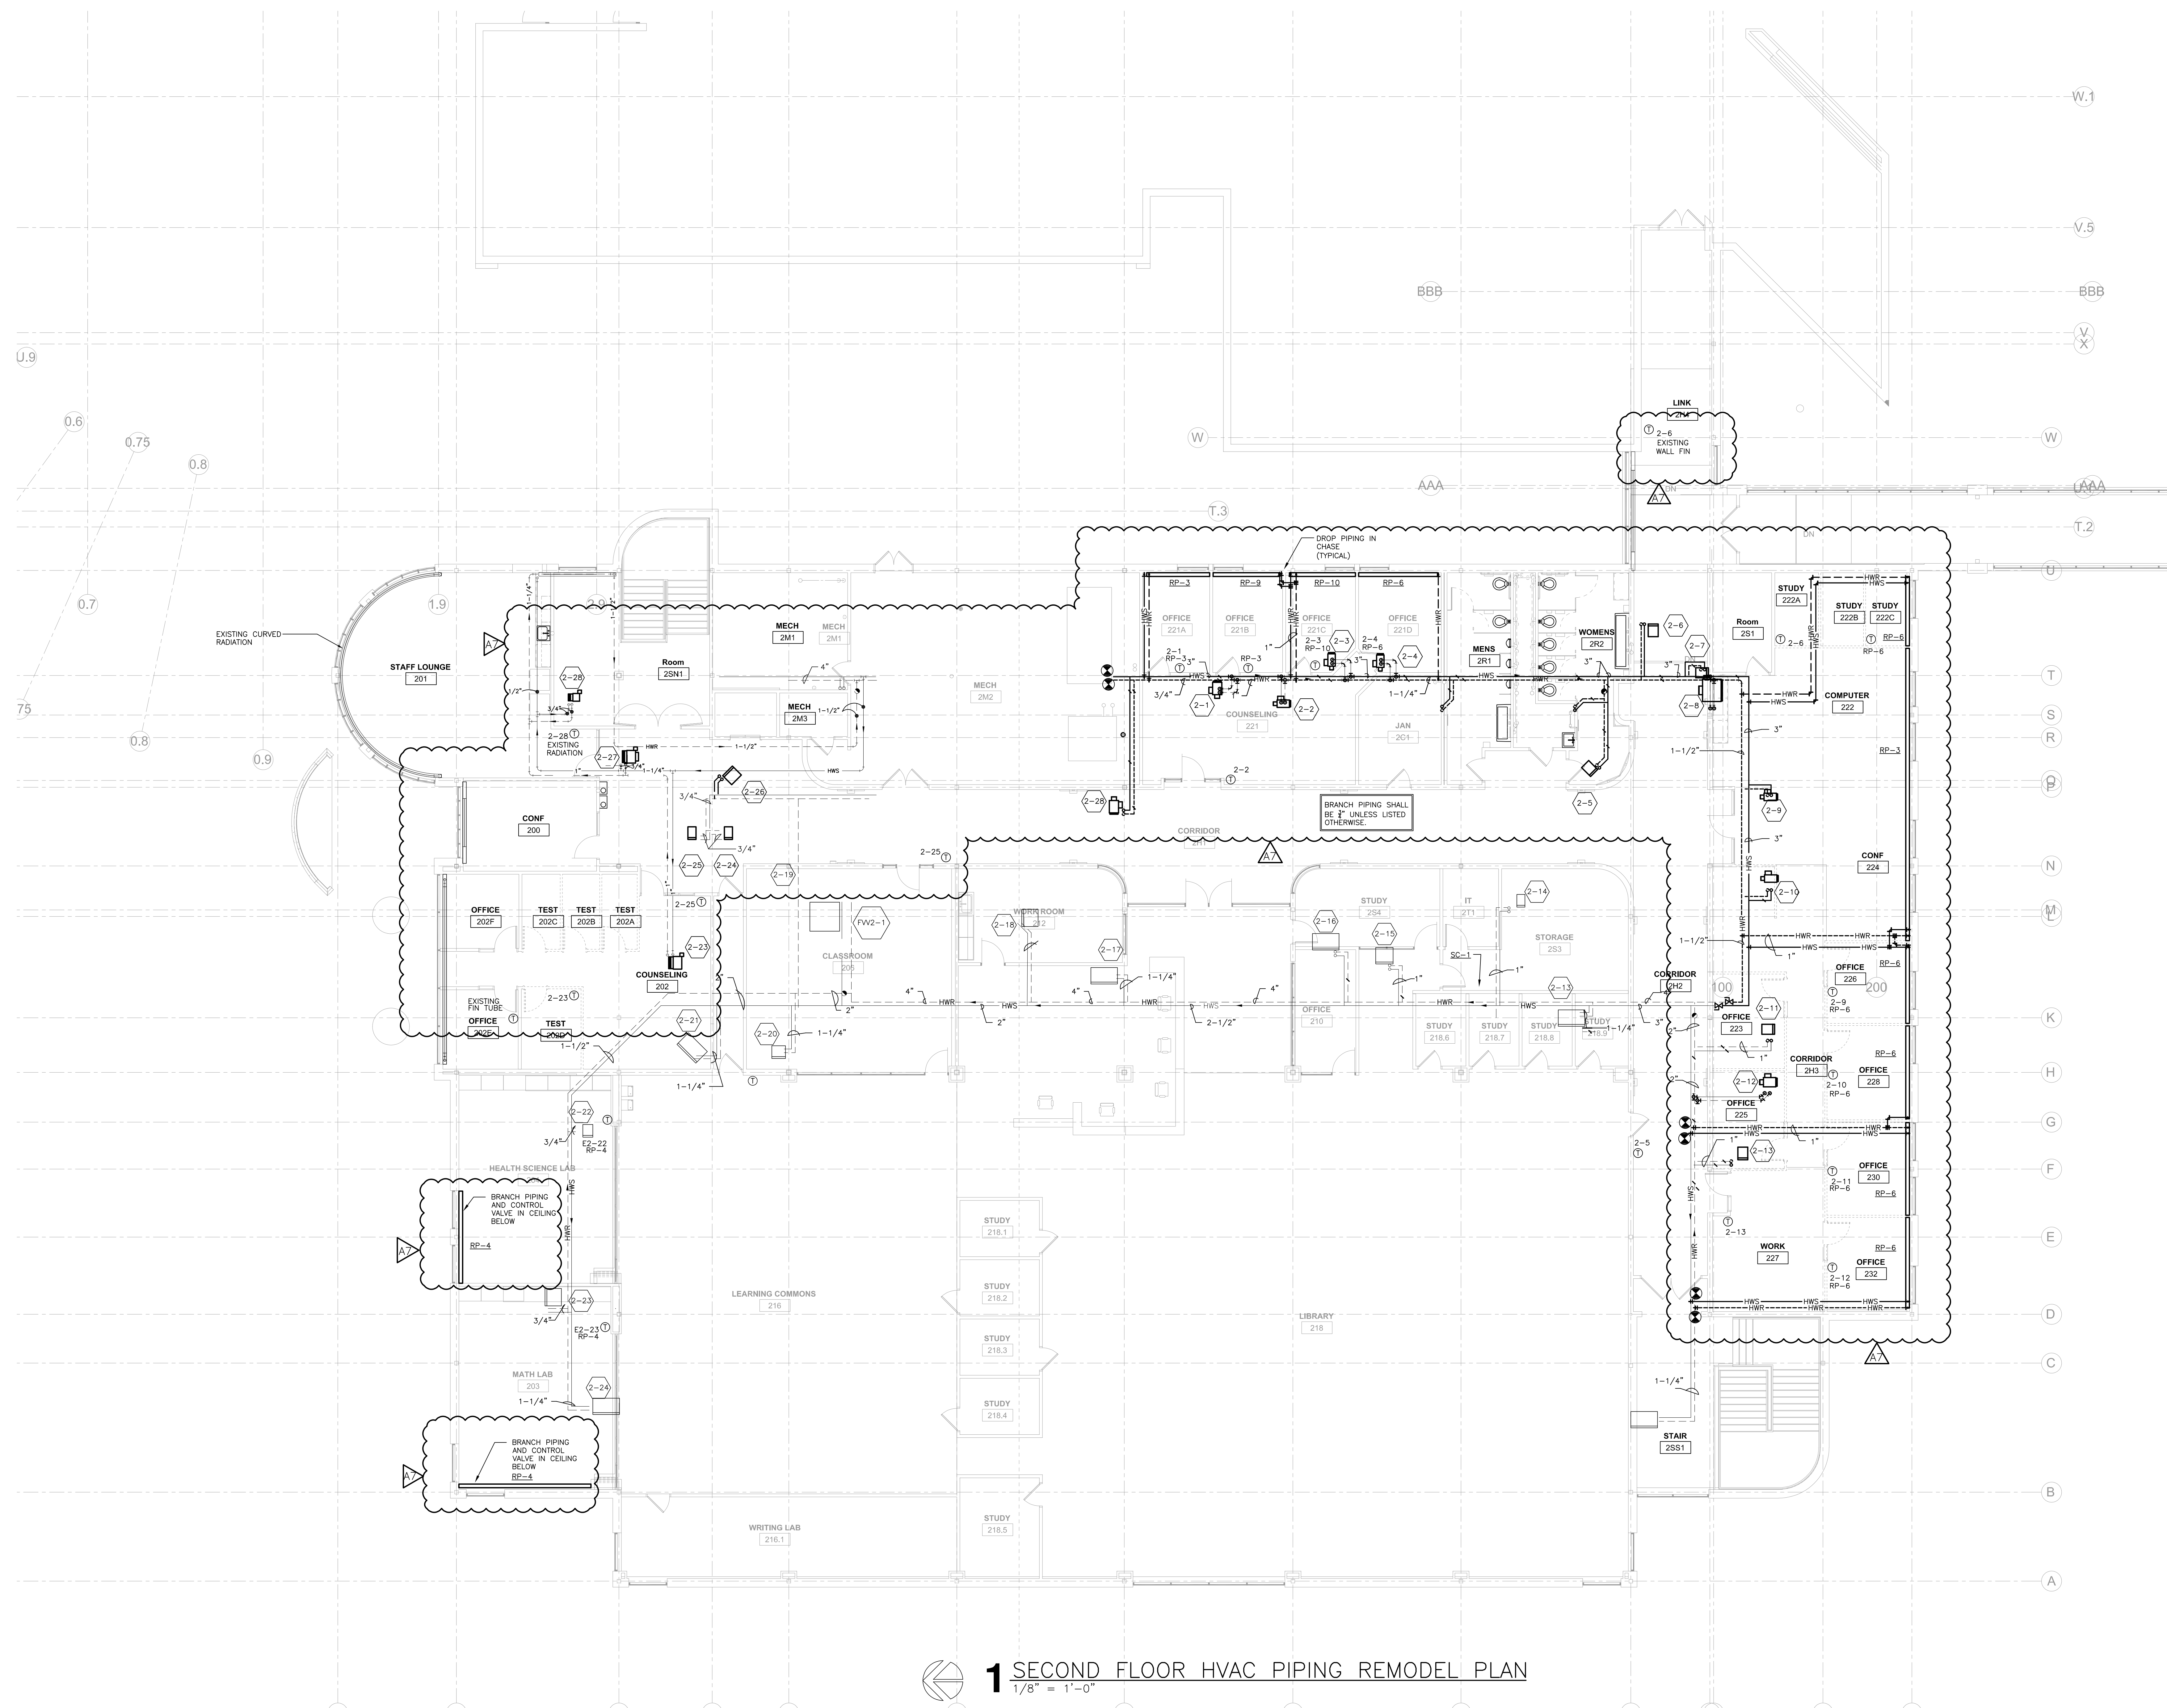

1 SECOND FLOOR HVAC PIPING REMODEL PLAN
1/8" = 1'-0"

M103R