

**DOCUMENT 00 90 00
ADDENDUM**

ADDENDUM NO. [4] Date: August 8, 2019

**RE: SCHOOL DISTRICT OF HOLMEN
HIGH SCHOOL ADDITION AND REMODELING BID PKG #2
1001 McHUGH ROAD
HOLMEN, WISCONSIN 54636
HSR 18061**

**FROM: HSR Associates, Inc
100 Milwaukee Street
La Crosse, WI 54603
(608) 784-1830**

To: Prospective Bidders

This addendum forms a part of the Contract Documents and modifies the original Bidding Documents dated July 2019. Acknowledge receipt of this Addendum in the space provided on the bid form. Failure to do so may subject the Bidder to disqualification.

This Addendum consists of [3] pages, [3] specification sections and [7] 30 x 42 drawing.

CHANGES TO SPECIFICATIONS:

1. Section 07 25 00 AIR BARRIERS
 - a. Section attached hereto as part of Contract Documents.
2. Section 09 64 29 WOOD STRIP AND PLANK FLOORING
 - a. 2.02, B, 2: Change "1/8" hardboard" to "1/4" hardboard"
3. Section 23 07 19 PIPE INSULATION
 - a. 2.02, K. Direct Buried Piping
 1. Pittsburgh Corning: Foamglas: Inorganic, incombustible, foamed or cellulated glass with annealed, rigid, hermetically sealed cells.
 - a. Block Insulation: ASTM C 552, Type I.
 - b. Special-Shaped Insulation: ASTM C 552, Type III.
 - c. Board Insulation: ASTM C 552, Type IV.
 - d. Preformed Pipe Insulation with Factory-Applied Jacket: Comply with ASTM C 552, Type II, Class 2.
 - e. Factory fabricate shapes according to ASTM C 450 and ASTM C 585.
 2. Minimum thickness of insulation.
 - a. 1 ½ inches for chilled water.
 3. Factory applied jacket. Terostat PC® FRi.
 4. Joint and seam sealant/adhesive.
 - a. Terostat PC® FRi. One component sealant, coating and adhesive, silicone based, which cures by reaction with humidity to a soft elastic product.

1. Odorless coating, free of solvents, isocyanates and PVC, demonstrates good weathering, UV and mechanical resistance, as well as excellent chemical resistance.
2. Not sensitive to temperature changes, and has excellent crack-bridging capabilities. Flame retardant sealant and coating (class O as per BS476

b. 3.10 DIRECT BURIED PIPING

A. Terostat PC® FRi.

1. Follow manufacturer's instructions.
2. Protect from freezing. Store and ship above 0°C (32°F). Avoid application at freezing conditions.
3. Do not apply if rain or temperatures below 5°C (41°F) or above 40°C (104°F) are expected before coating cures.
4. As a joint sealant.
 - a) If necessary, the mating surfaces should be rubbed to ensure they are flat and smooth before application of sealant. Apply using extrusion gun, cartridges or trowel.
 - b) Apply sealant to mating surfaces of one half or both halves of the pipe insulation section. Press insulation together firmly in order to obtain a complete seal. Smooth any squeezed out sealant flush with the Terostat PC® FRi finish. A raised joint surface is also acceptable, but a recessed (low) joint isn't. Eventually apply an extra bead.
5. As a coating.
 - a) Apply a coat of 1.5 to 4 kg/m² (30 to 80 lbs/100ft²) . It may be applied by trowel or cartridge. Immediately after application, the coating is smoothed using trowel, spatula, squeegee or gloves

CHANGES TO DRAWINGS

4. Sheet C102 SITE PLAN
 - a. Change note from "8' chain link fence" to "6' chain link fence"
5. Sheet A204 INTERIOR ELEVATIONS 30 x 42 attached hereto
 - a. Revisions clouded on Drawing
6. Sheet ID103 FINISH FLOOR PLAN – SEGMENT B 30 x 42 attached hereto
 - a. Revisions clouded on Drawing
7. Sheets ID105 FINISH FLOOR PLAN – SEGMENT E 30 x 42 attached hereto
 - a. Revisions clouded on Drawing
8. Sheet ID400 INTERIOR ELEVATIONS AND ENLARGED PLANS 30 x 42 attached hereto
 - a. Revisions clouded on Drawing
9. Sheet M106 OVERALL MECHANICAL PIPING REMODEL PLAN 30 x 42 attached hereto
 - a. Revisions clouded on Drawing
10. Sheet M110 MECHANICAL PIPING REMODEL PLAN – SEG. 'E' 30 x 42 attached hereto
 - a. Revisions clouded on Drawing

11. Sheet E204 FIRST FLOOR POWER PLAN – SEGMENT E

- a. 1/E204 - First Floor power plan – Segment 'E': 600 amp safety switch and adjacent transformer in electrical room is existing to remain. Install conduit raceways indicated to new kitchen panel K, for phase 1 of work. (Phase 2 of work will replace feeders with 400 amp conductors- not this bid set).

12. Sheet E500 ELECTRIC RISER DIAGRAM

- a. 1/E500-Electrical one-line diagram; Provide 100amp, 3 pole circuit breaker and feeder to panel LG in Band Mezzanine.
- b. 3/E500 –Existing Electrical one-line diagram; Indicate/show Panel LE2 to be mounted adjacent panel LE; with sub-feed lugs and conductors from panel LE.

13. Sheet E502 ELECTRICAL SYSTEMS PLAN 30 x 42 attached hereto

- a. Revisions clouded on Drawing.

PRIOR APPROVALS

1. Section 10 22 39 FOLDING PANEL PARTITIONS

- a. Moderco: Signature 842

END OF DOCUMENT 00 90 00

Page Intentionally Left Blank

SECTION 07 25 00

AIR BARRIERS

PART 1 GENERAL

1.01 SECTION INCLUDES

- A. Water-Resistive Barrier: Under exterior wall cladding, over sheathing or other substrate; not air tight or vapor retardant.

1.02 RELATED REQUIREMENTS

- A. Section 07 42 13 - Metal Wall Panels: Areas requiring water resistive barrier.

1.03 DEFINITIONS

- A. Weather Barrier: Assemblies that form either water-resistive barriers, air barriers, or vapor retarders.
- B. Water-Resistive Barrier: Water-shedding barrier made of material that is moisture resistant, to the degree specified, intended to be installed to shed water without sealed seams.

1.04 SUBMITTALS

- A. See Section 01 30 00 - Administrative Requirements, for submittal procedures.
- B. Product Data: Provide data on material characteristics.
- C. Manufacturer's Installation Instructions: Indicate preparation and installation methods.

1.05 FIELD CONDITIONS

- A. Maintain temperature and humidity recommended by the materials manufacturers before, during and after installation.

PART 2 PRODUCTS

2.01 WATER-RESISTIVE BARRIER MATERIALS (NEITHER AIR BARRIER OR VAPOR RETARDER)

- A. Weather Barrier Sheet, Mechanically Fastened:
 - 1. Air Permeance: 0.004 cubic feet per minute per square foot, maximum, when tested in accordance with ASTM E2178.
 - 2. Water Vapor Permeance: 5 perms, minimum, when tested in accordance with ASTM E96/E96M Procedure A (desiccant method).
 - 3. Water Penetration Resistance: Withstand a water head of 21 inches, minimum, for minimum of 5 hours, when tested in accordance with AATCC 127.
 - 4. Ultraviolet and Weathering Resistance: Approved in writing by manufacturer for minimum of 6 months weather exposure.
 - 5. Surface Burning Characteristics: Flame spread index of 25 or less, smoke developed index of 50 or less, when tested in accordance with ASTM E84.
 - 6. Products:
 - a. DuPont Building Innovations; Tyvek Commercial Wrap with Tyvek Fluid Applied Flashing - Brush Formulation, Tyvek Fluid Applied Flashing and Joint Compound, FlexWrap NF, StraightFlash, StraightFlash VF, Tyvek Wrap Caps, and Tyvek Tape: www.dupont.com.
 - b. Fiberweb, Inc; Typar MetroWrap: www.typar.com.
 - c. National Shelter Products, Inc.; DRYLine RainDrain: www.drylinewrap.com.
 - d. Pactiv Corporation; GreenGuard; RainDrop Building Wrap: greenguard.pactiv.com.
 - e. Substitutions: See Section 01 60 00 - Product Requirements.

PART 3 EXECUTION

3.01 EXAMINATION

- A. Verify that surfaces and conditions are ready to accept the work of this section.

3.02 PREPARATION

- A. Remove projections, protruding fasteners, and loose or foreign matter that might interfere with proper installation.

3.03 INSTALLATION

- A. Install materials in accordance with manufacturer's instructions.

- B. Water-Resistive Barriers: Install continuous barrier over surfaces indicated, with sheets lapped to shed water but with seams not sealed.
- C. Mechanically Fastened Sheets - On Exterior:
 - 1. Install sheets shingle-fashion to shed water, with seams generally horizontal.
 - 2. Overlap seams as recommended by manufacturer but at least 6 inches.
 - 3. Overlap at outside and inside corners as recommended by manufacturer but at least 12 inches.
 - 4. Install water-resistive barrier over jamb flashings.
 - 5. Install air barrier and vapor retarder UNDER jamb flashings.
 - 6. Install head flashings under weather barrier.
 - 7. At openings to be filled with frames having nailing flanges, wrap excess sheet into opening; at head, seal sheet over flange and flashing.
- D. Openings and Penetrations in Exterior Air Barriers:
 - 1. Install self-adhesive flashing over sills, covering entire sill frame member, extending at least 5 inches onto air barrier and at least 6 inches up jambs; mechanically fasten stretched edges.
 - 2. At openings to be filled with frames having nailing flanges, seal head and jamb flanges using a continuous bead of sealant compressed by flange and cover flanges with sealing tape at least 4 inches wide; do not seal sill flange.
 - 3. At openings to be filled with non-flanged frames, seal air barrier to all sides of opening framing, using self-adhesive flashing at least 9 inches wide, covering entire depth of framing.
 - 4. At head of openings, install self-adhesive flashing under air barrier extending at least 2 inches beyond face of jambs; seal air barrier to flashing.
 - 5. At interior face of openings, seal gap between window/door frame and rough framing, using joint sealant over backer rod.
 - 6. Service and Other Penetrations: Fill all annular space with spray foam insulation and trim flush with surface. Form self-adhesive flashing around penetrating item and seal to air barrier surface.


3.04 FIELD QUALITY CONTROL

- A. See Section 01 40 00 - Quality Requirements, for additional requirements.
- B. Obtain approval of installation procedures by the weather barrier manufacturer based on a mock-up installed in place, prior to proceeding with remainder of installation.


3.05 PROTECTION

- A. Do not leave materials exposed to weather longer than recommended by manufacturer.


END OF SECTION

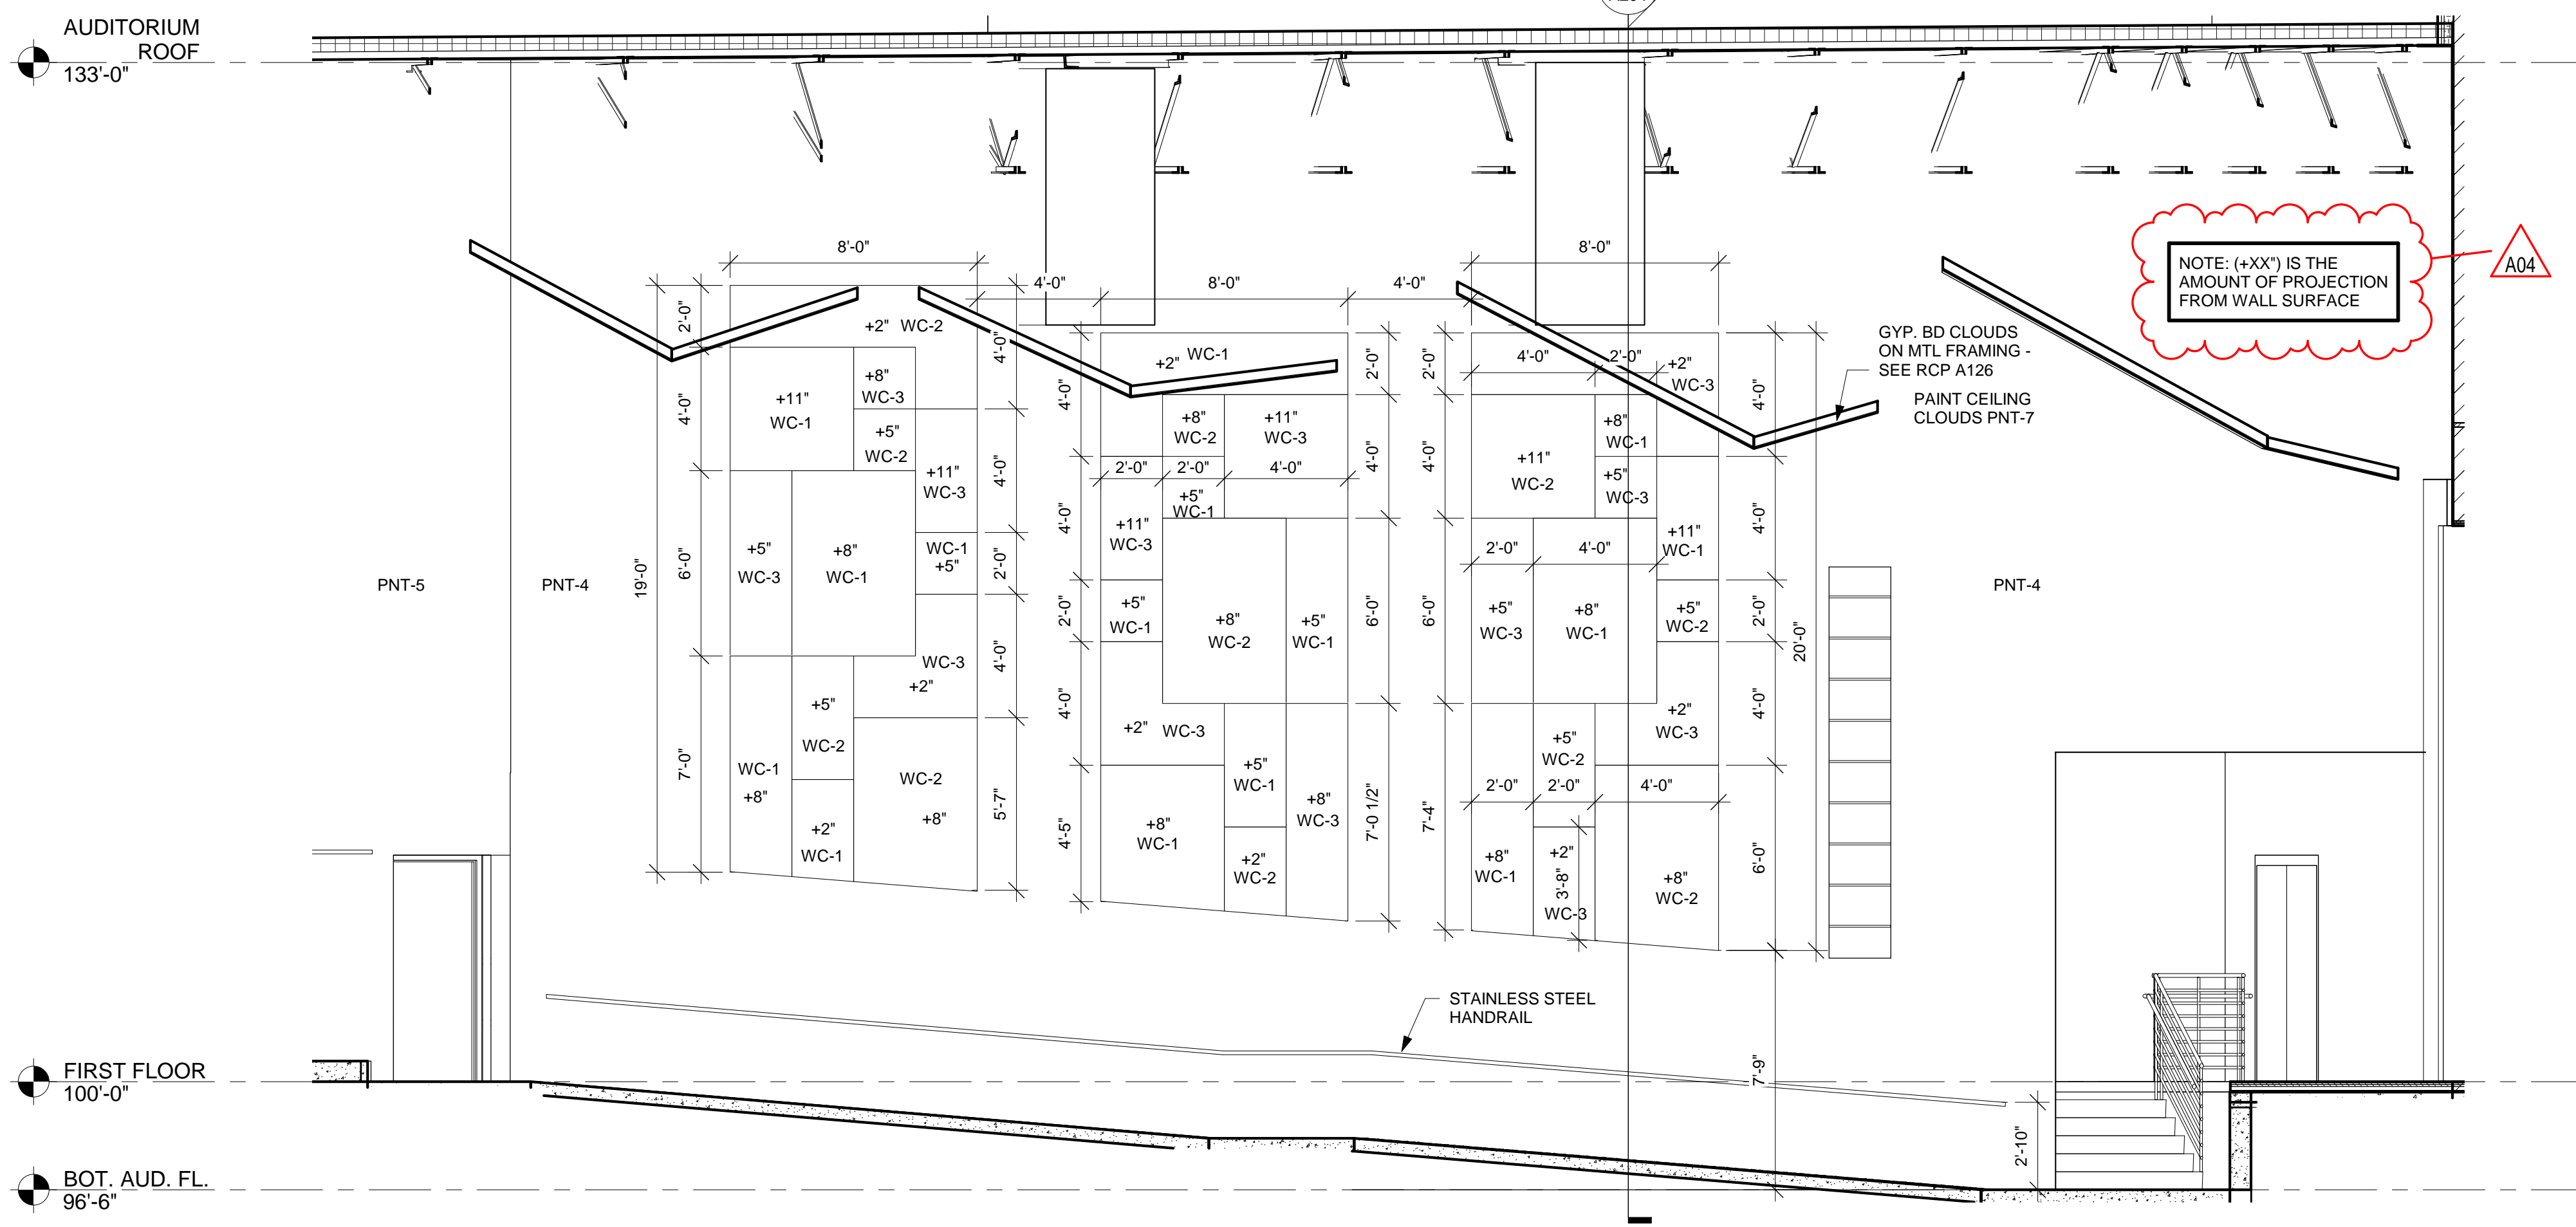


1 AUDITORIUM SIDE WALL ELEV.
1/4" = 1'-0"

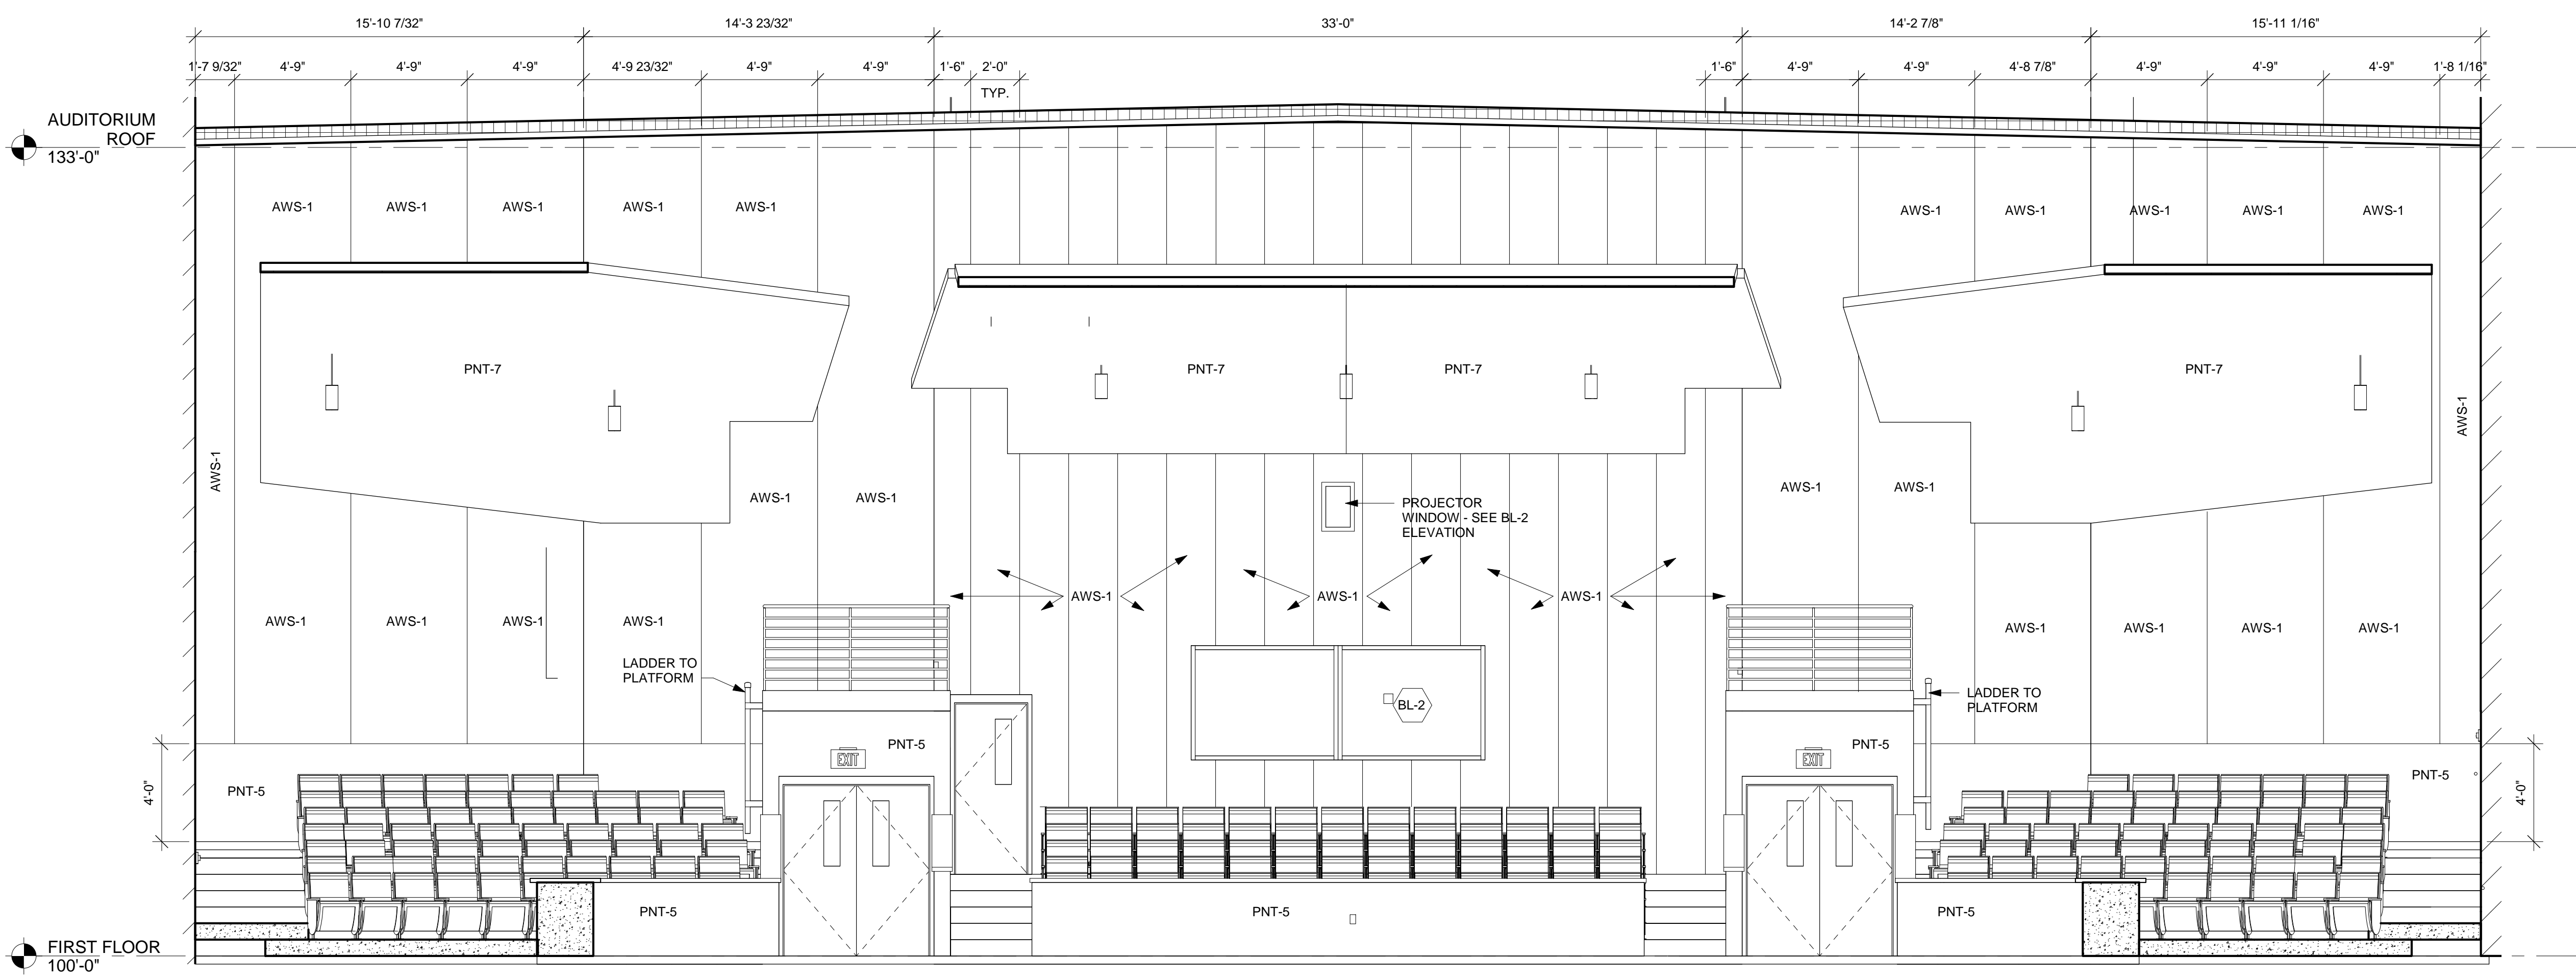


2 AUDITORIUM BACK WALL ELEV.
1/4" = 1'-0"

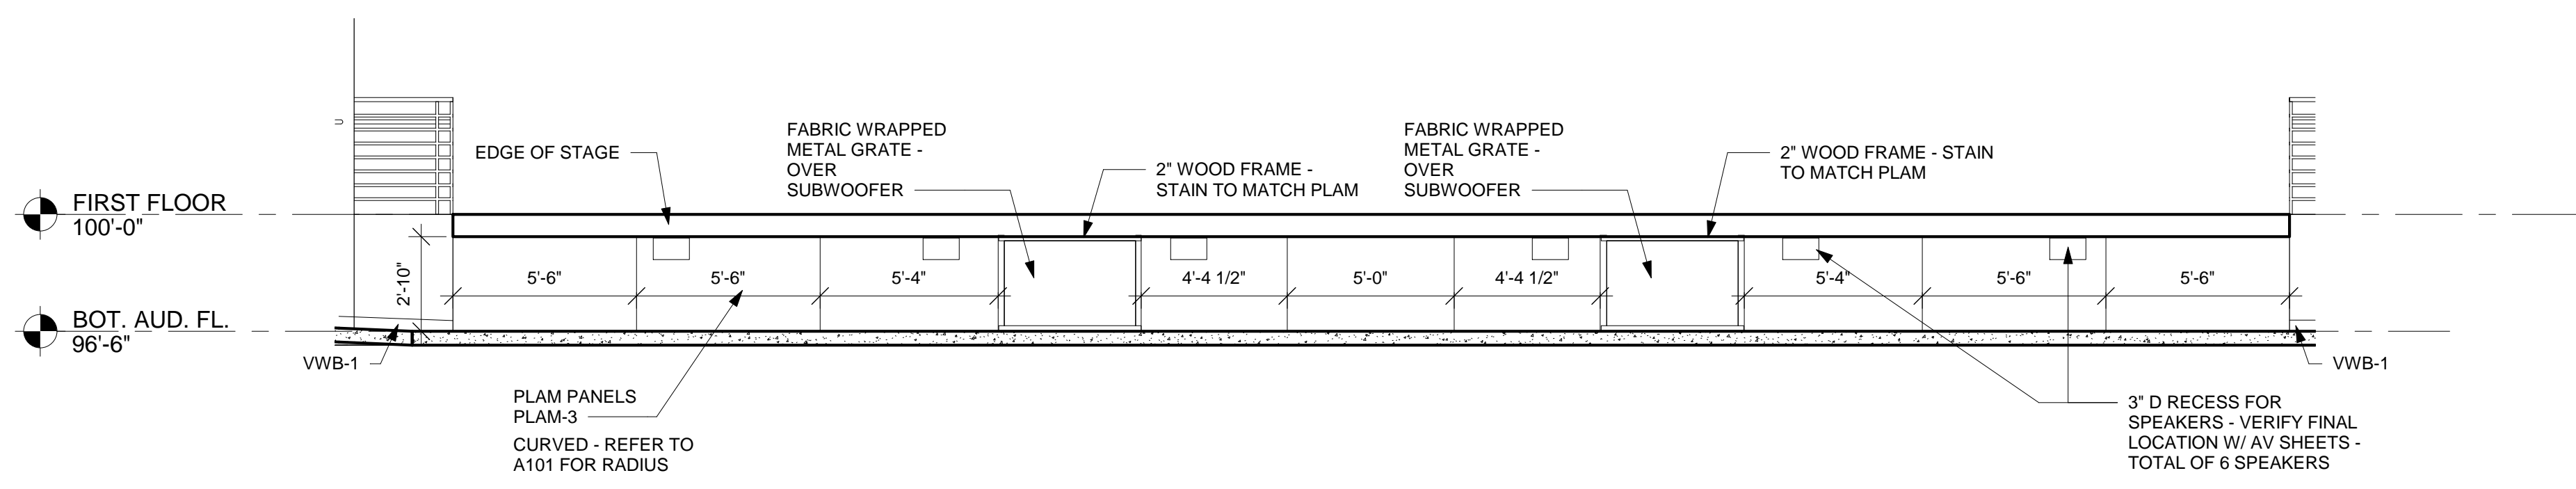

4 FRONT OF STAGE ELEVATION
1/4" = 1'-0"

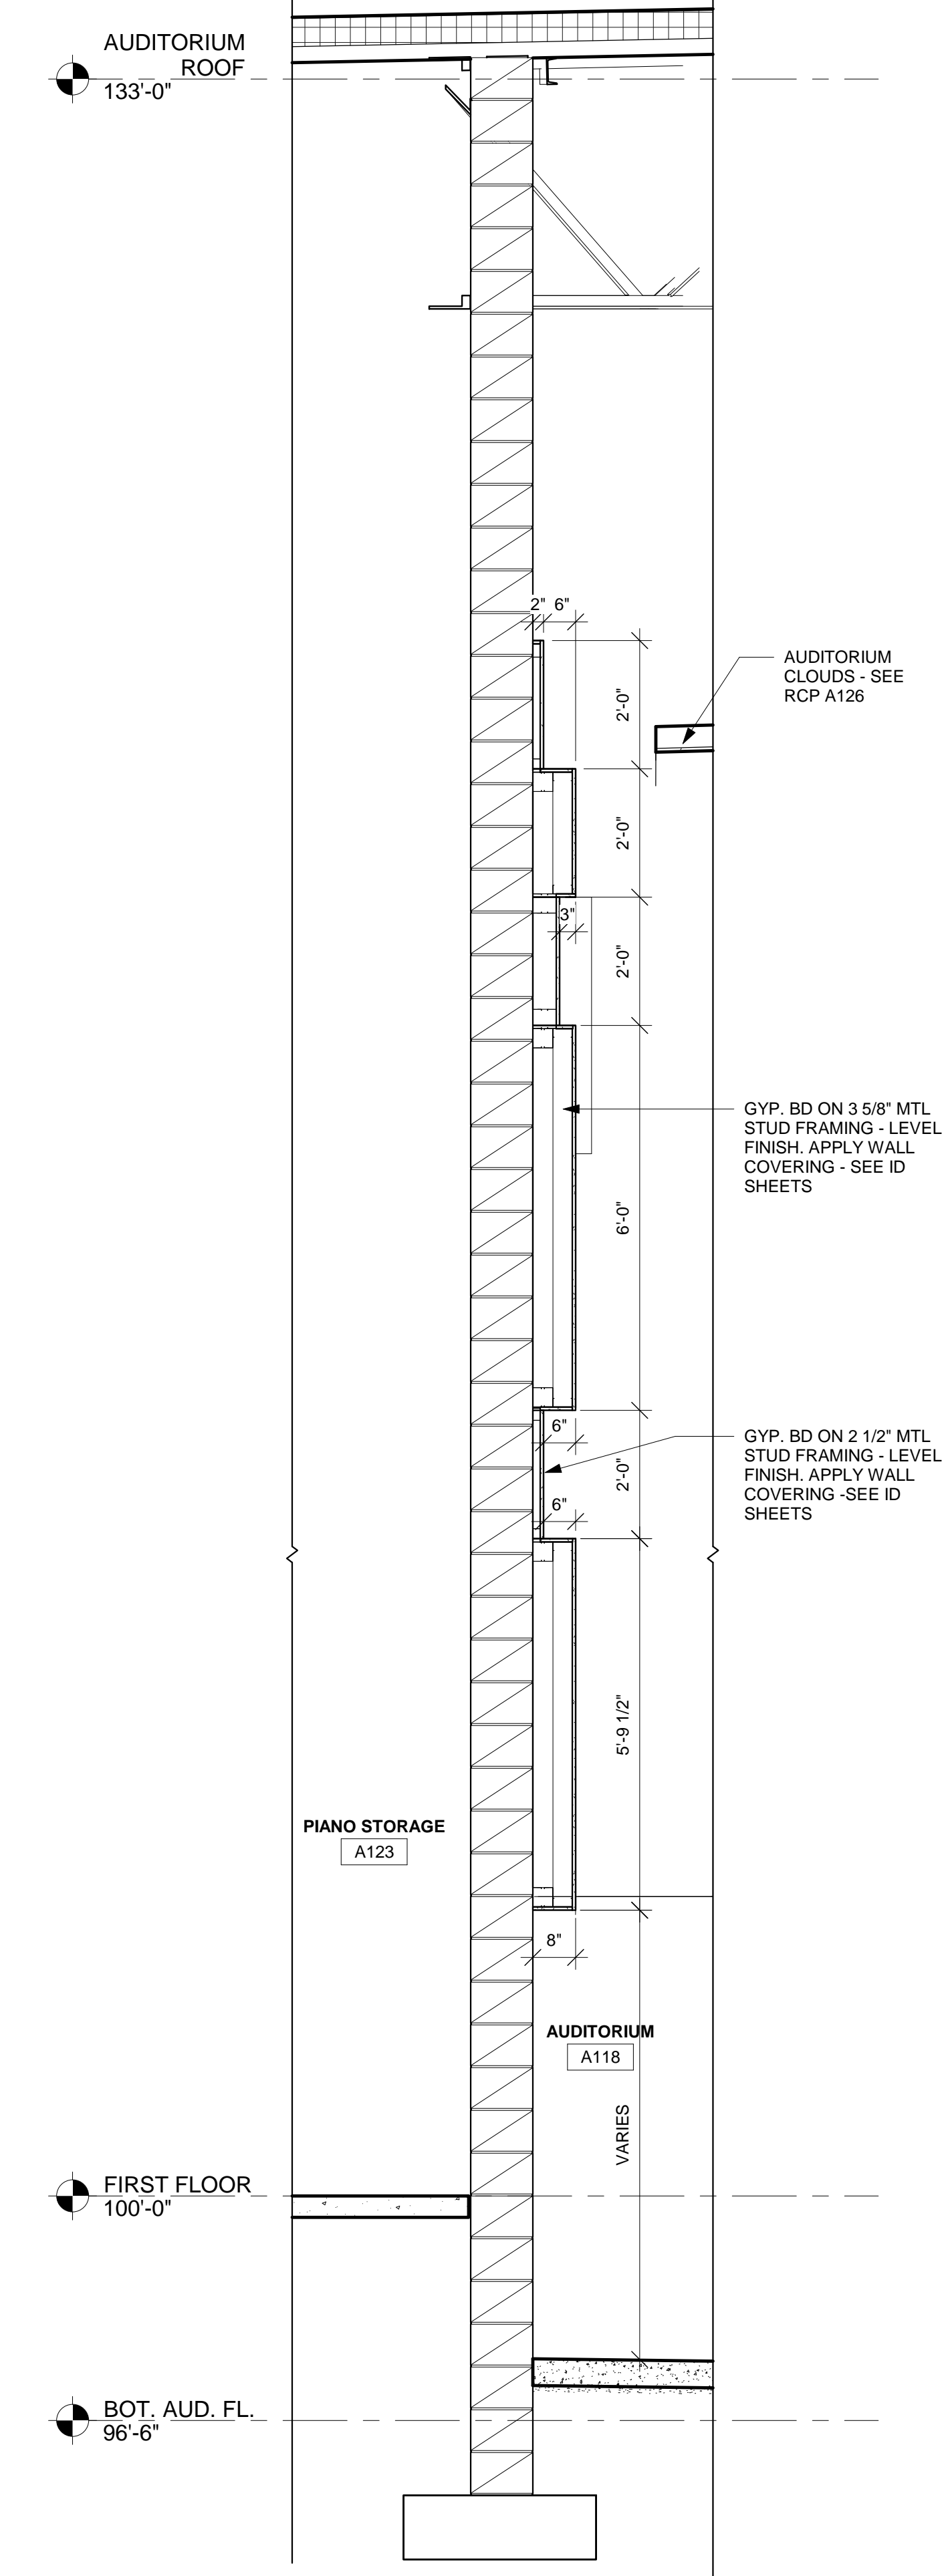

3 WALL SECTION
1/2" = 1'-0"

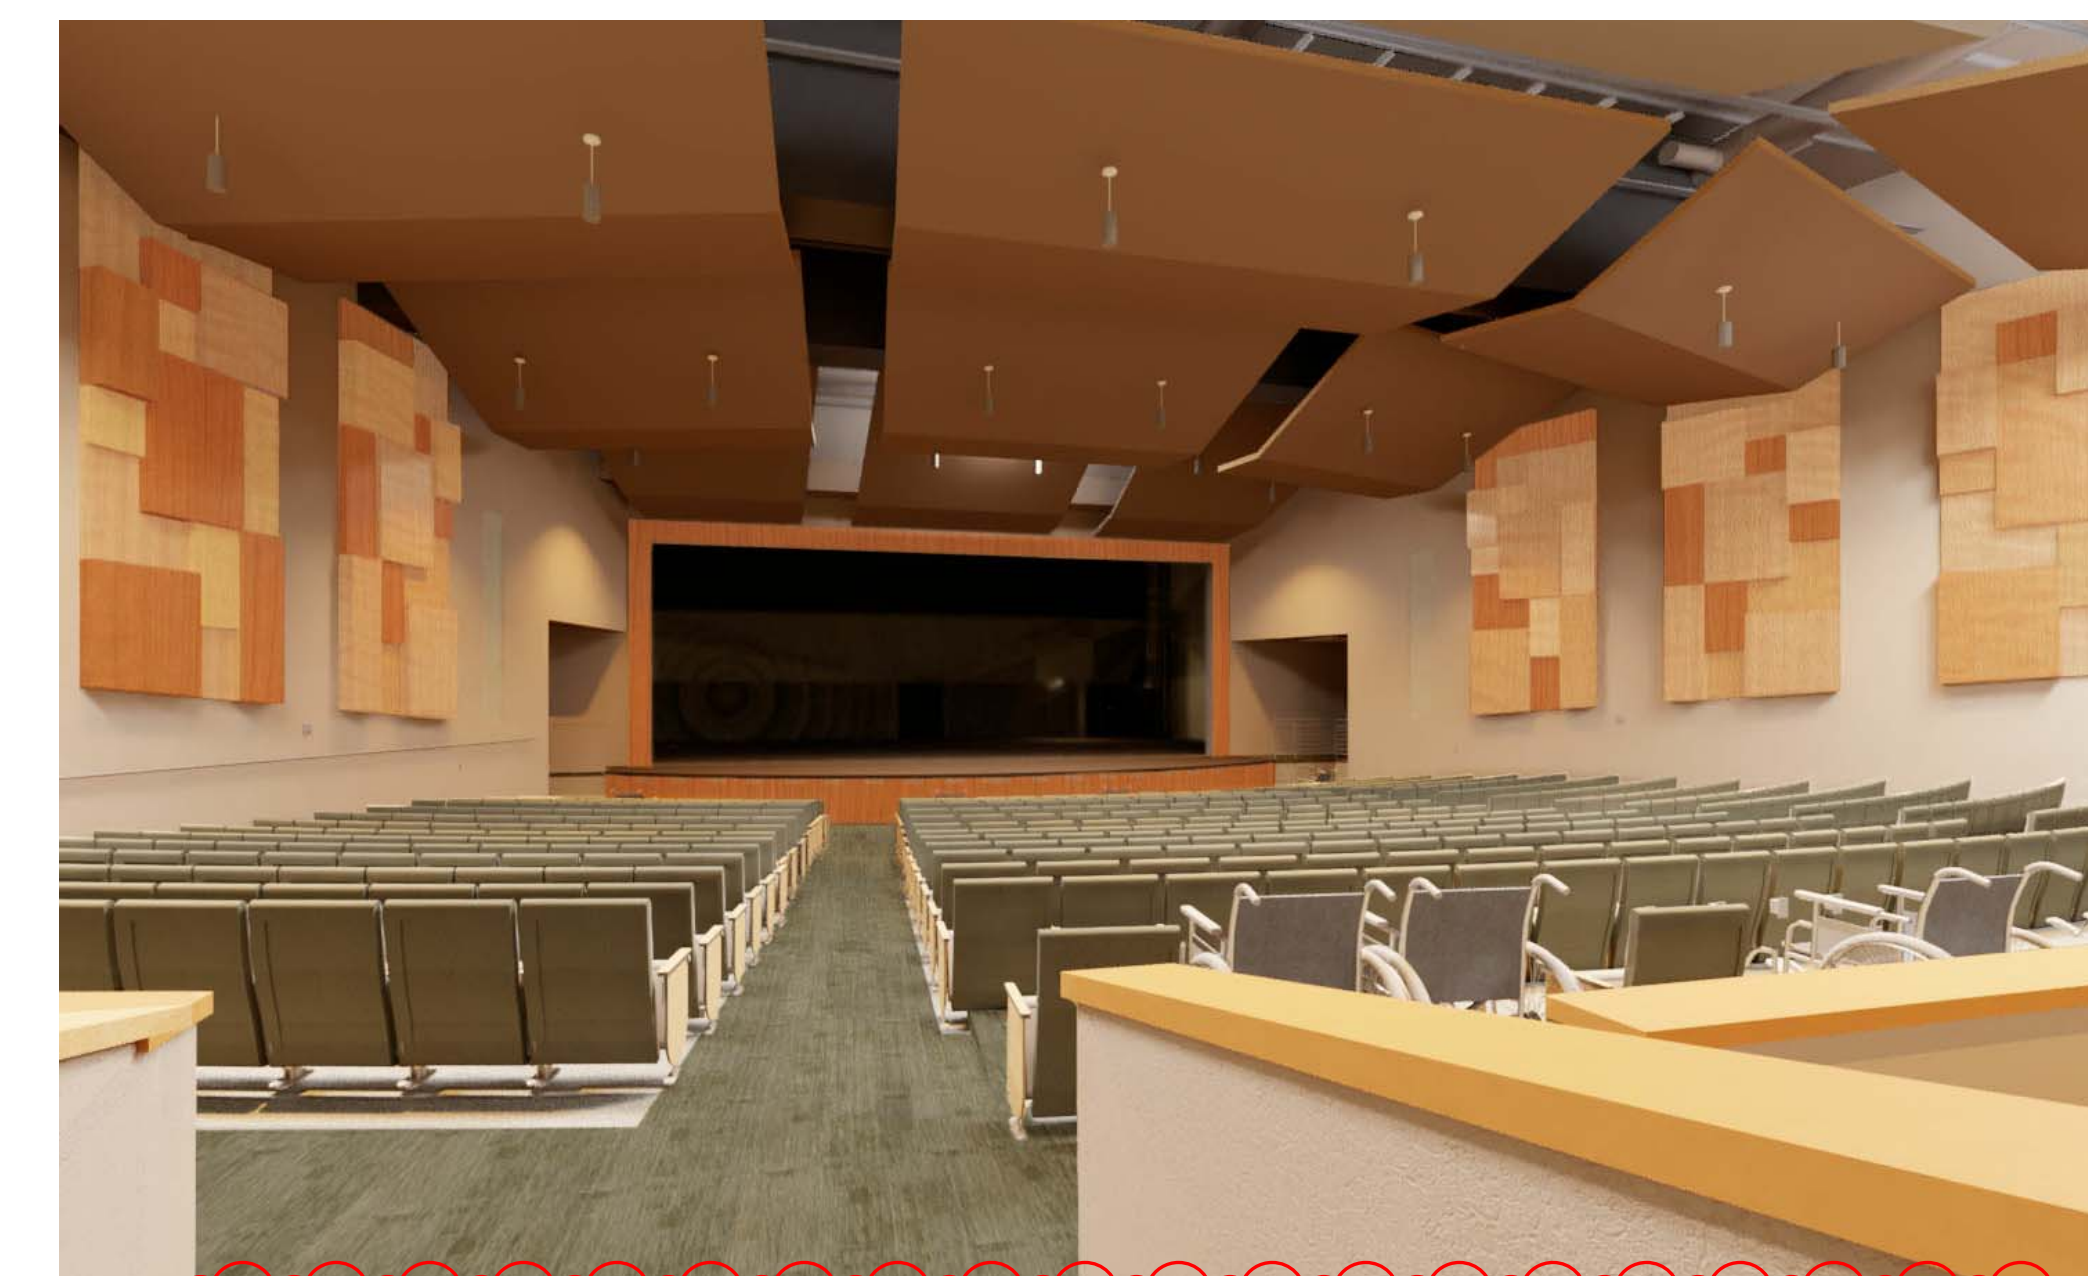

5 AUDITORIUM RENDERING
N.T.S.

No.	Description	Date
A01	Addendum 1	7/25/19
A04	Addendum 4	8/7/19



Consultant:


Project Title: **SCHOOL DISTRICT OF HOLMEN
HIGH SCHOOL ADDITION & REMODELING
BID PACKAGE #2**
Project Location: 1001 McHUGH RD
HOLMEN, WI 54636
Sheet Title: **FINISH FLOOR PLAN - SEGMENT B**

HSR Project Number: **18061**

Project Date: **JULY 2019**

Drawn By: **SB**

Key Plan:

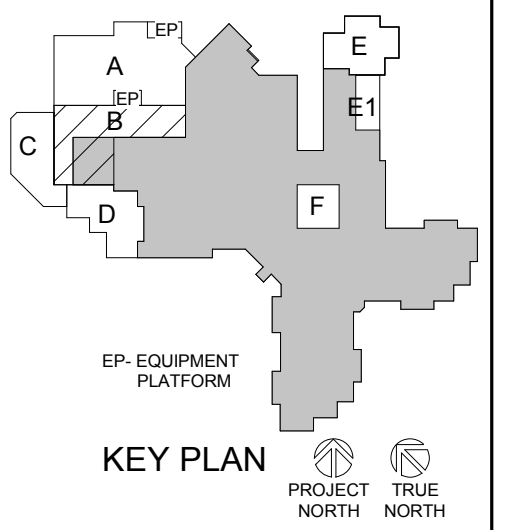

Revisions:

No.	Description	Date
A02	Addendum 2	7/30/19
A04	Addendum 4	8/7/19

Graphic Scale: **VARIES**

Last Update: **8/7/2019 9:43:45 AM**


ID103

- INTERIOR GENERAL NOTES:**
- A REFERENCES TO PAINT PERTAIN TO COLOR ONLY; PAINT TYPE SHALL BE IDENTIFIED IN THE ARCHITECTURAL SPECIFICATIONS.
 - B PNT-1 FIELD PAINT; ACCENT PAINT AS INDICATED. SEE ID SHEETS.
 - C REFER TO MASTER COLOR SCHEDULE ON ID600 FOR MATERIAL FINISH SPECIFICATIONS, ANNOTATIONS, AND ADDITIONAL INFORMATION.
 - D TOILET ROOM WALL AND FLOOR GROUT LINES SHALL ALIGN TO CONTINUE PATTERN THROUGHOUT. SEE D400 FOR ELEVATED PATTERNING.
 - E VINYL COMPOSITE EDGE (VCE) TO BE INSTALLED AT DISSIMILAR FINISH AREAS; REFER TO ID SHEETS. INSTALL APPROPRIATE EDGE PROFILE TO PROTECT FINISH EDGES. COLOR AS SELECTED BY A/E.
 - F AT DISSIMILAR FLOORING FINISHES, SET JOINT OF MATERIALS AT CENTER OF DOOR, TRANSITIONS TO BE AOA COMPLIANT.
 - G REFER TO PLUMBING FOR FLOOR DRAIN LOCATIONS.
 - H PAINT EXPOSED CEILINGS PNT-1 UNLESS OTHERWISE NOTED.


- FINISH KEY PLAN:**
- △ SEE ROOM FINISH REMARKS
 - XXX WALL BASE
 - PNT-X ACCENT PAINT

- FINISH LEGEND:**
- | | | |
|---------------------------------|-------|--------|
| TLE-1 | LVT-1 | CPT-1 |
| TLE-2 | LVT-2 | CPT-2 |
| PAF-1 | LVT-3 | CPT-3 |
| PAF-2 | RAF-1 | WCPT-1 |
| EPOXY SEE SPEC SECTION 09 67 00 | RAF-2 | RT-1 |
| TURF | RAF-3 | RST-1 |

- ROOM FINISH REMARKS**
- 1 PAINT ALL WALLS PNT-1 - ACCENT AS INDICATED ON PLANS
 - 2 PAINT ALL WALLS PNT-4 - ACCENT AS INDICATED ON PLANS
 - 3 PAINT ALL WALLS AND CEILINGS EPOXY PNT-1 - ACCENT AS INDICATED ON PLANS
 - 4 PAINT EXPOSED CEILINGS PNT-2
 - 5 FULL HEIGHT TILE AT ALL WALLS. SEE TILE PATTERN ON ID400
 - 6 PAINT ALL WALLS PNT-5
 - 7 PAINT EXPOSED CEILING PNT-5
 - 8 PAINT ALL WALLS PNT-3
 - 9 PAINT EXPOSED CEILINGS PNT-8
 - 10 PAINT EXPOSED CEILINGS PNT-4
 - 11 LOCATION AND DIMENSION OF TRACK LINES AND DASHES TO BE VERIFIED BY OWNER
 - 12 TRACK LANE LINES TO BE WHITE
 - 13 "3 DOT DRILL" DASHES IN CORRIDOR C102 TO BE BLACK
 - 14 HORIZONTAL AND PLAN VIEW VERTICAL LINES OF "LADDER DRILLS" TO BE STONE GRAY. PLAN EAST VERTICAL LINE OF "LADDER DRILLS" THAT IS ALSO TRACK LANE LINES TO BE WHITE
 - 15 TRACK HANDOFF DASHES IN CORRIDOR B121 TO BE BLACK. SEE ID103

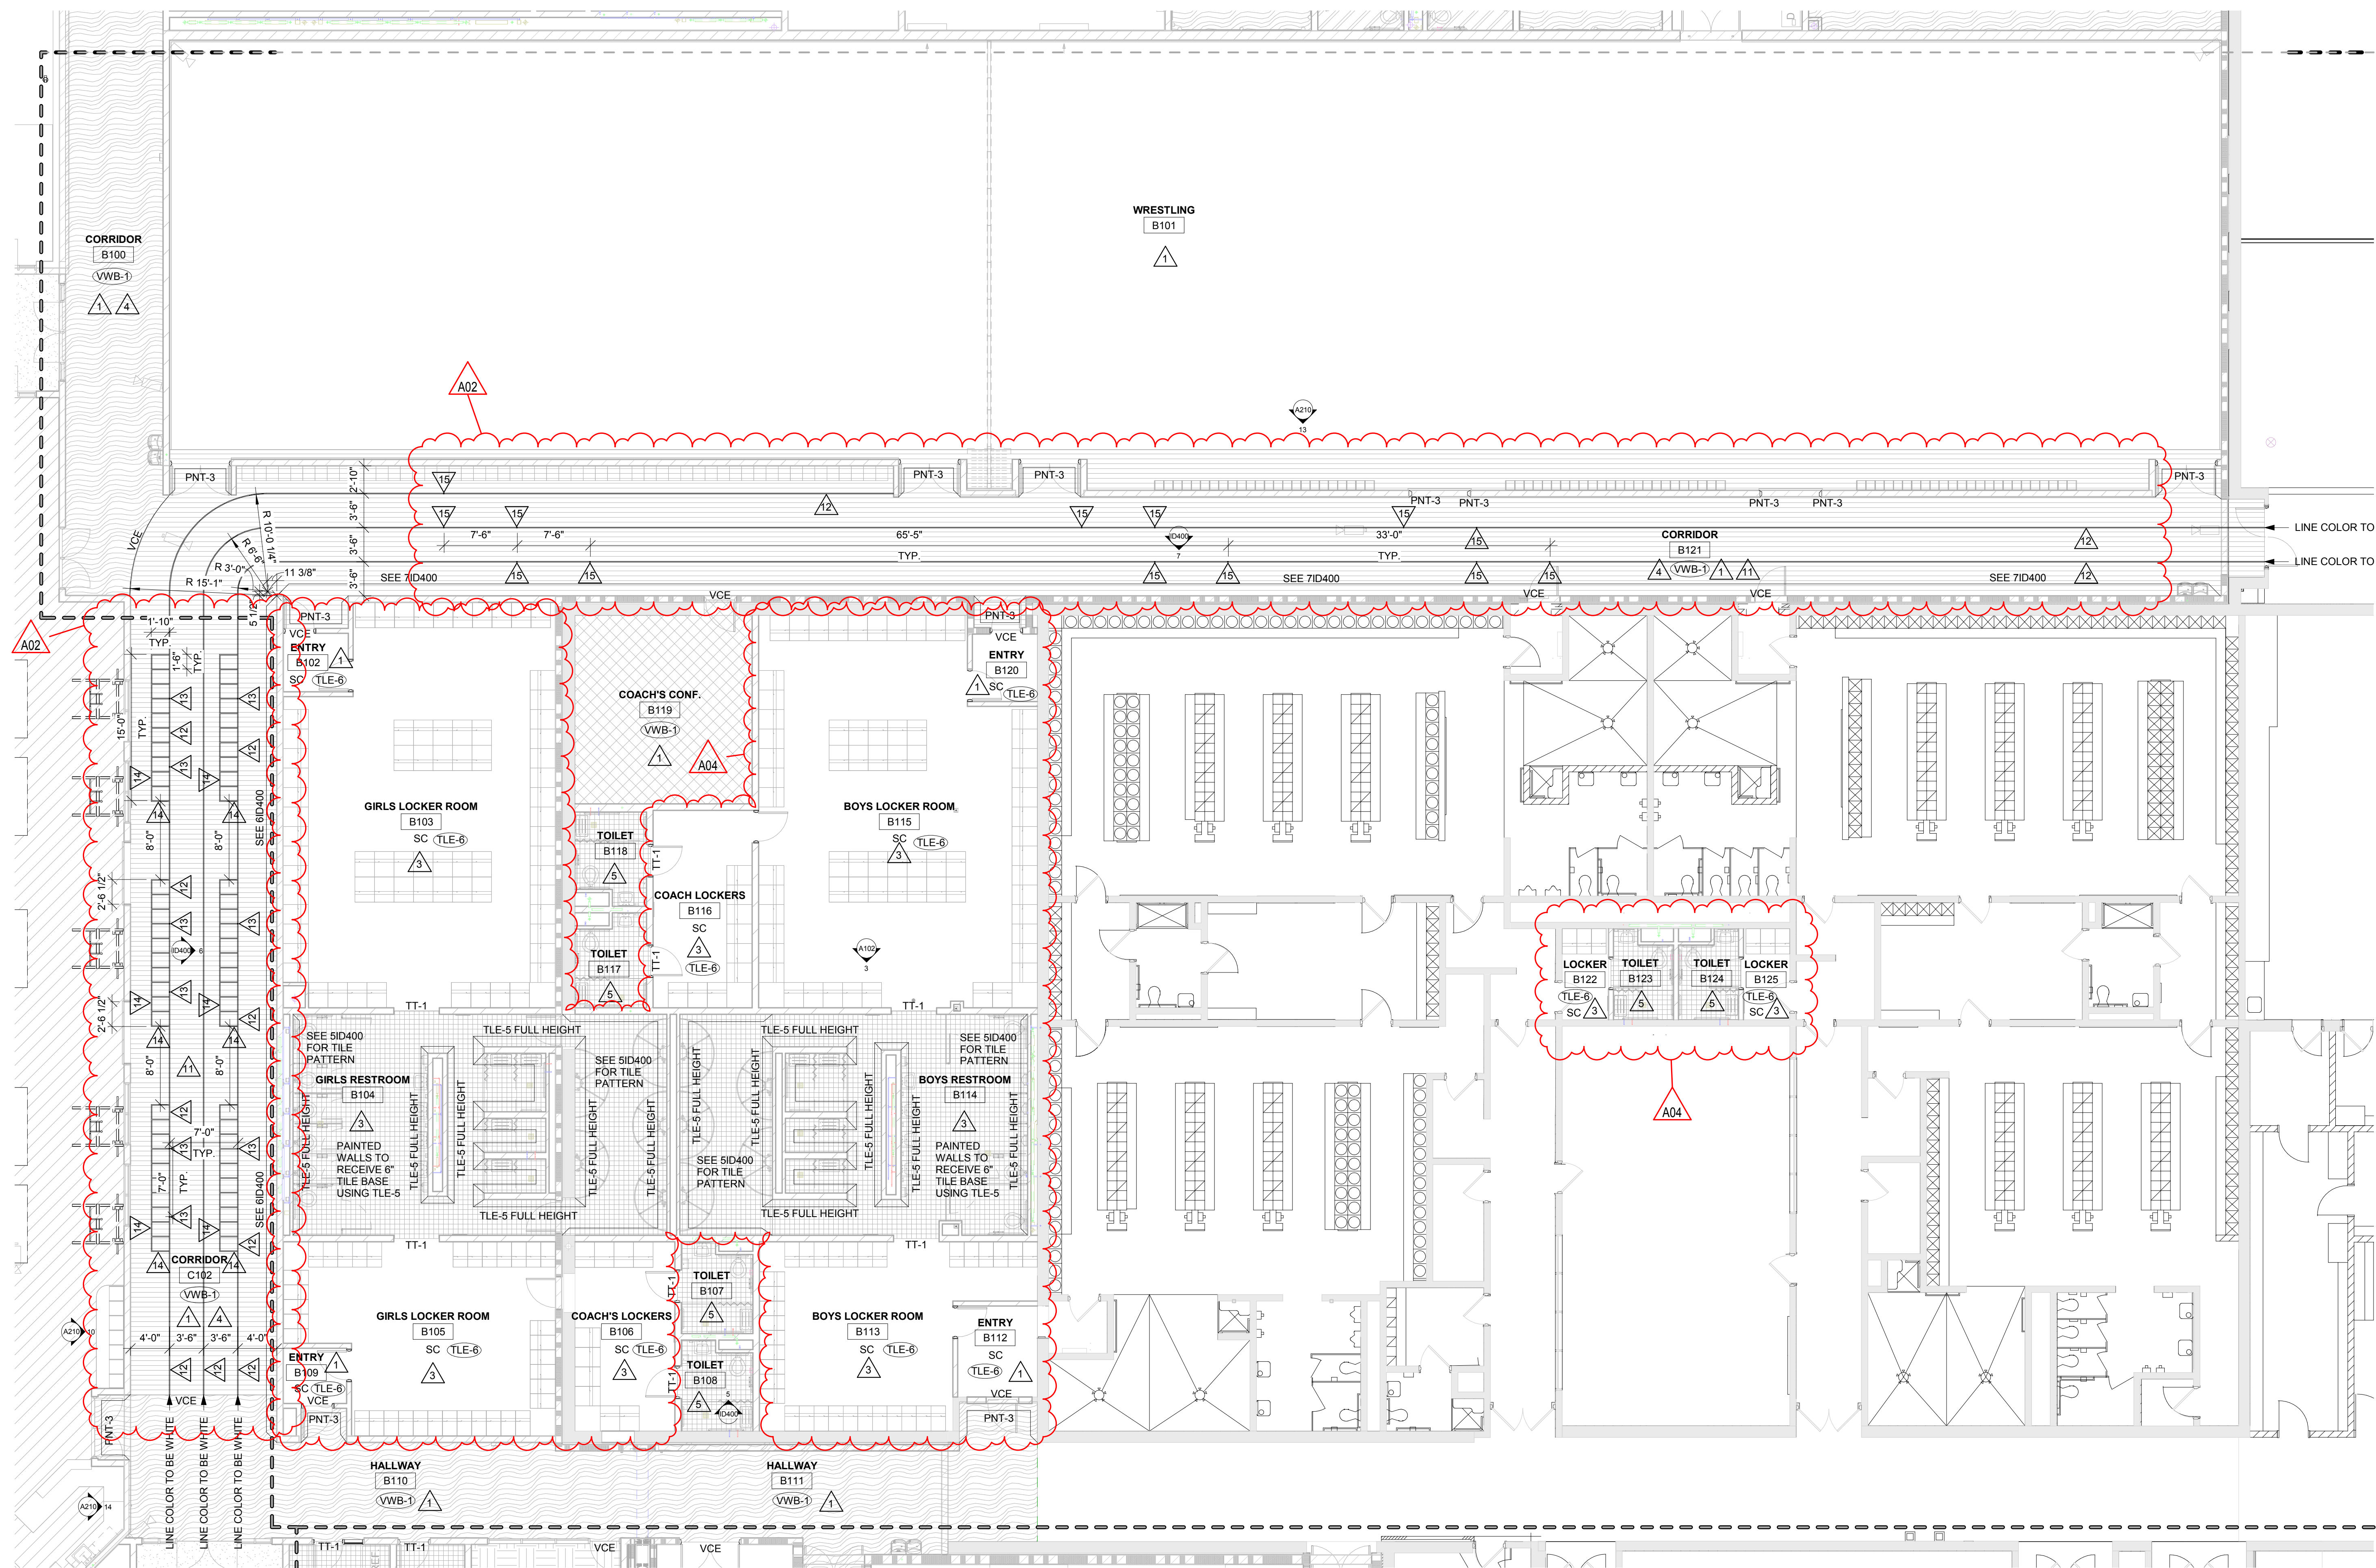

1 FIRST FLOOR FINISH PLAN - SEGMENT B
1/8" = 1'-0"

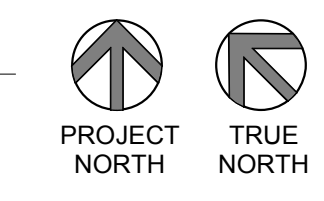




Consultant:

Project Title: **SCHOOL DISTRICT OF HOLMEN
HIGH SCHOOL ADDITION & REMODELING
BID PACKAGE #2**
Project Location: 1001 McHUGH RD
HOLMEN, WI 54636
Sheet Title: **FINISH FLOOR PLAN - SEGMENT E**

HSR Project Number: **18061**

Project Date: **JULY 2019**

Drawn By: **SB**

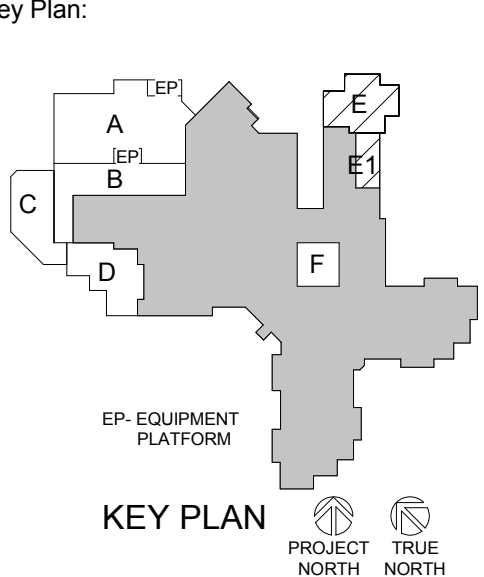

Revisions:

No.	Description	Date
A04	Addendum 4	8/7/19

Graphic Scale: **VARIES**

Last Update: **8/7/2019 9:43:48 AM**


ID105

- INTERIOR GENERAL NOTES:**
- A REFERENCES TO PAINT PERTAIN TO COLOR ONLY. PAINT TYPE SHALL BE IDENTIFIED IN THE ARCHITECTURAL SPECIFICATIONS.
 - B PNT-1 FIELD PAINT. ACCENT PAINT AS INDICATED. SEE ID SHEETS.
 - C REFER TO MASTER COLOR SCHEDULE ON ID600 FOR MATERIAL FINISH SPECIFICATIONS, ANNOTATIONS, AND ADDITIONAL INFORMATION.
 - D TOILET ROOM WALL AND FLOOR GROUT LINES SHALL ALIGN TO CONTINUE PATTERN THROUGHOUT. SEE ID400 FOR ELEVATED PATTERNING.
 - E VINYL COMPOSITE EDGE (VCE) TO BE INSTALLED AT DISSIMILAR FINISH AREAS. REFER TO ID SHEETS. INSTALL APPROPRIATE EDGE PROFILE TO PROTECT FINISH EDGES. COLOR AS SELECTED BY A/E.
 - F AT DISSIMILAR FLOORING FINISHES, SET JOINT OF MATERIALS AT CENTER OF DOOR. TRANSITIONS TO BE ADA COMPLIANT.
 - G REFER TO PLUMBING FOR FLOOR DRAIN LOCATIONS
 - H PAINT EXPOSED CEILINGS PNT-1 UNLESS OTHERWISE NOTED



- FINISH KEY PLAN:**
- SEE ROOM FINISH REMARKS
 - WALL BASE
 - ACCENT PAINT

- FINISH LEGEND:**
- | | | |
|--|--|--|
| | | |
| | | |

- ROOM FINISH REMARKS**
- 1 PAINT ALL WALLS PNT-1 - ACCENT AS INDICATED ON PLANS
 - 2 PAINT ALL WALLS PNT-4 - ACCENT AS INDICATED ON PLANS
 - 3 PAINT ALL WALLS AND CEILINGS EPOXY PNT-1 - ACCENT AS INDICATED ON PLANS
 - 4 PAINT EXPOSED CEILINGS PNT-2
 - 5 FULL HEIGHT TILE AT ALL WALLS. SEE TILE PATTERN ON ID400
 - 6 PAINT ALL WALLS PNT-5
 - 7 PAINT EXPOSED CEILING PNT-5
 - 8 PAINT ALL WALLS PNT-8
 - 9 PAINT EXPOSED CEILINGS PNT-8
 - 10 PAINT EXPOSED CEILINGS PNT-4
 - 11 LOCATION AND DIMENSION OF TRACK LINES AND DASHES TO BE VERIFIED BY OWNER
 - 12 TRACK LANE LINES TO BE WHITE
 - 13 "3 DOT DRILL" DASHES IN CORRIDOR C102 TO BE BLACK
 - 14 HORIZONTAL AND PLAN WEST VERTICAL LINES OF "LADDER DRILLS" TO BE STONE GRAY. PLAN EAST VERTICAL LINE OF "LADDER DRILLS" THAT IS ALSO TRACK LANE LINES TO BE WHITE.
 - 15 TRACK HANDOFF DASHES IN CORRIDOR B121 TO BE BLACK. SEE ID103

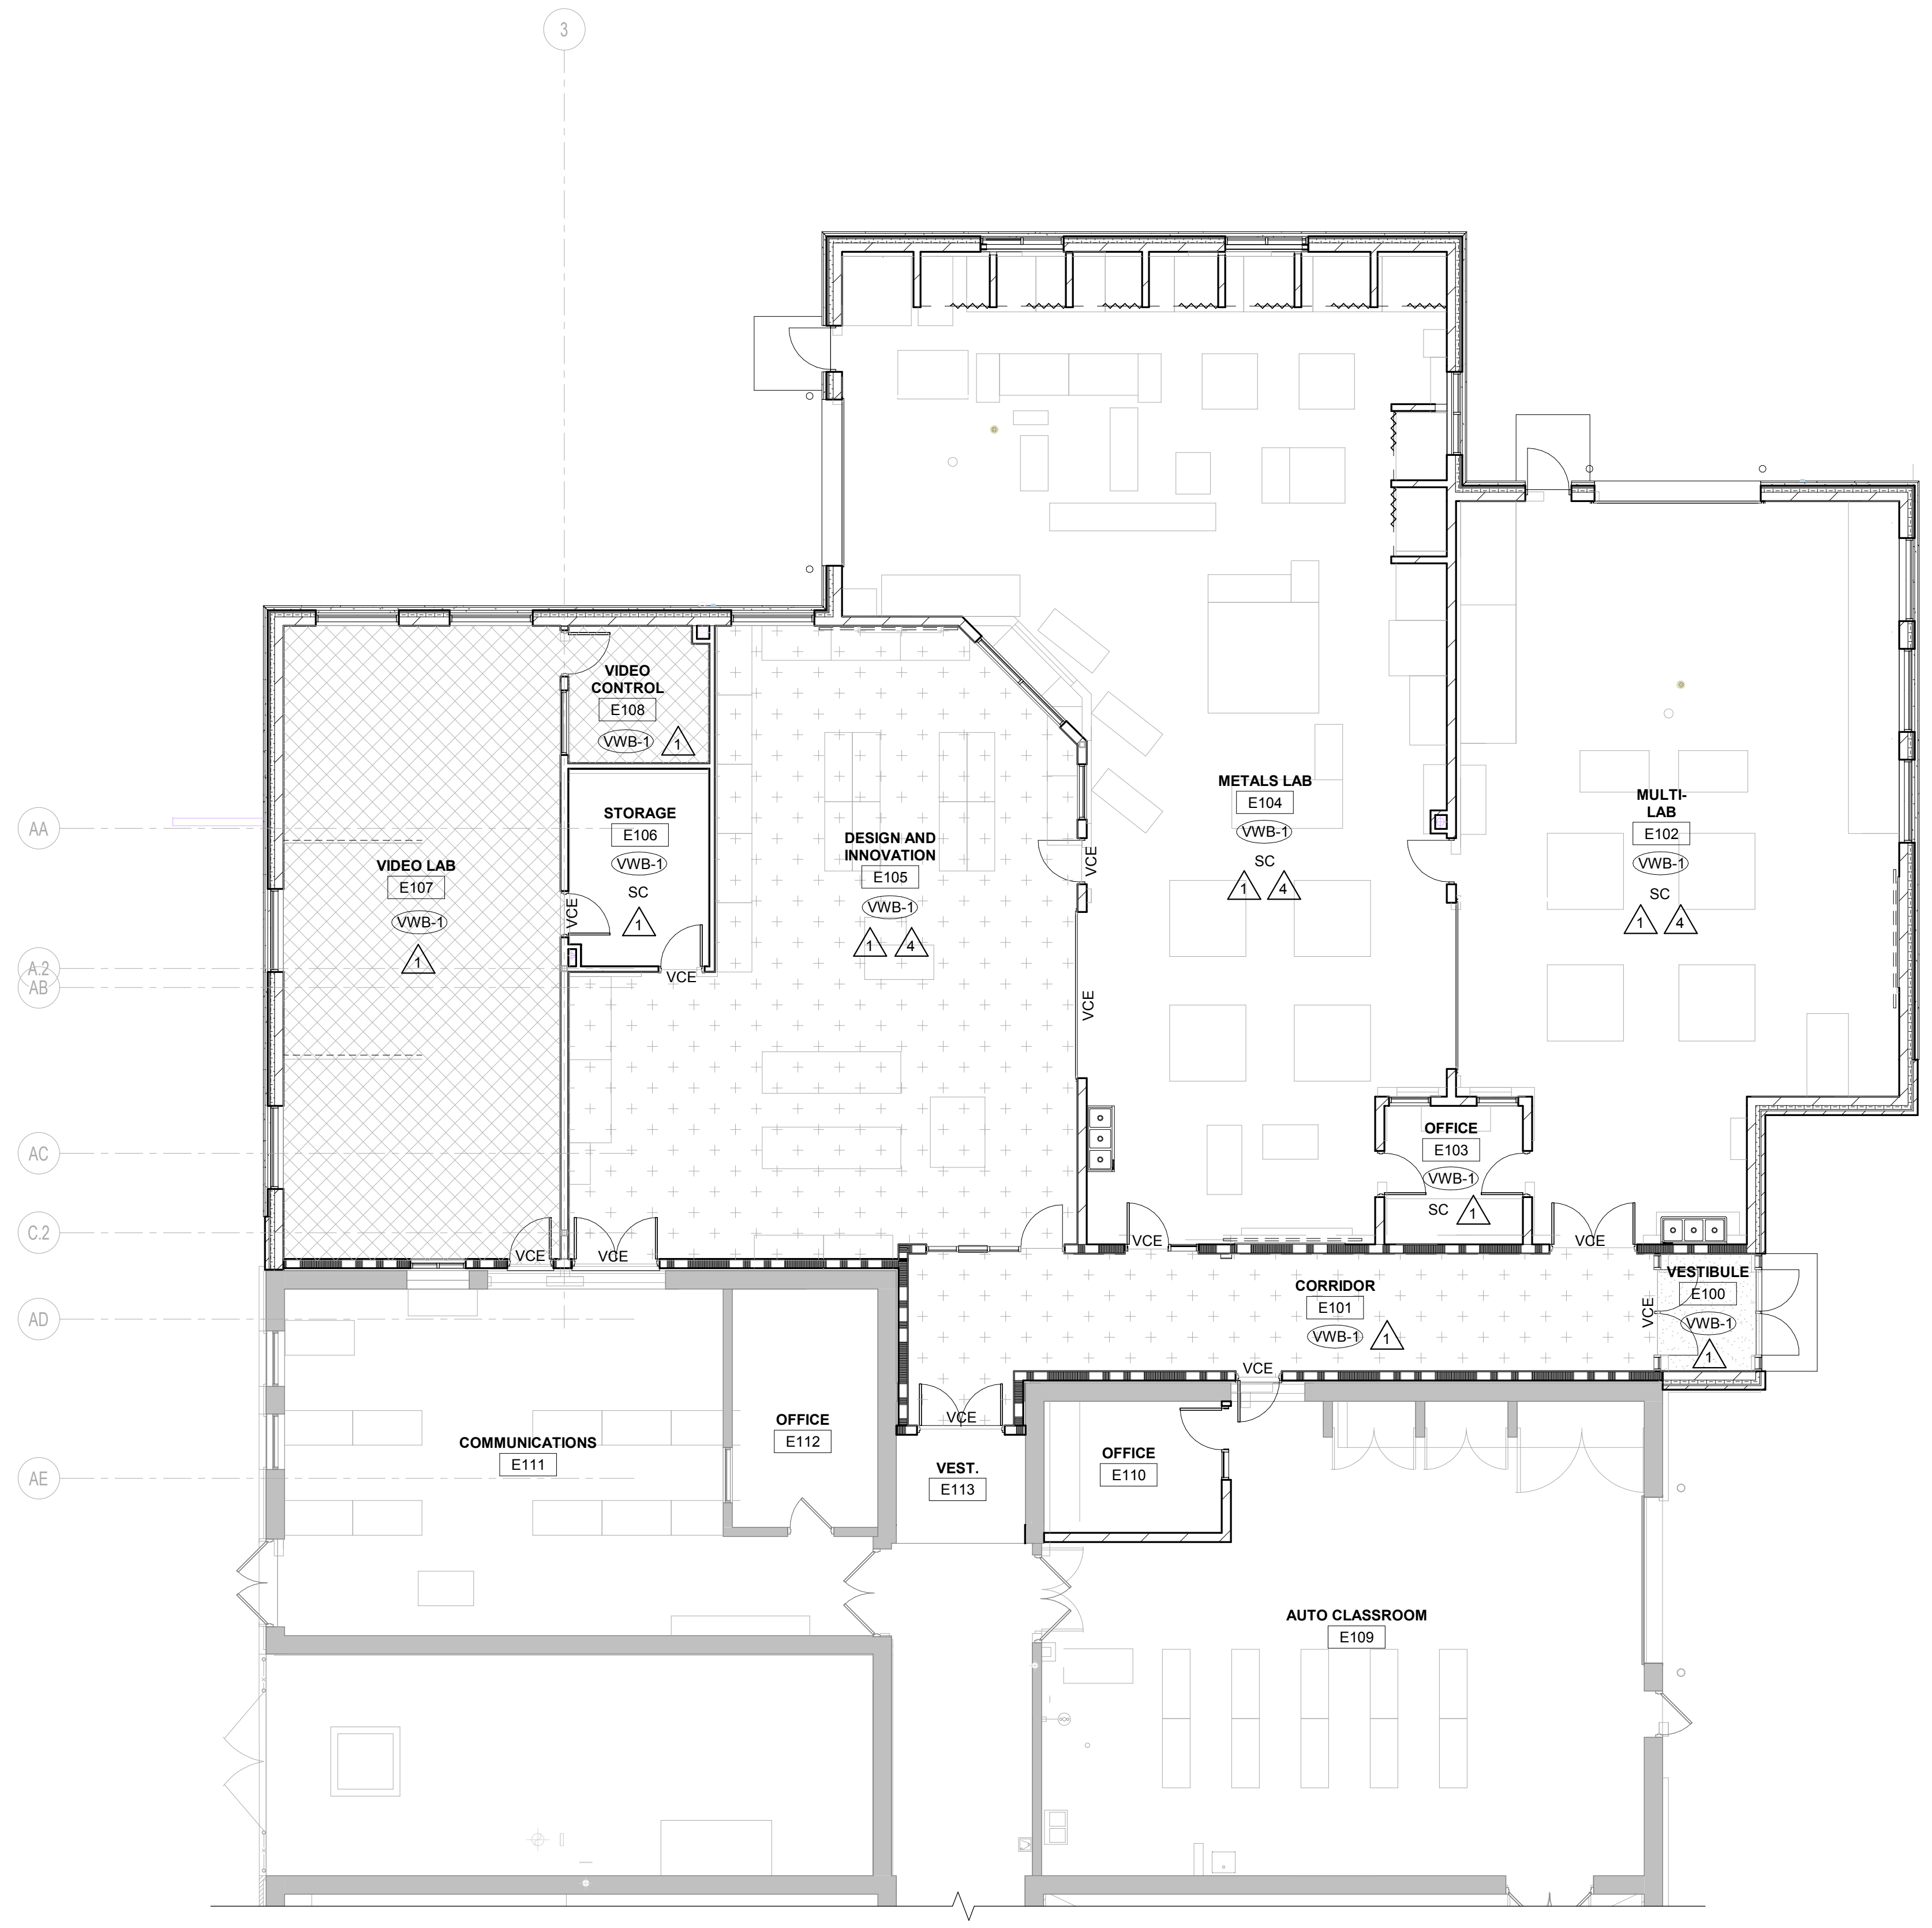


1 FIRST FLOOR FINISH PLAN - SEGMENT E
1/8" = 1'-0"

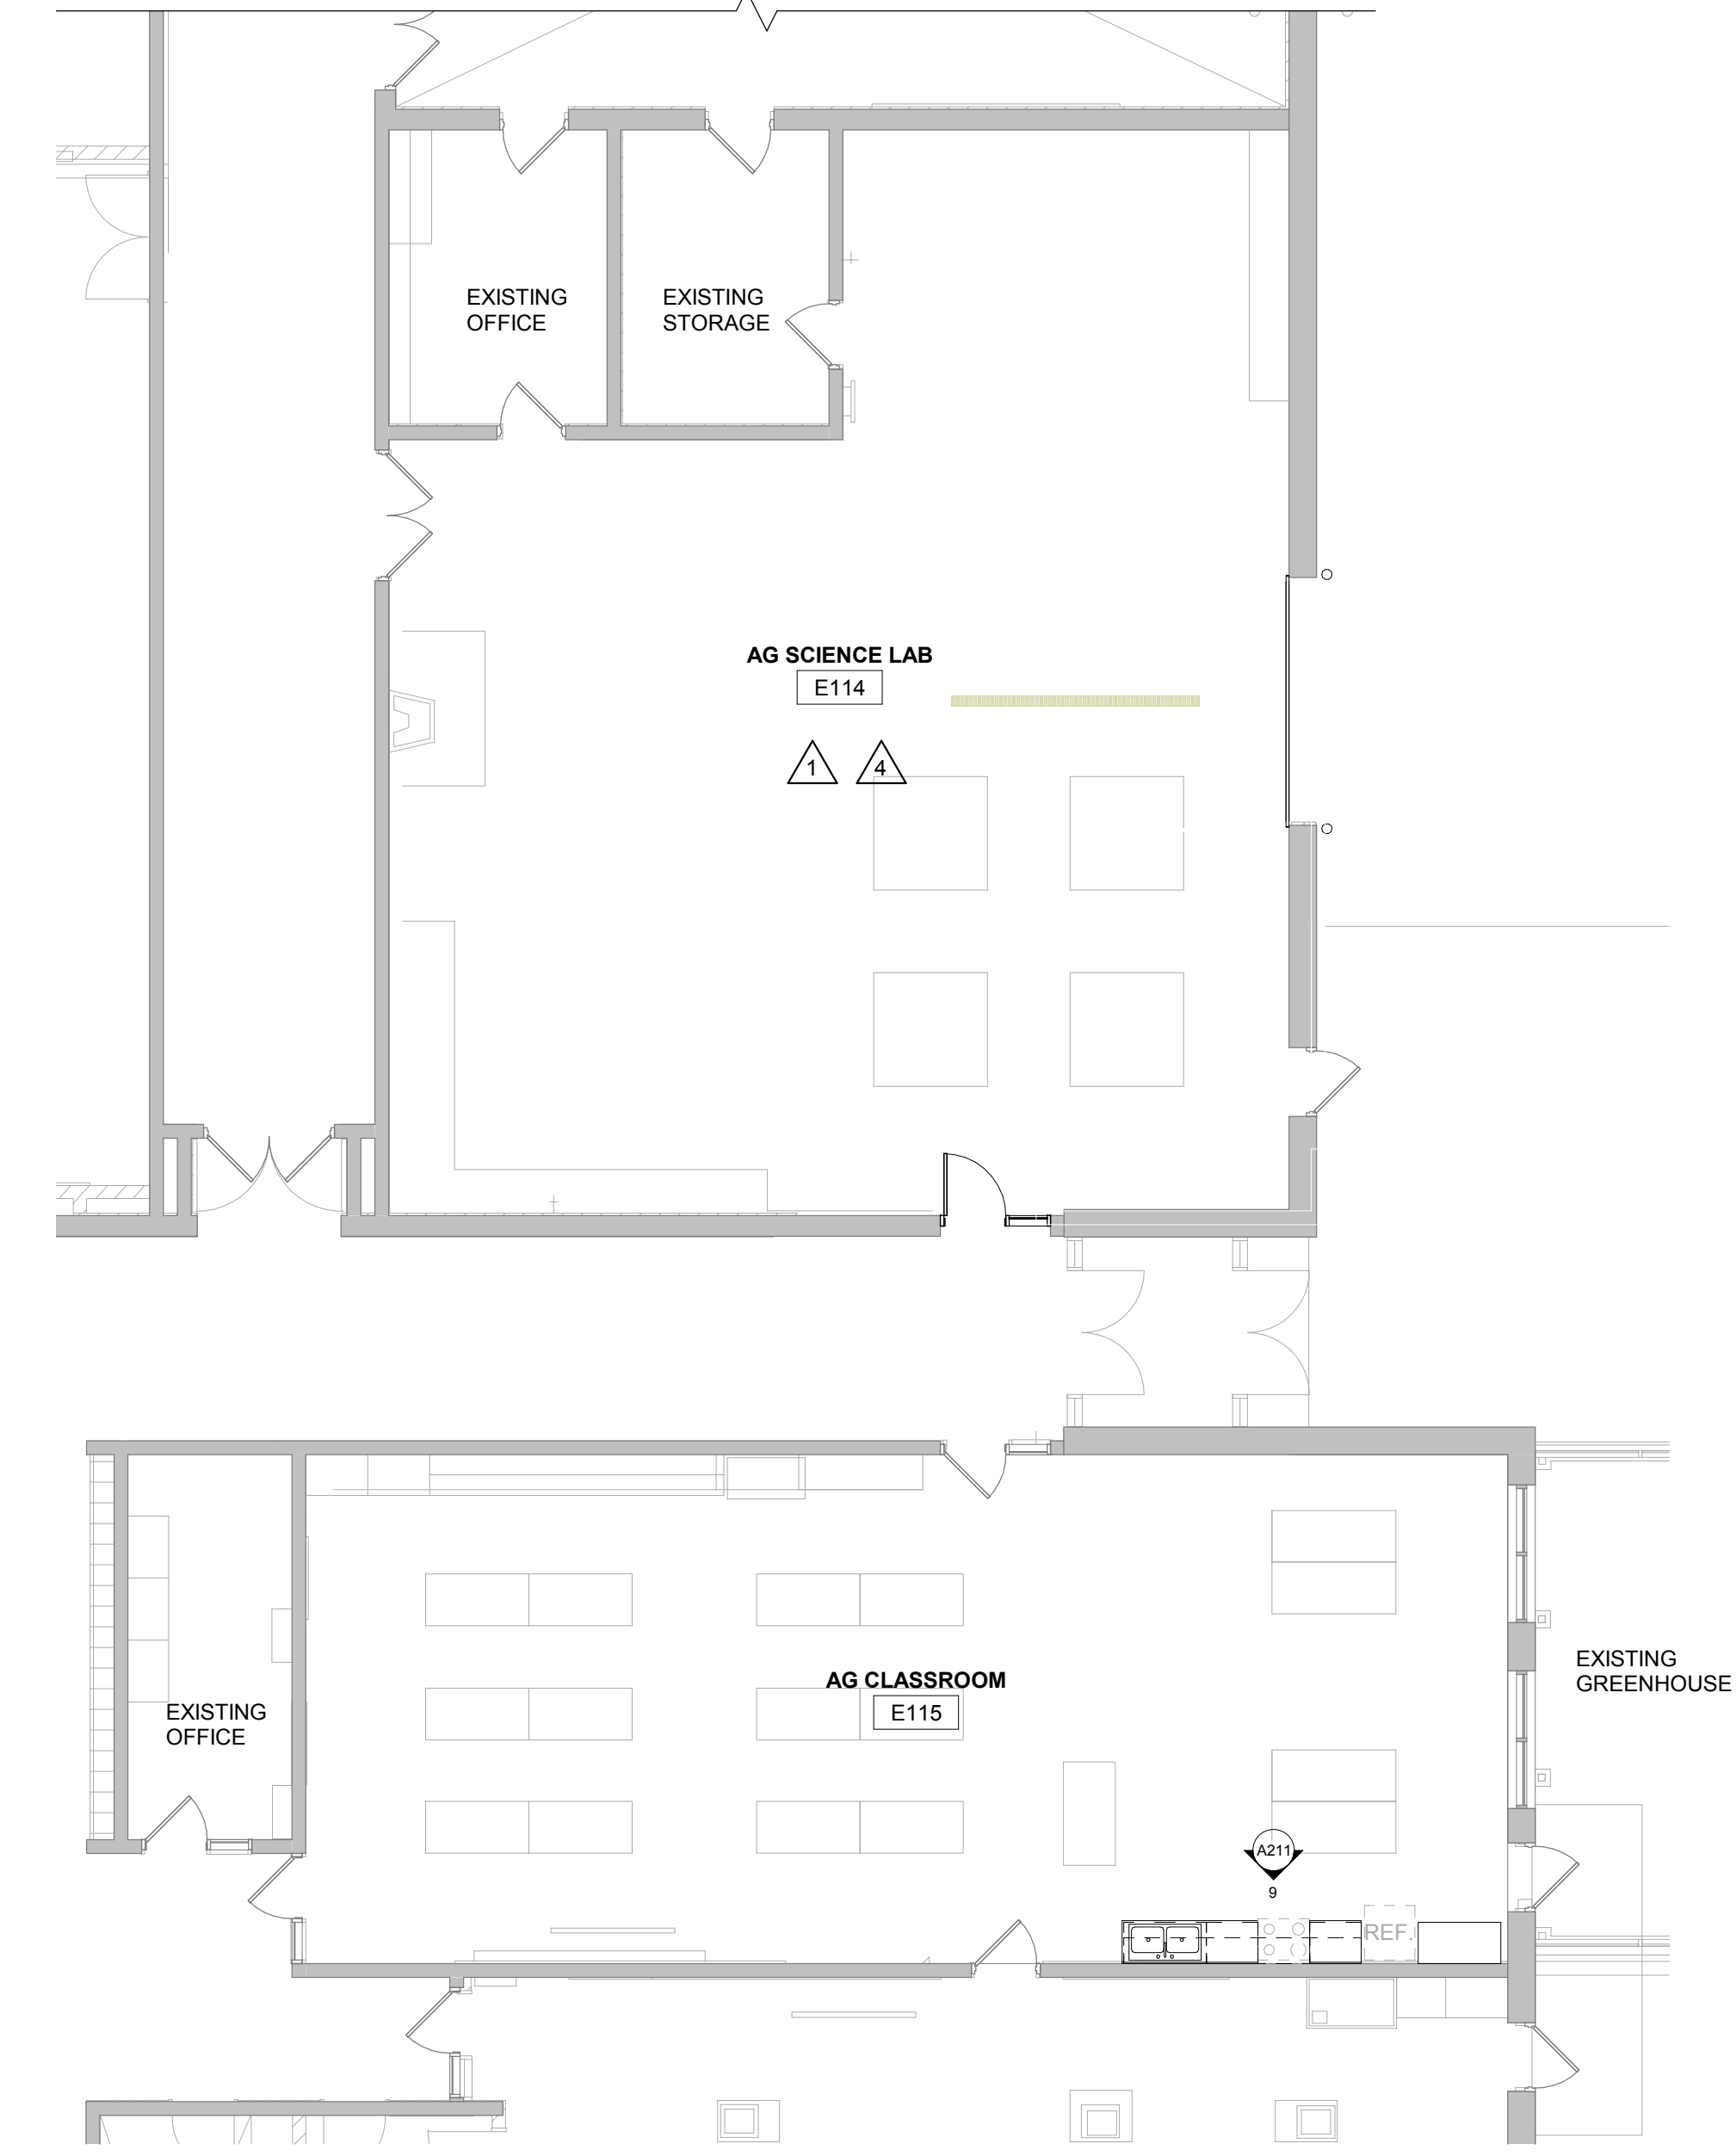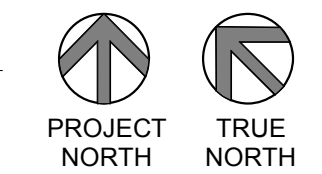

2 FIRST FLOOR FINISH PLAN - SEGMENT E1
1/8" = 1'-0"

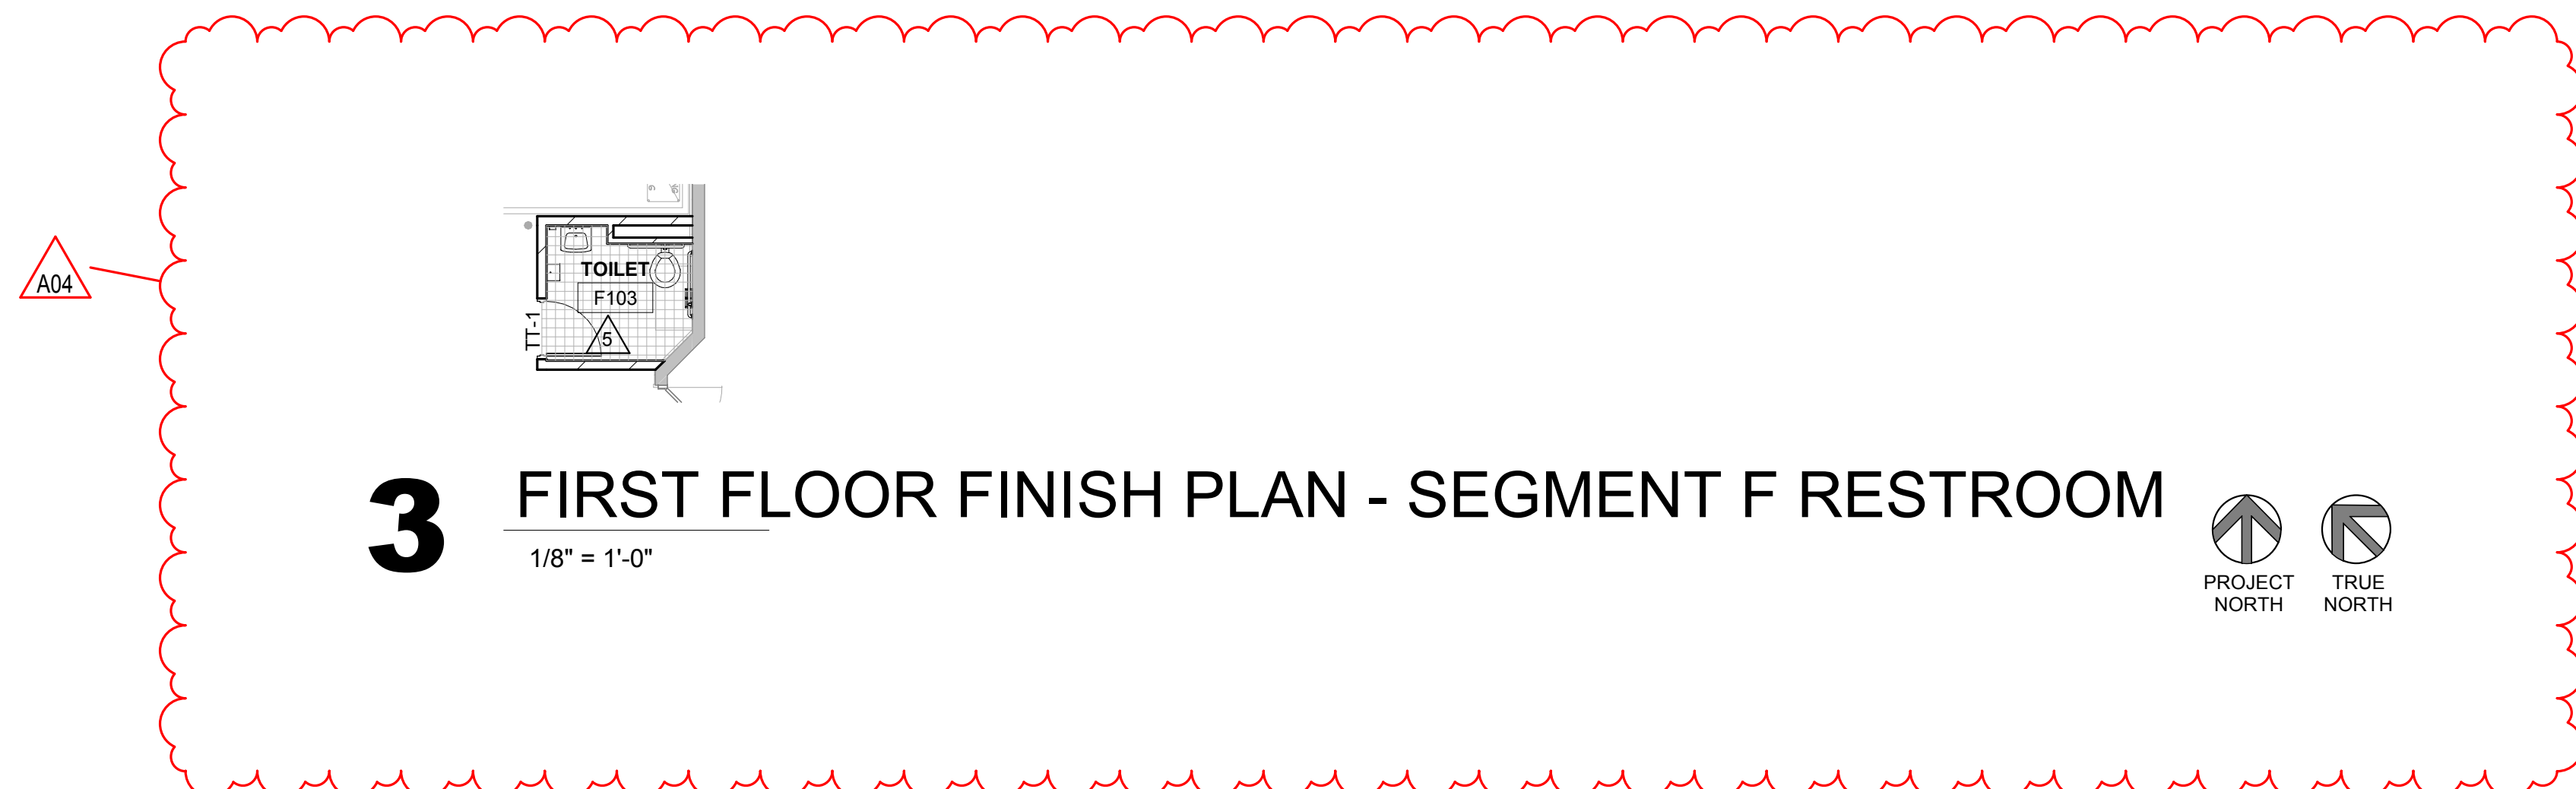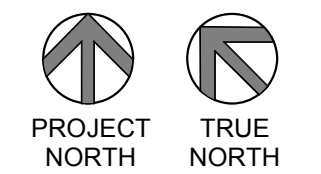


3 FIRST FLOOR FINISH PLAN - SEGMENT F RESTROOM
1/8" = 1'-0"

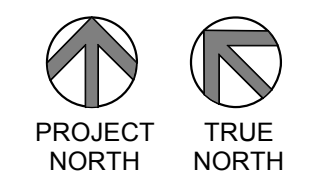





Consultant:

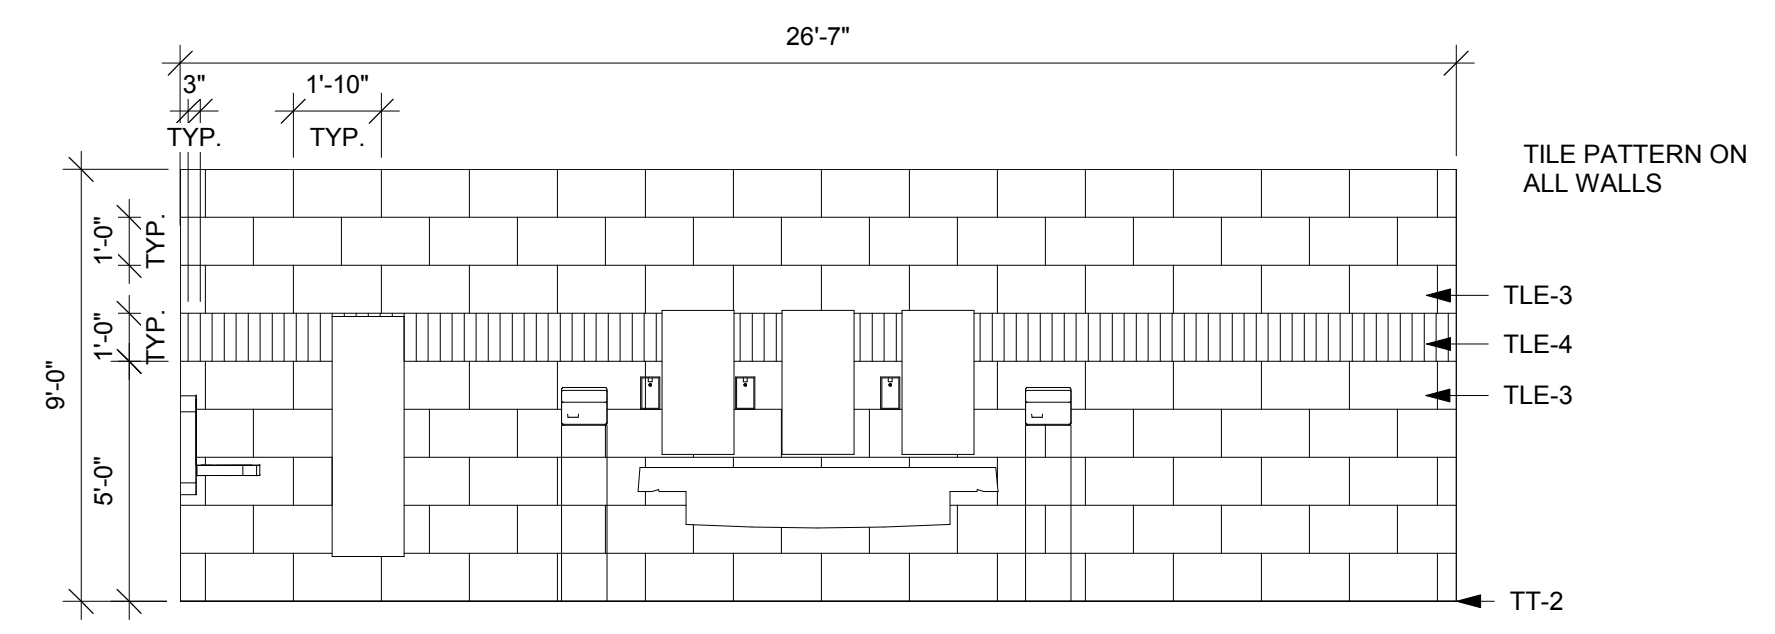

1 TILE ELEVATION
1/4" = 1'-0" A106, A107, A109

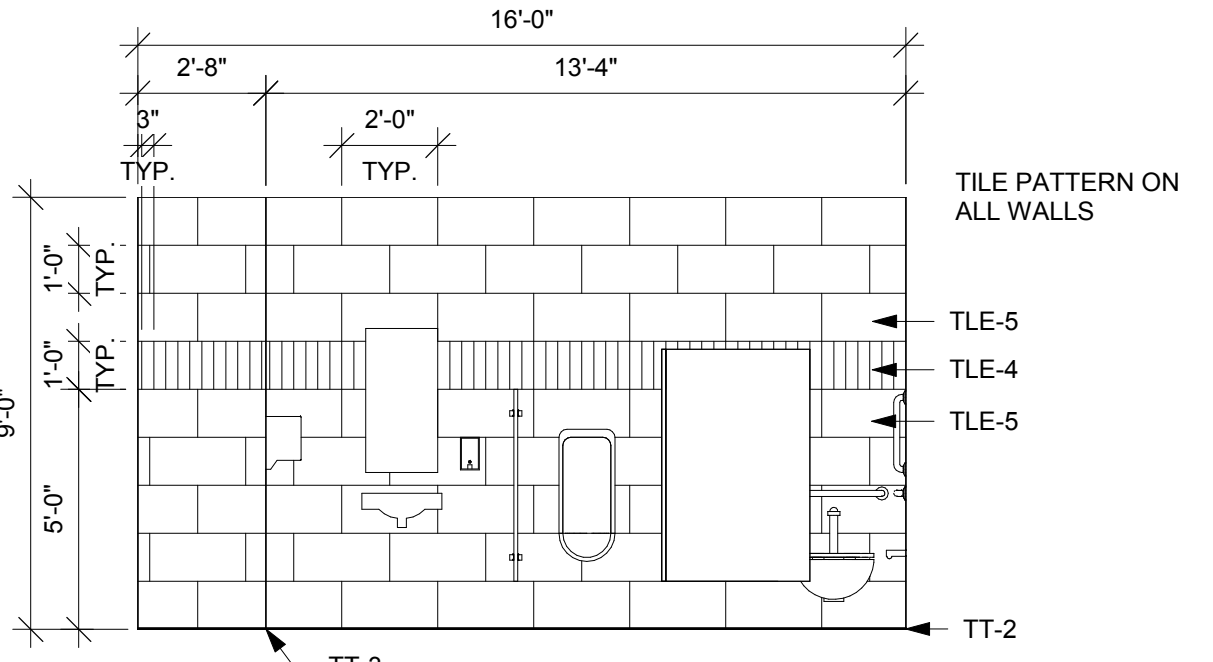

4 TILE ELEVATION
1/4" = 1'-0" A114, A115

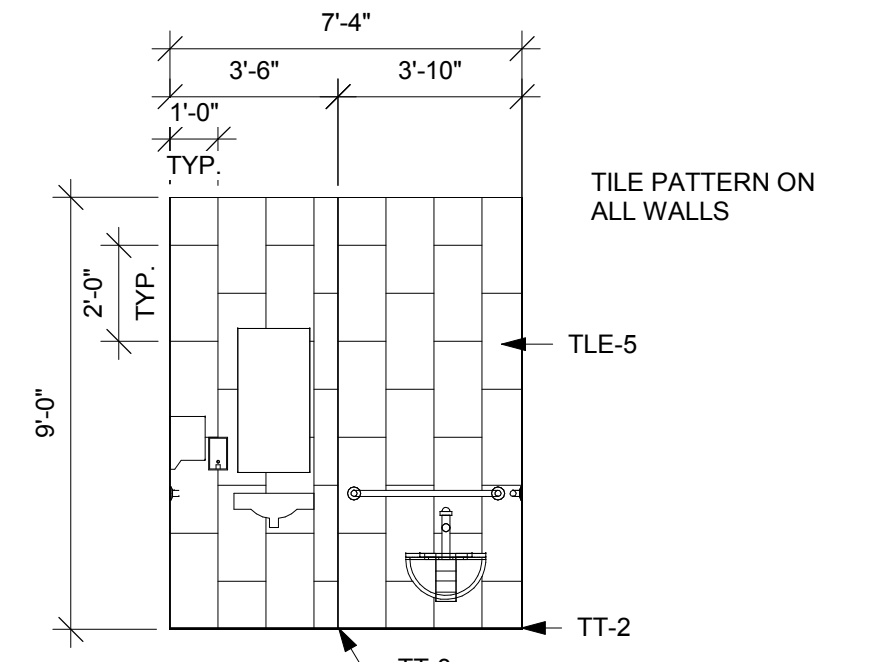


5 TILE ELEVATION
1/4" = 1'-0" A04


TILE PATTERN IN ROOMS
B104, B107, B108, B114,
B117, B118, B123, B124,
D101, F103

ROOM FINISH REMARKS

- 1 PAINT ALL WALLS PNT-1 - ACCENT AS INDICATED ON PLANS
- 2 PAINT ALL WALLS PNT-4 - ACCENT AS INDICATED ON PLANS
- 3 PAINT ALL WALLS AND CEILINGS EPOXY PNT-1 - ACCENT AS INDICATED ON PLANS
- 4 PAINT EXPOSED CEILINGS PNT-2
- 5 FULL HEIGHT TILE AT ALL WALLS. SEE TILE PATTERN ON ID400
- 6 PAINT ALL WALLS PNT-5
- 7 PAINT EXPOSED CEILING PNT-5
- 8 PAINT ALL WALLS PNT-5
- 9 PAINT EXPOSED CEILINGS PNT-8
- 10 PAINT EXPOSED CEILINGS PNT-4
- 11 LOCATION AND DIMENSION OF TRACK LINES AND DASHES TO BE VERIFIED BY OWNER
- 12 TRACK LANE LINES TO BE WHITE
- 13 1/8" DOT DRILL "DASHES" IN CORRIDOR C102 TO BE BLACK
- 14 HORIZONTAL AND PLAN WEST VERTICAL LINES OF "LADDER DRILLS" TO BE STONE GRAY. PLAN EAST VERTICAL LINE OF "LADDER DRILLS" THAT IS ALSO TRACK LANE LINES TO BE WHITE.
- 15 TRACK HANDOFF DASHES IN CORRIDOR B121 TO BE BLACK. SEE ID103

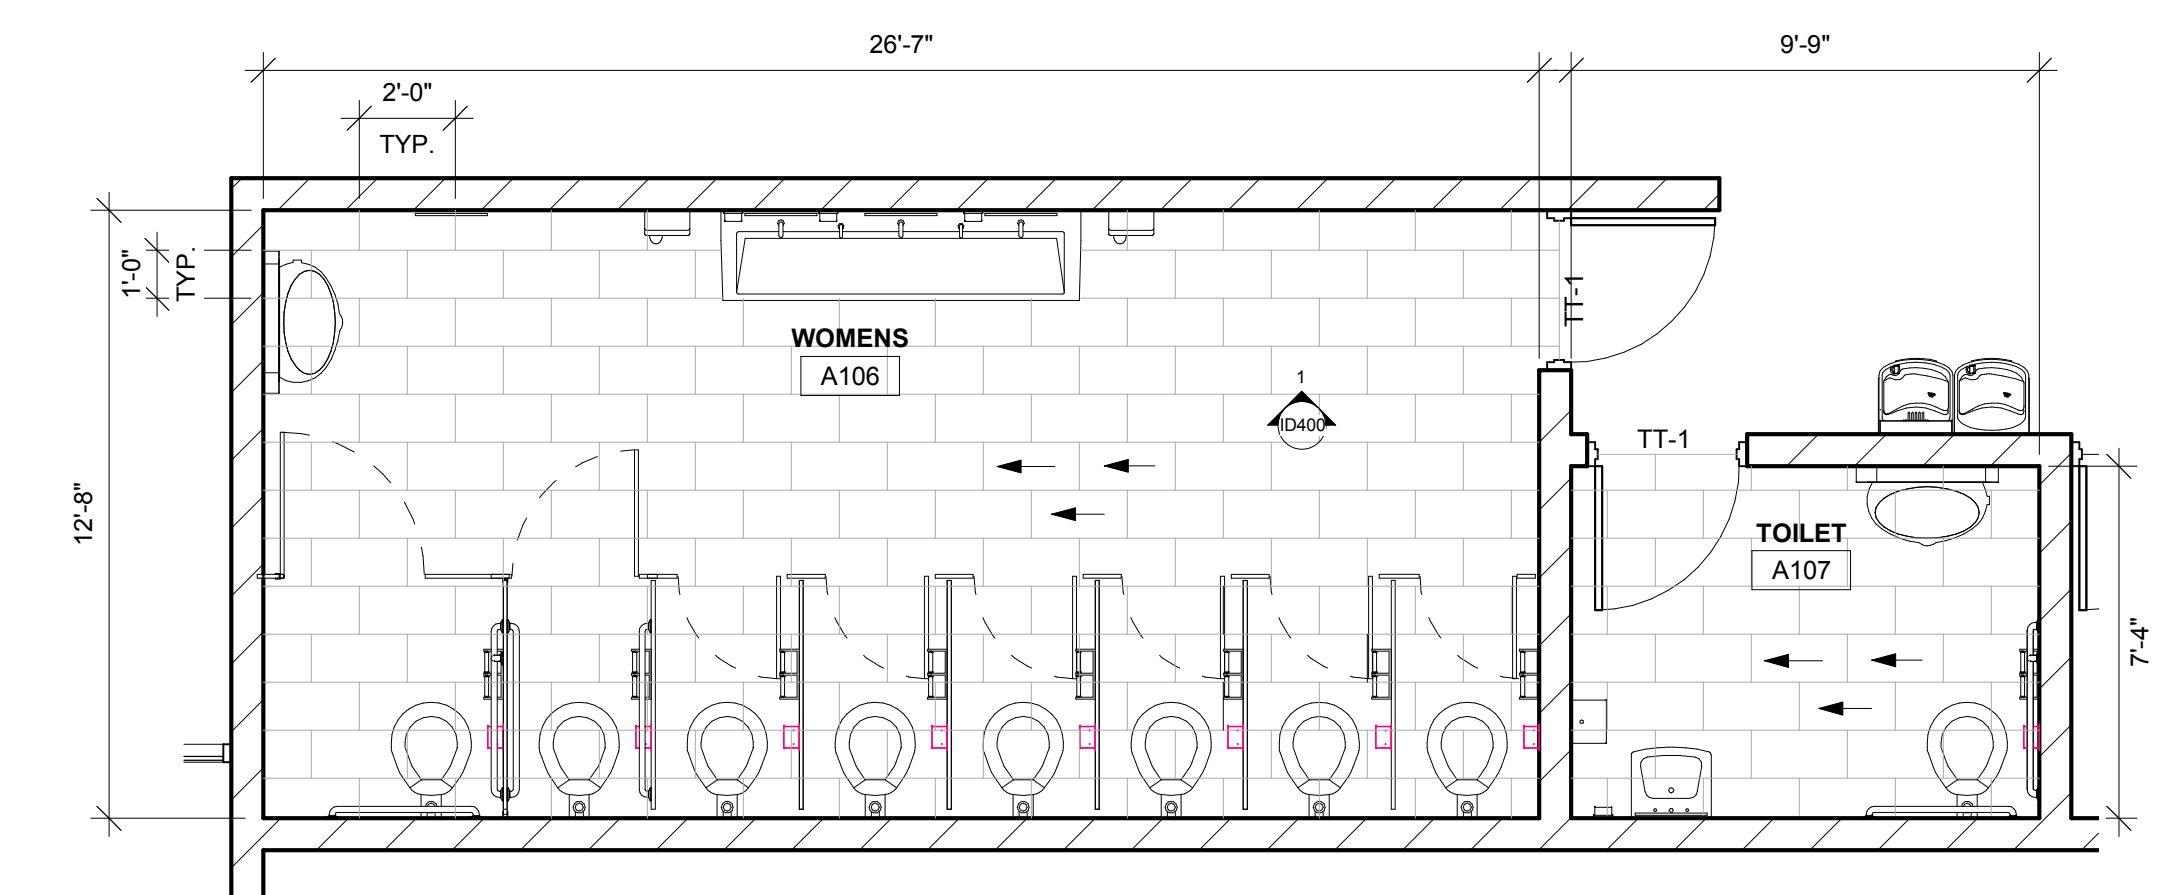


2 ENLARGED TILE PATTERN
1/4" = 1'-0" A106, A107, A109, A114, A115

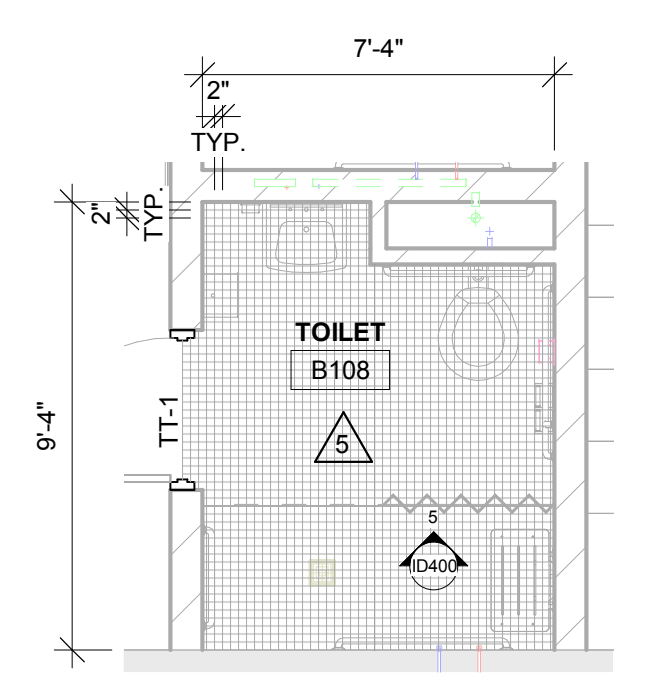


3 ENLARGED TILE PATTERN
1/4" = 1'-0" A04


B104, B107, B108, B114, B117, B118, B123, B124, F103

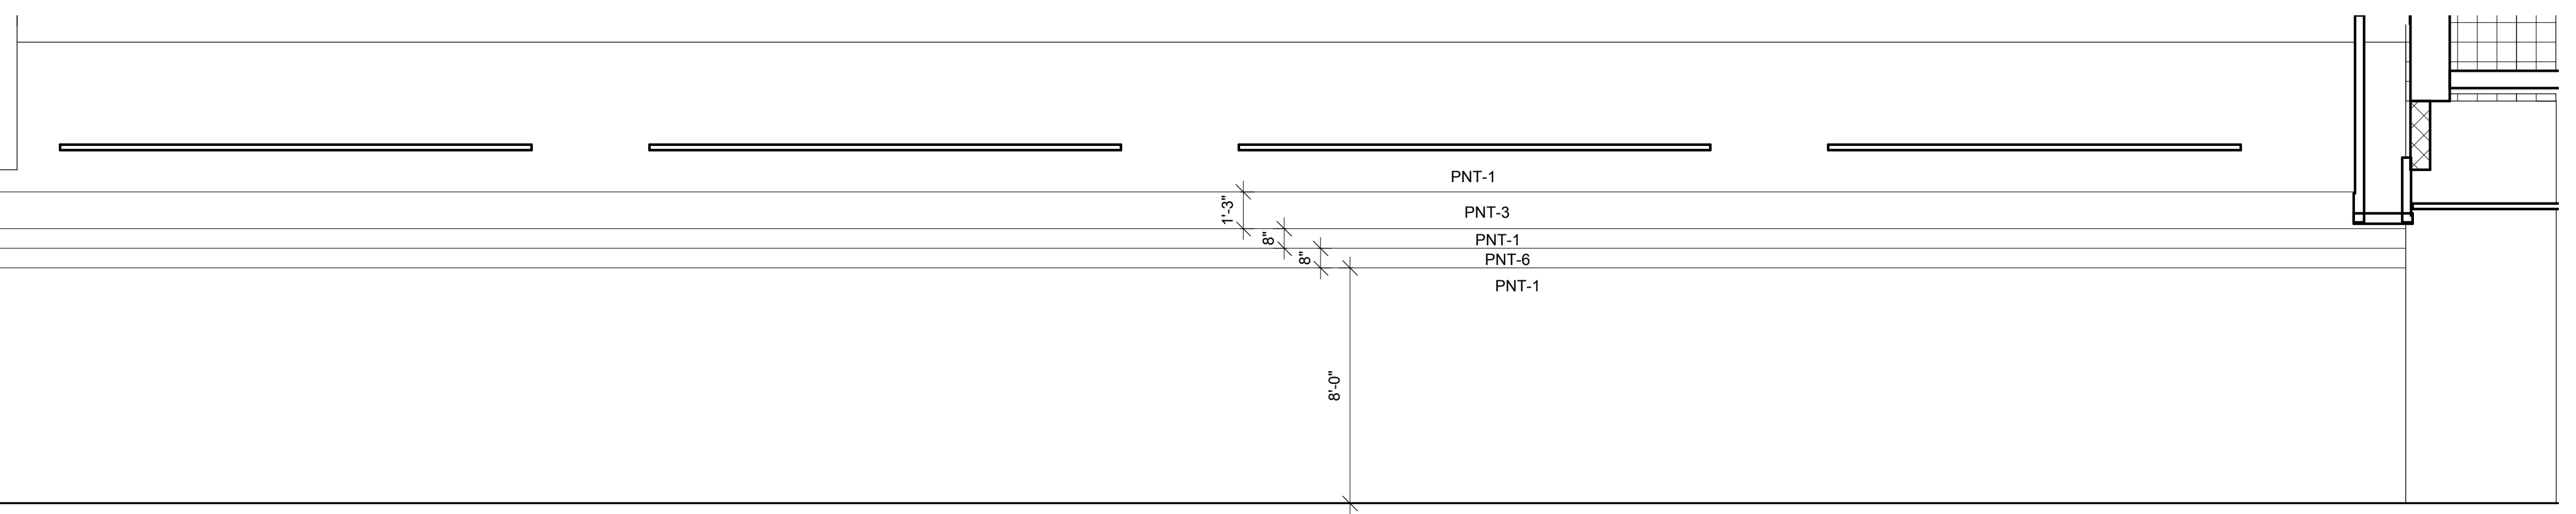

6 C102 ELEVATION
1/4" = 1'-0"

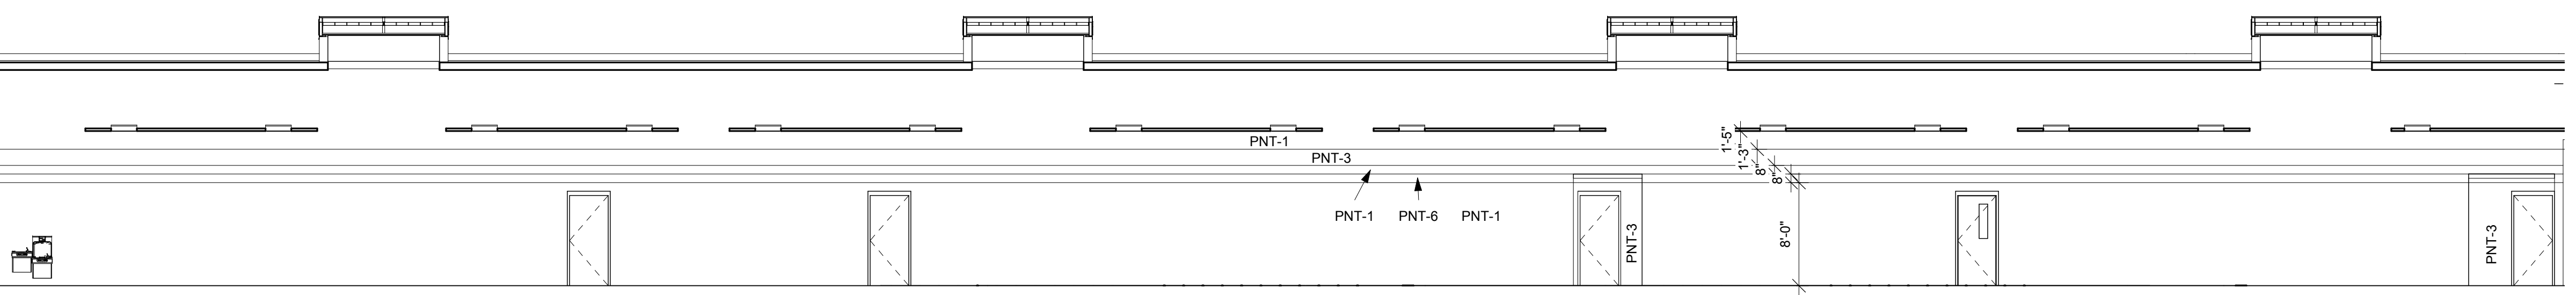

7 B121 ELEVATION
1/8" = 1'-0"

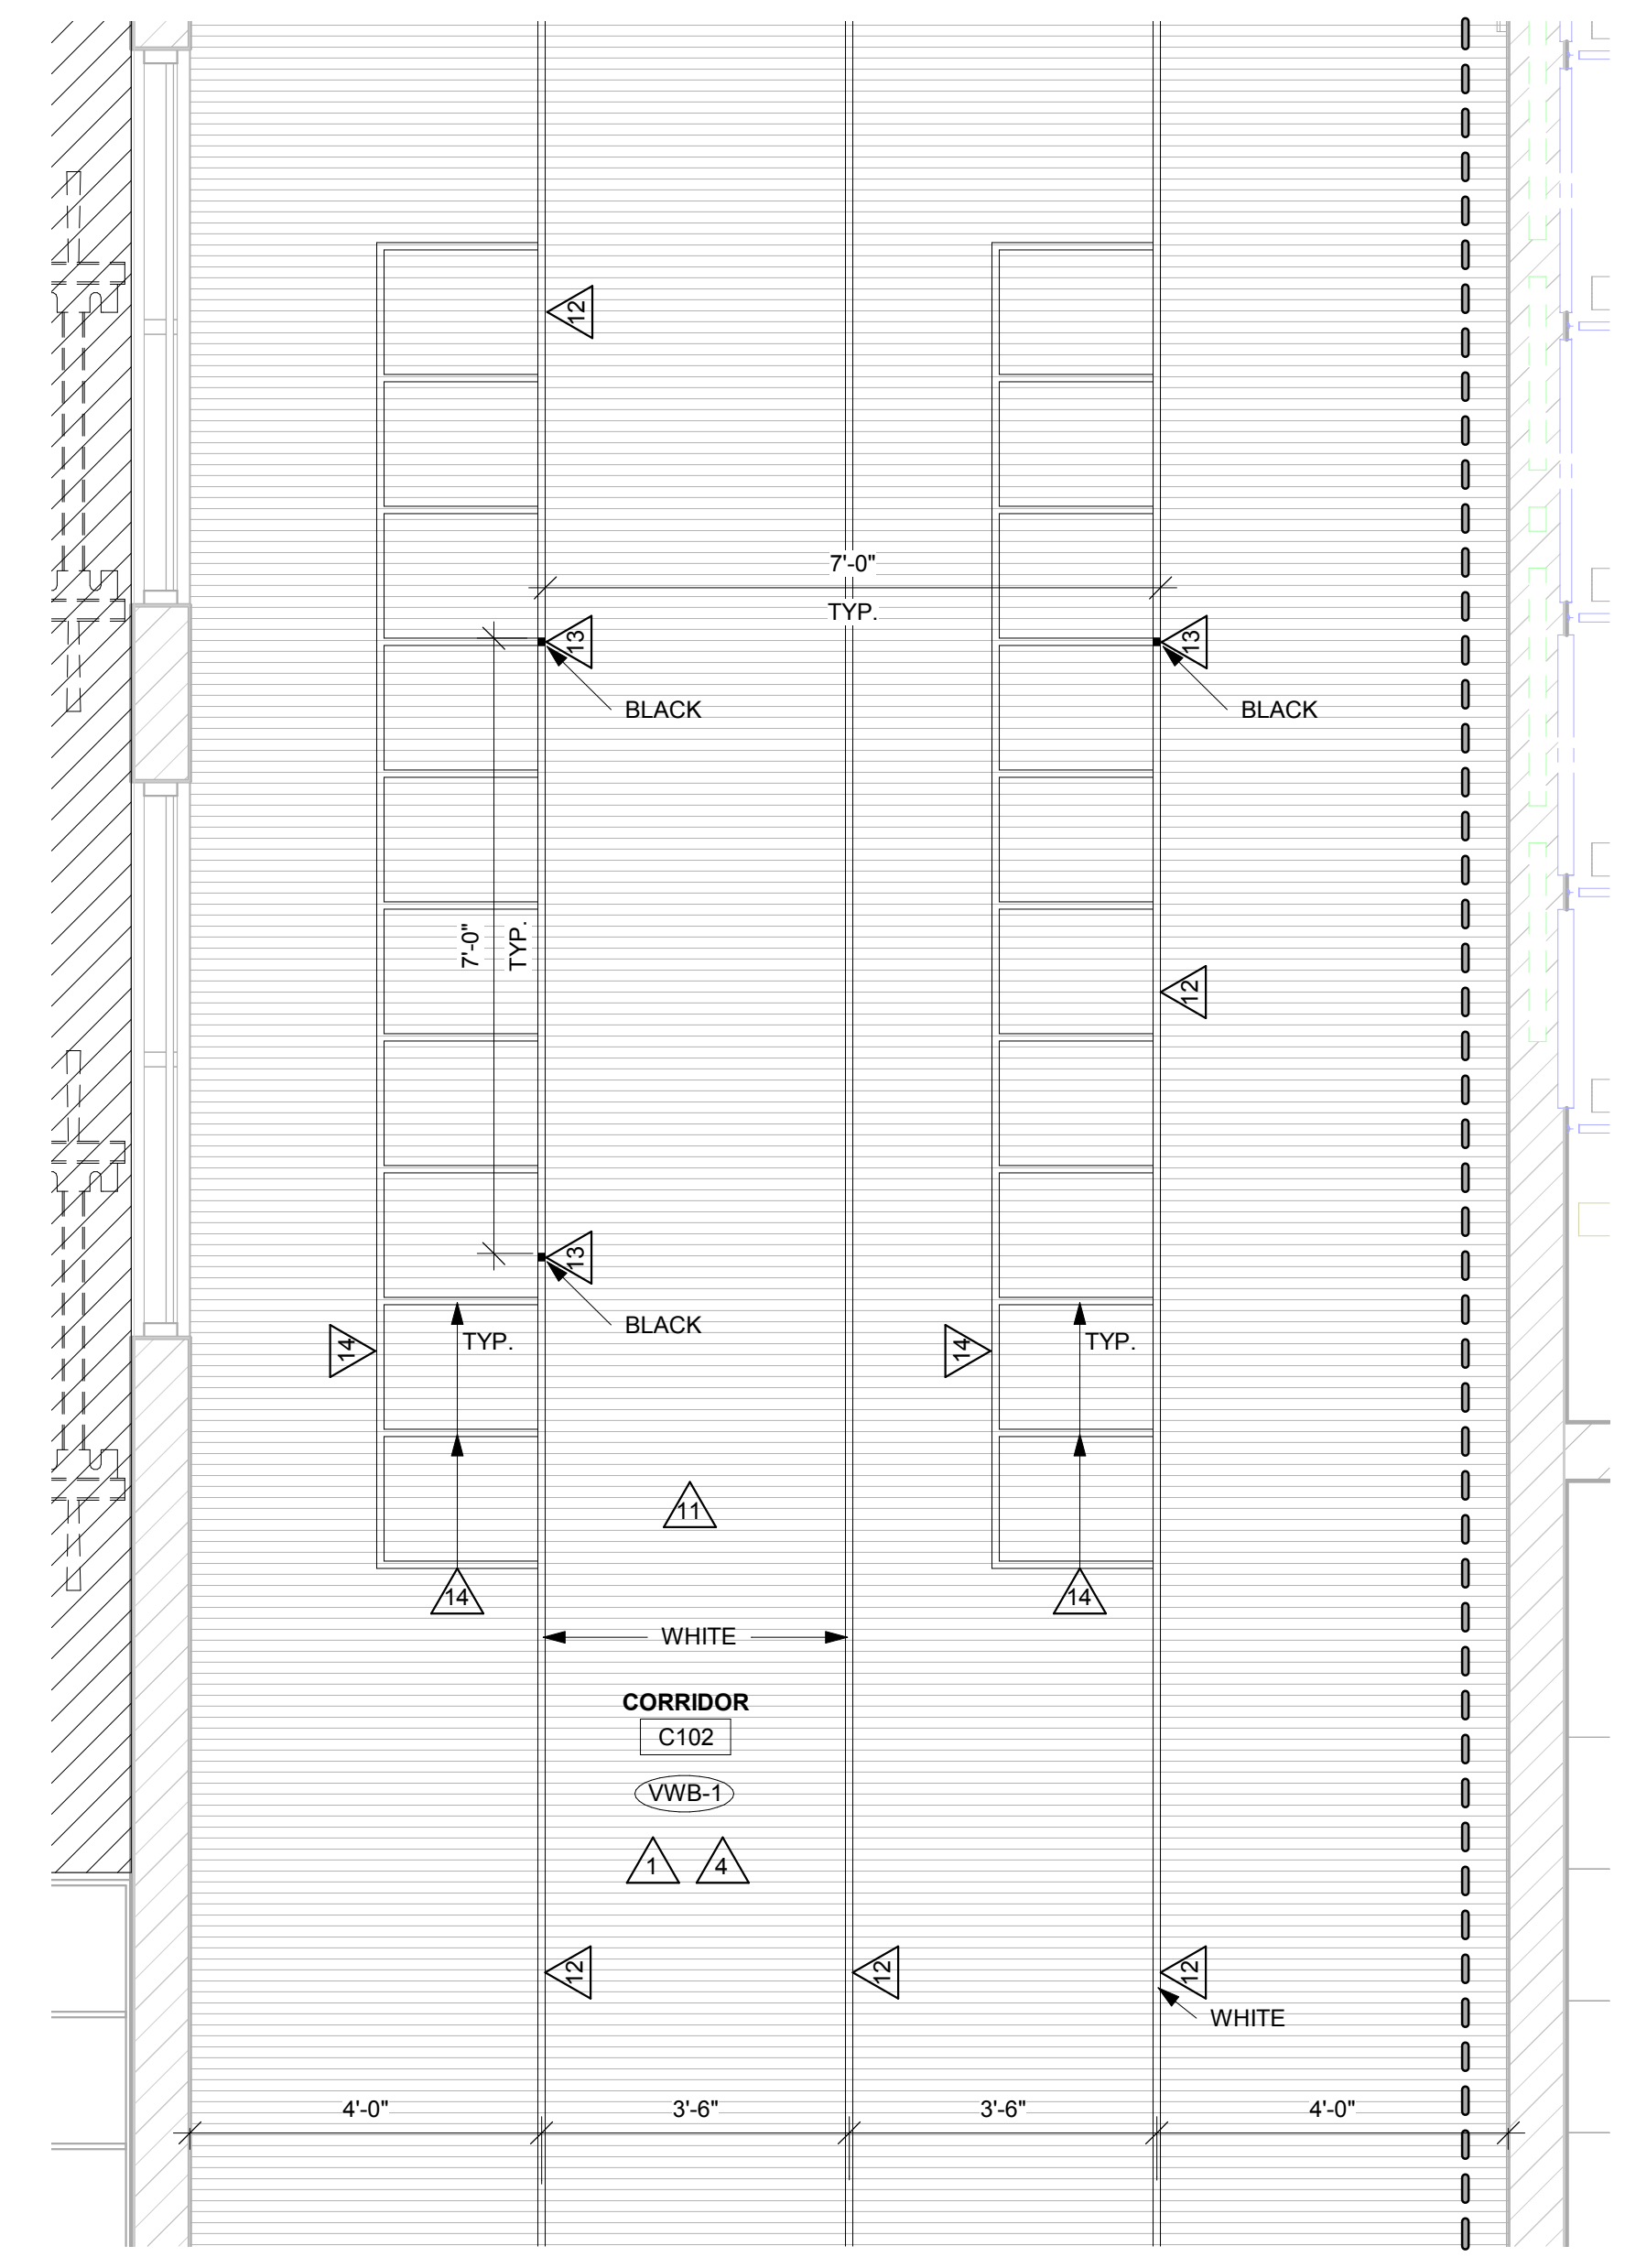

8 ENLARGED HALLWAY FLOOR PATTERN
1/2" = 1'-0" LAYOUT OCCURS IN 3 LOCATIONS SEE ID103

SCHOOL DISTRICT OF HOLMEN
HIGH SCHOOL ADDITION & REMODELING
BID PACKAGE #2
1001 McHUGH RD
HOLMEN, WI 54636
INTERIOR ELEVATIONS AND ENLARGED PLANS

Project Title:
Project Location:
Sheet Title:

HSR Project Number:
18061

Project Date:
JULY 2019

Drawn By:
SB

Key Plan:

Revisions:

No.	Description	Date
A02	Addendum 2	7/30/19
A04	Addendum 4	8/7/19


Graphic Scale:
VARIES

Last Update:
8/7/2019 9:43:50 AM

ID400



Consultant:

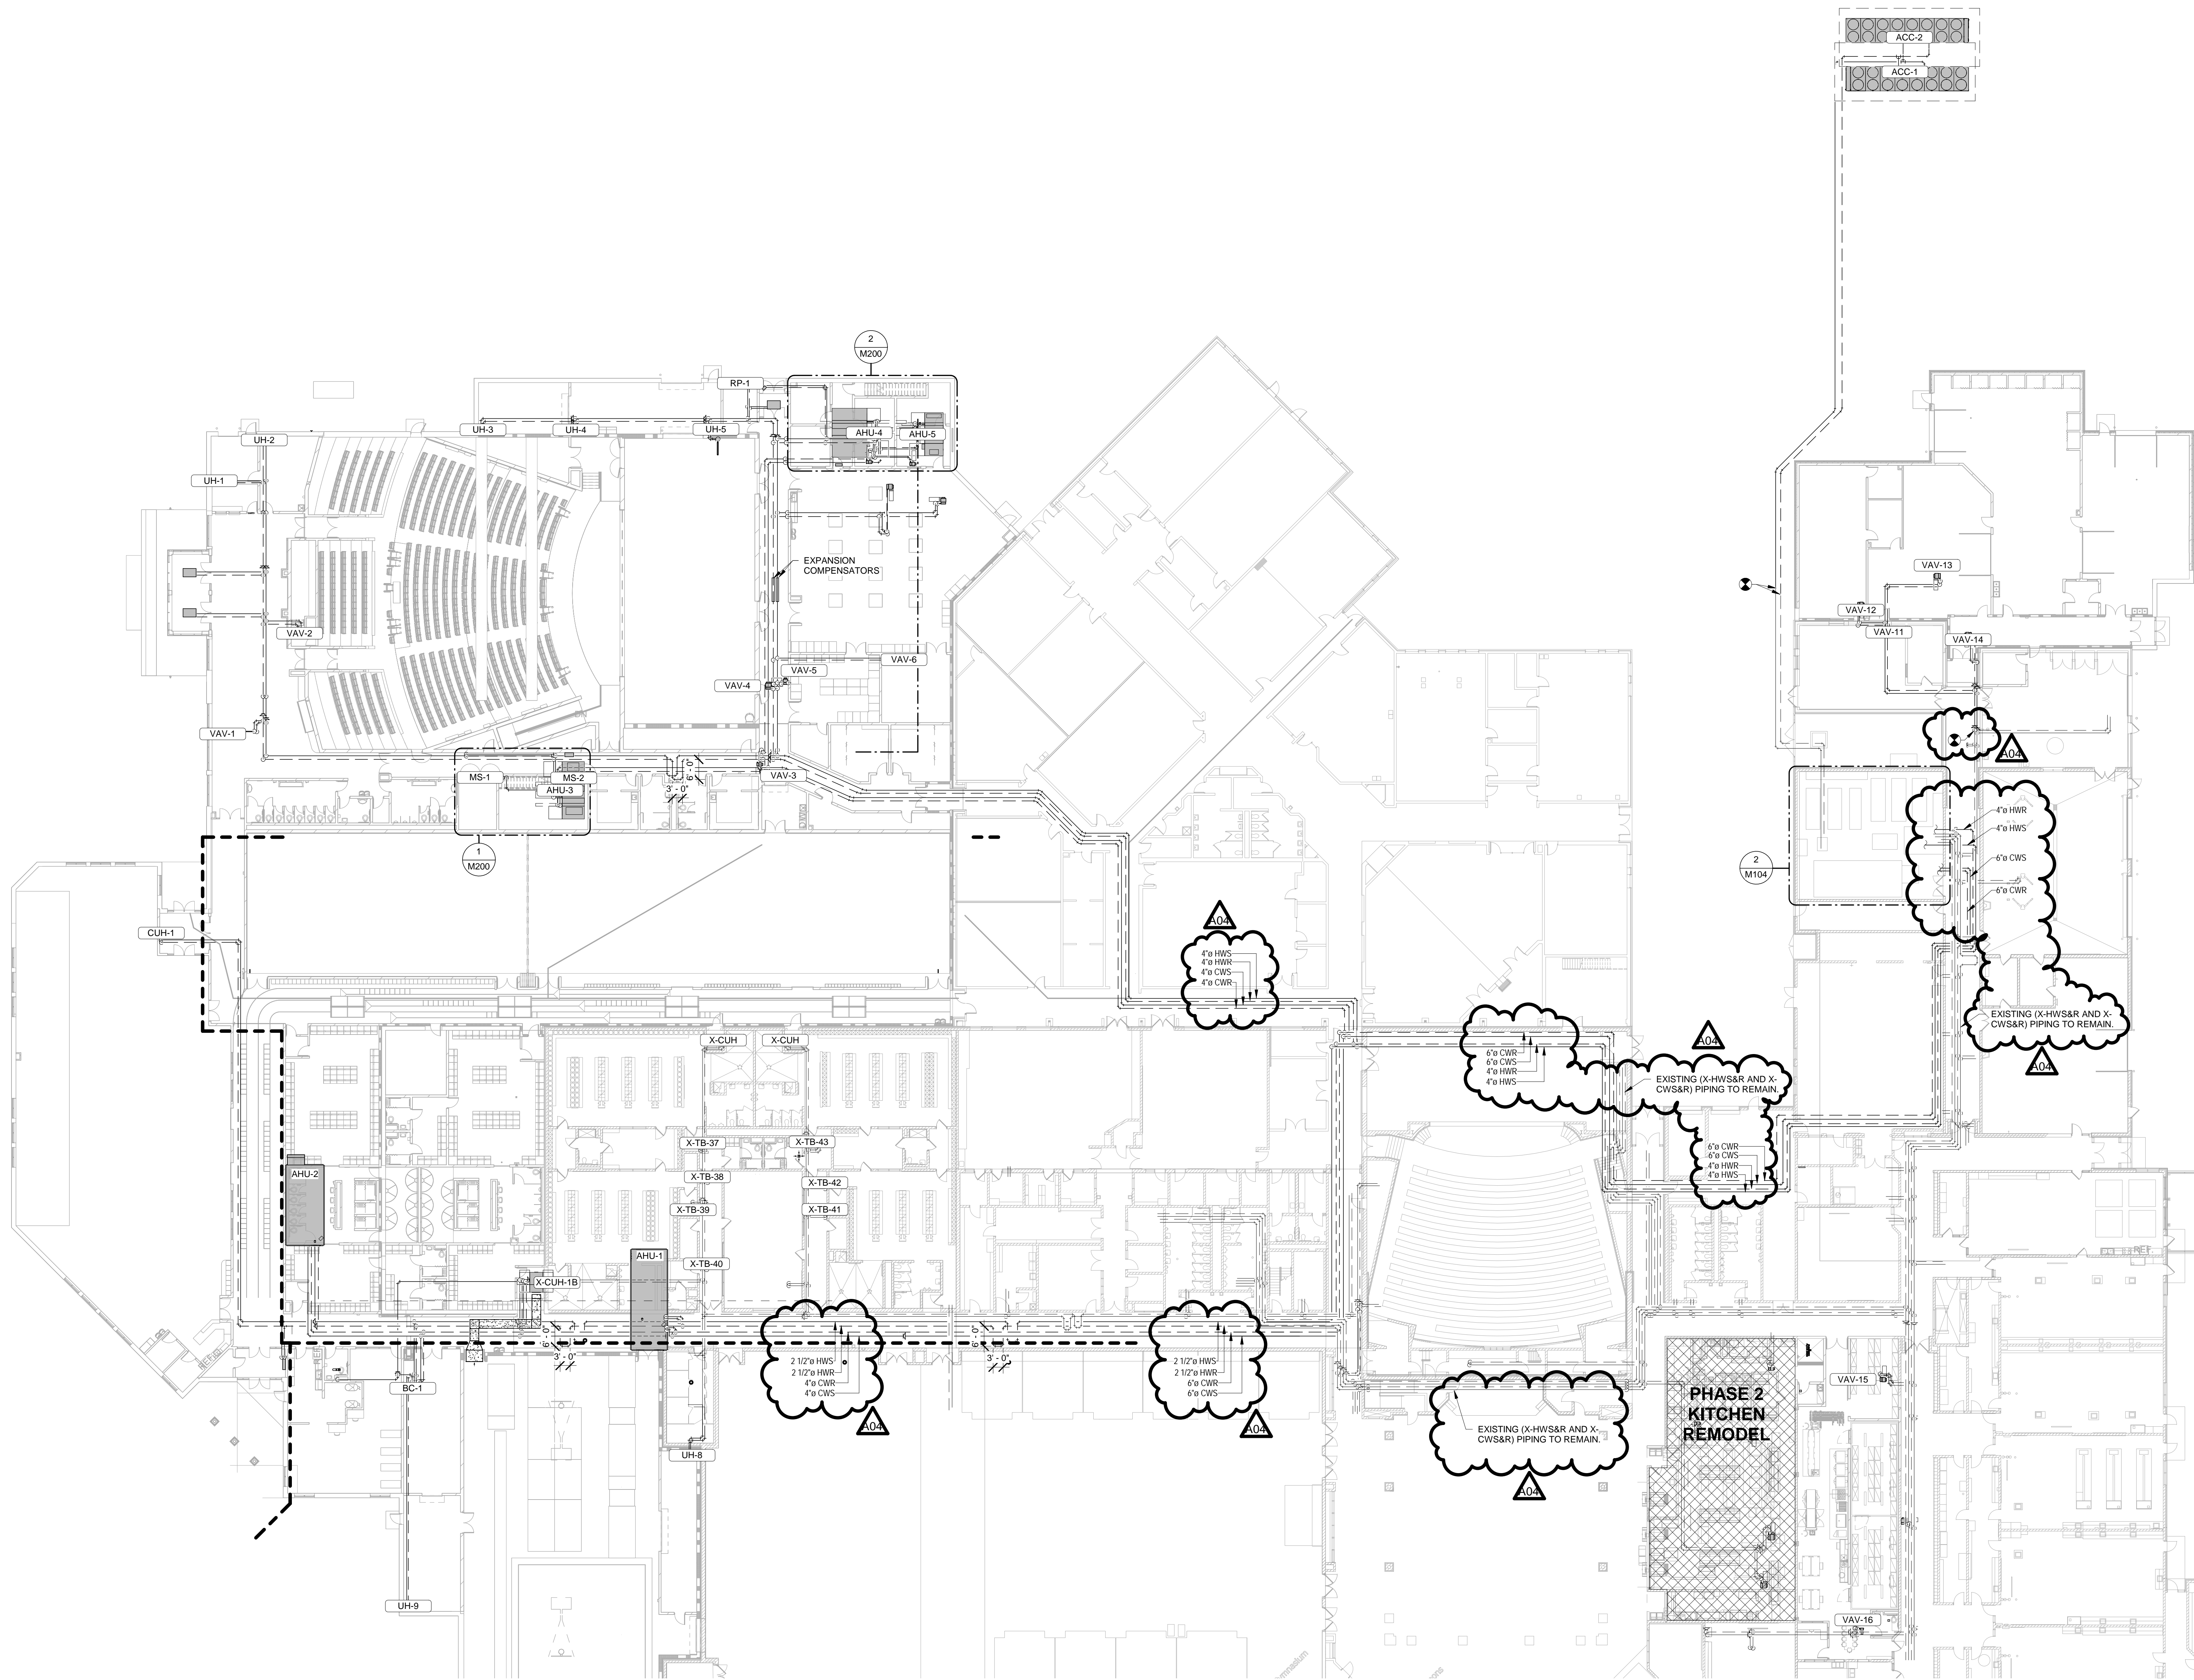

SCHOOL DISTRICT OF HOLMEN
HIGH SCHOOL ADDITION & REMODELING
OVERALL MECHANICAL PIPING REMODEL PLAN

Project Title:
Project Location: 1001 McHUGH RD
HOLMEN, WI 54636

HSR Project Number:
18061

Project Date:
JULY 2019

Drawn By:
Lescher


Key Plan:

No.	Description	Date
A01	Addendum 1	7/25/2019
A04	Addendum 4	8/7/2019

Graphic Scale:
VARIES

Last Update:
8/7/2019 2:24:24 PM

M106

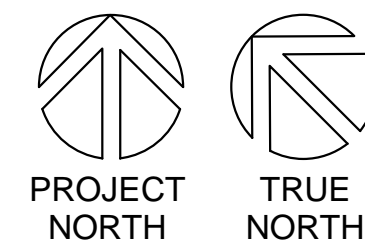

1

OVERALL MECHANICAL PIPING REMODEL PLAN

1" = 20'-0"



Consultant:


SCHOOL DISTRICT OF HOLMEN
HIGH SCHOOL ADDITION & REMODELING

HSR Project Number:
18061

Project Date:
JULY 2019

Drawn By:
Lescher

Key Plan:

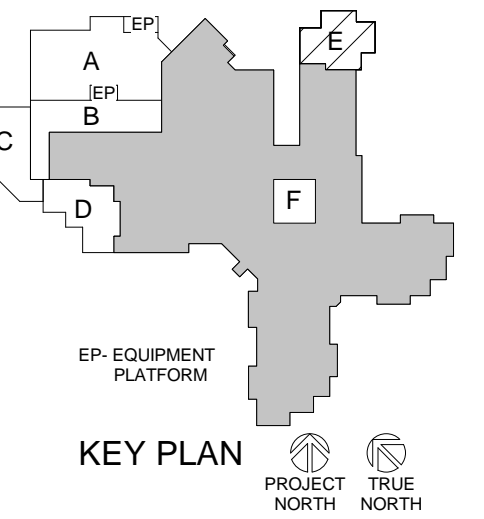


Revisions:

No.	Description	Date
A01	Addendum 1	7/25/2019
A04	Addendum 4	8/7/2019


Graphic Scale:
0 2 4 8 12

Last Update:
8/7/2019 2:24:31 PM

M110

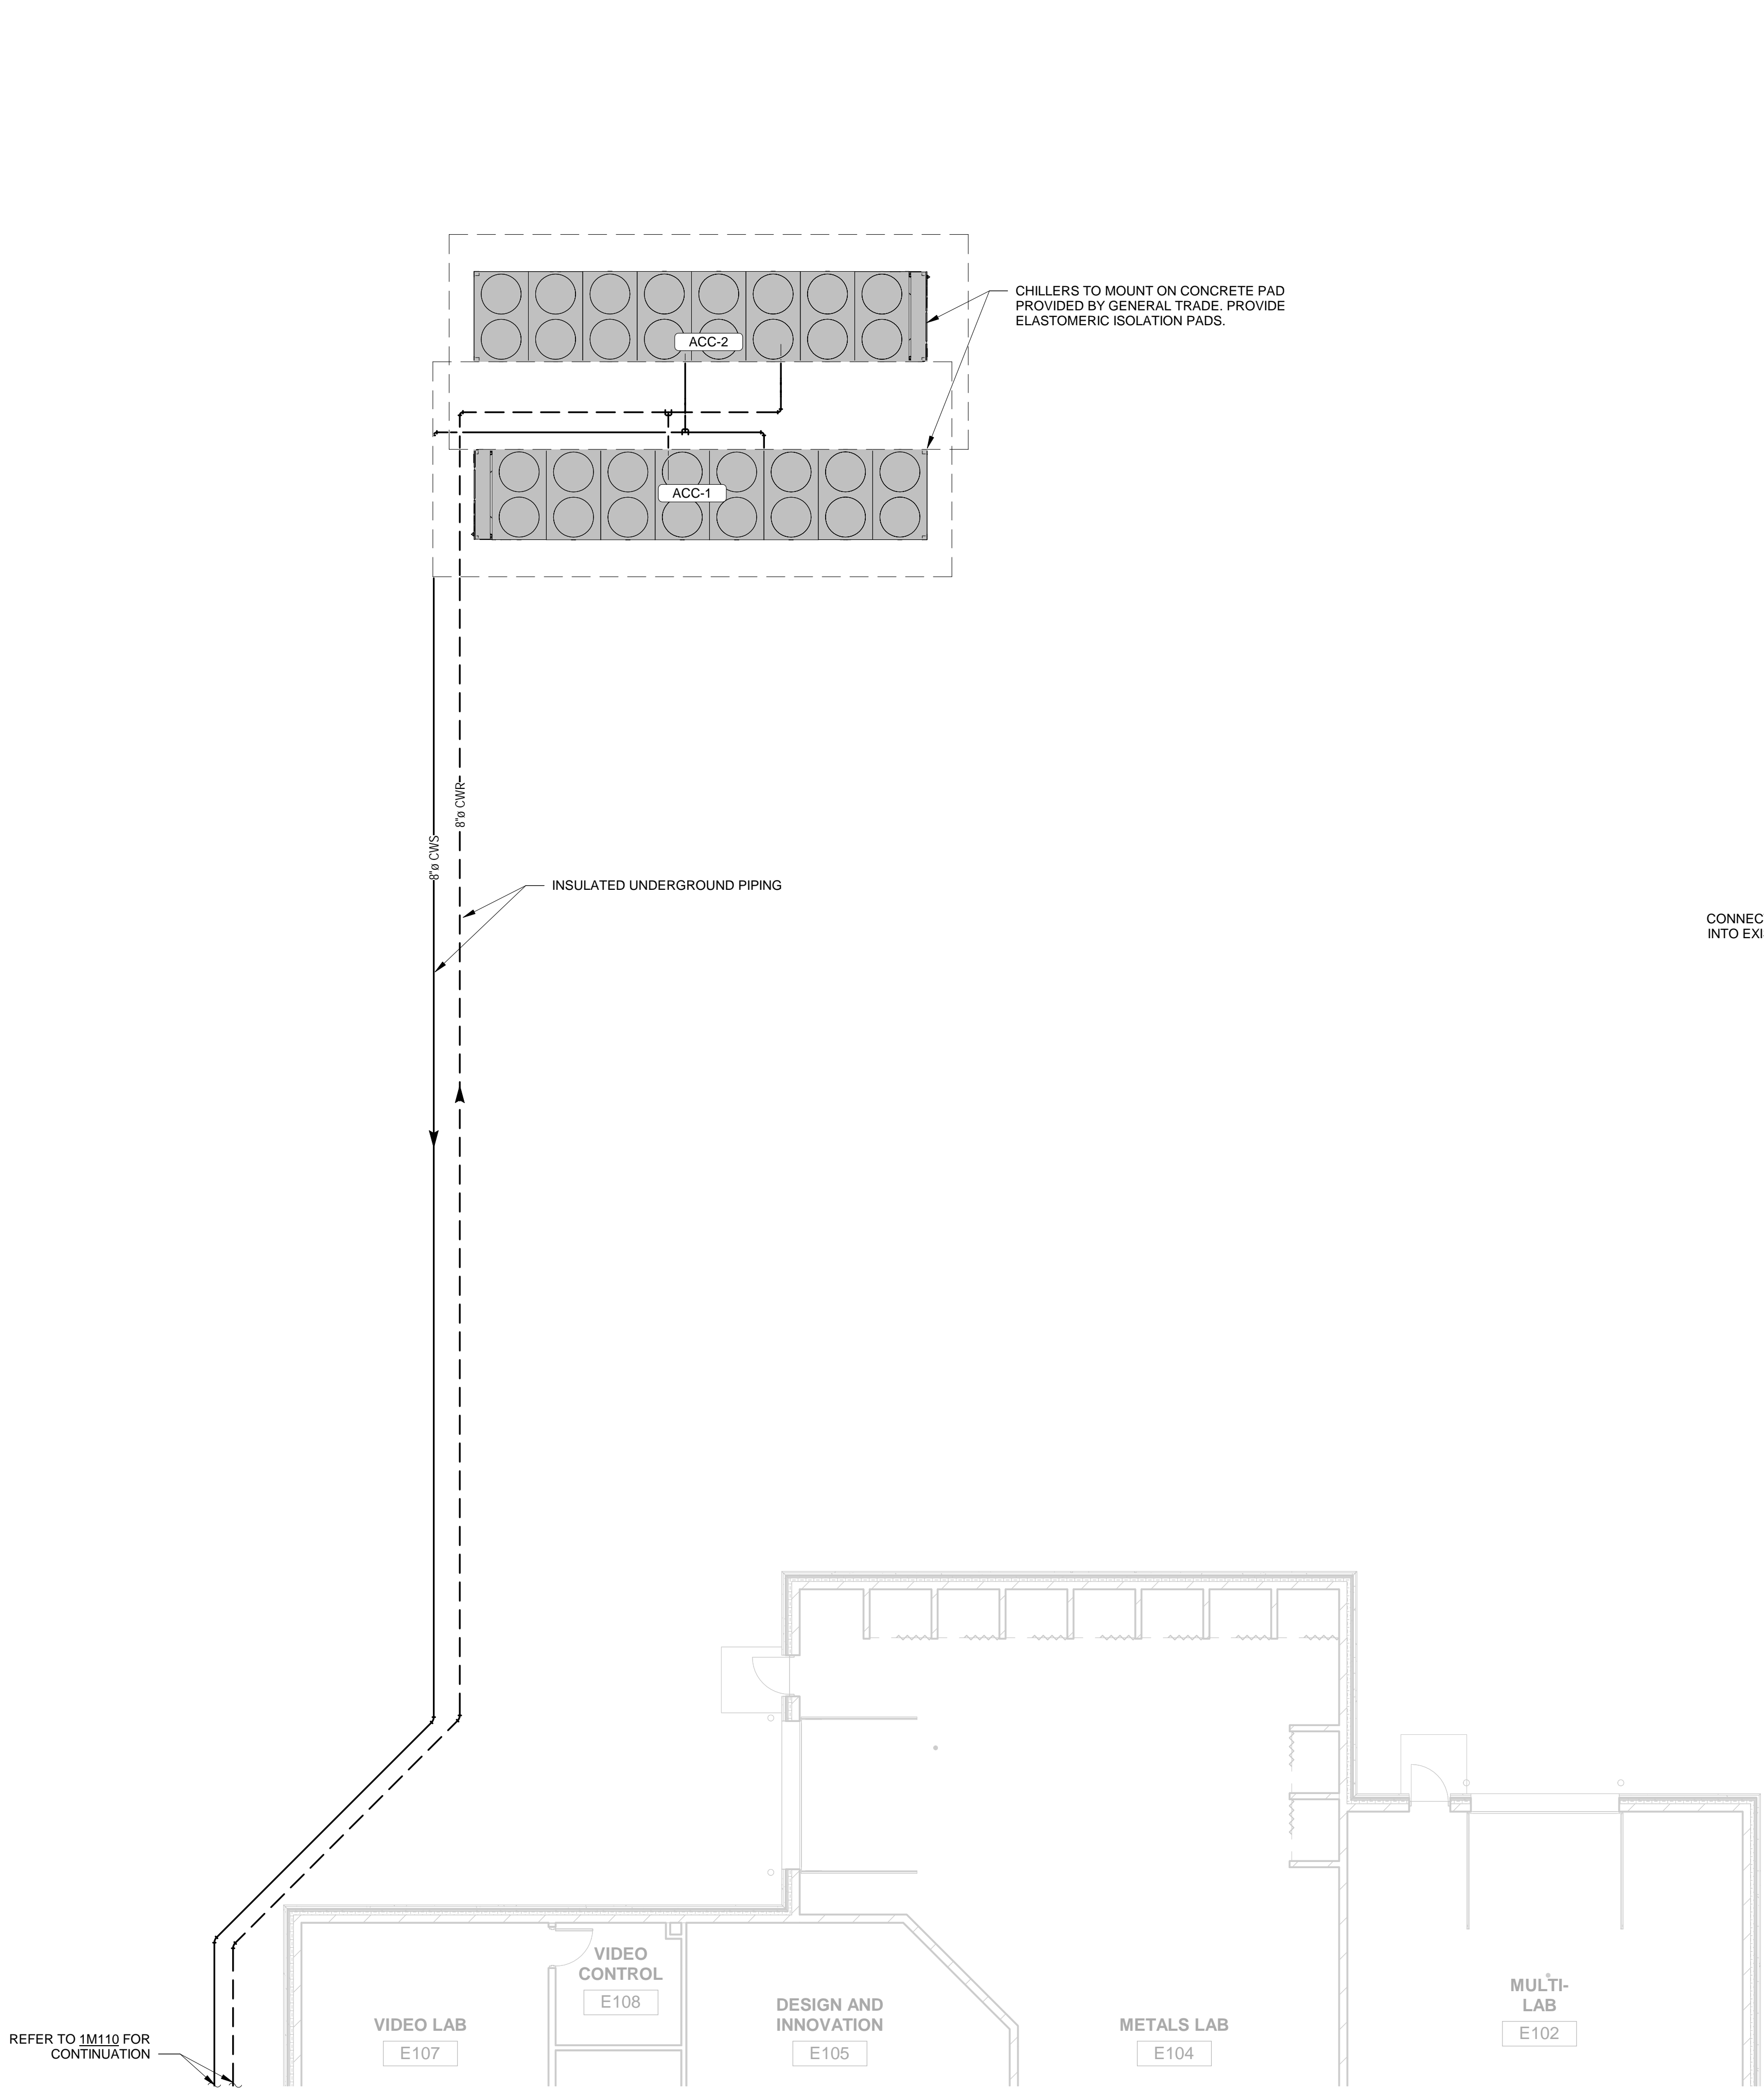

2 SITE PLAN
1/8" = 1'-0"

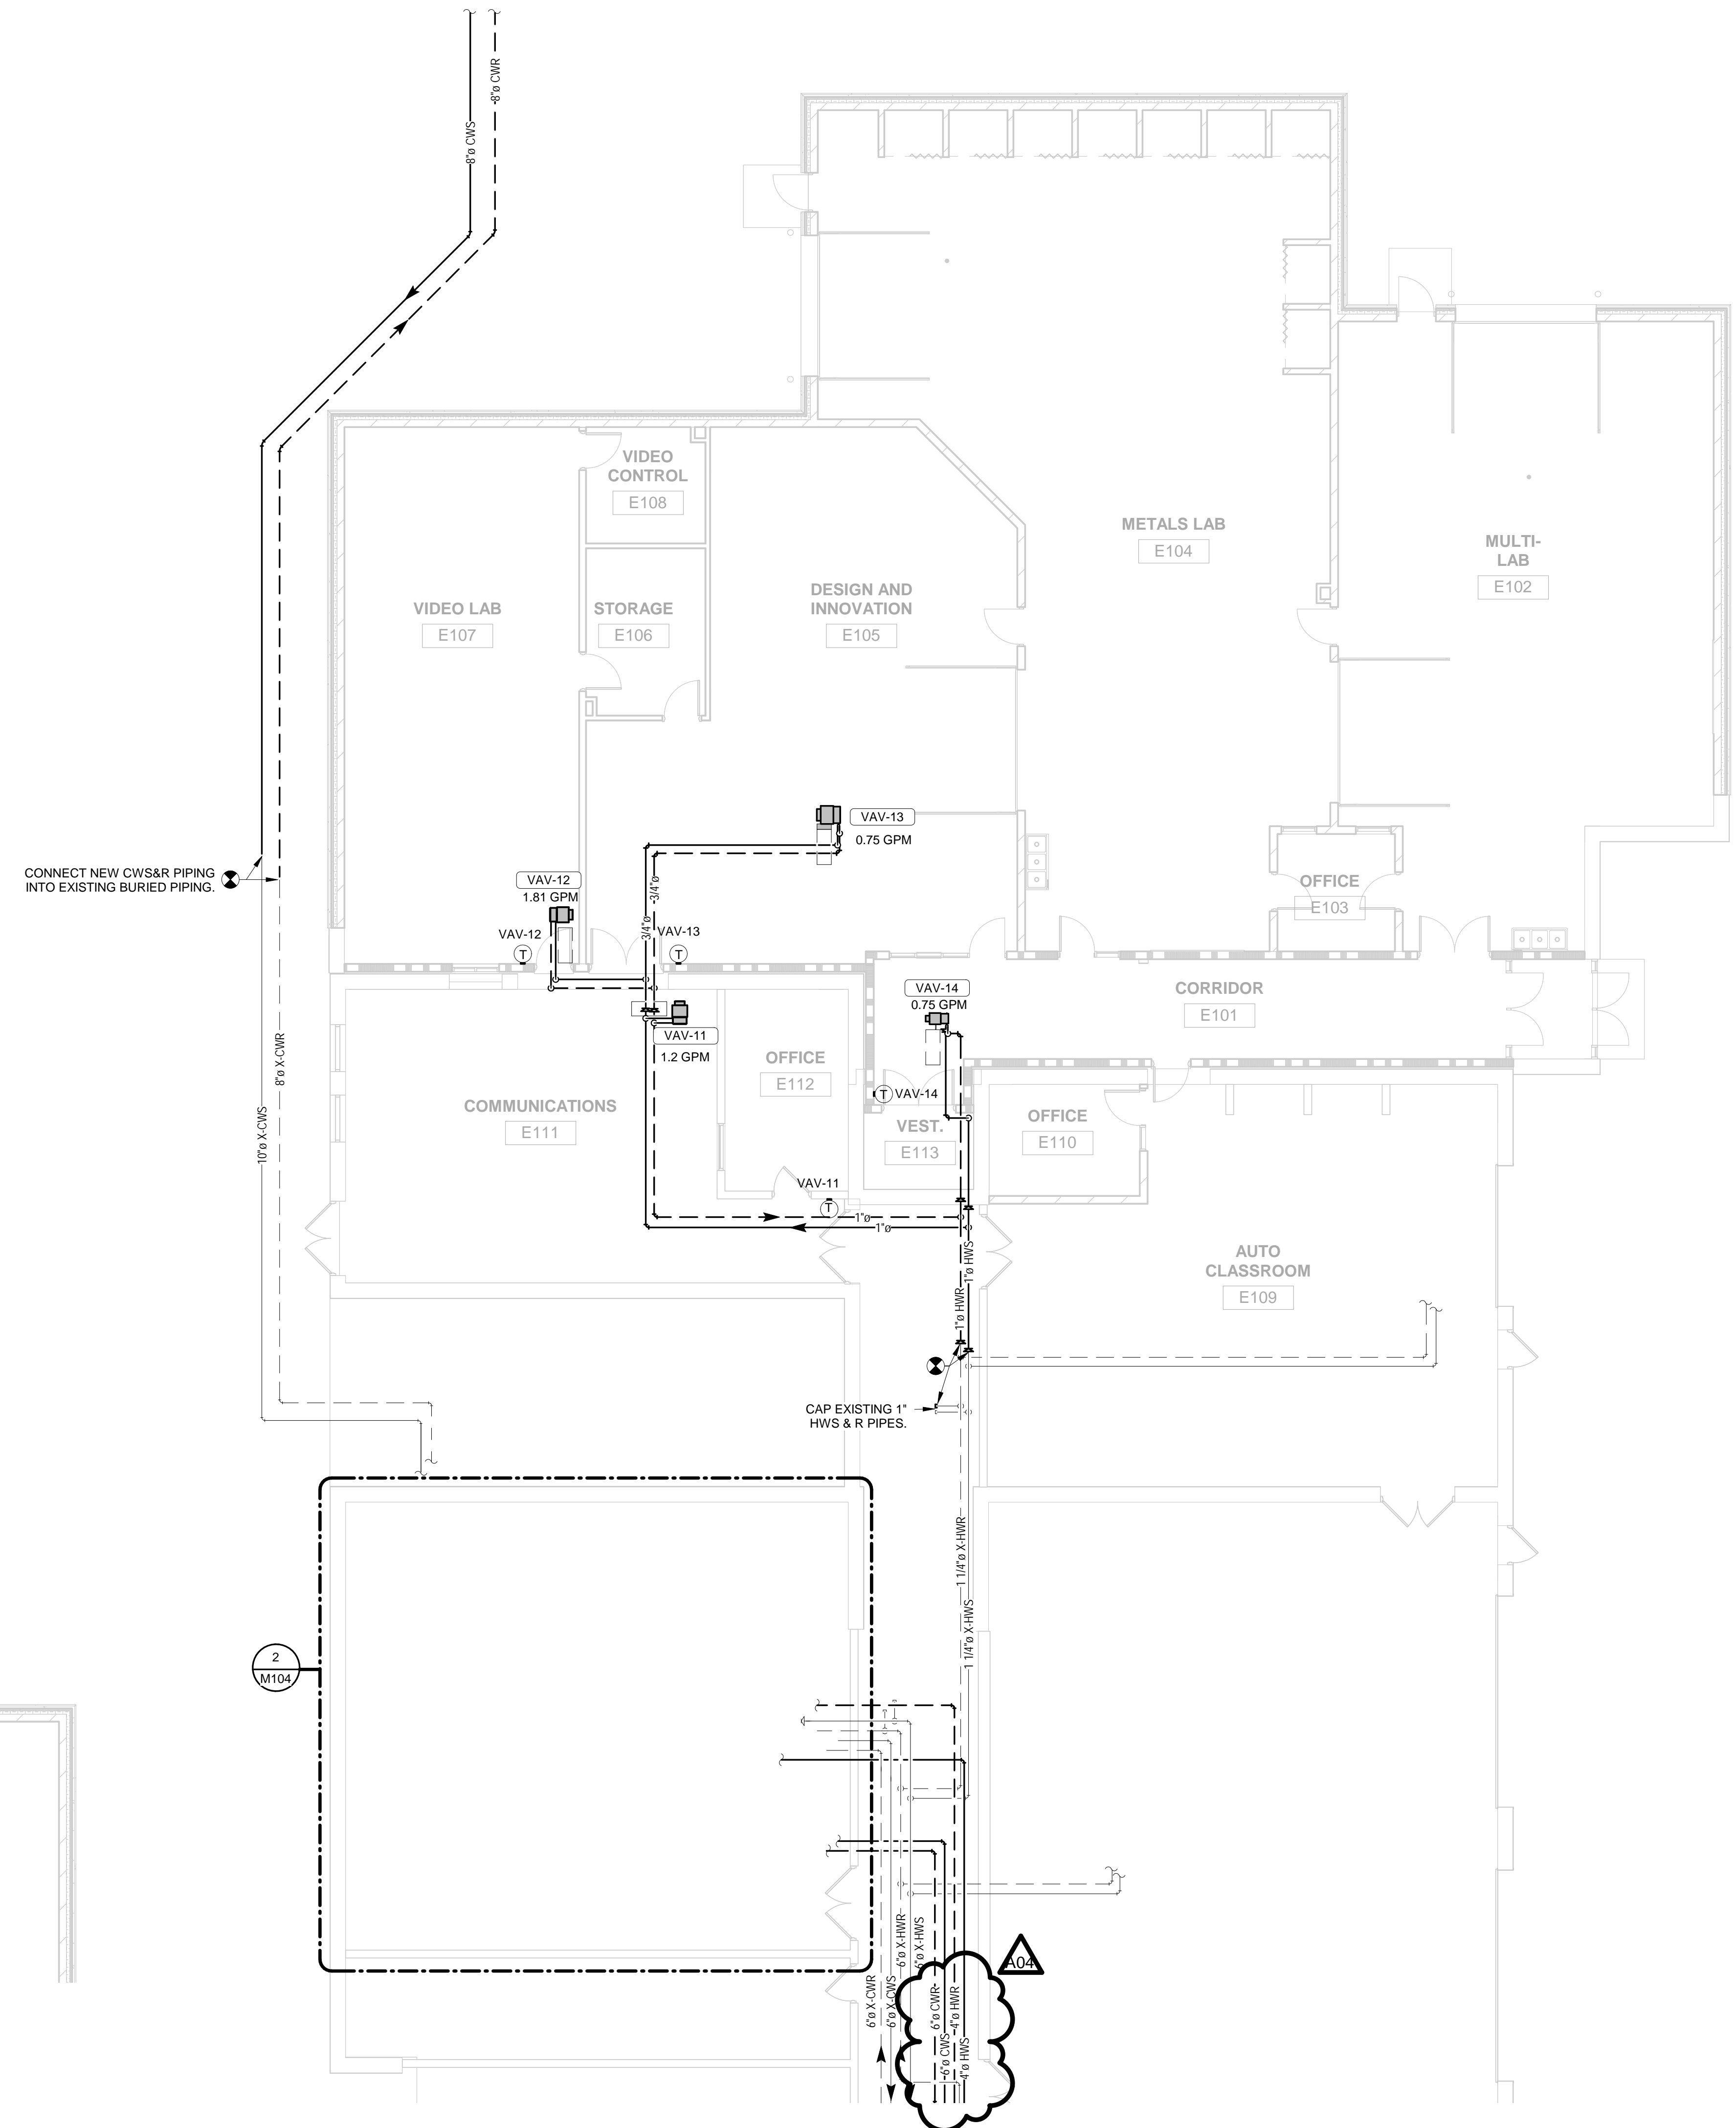

1 MECHANICAL PIPING PLAN - SEG. 'E'
1/8" = 1'-0"



Consultant:

Project Title: **SCHOOL DISTRICT OF HOLMEN
HIGH SCHOOL ADDITION & REMODELING**
Project Location: 1001 McHUGH RD
HOLMEN, WI 54636
Sheet Title: **ELECTRICAL SYSTEMS PLAN**

HSR Project Number: **18061**

Project Date: **MARCH 2019**

Drawn By: **Author**

Key Plan:

No.	Description	Date
A02	Addendum no. 2	7/30/19
A04	Addendum no. 4	8/7/19

Graphic Scale: **VARIES**

Last Update: **8/7/2019 9:37:33 AM**

E502

