

DOCUMENT 00 90 00
ADDENDUM

ADDENDUM NO. [2] Date: August 19, 2019

RE: LANESBORO PUBLIC SCHOOLS
ADDITION AND REMODEL
100 KIRKWOOD ST EAST
LANESBORO, MN 55949
HSR 18063

FROM: HSR Associates, Inc
100 Milwaukee Street
La Crosse, WI 54603
(608) 784-1830

To: Prospective Bidders

This addendum forms a part of the Contract Documents and modifies the original Bidding Documents dated July 2019. Acknowledge receipt of this Addendum in the space provided on the bid form. Failure to do so may subject the Bidder to disqualification.

This Addendum consists of [3] pages, [3] specification sections and [21] 30 x 42 drawings.

CHANGES TO PRIOR ADDENDUM: Addendum 1

1. Item 14: Delete change to 2.03, B. Subfloor thickness shall be 15/32".
2. Sheet A601 DOOR SCHEDULE
 - a. Door 210:
 - i. Change frame material from 'ALUM' to 'STEEL'.
 - ii. Change frame elevation reference from "19A602" to "8A603".
 - iii. Fire rating for door 210 shall be 90 minutes.
3. Prior Approvals: Item 4, a: Change "section" to "type".

CHANGES TO SPECIFICATIONS:

4. Section 08 31 00 ACCESS DOORS AND PANELS
 - a. Section attached hereto as part of Contract Documents.
5. Section 08 45 00 TRANSLUCENT WALL AND ROOF ASSEMBLY
 - a. Skylight shall be comparable to Kalwall, 4 foot s-line, S-420-3A, single slope.
6. Section 09 66 23 RESINOUS MATRIX TERRAZZO FLOORING
 - a. Section attached hereto as part of Contract Documents.
7. Section 09 84 30 SOUND ABSORBING WALL AND CEILING UNITS
 - a. 2.02, A: Described panels apply to AWP 1 & 2 as located on Drawings.
8. Section 12 35 53.19 WOOD LABORATORY CASEWORK
 - a. 2.04, a, 1: Epoxy resin sinks shall be "drop-in" in lieu of under mount.

9. Section 32 32 23 SEGMENTAL RETAINING WALLS
 - a. Section attached hereto as part of Contract Documents.

CHANGES TO DRAWINGS

10. Sheet A104 UPPER LEVEL REMODELED FLOOR PLAN 30 x 42 attached hereto
 - a. Revisions clouded on Drawing.
11. Sheet A112 LOWER LEVEL RCP SEGMENT C
 - a. Revisions clouded on Drawing.
 - b. Exterior metal soffit indicated.
12. Sheet A121 ROOF PLAN SEGMENT C 30 x 42 attached hereto
 - a. Revisions clouded on Drawing.
13. Section A201 ELEVATIONS 30 x 42 attached hereto
 - a. Revisions clouded on Drawing.
14. Sheet A206 INTERIOR ELEVATIONS 30 x 42 attached hereto
 - a. Revisions clouded on Drawing.
15. Sheet A210 CASEWORK ELEVATIONS 30 x 42 attached hereto
 - a. Revisions clouded on Drawing.
16. Sheet A300 BUILDING SECTIONS COMMONS 30 x 42 attached hereto
 - a. Revisions clouded on Drawing.
17. Sheet A304 GYM AREA SECTIONS 30 x 42 attached hereto
 - a. Revisions clouded on Drawing.
18. Sheet A306 WALL SECTIONS 30 x 42 attached hereto
 - a. Revisions clouded on Drawing.
19. Sheet A500 SECTION DETAILS 30 x 42 attached hereto
 - a. Revisions clouded on Drawing.
20. Sheet A501 SECTION DETAILS 30 x 42 attached hereto
 - a. Revisions clouded on Drawing.
21. Sheet A603 INTERIOR FRAME ELEVATIONS 30 x 42 attached hereto
 - a. Revisions clouded on Drawing.
22. Sheet ID101 OVERALL LOWER FLOOR FINISH PLAN 30 x 42 attached hereto
 - a. Revisions clouded on Drawing.
 - b. New flooring for Classroom 167 removed from Project.
23. Sheet ID 102 LOWER LEVEL FINISH PLAN SEGMENT A 30 x 42 attached hereto
 - a. Revisions clouded on Drawing.
 - b. New flooring for Classroom 167 removed from Project.
24. Sheet ID107 UPPER LEVEL FINISH PLAN SEGMENT B 30 x 42 attached hereto
 - a. Revisions clouded on Drawing.
 - b. Area requiring new terrazzo flooring identified.

25. Sheet S001 STRUCTURAL NOTES 30 x 42 attached hereto
 - a. Revisions clouded on Drawing.
 - b. Design wind speed revision
26. Sheet S101 FOUNDATION PLAN – SEGMENT B 30 x 42 attached hereto
 - a. Revisions clouded on Drawing.
 - b. Top of foundation wall revision for brick ledge.
 - c. Section references corrected; 3S801 changed to 2S801. 1S801 changed to 3S801.
27. Sheet S102 FOUNDATION PLAN – SEGMENT C 30 x 42 attached hereto
 - a. Revisions clouded on Drawing.
 - b. Footing and foundation size revised at northwest corner to accommodate exterior grade change.
28. Sheet S121.1 LOW ROOF FRAMING PLAN SEGMENT C 30 x 42 attached hereto
 - a. Revisions clouded on Drawing.
 - b. Horizontal structural support added at window opening.
29. Sheet S800 FOUNDATION DETAILS 30 x 42 attached hereto
 - a. Revisions clouded on Drawing.
30. Sheet S801 FOUNDATION DETAILS 30 x 42 attached hereto
 - a. Revisions clouded on Drawing.
 - b. Retaining wall detail added and reference numbers adjusted.

PRIOR APPROVALS

1. Section 22 30 00 WATER SOFTENERS
 - a. Robert B. Hill Co.: HICAP 0110-2
2. Section 04 20 00 UNIT MASONRY
 - a. Cemstone Supply Co.: Glen-Gery Sandy Creek Velour
3. Section 09 84 30 SOUND-ABSORBING WALL AND CEILING UNITS
 - a. Golden Valley Supply Co.: Golterman & Sabo

END OF DOCUMENT 00 90 00

Page Intentionally Left Blank

SECTION 08 31 00
ACCESS DOORS AND PANELS

PART 1 GENERAL

1.01 SECTION INCLUDES

- A. Wall access door and frame units.

1.02 RELATED REQUIREMENTS

- A. Section 04 20 00 - Unit Masonry: Openings in masonry.
- B. Section 09 91 23 - Interior Painting: Field paint finish.

1.03 SUBMITTALS

- A. See Section 01 30 00 - Administrative Requirements, for submittal procedures.
- B. Product Data: Provide sizes, types, finishes, hardware, scheduled locations, and details of adjoining work.

PART 2 PRODUCTS

2.01 ACCESS DOORS AND PANELS ASSEMBLIES

- A. Fire-Rated Wall-Mounted Units:
 - 1. Location: As indicated on drawings.
 - 2. Wall Fire-Rating: 1-1/2 hour.
 - 3. Material: Steel.
 - 4. Size: As noted on Drawings.
 - 5. Door/Panel: Hinged, standard duty. Insulated double-surface panel, with tool-operated spring or cam lock and no handle.
 - 6. Masonry Mounting Criteria: Provide surface-mounted frame with door surface flush with frame surface.
 - 7. Finish: Primed steel for field finish.

PART 3 EXECUTION

3.01 EXAMINATION

- A. Verify that masonry opening is correctly sized and located.

3.02 INSTALLATION

- A. Install units in accordance with manufacturer's instructions.
- B. Install frames plumb and level in openings, and secure units rigidly in place.
- C. Position units to provide convenient access to concealed equipment when necessary.

END OF SECTION

Page Intentionally Left Blank

SECTION 09 66 23
RESINOUS MATRIX TERRAZZO FLOORING

PART 1 GENERAL

1.01 SECTION INCLUDES

- A. Epoxy matrix terrazzo with ground finish, .
- B. Divider strips.

1.02 RELATED REQUIREMENTS

- A. Section 03 30 00 - Cast-in-Place Concrete: Concrete subfloor with light steel trowel finish.
- B. Section 07 92 00 - Joint Sealants: Sealing joints between terrazzo work and adjacent construction and fixtures.

1.03 REFERENCE STANDARDS

- A. ASTM E1155 - Standard Test Method for Determining F(F) Floor Flatness and F(L) Floor Levelness Numbers; 1996 (Reapproved 2008).
- B. ASTM F710 - Standard Practice for Preparing Concrete Floors to Receive Resilient Flooring; 2011.
- C. ASTM F1869 - Standard Test Method for Measuring Moisture Vapor Emission Rate of Concrete Subfloor Using Anhydrous Calcium Chloride; 2011.
- D. NTMA (GRAD) - Aggregate Gradation Standards; The National Terrazzo and Mosaic Association, Inc; current edition.
- E. NTMA (EPOXY) - Epoxy Terrazzo Specifications; The National Terrazzo and Mosaic Association, Inc; Current Edition located at www.ntma.com.
- F. NTMA (SPECS) - Terrazzo Specifications; The National Terrazzo and Mosaic Association, Inc.; current edition located at www.ntma.com.

1.04 SUBMITTALS

- A. See Section 01 30 00 - Administrative Requirements, for submittal procedures.
- B. Product Data: Provide data for divider strips, control joint strips, expansion joints, and sealer; include printed copy of current NTMA recommendations for type of terrazzo involved and color plates for initial selection.
- C. Shop Drawings: Indicate divider strip, patterns and control joint layout, and details of adjacent components.
- D. Samples: Submit two samples, 6 inch by 6 inch in size illustrating color, chip size and variation, chip gradation, matrix color, and typical divider strip.
- E. Cleaning and Maintenance Data: Include procedures for stain removal, stripping, and sealing.

1.05 QUALITY ASSURANCE

- A. Perform work in accordance with NTMA recommendations as posted at their web site at www.ntma.com.
- B. Installer Qualifications: Company specializing in performing the type of work specified in this section.

1.06 MOCK-UP

- A. Construct mock-up of terrazzo illustrating appearance of finished work in each configuration required. Size mock-up to be not less than 3 by 3 feet.
- B. Locate where directed.
- C. Mock-up may remain as part of the work.

1.07 DELIVERY, STORAGE, AND HANDLING

- A. Store terrazzo materials in a dry, secure area.
- B. Maintain minimum temperature of 60 degrees F.
- C. Keep products away from fire or open flame.

1.08 FIELD CONDITIONS

- A. Do not install terrazzo when temperature is below 50 degrees F or above 90 degrees F.
- B. Maintain temperature within specified range 24 hours before, during, and 72 hours after installation of flooring.
- C. Provide ambient lighting level of 50 ft candles, measured at floor surface.

PART 2 PRODUCTS

2.01 MANUFACTURERS

- A. Basis of Design - Resinous Matrix Terrazzo Flooring: Wisconsin Terrazzo; #3118 E: Final mixture to be verified with A/E.
- B. Other Acceptable Manufacturers - Resinous Matrix Terrazzo Flooring:
 - 1. Key Resin Company; Key Epoxy Terrazzo System: www.keyresin.com/#sle.
 - 2. General Polymers; Terrazzo 1100: www.generalpolymers.com.
 - 3. Crossfield Products Corp., Dex-O-Tex Division: www.crossfieldproducts.com
 - 4. Master Terrazzo Technologies LLC; Morocite: www.masterterrazzo.com
 - 5. TEC Specialty Construction Brands, Inc.; Tuff-Lite Epoxy Terrazzo: www.tecspecialty.com
 - 6. Terrazzo and Marble Supply Companies; Terroxy Resin Systems: www.tmsupply.com
 - 7. Substitutions: See Section 01 60 00 - Product Requirements.

2.02 EPOXY MATRIX TERRAZZO APPLICATIONS

- A. Floors:
 - 1. Thickness: 3/8 inch, nominal.

2.03 MATERIALS

- A. Epoxy Matrix Terrazzo: Aggregate and matrix mix applied to substrate, troweled flat, and ground smooth.
- B. Matrix: Two component resin and epoxy hardener with mineral filler and color pigment, non-volatile, thermo-setting.
- C. Aggregate: Type as indicated; sized in accordance with NTMA aggregate gradation standards; color(s) as indicated, uniform in color.
- D. Finishing Grout: Epoxy, color to match terrazzo matrix.
- E. Epoxy Primer: Two component resin and epoxy hardner, 100% solids.

2.04 ACCESSORIES

- A. Divider Strips: 1/8 inch thick zinc exposed top strip, zinc coated steel concealed bottom strip, with anchoring features.
- B. Control Joint Strips: 1/8 inch nominal width zinc exposed top strips, zinc coated steel concealed bottom strips, 1/8 inch wide neoprene filler strip between vertical strips, with anchoring features.
- C. Divider and Control Joint Strip Height: To suit thickness of terrazzo topping, with allowance for grinding.
- D. Non-Slip Inserts: Provide channel-shaped inserts filled with a mixture of resin and fine, abrasive aggregate.
- E. Cleaner: Neutralizing liquid type, pH of 7.
- F. Sealer: Slip and stain resistant, colorless, non-yellowing, penetrating liquid type to completely seal matrix surface; not detrimental to terrazzo components.
- G. Anchoring Devices
- H. Subfloor Filler: Epoxy aggregate mortar type.
- I. Primer: As recommended by manufacturer.

PART 3 EXECUTION

3.01 EXAMINATION

- A. Verify that sub-floor surfaces are smooth and flat within the tolerances specified for that type of work and are ready to receive terrazzo.
- B. Minimum floor flatness performance at completion of cast-in-place concrete is indicated in Section 03 30 00. Maximum allowable floor flatness tolerances shall be no more than 1/8 inch in 10 feet and 1/16 inch in 24 inches. (Approximate minimum FF 50/FL35 per ASTM E1155) Locations not meeting this standard shall have leveling compound installed. Refer to Division 1 Allowances when applicable.
- C. Verify that new concrete sub-floor surfaces are ready for tile installation by testing for moisture emission rate. Obtain instructions if test results are not within limits recommended by tile manufacturer and setting materials manufacturer. Testing procedures shall be as follows:
 - 1. An independent testing agency will perform field quality control tests, as specified in Section 01 40 00.
 - 2. Test methods shall follow ASTM F 2170-02 Standard Test Method for Determining Relative Humidity in Concrete Floor Slabs Using in situ Probes.
 - 3. Maximum allowable moisture levels for each type of floor finish shall be received from flooring suppliers prior to testing.
 - 4. At floors to receive finish materials, perform three tests for the first 1000 square feet and at least one additional test for each additional 1000 square feet.
 - 5. Select test locations to provide information about moisture distribution across the entire floor slab, especially areas of potential high moisture. For slabs on-grade and below-grade, include a test location within three feet of each exterior wall.
- D. Verify that concrete sub-floor surfaces are ready for terrazzo installation by testing for moisture emission rate and alkalinity per ASTM F1869; obtain instructions if test results are not within the following limits:
 - 1. Moisture Vapor Emission: Not greater than 3 lb per 1000 sq ft per 24 hours, tested according to ASTM F1869.
 - 2. Alkalinity: pH range of 5 to 9, tested according to ASTM F710.
- E. Provide sound concrete surfaces free of laitance, glaze, efflorescence, curing compounds, form-release agents, dust, dirt, grease, oil, and other contaminants incompatible with terrazzo.
 - 1. Shot-blast surfaces with an apparatus that abrades the concrete surface, contains the dispensed shot within the apparatus, and recirculates the shot by vacuum pickup.
 - a. Prepared concrete surface shall have an ICRI profile of 2 or higher (texture similar to 80-100 grit sand paper) and sufficient portland cement paste removed to expose aggregate.
 - 2. Repair damaged and deteriorated concrete according to terrazzo manufacturer's written recommendations.
 - 3. Use patching and fill material to fill holes and depressions in substrates according to terrazzo manufacturer's written instructions.
- F. Verify that required floor-mounted utilities are in correct location.
- G. If grinding is required prior to application protect other work from dust generated by grinding operations. Control dust to prevent air pollution and comply with environmental protection regulations.
 - 1. Erect and maintain temporary enclosures and other suitable methods to limit dust migration and to ensure adequate ambient temperatures and ventilation conditions during installation.

3.02 PREPARATION

- A. Clean substrate of foreign matter.
- B. Apply primer in accordance with manufacturer's instructions.

3.03 INSTALLATION

- A. Install control joint strips straight and flat to locations indicated.
- B. Install divider strips according to pattern approved on shop drawings.
- C. Place terrazzo mix over substrate to thickness indicated.

3.04 APPLICATION - TERRAZZO

- A. Place terrazzo mix over prepared substrate to thickness indicated.

3.05 CURING

- A. Cure terrazzo overnight prior to grinding.
- B. Close area to allow undisturbed curing.

3.06 FINISHING

- A. Finish terrazzo to NTMA requirements.
- B. Produce terrazzo finish surface to match approved mock-up, with 70 percent chip exposed.
- C. Grind terrazzo surfaces with power disc machine; sequence with coarse to fine grit abrasive, using a wet method or using a dry grinder with vacuum to control dust.
- D. Apply grout mix to match mortar over ground surface to fill honeycomb exposed during grinding.
- E. Remove grout residue by grinding, using a fine grit abrasive.

3.07 TOLERANCES

- A. Maximum Variation from Flat Surface: 1/4 inch in 10 feet.
- B. Maximum Variation from Level (Except Surfaces Sloping to Drain): 1/8 inch.

3.08 CLEANING

- A. Scrub and clean terrazzo surfaces with neutral pH cleaner in accordance with manufacturer's instructions. Let dry.
- B. Immediately after terrazzo has dried, apply sealer in accordance with manufacturer's instructions.
- C. Polish surfaces in accordance with manufacturer's instructions.

3.09 PROTECTION

- A. Protect finished terrazzo from damage due to subsequent construction until Date of Substantial Completion.

END OF SECTION

SECTION 32 32 23
SEGMENTAL RETAINING WALLS

PART 1 GENERAL

1.01 SECTION INCLUDES

- A. Shop drawings.
- B. Retaining wall units.
- C. Cap units.
- D. Shear connectors.
- E. Drainage filter.
- F. Aggregate for leveling pad.
- G. Drainage fill.
- H. Reinforced backfill.
- I. Drainage pipe.

1.02 RELATED REQUIREMENTS

- A. Section 33 41 00 - Subdrainage.

1.03 REFERENCE STANDARDS

- A. AASHTO M 288 - Standard Specification for Geosynthetic Specification for Highway Applications; 2017.
- B. ASTM C140/C140M - Standard Test Methods of Sampling and Testing Concrete Masonry Units and Related Units; 2016.
- C. ASTM C920 - Standard Specification for Elastomeric Joint Sealants; 2014a.
- D. ASTM C1372 - Standard Specification for Dry-Cast Segmental Retaining Wall Units; 2017.
- E. ASTM D4595 - Standard Test Method for Tensile Properties of Geotextiles by the Wide-Width Strip Method; 2017.
- F. ASTM D5262 - Standard Test Method for Evaluating the Unconfined Tension Creep and Creep Rupture Behavior of Geosynthetics; 2007 (Reapproved 2016).
- G. ASTM D5818 - Standard Practice for Exposure and Retrieval of Samples to Evaluate Installation Damage of Geosynthetics; 2011.
- H. ASTM D6638 - Standard Test Method for Determining Connection Strength Between Geosynthetic Reinforcement and Segmental Concrete Units (Modular Concrete Blocks); 2018.
- I. ASTM D6916 - Standard Test Method for Determining the Shear Strength Between Segmental Concrete Units (Modular Concrete Blocks); 2018.
- J. ASTM D698 - Standard Test Methods for Laboratory Compaction Characteristics of Soil Using Standard Effort (12,400 ft-lbf/ft³ (600 kN-m/m³)); 2012, with Editorial Revision (2015).
- K. ASTM D1241 - Standard Specification for Materials for Soil-Aggregate Subbase, Base, and Surface Courses; 2015.
- L. ASTM D2487 - Standard Practice for Classification of Soils for Engineering Purposes (Unified Soil Classification System); 2011.
- M. ASTM D4318 - Standard Test Methods for Liquid Limit, Plastic Limit, and Plasticity Index of Soils; 2017.
- N. ASTM D4491 - Standard Test Methods for Water Permeability of Geotextiles by Permittivity; 1999a (Reapproved 2014).
- O. ASTM D4751 - Standard Test Method for Determining Apparent Opening Size of a Geotextile; 2016.
- P. ASTM D5321/D5321M - Standard Test Method for Determining the Shear Strength of Soil-Geosynthetic and Geosynthetic-Geosynthetic Interfaces by Direct Shear; 2017.
- Q. ASTM D7928 - Standard Test Method for Particle-Size Distribution (Gradation) of Fine-Grained Soils Using the Sedimentation (Hydrometer) Analysis; 2017.
- R. NCMA TR-127 - Design Manual for Segmental Retaining Walls; 2010, Third Edition.

1.04 SUBMITTALS

- A. See Section 01 30 00 - Administrative Requirements, for submittal procedures.
- B. Segmental Retaining Wall Units:
 - 1. Manufacturer's product data.
 - 2. Test data on freeze-thaw durability per ASTM C1372.
 - 3. Test data on unit strength and shear resistance between units.
 - 4. Test data on soil reinforcement connection.
 - 5. Manufacturer's certification that units meet requirements of specification.
 - 6. Storage and handling requirements and recommendations.
 - 7. Installation methods.
- C. Shop Drawings: Engineering drawings for installation, including elevations, large-scale details of elevations, typical sections, details, and connections, soil reinforcement, and drainage provisions.
 - 1. Include marked up contract drawings showing exact dimensions for blocks, required coping, and other minor revisions.
 - 2. Design Data: Submit detailed design calculations showing compliance with specified design criteria and material evaluations performed in accordance with specified design standard, signed and sealed by Design Engineer.
- D. Design Engineer's Qualification Statement.
- E. Concrete Unit Manufacturer Qualification Statement.
- F. Installer Qualification Statement.

1.05 QUALITY ASSURANCE

- A. Design Engineer Qualifications: Provide design by or under direct supervision of Professional Engineer experienced in the work of this section and licensed in the State in which the Project is located and:
 - 1. Having minimum of five years documented experience in design of reinforced soil structures.
- B. Manufacturer Qualifications -- Concrete Units: Firm specializing in manufacturing products specified in this section and:
 - 1. With not less than 2 years experience.
- C. Installer Qualifications: Firm specializing in design and installation of segmental retaining walls and:
 - 1. With not less than 2 years documented experience.
 - 2. With a minimum of five previously constructed successful projects, similar in size and magnitude, using specified retaining wall system; provide contact names and numbers.
 - 3. Having site supervisor with verifiable qualified experience suitable for this project.
 - 4. Approved by retaining wall system manufacturer.
- D. Preconstruction Soil Testing: Engage a qualified independent testing agency to test soil reinforcement and backfill materials for compliance with design criteria.
 - 1. Testing Agency Qualifications: As specified in Section 01 40 00.

1.06 DELIVERY, STORAGE, AND HANDLING

- A. Store products above ground on wood pallets or blocking, in manufacturer's unopened packaging, until ready for installation.
- B. Prevent excessive soil and mud from coming in contact with face of concrete units.
- C. Protect material from damage. Do not use damaged material. Remove damaged material from the site.
- D. Store and dispose of solvent-based materials, and materials used with solvent-based materials, in accordance with requirements of local authorities having jurisdiction.

1.07 WARRANTY

- A. See Section 01 78 00 - Closeout Submittals, for additional warranty requirements.
- B. Correct defective Work within a one year period after Date of Substantial Completion.
- C. Provide five year manufacturer warranty for Segmental Retaining Wall.

PART 2 PRODUCTS

2.01 MANUFACTURERS

- A. Segmental Retaining Walls:
 - 1. Anchor Wall Systems, Inc; Sterling Wall System: www.anchorwall.com/#sle.
 - 2. Keystone Retaining Wall Systems LLC; Keystone Standard, Tri-Plane: www.keystonewalls.com/#sle.
 - 3. Rockwood Retaining Walls; Sapphire 6 & 8: www.rockwoodwalls.com/#sle.
 - 4. Substitutions: See Section 01 60 00 - Product Requirements.

2.02 RETAINING WALLS

- A. Contractor is responsible for design of the retaining walls.
- B. Design Standard: Design retaining walls to be capable of withstanding the effects of gravity loads due to soil pressures resulting from grades indicated, determined in accordance with:
 - 1. In addition, comply with applicable local, state, and federal codes and regulations.
 - 2. This design method considers potential failure modes categorized by external, internal, local, compound, and global stability.
 - 3. Provide engineering services as required for analysis for all modes of stability.
 - 4. Use of design software for calculations is permitted.
 - 5. Submit complete shop drawings showing all features of the design.
- C. Mass (Weight) Per Wall Face Area: 35 pounds per square foot, minimum, including filled voids.
- D. Shear Resistance: Design the wall not to exceed the capacity of materials and soils to resist shear:
 - 1. Shear Resistance Between Units: Determine in accordance with ASTM D6916.
 - 2. Connection Between Units and Soil Reinforcement: Determine in accordance with ASTM D6638. Strength shall exceed the maximum tensile force with a Factor of Safety of 1.5.
 - 3. Coefficient for Direct Shear of Reinforcement on Soil: Determine in accordance with ASTM D5321/D5321M using soil similar in gradation and texture to that to be used for fill in the reinforced zone.
- E. Soil Reinforcement:
 - 1. Test reinforcement to be used in accordance with ASTM D6706 using soil taken from project site.
 - 2. Do not use more than one type of reinforcement attached to units within the same wall; do not use products made by different manufacturers in the same wall; minimize the number of different reinforcement and filter products to avoid confusion in placement.
 - 3. Walls Less Than 12 feet High: Use only one type of reinforcement of one grade and strength.
 - 4. Long Term Design Strength of Reinforcement: $LTDS = Tult / (RFd \times RFid \times RFcr)$, where:
 - a. Tult = Ultimate (tensile) strength per ASTM D4595.
 - b. RFd = Reduction Factor for chemical and biological durability; minimum 2.0 if durability testing has not been conducted, otherwise 1.1 for High-density polyethylene. (HDPE), and 1.1 for polyethylene terephthalate (PET).
 - c. RFid = Reduction Factor for Installation Damage; minimum 1.1 and 3.0 if testing per ASTM D5818 has not been conducted.
 - d. RFcr = Reduction Factor for Creep; consistent with test procedure used for determining the ultimate strength per ASTM D5262.
 - e. The product $RFd \times RFid \times RFcr$ shall be greater than 2.0.
- F. Drainage: Design to prevent water accumulation in retained soil; use drainage fill and drainage pipe as specified in this Section ; provide outlet down-grade from west end of north wall.
- G. Minimum Factor of Safety: Design with the following stability requirements:
 - 1. Sliding = 1.5.
 - 2. Pullout = 1.5.
 - 3. Tensile Overstress = 1.5.
 - 4. Overturning = 2.0.
 - 5. Bearing Capacity = 2.0.

2.03 MATERIALS

- A. Retaining Wall Units: Machine-formed concrete blocks of shapes and sizes suitable for the retaining wall configuration required and complying with ASTM C1372 and the following:
 - 1. Face Color: Tan.
 - 2. Texture: Split face, on exposed surfaces.
 - 3. Shear Resistance Mechanism: Manufacturer's standard.
 - 4. Moisture Absorption: 8 percent, maximum.
 - 5. Freeze-Thaw Resistance: Maximum of 1 percent or less weight loss after 100 cycles for each of 5 specimens or maximum of 1.5 percent or less weight loss after 150 cycles for 4 of 5 specimens, when tested in accordance with ASTM C1262.
 - 6. Compressive Strength, 28 Day: 3000 pounds per square inch, minimum in accordance with ASTM C140/C140M.
 - 7. Concrete Density: 125 pounds per cubic foot, minimum, oven dry.
 - 8. Dimensional Tolerances: Plus/minus 1/16 inch from specified dimension.
 - 9. Appearance: No visible chips, cracks, or other imperfections when viewed from 10 feet under diffuse lighting.
- B. Cap Units: Portland cement concrete machine-formed solid blocks, matching segmental retaining wall units, complying with ASTM C1372, with abutting edges saw cut or formed to provide tight fitting, flush end-to-end joints.
 - 1. Height: 4 inches, minimum.
 - 2. Depth: To fully cover wall units.
 - 3. Masonry Adhesive: To secure cap units as top course of wall.
 - a. Expected Life Span: 30 years.
 - b. Provide adhesive conforming to ASTM C920, Type S, Grade NS, Class 25, and as approved by unit manufacturer.
- C. Shear Connectors: Connection method to withstand design stresses and prevent movement of segmental retaining wall units, and to hold soil reinforcement in proper design position during grid pre-tensioning and backfilling.
 - 1. Flexural Strength: 128,000 pounds per square inch, minimum, determined in accordance with ASTM D6638.
 - 2. Short Beam Shear: 6,400 pounds per square inch, minimum, determined in accordance with ASTM D6638.
 - 3. Maintain strength over design temperature range of minus 10 degrees F to plus 100 degrees F.
- D. Drainage Filter: Geosynthetic textile.
 - 1. Apparent Opening Size: 70 to 100 U.S. Sieve size, when tested in accordance with ASTM D4751.
 - 2. Permittivity: 0.5 per second, minimum, when tested in accordance with ASTM D4491.
 - 3. Durability: Comply with minimum requirements of AASHTO M 288 Class 1; minimum mass of 8 ounces per square yard.
- E. Aggregate for Leveling Pad: Compacted sand, gravel, or crushed rock complying with one of the following:
 - 1. Meeting requirements of ASTM D1241, Gradation C.
 - 2. Do not use pea gravel.
- F. Drainage Fill: Clean, freely draining aggregate placed within, between, or immediately behind segmental retaining wall units; do not use pea gravel; use one of the following:
 - 1. Aggregate meeting requirements of ASTM D448, Size No. 57.
 - 2. Crushed stone or coarse gravel, 3/8 inch; no more than 5 percent passing No. 200 sieve.
 - 3. Crushed stone or coarse gravel, meeting requirements of ASTM D7928.
- G. Reinforced Backfill: Compacted soil placed behind drainage fill within reinforced soil mass; do not use heavy clay or organic soils; comply with one of the following:
 - 1. Use site-excavated or other soil approved by Testing Agency.
 - 2. Granular soil with less than 35 percent passing No. 200 sieve per ASTM D7928.

3. Inorganic ASTM D2487 soil types GP, GW, SP, or SM, free of debris.
 - a. Maximum Size: 3/4 inch, unless approved by Design Engineer, and design strength reduced to account for additional installation damage.
 - b. Plasticity of Fines: Less than 10. Liquid Limit: Less than 40, when tested in accordance with ASTM D4318.
- H. Drainage Pipe: 4 inch Perforated schedule 40 PVC, complying with ASTM D3034; or corrugated HDPE complying with ASTM F405; with geotextile filter wrap.

PART 3 EXECUTION

3.01 EXAMINATION

- A. Verify location of existing structures and utilities prior to excavation.
- B. Protect adjacent structures from the effects of excavation.
- C. Verify that layout dimensions are correct and substrate is in proper condition for installation.
- D. Notify Architect of unsatisfactory conditions.
- E. Do not proceed with installation until unsatisfactory conditions have been corrected.

3.02 PREPARATION

- A. Excavation:
 1. Excavate to lines and grades indicated on drawings.
 2. Do not disturb embankment or foundation beyond lines. Minimize over-excavation; fill over-excavated areas with compacted reinforced backfill or leveling pad material at Contractor's expense.
 3. After excavation, and prior to placement of leveling materials, Geotechnical Engineer will examine bearing soil surface to verify strength meets or exceeds design requirements and assumptions.
 4. Replace unsuitable bearing soil as directed by Architect.
 5. Provide means of controlling surface water away from excavation during construction.
- B. Leveling Pad:
 1. Depth: 6 inches, minimum or as required by design.
 2. Width: 6 inches minimum extension beyond front and back faces of units.
 3. In lieu of pad made solely of aggregate or concrete, pad may be 3 inches, minimum, of thick compacted sand or crushed rock, covered with 2 inches to 3 inches of unreinforced concrete.
 4. Location: Top of pad at 1 inch below grade for each 8 inches that wall extends above grade.
 5. Compact aggregate to lines and grades on drawings, in lifts 6 inches thick, maximum.
 6. Compact aggregate to a minimum of 95 percent standard Proctor density, when determined in accordance with ASTM D698 at moisture content within 2 percent of optimum.
 7. Use only hand-operated compaction equipment within 36 inches of back of wall.
- C. Verify level grade before proceeding.
- D. Install drainage collection pipe with a continuous fall in the direction of flow. Cap open ends as necessary to prevent soil and debris from entering.

3.03 INSTALLATION

- A. Install in accordance with drawings, manufacturer instructions, and applicable codes and regulations.
- B. Segmental Retaining Wall Units:
 1. Place first course of units on leveling pad; check alignment and level. Check for full contact with base and for stability.
 2. Place units side by side for full length of wall, aligning back face of straight walls using string line or offset from base line.
 3. Do not leave gaps between units.
 4. Lay out corners in accordance with manufacturer's instructions. Do not leave gaps to produce wall batter or curvature.
 5. Cut blocks with saw; do not split units.
 6. Sweep excess material from tops of units before laying succeeding courses.
 7. Place a maximum of 2 succeeding courses above level backfill. Check for proper alignment and batter.

8. Where top of wall changes elevation, step units to match grade or turn top course into embankment.
 9. Where bottom of wall changes elevation, step base leveling pad and extend lowest course a minimum of two units into slope.
 10. Install shear connectors per manufacturer recommendations.
- C. Soil Reinforcement: Install each layer on fully compacted fill.
1. Orient soil reinforcement material with highest strength axis perpendicular to wall alignment.
 2. Attach to top of wall units and extend horizontally, full length, over compacted backfill slightly sloping downward away from wall.
 3. Install in one piece lengths with 100 percent coverage in each layer at each level. Do not splice or leave gaps between panels or ends of pieces.
 4. Pull taut and remove slack prior to backfill placement.
- D. Drainage Fill: Place drainage fill in, between, and behind units.
1. Compact to lines and grades on drawings, in lifts 6 inches thick, maximum; decrease lift thickness where necessary to achieve required density.
 2. Extend drainage fill 6 inches beyond back face of units.
 3. Base of drainage fill elevation shall not exceed two courses or 16 inches from base of wall units.
- E. Backfill: Place, spread, and compact backfill from behind drainage fill to undisturbed soil while minimizing the development of slack in the soil reinforcement.
1. Use only lightweight hand-operated compaction equipment within 3 feet from back wall face, or one half of wall height, whichever is greater.
 2. Place backfill in lifts of maximum 6 inches to 8 inches loose thickness where hand compaction is used and 8 inches to 10 inches where heavy compaction equipment is used.
 3. Compact backfill to 95 percent maximum density and upper 2 feet of backfill to 98 percent maximum density, standard Proctor, as determined in accordance with ASTM D698, or as recommended by Geotechnical Engineer.
 4. Moisture content of backfill prior to and during compaction to be within plus or minus 2 percentage points dry of optimum and uniform throughout each layer.
 5. Do not operate tracked construction equipment directly upon soil reinforcement. Maintain a minimum fill thickness of 6 inches for operation of tracked vehicles over soil reinforcement. Minimize turning of tracked vehicles while over soil reinforcement.
 6. Operate wheeled equipment at speeds less than 10 miles per hour over soil reinforcement.
 7. Prevent contamination of the filter fabric, unit fill, blanket drains, chimney drains, and/or drainage composite from poor drainage materials such as fine grained silt and clay.
- F. Cap Units: Install with masonry adhesive.
1. Verify in-place top of wall elevation prior to installation of cap units and adjust accordingly.
 2. Clear cap units and top course of segmental retaining wall units of debris and standing water before applying adhesive.
 3. Apply masonry adhesive to top surface of top unit and place cap into position over projecting pins. Protect wall face from masonry adhesive.
- G. Site Drainage:
1. At end of each day:
 - a. Grade backfill a minimum of 2 percent away from wall to prevent runoff from adjacent areas from entering wall site and to prevent ponding at the wall.
 - b. Construct a berm at the crest of the wall to prevent surface water from overtopping.
 2. At completion, if other work adjacent to wall is not to be done immediately (paving, landscaping, etc), grade top of backfill and provide temporary drainage to prevent water runoff toward the wall.
 3. Surface water control and groundwater seepage shall be the responsibility of the project Architect.

3.04 FIELD QUALITY CONTROL

- A. See Section 01 40 00 - Quality Requirements, for additional requirements.
- B. Provide manufacturer's field representative to observe and inspect concrete units.

- C. Observe and inspect:
 - 1. Concrete units: For correct type, for quality installation with courses that are level and follow the designed batter ratio.
 - 2. Soil backfill: For correct type, for specified compaction with level grading prior to reinforcement installation.
 - 3. Soil reinforcement: For correct type, for solid connection to concrete units, and for smooth and taut installation.
 - 4. Field location in plan and elevation.
- D. General Contractor will engage inspection and testing services, including independent laboratories, to provide quality assurance and testing services during construction. Contractor will secure necessary construction control testing during construction.
- E. Correct work found deficient and not in accordance with drawings and specifications.

3.05 CLEANING

- A. Clean wall face to remove debris and stains.
- B. Leave adjacent paved areas broom clean.

3.06 PROTECTION

- A. Prevent damage to wall and earthwork by subsequent construction and uncontrolled runoff until substantial completion; repair damage due to failure to protect wall or earthwork.
- B. Do not operate equipment with wheel loads in excess of 150 pounds per square foot live load within 10 feet from the wall face.
- C. Do not place temporary soil or fill stockpiles adjacent to wall.

END OF SECTION

Page Intentionally Left Blank



Consultant:

ENGINEER CERTIFICATION
I hereby certify that this Plan, Specification or Report was prepared by me or under my direct supervision and that I am a duly licensed Engineer under the laws of the state of Minnesota.
Date: July 9, 2019
Lic. No.: 56867

ARCHITECT CERTIFICATION
I hereby certify that this Plan, Specification or Report was prepared by me or under my direct supervision and that I am a duly licensed Architect under the laws of the state of Minnesota.
Date: July 9, 2019
Lic. No.: 56867

UPPER LEVEL REMODELED FLOOR PLAN - SEG B

GENERAL NOTES:

- SEE ID SHEETS FOR FLOOR AND WALL FINISH LAYOUTS.
- LOOSE FURNISHINGS EXCEPT AS NOTED SHALL BE PROVIDED AND INSTALLED BY THE OWNER.
- VERIFY EXACT SIZE AND LOCATION OF ALL MECHANICAL, PLUMB AND ELEC. OPENINGS - GENERAL CONTRACTOR SHALL BE RESPONSIBLE FOR FINISH AT ALL VISIBLE AREAS. ALL OPENING SHALL BE SEALED AFTER UTILITY INSTALLATION.
- PAINT ALL EXPOSED STEEL LINTELS.
- SEE STRUCTURAL FOR SLAB CONTROL JOINTS.
- SEE A510 FOR WALL CONTROL JOINT DETAILS. SEE PLANS AND ELEVATIONS FOR C/J LOCATIONS. C/J = CONTROL JOINTS.
- REFER TO OVERALL PLANS FOR FIRE RATING LOCATIONS AND ACCESSIBILITY ROUTES.
- EXTEND ALL WALLS TO DECK UNLESS NOTED OTHERWISE. SEE A600 FOR TOP OF WALL DETAILS.
- UNLESS NOTED OTHERWISE RESTROOM FLOORS SHALL BE SLOPED A MIN. 1/16" TO FLOOR DRAINS - TO "CENTER", IF NO FLOOR DRAINS.
- FIXED EQUIPMENT IS SHOWN ON THIS PLAN FOR COORDINATION. SEE SHEETS A304-304 FOR ALL EQUIPMENT NOTES.
- SEE A500 FOR TYPICAL HEAD FLASHING AND THROUGH-WALL FLASHING ISOMETRIC DETAILS.
- GEN. CONTRACTOR TO PROVIDE CONC. EQUIP. PADS/CURBS AS REQUIRED FOR MECHANICAL EQUIP. - VERIFY SIZE/PROFILE/LOCATION WITH MECHANICAL.
- ALL DOORS TO BE LOCATED 4" FROM WALL AT HINGE UNLESS NOTED OTHERWISE.

LEGEND:

(A) SYMBOL INDICATES WALL TYPE - SEE SHEET A600 FOR WALL TYPE DETAILS.

(A) SYMBOL INDICATES WINDOW TYPE - SEE SHEET A601 FOR WINDOW FRAME ELEVATIONS.


(A) SYMBOL INDICATES CONSTRUCTION NOTE THIS SHEET

1 HOUR WALL

2 HOUR WALL

KEY NOTES PLAN

- PATCH AND PREP FLOOR AS REQUIRED FOR NEW FLOOR FINISH - SEE ID SHEETS
- CONCRETE STEEP - SEE STRUCTURAL
- 3'-6" HIGH WALL WITH SOLID SURFACE CAP
- SEE ROOM 108 FOR CASEWORK ELEVATION TAG
- BUILDING OUTLINE ABOVE
- MOP BASH - SEE PLUMBING
- NEW PLUMBING FIXTURE - SEE PLUMBING
- PATCH WALL TO MATCH ADJACENT FINISH
- INDOOR PLAY AREA EQUIPMENT AND PADDED FLOORING BY OTHERS
- REPLACE DOOR SLAB AND HARDWARE
- LADDER TO BE INSTALLED FOR EGRESS
- VENDING MACHINES (N.I.C.)
- DRINKING FOUNTAIN HIGH - LOW - SEE PLUMBING
- ROOF TOP MECHANICAL EQUIPMENT - SEE MECH
- SOLID SURFACE SILL
- 42" GUARDRAIL
- MECHANICAL PIPING TO ROOF - SEE MECH
- GALVANIZED GRATE OVER AREA WELL
- MECHANICAL AREA WELL - SEE STRUCTURAL
- REMOVE MECHANICAL EQUIPMENT AND CONCRETE PAD - SEE MECH AND CIVIL
- NEW HOLLOW METAL DOOR AND FRAME - SEE DOOR SCHEDULE
- EXISTING CONCESSION OPENING AND O.H. DOOR
- LADDER TO BE INSTALLED FOR ROOF ACCESS
- ANODIZED HSS TO MATCH MILLION COLOR - SEE STRUCT FOR DETAIL
- WOOD TOP BENCH WITH WALL MOUNTED BRACKETS 5' O.C. MAX.
- NEW CONCRETE SLAB AS REQUIRED TO INSTALL NEW FOOTINGS - SEE STRUCTURAL
- REPLACE DOOR HARDWARE - SEE DOOR SCHEDULE
- INFILL OPENING WITH CMU BLOCKING
- PARTIAL HEIGHT WALLS (6'-0" WALLS)
- METAL MESH RAILING
- EXTENTS OF PRECAST PLANT AND CONCRETE TOPPING
- RAIN LEADER - SEE PLUMBING
- FILL OPENING, STAKE MORTAR JOINTS FLUSH AND PARGE BLOCK SURFACE SMOOTH FOR INTERIOR AND EXTERIOR
- NEW O.H. DOOR - SEE DOOR SCHEDULE
- WATER METER - SEE PLUMBING
- EYE WASH - SEE PLUMBING

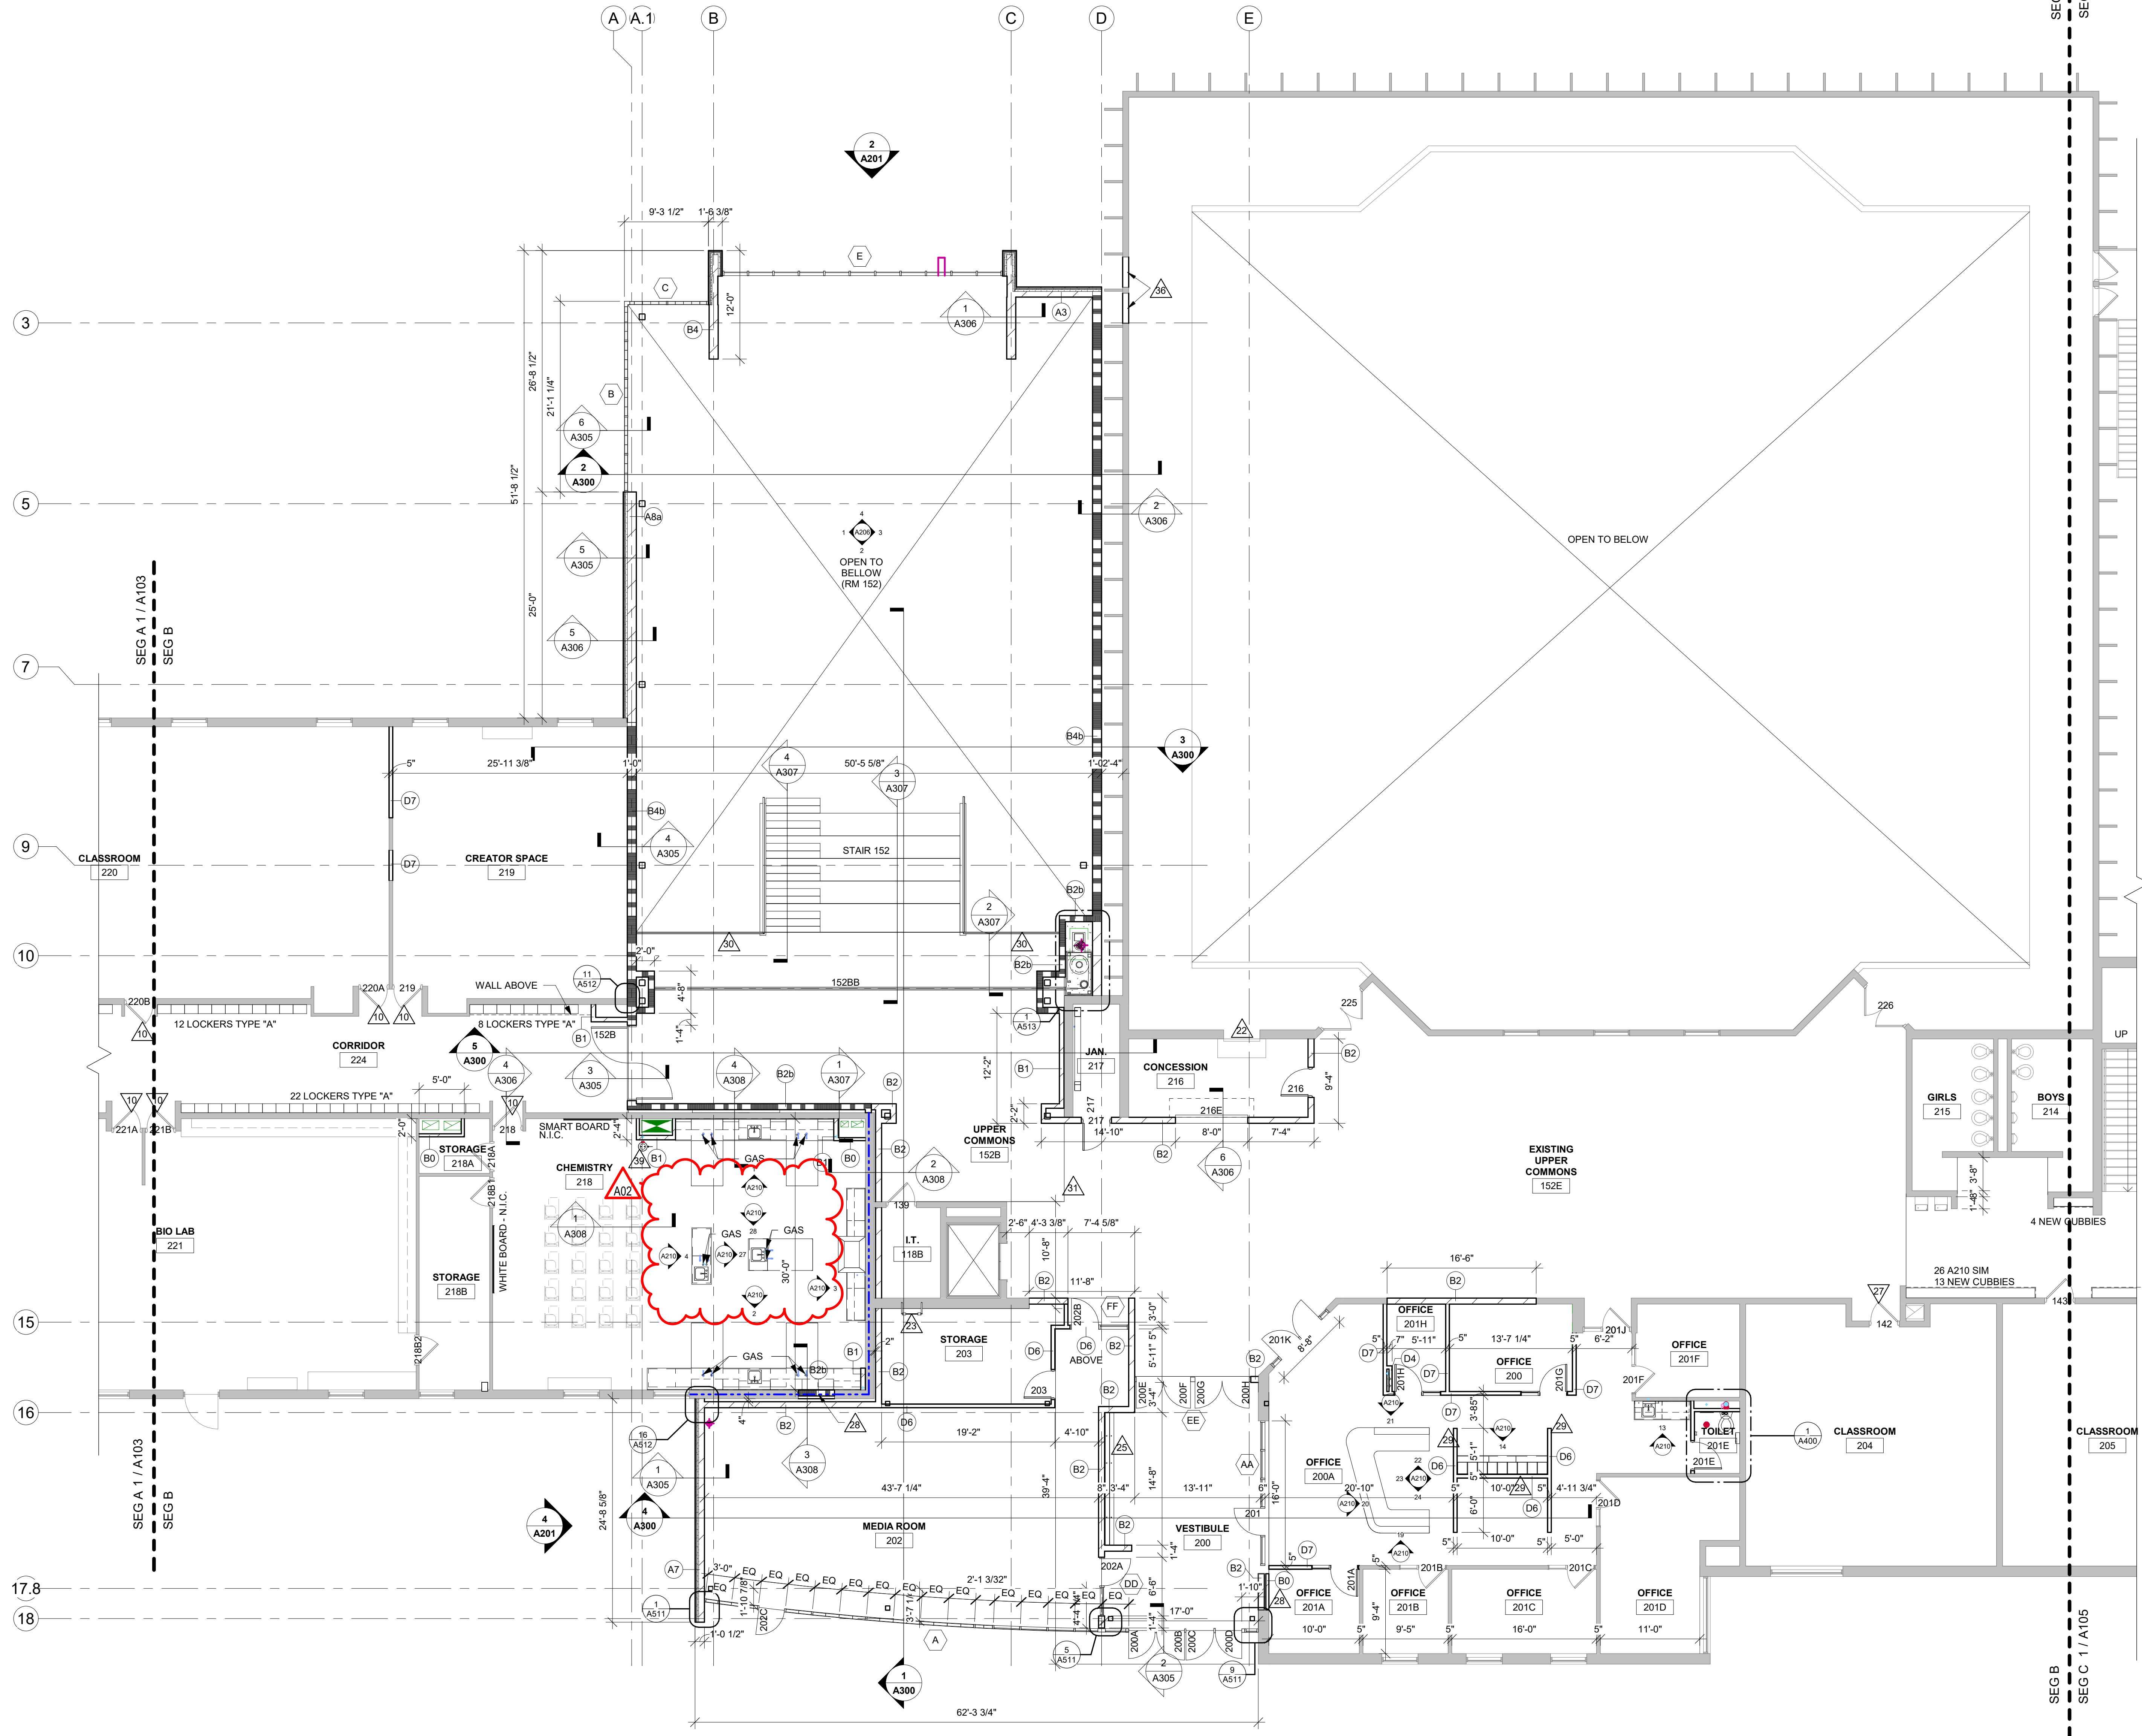

**LANESBORO PUBLIC SCHOOLS
ADDITION & REMODEL**

Project Location: 204 KIRKWOOD ST EAST
LANESBORO, MN 55949

Sheet Title: UPPER LEVEL REMODELED FLOOR PLAN - SEG B

HSR Project Number: 18063

Project Date: 7-25-19

Drawn By: TBS/SRW

Key Plan:



KEY PLAN

Revisions:

No.	Description	Date
A02	ADDENDUM #02	8-19-19

Graphic Scale: 0' 2' 4' 8' 12'

Last Update: 8/19/2019 10:06:34 AM

A104

1 UPPER LEVEL REMODELED FLOOR PLAN - SEG B
1/8" = 1'-0"



Consultant:

ENGINEER CERTIFICATION

I hereby certify that this Plan, Specification or Report was prepared by me or under my direct supervision and that I am a duly licensed Engineer under the laws of the state of Minnesota.
Date: July 9, 2019 Lic No: 103131
This drawing is conditionally issued and reproductions or use of any technical design information is strictly forbidden without written agreement from the responsible Engineer.

ARCHITECT CERTIFICATION


I hereby certify that this Plan, Specification or Report was prepared by me or under my direct supervision and that I am a duly licensed Architect under the laws of the state of Minnesota.
Date: July 9, 2019 Lic No: 58867
This drawing is conditionally issued and reproductions or use of any technical design information is strictly forbidden without written agreement from the responsible Architect.

Project Title: LANESBORO PUBLIC SCHOOLS ADDITION & REMODEL
Project Location: 204 KIRKWOOD ST EAST LANESBORO, MN 55949
Sheet Title: LOWER LEVEL RCP - SEG C

HSR Project Number: 18063

Project Date: 7-25-19

Drawn By: TBS/SRW

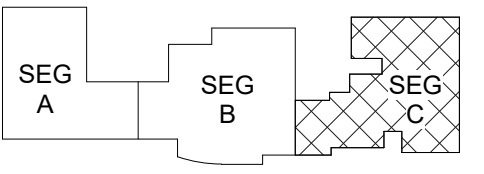

KEY PLAN

No.	Description	Date
A02	ADDENDUM #02	8-19-19

Graphic Scale: 0' 2' 4' 8' 12'

Last Update: 8/20/2019 11:09:28 AM

A112

GENERAL NOTES:


- A REFER TO MECHANICAL AND PLUMBING CEILING ACCESS PANEL LOCATIONS & SIZES.
- B SEE MECHANICAL FOR CEILING GRILLE INFORMATION.
- C SEE ELECTRICAL FOR LIGHTING TYPES.
- D ALL INTERIOR PARTITIONS TO EXTEND TO BOTTOM OF DECK UNLESS OTHERWISE NOTED. CLOSE DECK FLUTES AT TOP OF WALL WITH NEOPRENE FILES OR FIRESTOPPING SYSTEM. IN GYPSIUM PARTITIONS SEE SPECIFICATION FOR LEVEL OF FINISH ABOVE FINISHED CEILING.
- E ALL REMAINING ANNULAR SPACE AROUND ITEMS PENETRATING WALLS SHALL BE NEATLY SEALED. PENETRATIONS OF FIRE RATED WALLS SHALL BE FIRESTOPPED WITH THE SAME AS THE WALL.
- F WHERE NO CEILING/EXPOSED STRUCTURE UNLESS NOTED OTHERWISE, CONTRACTOR SHALL KEEP ALL MEP ABOVE OR EVEN WITH THE LEVEL OF THE LIGHTS. MEP SHALL RUN IN NEAT ORDERLY APPEARANCE GENERALLY PARALLEL OR PERPENDICULAR TO FINISHED STRUCTURE. WALLS IN THESE ROOMS TO RUN TO DECK AND ALL STRUCTURE / MEP COMPONENTS ARE TO BE PAINTED.
- G ALL EXTERIOR EXPOSED STEEL UNITS/HEADERS SHALL BE GALVANIZED, PRIMED AND PAINTED UNLESS NOTED OTHERWISE.
- H REFER TO INTERIOR DESIGN SHEETS FOR OTHER FINISHES.
- I HANGERS AND SUPPORTS: MECHANICAL, PLUMBING, ELECTRICAL AND OTHER CABLING CONTRACTORS SHALL NOT HANG OR SUPPORT THE WORK FROM THE ROOF DECK IN ANY FASHION. CONDUIT RUNS SHALL NOT BE LAID ON ROOF DECK NOR LAID ON THE STRUCTURAL SUPPORT THAT SUPPORTS THE ROOF DECK. NO FASTENERS SHALL PENETRATE ROOF DECK BY ANY TRADE OTHER THAN THE ROOFING CONTRACTOR FOR THE NEW ROOF SYSTEM.
- J CONFIRM EXACT LOCATION OF OVERHEAD PROJECTORS AND OTHER CEILING MOUNTED EQUIPMENT WITH OWNER / MANUFACTURER PRIOR TO INSTALLATION. SEE EQUIPMENT PLANS FOR ADDITIONAL EQUIPMENT.
- K CEILING TYPES INSTALLED AS NOTED ON PLANS. SEE SPECIFICATIONS FOR ADDITIONAL SYSTEM INFORMATION.
ACT-1= SQUARE EDGE, ACT-2= TEGULAR EDGE, ACT-3= VINYL FACED GYP

LEGEND:

- [Symbol] LIGHT FIXTURE - SEE ELECTRICAL
- [Symbol] LIGHT FIXTURE - SEE ELECTRICAL
- [Symbol] LIGHT FIXTURE - SEE ELECTRICAL
- [Symbol] LIGHT FIXTURE - SEE ELECTRICAL
- [Symbol] SUPPLY - SEE MECHANICAL
- [Symbol] RETURN - SEE MECHANICAL
- [Symbol] RADIANT HEATER - SEE MECHANICAL
- [Symbol] CEILING ACCESS PANEL - SEE SPECIFICATIONS

KEY NOTES RCP

- 1 NEW CEILING TO BE INSTALLED
- 2 OPEN TO STRUCTURE - PAINT
- 3 GYP SOFFIT
- 4 CAB HEATER - SEE MECHANICAL
- 5 SKYLIGHT
- 6 EXTENTS OF CEILING REMOVAL FOR PIPE RELOCATION - PATCH & REPAIR TO MATCH EXISTING CEILING
- 8 GRID ONLY AT THIS LOCATION, STRUCTURE AND ALL EQUIPMENT TO BE PAINTED ABOVE
- 9 EXISTING WOOD BEAMS
- 10 STEEL BEAM - SEE STRUCTURE
- 11 TYPED 2 FLUSH SOFFIT METAL PANEL - 0742.3

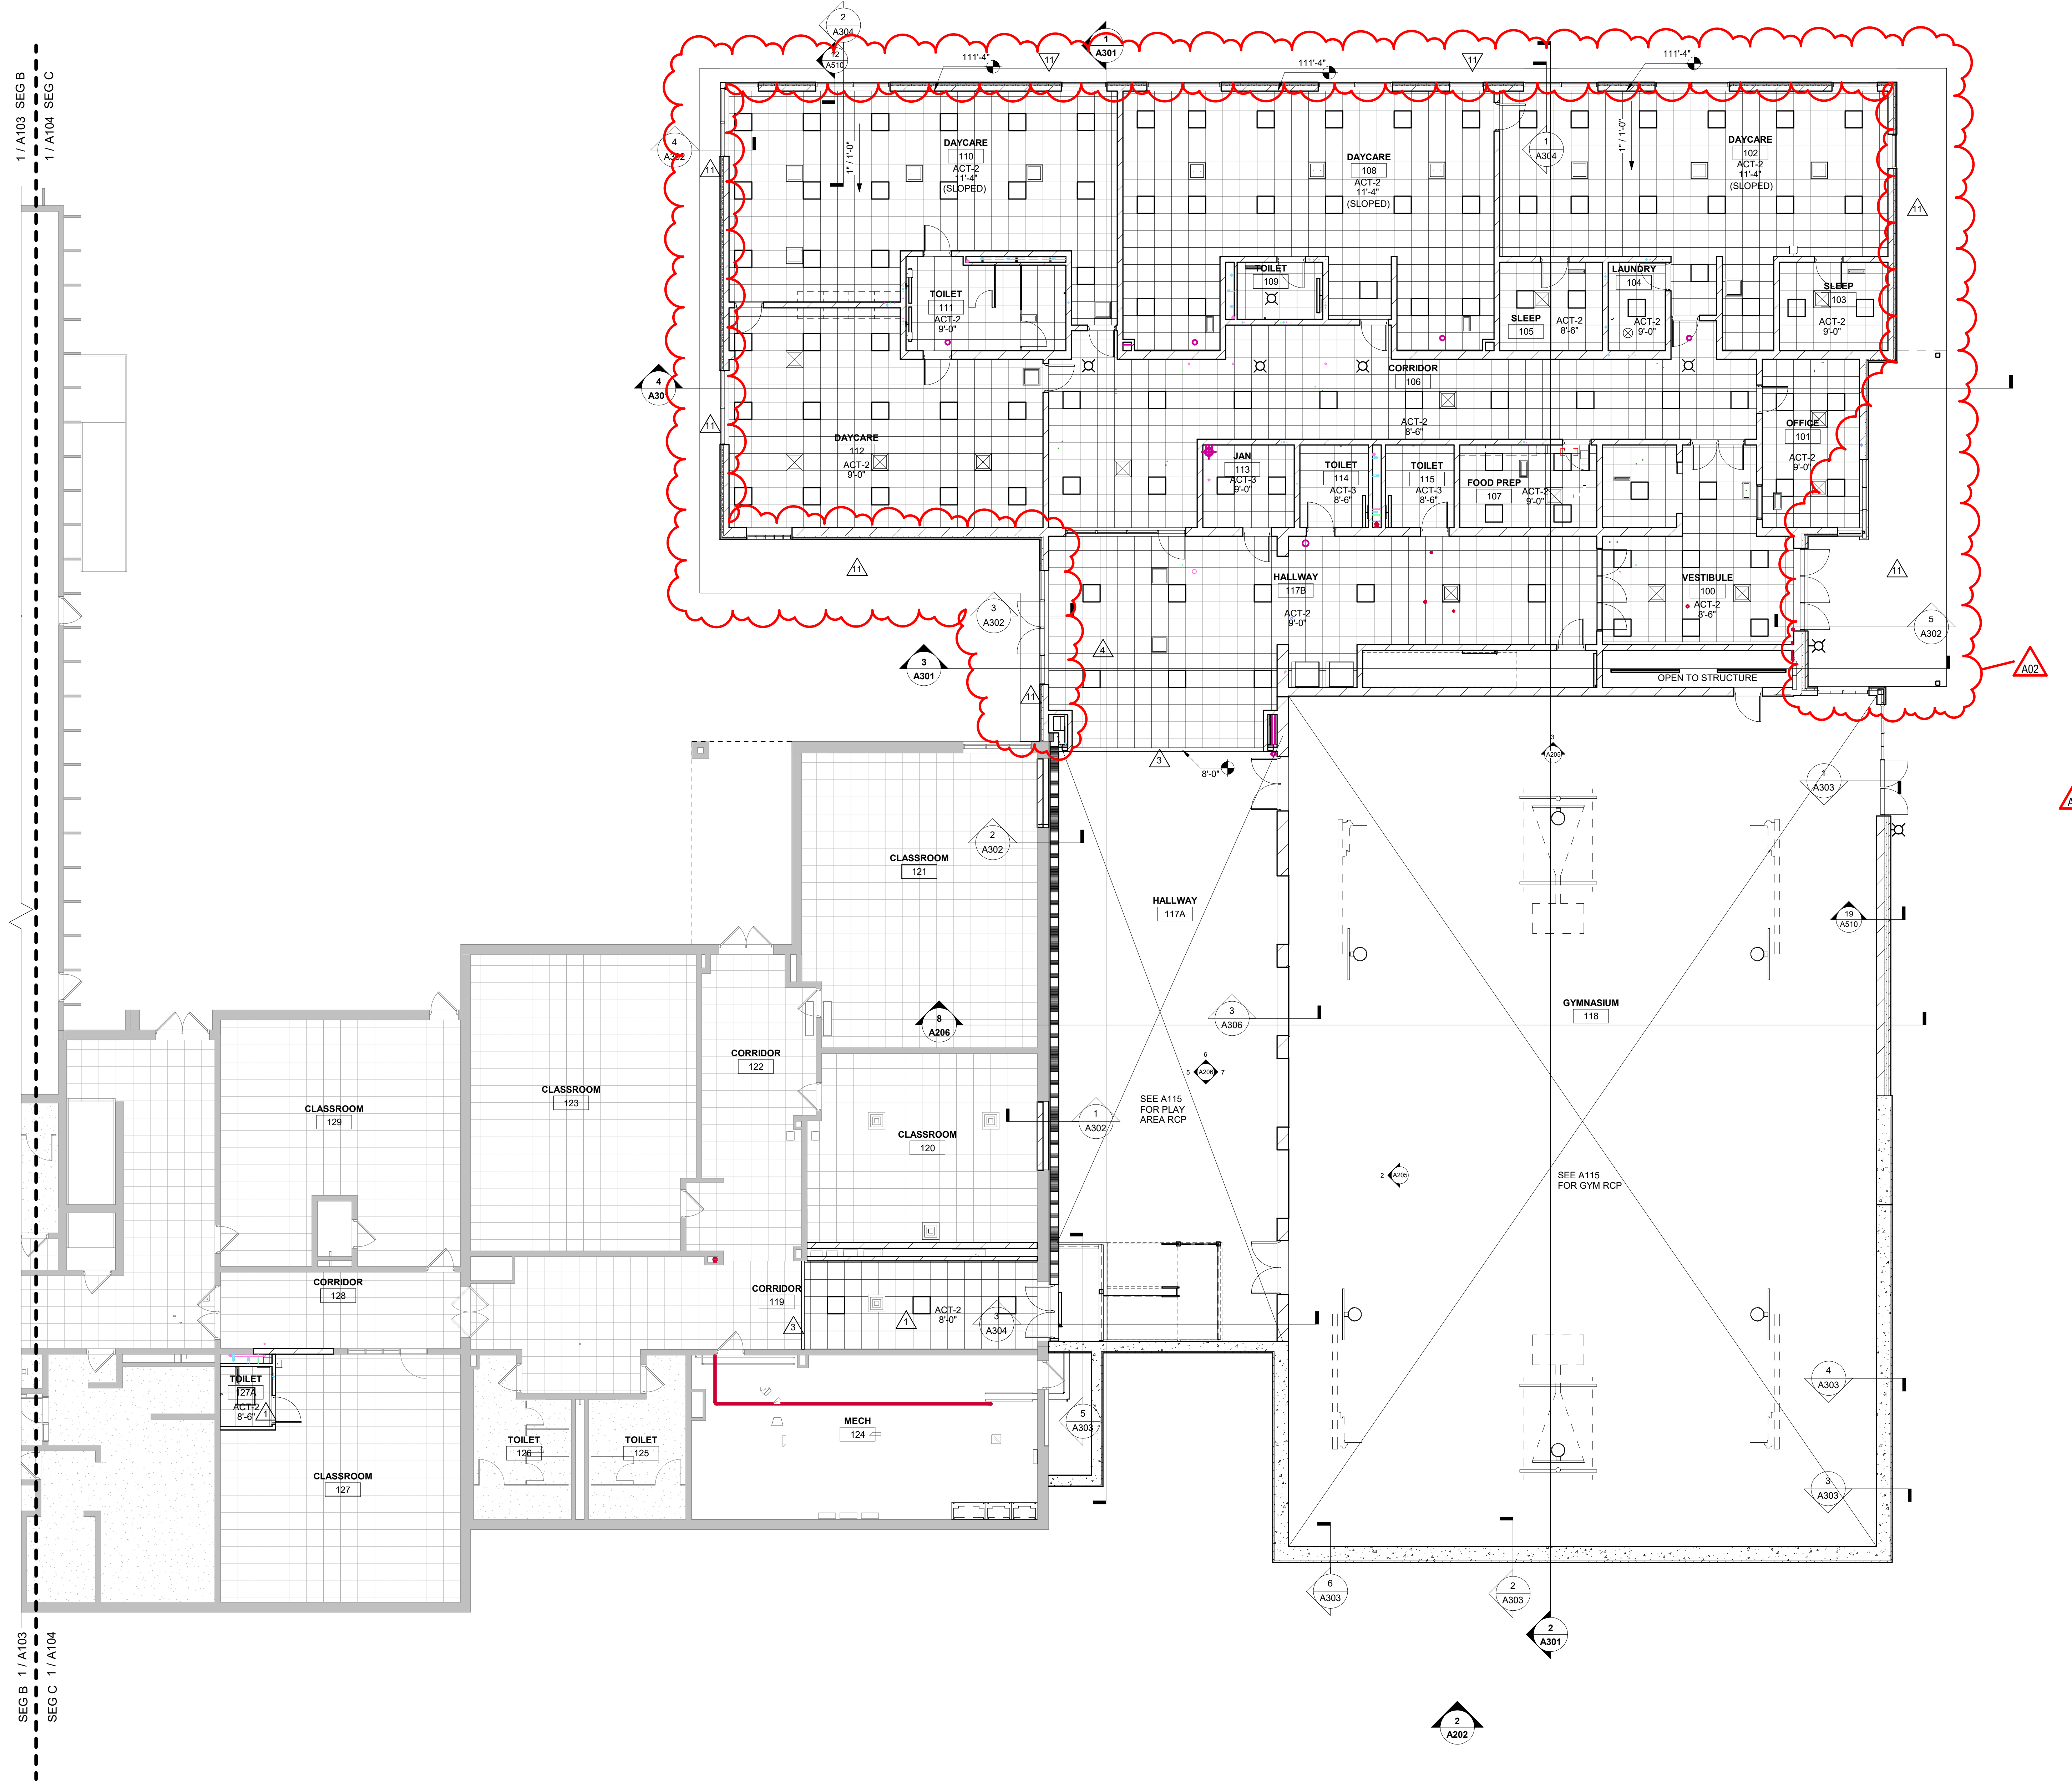

1 LOWER LEVEL RCP - SEG C
1/8" = 1'-0"

1/A103 SEG B
1/A104 SEG C
SEG B 1/A103
SEG C 1/A104



Consultant:

ENGINEER CERTIFICATION

I hereby certify that this Plan, Specification or Report was prepared by me or under my direct supervision and that I am a duly licensed Engineer under the laws of the state of Minnesota.
Date: July 9, 2019 Lic No: 58867
This drawing is conditionally issued and reproduction or use of any technical design information is strictly forbidden without written agreement from the responsible Engineer.

ARCHITECT CERTIFICATION

I hereby certify that this Plan, Specification or Report was prepared by me or under my direct supervision and that I am a duly licensed Architect under the laws of the state of Minnesota.
Date: July 9, 2019 Lic No: 58867
This drawing is conditionally issued and reproduction or use of any technical design information is strictly forbidden without written agreement from the responsible Architect.

GENERAL ROOF NOTES:

- A SEE ROOF SYSTEM NOTES FOR MINIMUM AND AVERAGE INSULATION VALUES.
- B ROOFING CONTRACTOR TO VERIFY ALL TAPERED INSULATION DRAWING PLAN DRAIN LOCATIONS WITH PHYSICAL LOCATION OF ROOF DRAIN AS INSTALLED BY PLUMBING TRADE PRIOR TO AE APPROVAL OF TAPERED INSULATION SUBMITTAL DRAWING.
- C VERIFY ROOF EQUIPMENT AND PENETRATIONS WITH ALL TRADES. EQUIPMENT SHOWN IS GRAPHIC ONLY.
- D ALL METAL ITEMS AT ROOF TOPS, UNLESS REQUIRED OTHERWISE BY EQUIPMENT MANUFACTURER, SHALL BE PAINTED TO MATCH OTHER TRIM BY THE G.C. - PREPARE, PRIME AND PAINT AS REQUIRED. PROVIDE FACTORY PRIMED PRODUCTS WHERE POSSIBLE.
- E ROOF PENETRATIONS FOR DRAINS, VENTS, ETC. SHALL BE COMPLETED AS PER CURRENT SMACNA REQUIREMENTS AND THE ROOF MANUFACTURERS APPROVED DETAILS FOR WARRANTY SATISFACTION. COORDINATE QUANTITY AND LOCATIONS WITH MEP CONTRACTOR. PROVIDE CURBS WHERE REQUIRED.
- F ALL METAL ROOF AND FLASHING SHALL MEET CURRENT SMACNA REQUIREMENTS AND MANUFACTURER'S SPECIFIED WARRANTY.
- G WHERE MEMBRANE IS SHOWN OVER TOP OF WALL EXTEND DOWN OPPOSITE SIDE AND SECURE TO BLOCKING.
- H TOP OF WALL BLOCKING SHOWN IS GRAPHIC. PROVIDE BLOCKING THAT SHALL BE ANCHORED TO WALL BELOW AS RECOMMENDED BY ROOFING SYSTEM MANUFACTURER TO WITHSTAND WIND UPLIFT AS STATED IN CODE. TOP OF WALLS SHALL SLOPE TOWARDS ROOF.
- I INSTALL BOND BREAK BETWEEN ALL WOOD BLOCKING AND CMU OR CONCRETE.
- J WHERE ROOF DRAINS PENETRATE ABOVE ROOMS W/ NO CEILING CARE SHALL BE TAKEN TO ENSURE NEAT CUTS IN THE DECK AND PIPING/INSULATION SHALL BE CUT AND ANCHORED NEATLY @ RIGHT ANGLES TO STRUCTURE.
- K THE GENERAL CONTRACTOR, ROOFING CONTRACTOR AND MEP CONTRACTORS SHALL MEET TO PLAN AND DISCUSS FINAL ROOF EQPT. LOCATIONS. TIMING OF MEETING SHALL OCCUR BEFORE INSTALLATION OF ROOF DRAIN LEADERS TO ALLOW FOR ANY REQUIRED ADJUSTMENTS.
- L THE GENERAL CONTRACTOR, ROOFING CONTRACTOR AND PLUMBING CONTRACTORS SHALL MEET TO PLAN AND DISCUSS FINAL ROOF DRAIN LOCATIONS. TAPERED INSULATION DRAWING SHALL BE RE-SUBMITTED TO THE A/E AFTER DRAIN LOCATIONS ARE APPROVED BY ALL IN WRITING. TAPERED INSULATION INSTALLED CONTRARY TO THE LOW POINT OF THE DRAIN, OVER FLOW OR SCUPPER LOCATIONS SHALL BE CAUSE FOR REJECTION OF WORK.

ROOF SYSTEM DESCRIPTIONS:


- A INDUCTION WELDED, SINGLE KEE MEMBRANE ROOFING SYSTEM OVER 2 1/2" POLYISOCYANURATE (MIN. 2 LAYERS) INSULATION OVER VAPOR BARRIER OVER METAL DECK. VAPOR BARRIER SHALL BE TAPED SEAL AT PERIMETER AND OVERLAPPED SEAMS. (ALTERNATE BID: FULLY ADHERED EPDM SYSTEM. SEE 012300)
- B FULLY ADHERED, SINGLE KEE MEMBRANE ROOFING SYSTEM OVER 1/2" HIGH DENSITY COVER BOARD OVER 2 1/2" POLYISOCYANURATE (MIN. 2 LAYERS) INSULATION OVER VAPOR BARRIER OVER METAL DECK OVER SLOPED STRUCTURE. VAPOR BARRIER SHALL BE TAPED SEAL AT PERIMETER AND OVERLAPPED SEAMS. INSTALL SIMULATED STANDING SEAM RIBS OVER MEMBRANE.

ROOF EQUIPMENT LEGEND:

- ACCU AIR COOLED CONDENSING UNIT-SEE MECHANICAL.
- INTAKE VENT HOOD-SEE MECHANICAL.
- EXHAUST VENT HOOD-SEE MECHANICAL.
- AIR INTAKE/EXHAUST VENT-SEE MECHANICAL.
- PLUMBING VENT-SEE PLUMBING.
- ORD = ROOF DRAIN WITH 4" SQUARE SLUMP. INSTALL TO OS = MEET ROOF WARRANTY REQUIREMENT - SEE PLUMBING.

KEY NOTES ROOF

- 1 ROOF TOP MECHANICAL EQUIPMENT - SEE MECHANICAL
- 2 ROOF INTAKE/EXHAUST - SEE MECHANICAL
- 3 PIPING FOR MECHANICAL UNITS - SEE MECHANICAL
- 4 STEEL ROOF ACCESS LADDER - PAINT
- 5 INSTALL WALKWAY PADS
- 6 TAPERED INSULATION CRICKET
- 7 ROOF ACCESS HATCH - PAINT
- 8 EXISTING METAL ROOF
- 9 NO ROOF PENETRATIONS IN THIS AREA
- 10 OVERFLOW SCUPPER - SEE 54120

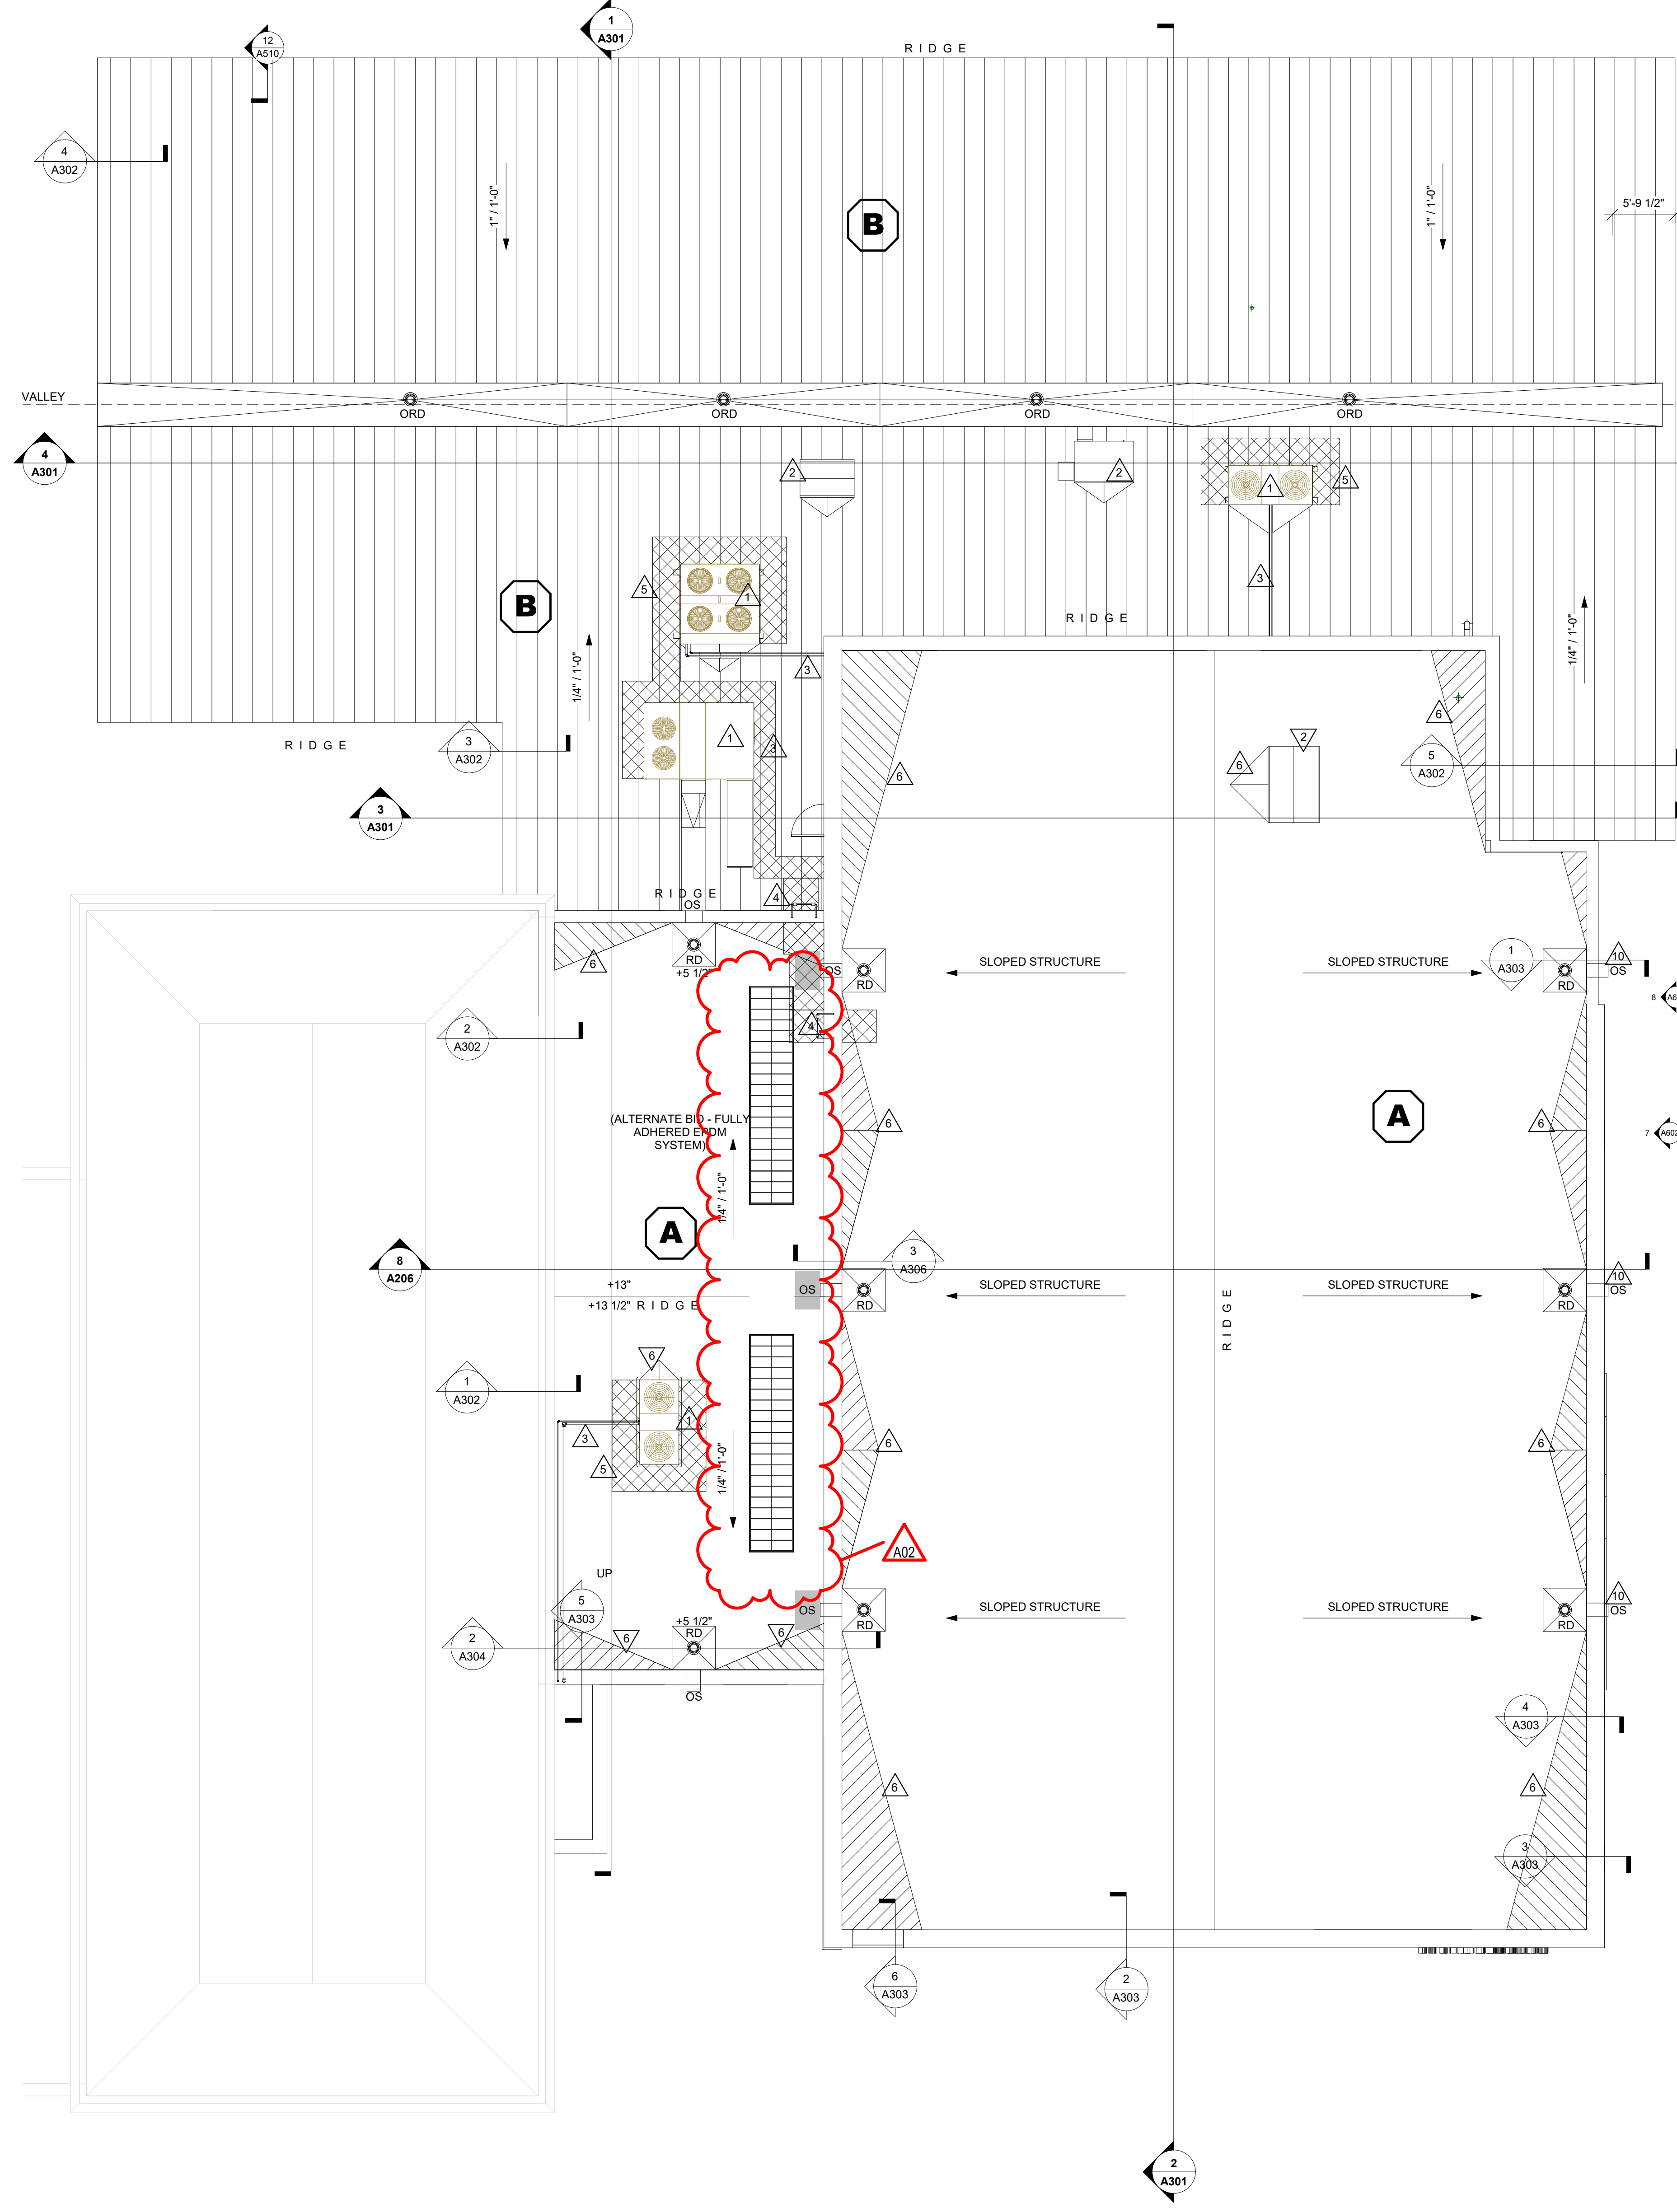

1 ROOF PLAN - SEG - C
1/8" = 1'-0"

Project Title: LANESBORO PUBLIC SCHOOLS
ADDITION & REMODEL
Project Location: 204 KIRKWOOD ST EAST
LANESBORO, MN 55949
Sheet Title: ROOF PLAN SEG - C

HSR Project Number: 18063
Project Date: 7-25-19
Drawn By: TBS
Key Plan:

No.	Description	Date
A02	ADDENDUM #02	8-19-19

Graphic Scale: VARIES
Last Update: 8/19/2019 3:24:18 PM

A121



Consultant:

ENGINEER CERTIFICATION
I hereby certify that this Plan, Specification or Report was prepared by me or under my direct supervision and that I am a duly licensed Engineer under the laws of the state of Minnesota.
Date: July 9, 2019 Lic No: 113131
This drawing is conditionally issued and reproductions or use of any technical design information is strictly forbidden without written agreement from the responsible Engineer.

ARCHITECT CERTIFICATION
I hereby certify that this Plan, Specification or Report was prepared by me or under my direct supervision and that I am a duly licensed Architect under the laws of the state of Minnesota.
Date: July 9, 2019 Lic No: 58867
This drawing is conditionally issued and reproductions or use of any technical design information is strictly forbidden without written agreement from the responsible Architect.

Project Title: LANESBORO PUBLIC SCHOOLS
ADDITION & REMODEL
Project Location: 204 KIRKWOOD ST EAST
LANESBORO, MN 55949
Sheet Title: ELEVATIONS

HSR Project Number: 18063
Project Date: 7-25-19
Drawn By: TBS/SRW
Key Plan:

No.	Description	Date
A01	ADDENDUM #01	8-13-19
A02	ADDENDUM #02	8-19-19

Graphic Scale: 0" 2" 4" 8" 12"

Last Update: 8/20/2019 10:15:16 AM

A201

GENERAL NOTES:






- A SEE DETAILS A510 FOR CONTROL JOINT (CJ) AND BRICK CONTROL JOINT (BCJ) INFORMATION.
- B BRICK COURSING: RUNNING BOND TYPICAL.
- C SEE SPECIFICATION FOR MATERIAL TYPE.

LEGEND:

- KEYNOTE TAG
- WINDOW TAG. SEE SHEET A602 FOR FRAME ELEVATIONS
- THROUGH WALL CONTROL JOINT - SEE DETAILS A510
- BRICK VENEER CONTROL JOINT - SEE DETAILS A510

KEY NOTES ELEVATION

- 1 VERTICAL ARCHITECTURAL METAL FLUSH PANEL TYPE 2 - COLOR #1
- 2 BRICK VENEER - LIGHT BROWN
- 3 HORIZONTAL METAL FLUSH PANEL TYPE 2 - COLOR #2
- 4 PRE-FINISHED ALUMINUM CAP TO MATCH METAL PANEL
- 5 MECHANICAL EQUIPMENT - SEE MECH
- 6 ROOF ACCESS LADDER
- 7 MECHANICAL LOUVER - SEE MECH
- 8 PRE-FINISHED METAL FASCIA
- 9 ARCHITECTURAL METAL PLATE WALL PANEL TYPE 1 - COLOR #3
- 10 OVERFLOW SCUPPER - SEE ROOF PLAN
- 11 CONCRETE PAD - SEE STRUCTURAL
- 12 SPLIT FACE CMU
- 13 ARCHITECTURAL METAL PLATE WALL PANEL TYPE 1 - COLOR #4
- 14 BRICK VENEER - TAN
- 15 GABLE ARCHITECTURAL METAL PLATE WALL PANEL TYPE 1 - COLOR #3
- 16 PRE-FINISHED ALUMINUM CAP

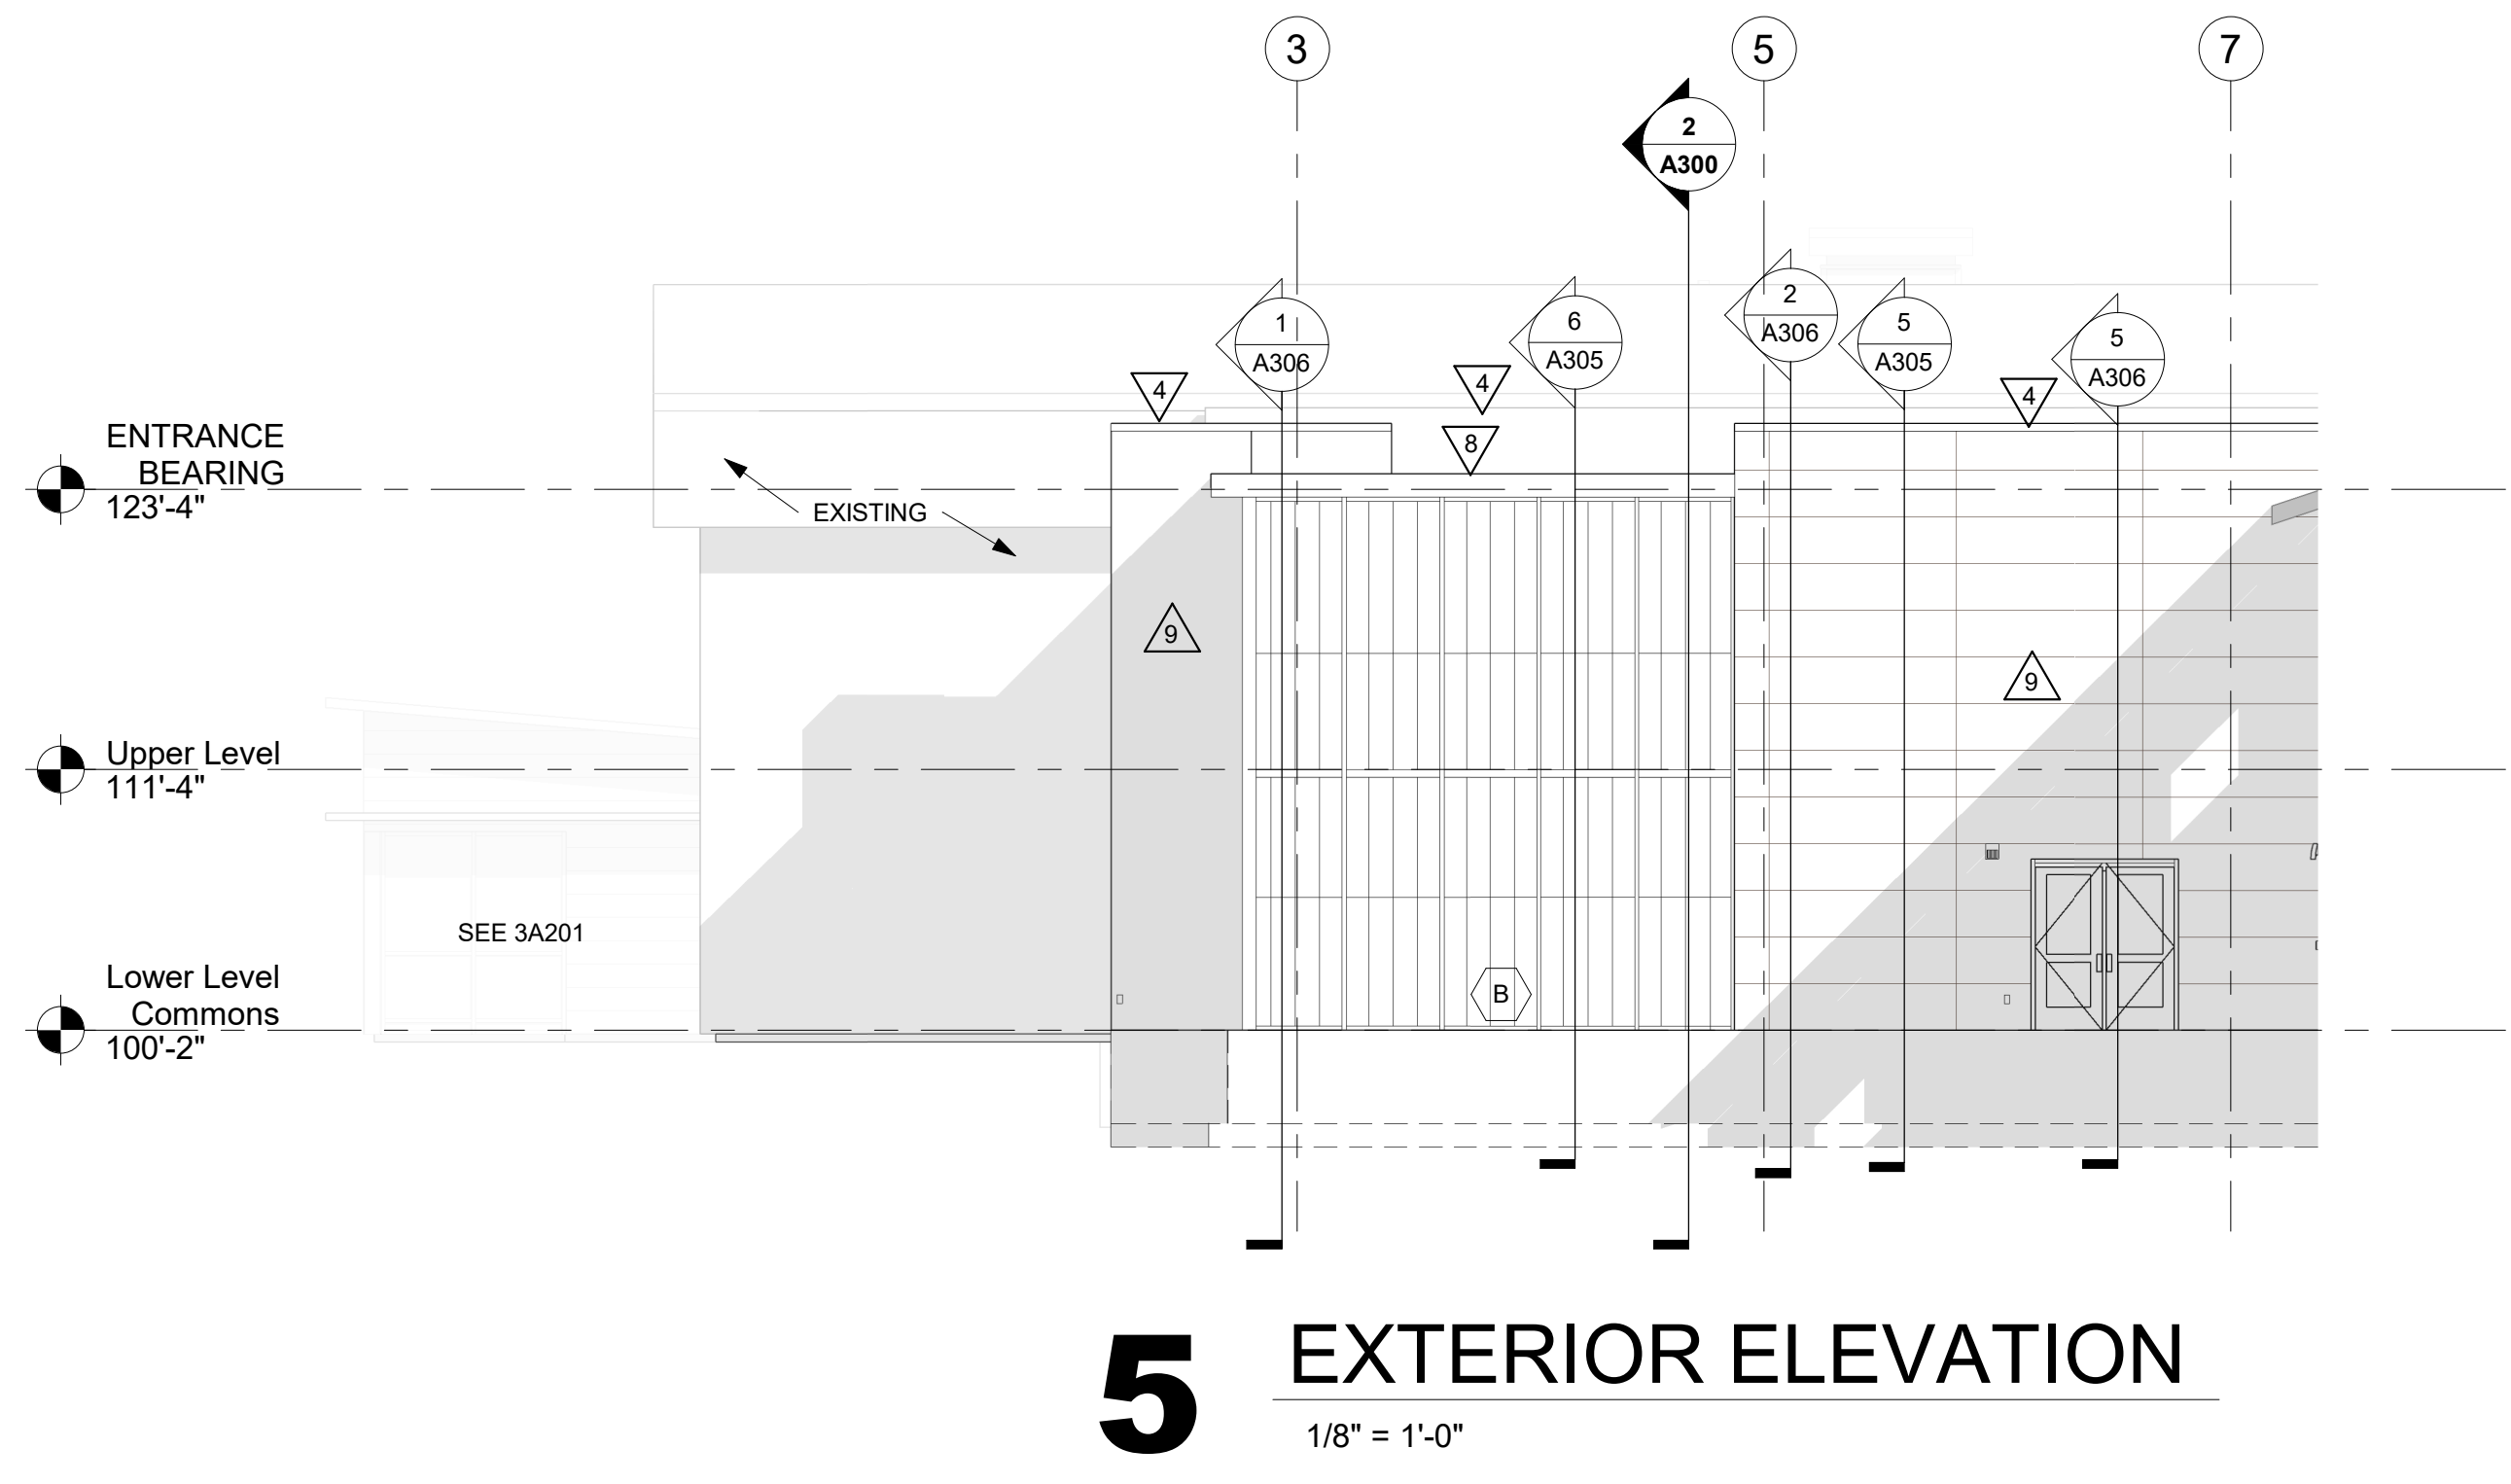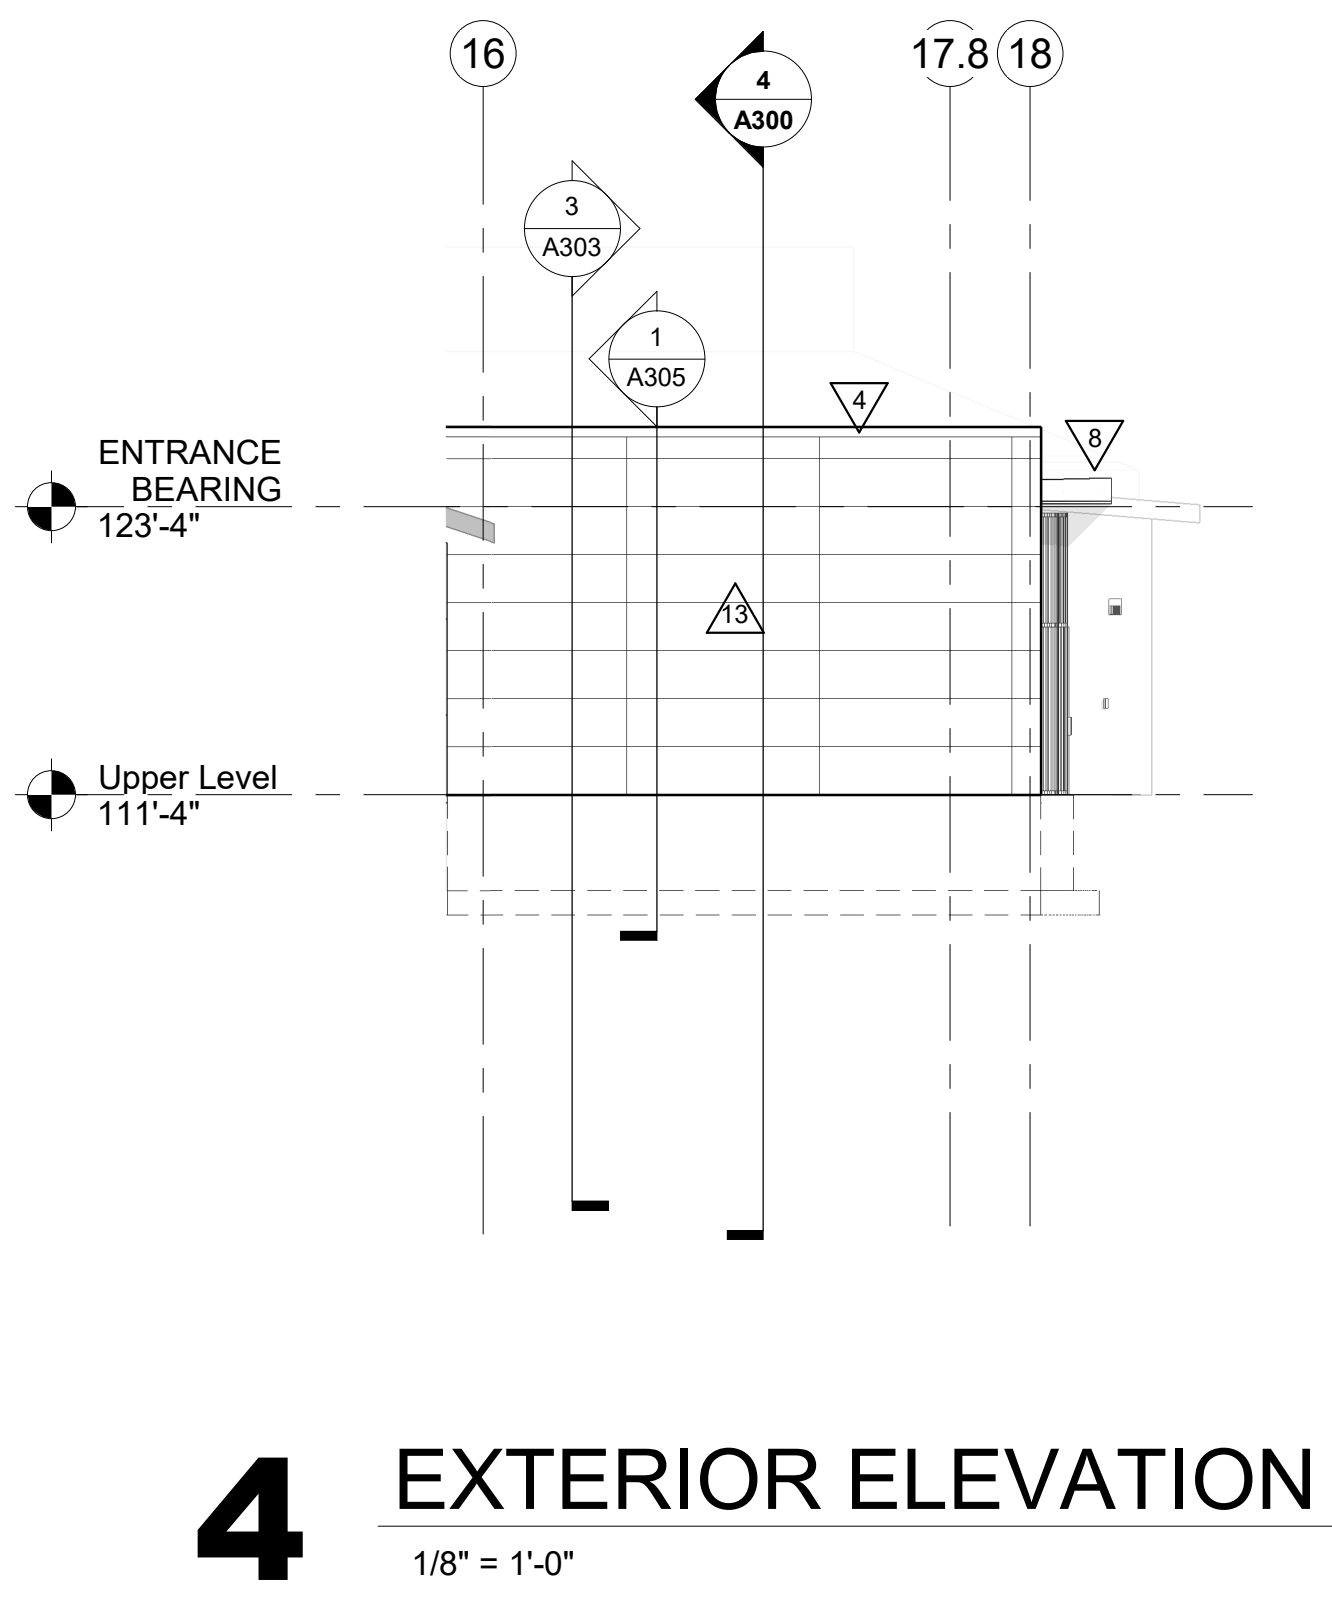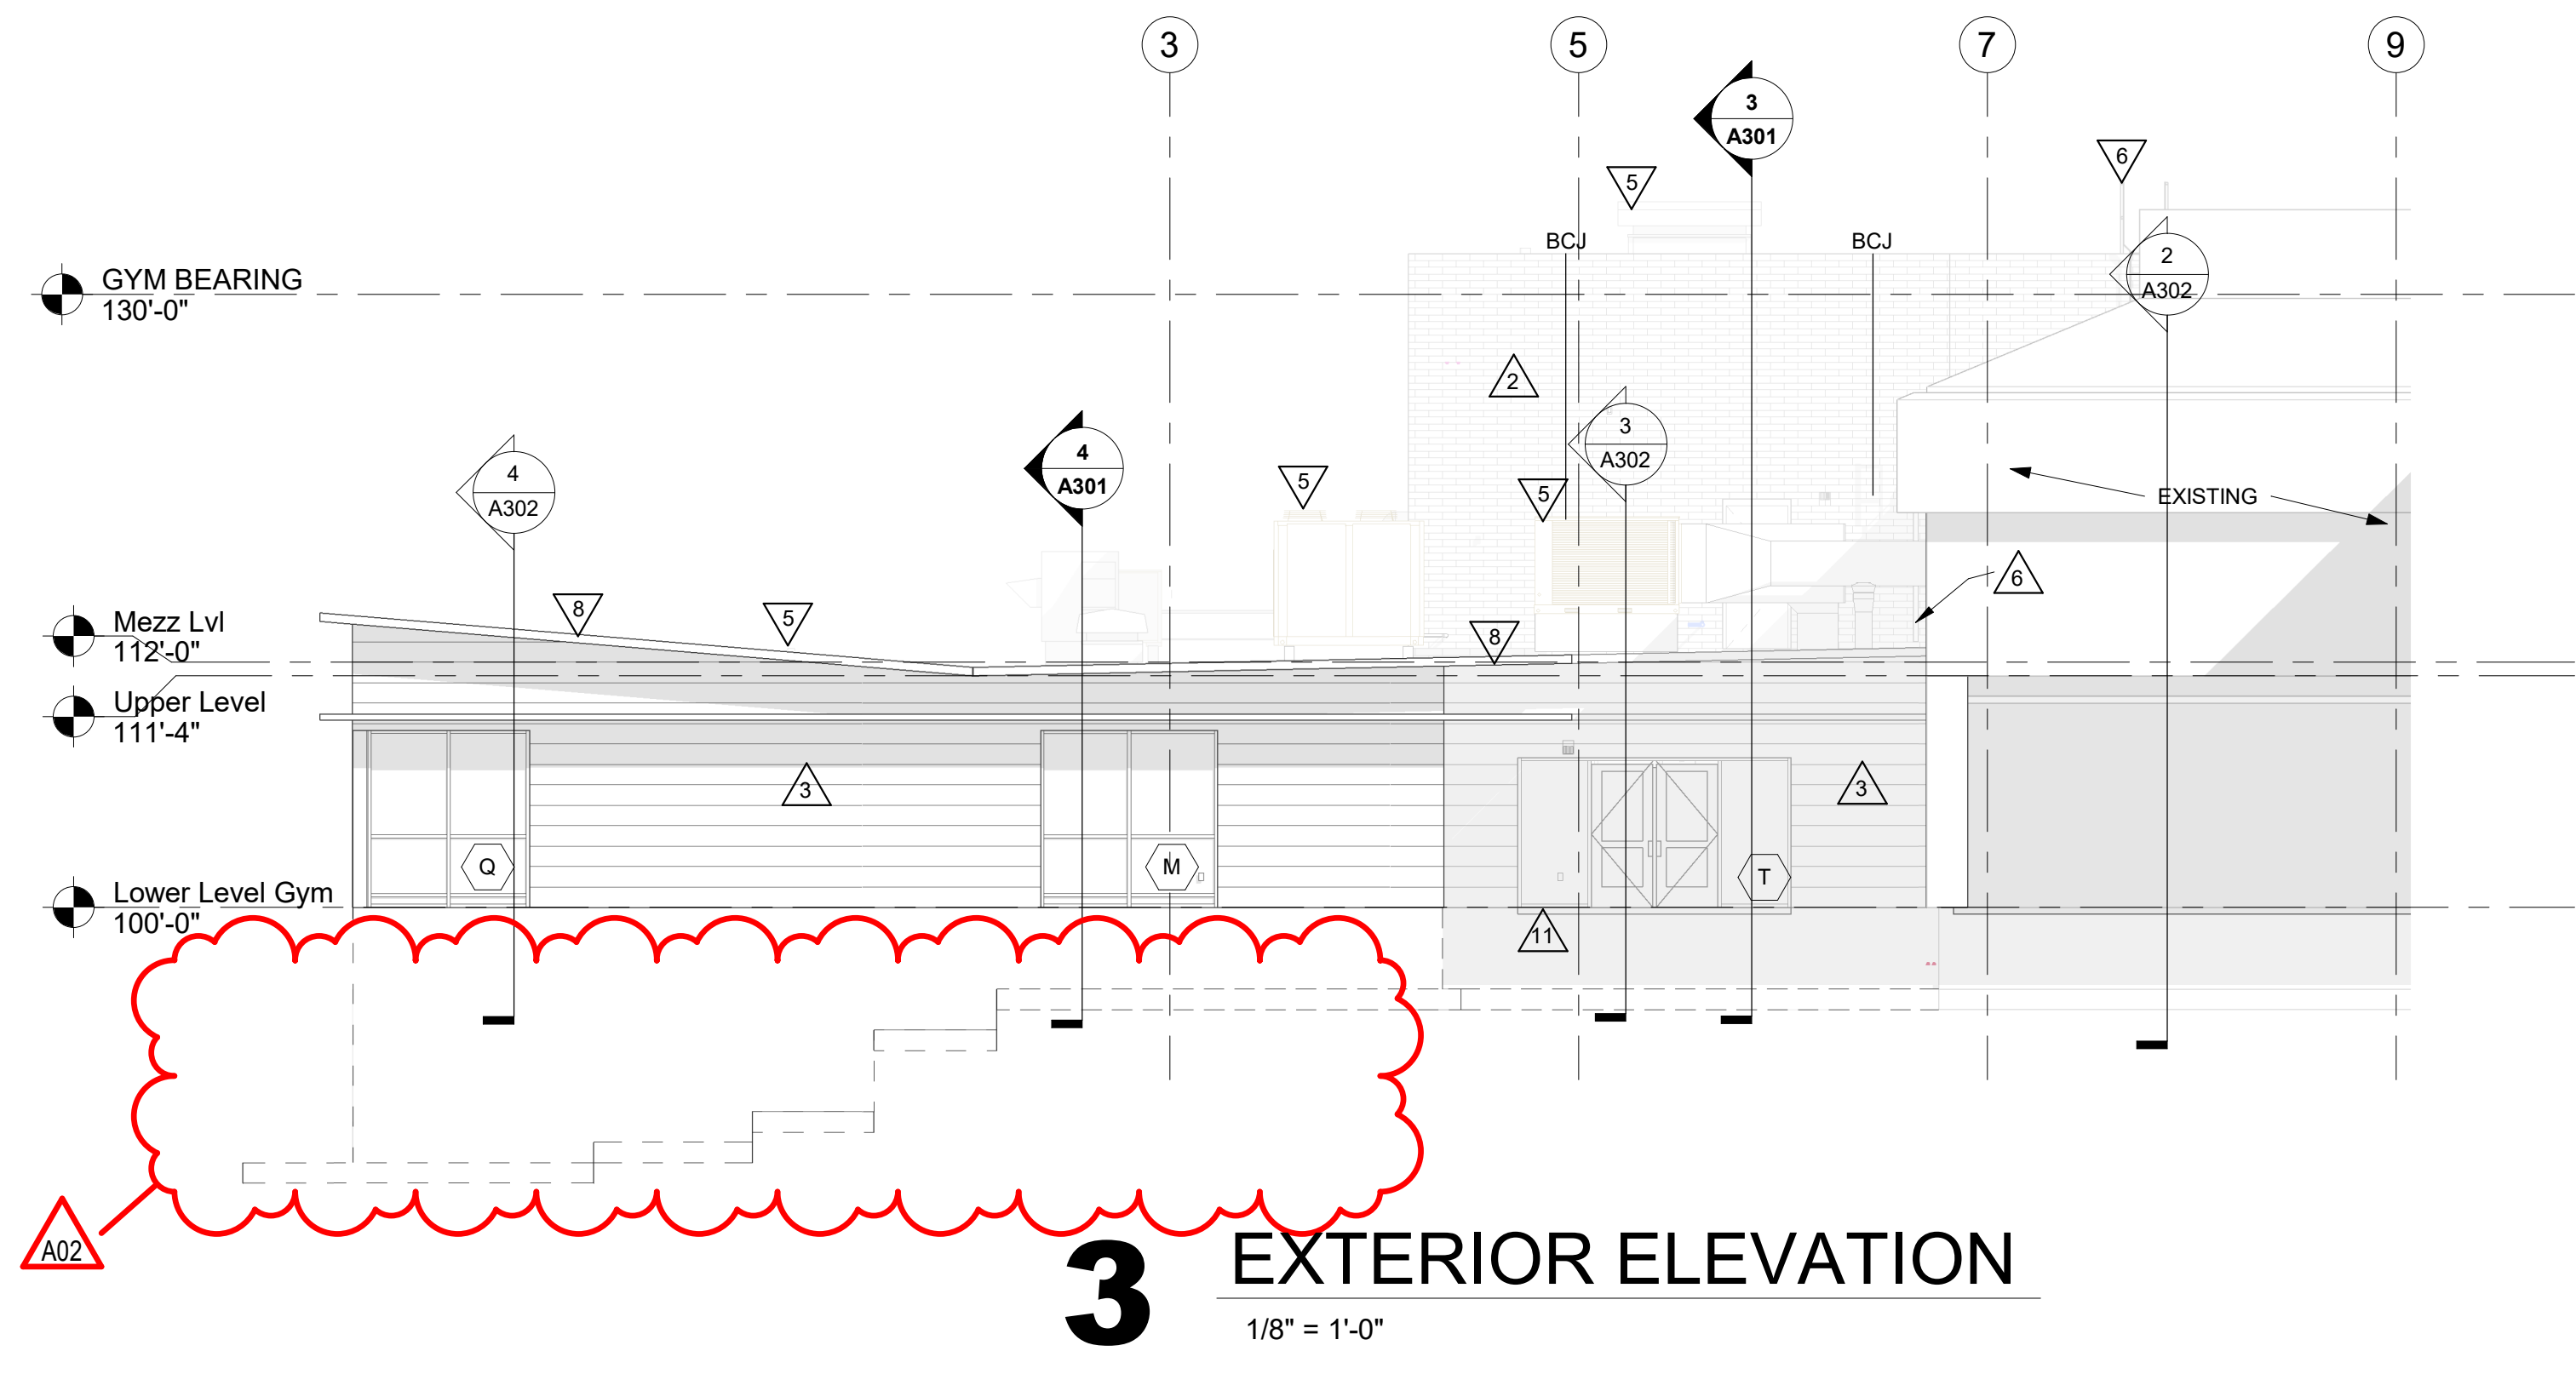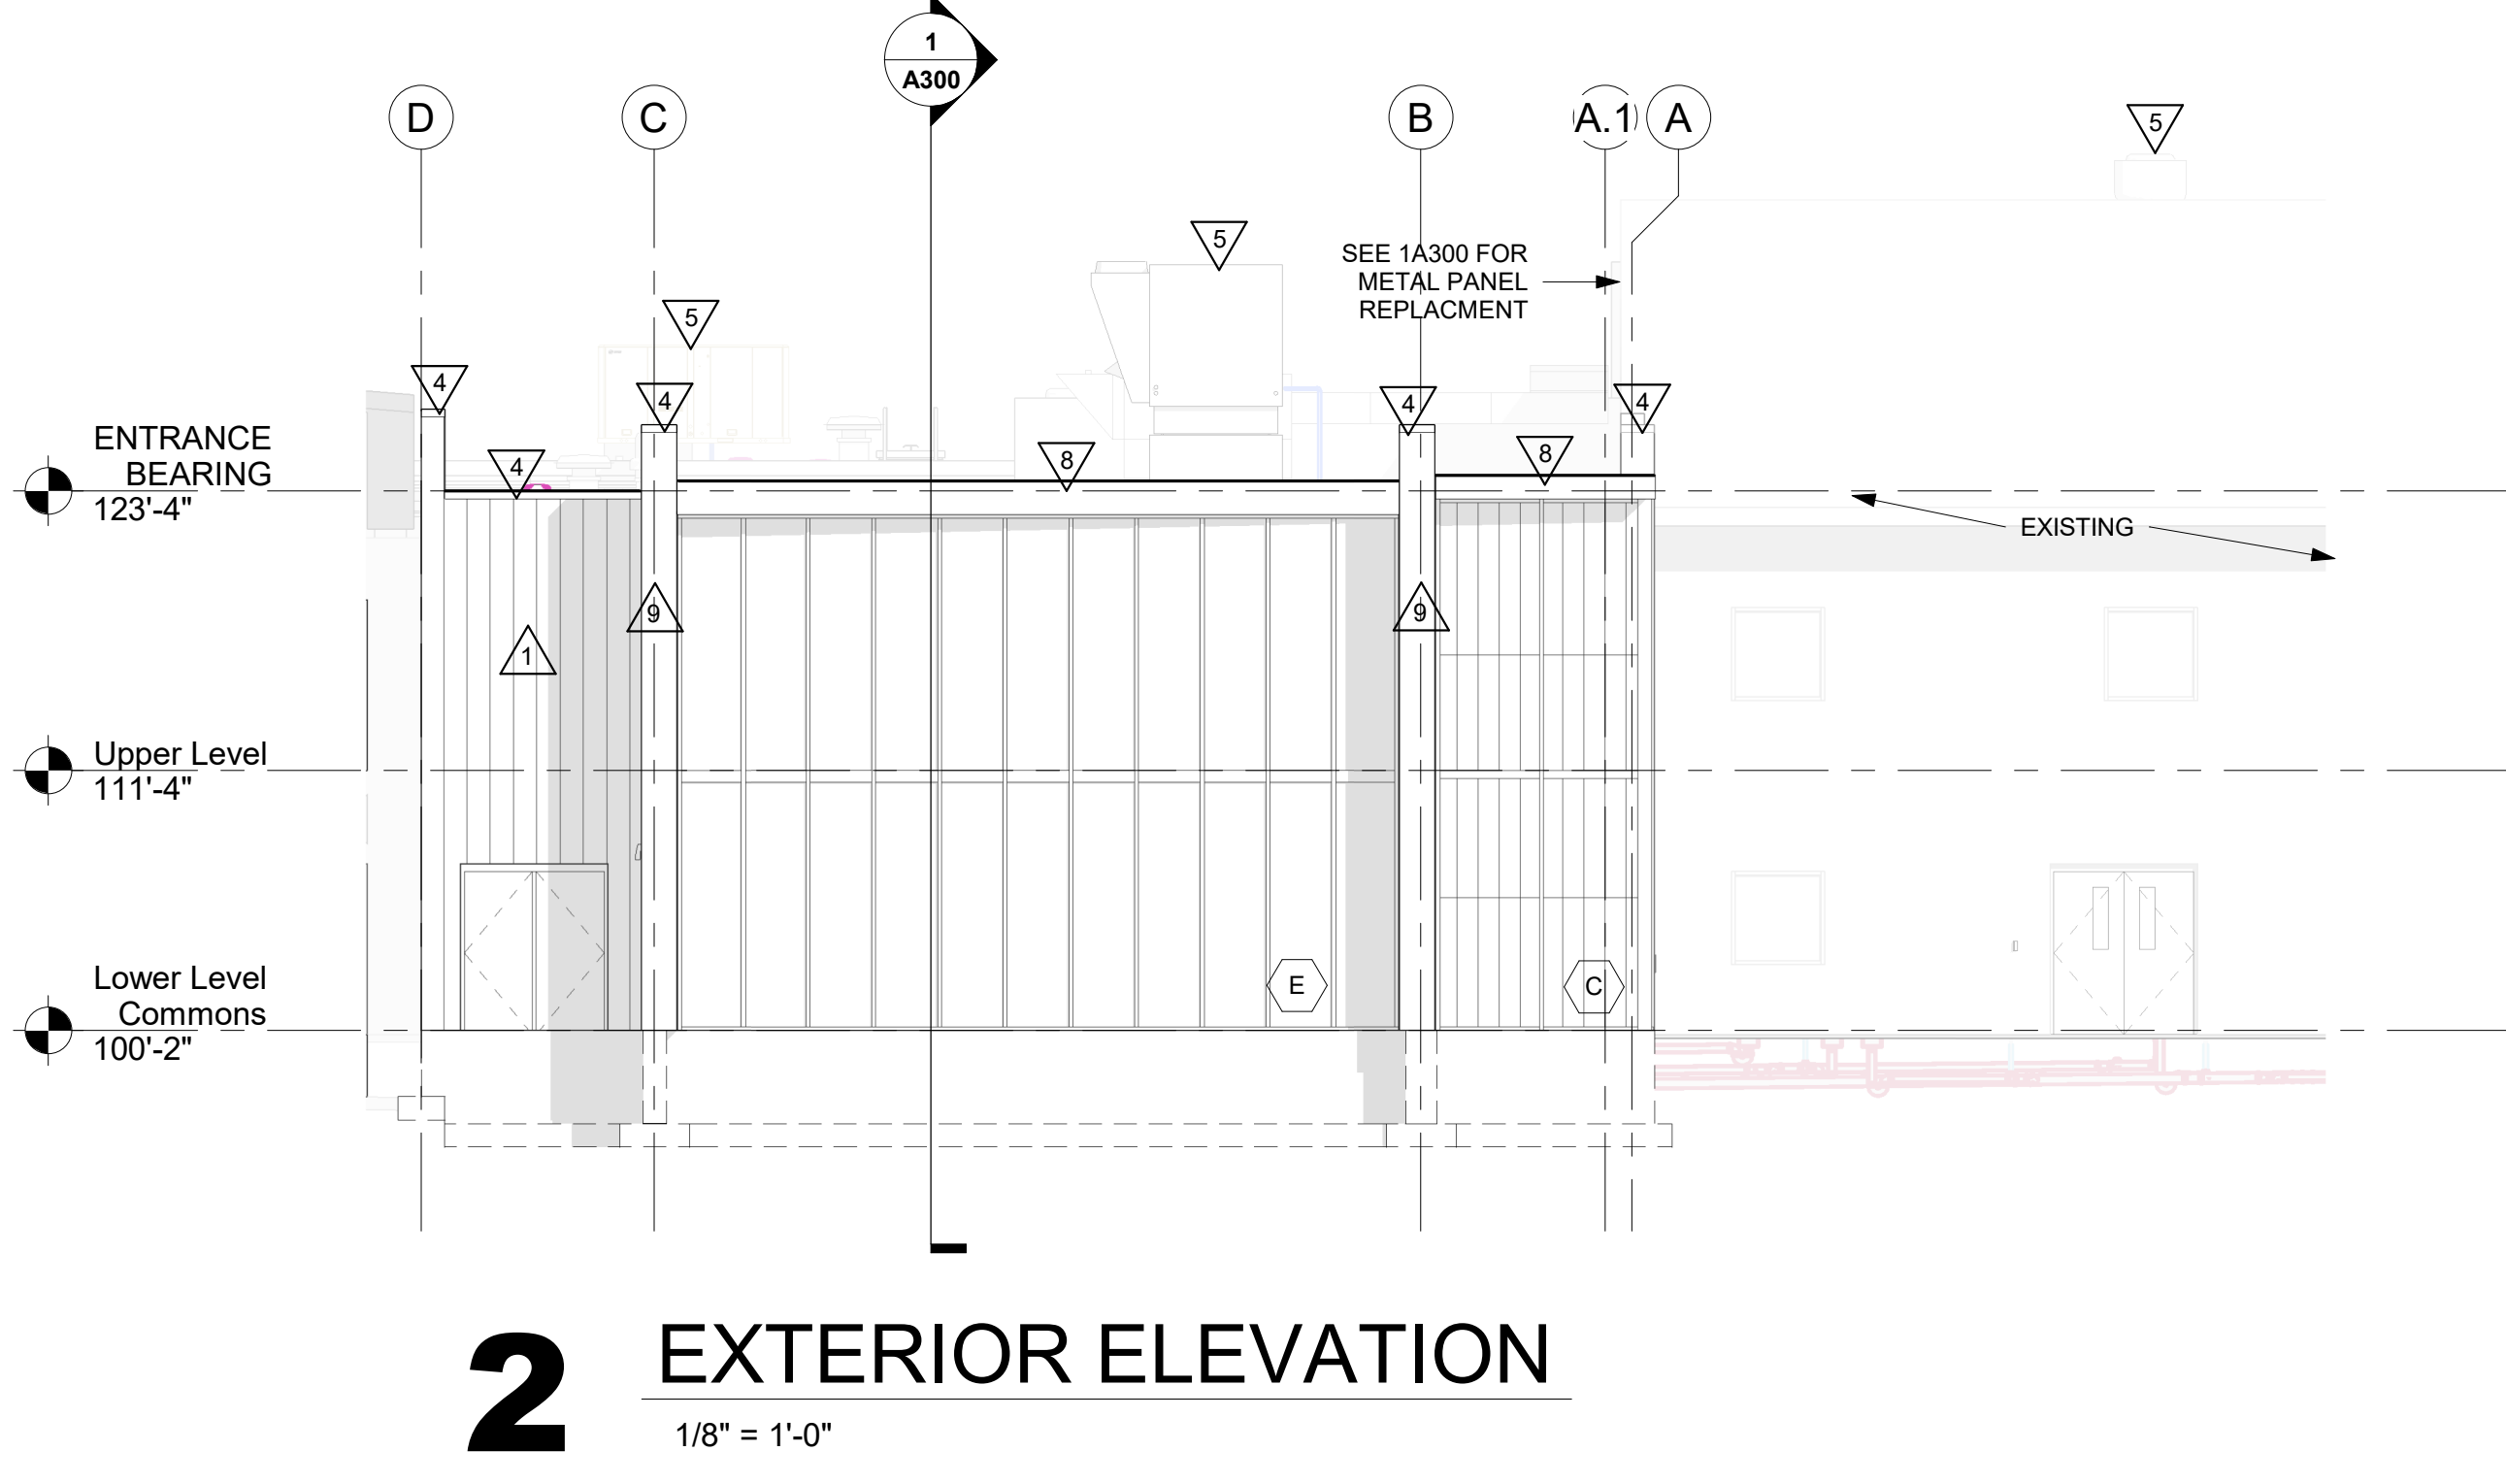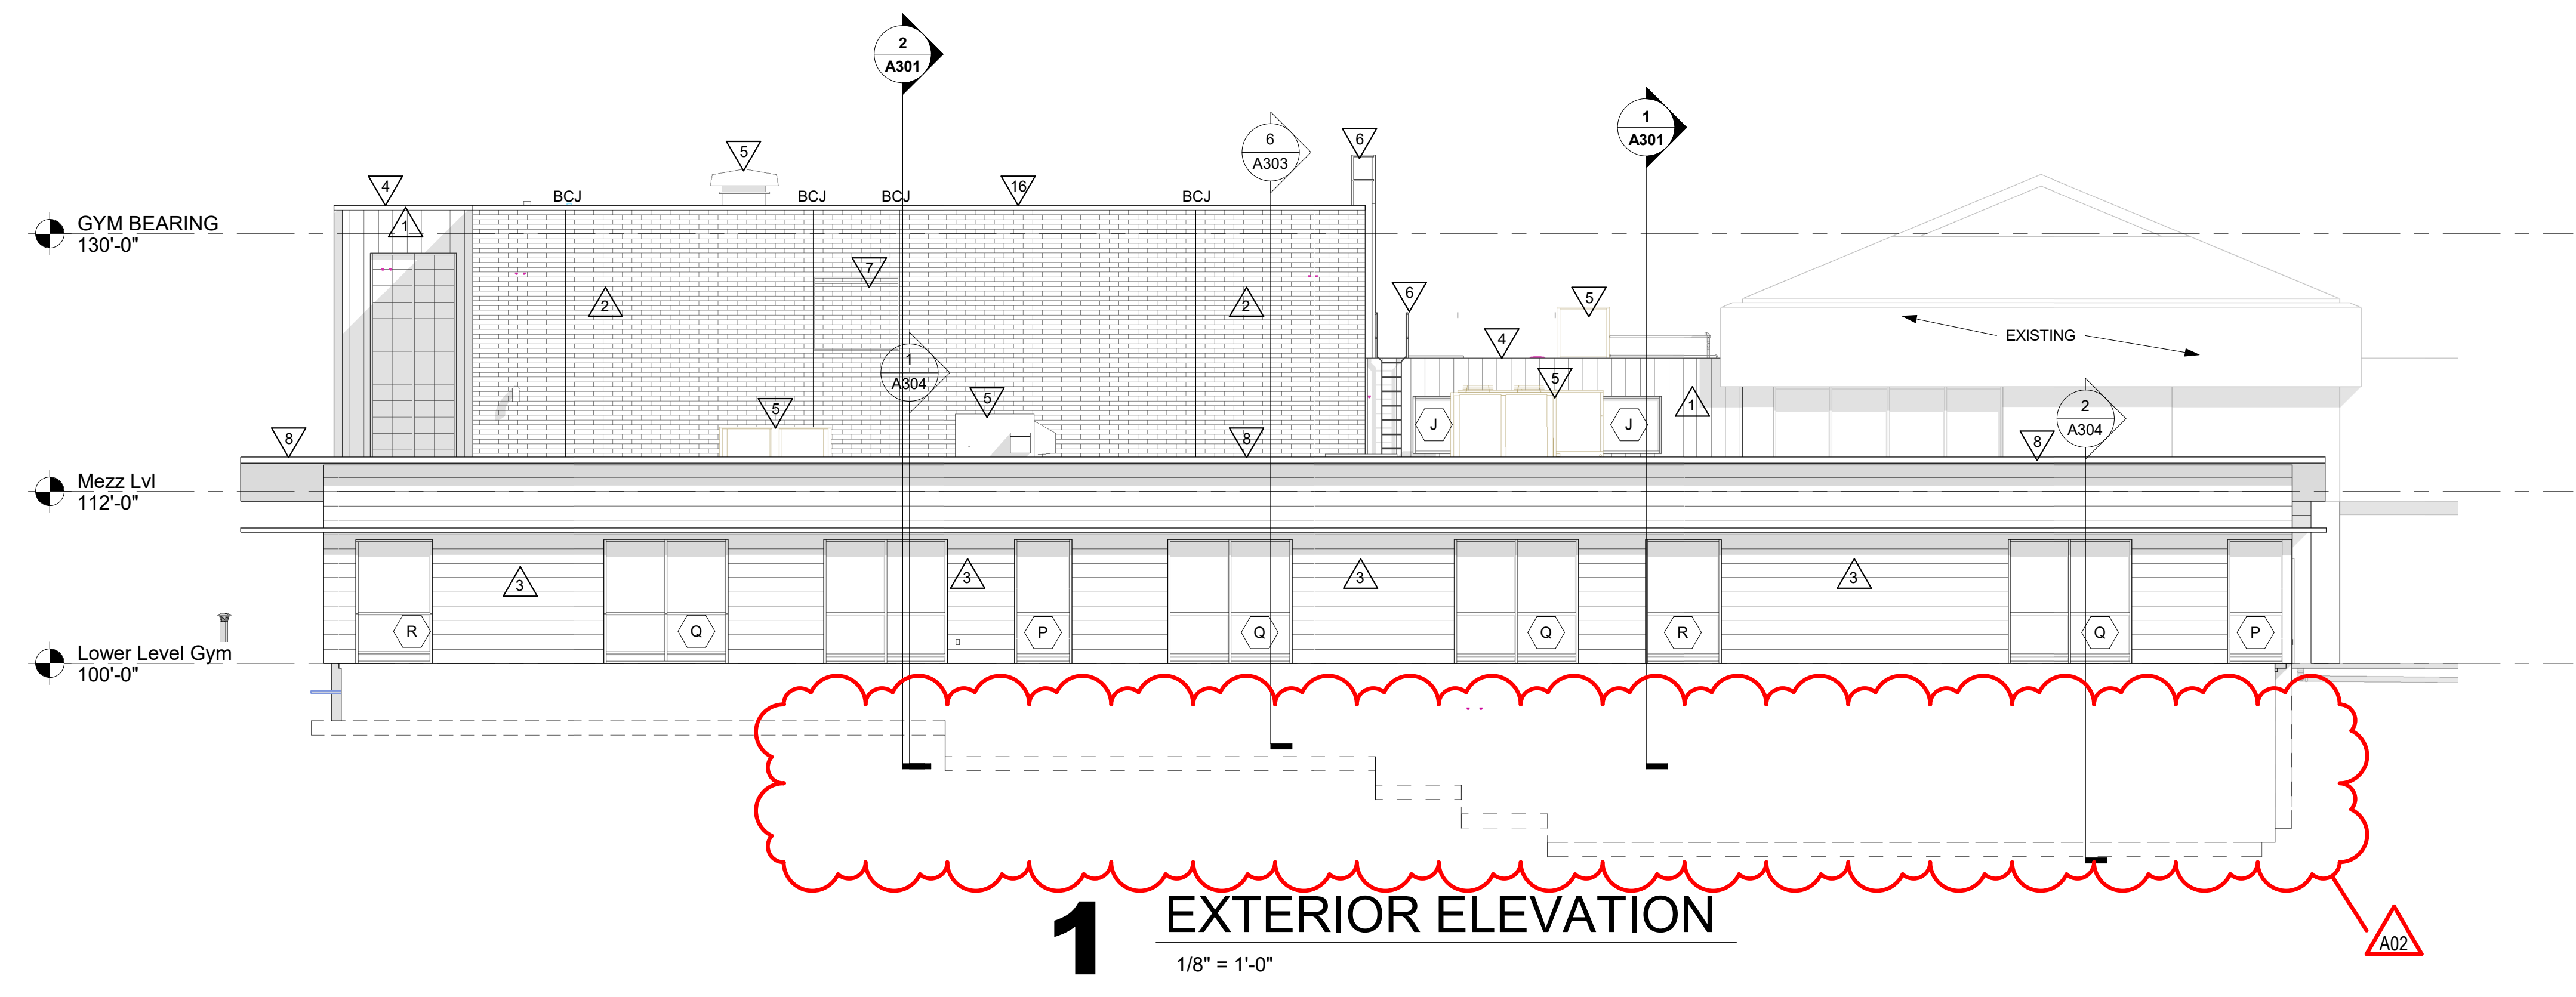



Consultant:

ENGINEER CERTIFICATION
I hereby certify that this Plan, Specification or Report was prepared by me or under my direct supervision and that I am a duly licensed Engineer under the laws of the state of Minnesota.
Date: July 9, 2019 Lic. No. 113131
This drawing is conditionally issued and reproduction or use of any technical design information is strictly forbidden without written agreement from the responsible Engineer.

ARCHITECT CERTIFICATION
I hereby certify that this Plan, Specification or Report was prepared by me or under my direct supervision and that I am a duly licensed Architect under the laws of the state of Minnesota.
Date: July 9, 2019 Lic. No. 58867
This drawing is conditionally issued and reproduction or use of any technical design information is strictly forbidden without written agreement from the responsible Architect.


Project Title: LANESBORO PUBLIC SCHOOLS ADDITION & REMODEL
Project Location: 204 KIRKWOOD ST EAST LANESBORO, MN 55949
Sheet Title: INTERIOR ELEVATIONS

HSR Project Number: 18063
Project Date: 7-25-19
Drawn By: HSR


No.	Description	Date
A02	ADDENDUM #02	8-19-19

Graphic Scale: VARIES
Last Update: 8/19/2019 3:24:23 PM


A206

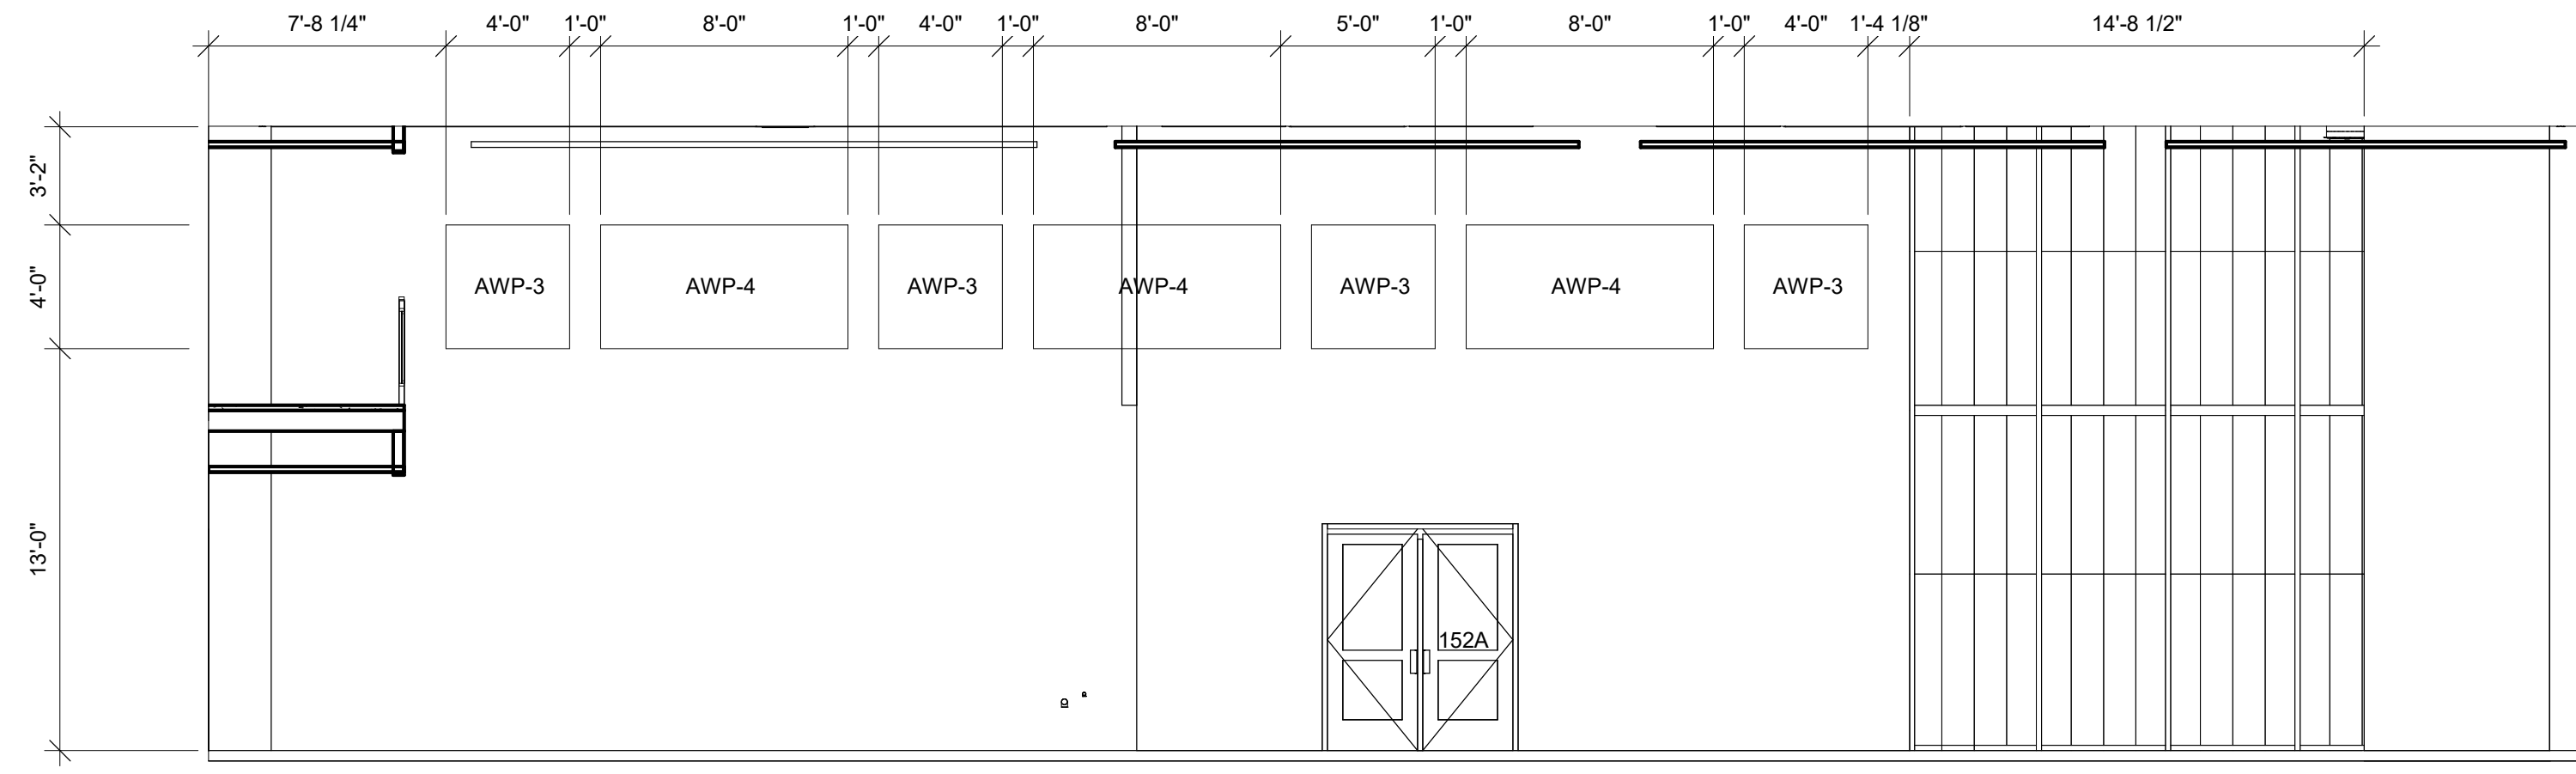


1 WEST ELEVATION - COMMONS
3/16" = 1'-0"

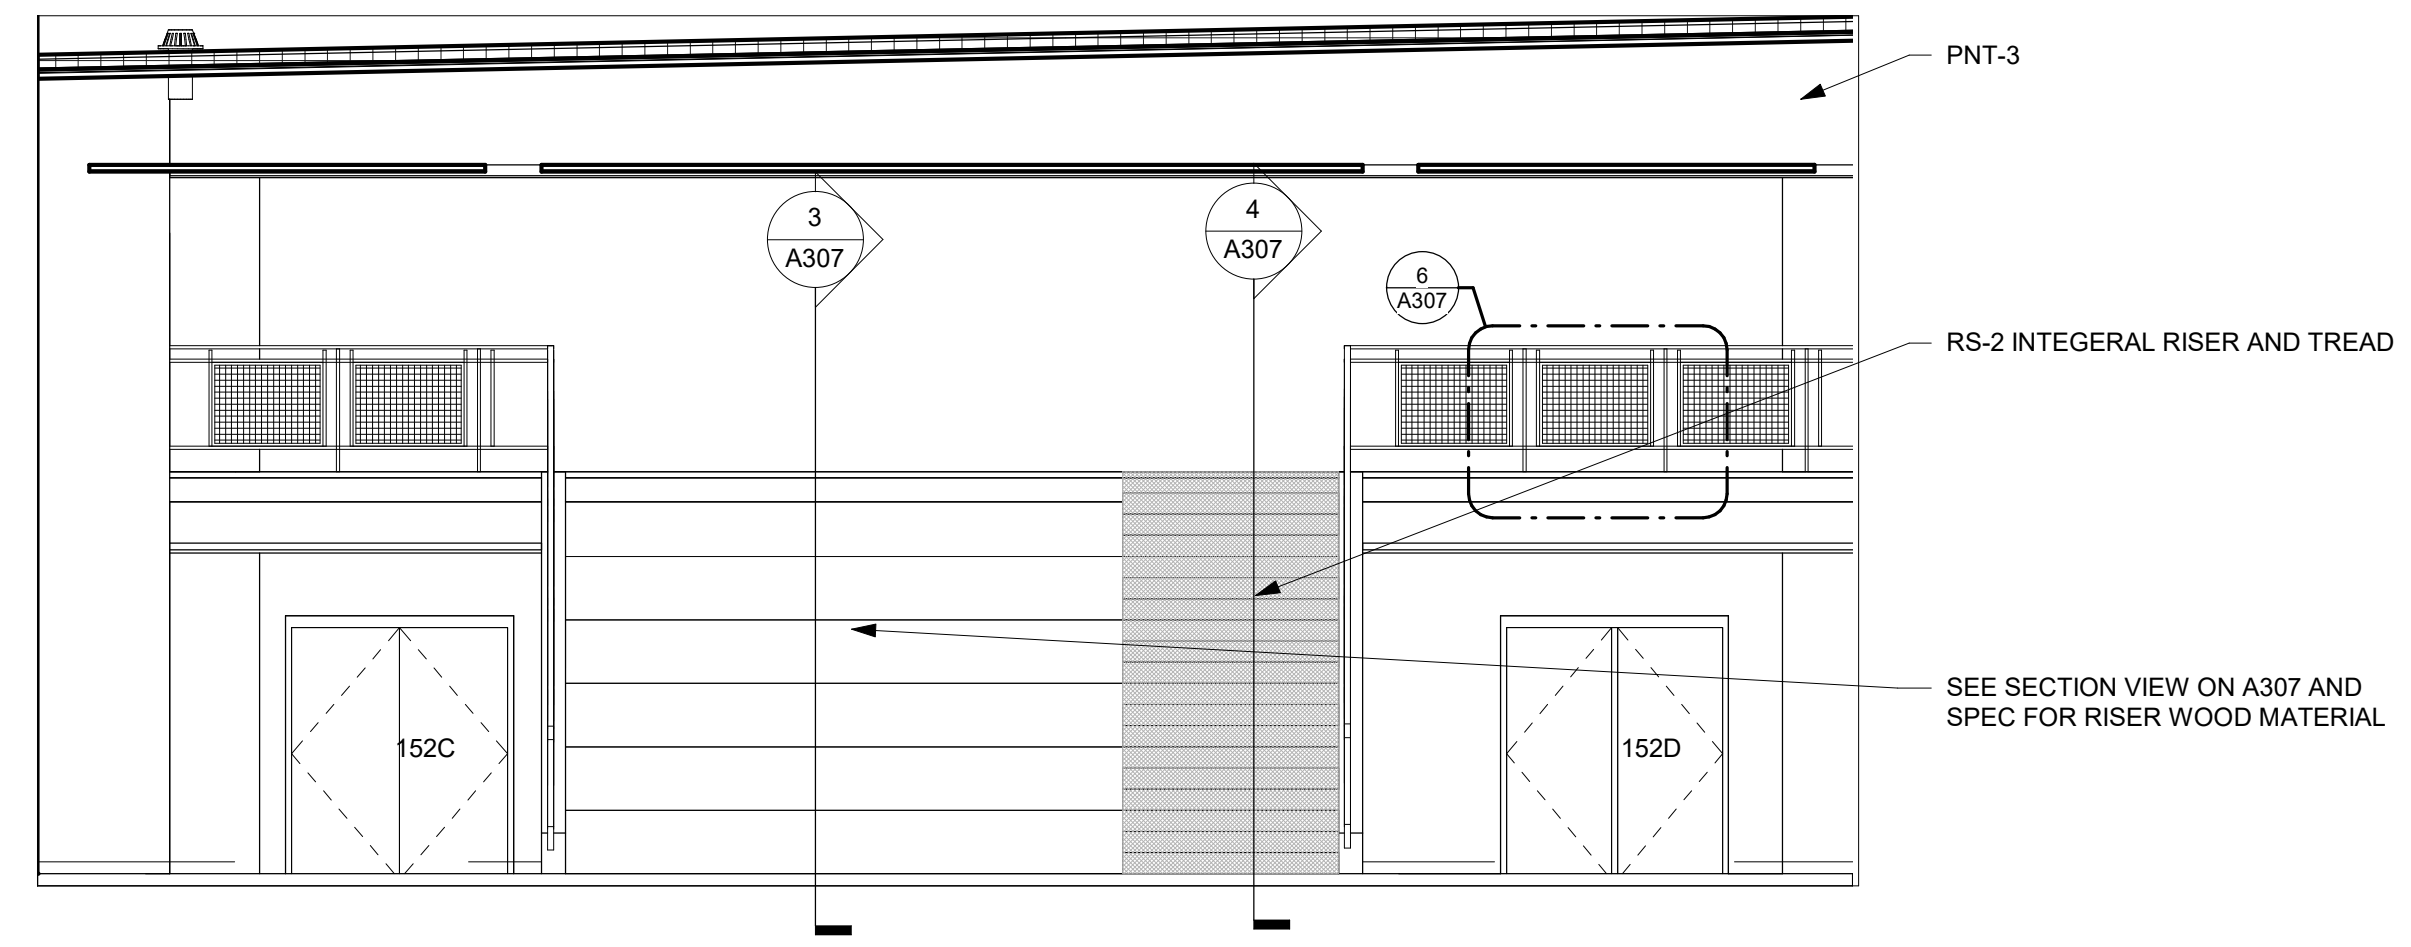


2 SOUTH ELEVATION - COMMONS
3/16" = 1'-0"

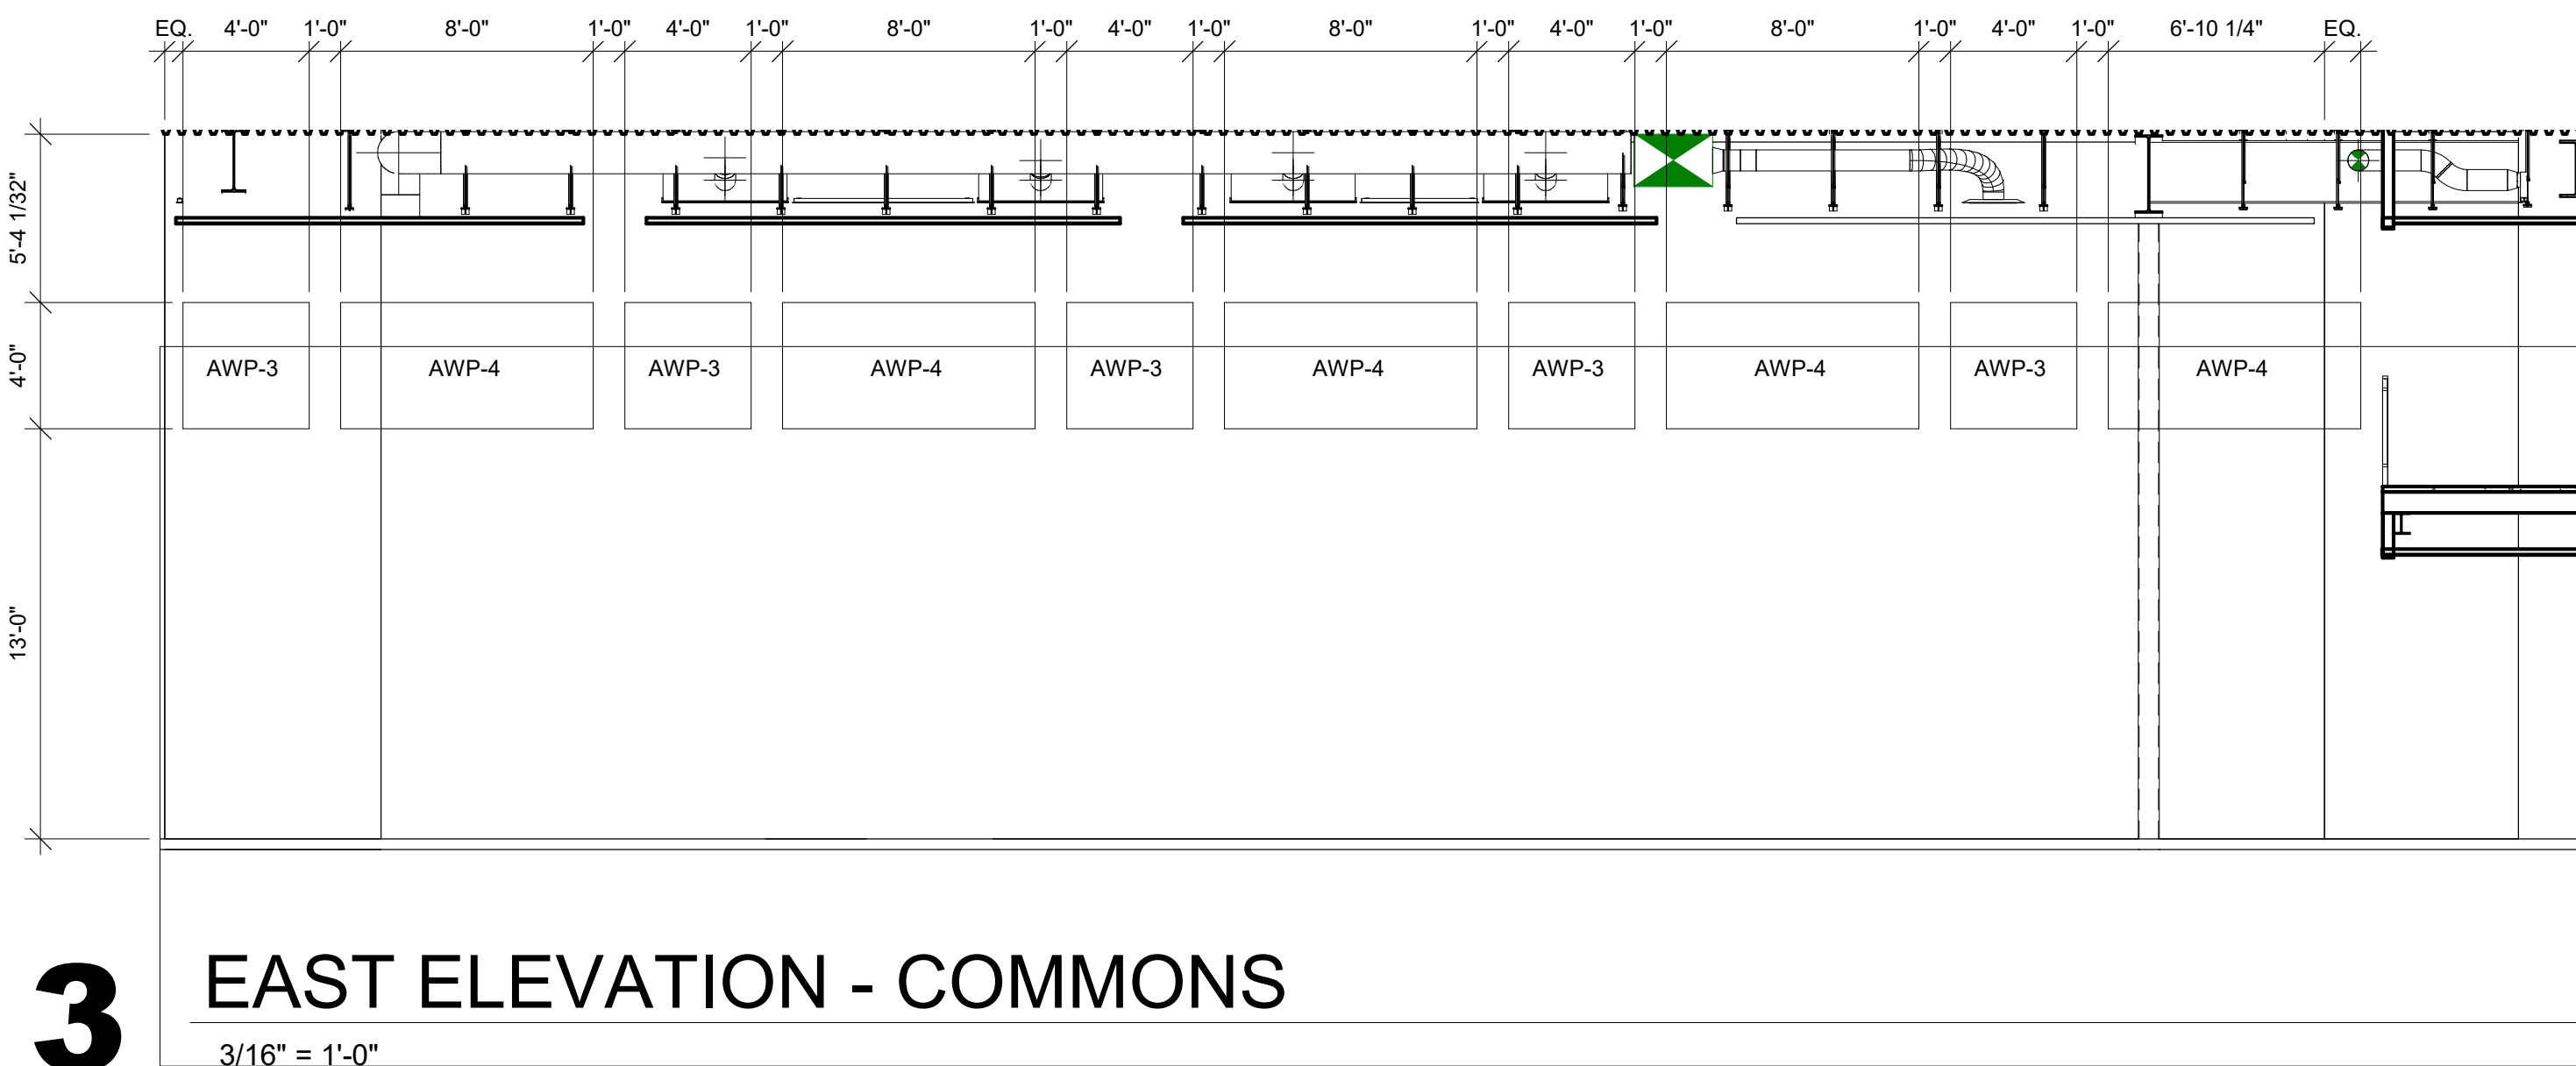


3 EAST ELEVATION - COMMONS
3/16" = 1'-0"

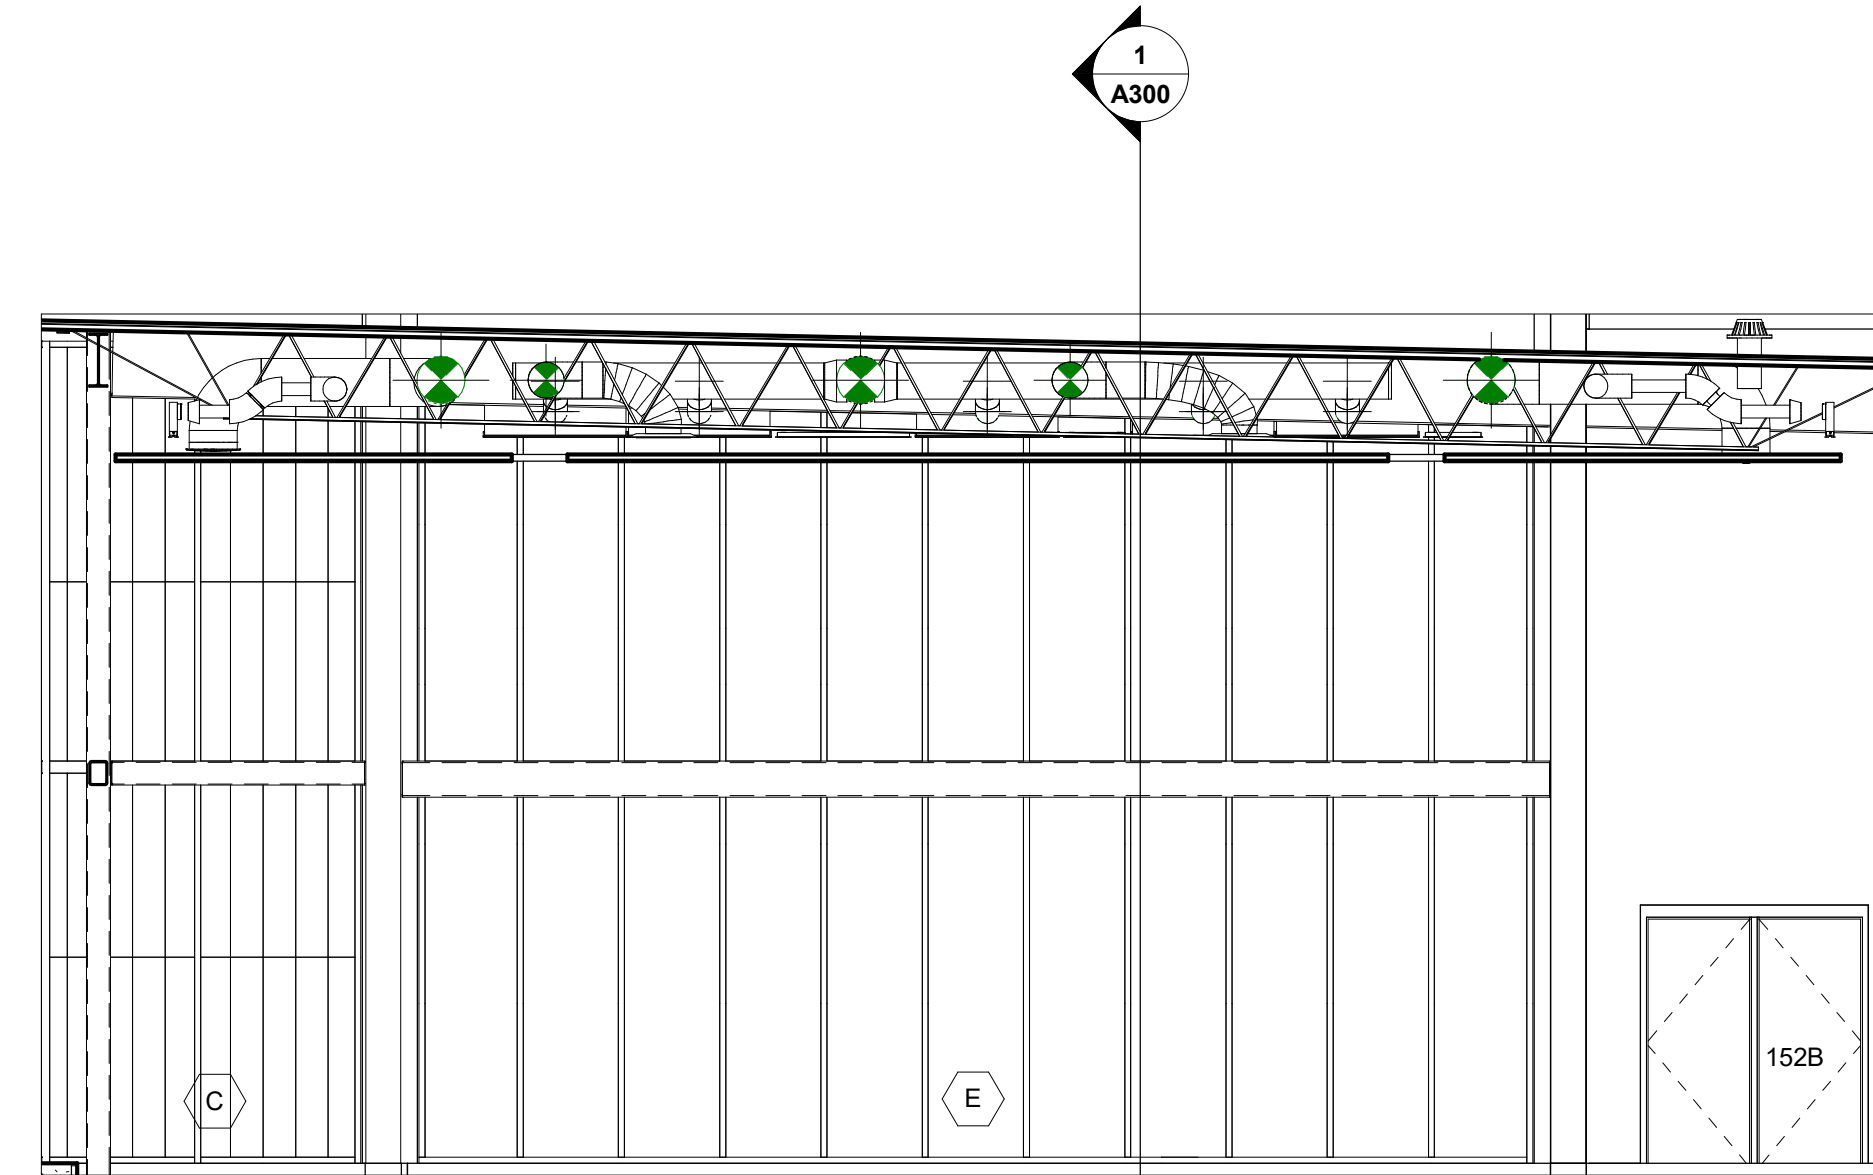


4 NORTH ELEVATION - COMMONS
3/16" = 1'-0"

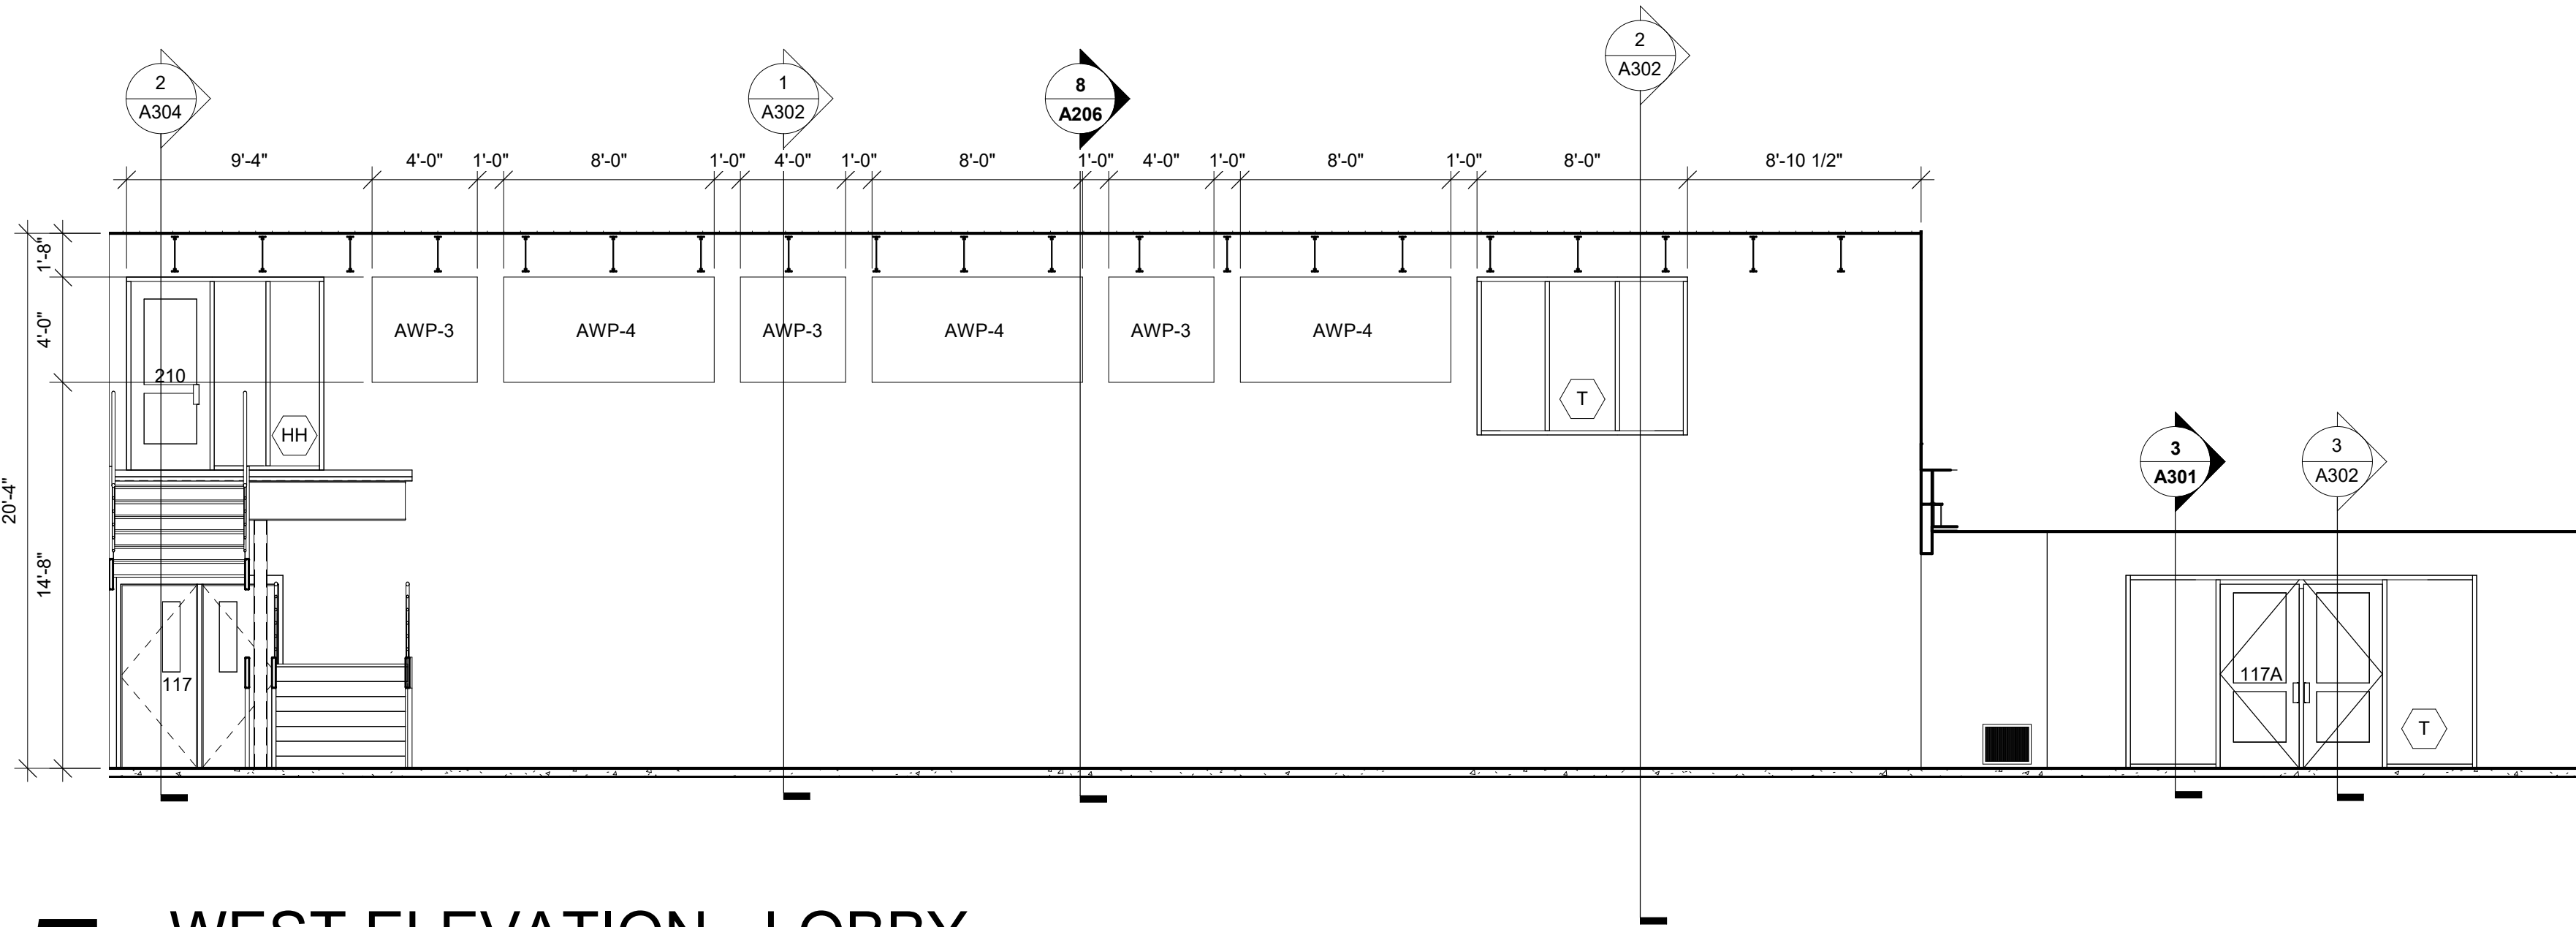


5 WEST ELEVATION - LOBBY
3/16" = 1'-0"

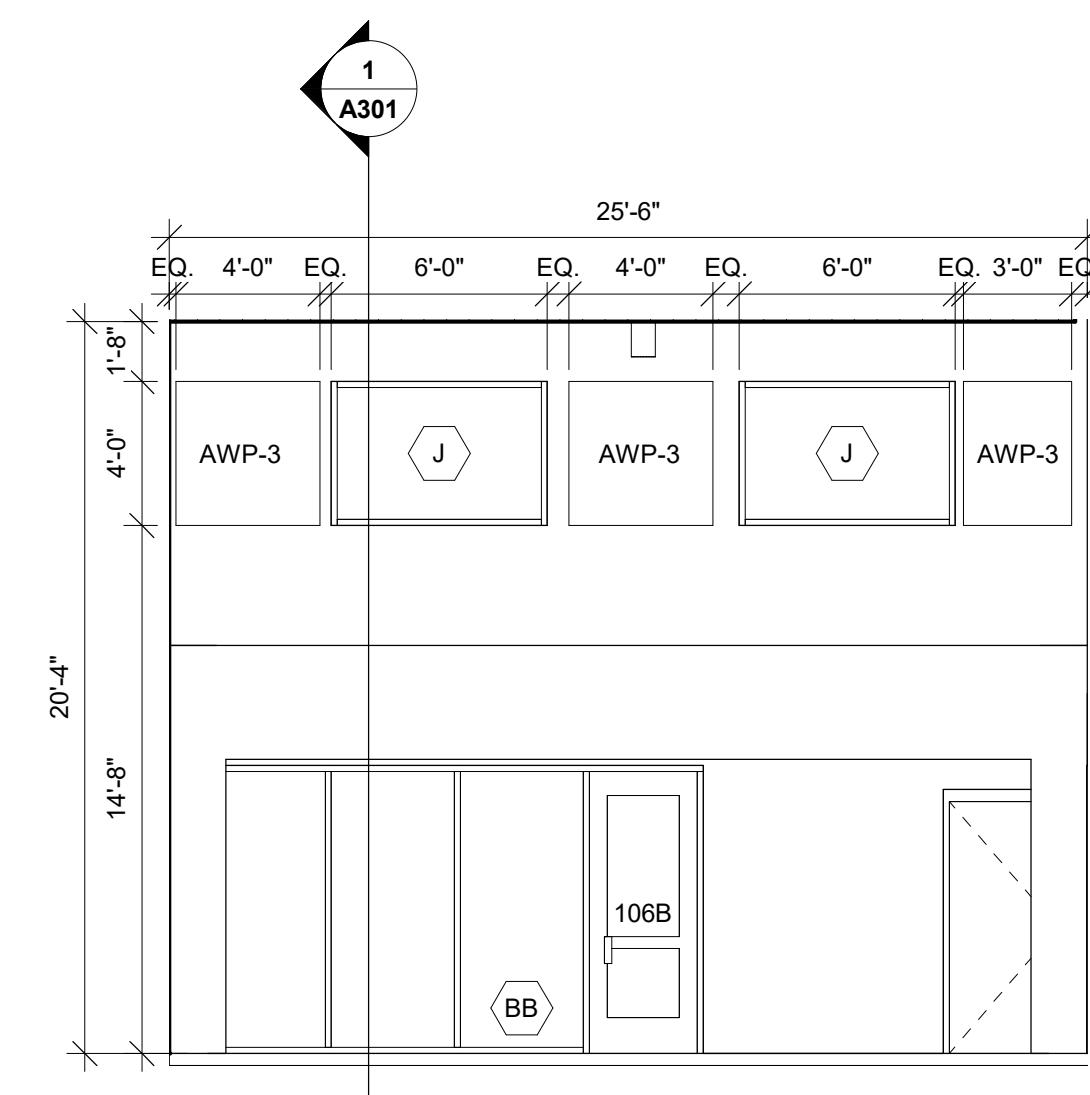

6 NORTH ELEVATION - LOBBY
3/16" = 1'-0"

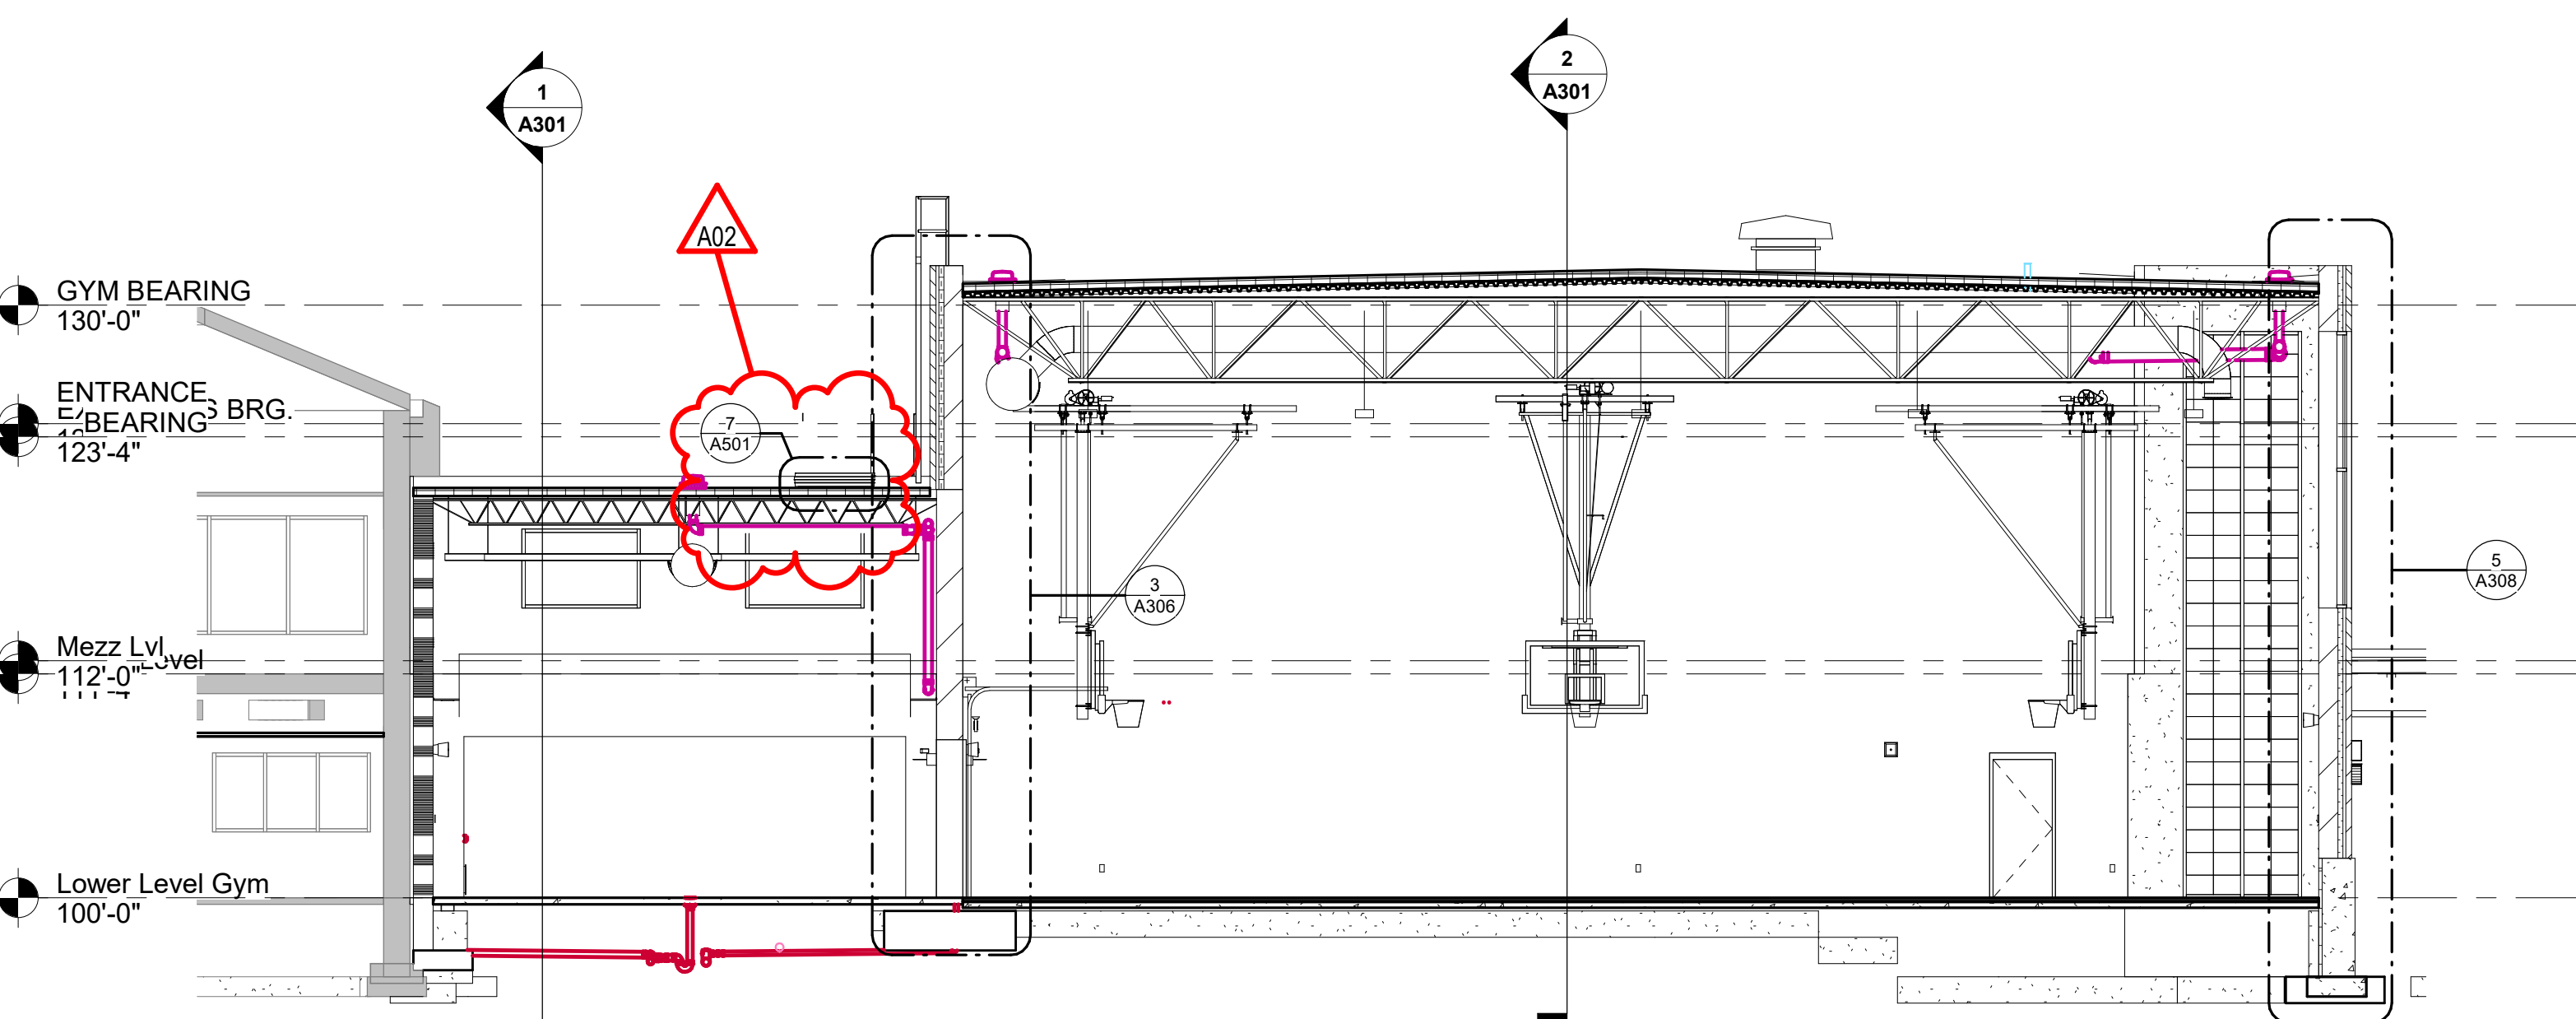


8 NORTH ELEVATION - HALLWAY/GYM
1/8" = 1'-0"

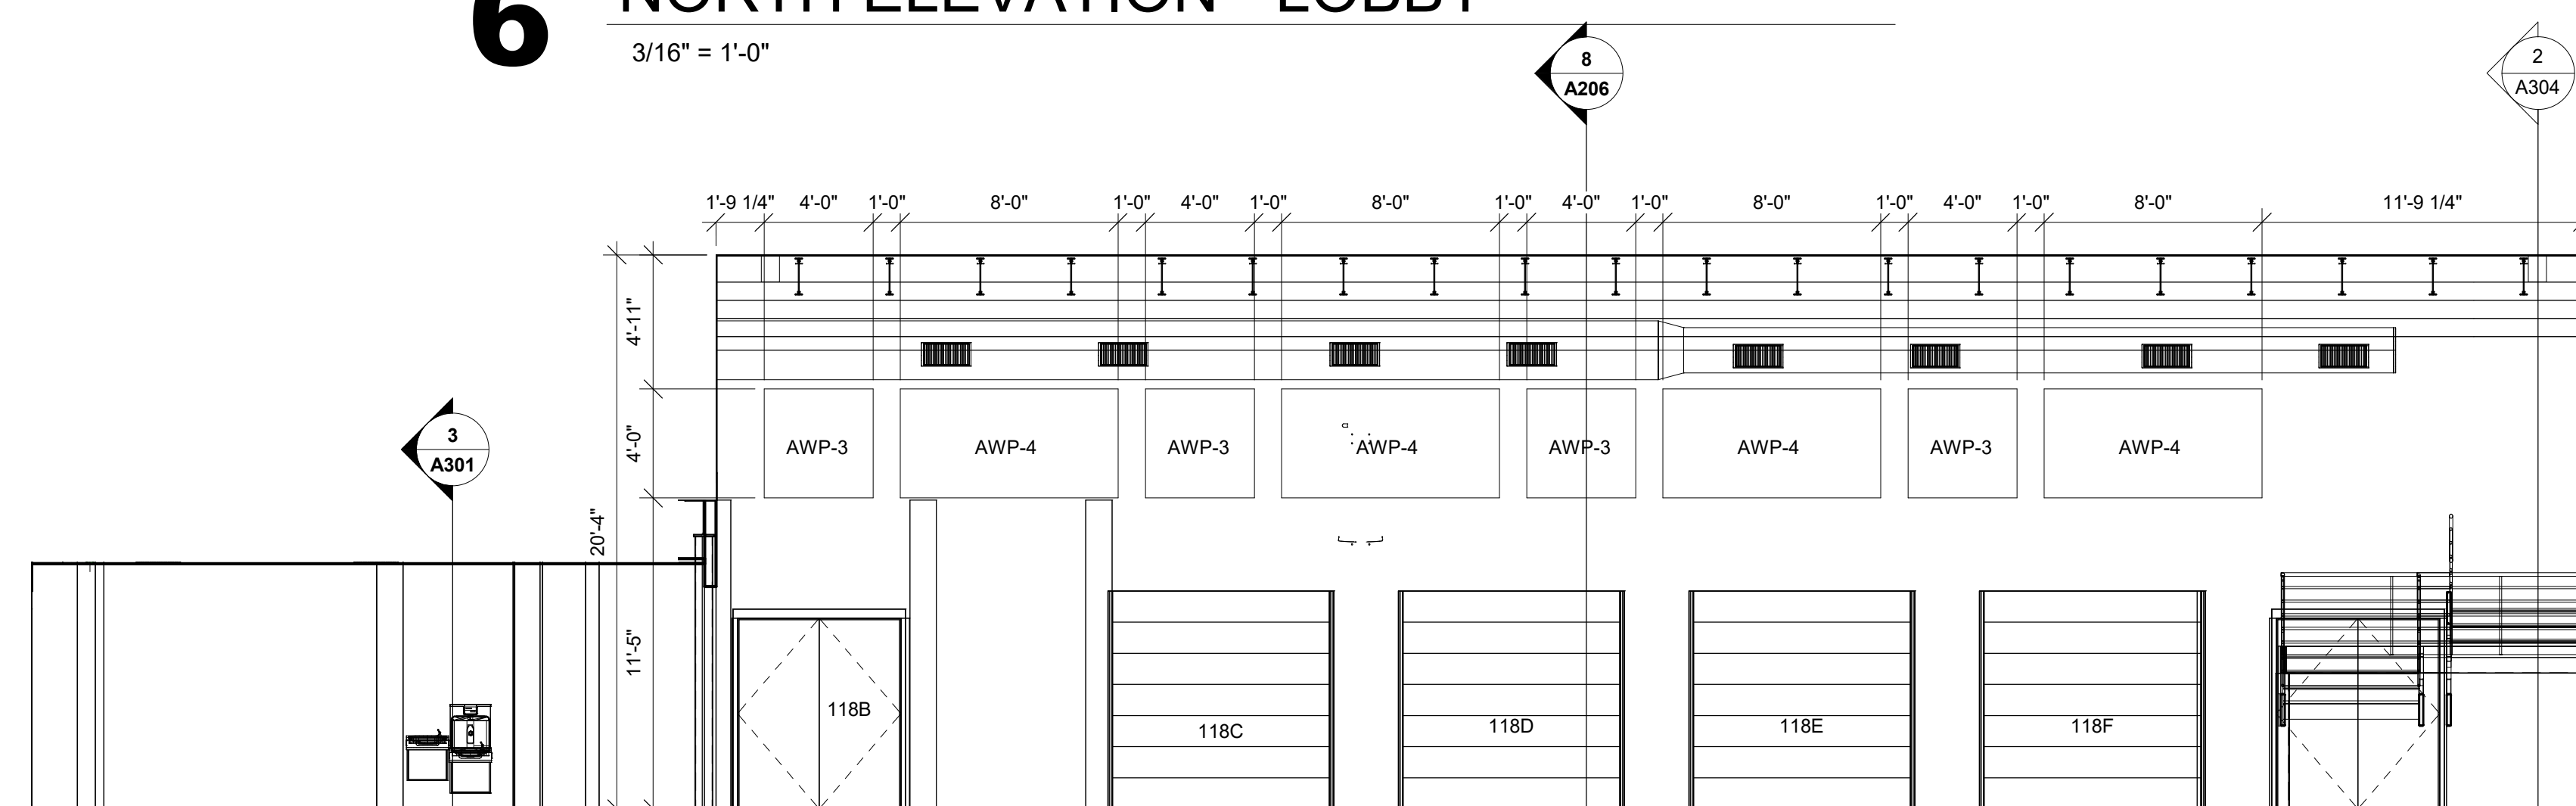


7 EAST ELEVATION - LOBBY
3/16" = 1'-0"


- CASEWORK GENERAL NOTES:**
- A SEE ELEVATIONS FOR LOCK LOCATIONS. ALL CABINET LOCKS TO BE KEVED ALIKE.
 - B PROVIDE FINISHED END PANELS AT ALL KNEE SPACE, ALCOVES, AND EXPOSED CABINET ENDS.
 - C CASEWORK MANUFACTURER TO FIELD VERIFY ALL CASEWORK DIMENSIONS & CONDITIONS PRIOR TO FABRICATION OF CASEWORK.
 - D INSTALL 1-1/2" WOOD BLOCKING BETWEEN STUDS FOR CASEWORK MOUNTING AT TOP AND BOTTOM OF ALL WALL CABINETS AND AT TOP OF ALL BASE CABINETS.
 - E ALL BASE CABINET KICKS, ALCOVES, KNEE SPACES AND END PANELS TO RECEIVE BASE UNLESS OTHERWISE NOTED. SEE MASTER COLOR SCHEDULE FOR SIZES AND COLOR.
 - F TYPICAL FINISH AT ALL HARDWARE: WIRE PULLS, HINGES, ETC SHALL BE BRUSHED S.S.
 - G SEAL EDGE OF COUNTER/BACKSPLASH TO ALL WALL LOCATIONS W/ CLEAR SEALANT.
 - H PROVIDE CORD GRIMMETS AT ALL WORK STATIONS - REFER TO ARCHITECTURAL PLANS FOR LOCATIONS.
 - I REFER TO MASTER COLOR SCHEDULE ON ID100 FOR PLASTIC LAMINATE SELECTIONS.

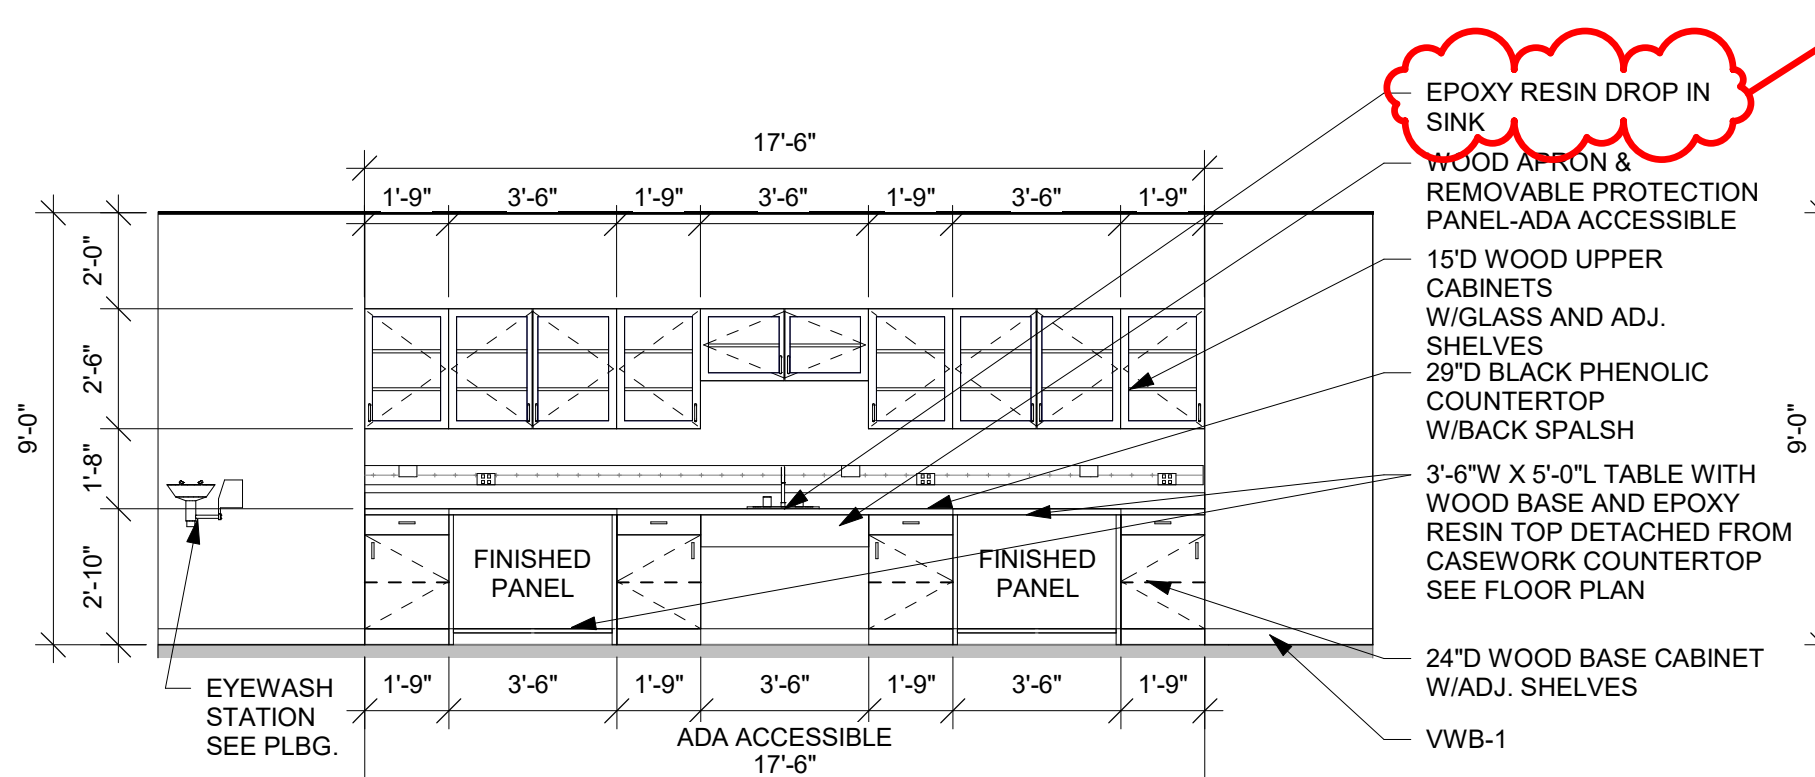


1 CW RM 218
1/4" = 1'-0"

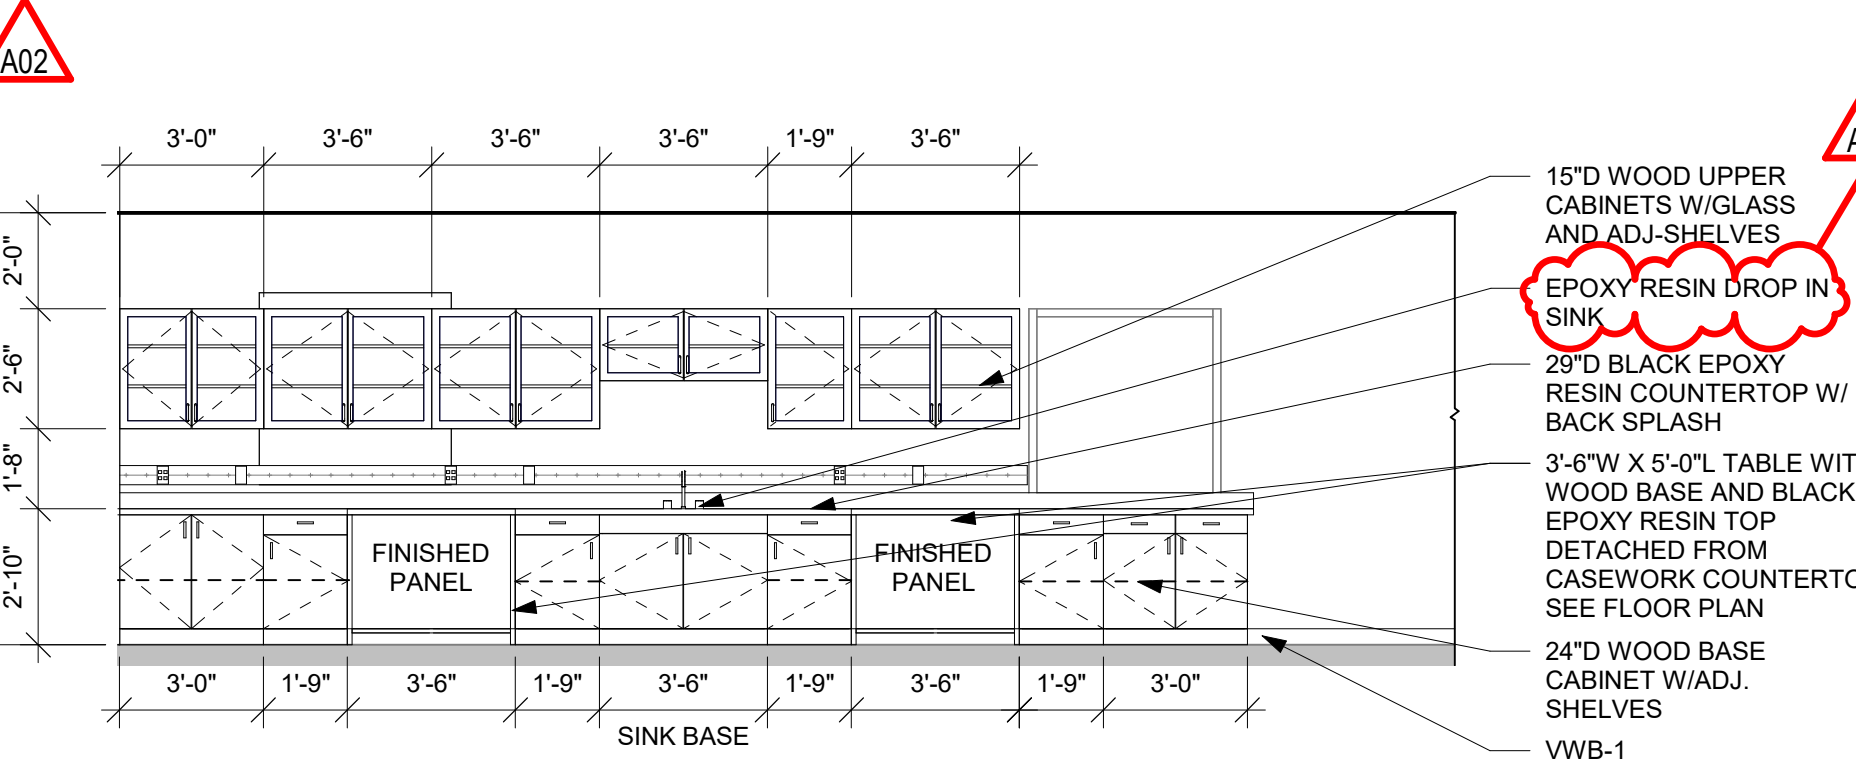


2 CW RM 218
1/4" = 1'-0"

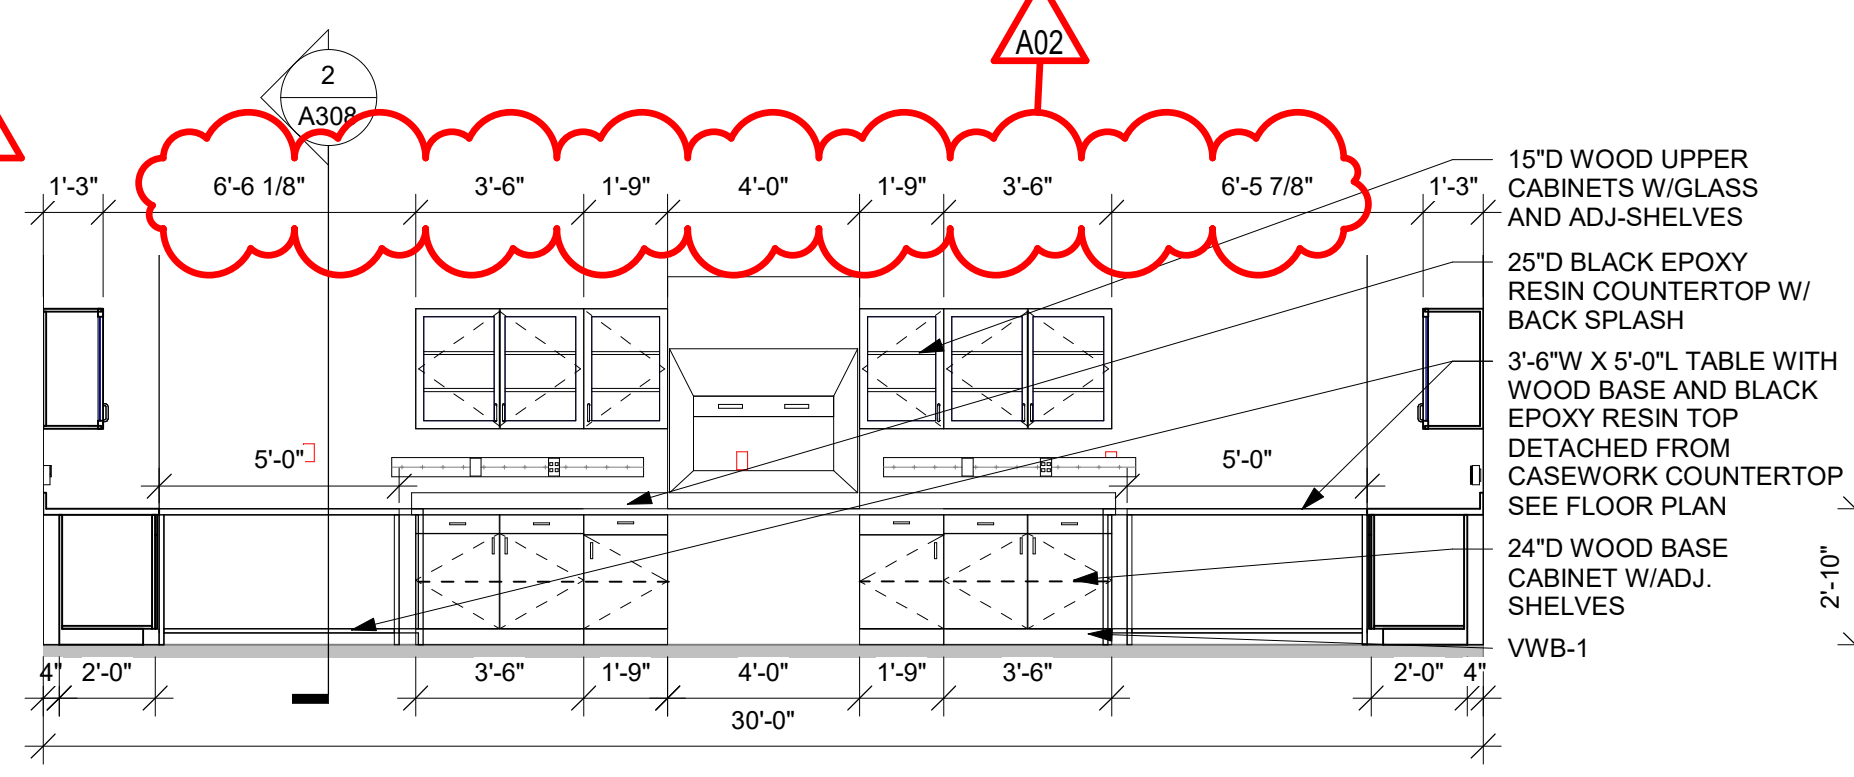


3 CW RM 218
1/4" = 1'-0"

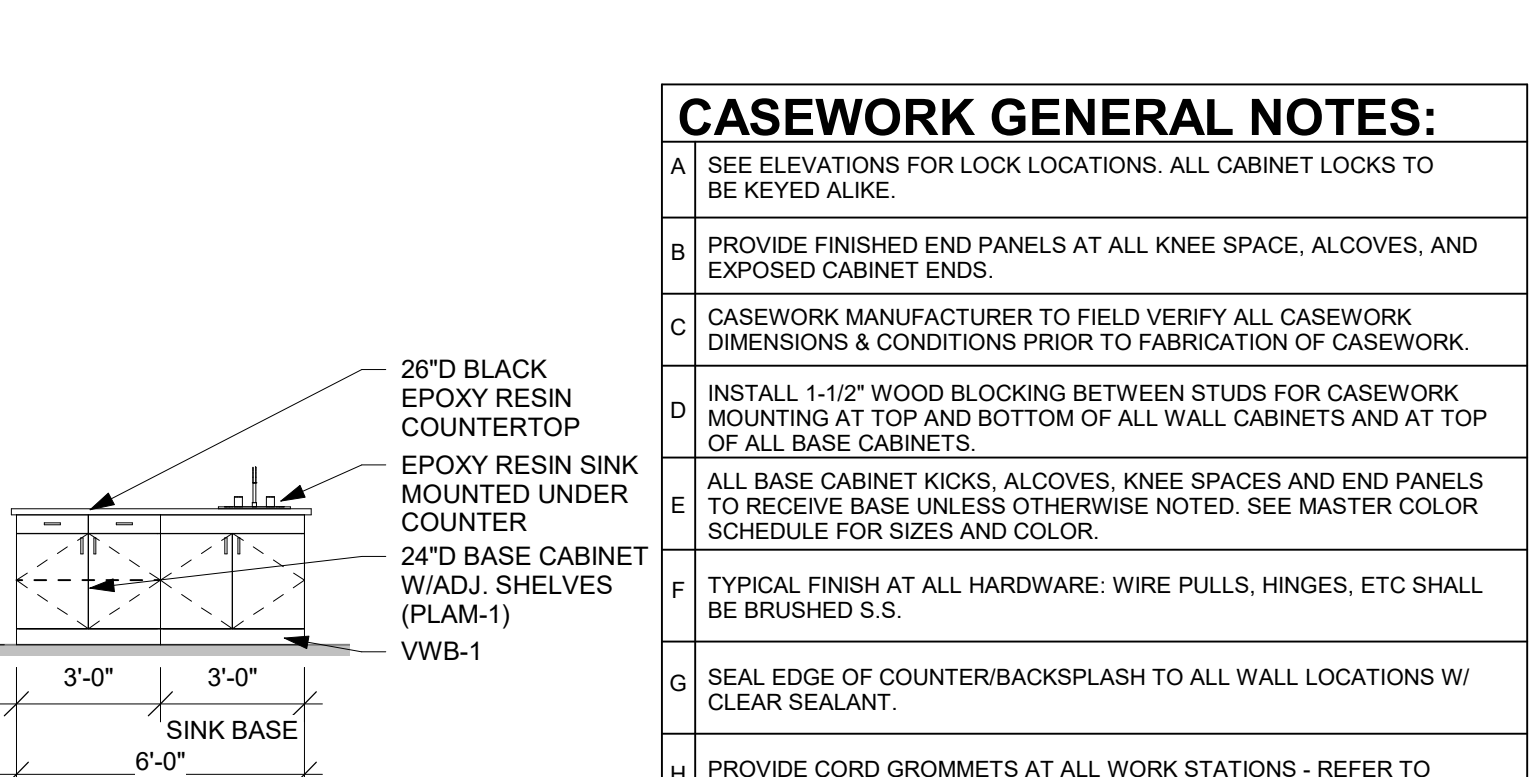


4 CW RM 218
1/4" = 1'-0"

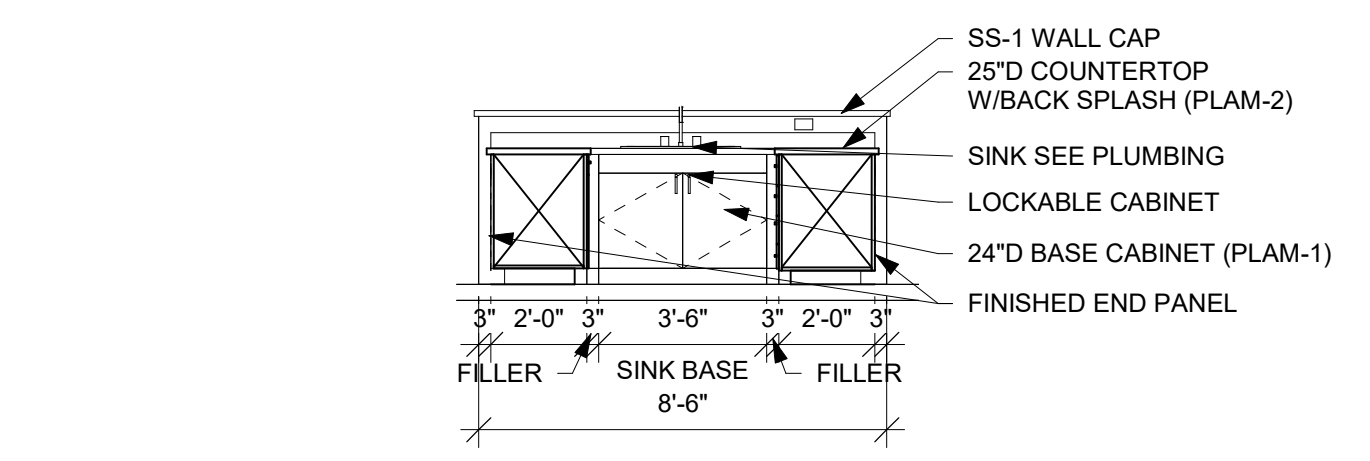


5 CW RM 108 +102
1/4" = 1'-0"

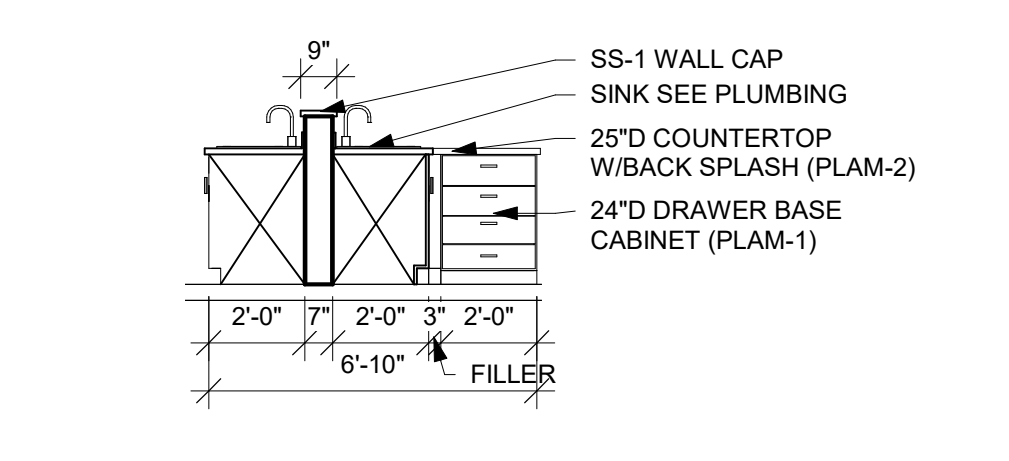


6 CW RM 108 +102
1/4" = 1'-0"

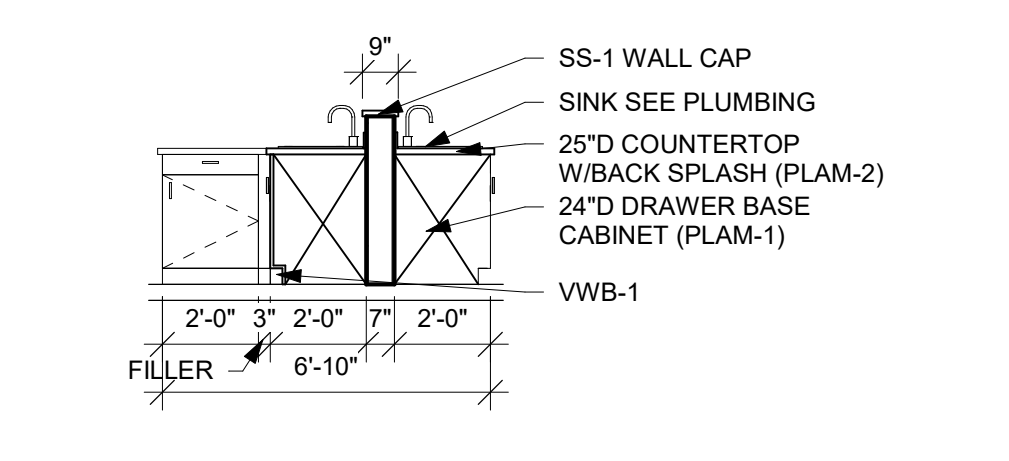


7 CW RM 108 +102
1/4" = 1'-0"

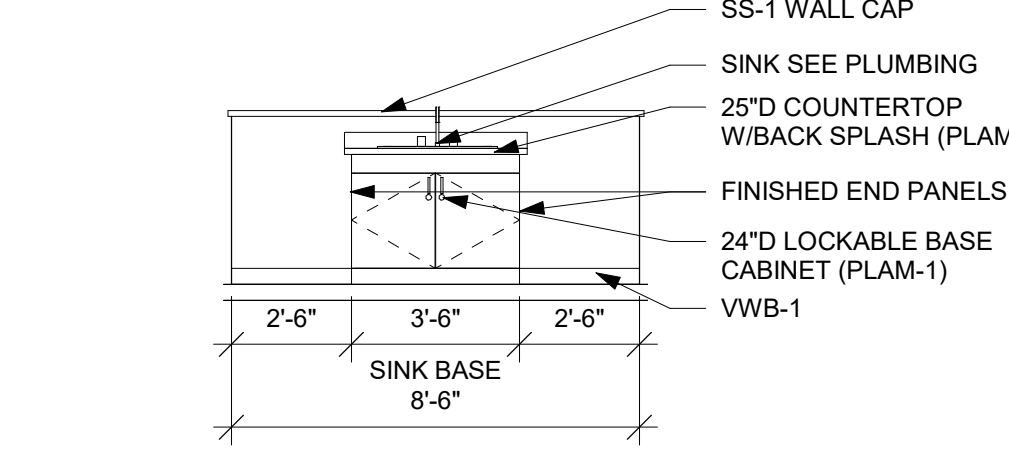


8 CW RM 108 +102
1/4" = 1'-0"

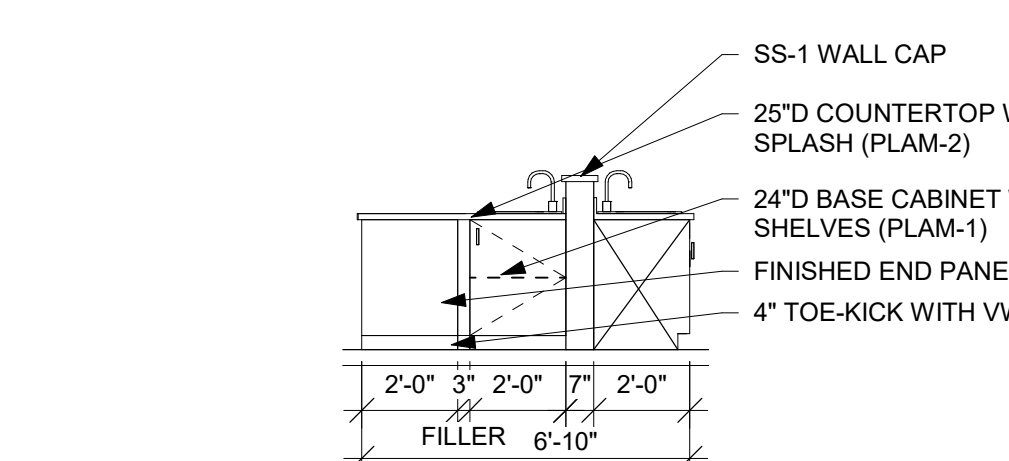


9 CW RM 108 +102
1/4" = 1'-0"

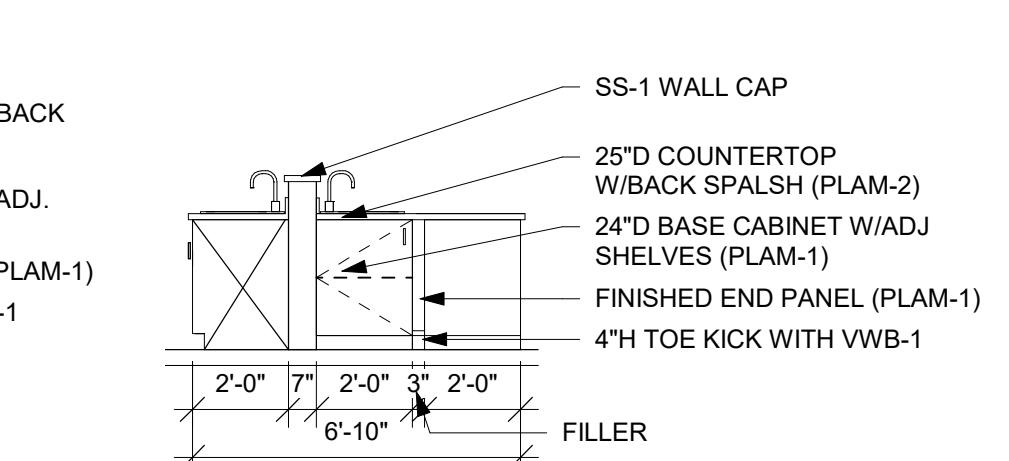


10 CW RM 108 +102
1/4" = 1'-0"

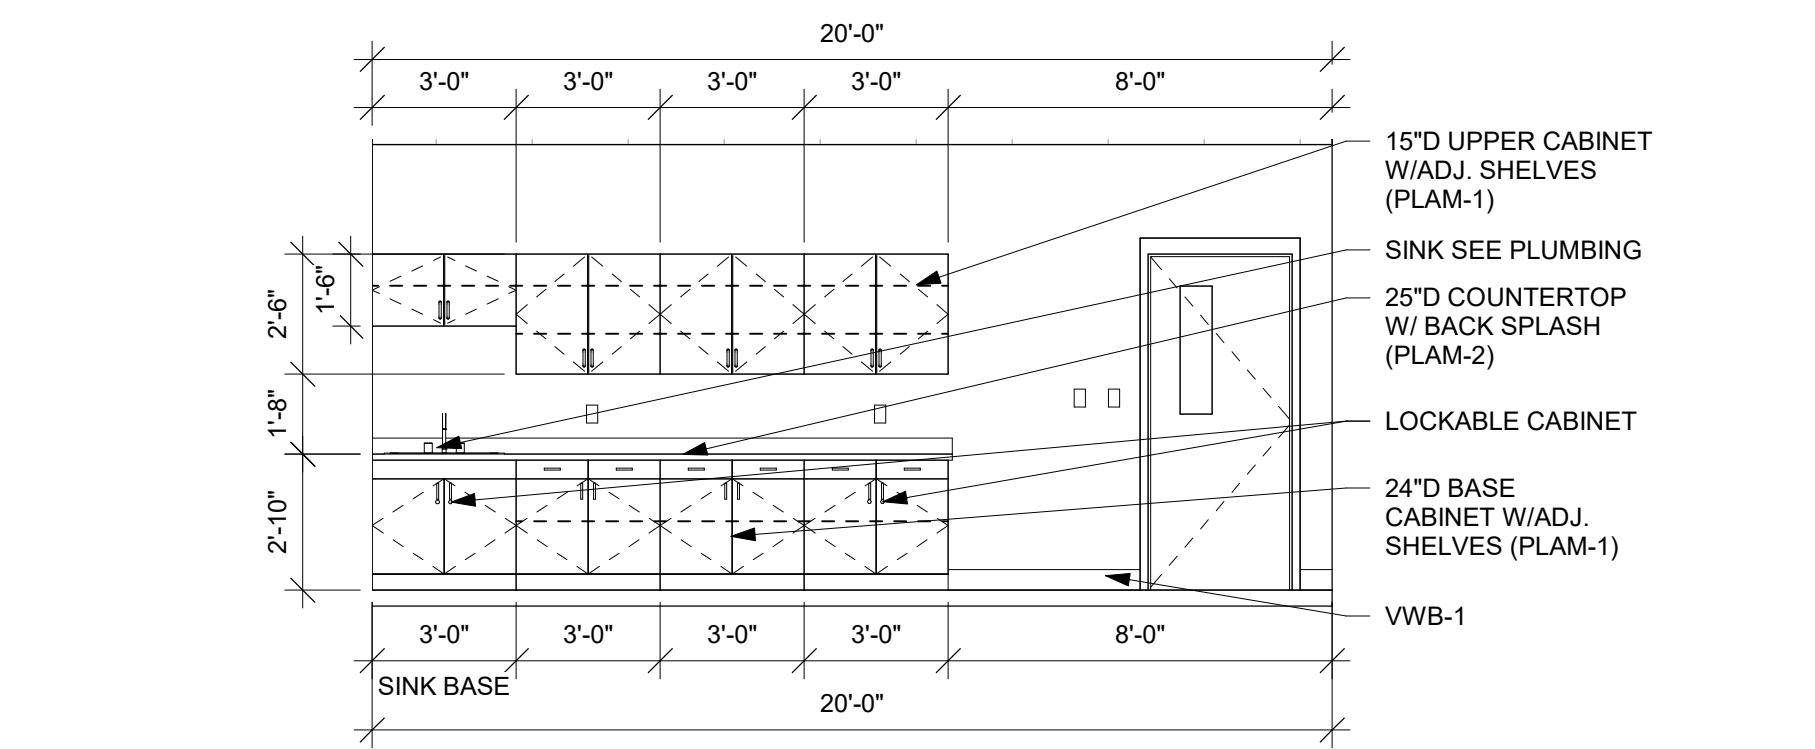


11 CW RM 110
1/4" = 1'-0"

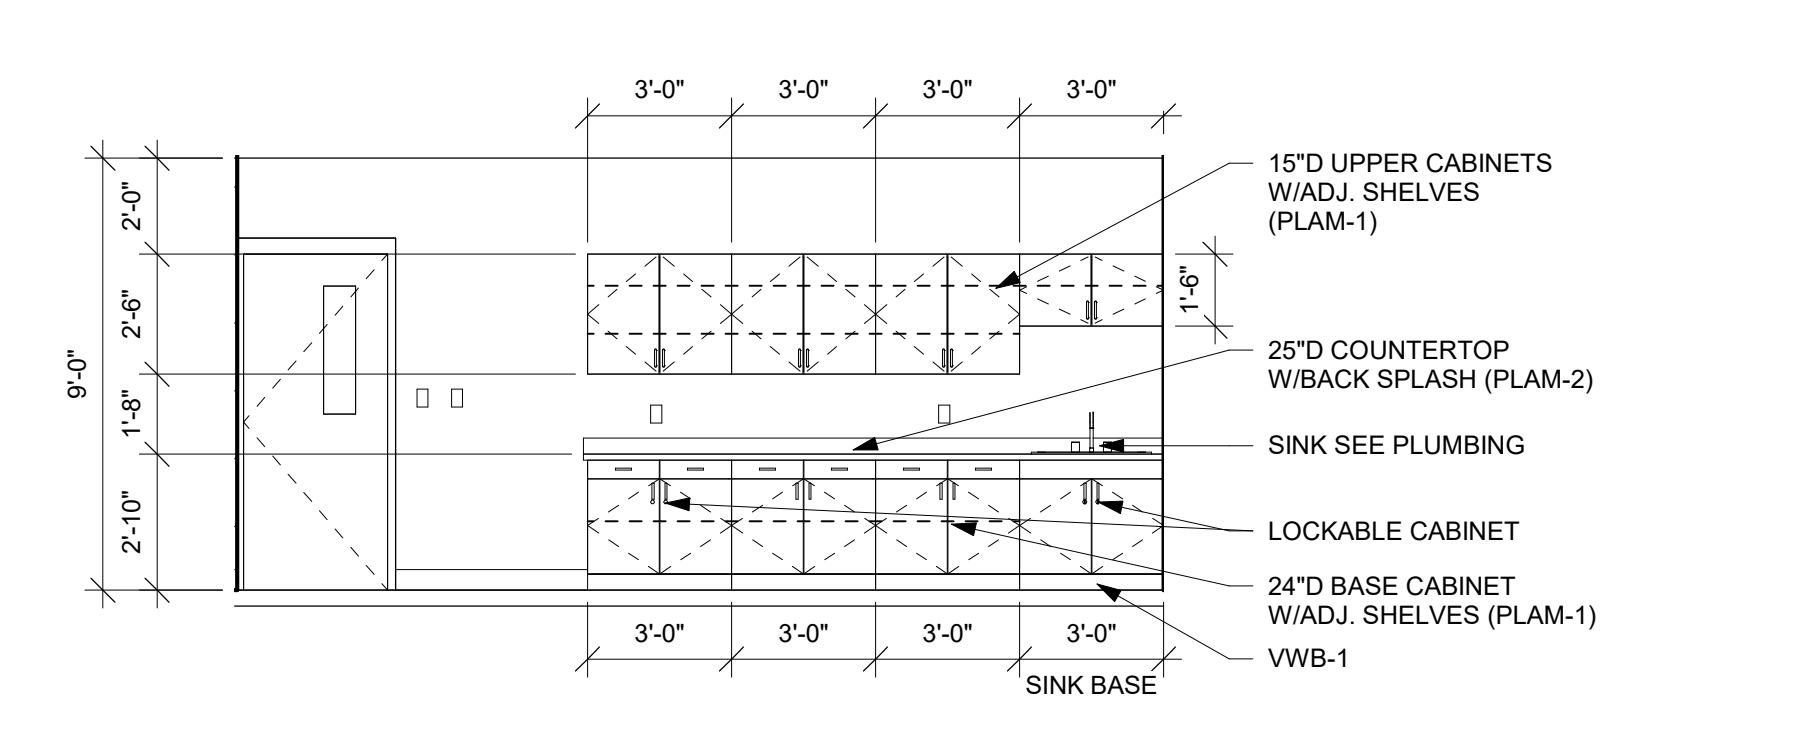


12 CW RM 112
1/4" = 1'-0"

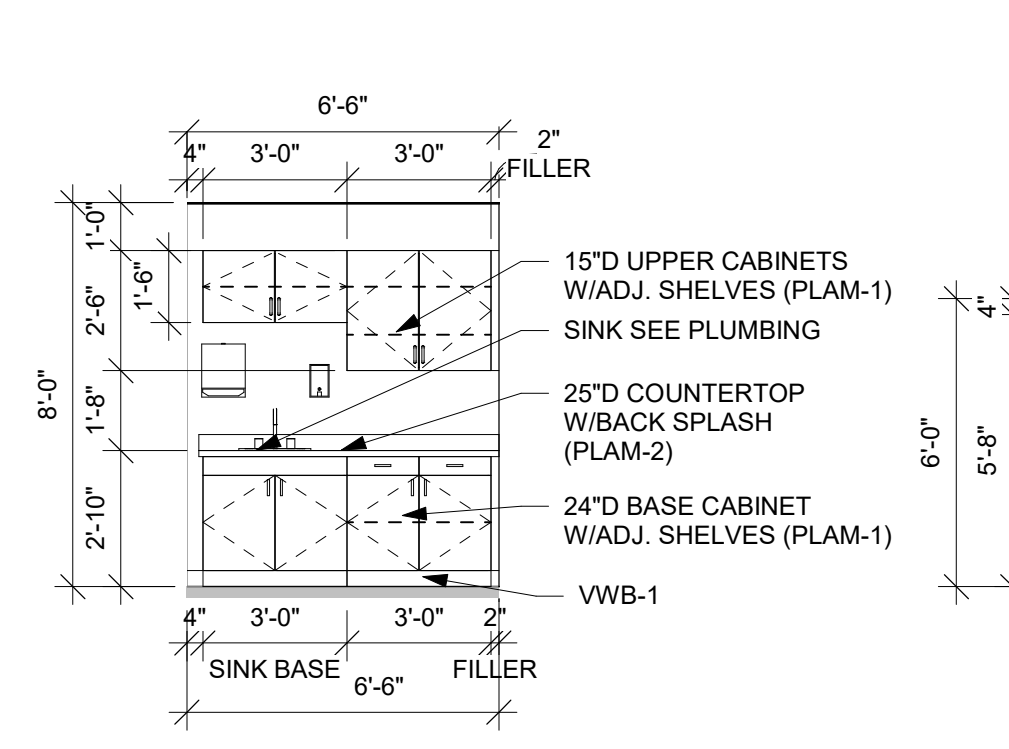


13 CW RM 201
1/4" = 1'-0"

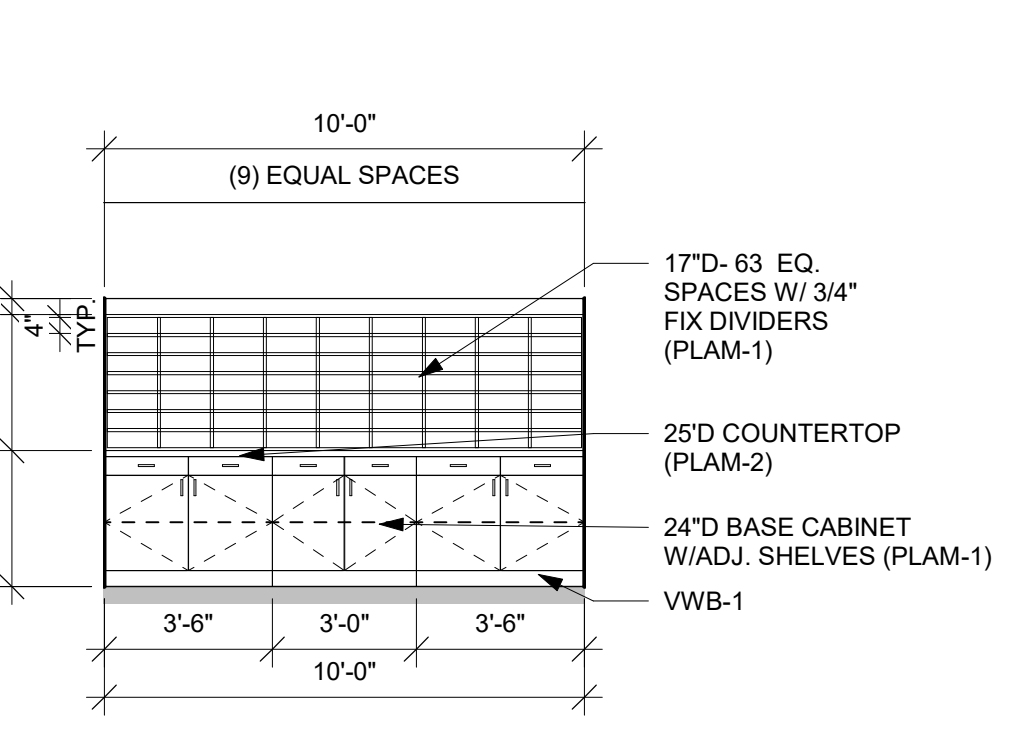


14 CW RM 201
1/4" = 1'-0"

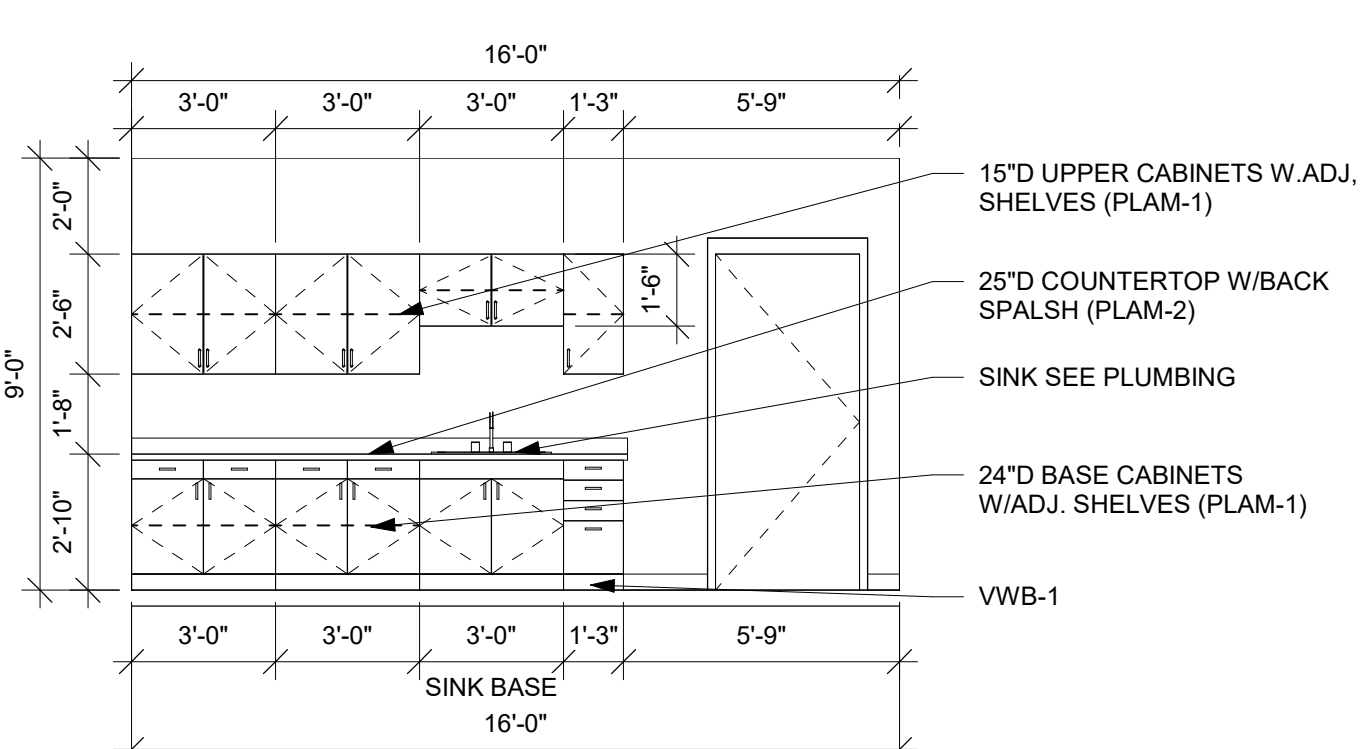


15 CW RM 107
1/4" = 1'-0"

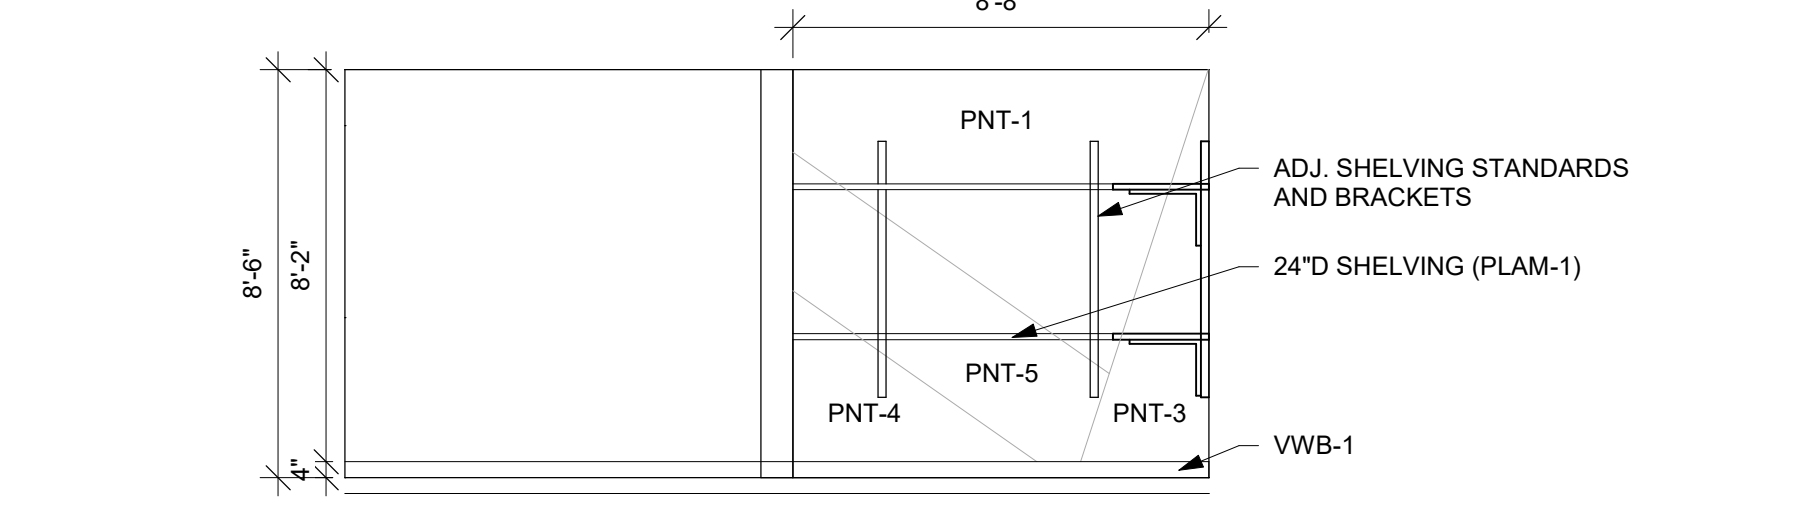


16 CW RM 140A
1/4" = 1'-0"

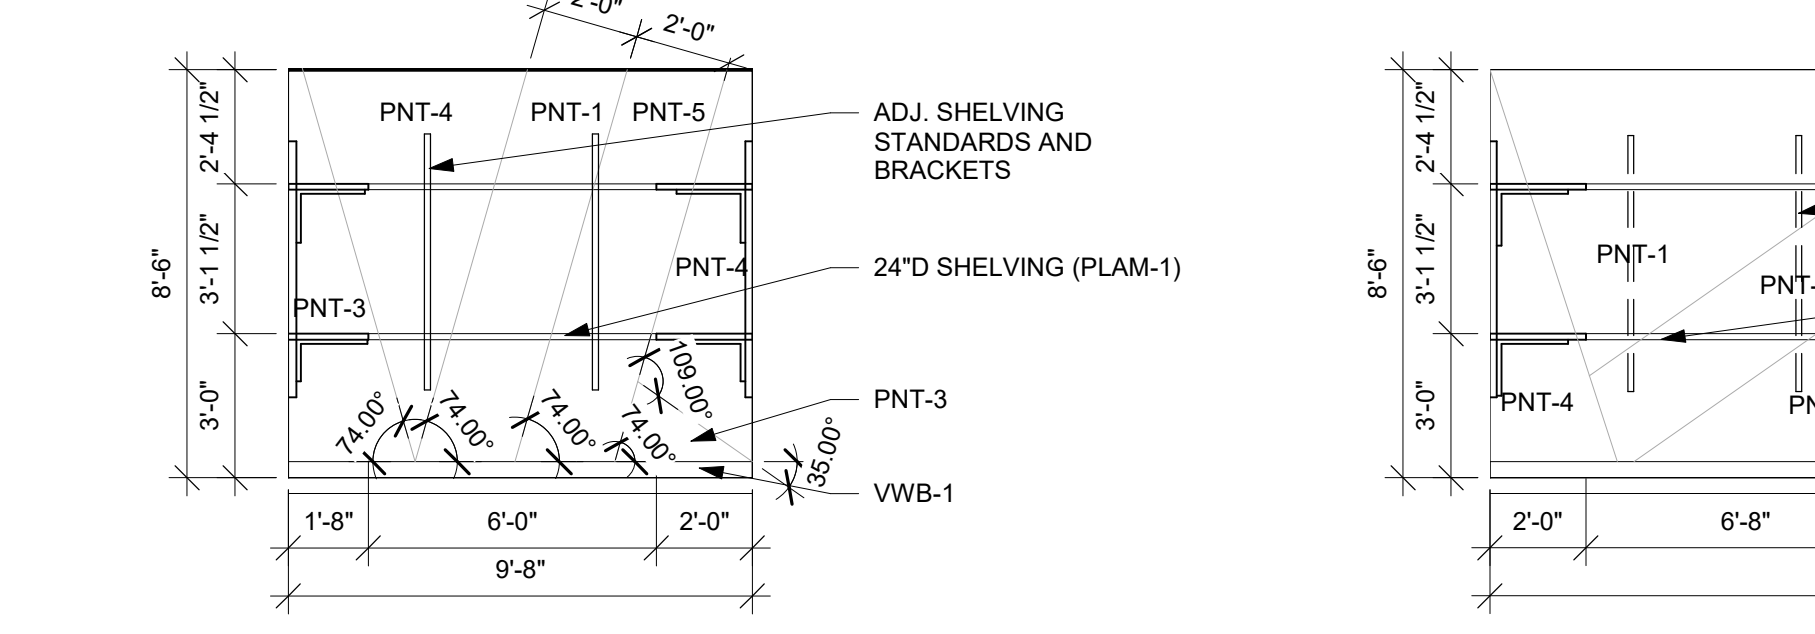


17 CW RM 140A
1/4" = 1'-0"

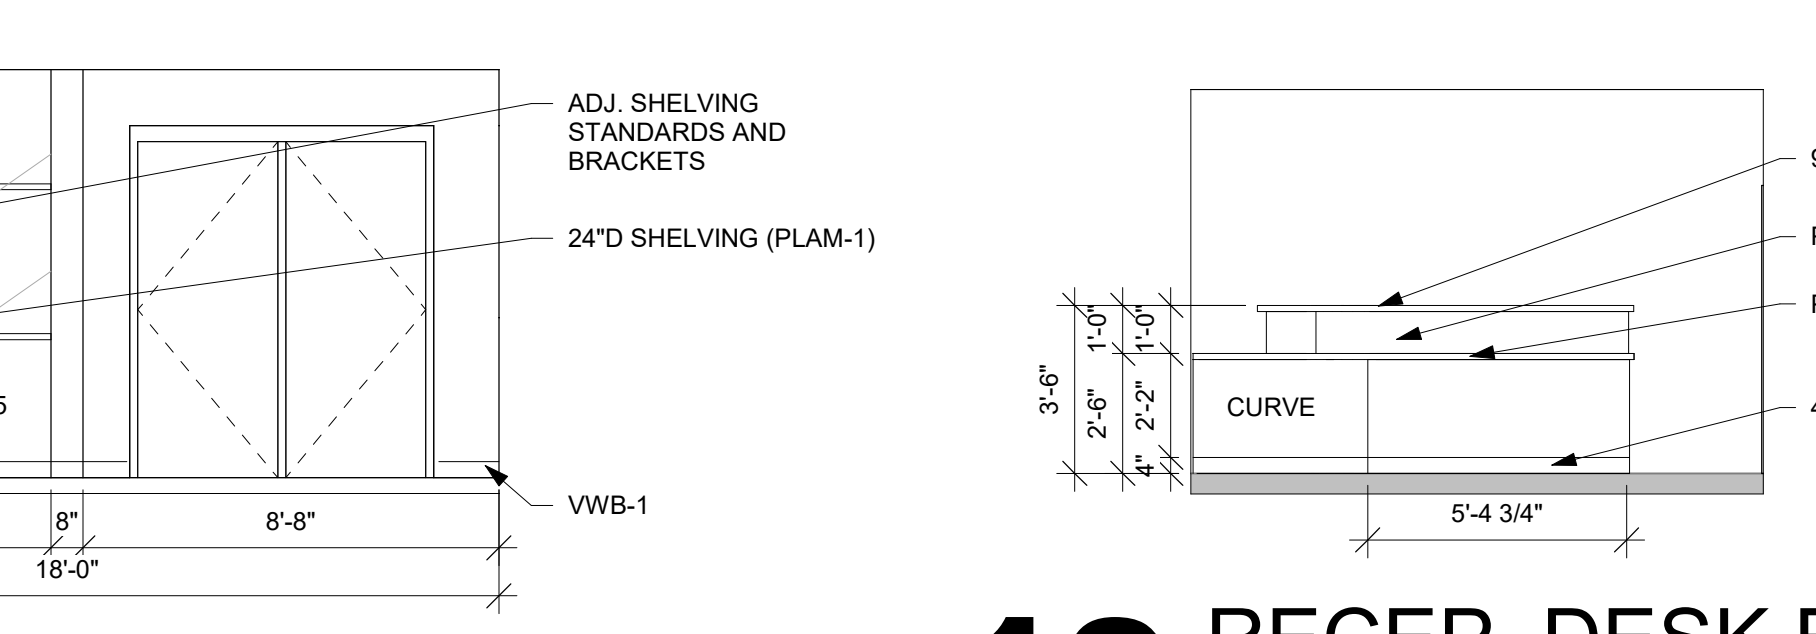


18 CW RM 140A
1/4" = 1'-0"

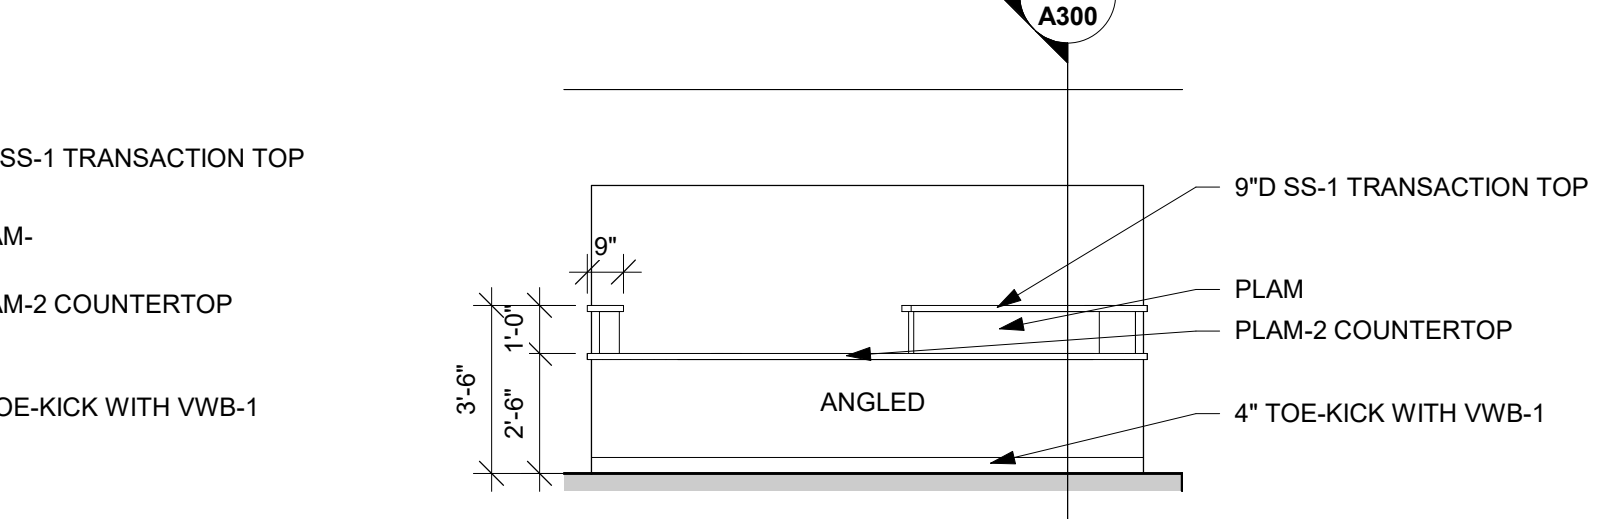


19 RECEP. DESK ELEV.
1/4" = 1'-0"

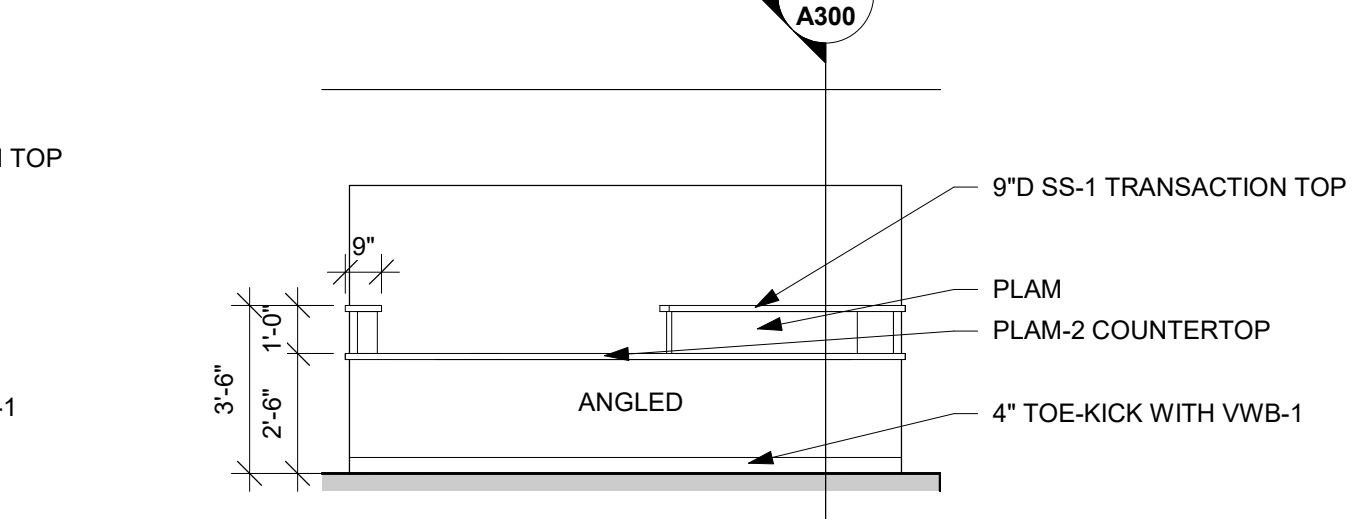


20 RECEP. DESK ELEV.
1/4" = 1'-0"

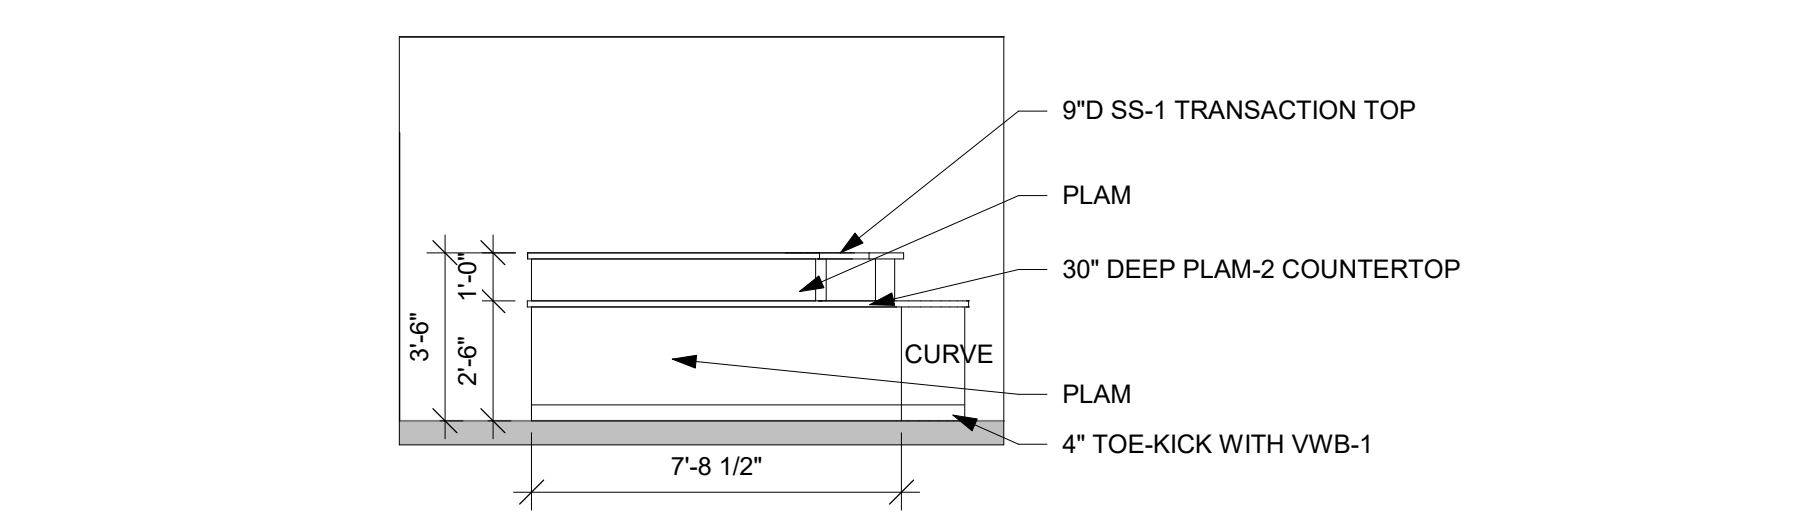


21 RECEP. DESK ELEV.
1/4" = 1'-0"

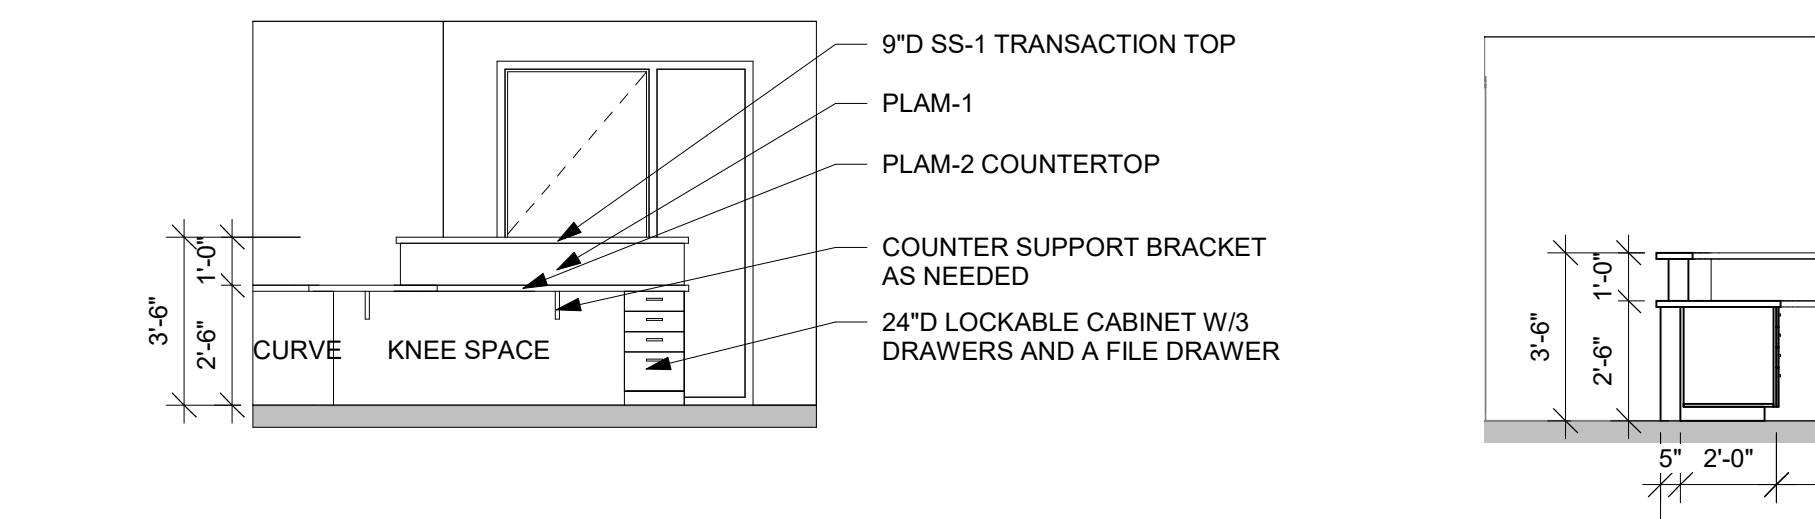


22 RECEP. DESK ELEV.
1/4" = 1'-0"

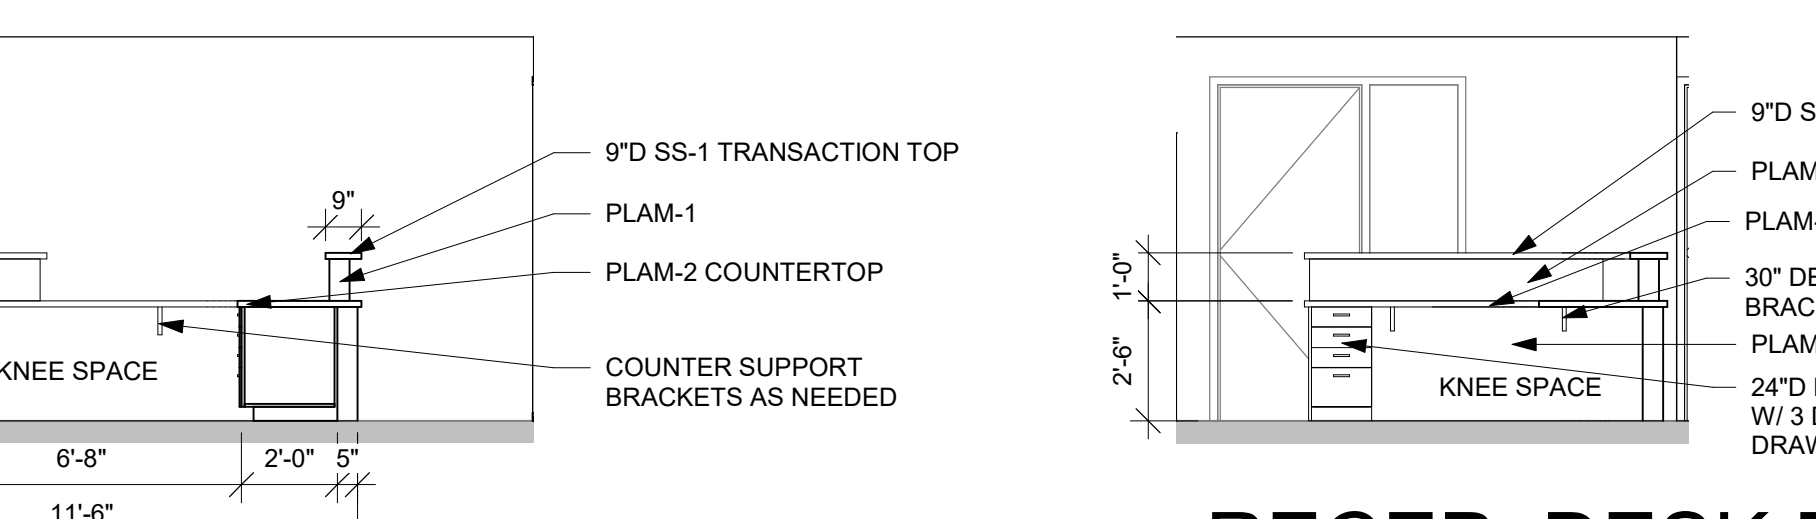


23 RECEP. DESK ELEV.
1/4" = 1'-0"

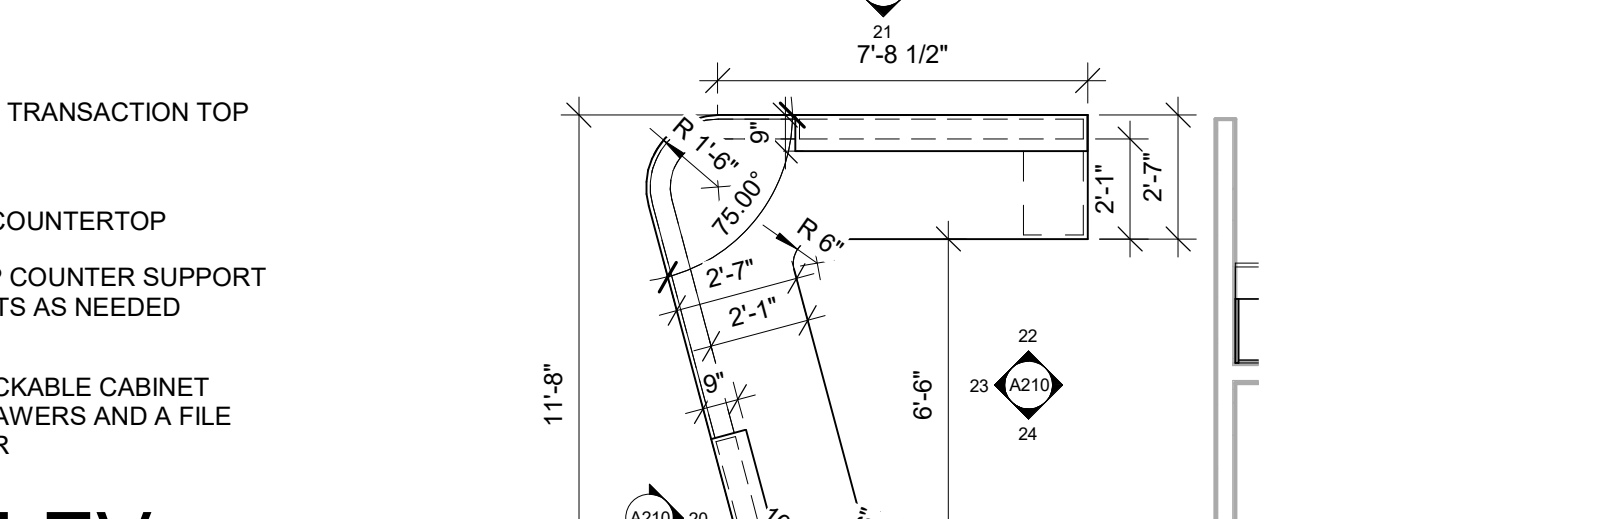


24 RECEP. DESK ELEV.
1/4" = 1'-0"

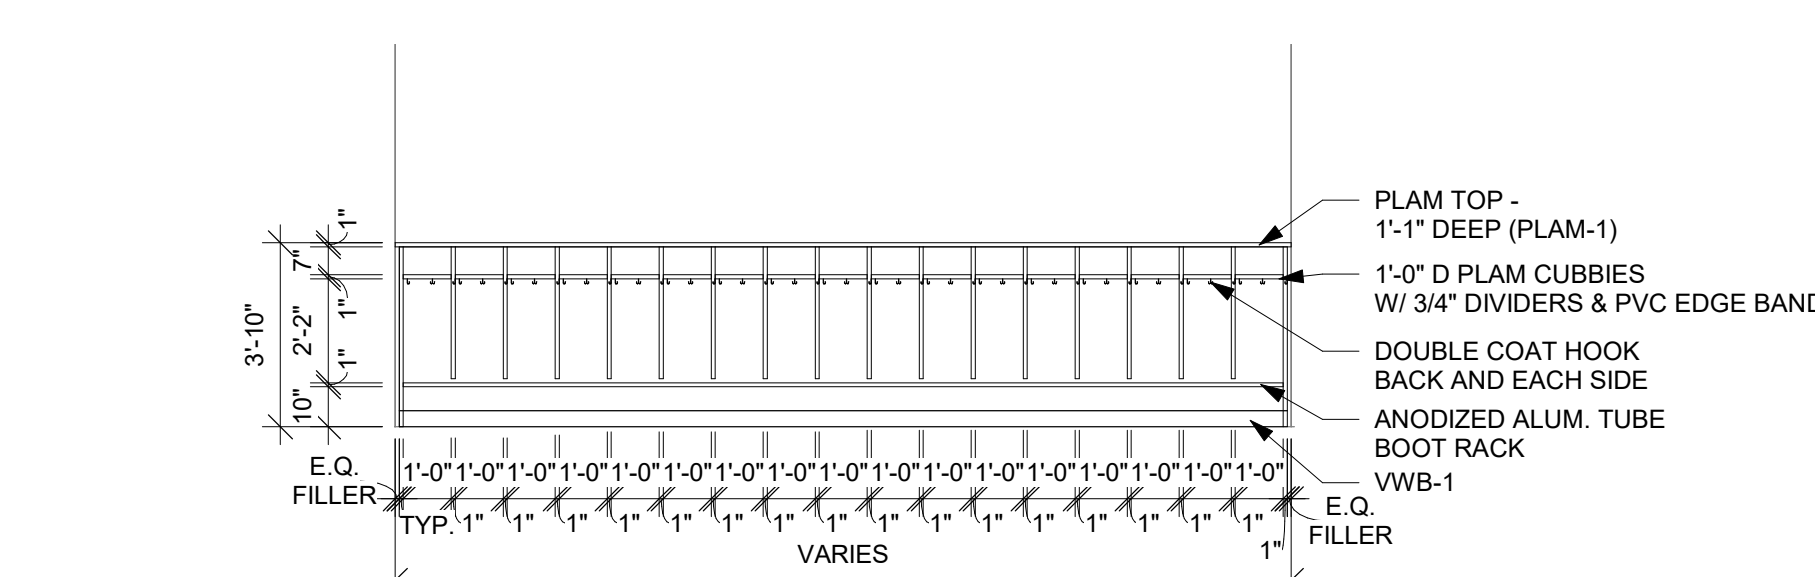


26 CUBBIES
1/4" = 1'-0"

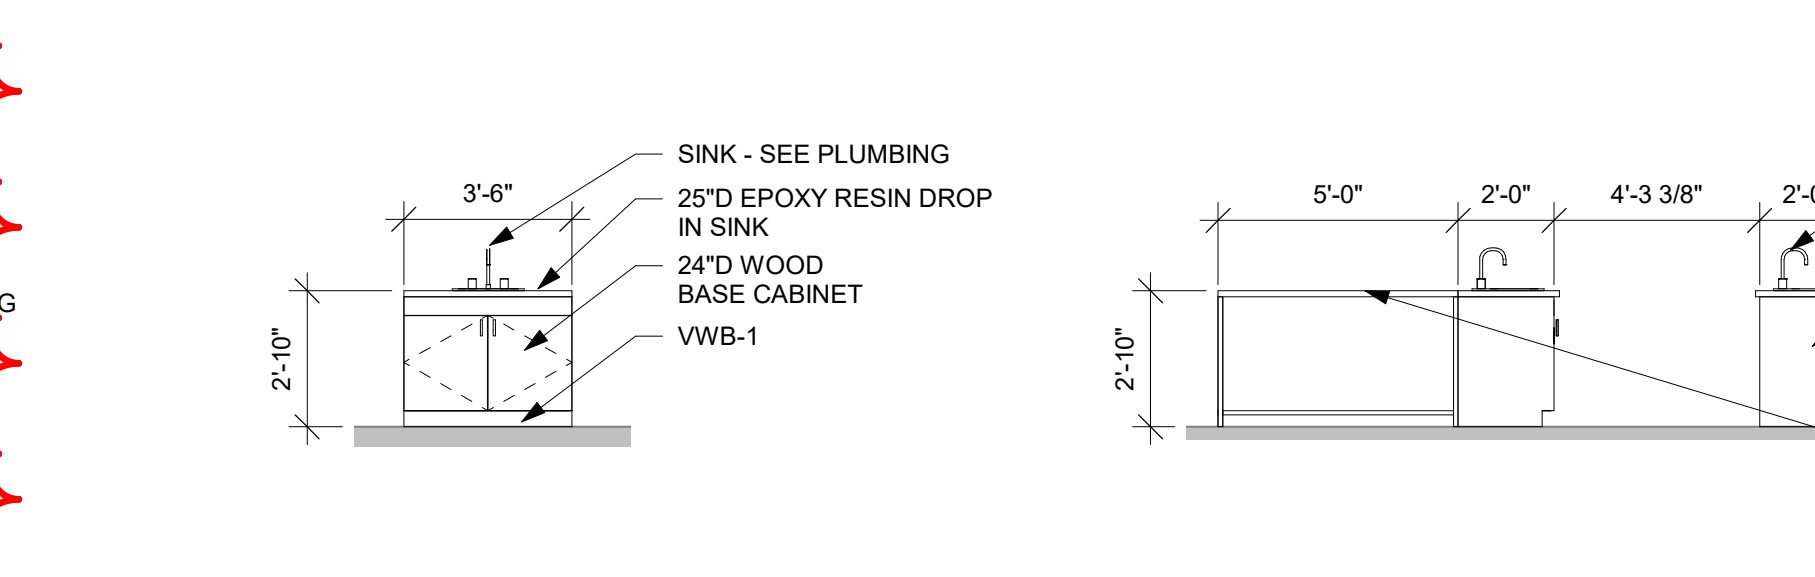


27 CW RM 218
1/4" = 1'-0"

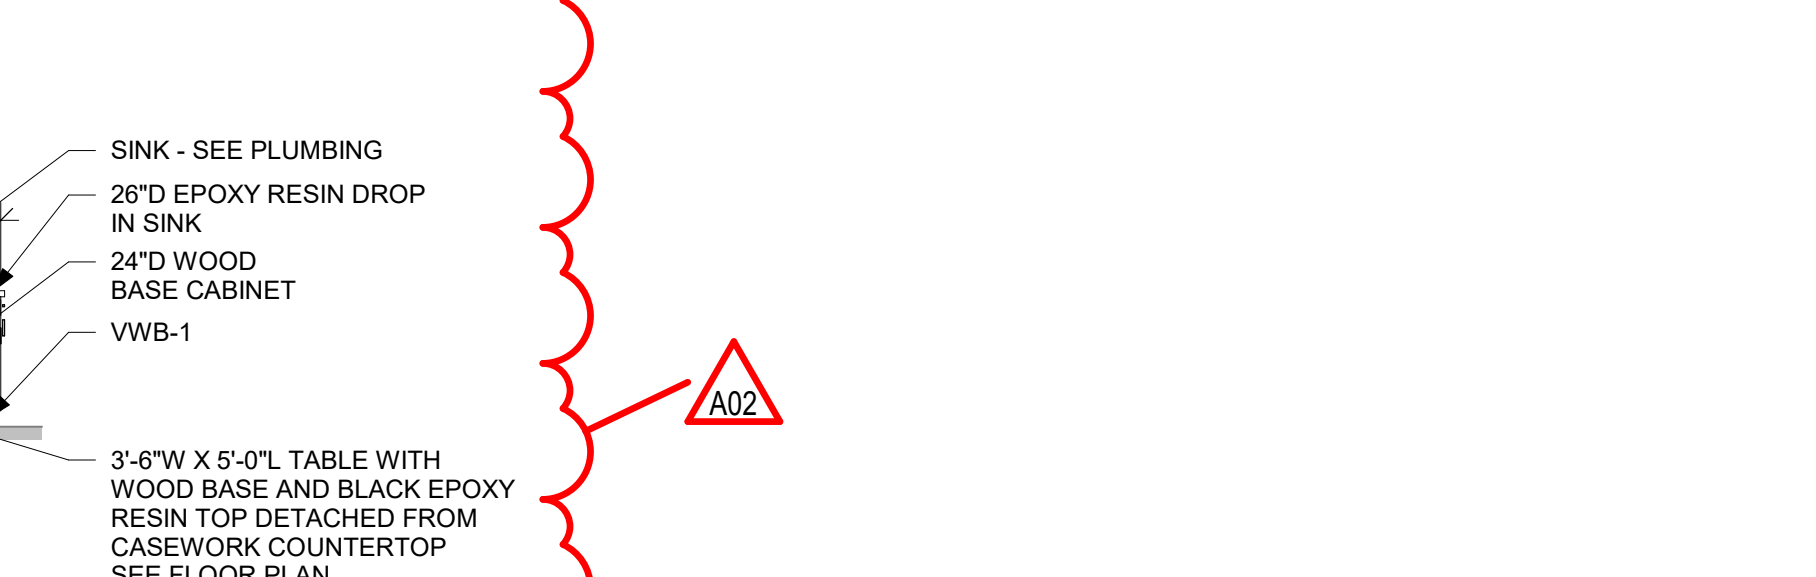

28 CW RM 218
1/4" = 1'-0"

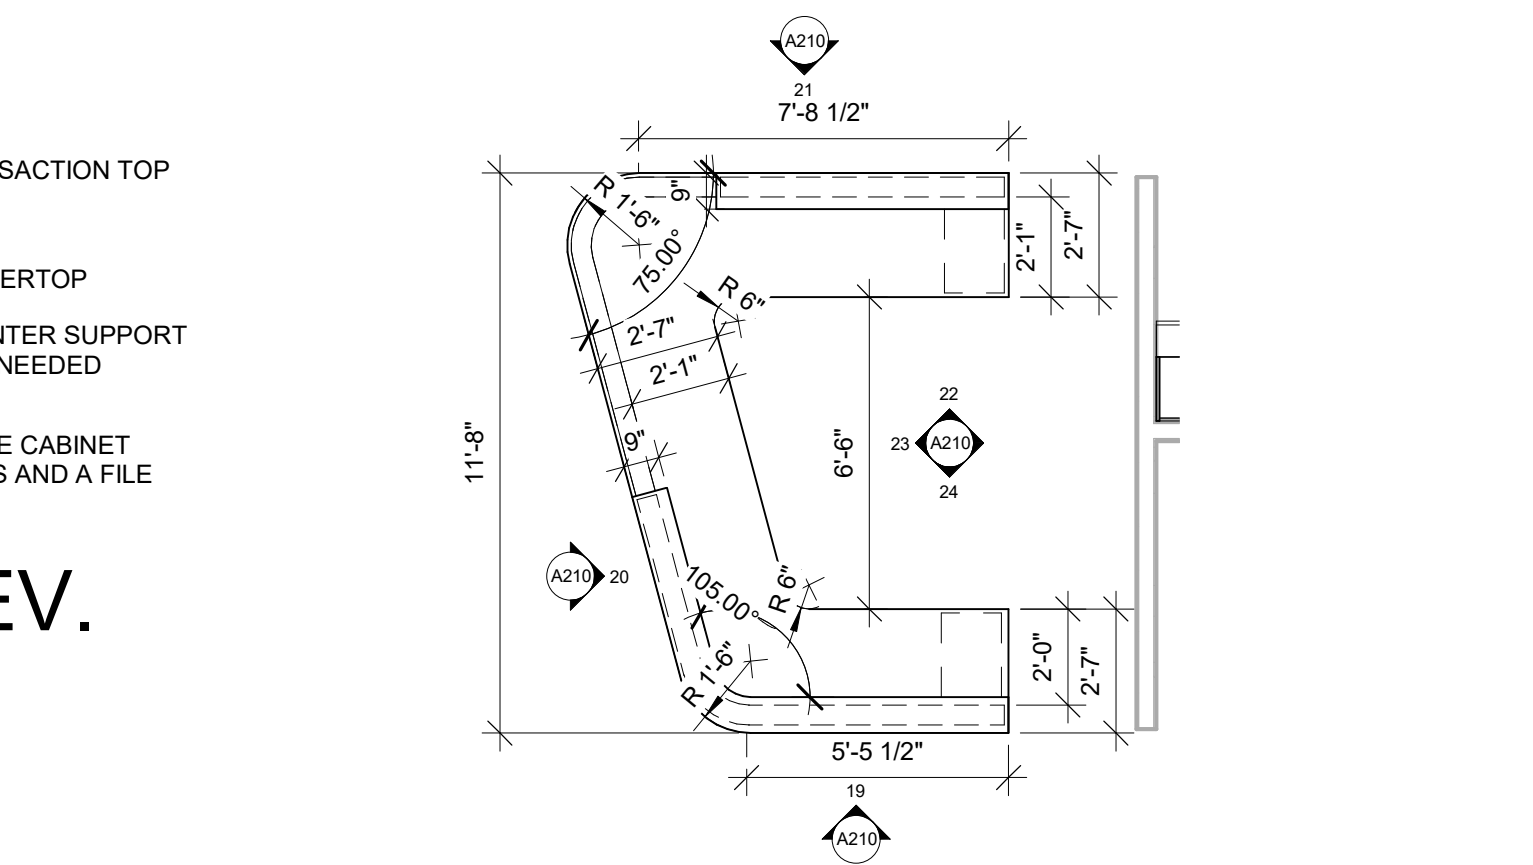

25 RECEPTION DESK PLAN VIEW
1/4" = 1'-0"

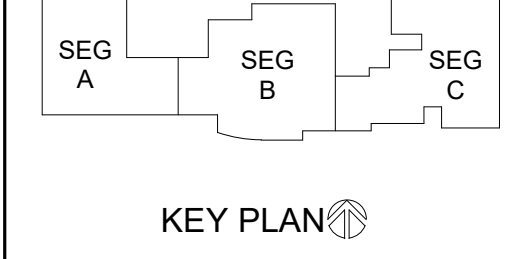


No.	Description	Date
A02	ADDENDUM #02	8-19-19




Consultant:

ENGINEER CERTIFICATION
I hereby certify that this Plan, Specification or Report was prepared by me or under my direct supervision and that I am a duly licensed Engineer under the laws of the state of Minnesota.
Jim Tompkins
Date: July 9, 2019 Lic. No.: 113131
This drawing is conditionally issued and reproductions or use of any technical design information is strictly forbidden without written agreement from the responsible Engineer.


ARCHITECT CERTIFICATION
I hereby certify that this Plan, Specification or Report was prepared by me or under my direct supervision and that I am a duly licensed Architect under the laws of the state of Minnesota.
Carli A.
Date: July 9, 2019 Lic. No.: 58867
This drawing is conditionally issued and reproductions or use of any technical design information is strictly forbidden without written agreement from the responsible Architect.

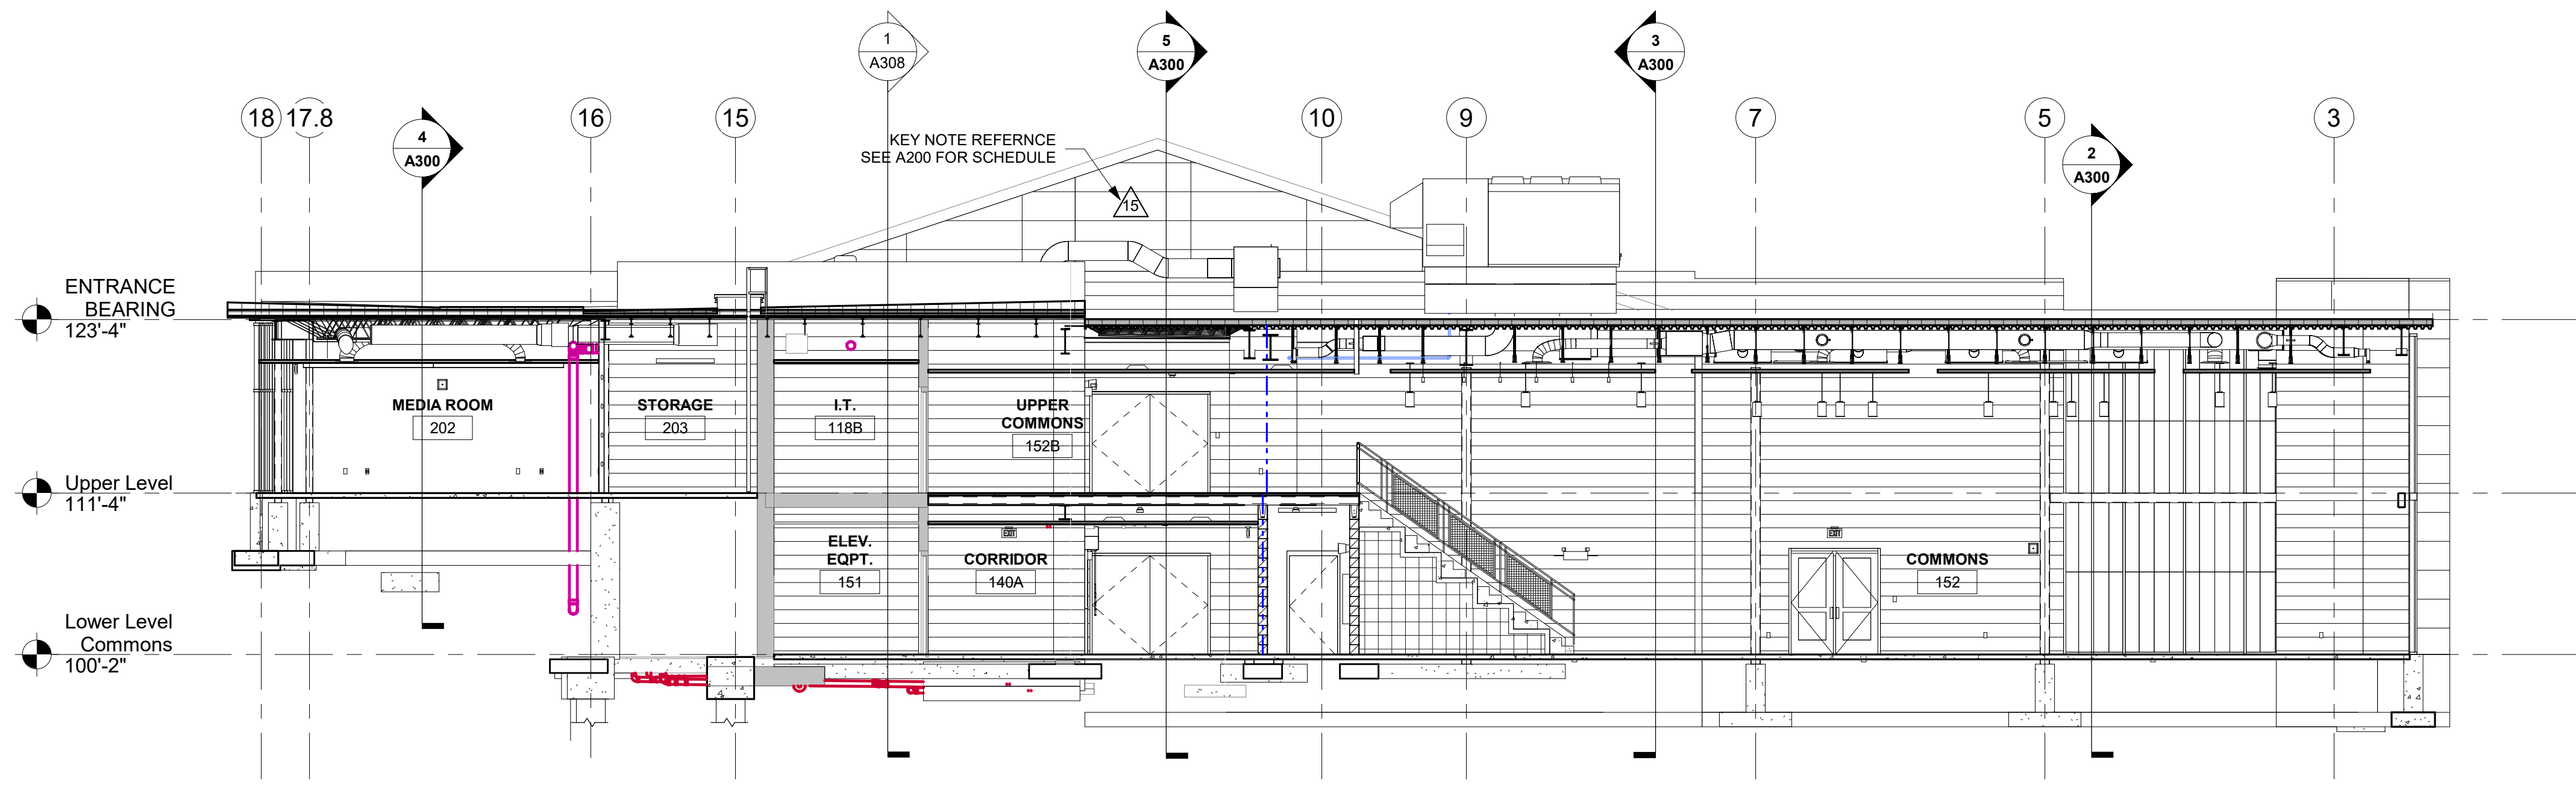


1 BUILDING SECTION
1/8" = 1'-0"

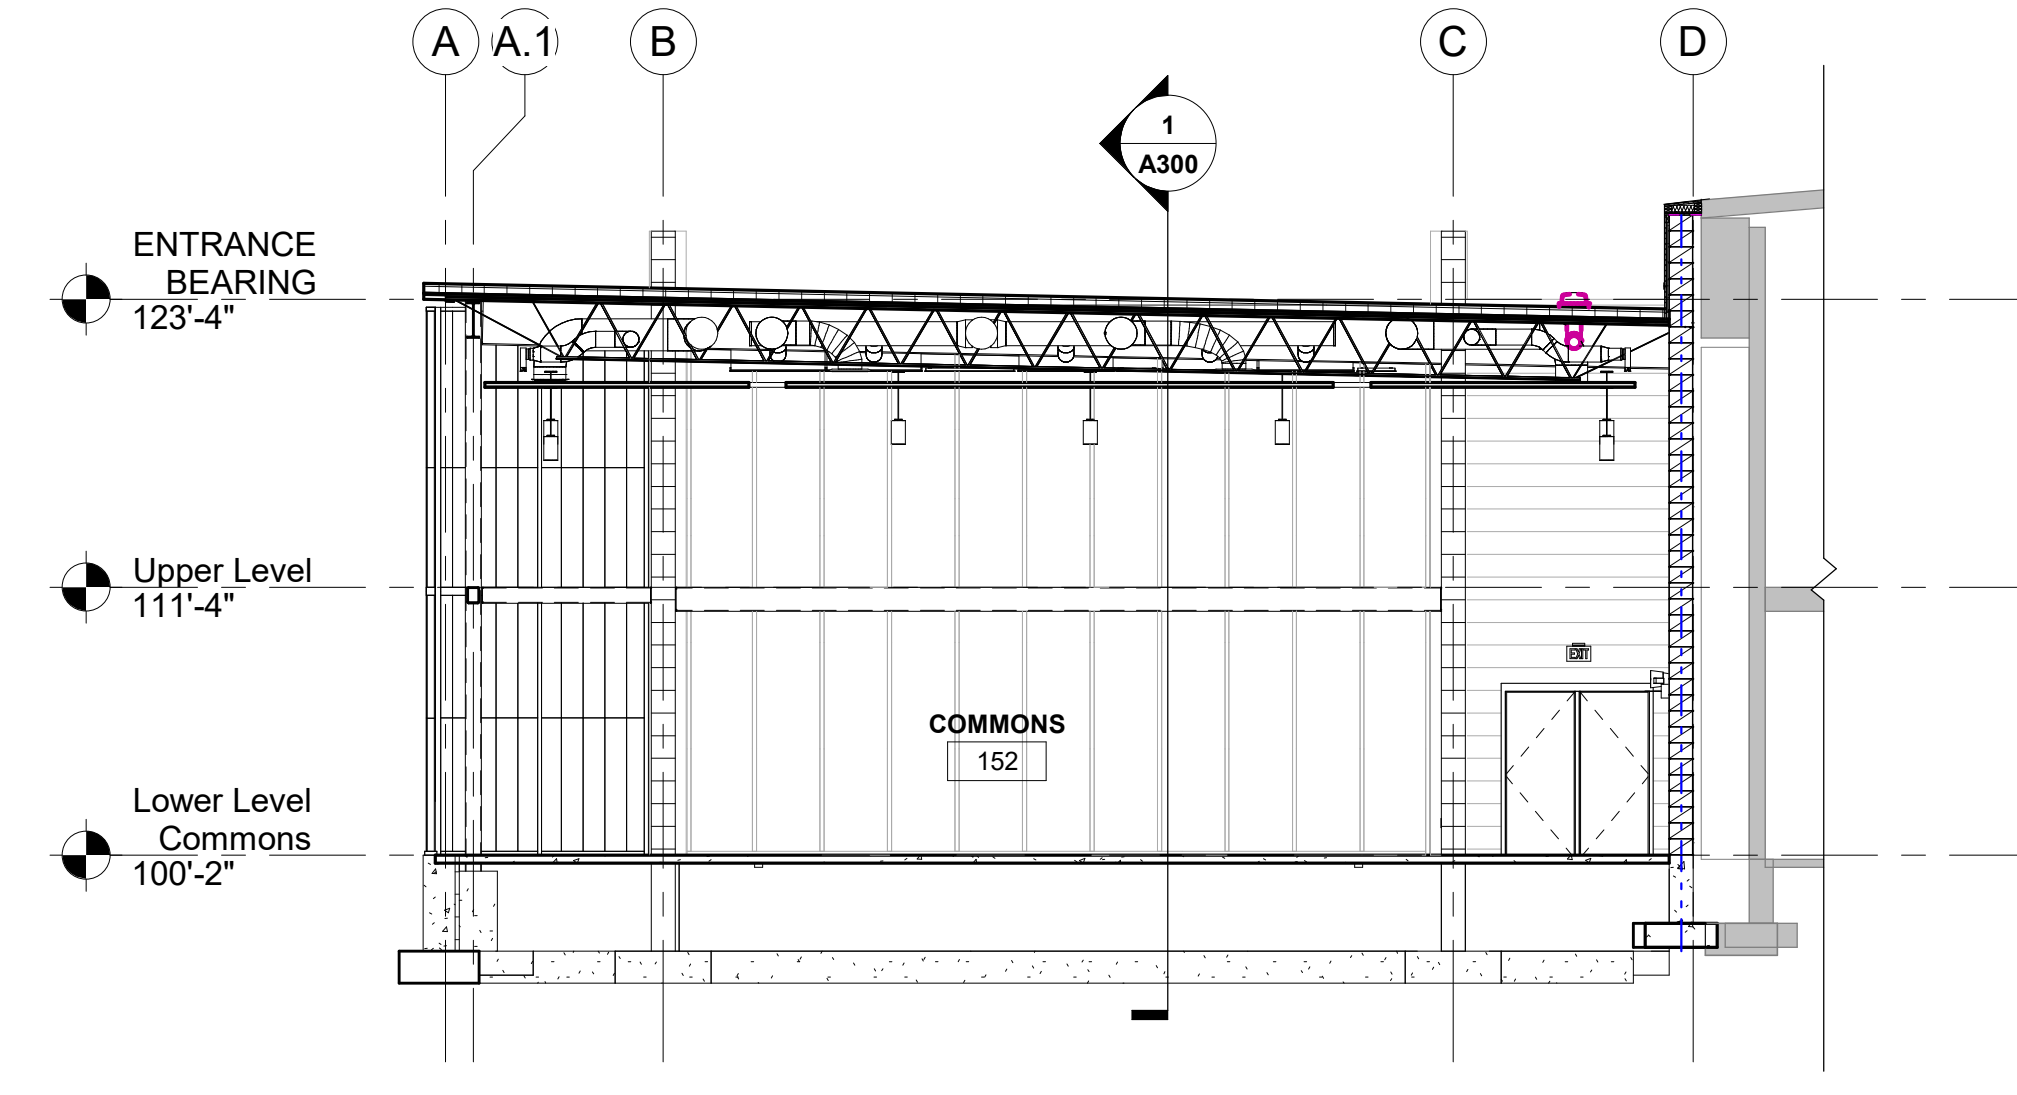


2 BUILDING SECTION
1/8" = 1'-0"

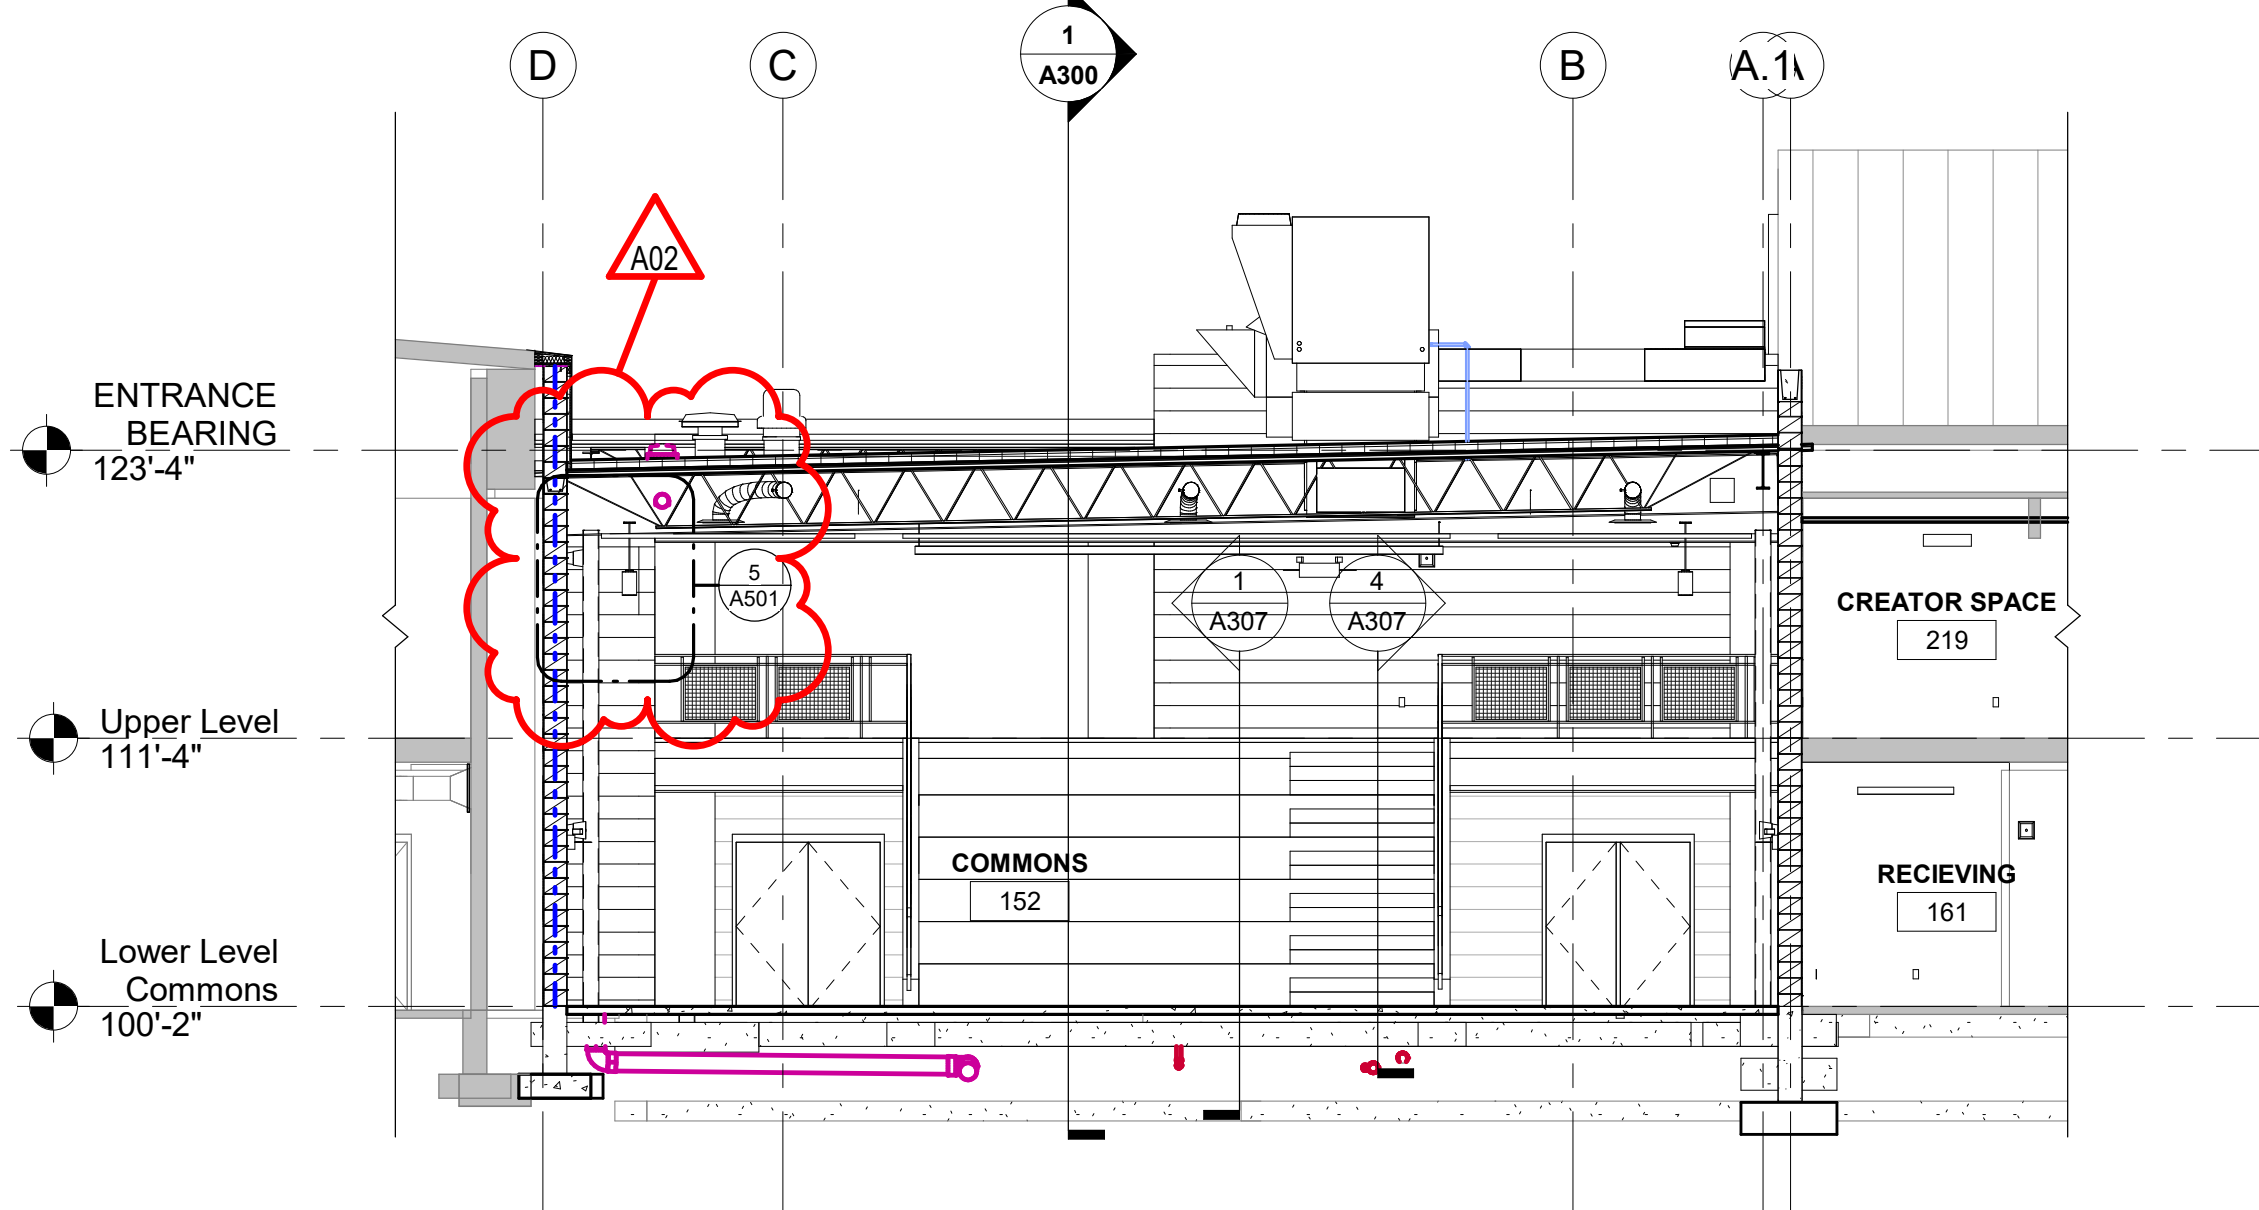

3 BUILDING SECTION
1/8" = 1'-0"

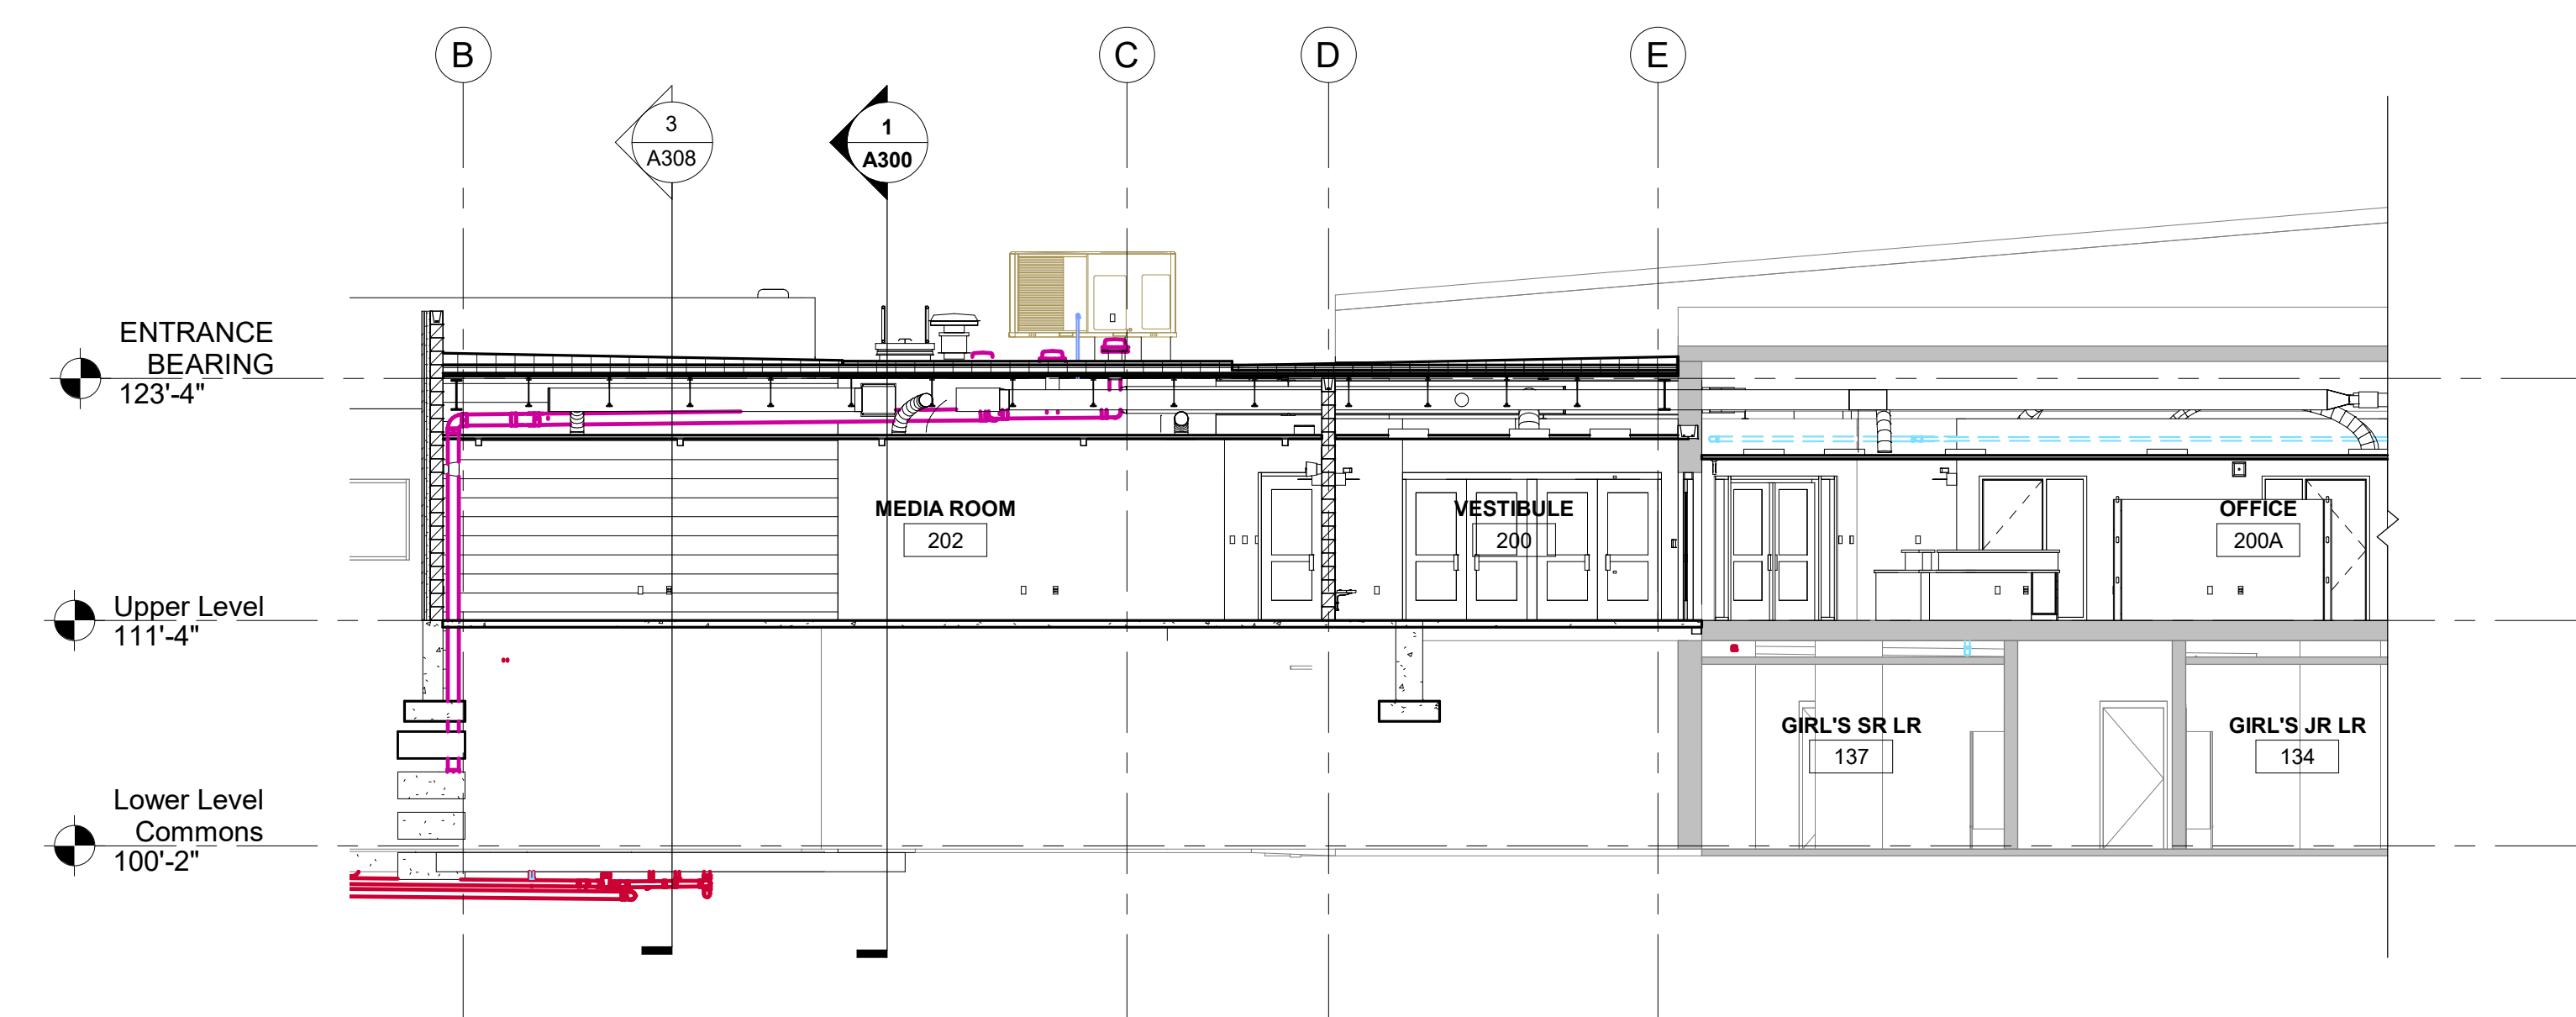

4 BUILDING SECTION
1/8" = 1'-0"

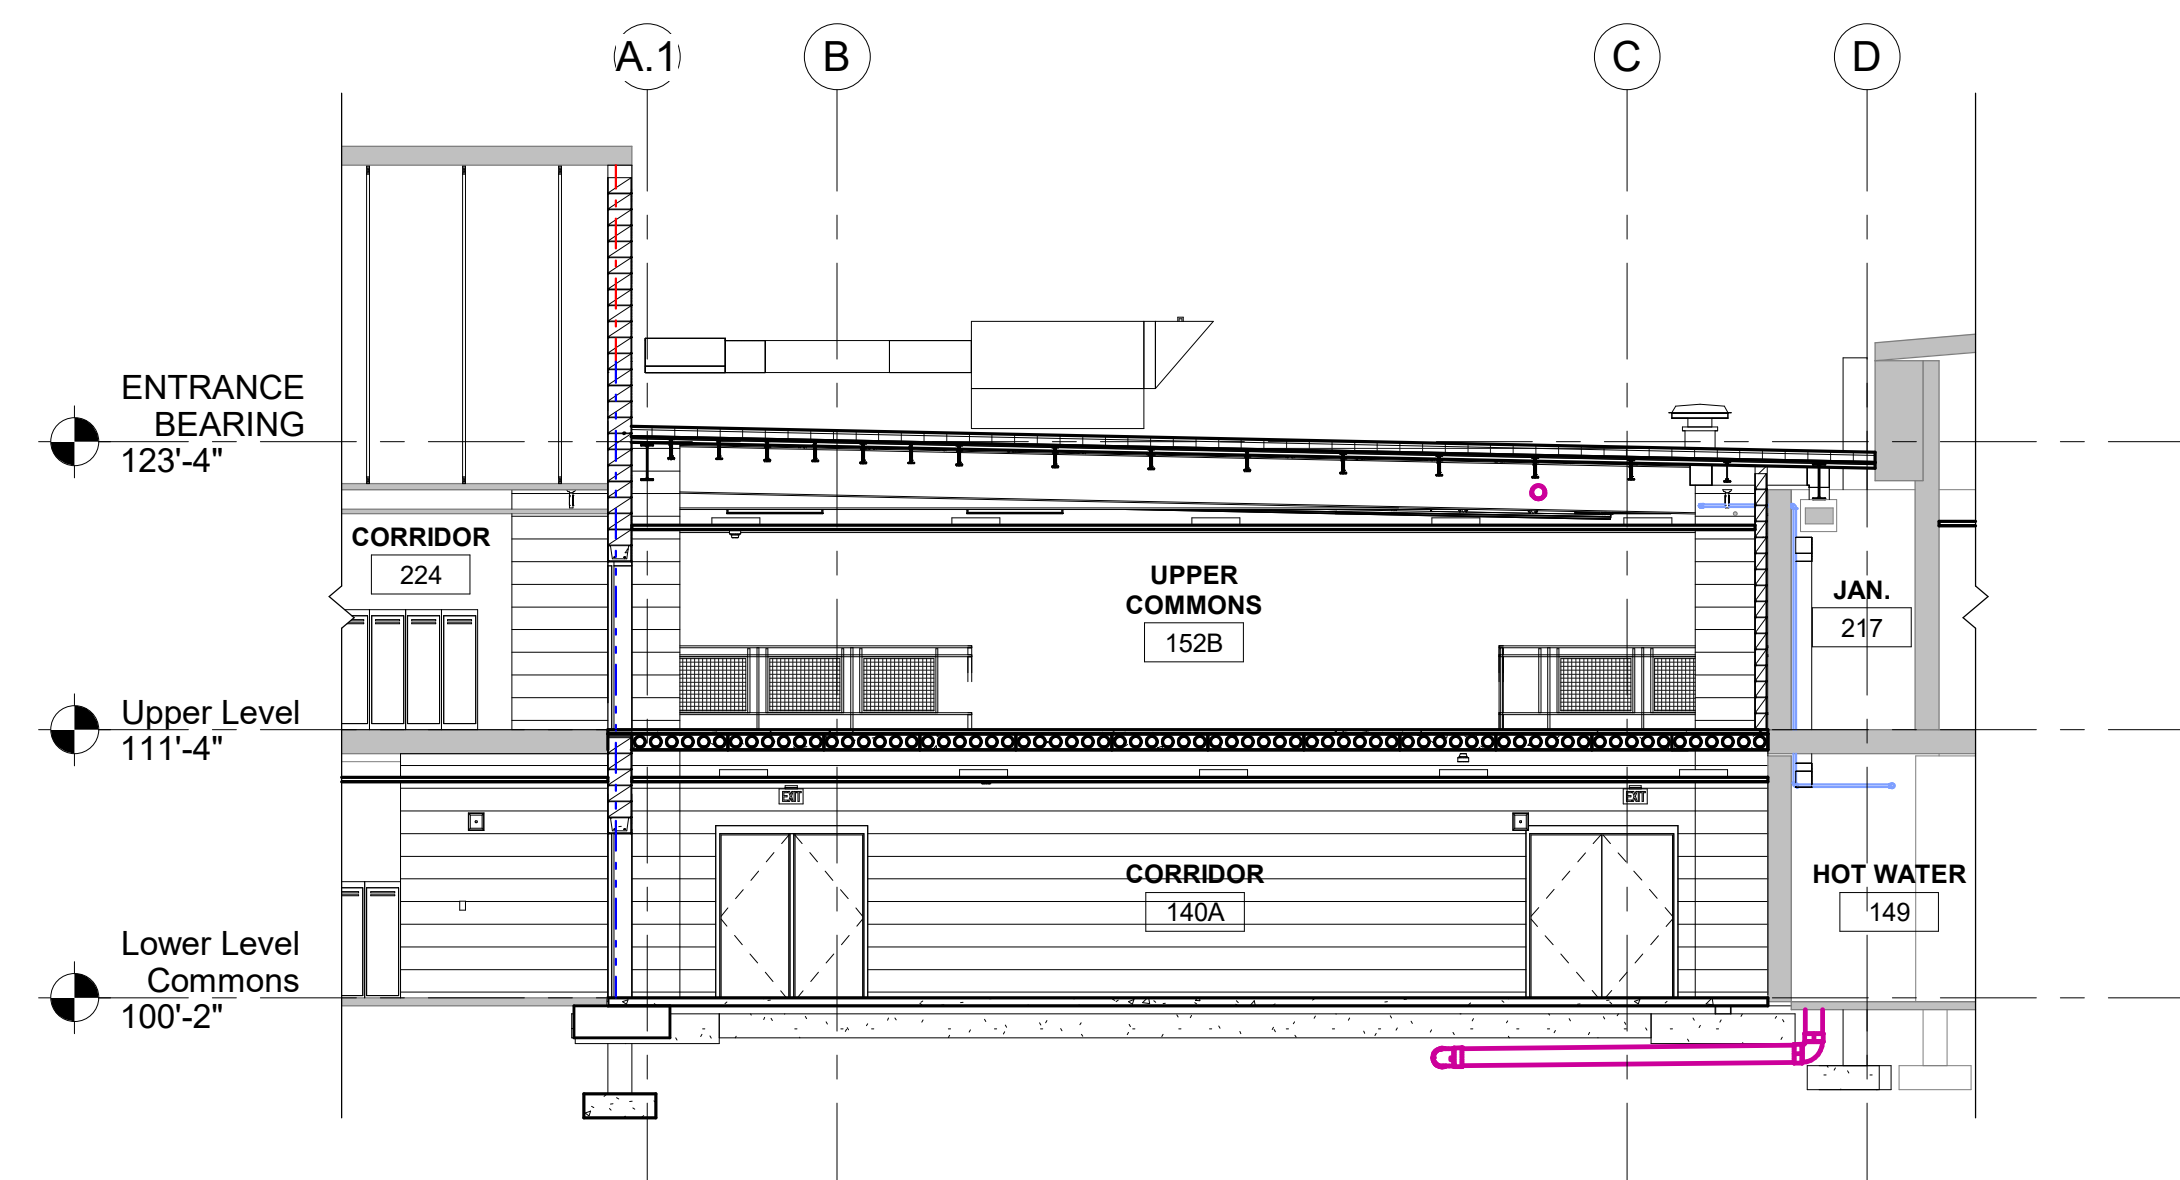

5 BUILDING SECTION
1/8" = 1'-0"


LANESBORO PUBLIC SCHOOLS
ADDITION & REMODEL
 204 KIRKWOOD ST EAST
 LANESBORO, MN 55949
BUILDING SECTIONS COMMONS

Project Title: HSR Project Number: 18063

Project Date: 7-25-19

Drawn By: HSR

Key Plan:

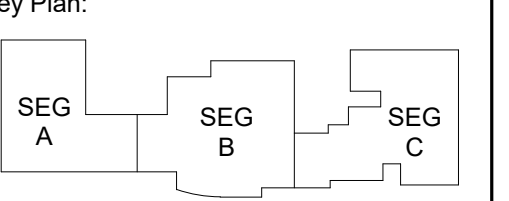


KEY PLAN

Revisions:

No.	Description	Date
A02	ADDENDUM #02	8-19-19

Graphic Scale:

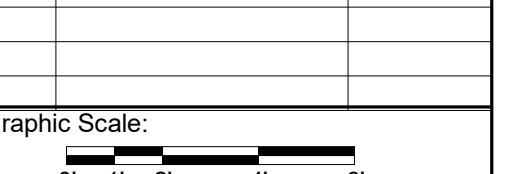

Last Update: 8/20/2019 11:09:31 AM

A300



Consultant:

ENGINEER CERTIFICATION
I hereby certify that this Plan, Specification or Report was prepared by me or under my direct supervision and that I am a duly licensed Engineer under the laws of the state of Minnesota.

Jim Tompke
Date: July 9, 2019 Lic. No.: 11311
This drawing is conditionally issued and reproductions or use of any technical design information is strictly forbidden without written agreement from the responsible Engineer.

ARCHITECT CERTIFICATION
I hereby certify that this Plan, Specification or Report was prepared by me or under my direct supervision and that I am a duly licensed Architect under the laws of the state of Minnesota.

Quillan
Date: July 9, 2019 Lic. No.: 58867
This drawing is conditionally issued and reproductions or use of any technical design information is strictly forbidden without written agreement from the responsible Architect.

Project Title: LANESBORO PUBLIC SCHOOLS
ADDITION & REMODEL

Project Location: 204 KIRKWOOD ST EAST
LANESBORO, MN 55949


Sheet Title: GYM AREA SECTIONS

HSR Project Number: 18063

Project Date: 7-25-19

Drawn By: TBS/SW

Key Plan:

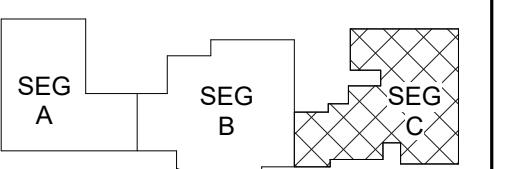

KEY PLAN


Revisions:

No.	Description	Date
A02	ADDENDUM #02	8-19-19


Graphic Scale: 0' 6" 1' 2' 3'

Last Update: 8/20/2019 11:09:33 AM


A304

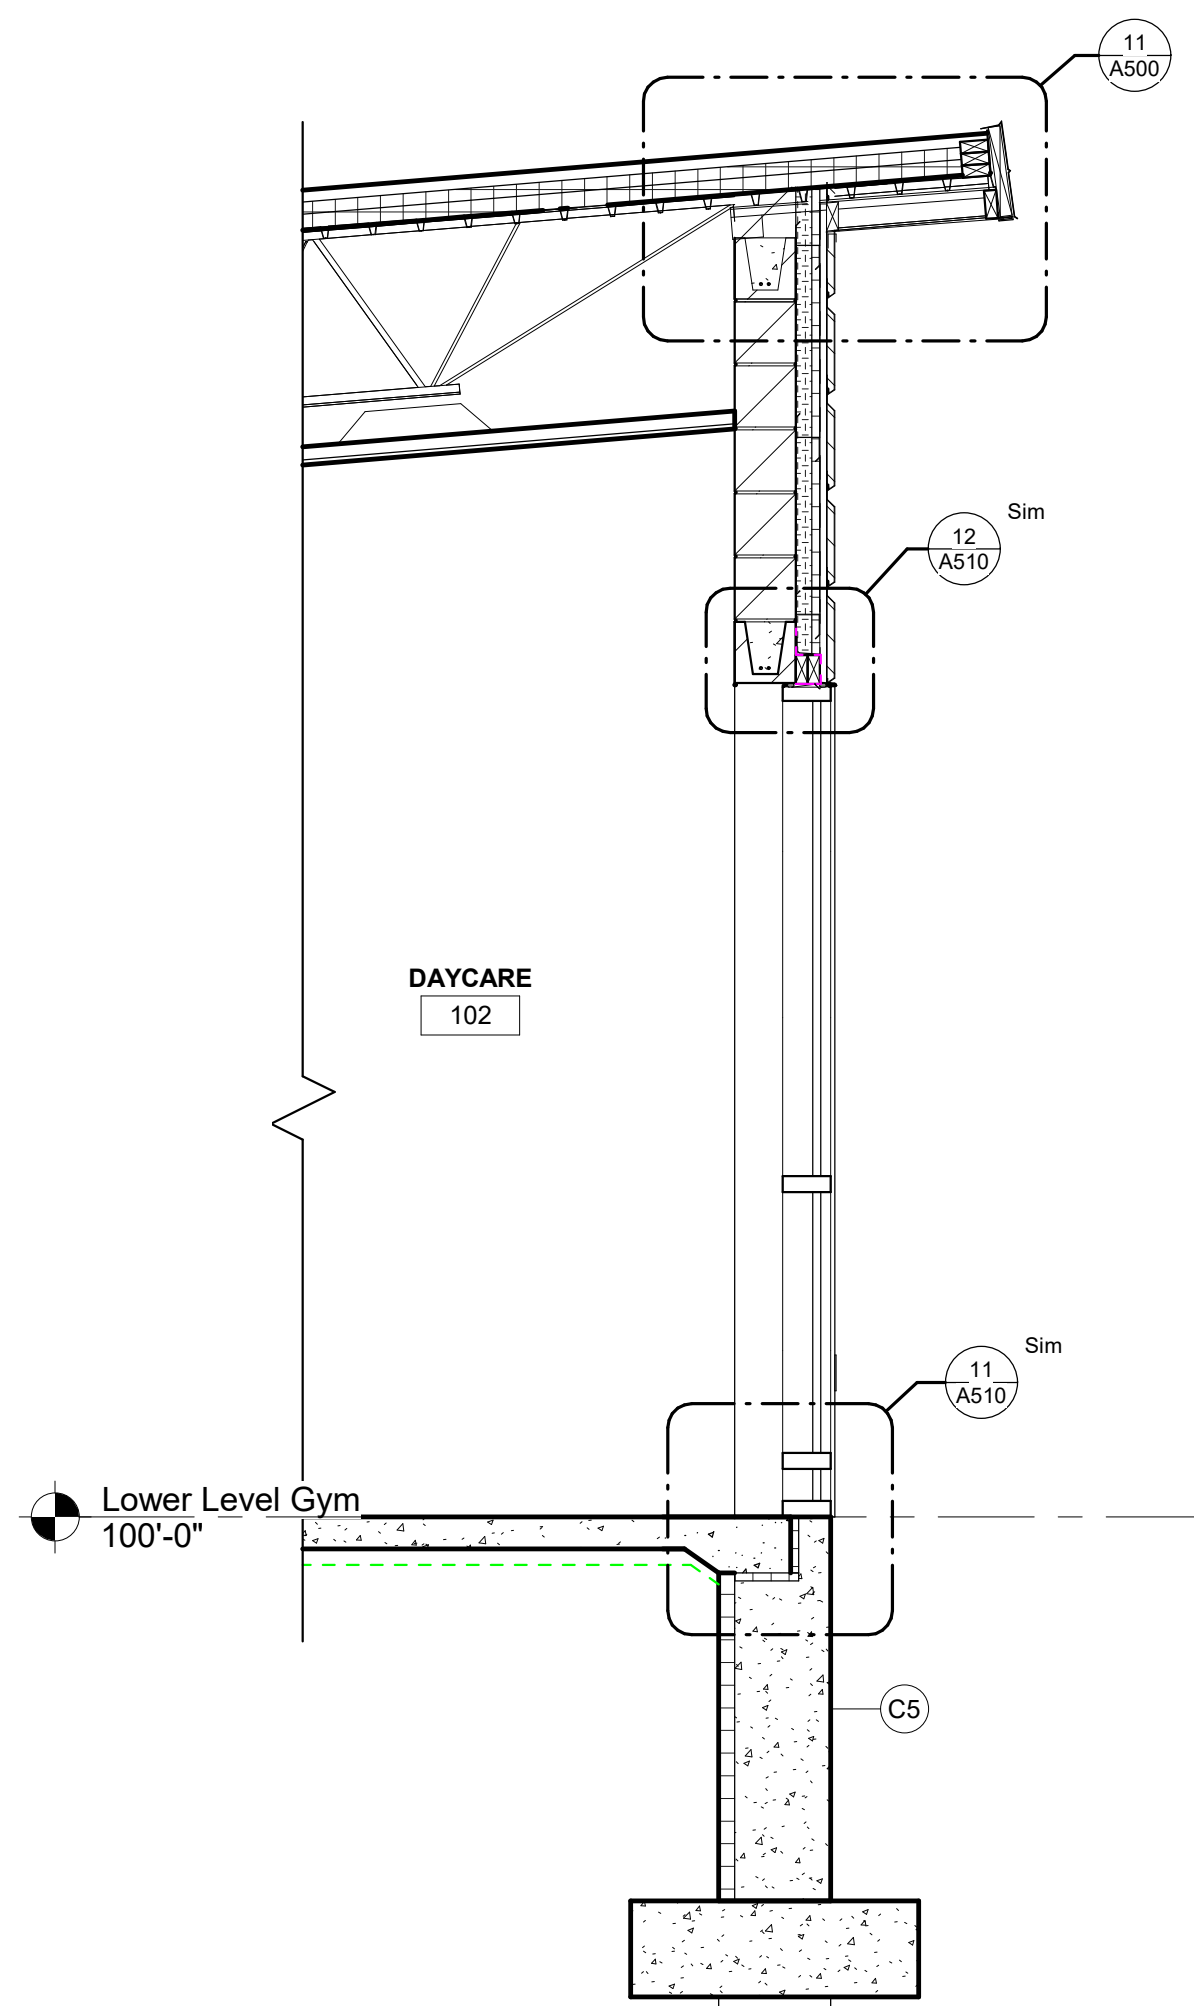

1 WALL SECTION
1/2" = 1'-0"

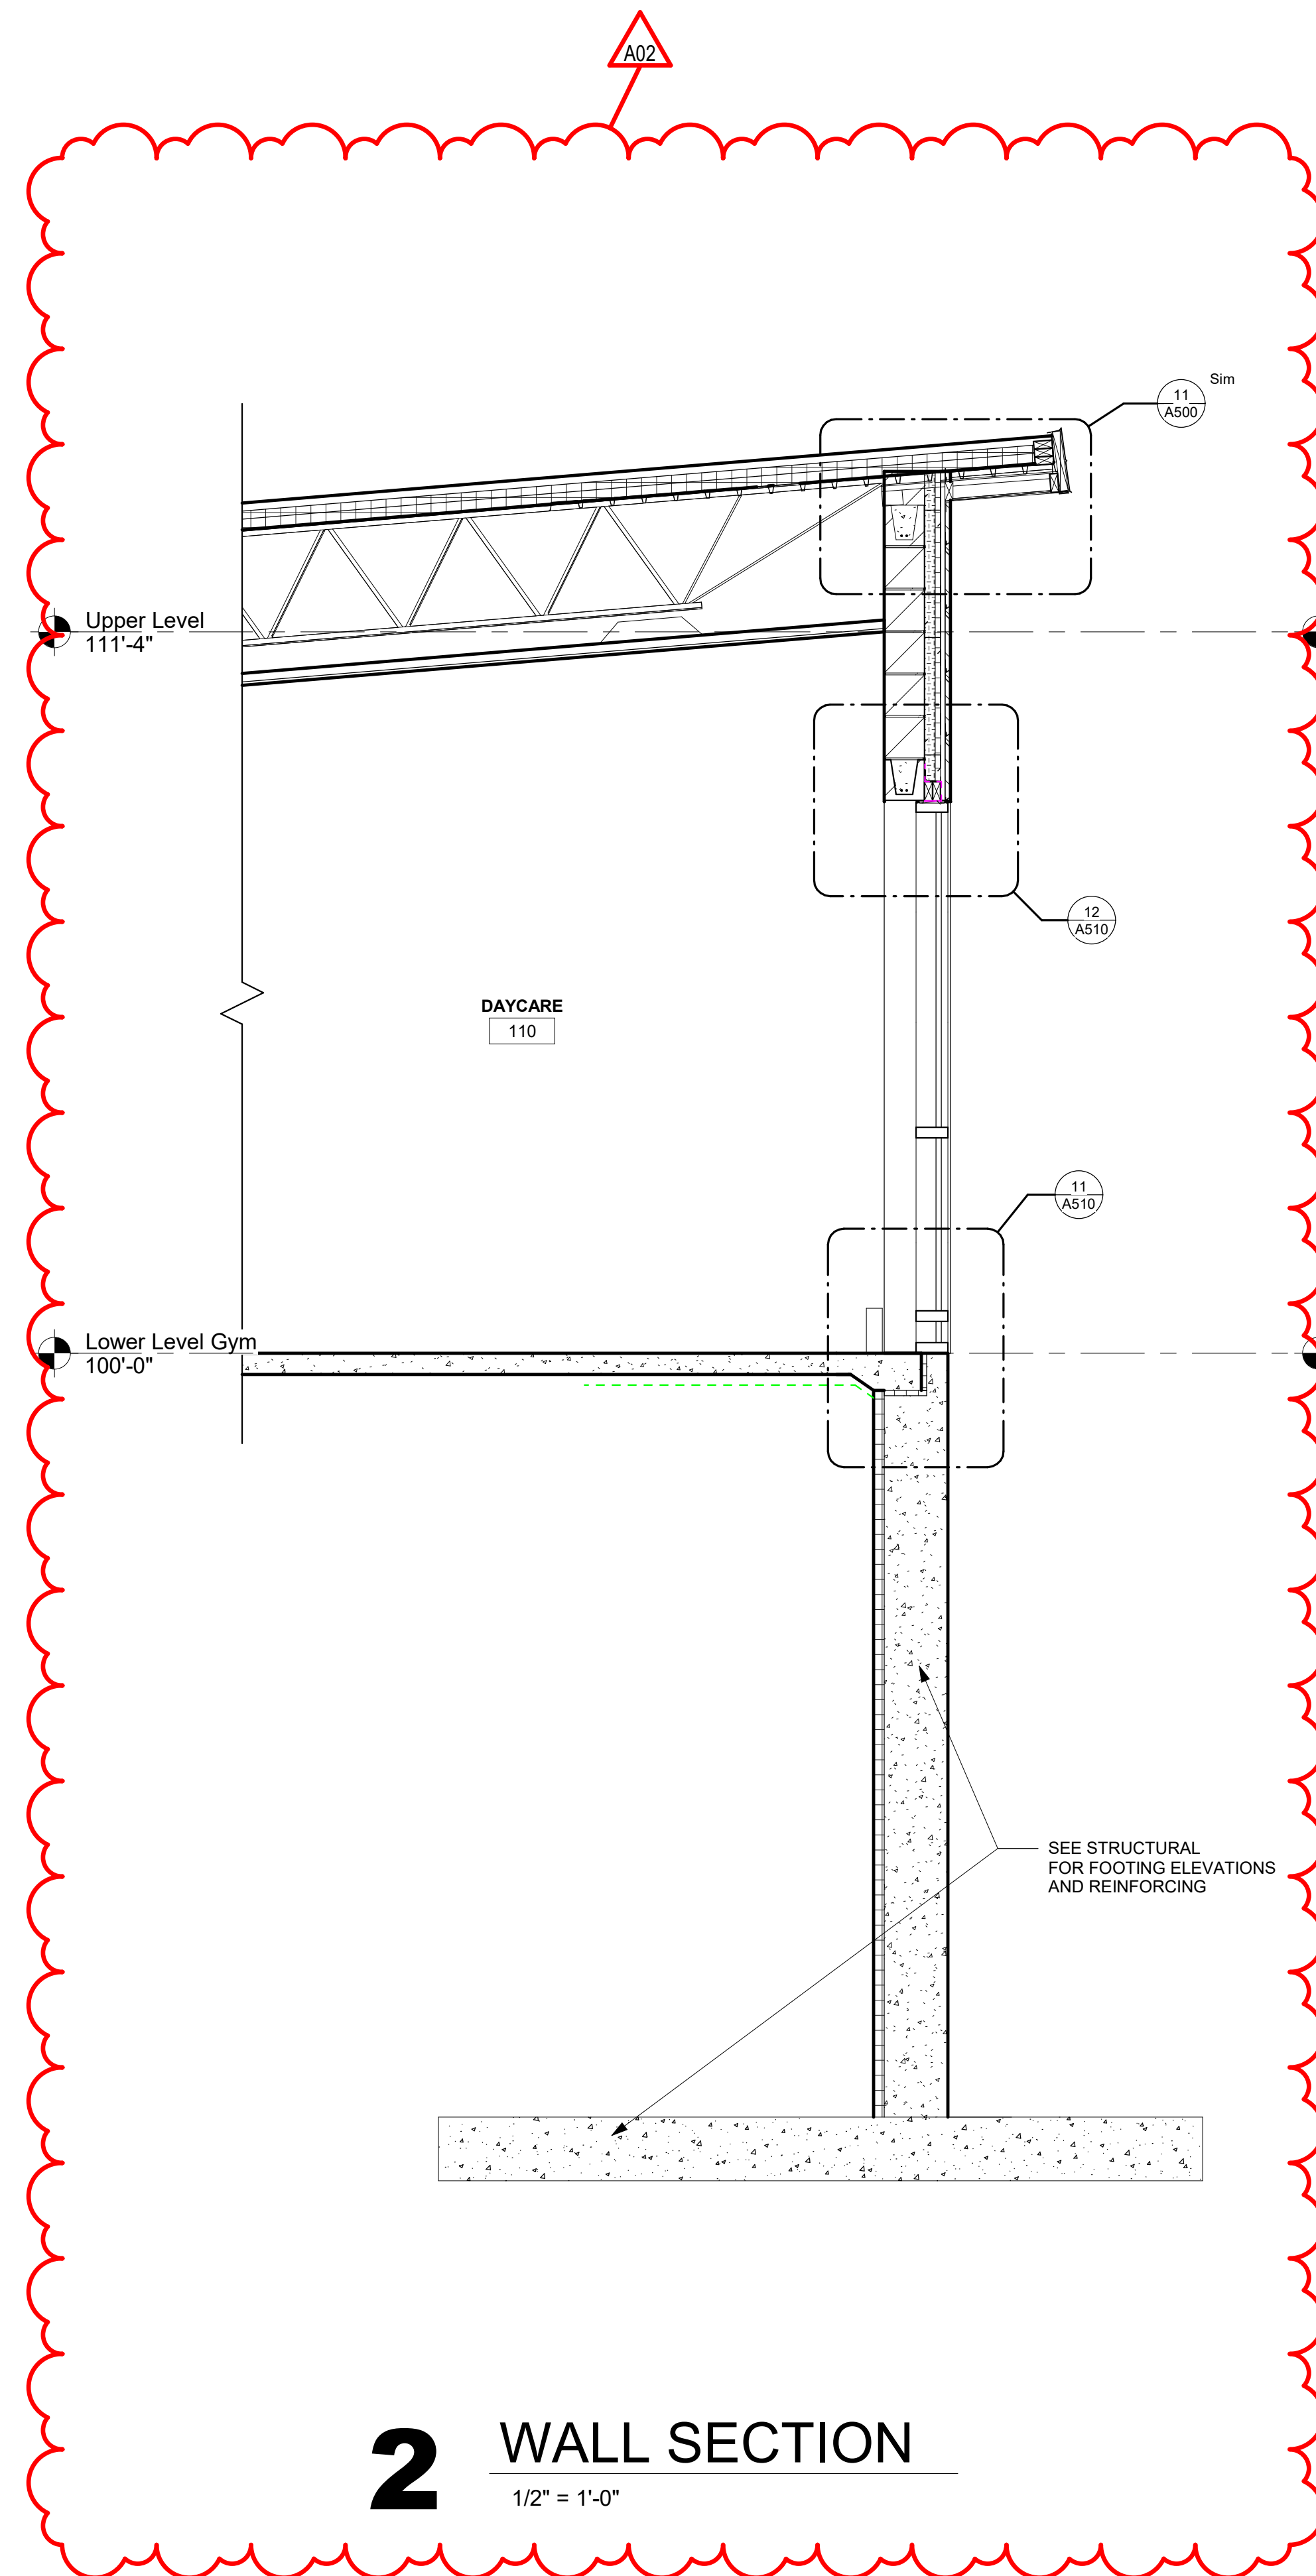

2 WALL SECTION
1/2" = 1'-0"

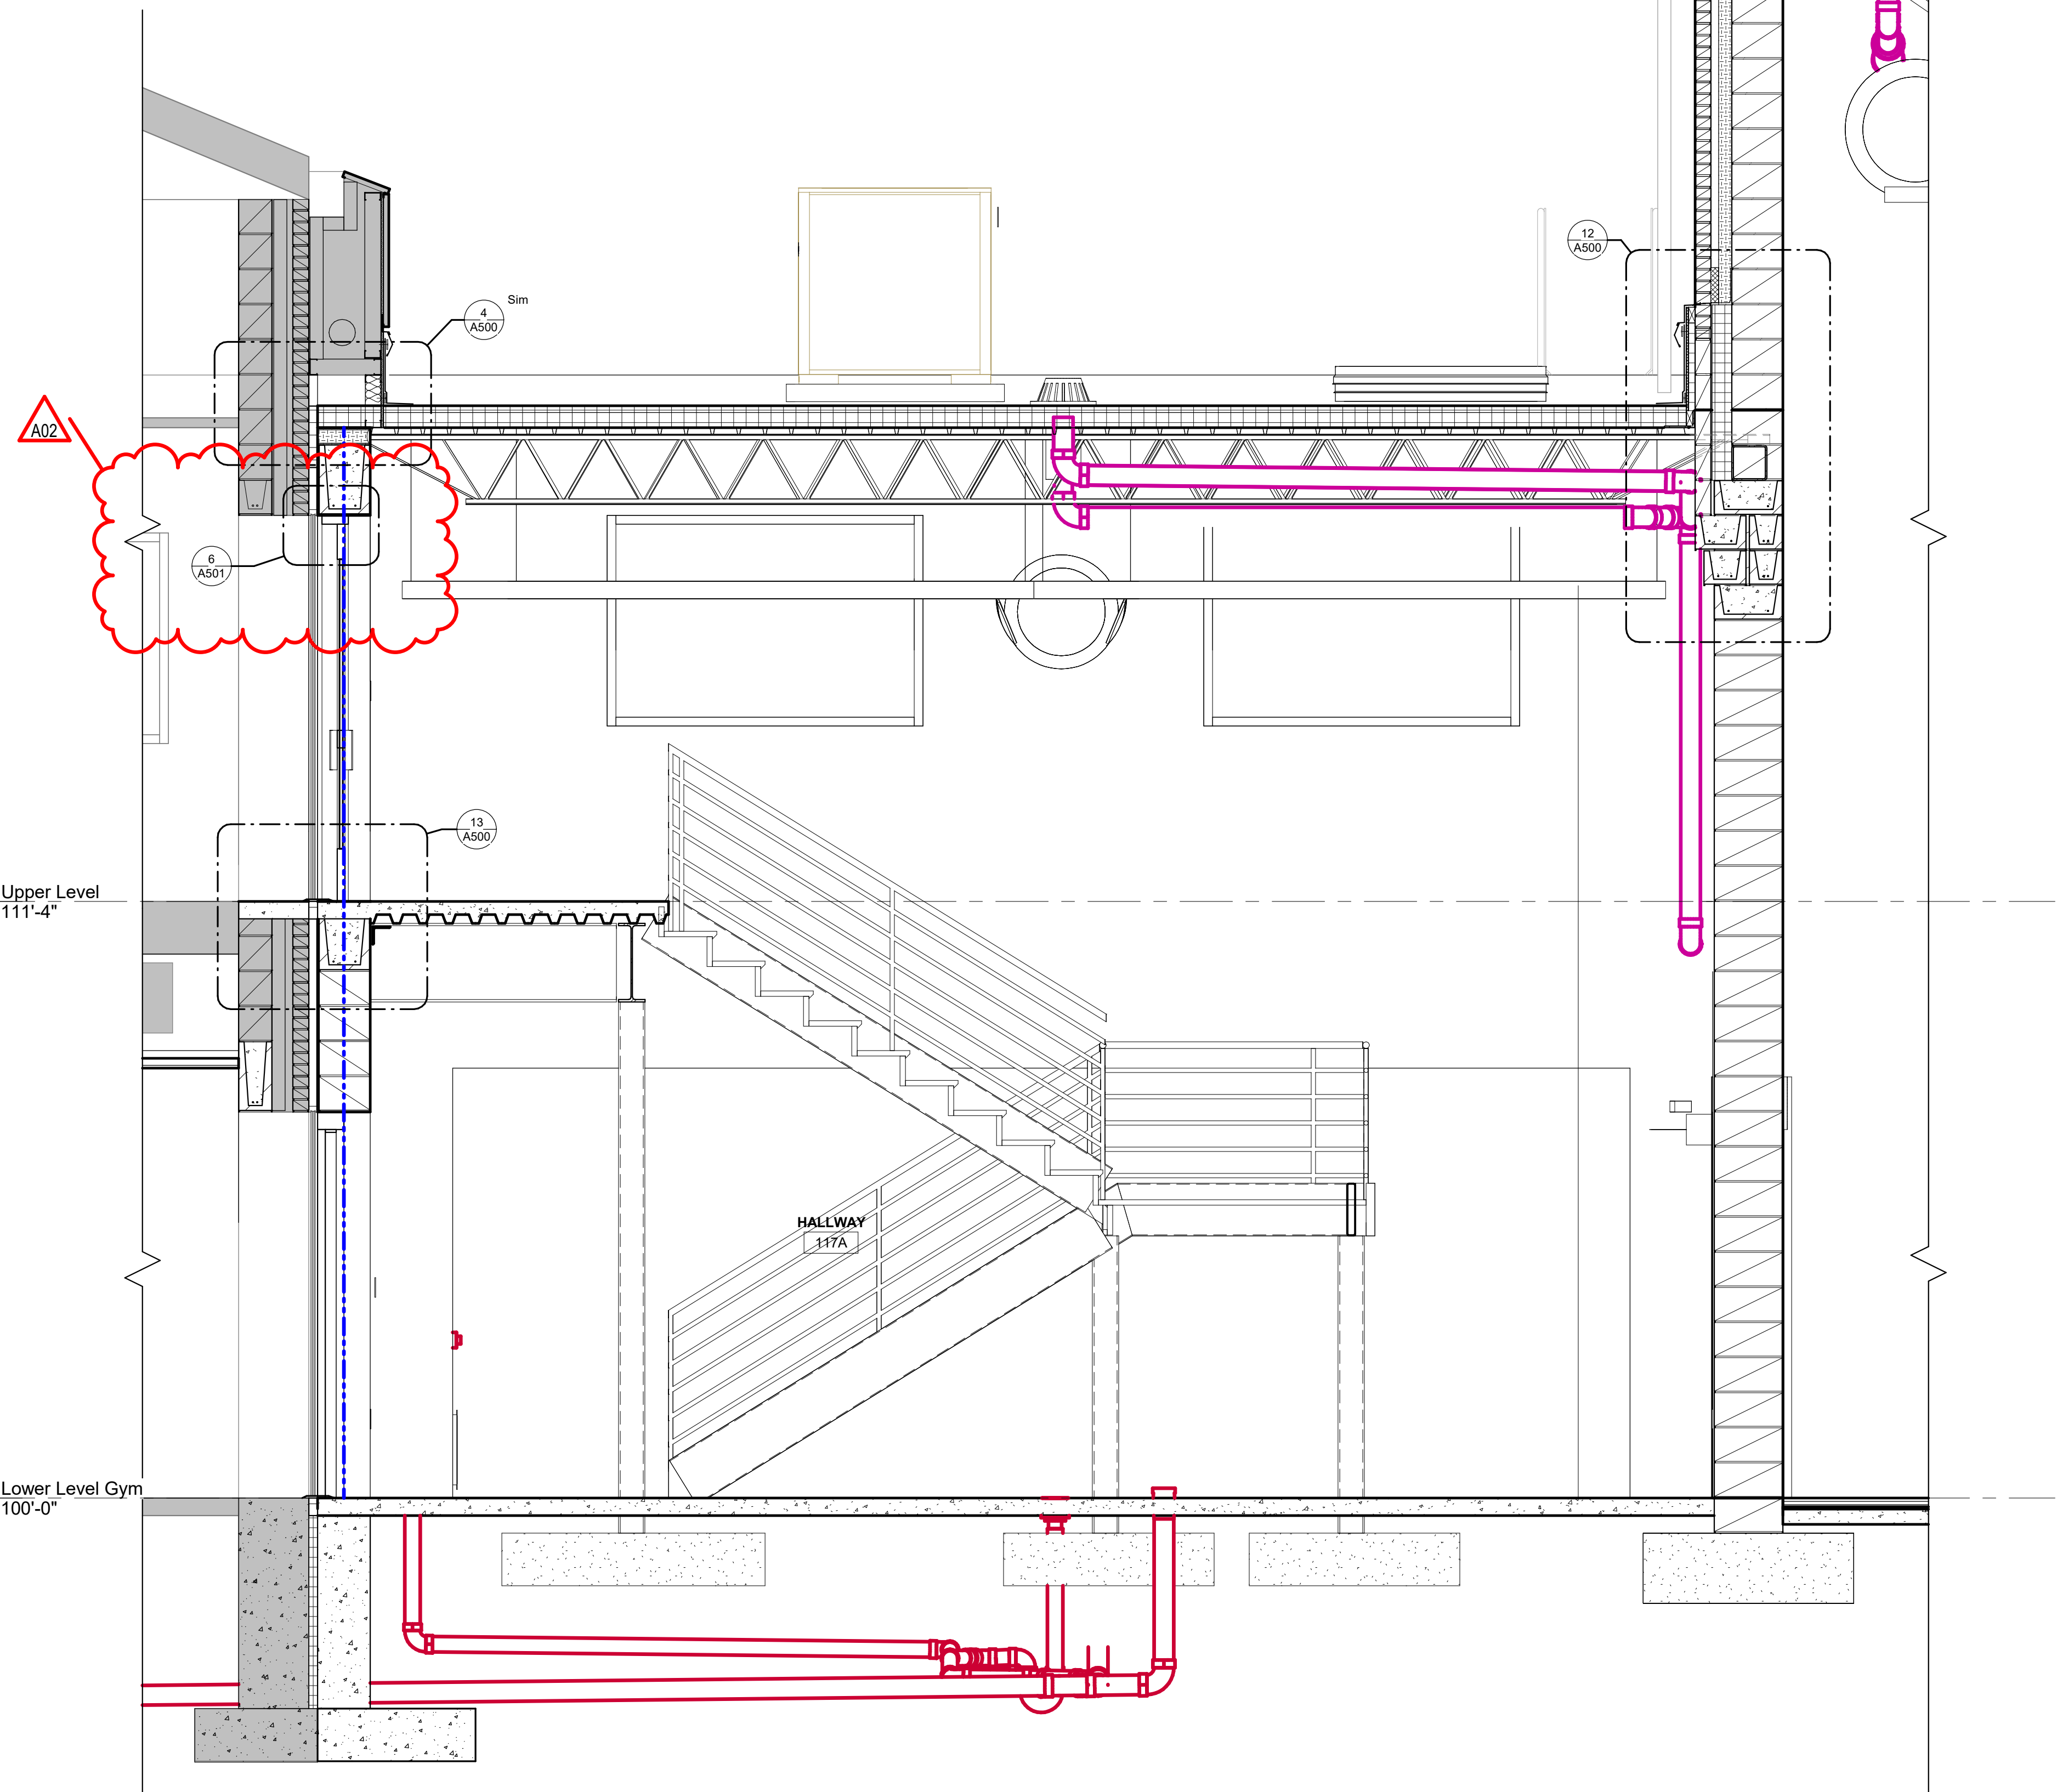


3 BUILDING SECTION
1/2" = 1'-0"



Consultant:

ENGINEER CERTIFICATION
I hereby certify that this Plan, Specification or Report was prepared by me or under my direct supervision and that I am a duly licensed Engineer under the laws of the state of Minnesota.
Date: July 9, 2019 Lic. No. 11311
This drawing is conditionally issued and reproductions or use of any technical design information is strictly forbidden without written agreement from the responsible Engineer.

ARCHITECT CERTIFICATION
I hereby certify that this Plan, Specification or Report was prepared by me or under my direct supervision and that I am a duly licensed Architect under the laws of the state of Minnesota.
Date: July 9, 2019 Lic. No. 58867
This drawing is conditionally issued and reproductions or use of any technical design information is strictly forbidden without written agreement from the responsible Architect.

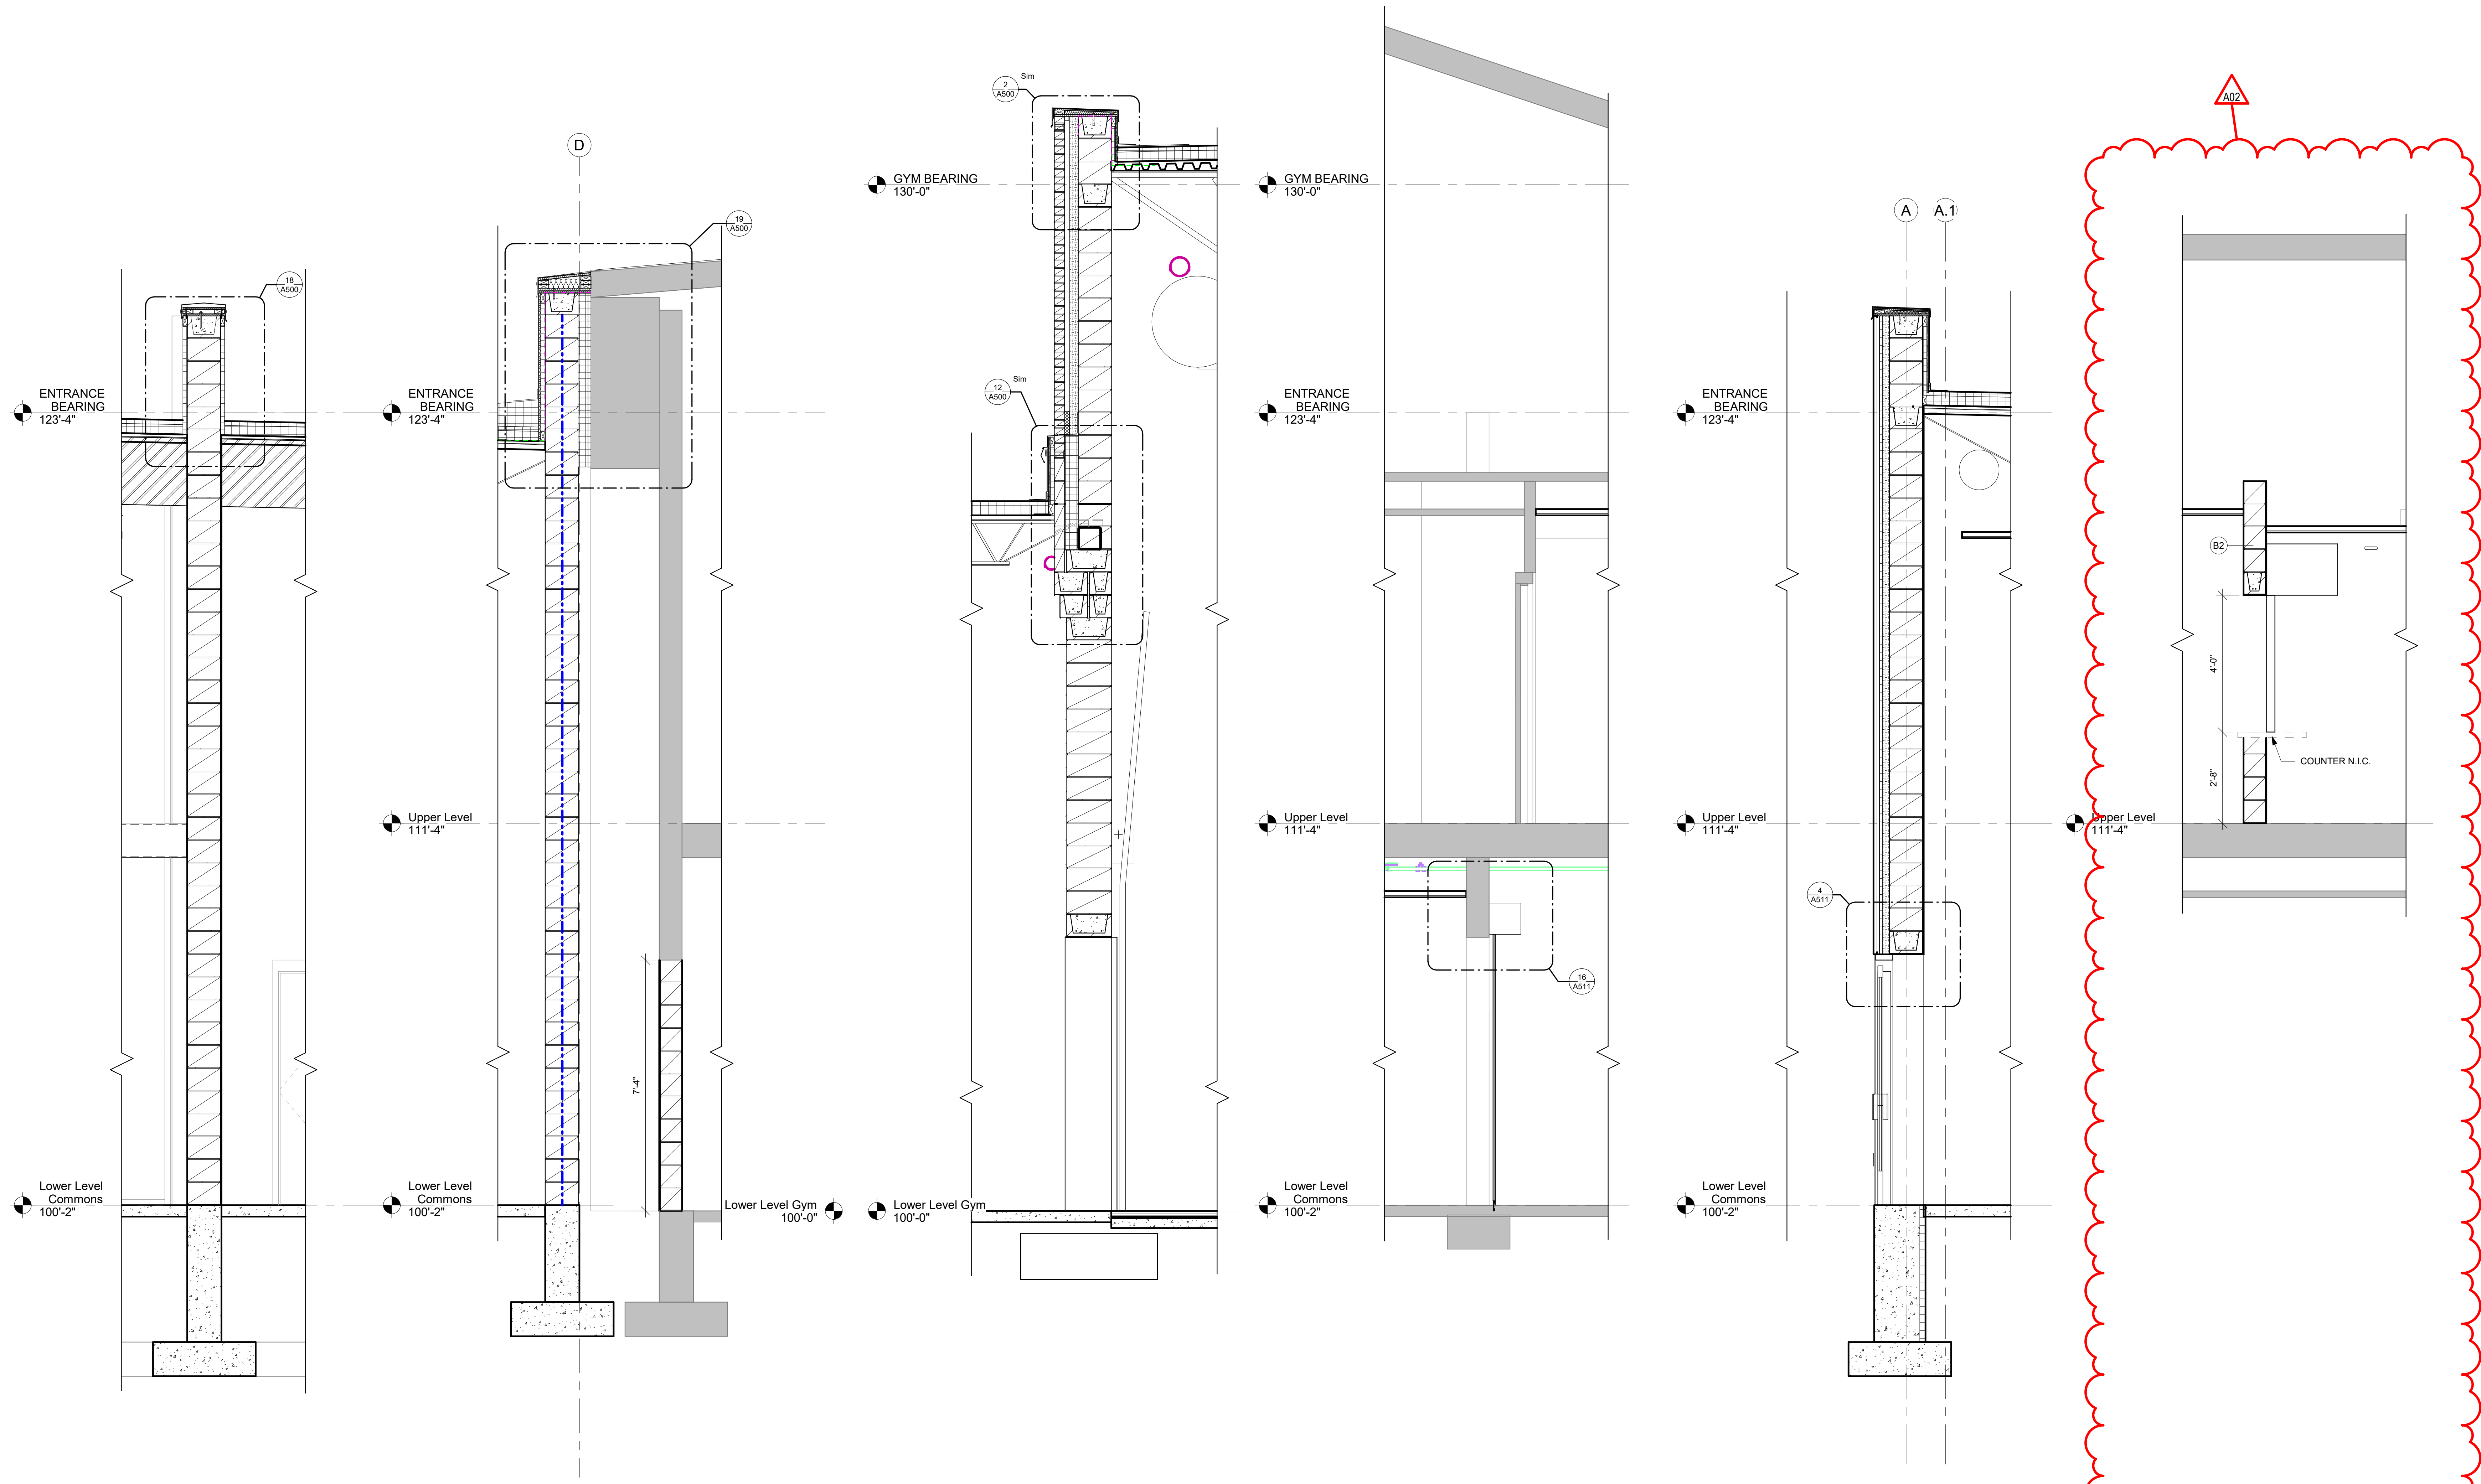

1 WALL SECTION
1/2" = 1'-0"

2 WALL SECTION
1/2" = 1'-0"

3 WALL SECTION
1/2" = 1'-0"

4 WALL SECTION
1/2" = 1'-0"

5 WALL SECTION
1/2" = 1'-0"

6 WALL SECTION
1/2" = 1'-0"

**LANESBORO PUBLIC SCHOOLS
ADDITION & REMODEL**

Project: 204 KIRKWOOD ST EAST
Location: LANESBORO, MN 55949

Sheet Title: **WALL SECTIONS**

HSR Project Number: 18063
Project Date: 7-25-19
Drawn By: TBS/SRW

Revisions:

No.	Description	Date
A02	ADDENDUM #02	8-19-19

Graphic Scale: VARIES

Last Update: 8/19/2019 10:09:06 AM

A306



Consultant:

ENGINEER CERTIFICATION

I hereby certify that this Plan, Specification or Report was prepared by me or under my direct supervision and that I am a duly licensed Engineer under the laws of the state of Minnesota.

Fin Temple
Date: July 9, 2019 Lic No: 10311
This drawing is conditionally issued and reproduction or use of any technical design information is strictly forbidden without written agreement from the responsible Engineer.

ARCHITECT CERTIFICATION

I hereby certify that this Plan, Specification or Report was prepared by me or under my direct supervision and that I am a duly licensed Architect under the laws of the state of Minnesota.

Quill On
Date: July 9, 2019 Lic No: 58867
This drawing is conditionally issued and reproduction or use of any technical design information is strictly forbidden without written agreement from the responsible Architect.

LANESBORO PUBLIC SCHOOLS
ADDITION & REMODEL

204 KIRKWOOD ST EAST
LANESBORO, MN 55949

SECTION DETAILS

Project Title: HSR Project Number: 18063
Project Date: 7-25-19
Drawn By: HSR

Key Plan: SEG A, SEG B, SEG C


Revisions:

No.	Description	Date
A02	ADDENDUM #02	8-19-19


Graphic Scale: VARIES

Last Update: 8/20/2019 11:09:36 AM


A500

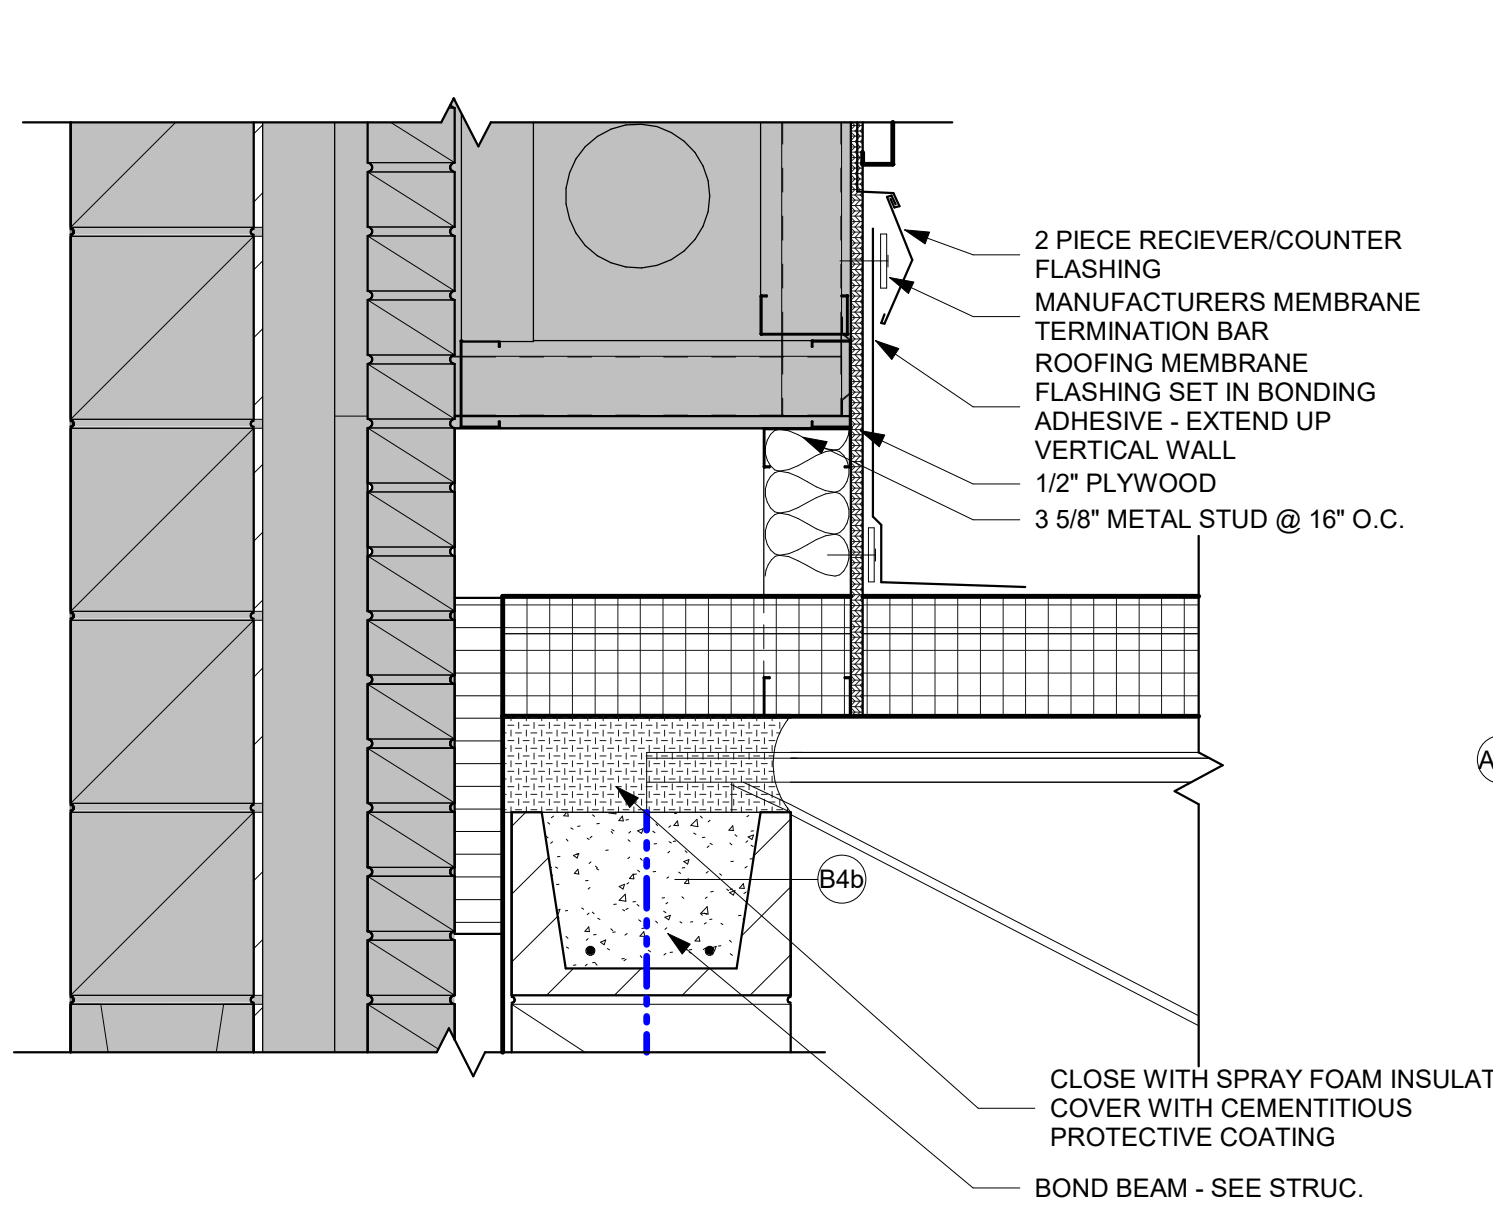


4 WALL DETAIL
1 1/2" = 1'-0"

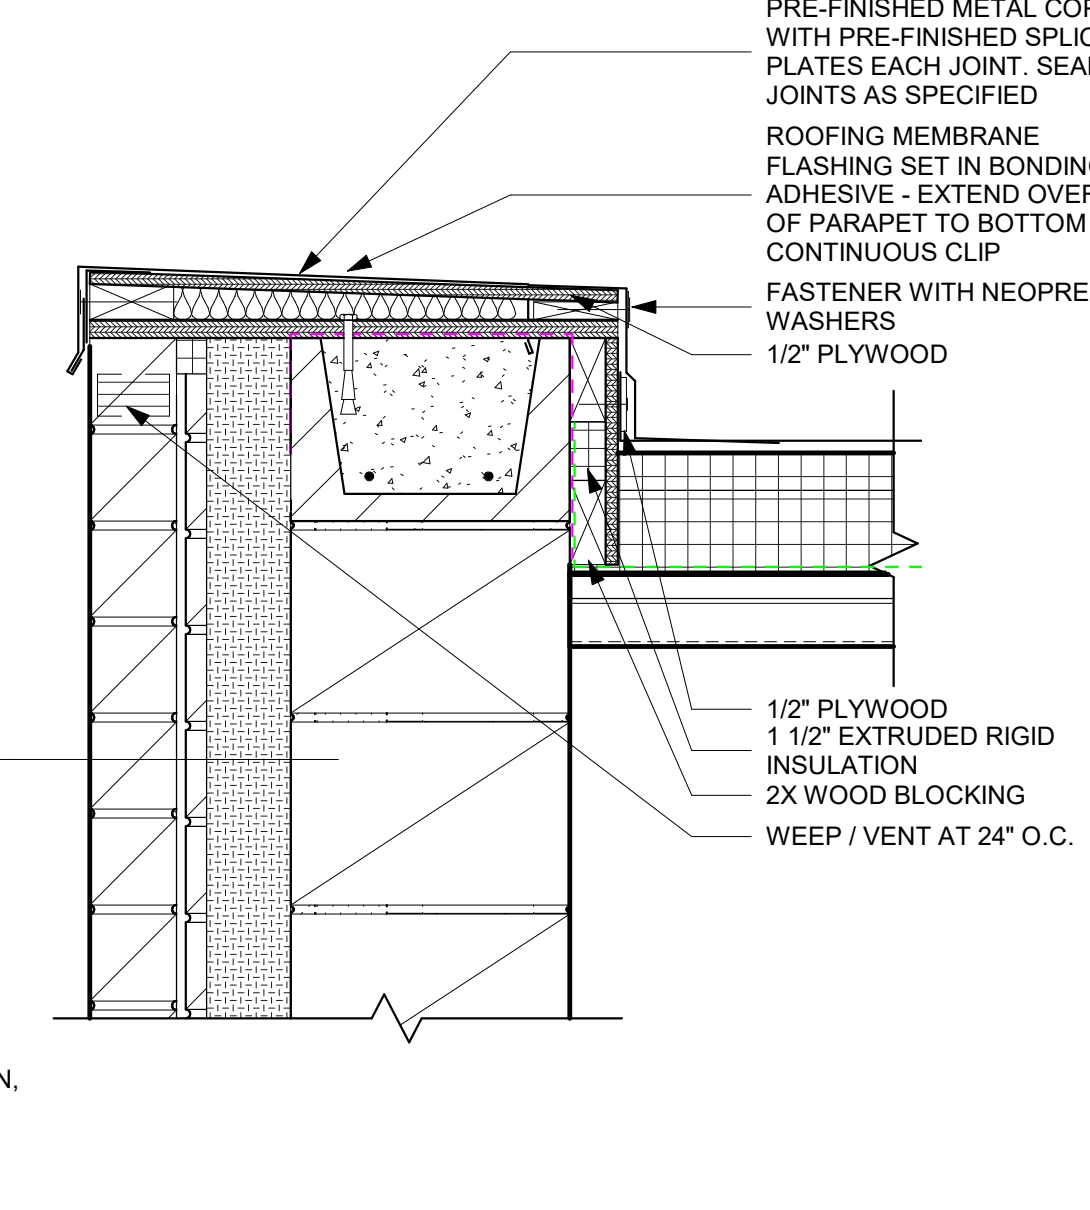


8 WALL DETAIL
1 1/2" = 1'-0"

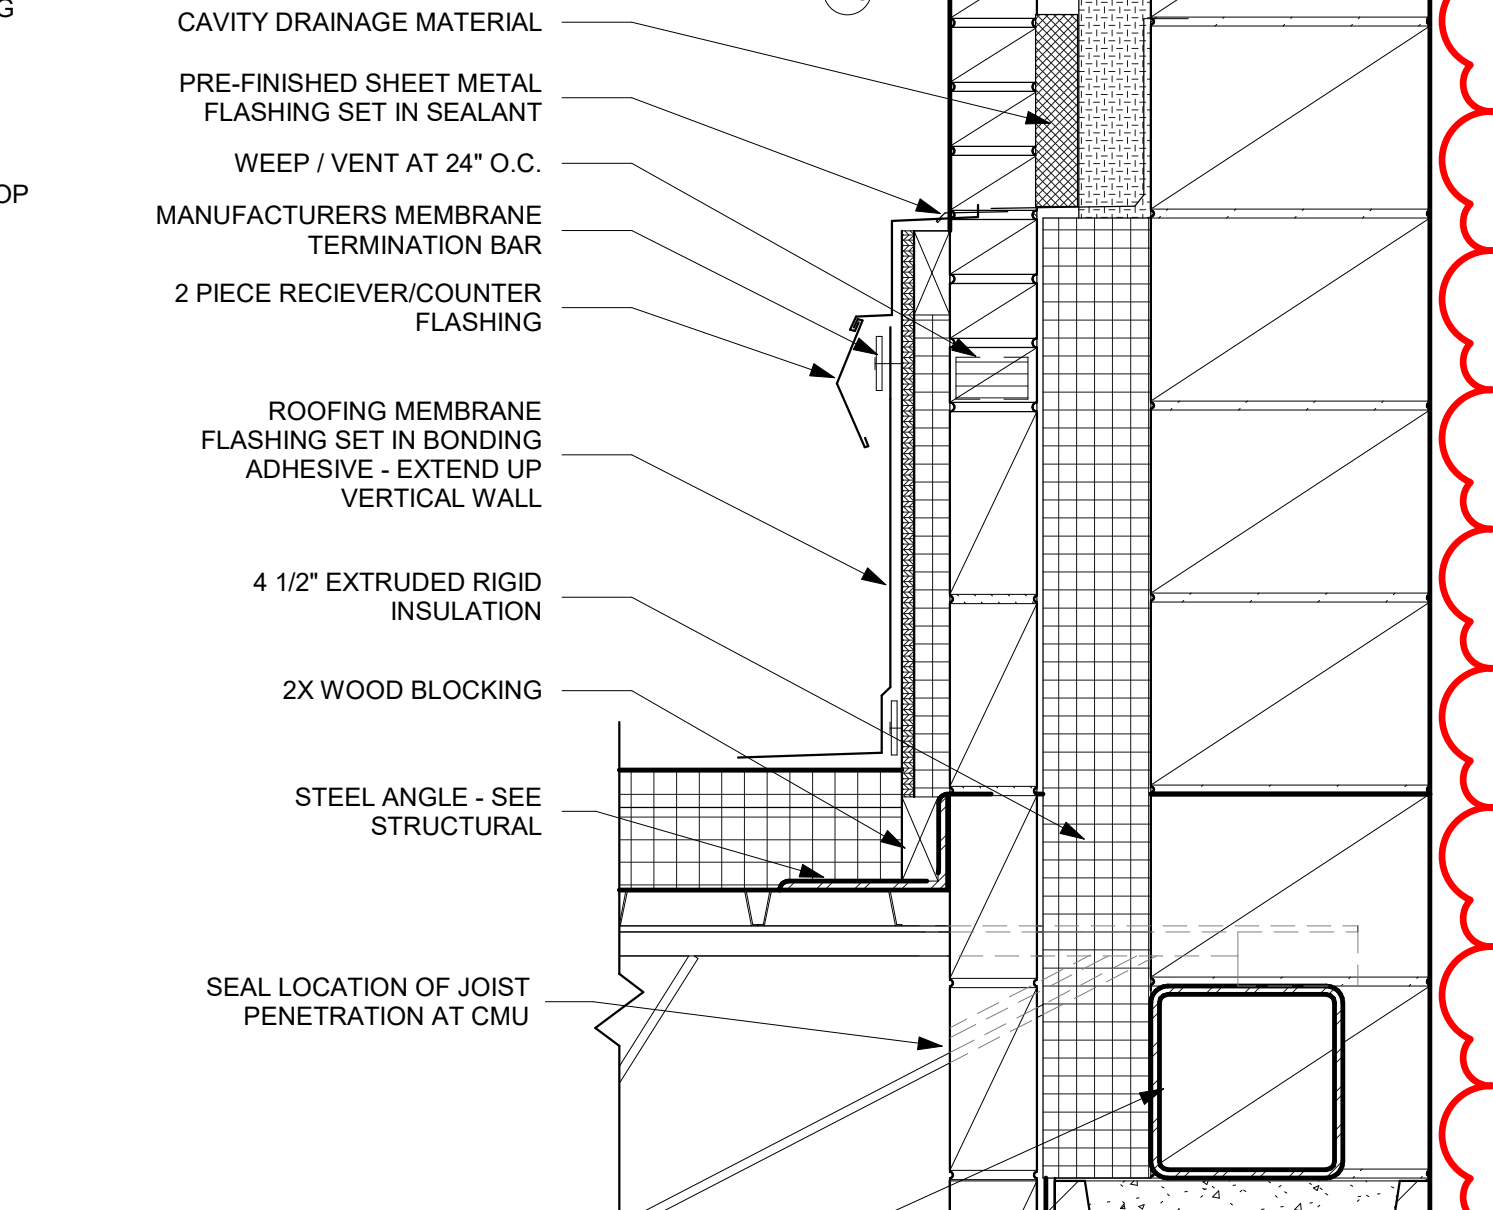


12 WALL DETAIL
1 1/2" = 1'-0"

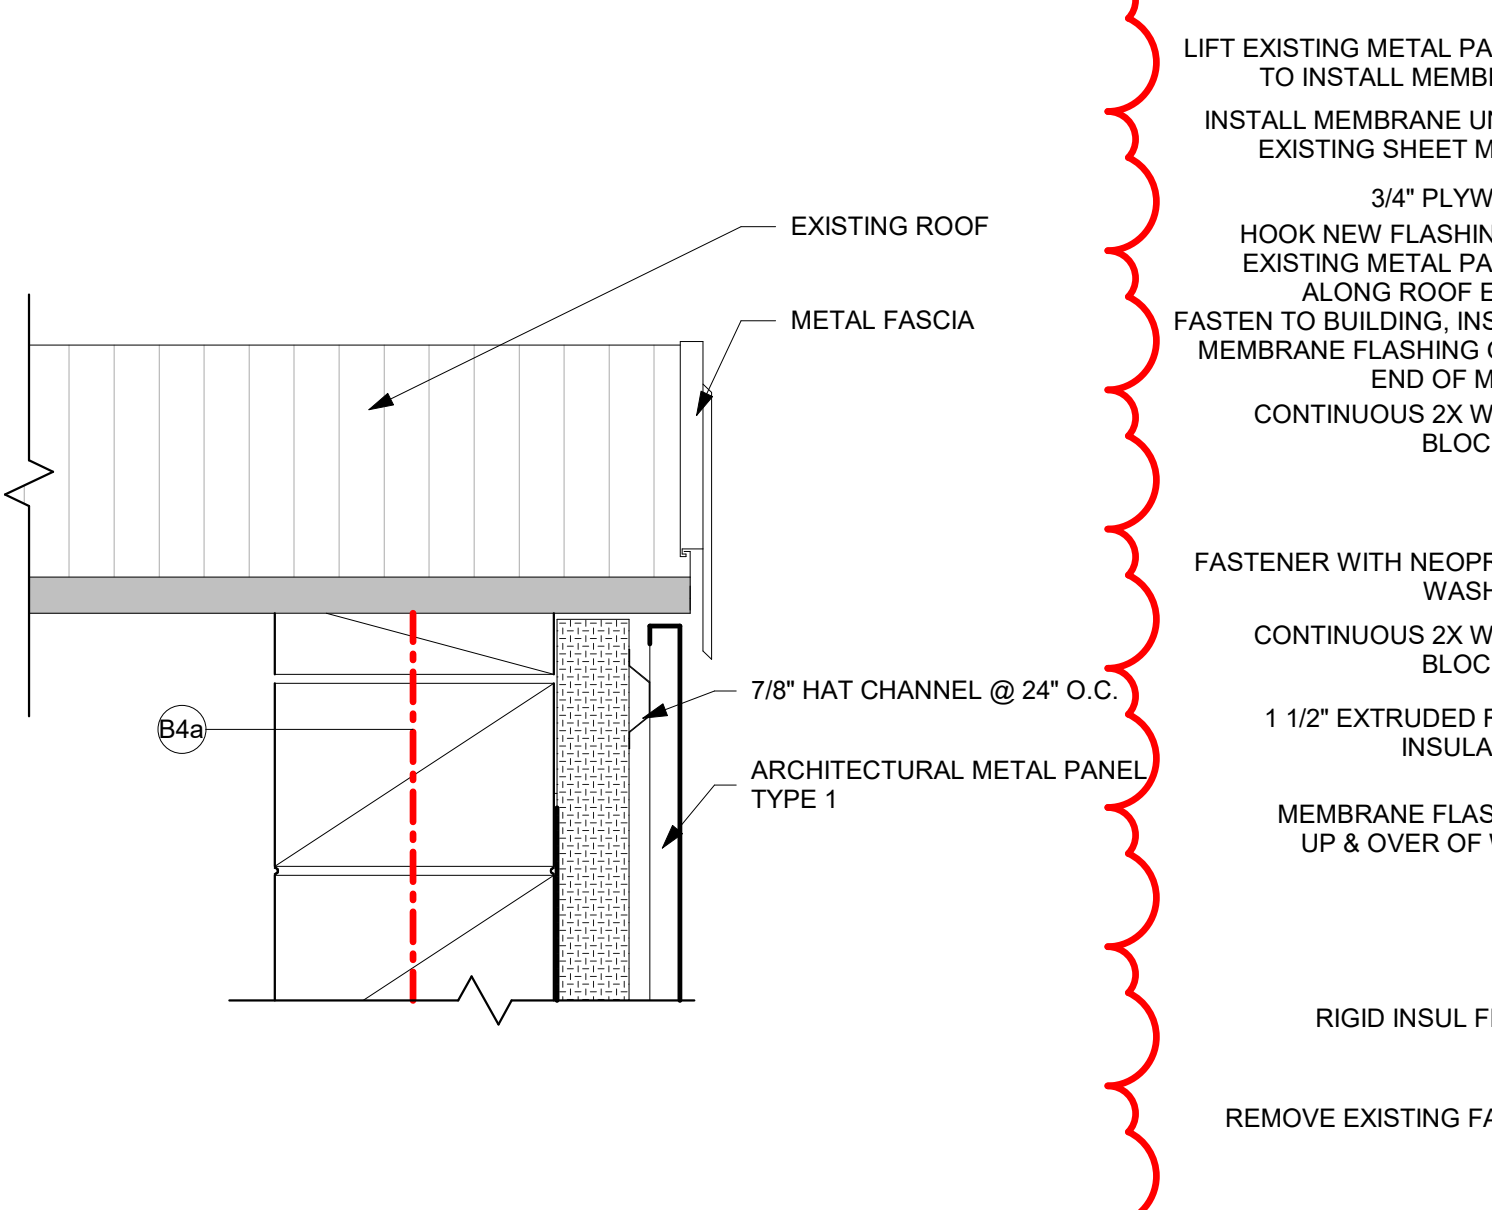


16 WALL DETAIL
1 1/2" = 1'-0"

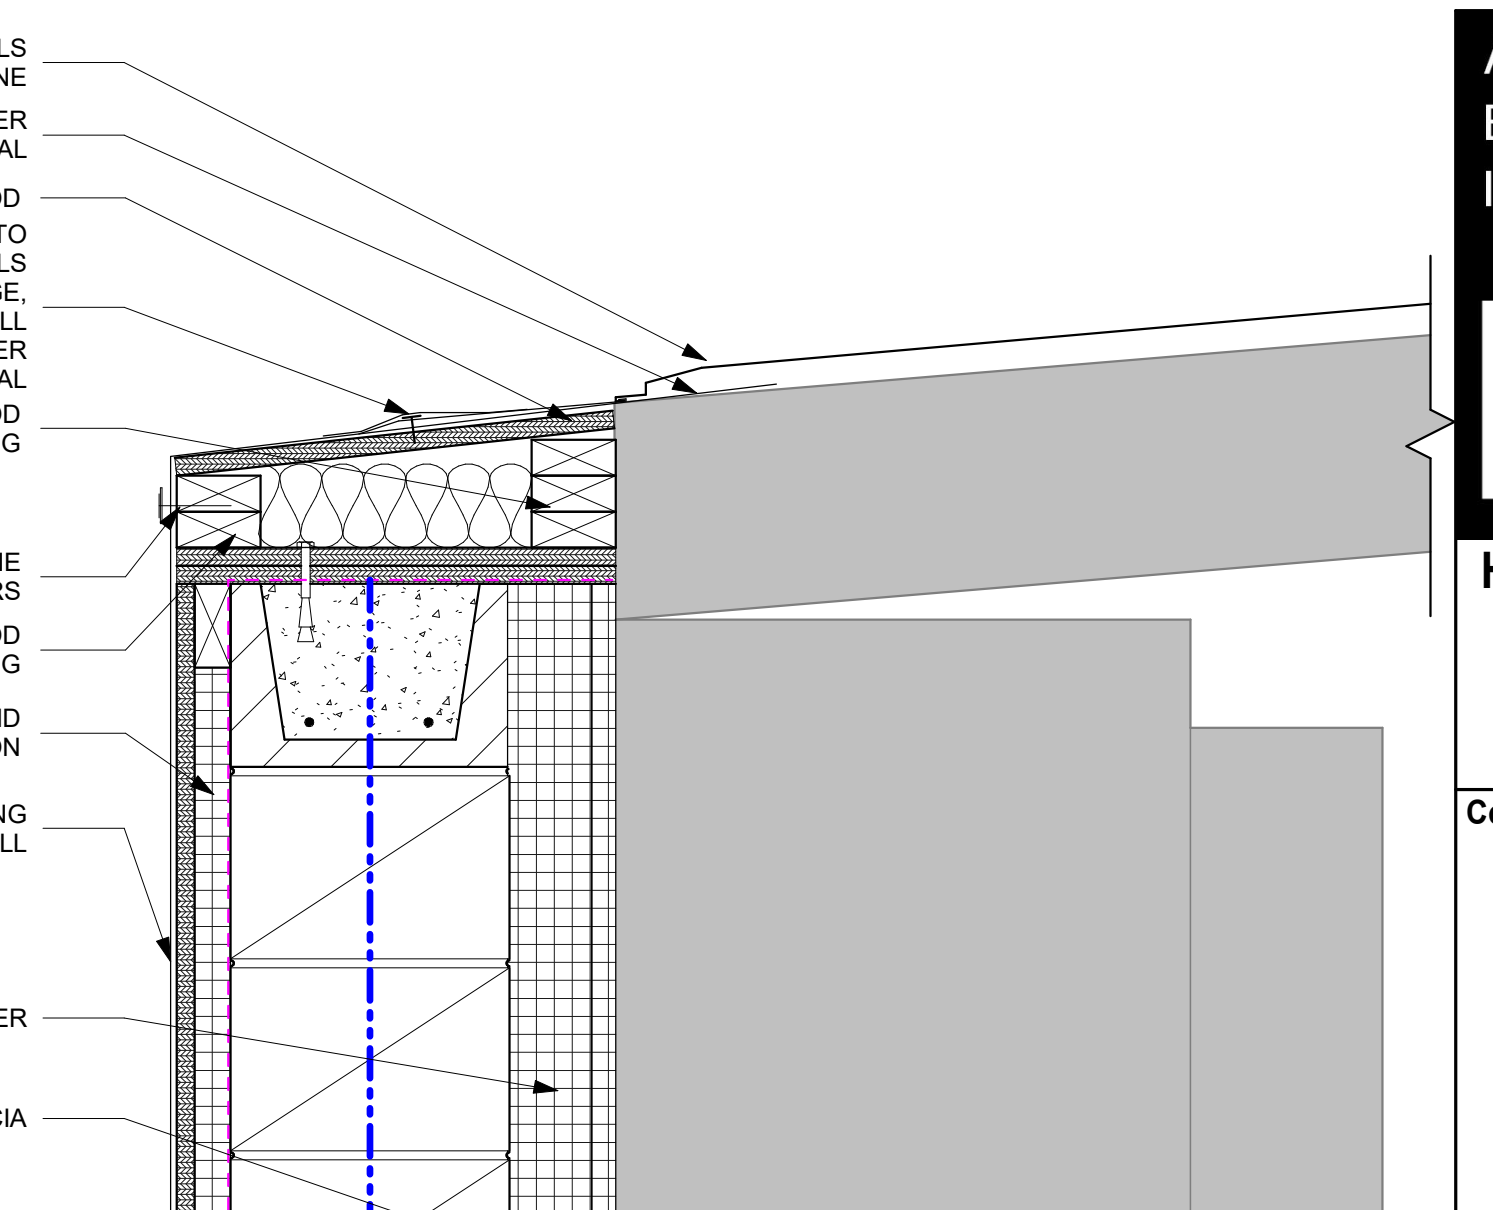


19 WALL DETAIL
1 1/2" = 1'-0"

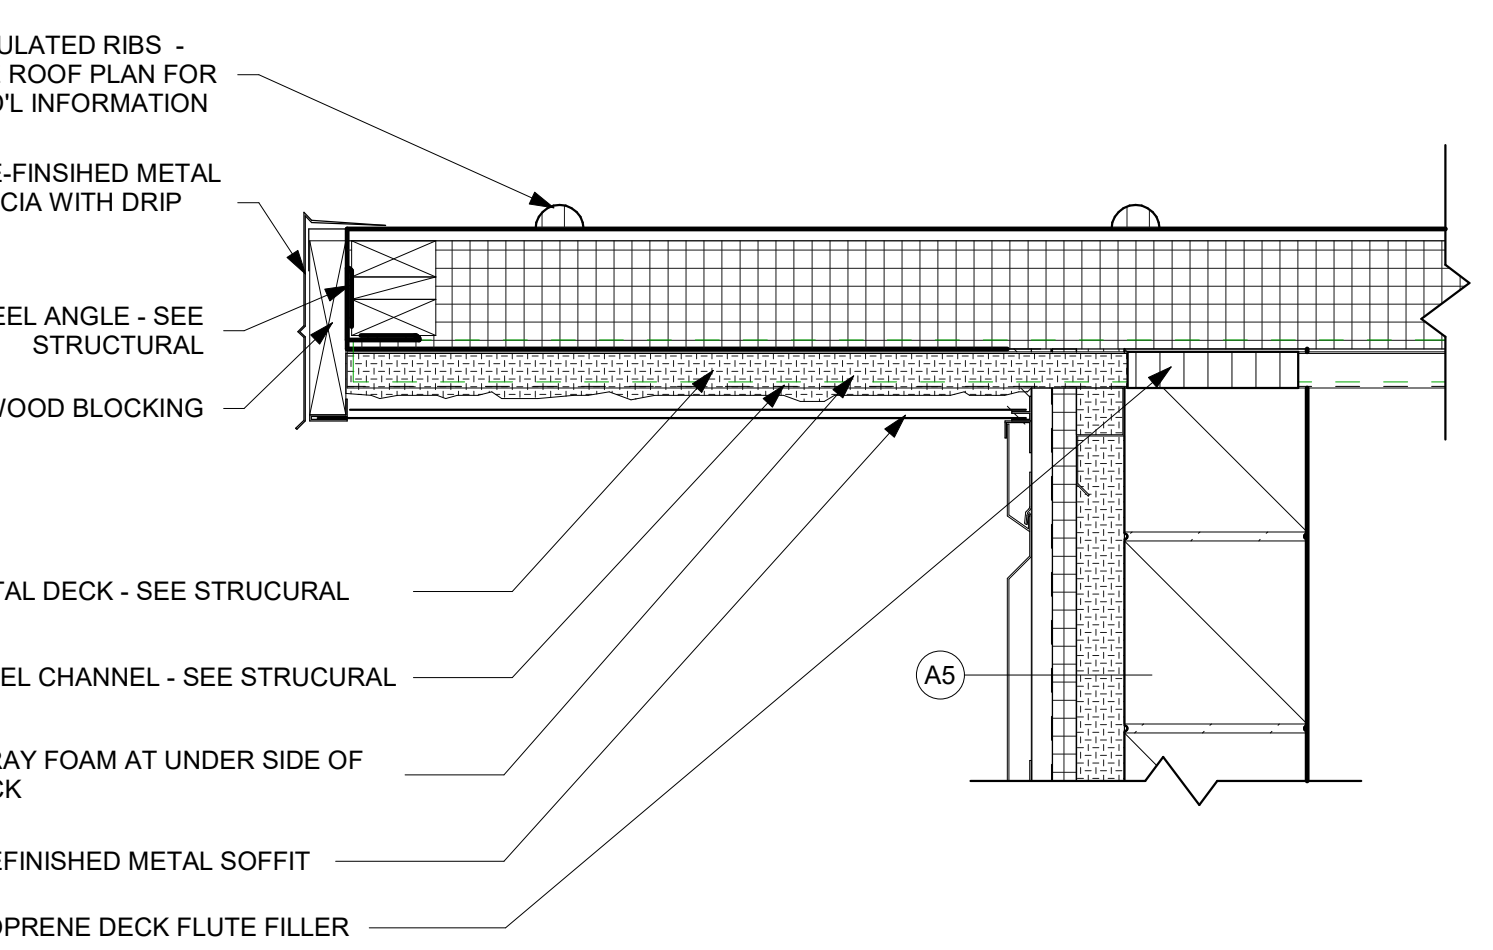


3 WALL DETAIL
1 1/2" = 1'-0"

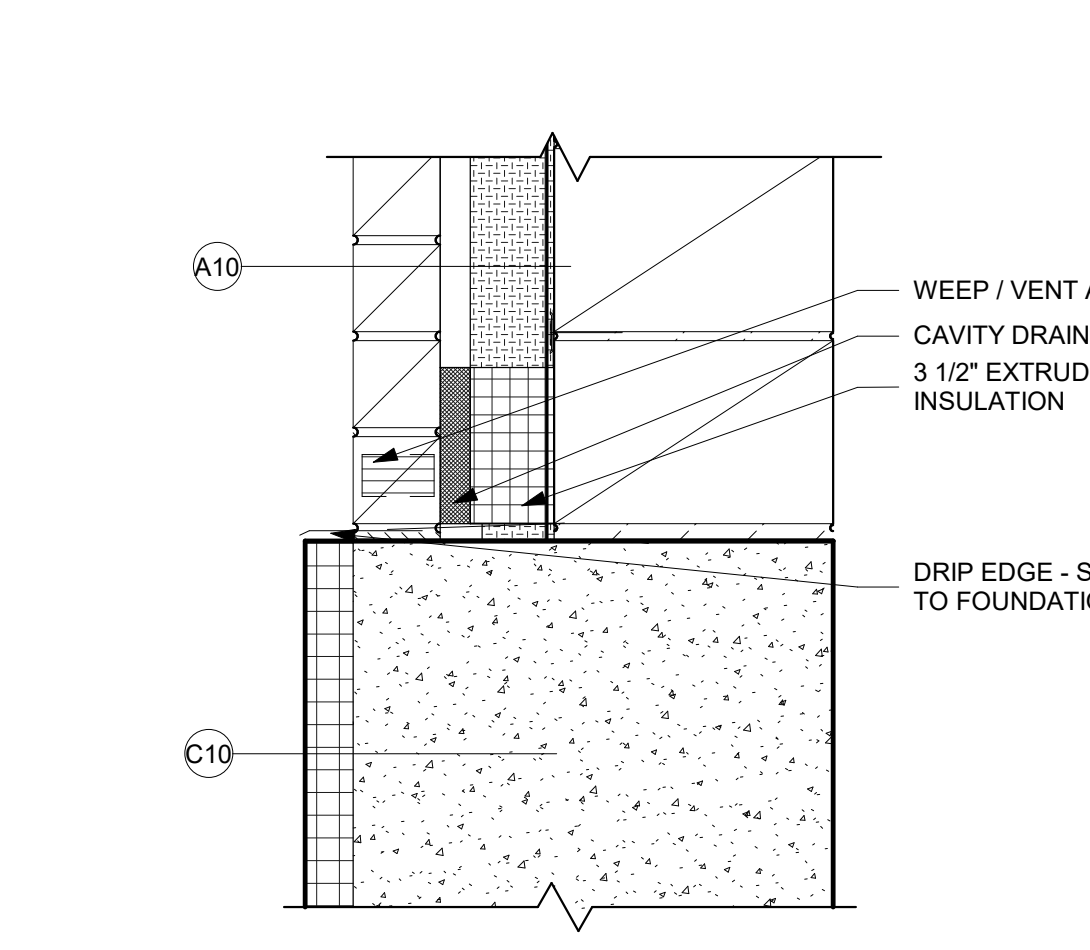


7 WALL DETAIL
1 1/2" = 1'-0"

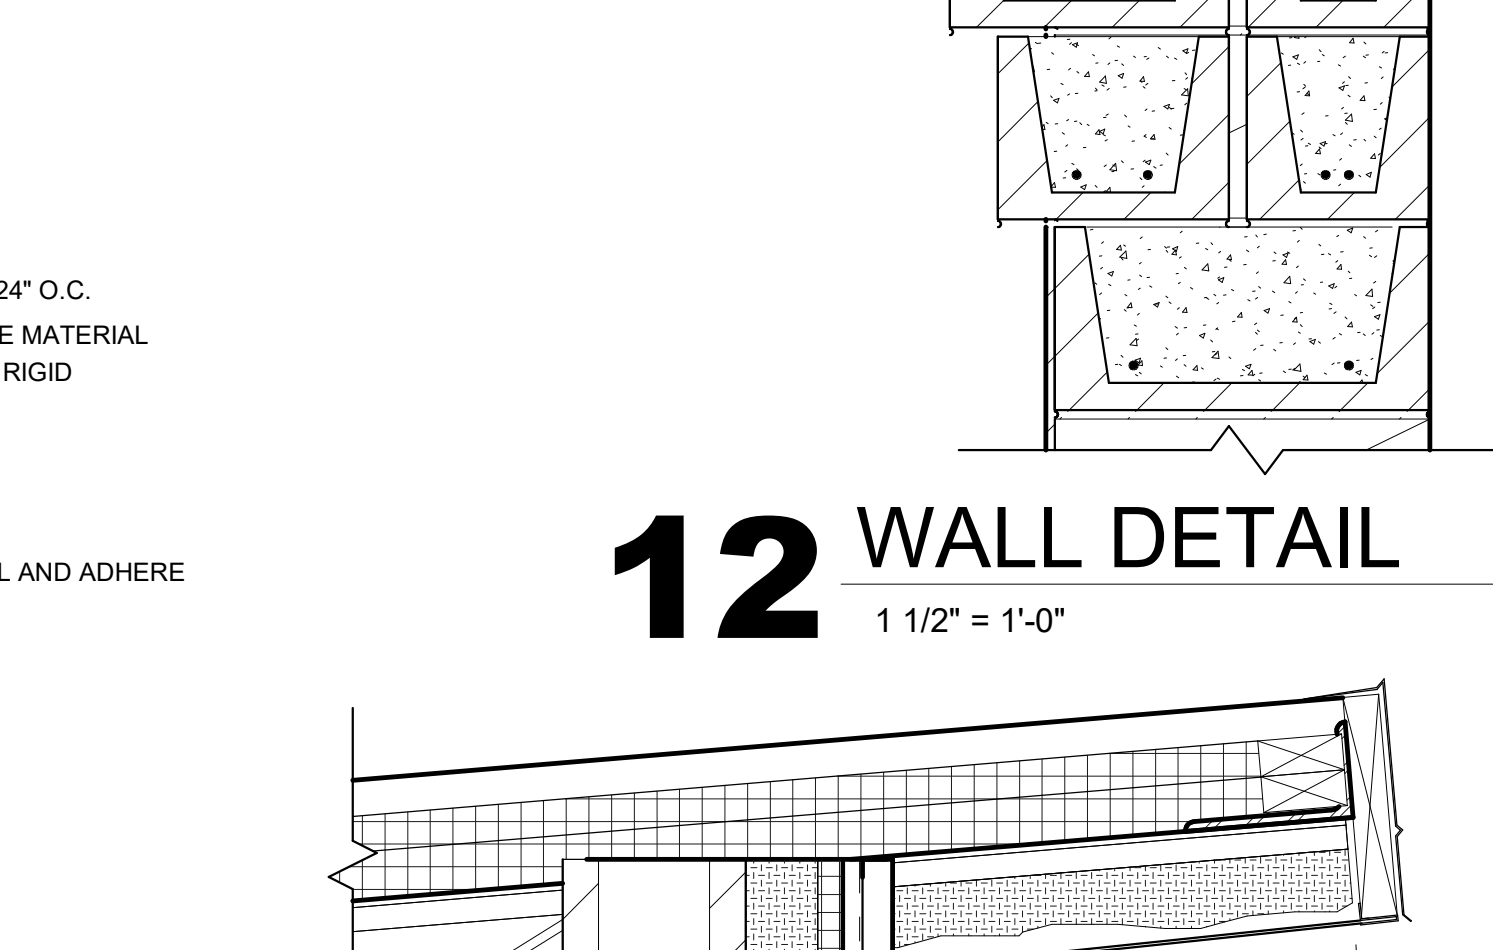


11 WALL DETAIL
1 1/2" = 1'-0"

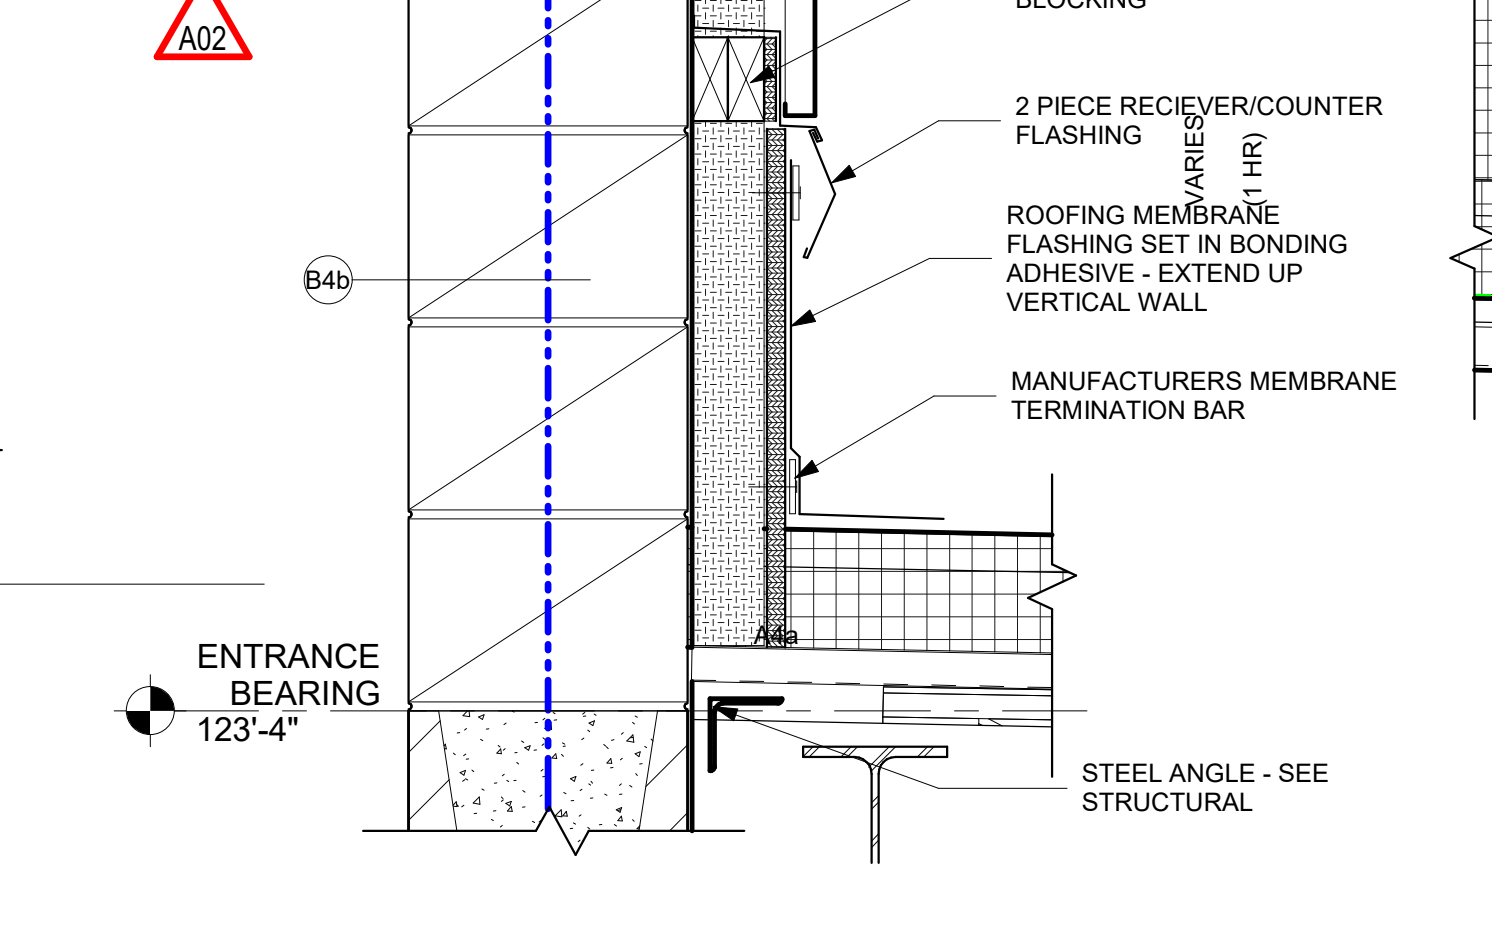


15 WALL DETAIL
1 1/2" = 1'-0"

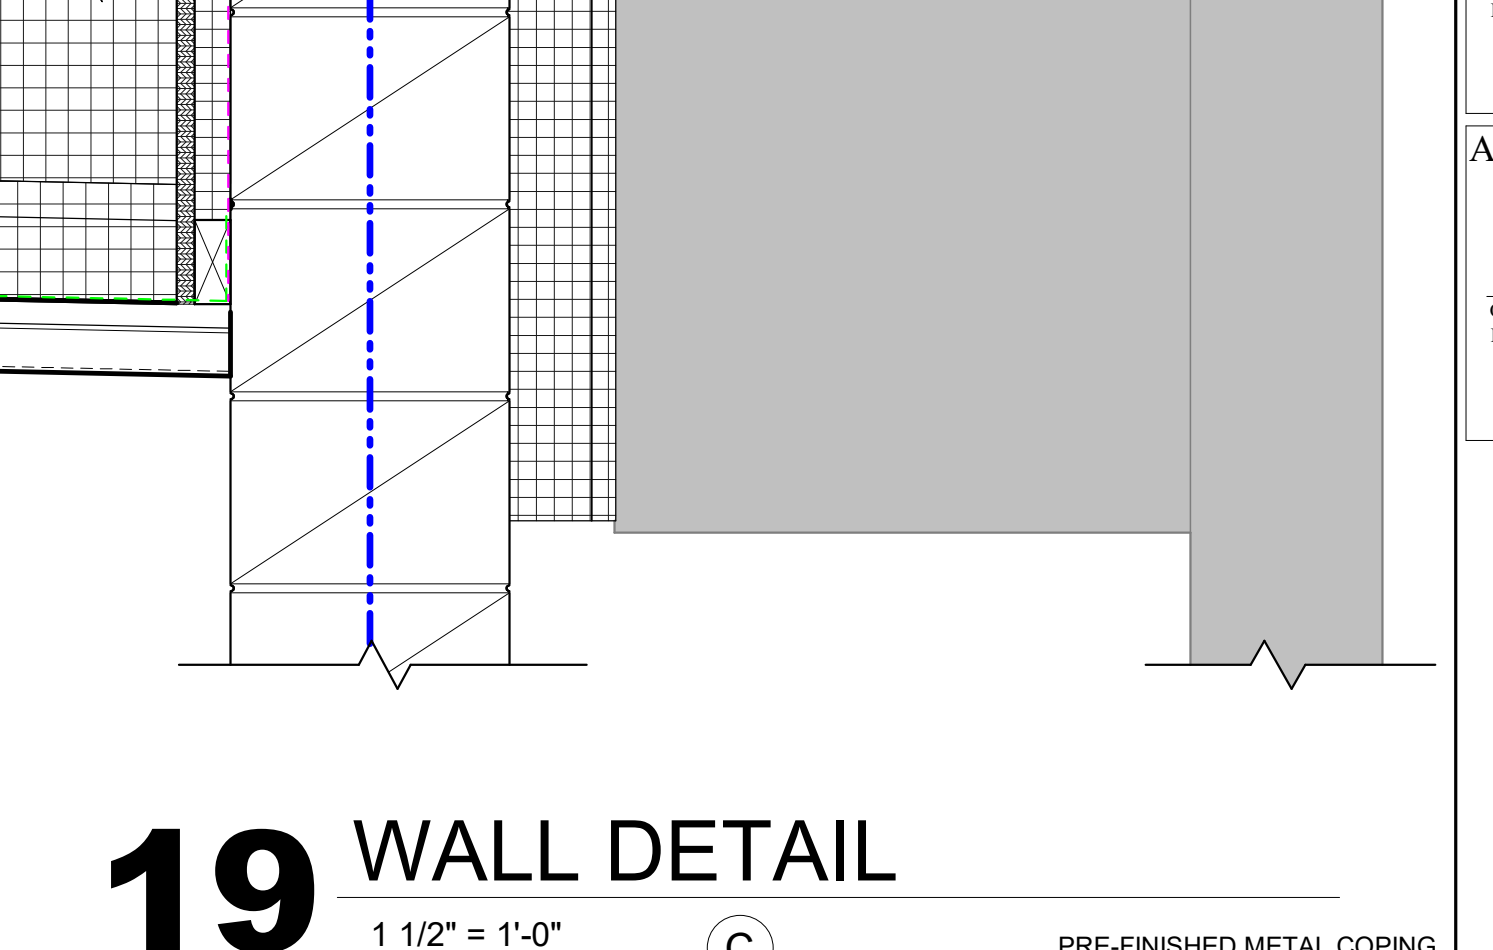


19 WALL DETAIL
1 1/2" = 1'-0"

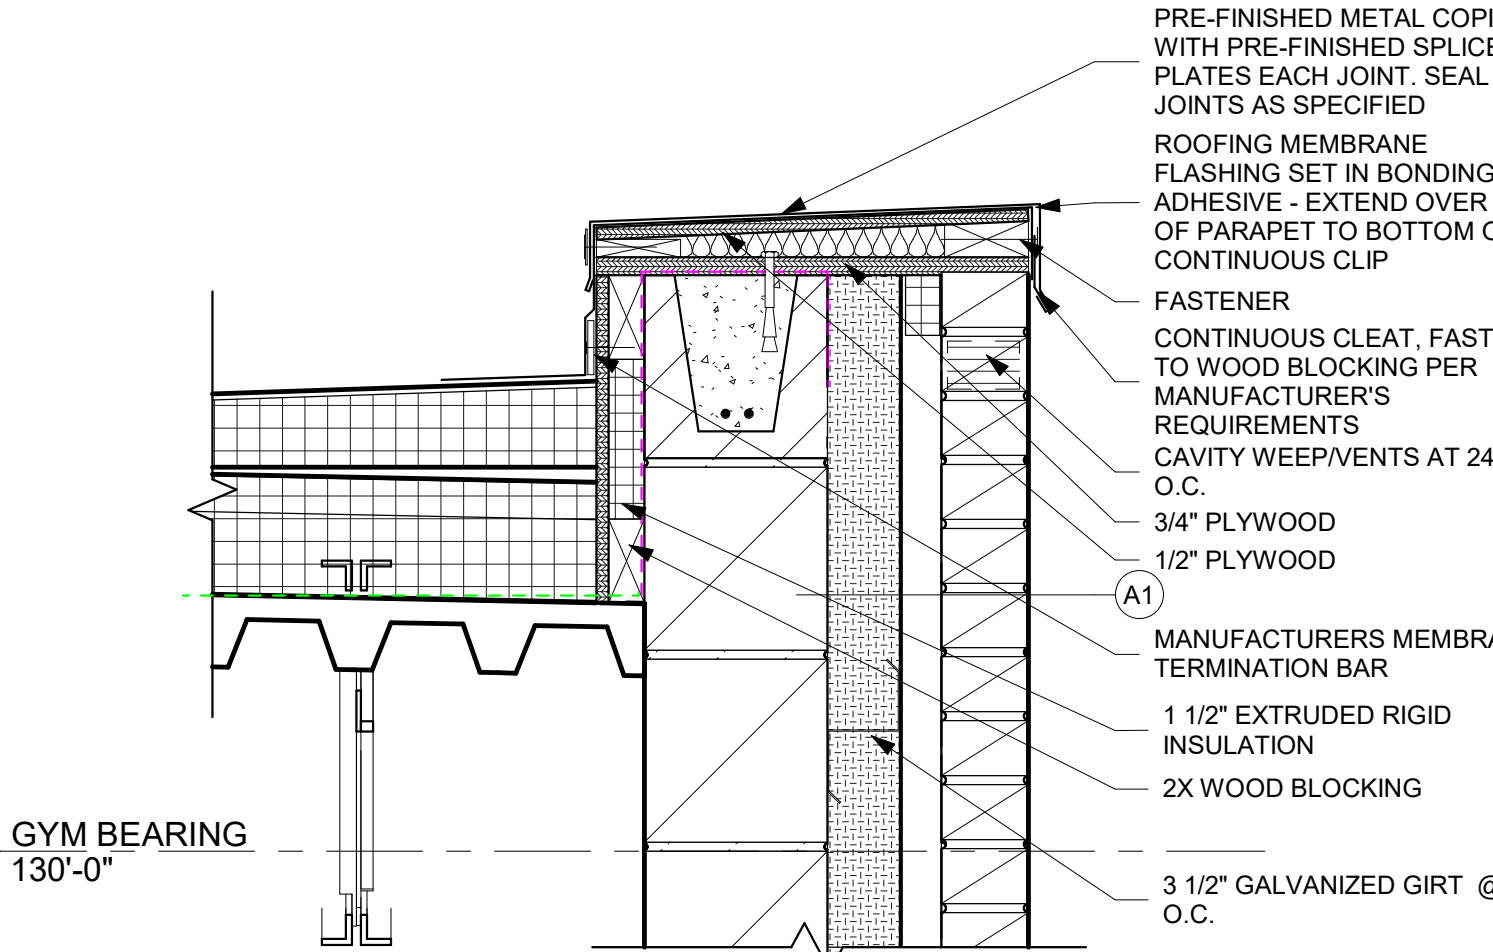


2 WALL DETAIL
1 1/2" = 1'-0"

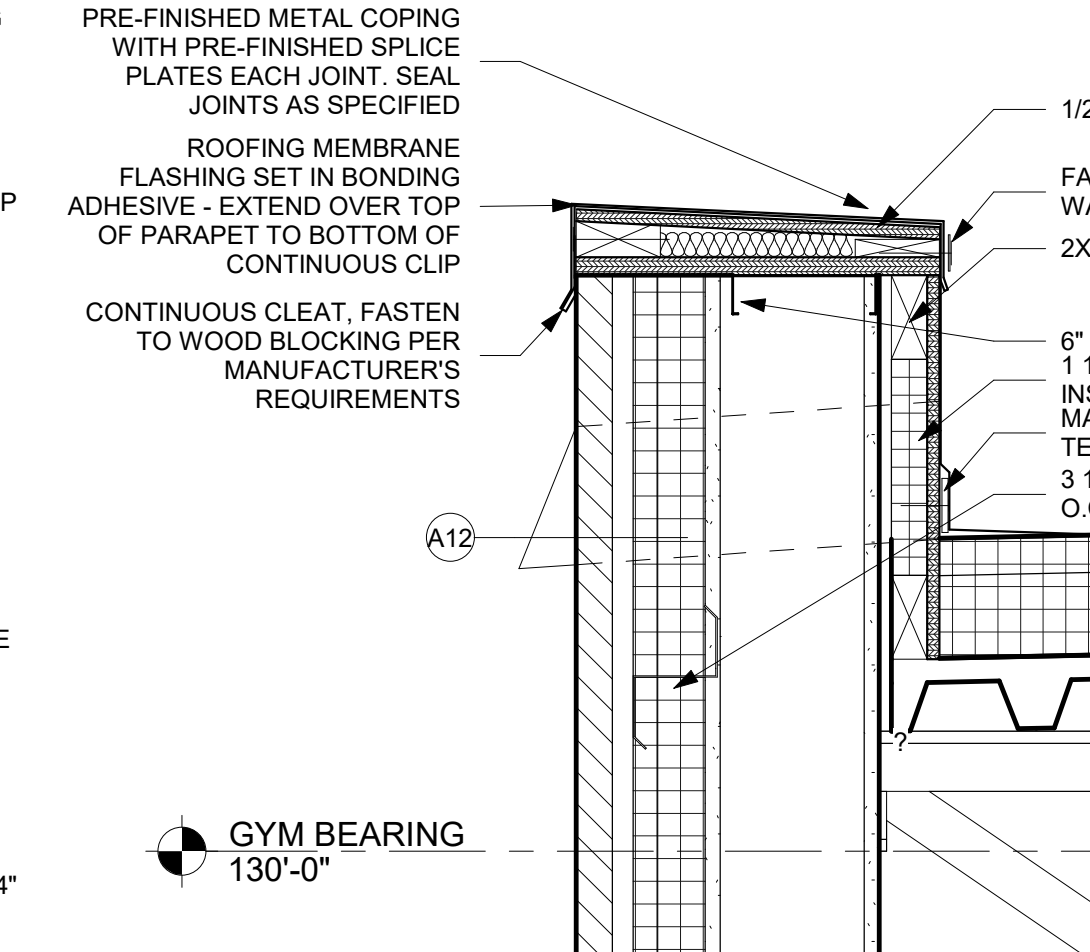


6 WALL DETAIL
1 1/2" = 1'-0"

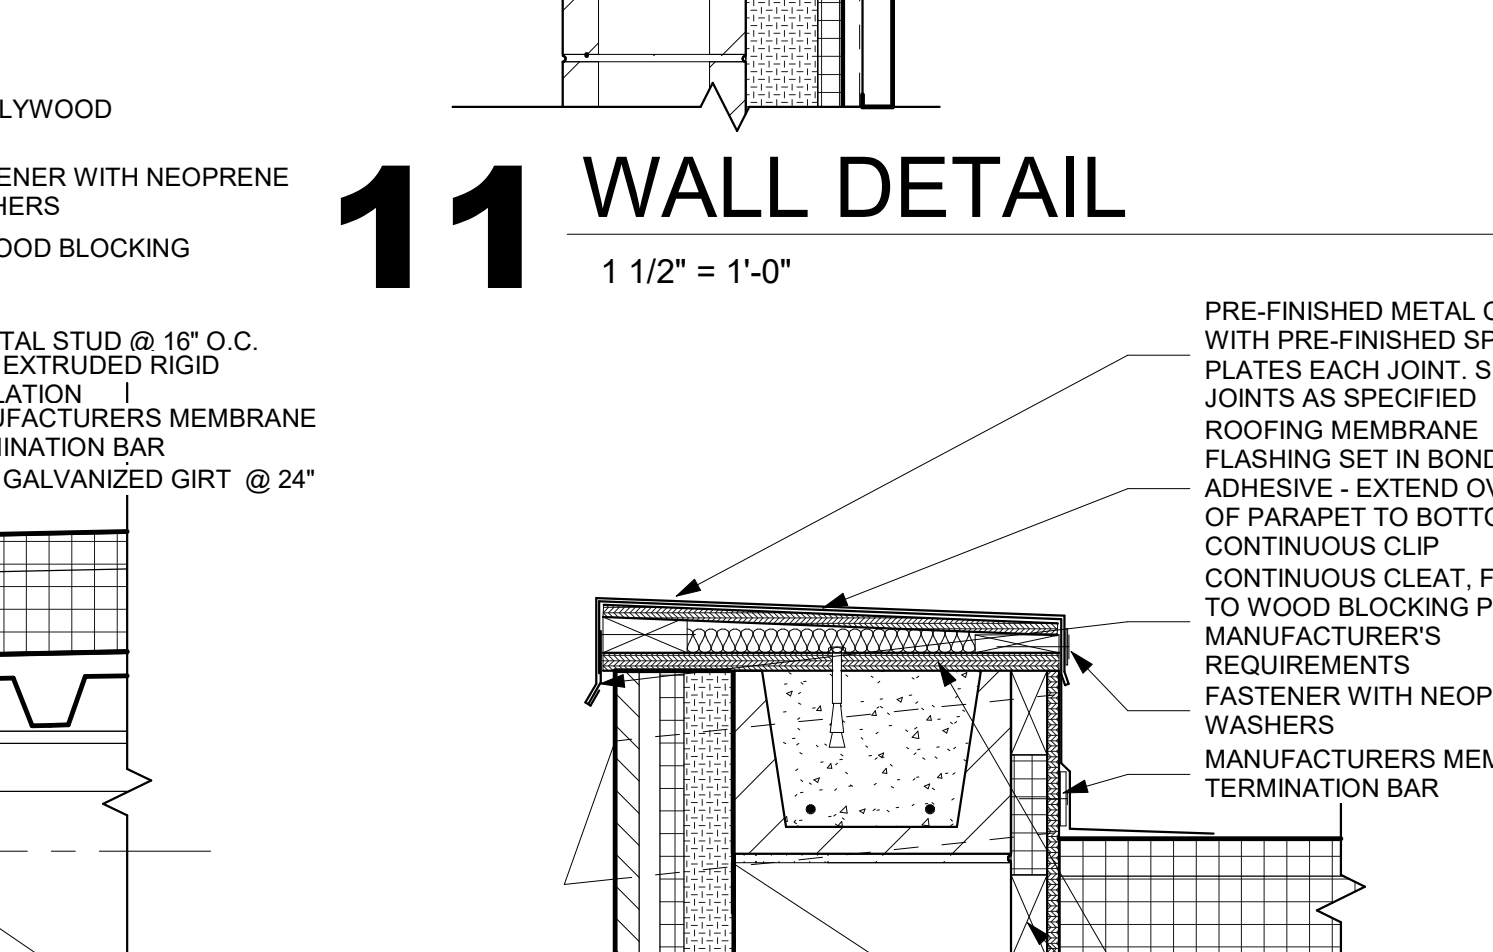


10 WALL DETAIL
1 1/2" = 1'-0"

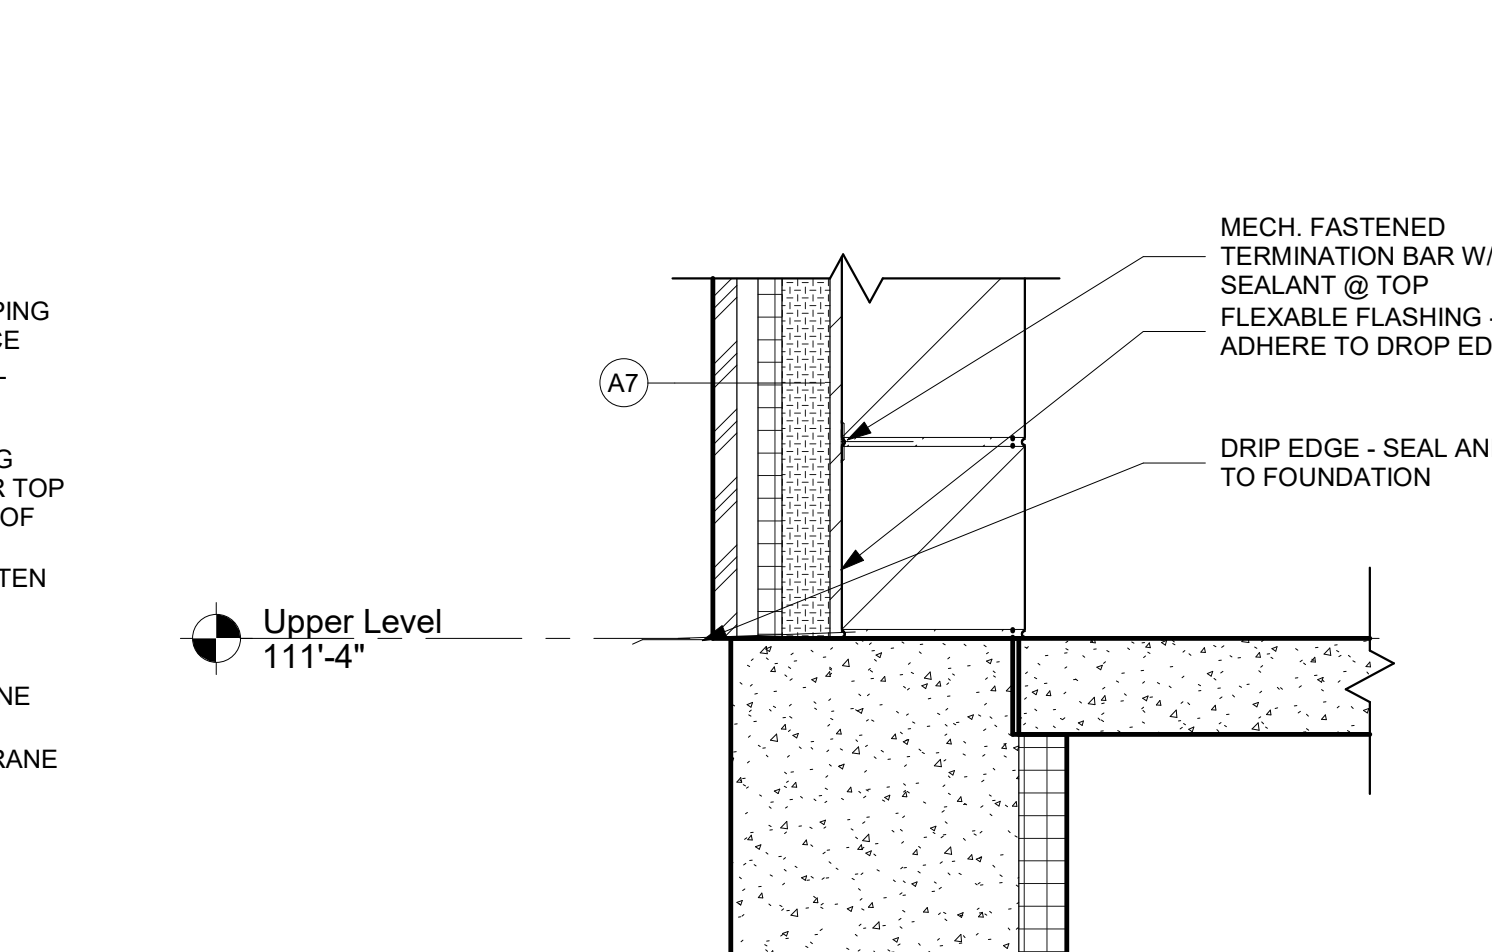


14 WALL DETAIL
1 1/2" = 1'-0"

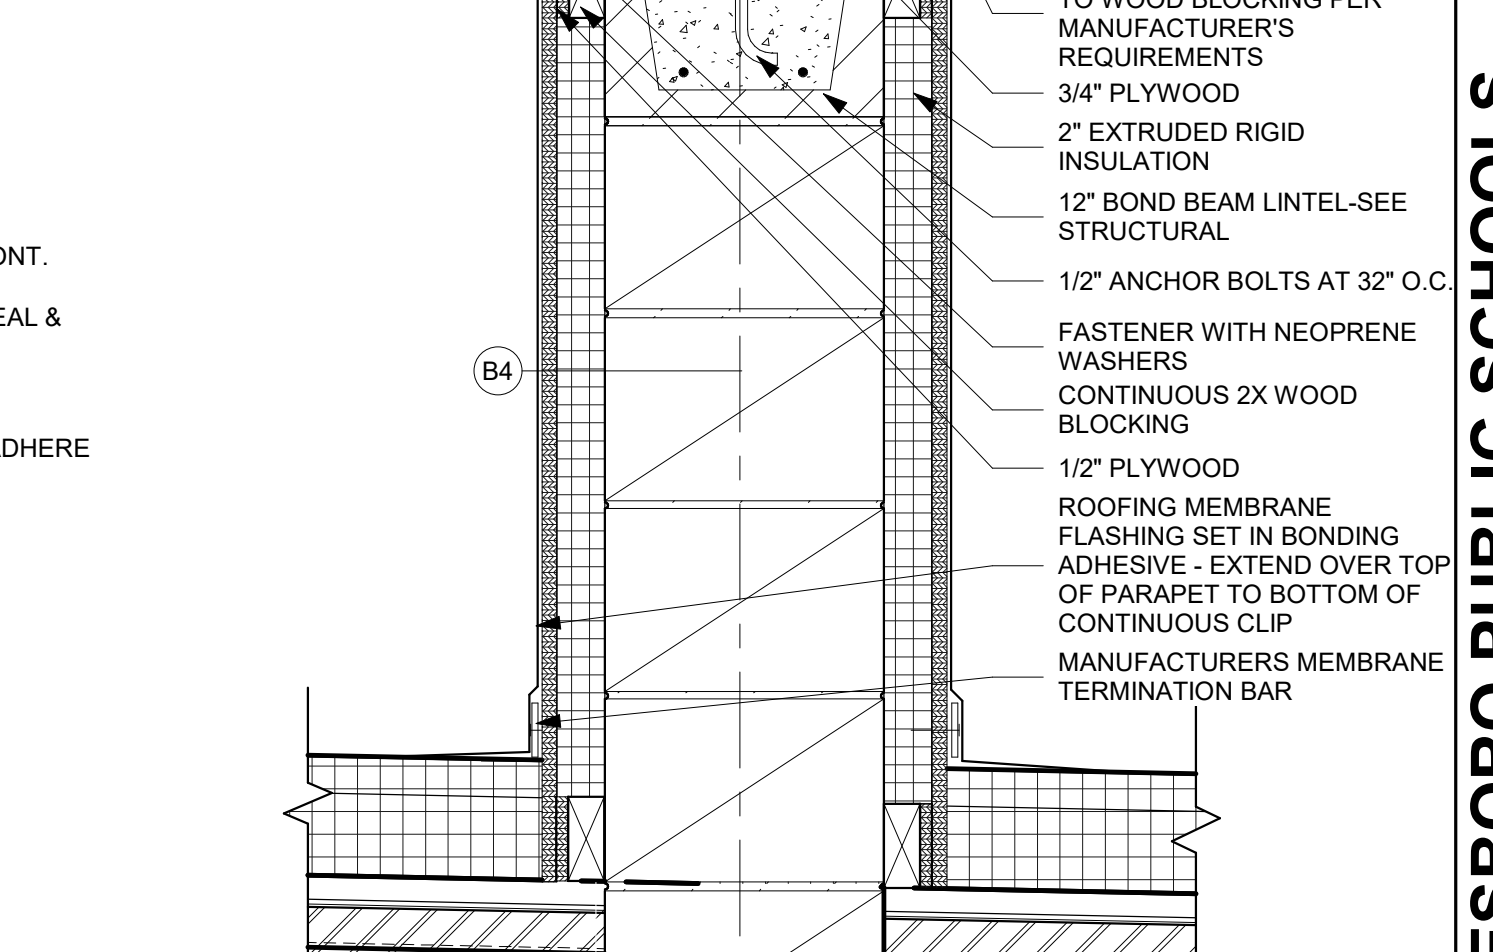


18 WALL DETAIL
1 1/2" = 1'-0"

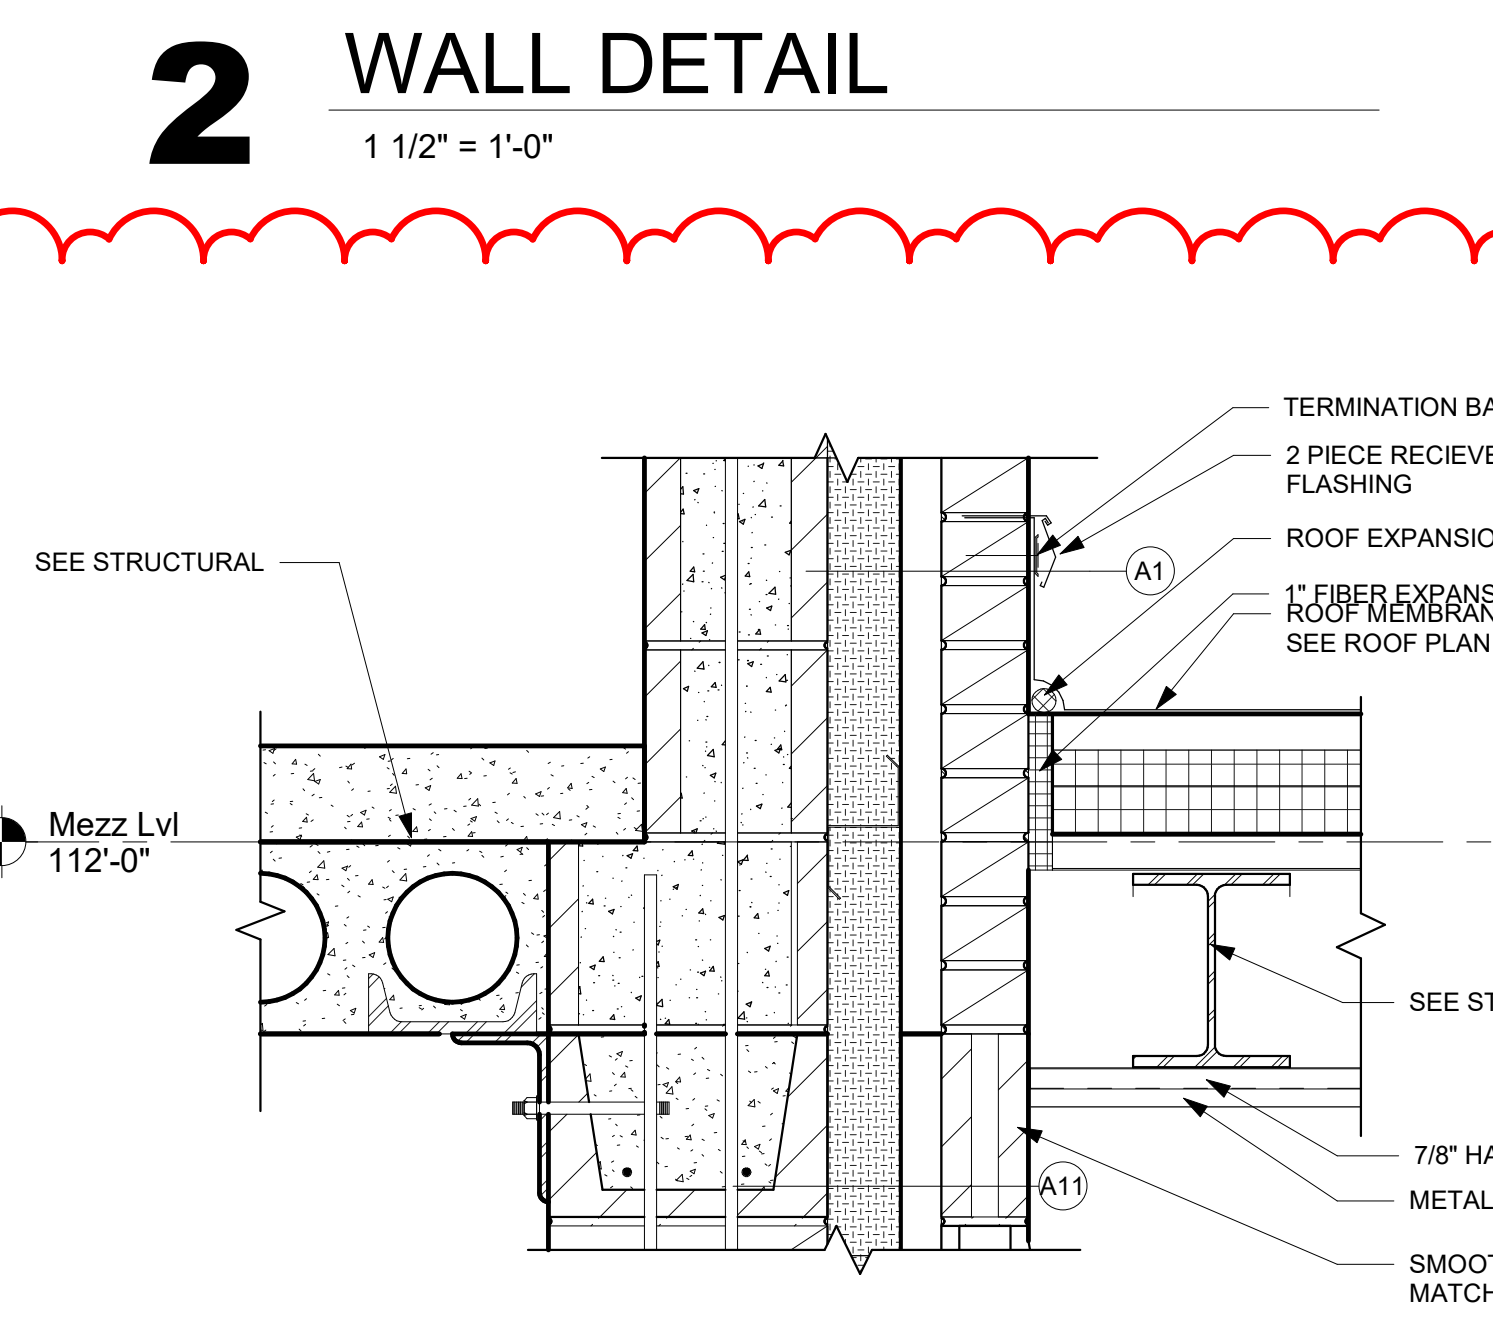


1 WALL DETAIL
1 1/2" = 1'-0"

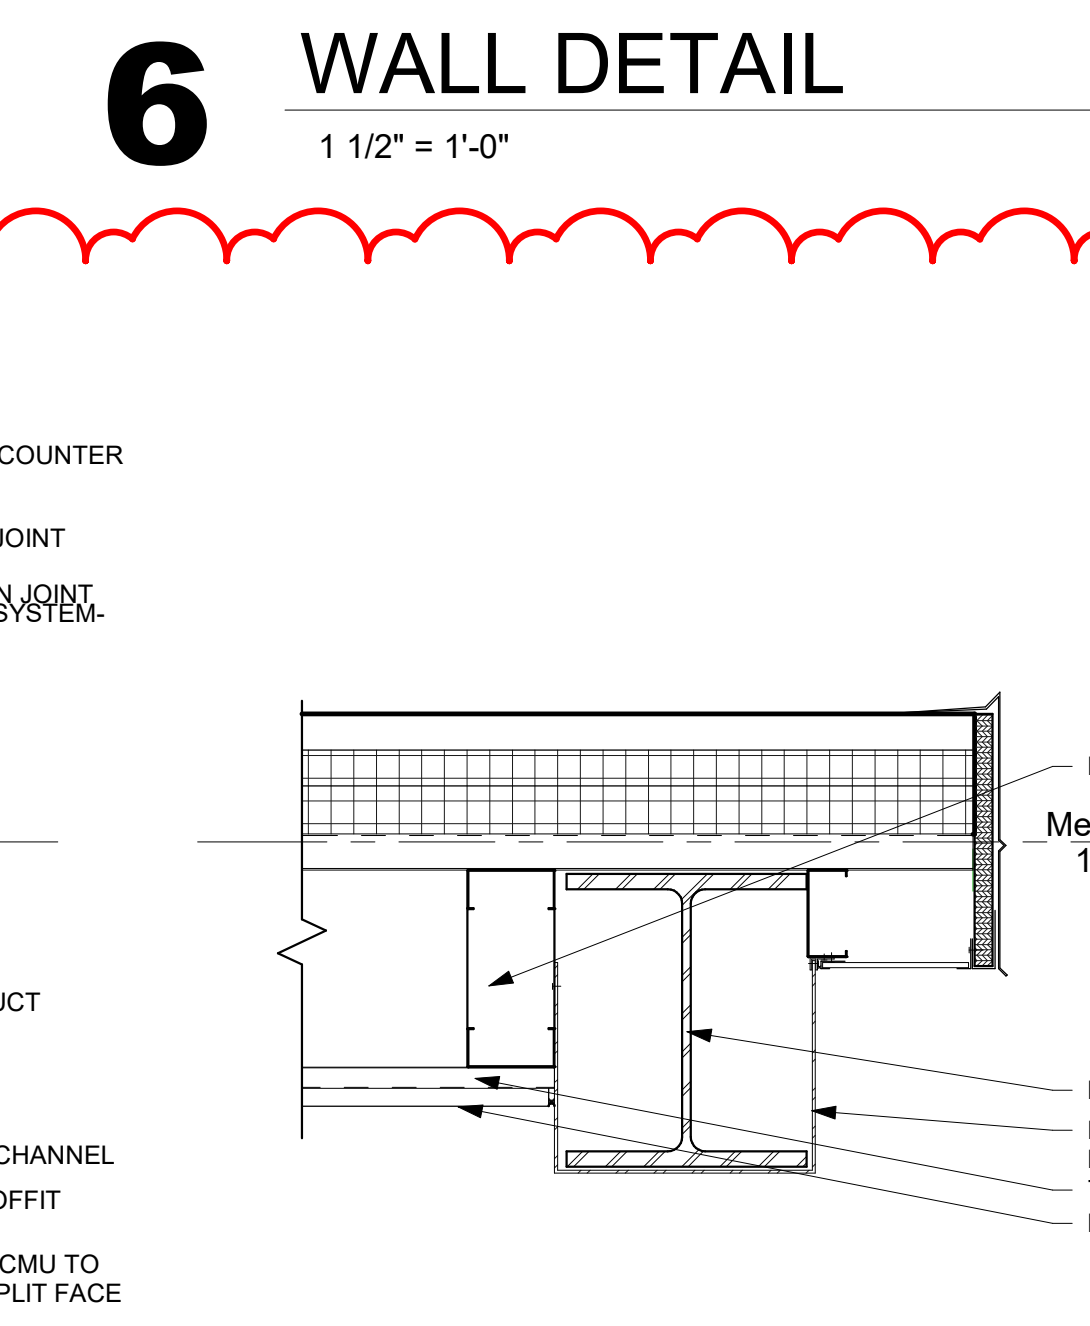


5 ROOF DETAIL
1 1/2" = 1'-0"

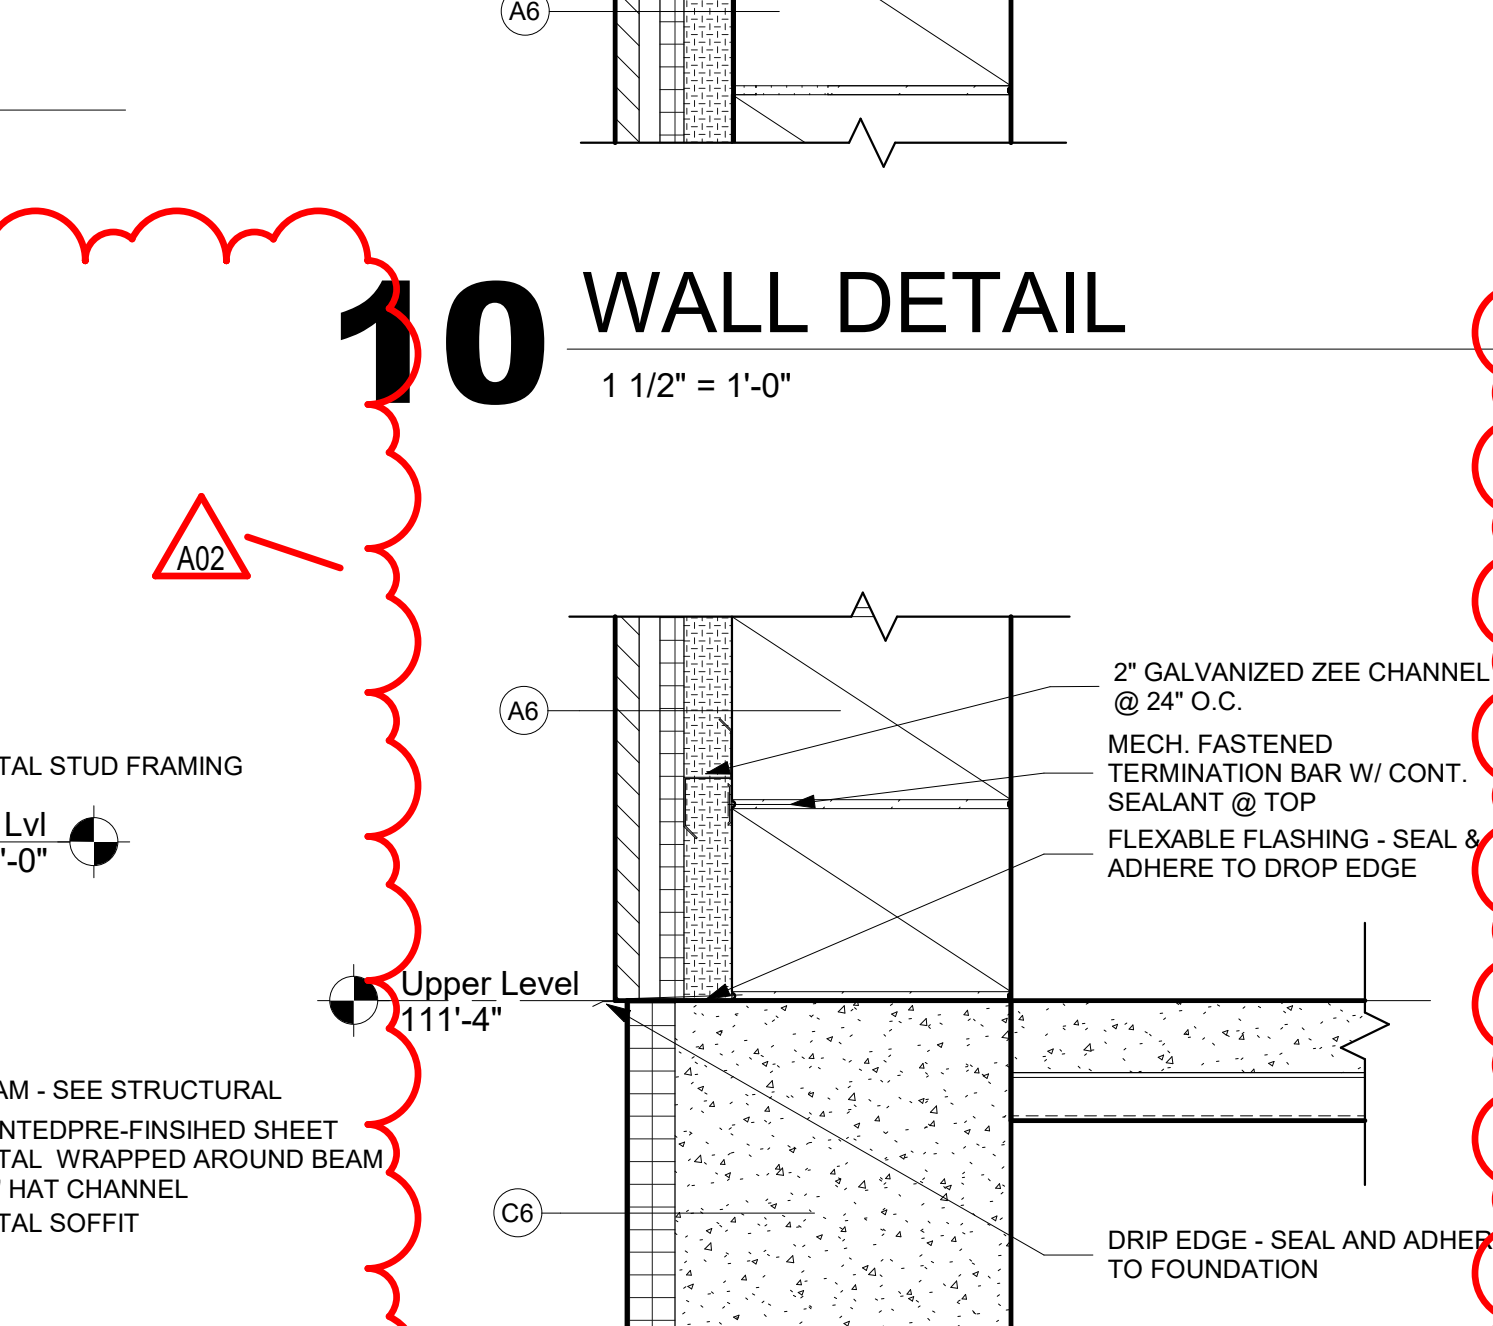

9 WALL DETAIL
1 1/2" = 1'-0"

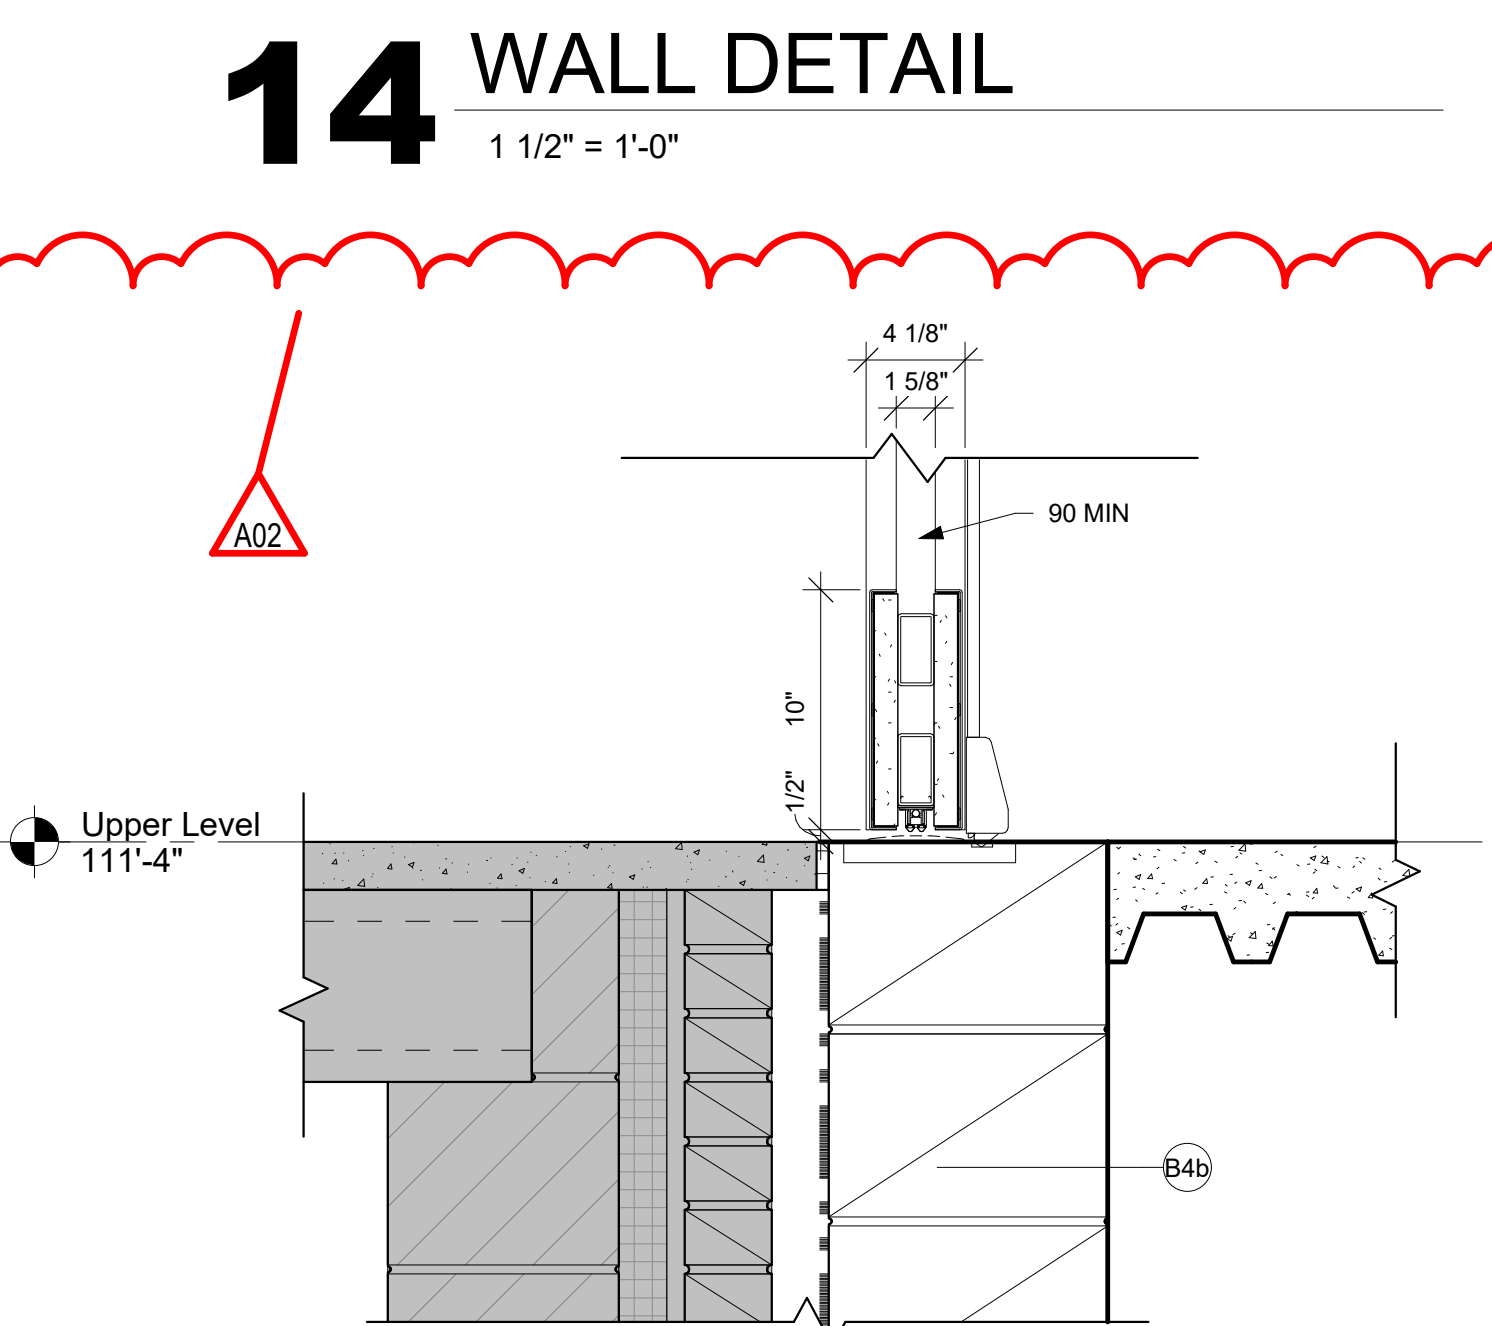

13 DOOR 210 DETAIL
1 1/2" = 1'-0"

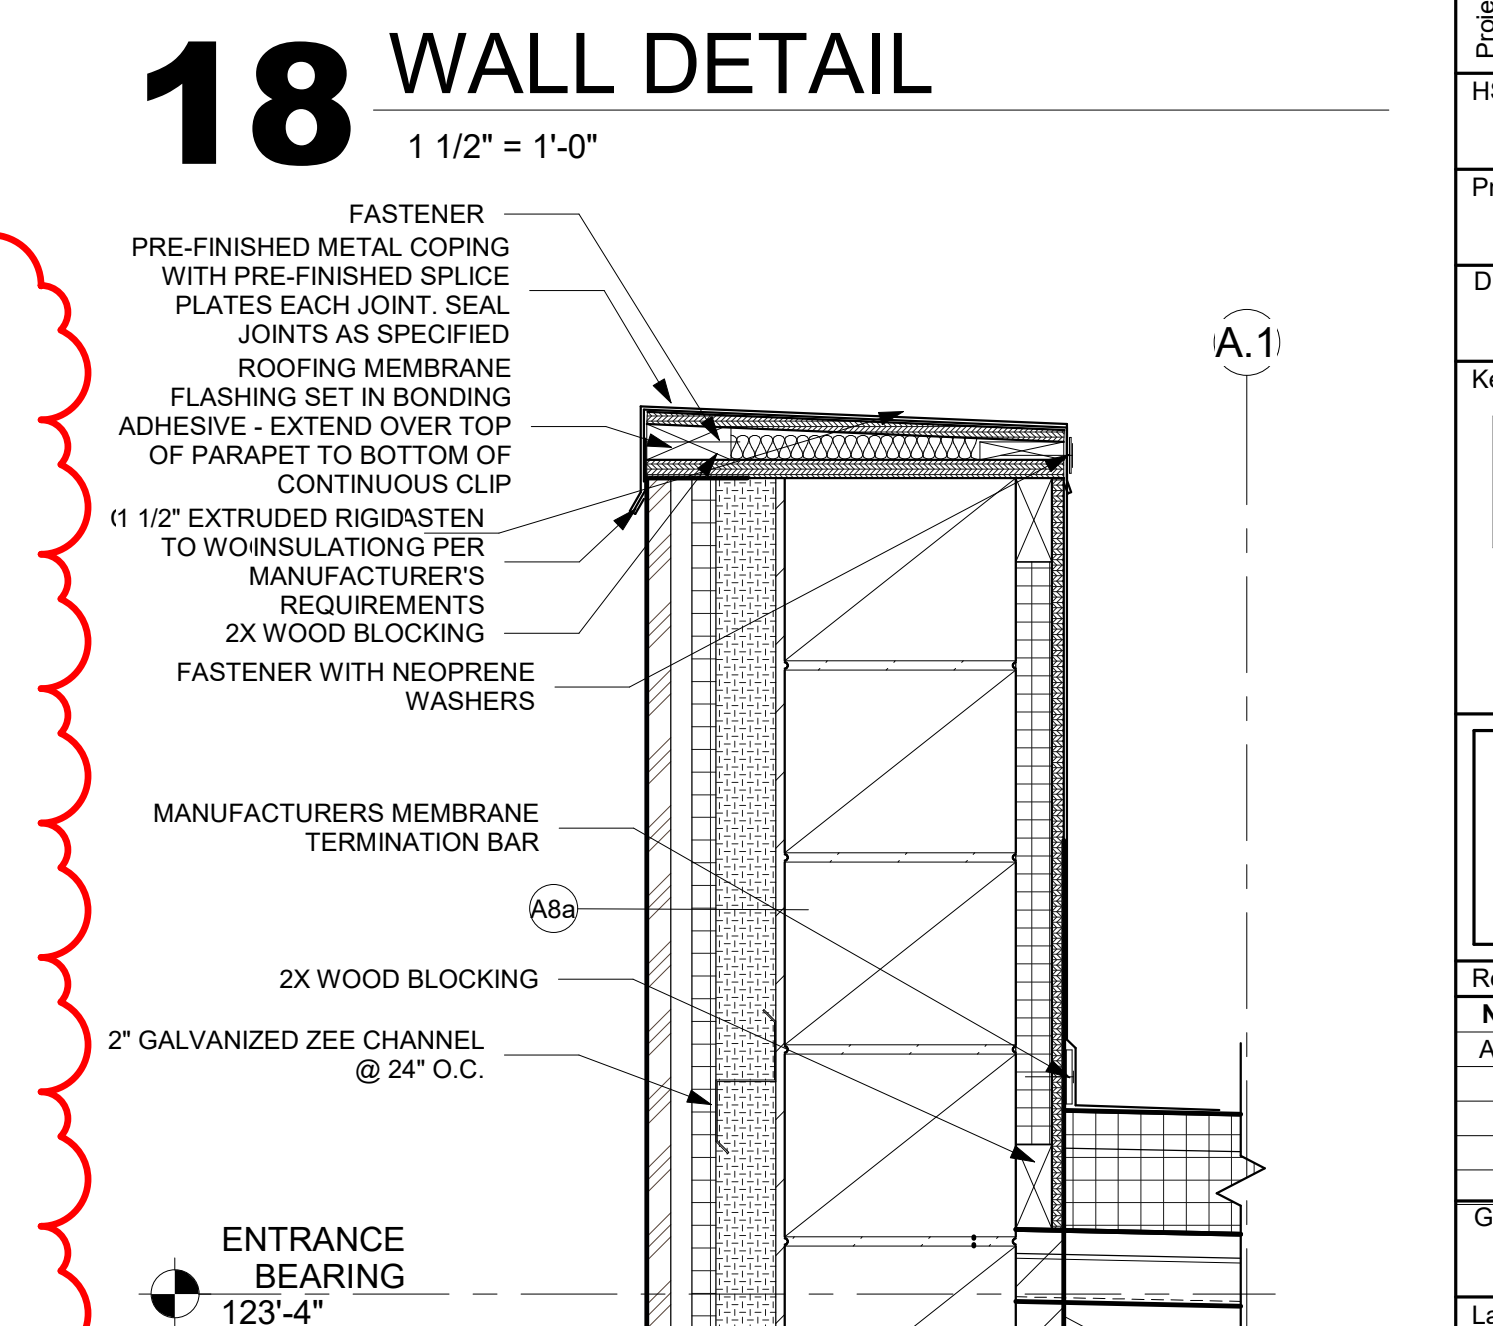

17 WALL DETAIL
1 1/2" = 1'-0"



Consultant:

ENGINEER CERTIFICATION

I hereby certify that this Plan, Specification or Report was prepared by me or under my direct supervision and that I am a duly licensed Engineer under the laws of the state of Minnesota.
Date: July 9, 2019 Lic No: 11311
This drawing is conditionally issued and reproductions or use of any technical design information is strictly forbidden without written agreement from the responsible Engineer.

ARCHITECT CERTIFICATION

I hereby certify that this Plan, Specification or Report was prepared by me or under my direct supervision and that I am a duly licensed Architect under the laws of the state of Minnesota.
Date: July 9, 2019 Lic No: 58867
This drawing is conditionally issued and reproductions or use of any technical design information is strictly forbidden without written agreement from the responsible Architect.

Project Title: LANESBORO PUBLIC SCHOOLS
ADDITION & REMODEL

Project Location: 204 KIRKWOOD ST EAST
LANESBORO, MN 55949

Sheet Title: SECTION DETAILS

HSR Project Number: 18063

Project Date: 7-25-19

Drawn By: Author

Key Plan:


Revisions:

No.	Description	Date
A02	ADDENDUM #02	8-19-19


Graphic Scale: VARIES

Last Update: 8/20/2019 11:09:37 AM


A501

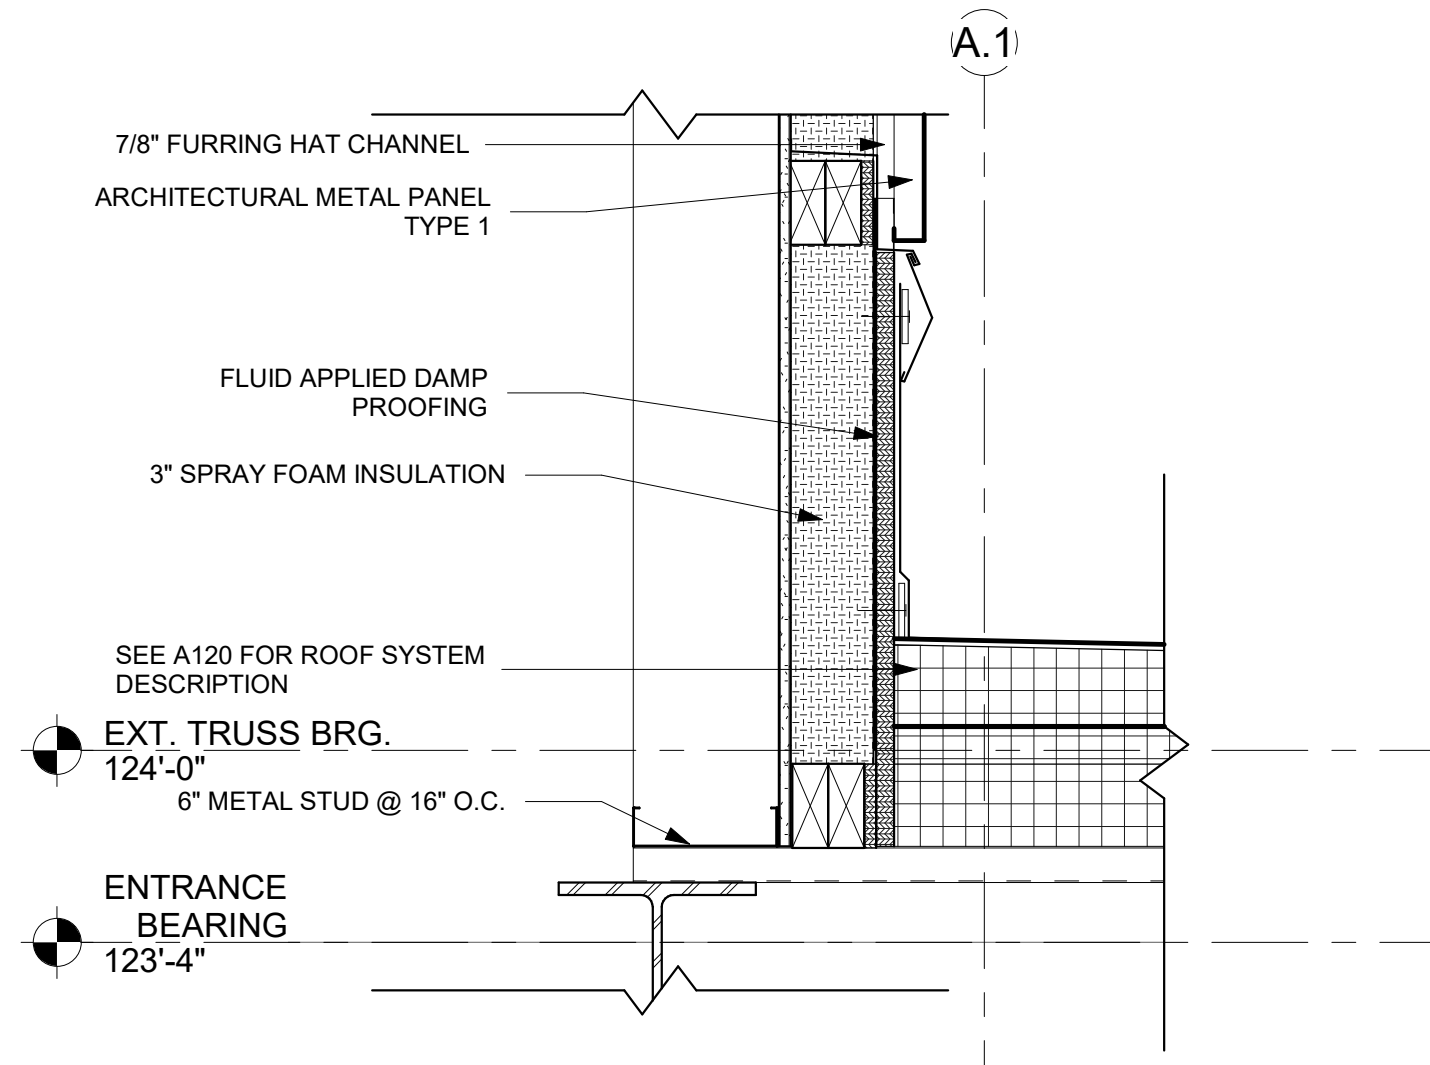


3 WALL DETAIL
1 1/2" = 1'-0"

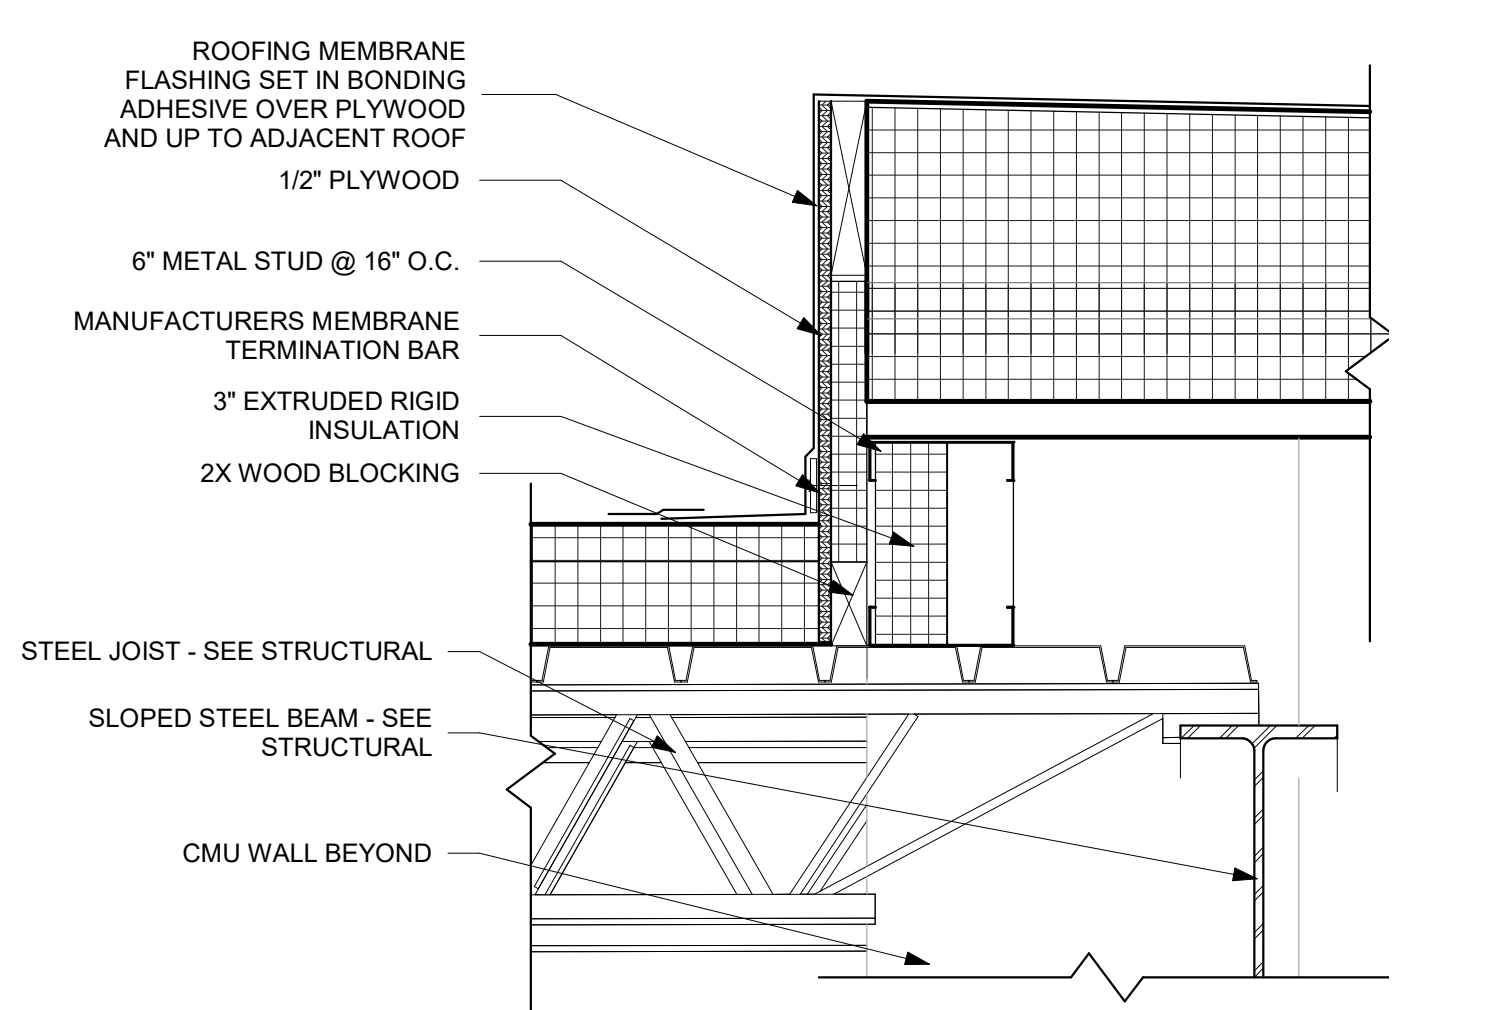


2 ROOF DETAIL
1 1/2" = 1'-0"

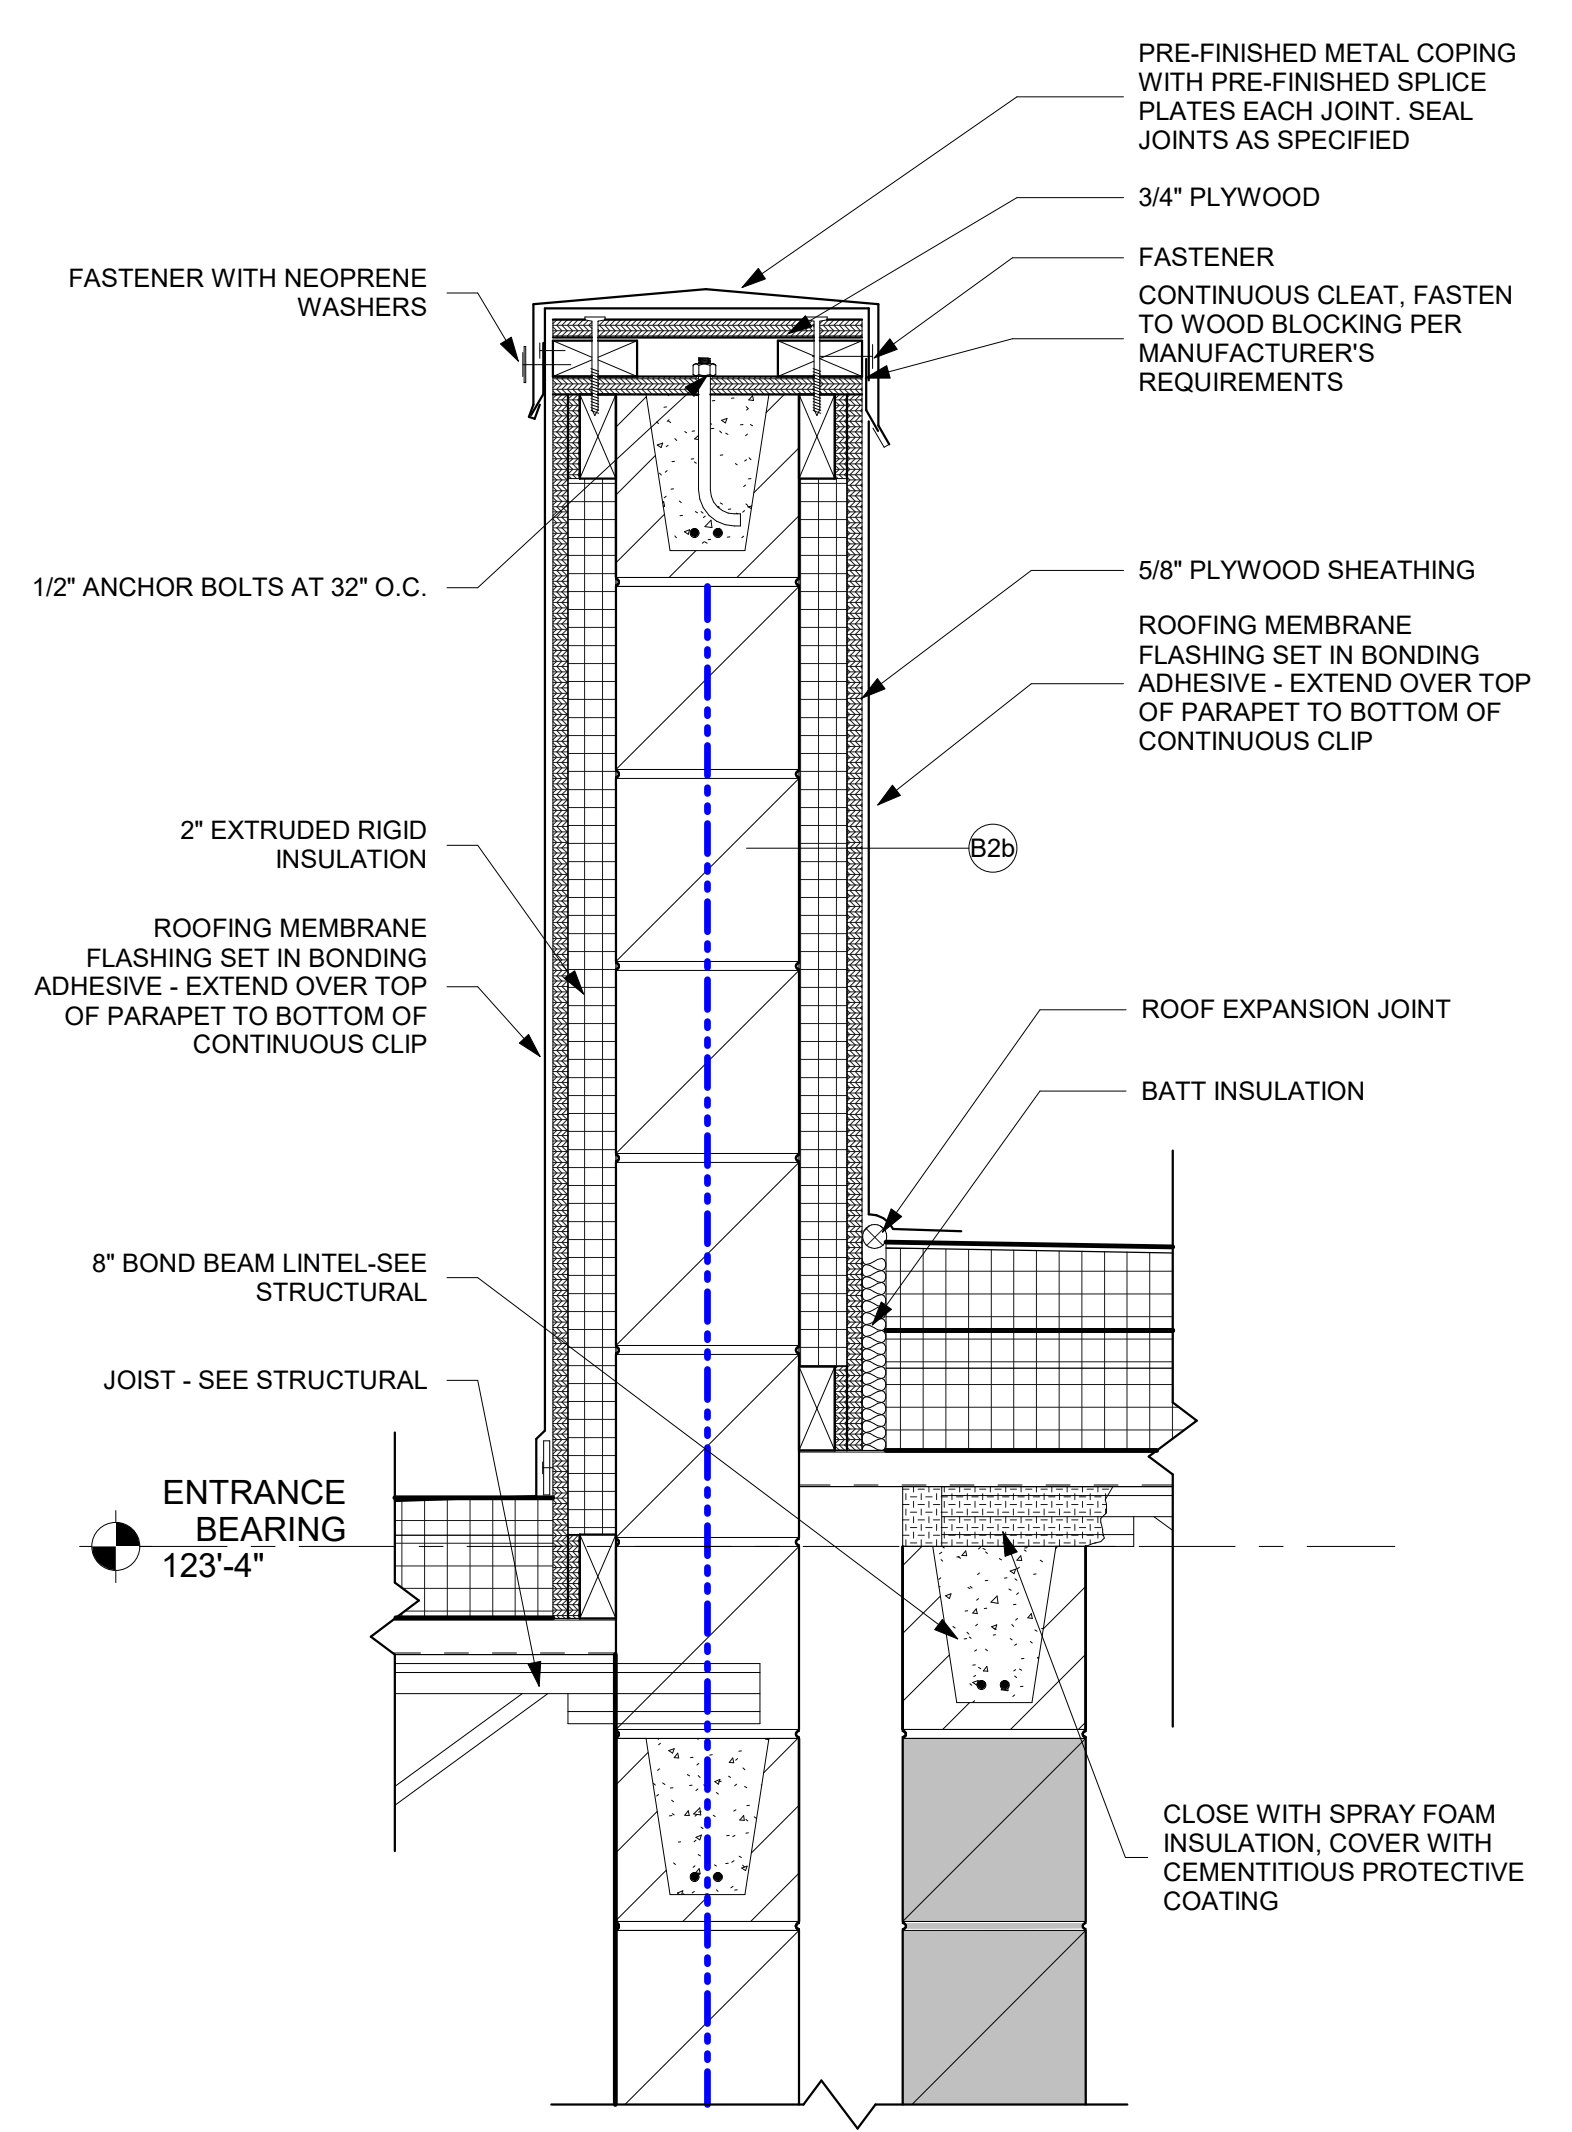


1 WALL DETAIL
1 1/2" = 1'-0"

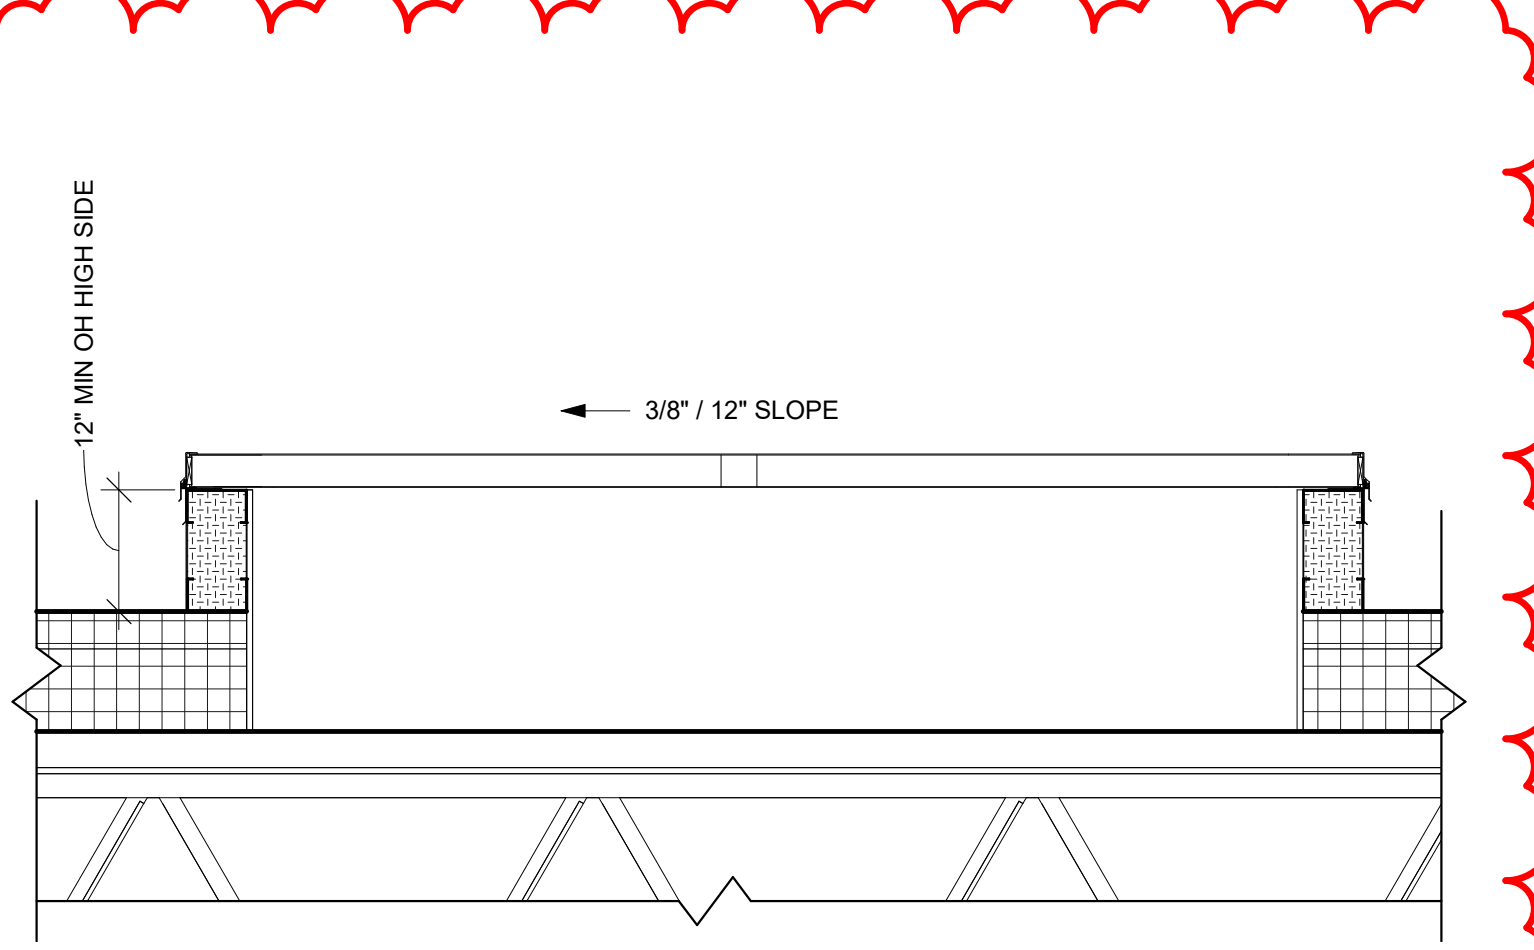


7 SKYLIGHT DETAIL
1 1/2" = 1'-0"

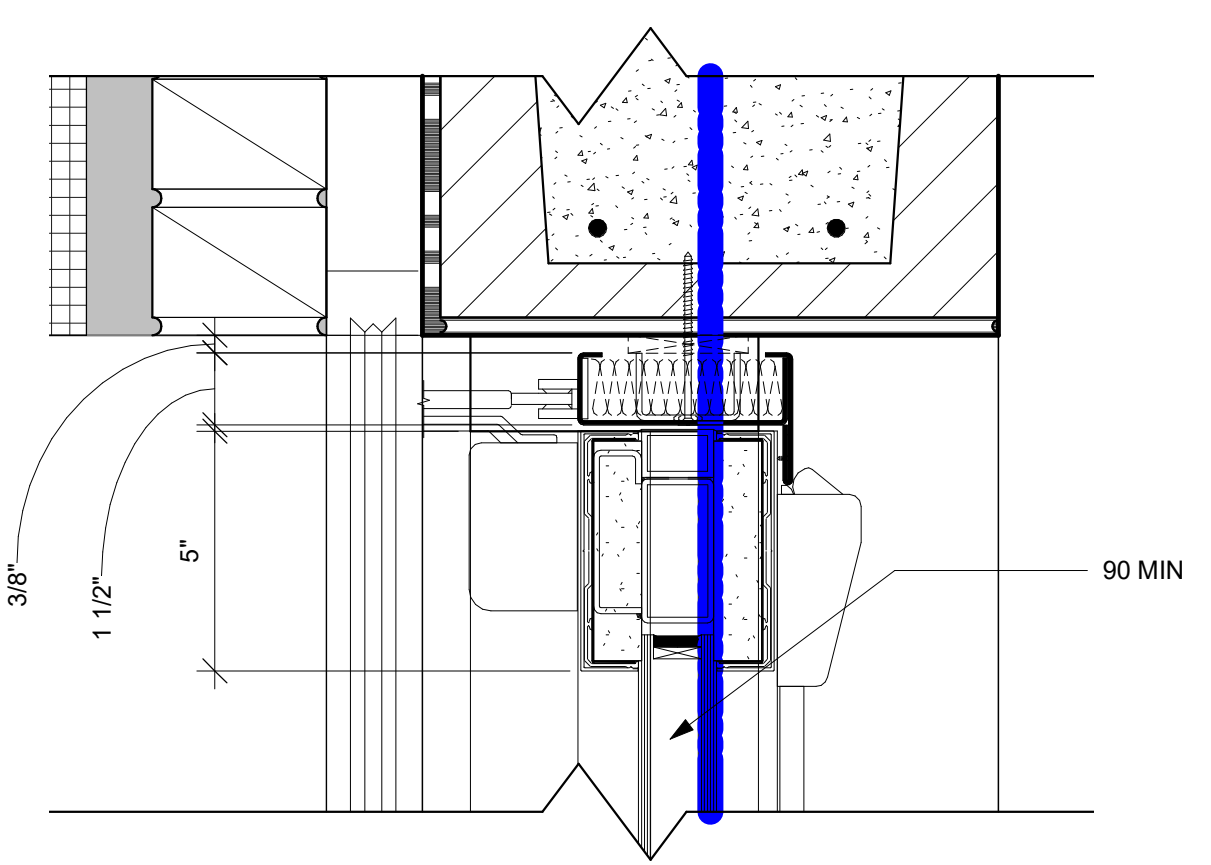

6 DOOR 210 DETAIL
3" = 1'-0"

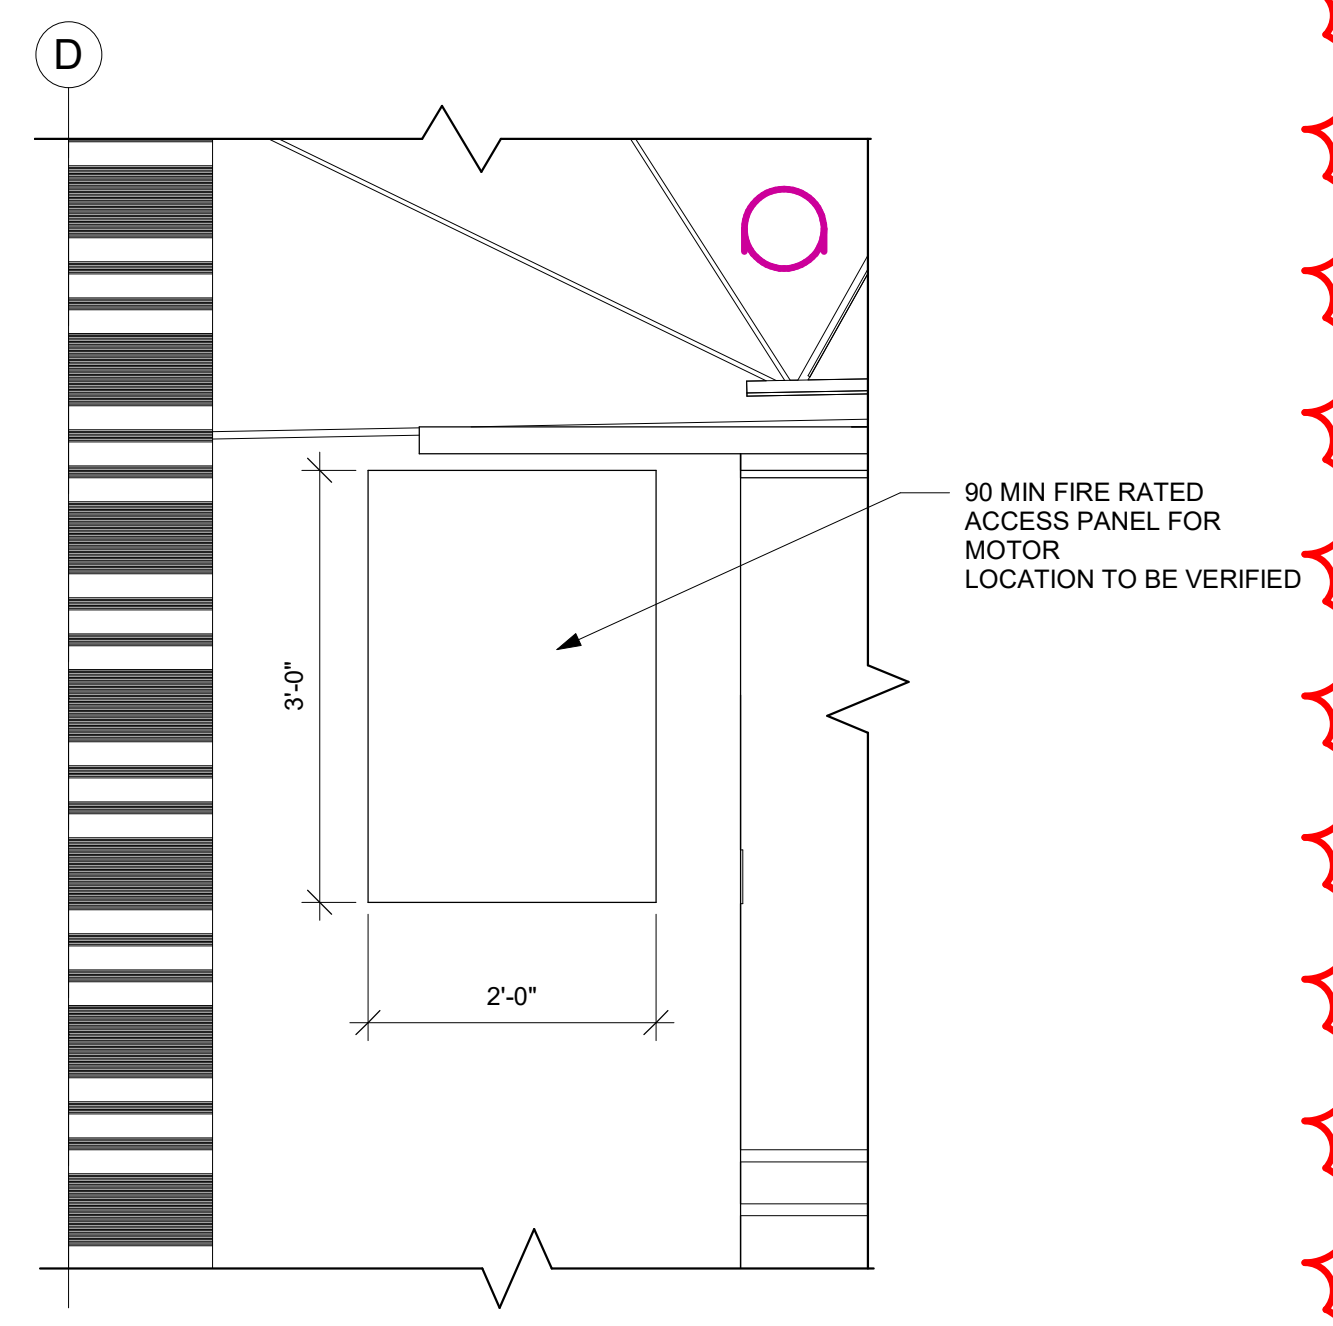

5 ACCESS PANEL
3/4" = 1'-0"

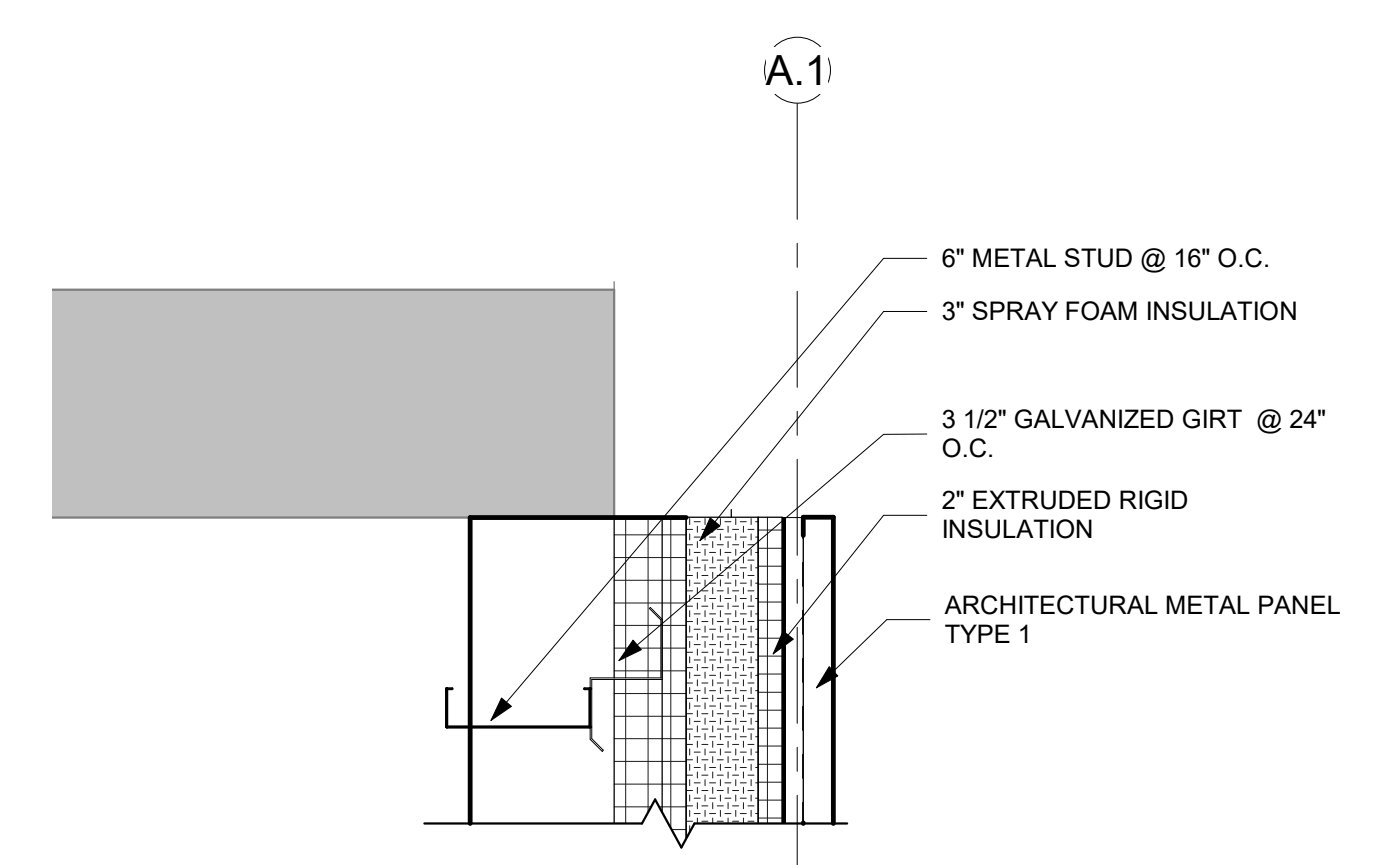

4 WALL DETAIL
1 1/2" = 1'-0"

A02



Consultant:

ENGINEER CERTIFICATION

I hereby certify that this Plan, Specification or Report was prepared by me or under my direct supervision and that I am a duly licensed Engineer under the laws of the state of Minnesota.

Jim Tompkins
Date: July 9, 2019 Lic. No. 11311

This drawing is conditionally issued and reproductions or use of any technical design information is strictly forbidden without written agreement from the responsible Engineer.

ARCHITECT CERTIFICATION

I hereby certify that this Plan, Specification or Report was prepared by me or under my direct supervision and that I am a duly licensed Architect under the laws of the state of Minnesota.

Quillan
Date: July 9, 2019 Lic. No. 58867

This drawing is conditionally issued and reproductions or use of any technical design information is strictly forbidden without written agreement from the responsible Architect.

Project Title: LANESBORO PUBLIC SCHOOLS

ADDITION & REMODEL

Project Location: 204 KIRKWOOD ST EAST
LANESBORO, MN 55949


Sheet Title: INTERIOR FRAME ELEVATIONS

HSR Project Number: 18063

Project Date: 7-25-19

Drawn By: Author

Key Plan:

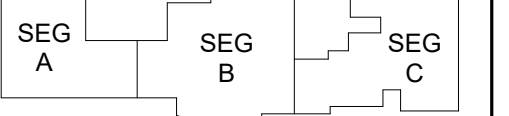


KEY PLAN

Revisions:


No.	Description	Date
A02	ADDENDUM #02	8-19-19

Graphic Scale:

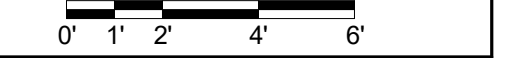


Last Update: 8/20/2019 11:09:37 AM


A603

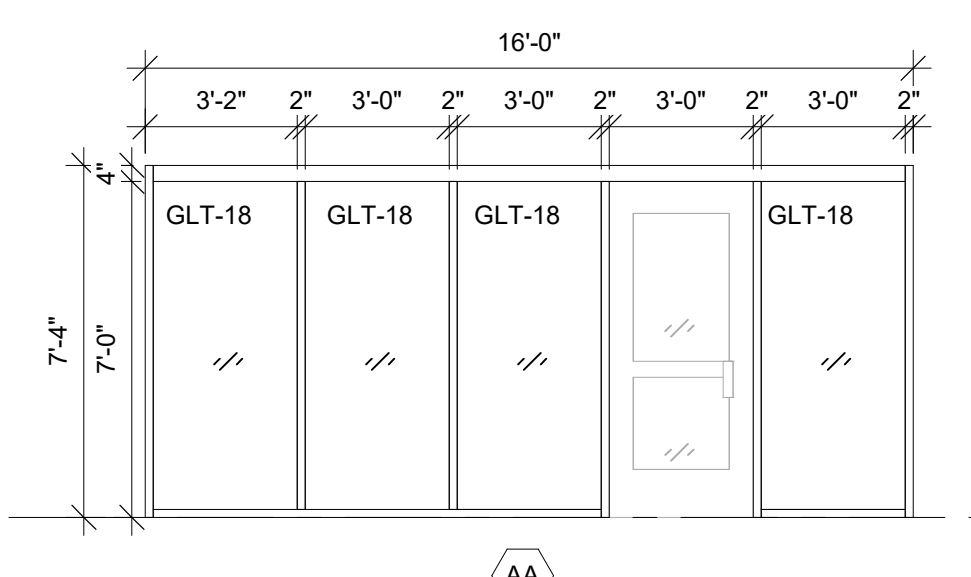


1 HM FRAME ELEV.
1/4" = 1'-0"

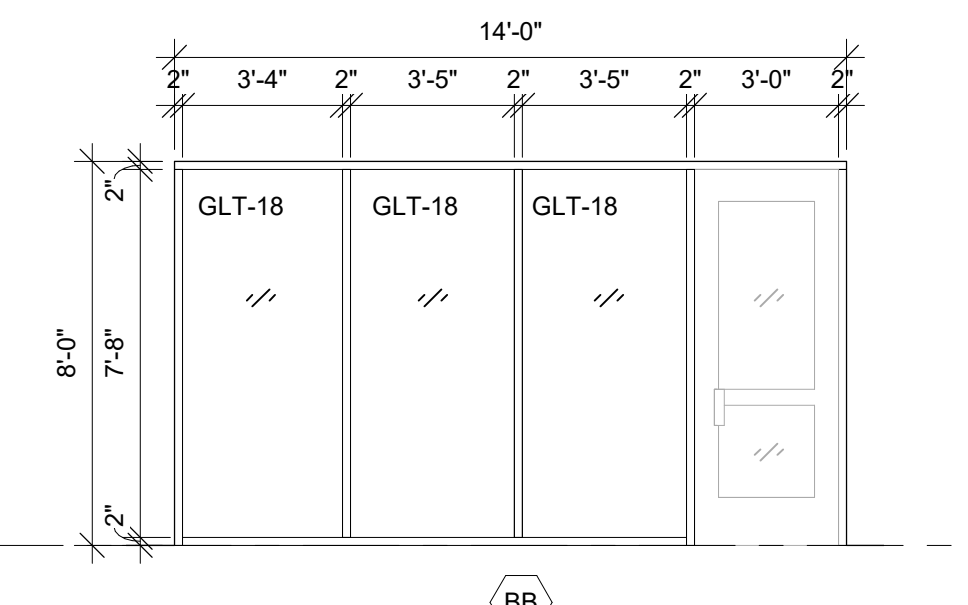


2 ALUM FRAME ELEV.
1/4" = 1'-0"

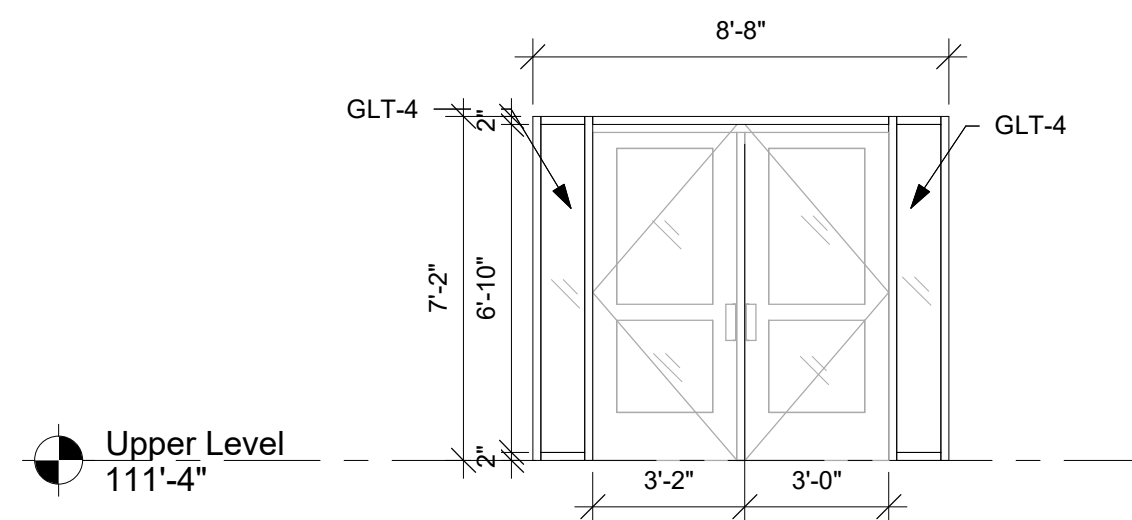


3 ALUM FRAME ELEV.
1/4" = 1'-0"

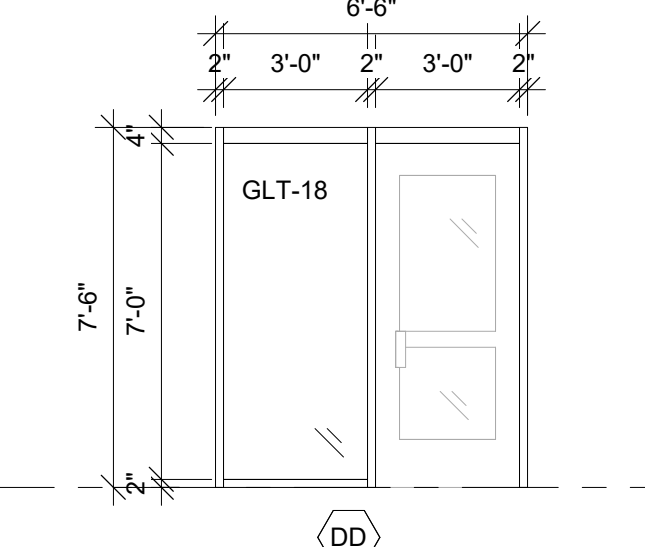


4 HM FRAME ELEV.
1/4" = 1'-0"

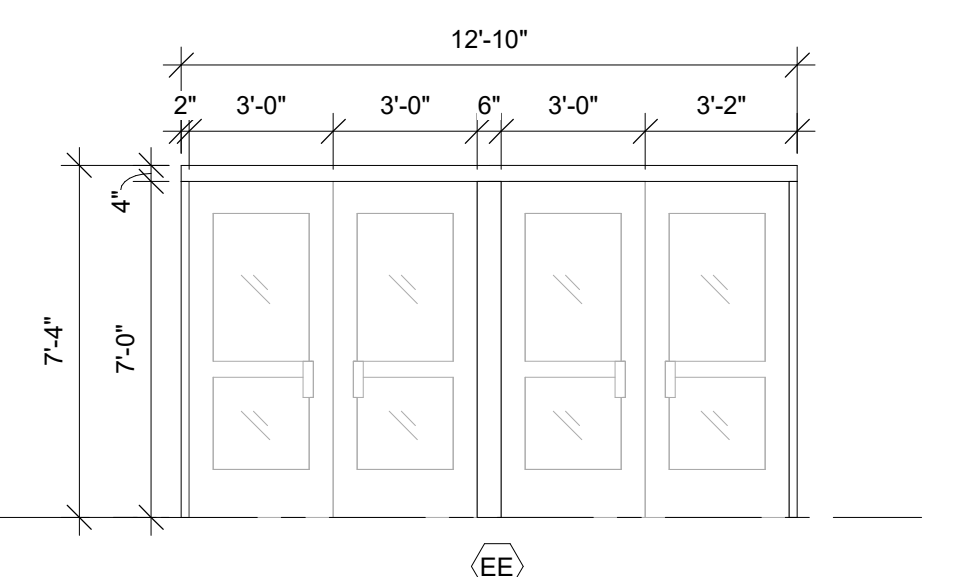


5 HM FRAME ELEV.
1/4" = 1'-0"

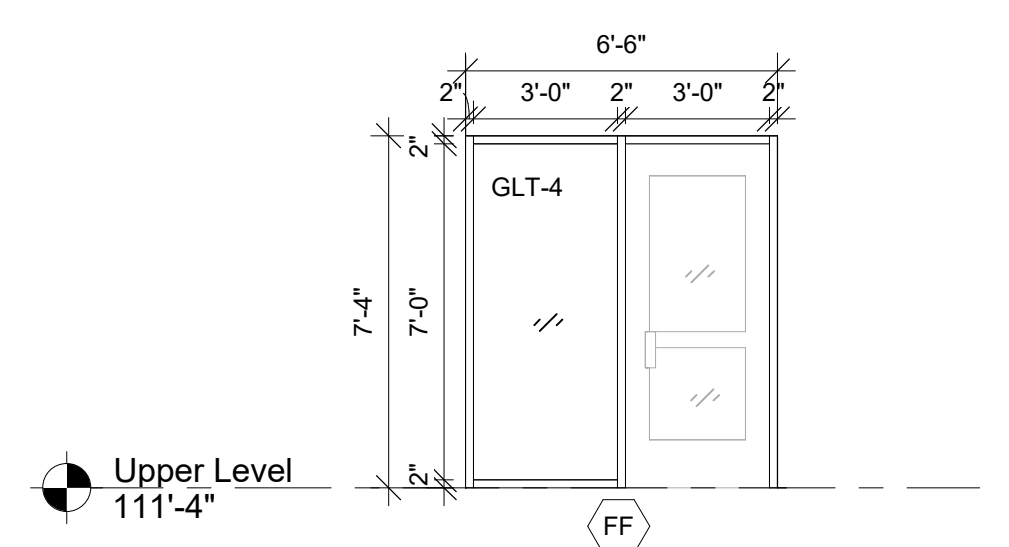

6 ALUM FRAME ELEV.
1/4" = 1'-0"

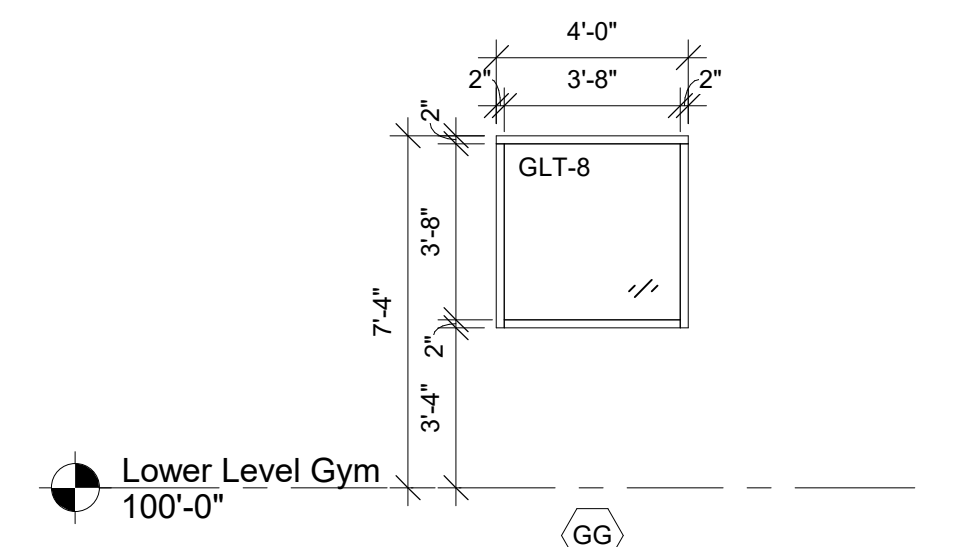

7 HM FRAME ELEV.
1/4" = 1'-0"

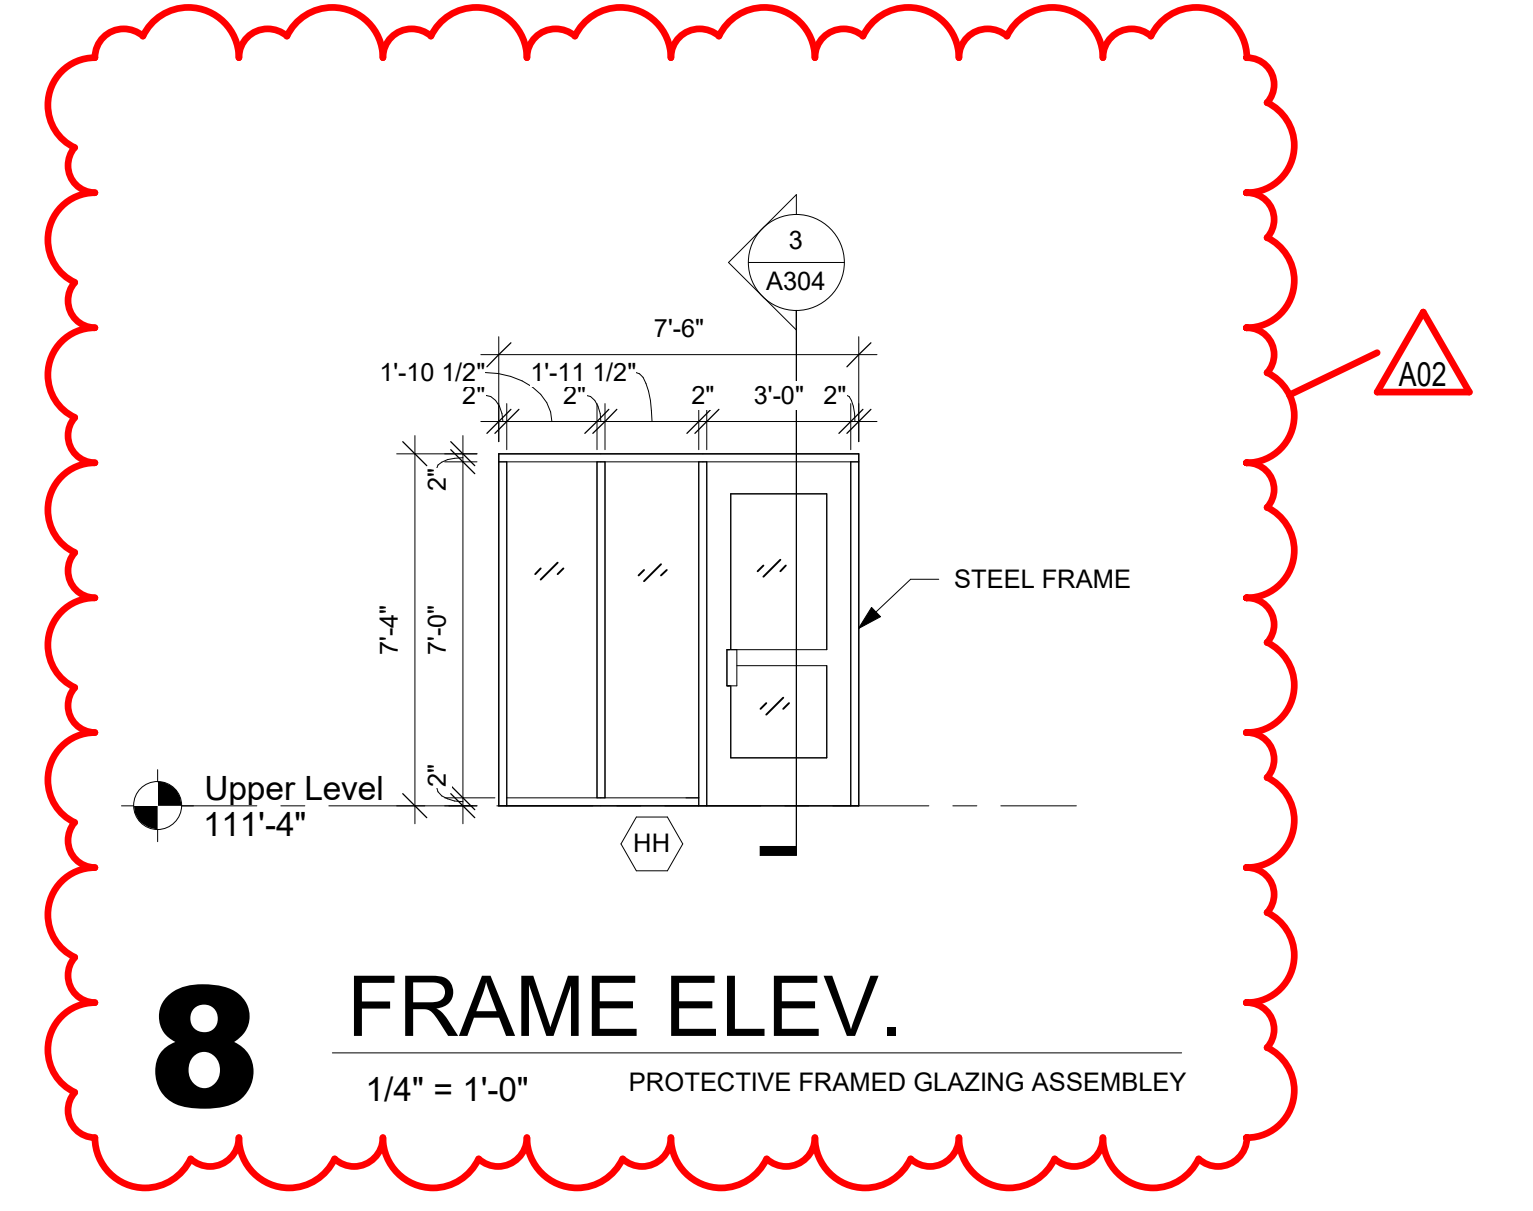

8 FRAME ELEV.
1/4" = 1'-0" PROTECTIVE FRAMED GLAZING ASSEMBLY

Consultant:

ENGINEER CERTIFICATION
I hereby certify that this Plan, Specification or Report was prepared by me or under my direct supervision and that I am a duly licensed Engineer under the laws of the state of Minnesota.
Date: July 9, 2019 Lic No: 56867
This drawing is conditionally issued and reproduction or use of any technical design information is strictly forbidden without written agreement from the responsible Engineer.

ARCHITECT CERTIFICATION
I hereby certify that this Plan, Specification or Report was prepared by me or under my direct supervision and that I am a duly licensed Architect under the laws of the state of Minnesota.
Date: July 9, 2019 Lic No: 56867
This drawing is conditionally issued and reproduction or use of any technical design information is strictly forbidden without written agreement from the responsible Architect.

INTERIOR GENERAL NOTES:

A REFERENCES TO PAINT PERTAIN TO COLOR ONLY; PAINT TYPE SHALL BE IDENTIFIED IN THE ARCHITECTURAL SPECIFICATIONS.

B PNT-1 FIELD PAINT; ACCENT PAINT AS INDICATED. SEE ID SHEETS.

C REFER TO MASTER COLOR SCHEDULE ON ID600 FOR MATERIAL FINISH SPECIFICATIONS, ANNOTATIONS, AND ADDITIONAL INFORMATION.

D TOILET ROOM WALL AND FLOOR GROUT LINES SHALL ALIGN TO CONTINUE PATTERN THROUGHOUT. SEE ID400 FOR ELEVATED PATTERNING.

E VINYL COMPOSITE EDGE (VCE) TO BE INSTALLED AT DISSIMILAR FINISH AREAS. REFER TO ID SHEETS. INSTALL APPROPRIATE EDGE PROFILE TO PROTECT FINISH EDGES. COLOR AS SELECTED BY A/E.

F AT DISSIMILAR FLOORING FINISHES, SET JOINT OF MATERIALS AT CENTER OF DOOR. TRANSITIONS TO BE ADA COMPLIANT.

FINISH KEY PLAN:


△ SEE ROOM FINISH REMARKS

XXX WALL BASE

PNT-X ACCENT PAINT

FINISH LEGEND:

TLE-1	LVT-1	RS-1
TLE-2	LVT-2	VCT-1
SEE ID400	LVT-3	CPT-1
TLE-4	RST-1	CPT-2
TLE-5	SEE ID SHEET FOR CALL OUT	WCPT-1
TLE-6	SEE ID SHEET	SEE ID400 FOR CARPET PATTERN
SEE ID400	RT-1	FAF-1 SEE SPEC
	RT-2	
	RT-3	

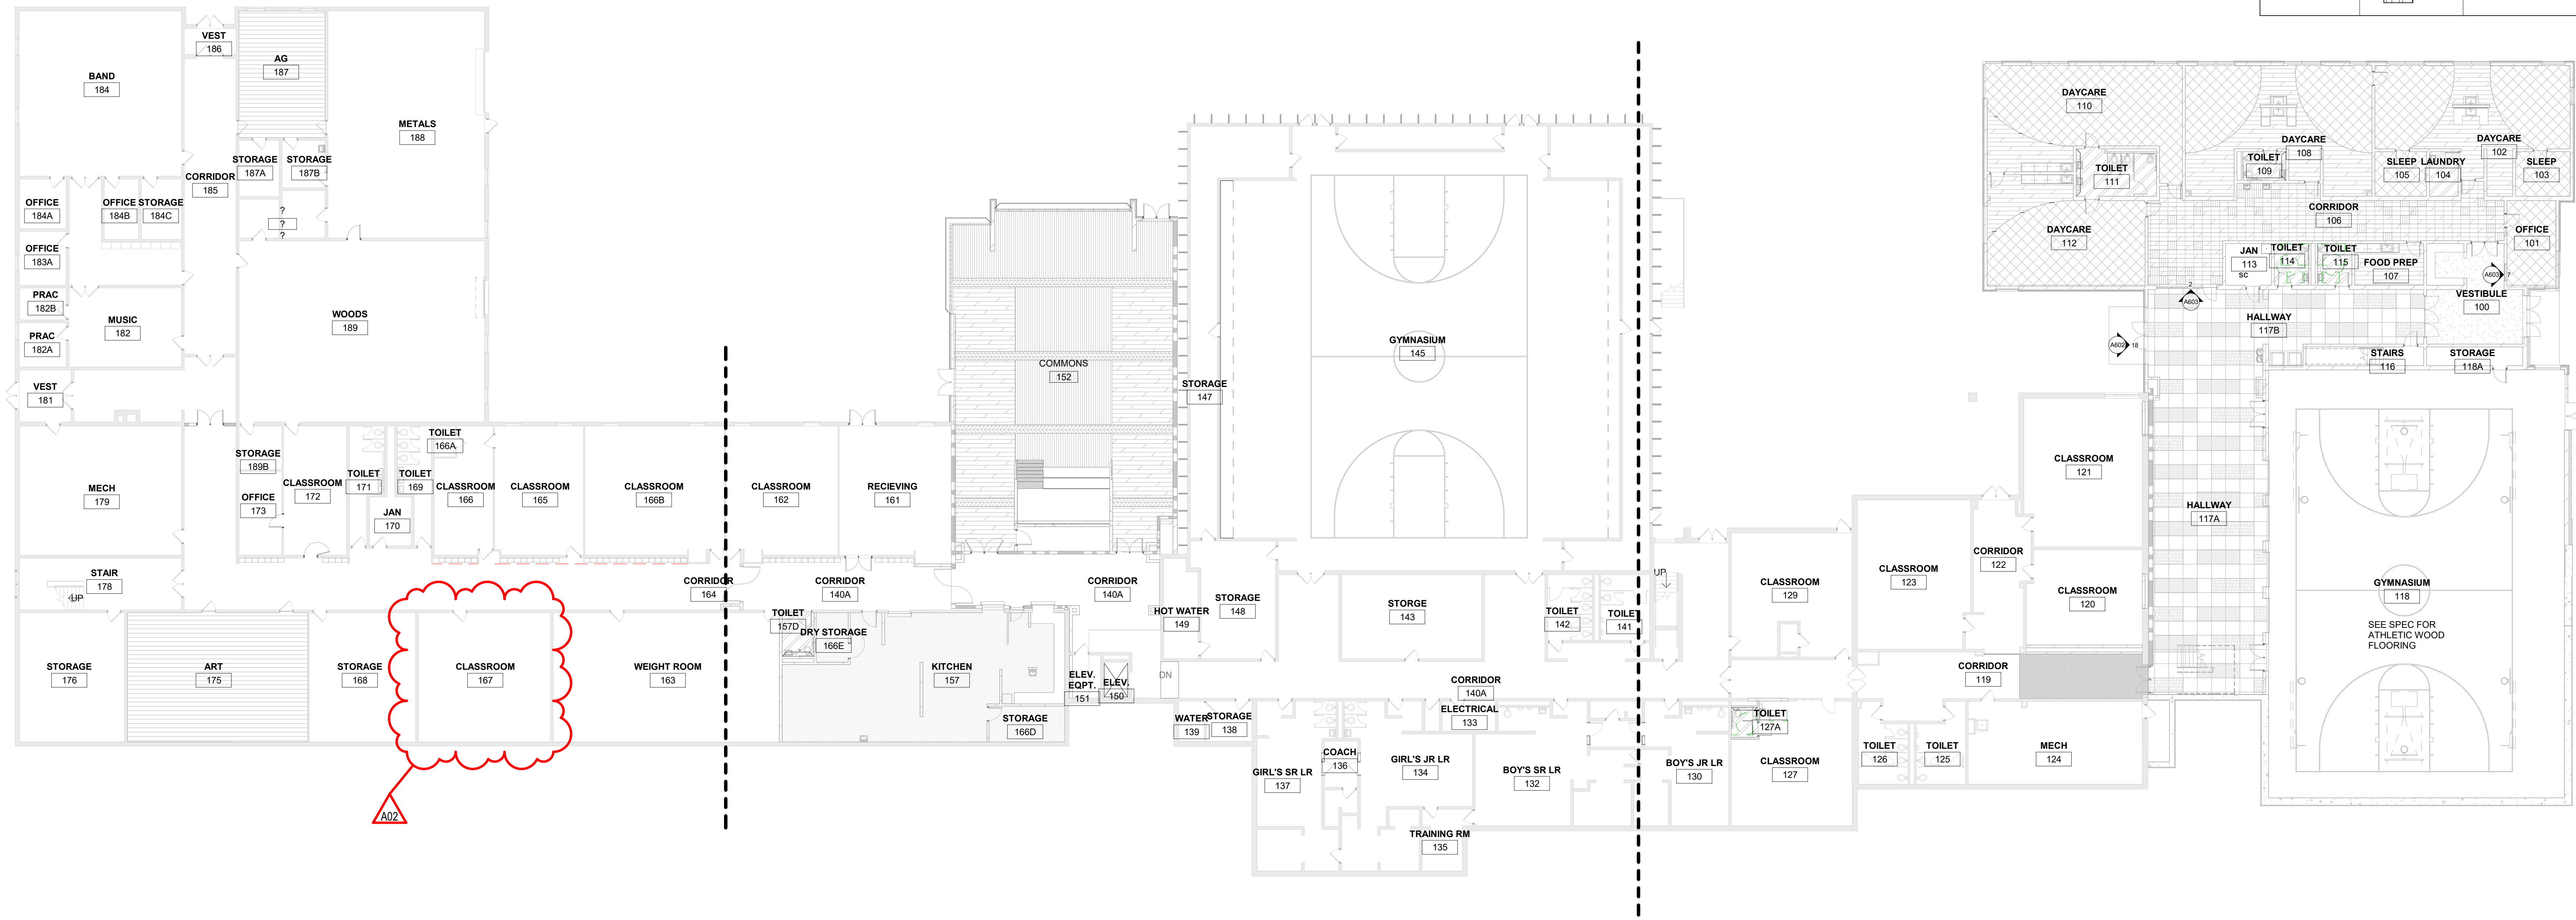

1 LOWER LEVEL OVERALL FINISH PLAN
1/16" = 1'-0"

**LANESBORO PUBLIC SCHOOLS
ADDITION & REMODEL**


Project Location: 204 KIRKWOOD ST EAST
LANESBORO, MN 55949

Sheet Title: **OVERALL LOWER LEVEL FINISH PLAN**

HSR Project Number: **18063**

Project Date: **7-25-19**

Drawn By: **K.VEERKAMP**

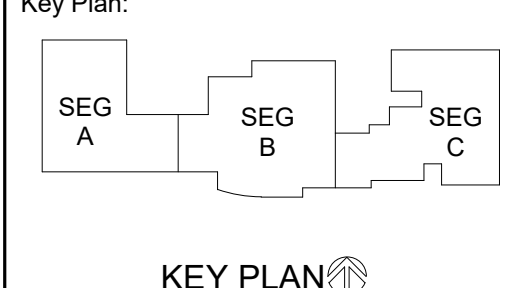

Revisions:

No.	Description	Date
A02	ADDENDUM #02	8-19-19

Graphic Scale: **VARIES**

Last Update: **8/19/2019 3:38:42 PM**

ID101



Consultant:

ENGINEER CERTIFICATION

I hereby certify that this Plan, Specification or Report was prepared by me or under my direct supervision and that I am a duly licensed Engineer under the laws of the state of Minnesota.
Date: July 9, 2019 Lic No: 11311
This drawing is conditionally issued and reproductions or use of any technical design information is strictly forbidden without written agreement from the responsible Engineer.

ARCHITECT CERTIFICATION

I hereby certify that this Plan, Specification or Report was prepared by me or under my direct supervision and that I am a duly licensed Architect under the laws of the state of Minnesota.
Date: July 9, 2019 Lic No: 58867
This drawing is conditionally issued and reproductions or use of any technical design information is strictly forbidden without written agreement from the responsible Architect.

INTERIOR GENERAL NOTES:

- REFERENCES TO PAINT PERTAIN TO COLOR ONLY; PAINT TYPE SHALL BE IDENTIFIED IN THE ARCHITECTURAL SPECIFICATIONS.
- PNT-1 FIELD PAINT; ACCENT PAINT AS INDICATED. SEE ID SHEETS.
- REFER TO MASTER COLOR SCHEDULE ON ID#00 FOR MATERIAL FINISH SPECIFICATIONS, ANNOTATIONS, AND ADDITIONAL INFORMATION.
- TOILET ROOM WALL AND FLOOR GROUT LINES SHALL ALIGN TO CONTINUE PATTERN THROUGHOUT. SEE ID#00 FOR ELEVATED PATTERNING.
- VINYL COMPOSITE EDGE (VCE) TO BE INSTALLED AT DISSIMILAR FINISH AREAS. REFER TO ID SHEETS. INSTALL APPROPRIATE EDGE PROFILE TO PROTECT FINISH EDGES. COLOR AS SELECTED BY A/E.
- AT DISSIMILAR FLOORING FINISHES, SET JOINT OF MATERIALS AT CENTER OF DOOR. TRANSITIONS TO BE ADA COMPLIANT.

FINISH KEY PLAN:

- SEE ROOM FINISH REMARKS
- WALL BASE
- ACCENT PAINT

FINISH LEGEND:

ROOM FINISH REMARKS

- PAINT ALL WALLS PNT-1, ACCENT AS INDICATED ON PLANS.
- PATCH FLOORING TO MATCH EXISTING
- EXISTING FLOORING REMAINS, PATCH AS NEEDED
- PAINT ALL WALLS PNT-1 EPOXY.
- FULL HEIGHT TILE ON WET WALLS. 4'-0" TILE WITH 3" BULLNOSE ON REMAINING WALLS. SEE ID#00.
- TOUCH UP PAINT AS NEEDED
- FULL HEIGHT TILE ON WET WALLS. 6" TILE BASE WITH SCHLUTER CAPPING TRIM ON REMAINING WALLS. SEE ID#00.
- SEE ELEVATIONS FOR ACCENT PAINT DESIGN




1 SEG A-LOWER LEVEL FINISH PLAN
1/8" = 1'-0"

LANESBORO PUBLIC SCHOOLS
ADDITION & REMODEL
 Project Location: 204 KIRKWOOD ST EAST
 LANESBORO, MN 55949
 Sheet Title: **LOWER LEVEL FINISH PLAN SEGMENT A**

Project Title: HSR Project Number: 18063

Project Date: 7-25-19

Drawn By: K.VEERKAMP

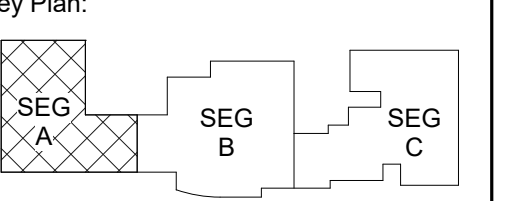

KEY PLAN

Revisions:

No.	Description	Date
A02	ADDENDUM #02	8-19-19

Graphic Scale: VARIES

Last Update: 8/19/2019 3:38:42 PM

ID102



Consultant:

ENGINEER CERTIFICATION

I hereby certify that this Plan, Specification or Report was prepared by me or under my direct supervision and that I am a duly licensed Engineer under the laws of the state of Minnesota.

Jan Tompke
Date: July 9, 2019 Lic No: 11514

This drawing is conditionally issued and reproduction or use of any technical design information is strictly forbidden without written agreement from the responsible Engineer.

ARCHITECT CERTIFICATION

I hereby certify that this Plan, Specification or Report was prepared by me or under my direct supervision and that I am a duly licensed Architect under the laws of the state of Minnesota.

Cheri A
Date: July 9, 2019 Lic No: 5887

This drawing is conditionally issued and reproduction or use of any technical design information is strictly forbidden without written agreement from the responsible Architect.

INTERIOR GENERAL NOTES:

- A REFERENCES TO PAINT PERTAIN TO COLOR ONLY. PAINT TYPE SHALL BE IDENTIFIED IN THE ARCHITECTURAL SPECIFICATIONS.
- B PNT-1 FIELD PAINT; ACCENT PAINT AS INDICATED. SEE ID SHEETS.
- C REFER TO MASTER COLOR SCHEDULE ON ID000 FOR MATERIAL FINISH SPECIFICATIONS, ANNOTATIONS, AND ADDITIONAL INFORMATION.
- D TOILET ROOM WALL AND FLOOR GROUT LINES SHALL ALIGN TO CONTINUE PATTERN THROUGHOUT. SEE ID000 FOR ELEVATED PATTERNING.
- E VINYL COMPOSITE EDGE (VCE) TO BE INSTALLED AT DISSIMILAR FINISH AREAS. REFER TO ID SHEETS. INSTALL APPROPRIATE EDGE PROFILE TO PROTECT FINISH EDGES. COLOR AS SELECTED BY A/E.
- F AT DISSIMILAR FLOORING FINISHES, SET JOINT OF MATERIALS AT CENTER OF DOOR. TRANSITIONS TO BE ADA COMPLIANT.


FINISH KEY PLAN:

- SEE ROOM FINISH REMARKS
- WALL BASE
- ACCENT PAINT

FINISH LEGEND:

ROOM FINISH REMARKS

- 1 PAINT ALL WALLS PNT-1. ACCENT AS INDICATED ON PLANS.
- 2 PATCH FLOORING TO MATCH EXISTING TERRAZZO
- 3 EXISTING FLOORING REMAINS. PATCH AS NEEDED
- 4 PAINT ALL WALLS PNT-1. EPOXY.
- 5 FULL HEIGHT TILE ON WET WALLS. 4"X4" TILE WITH 3" BULLNOSE ON REMAINING WALLS. SEE ID400
- 6 TOUCH UP PAINT AS NEEDED
- 7 FULL HEIGHT TILE ON WET WALLS. 6" TILE BASE WITH SCHLUTER CAPPING TRIM ON REMAINING WALLS. SEE ID400
- 8 SEE ELEVATIONS FOR ACCENT PAINT DESIGN

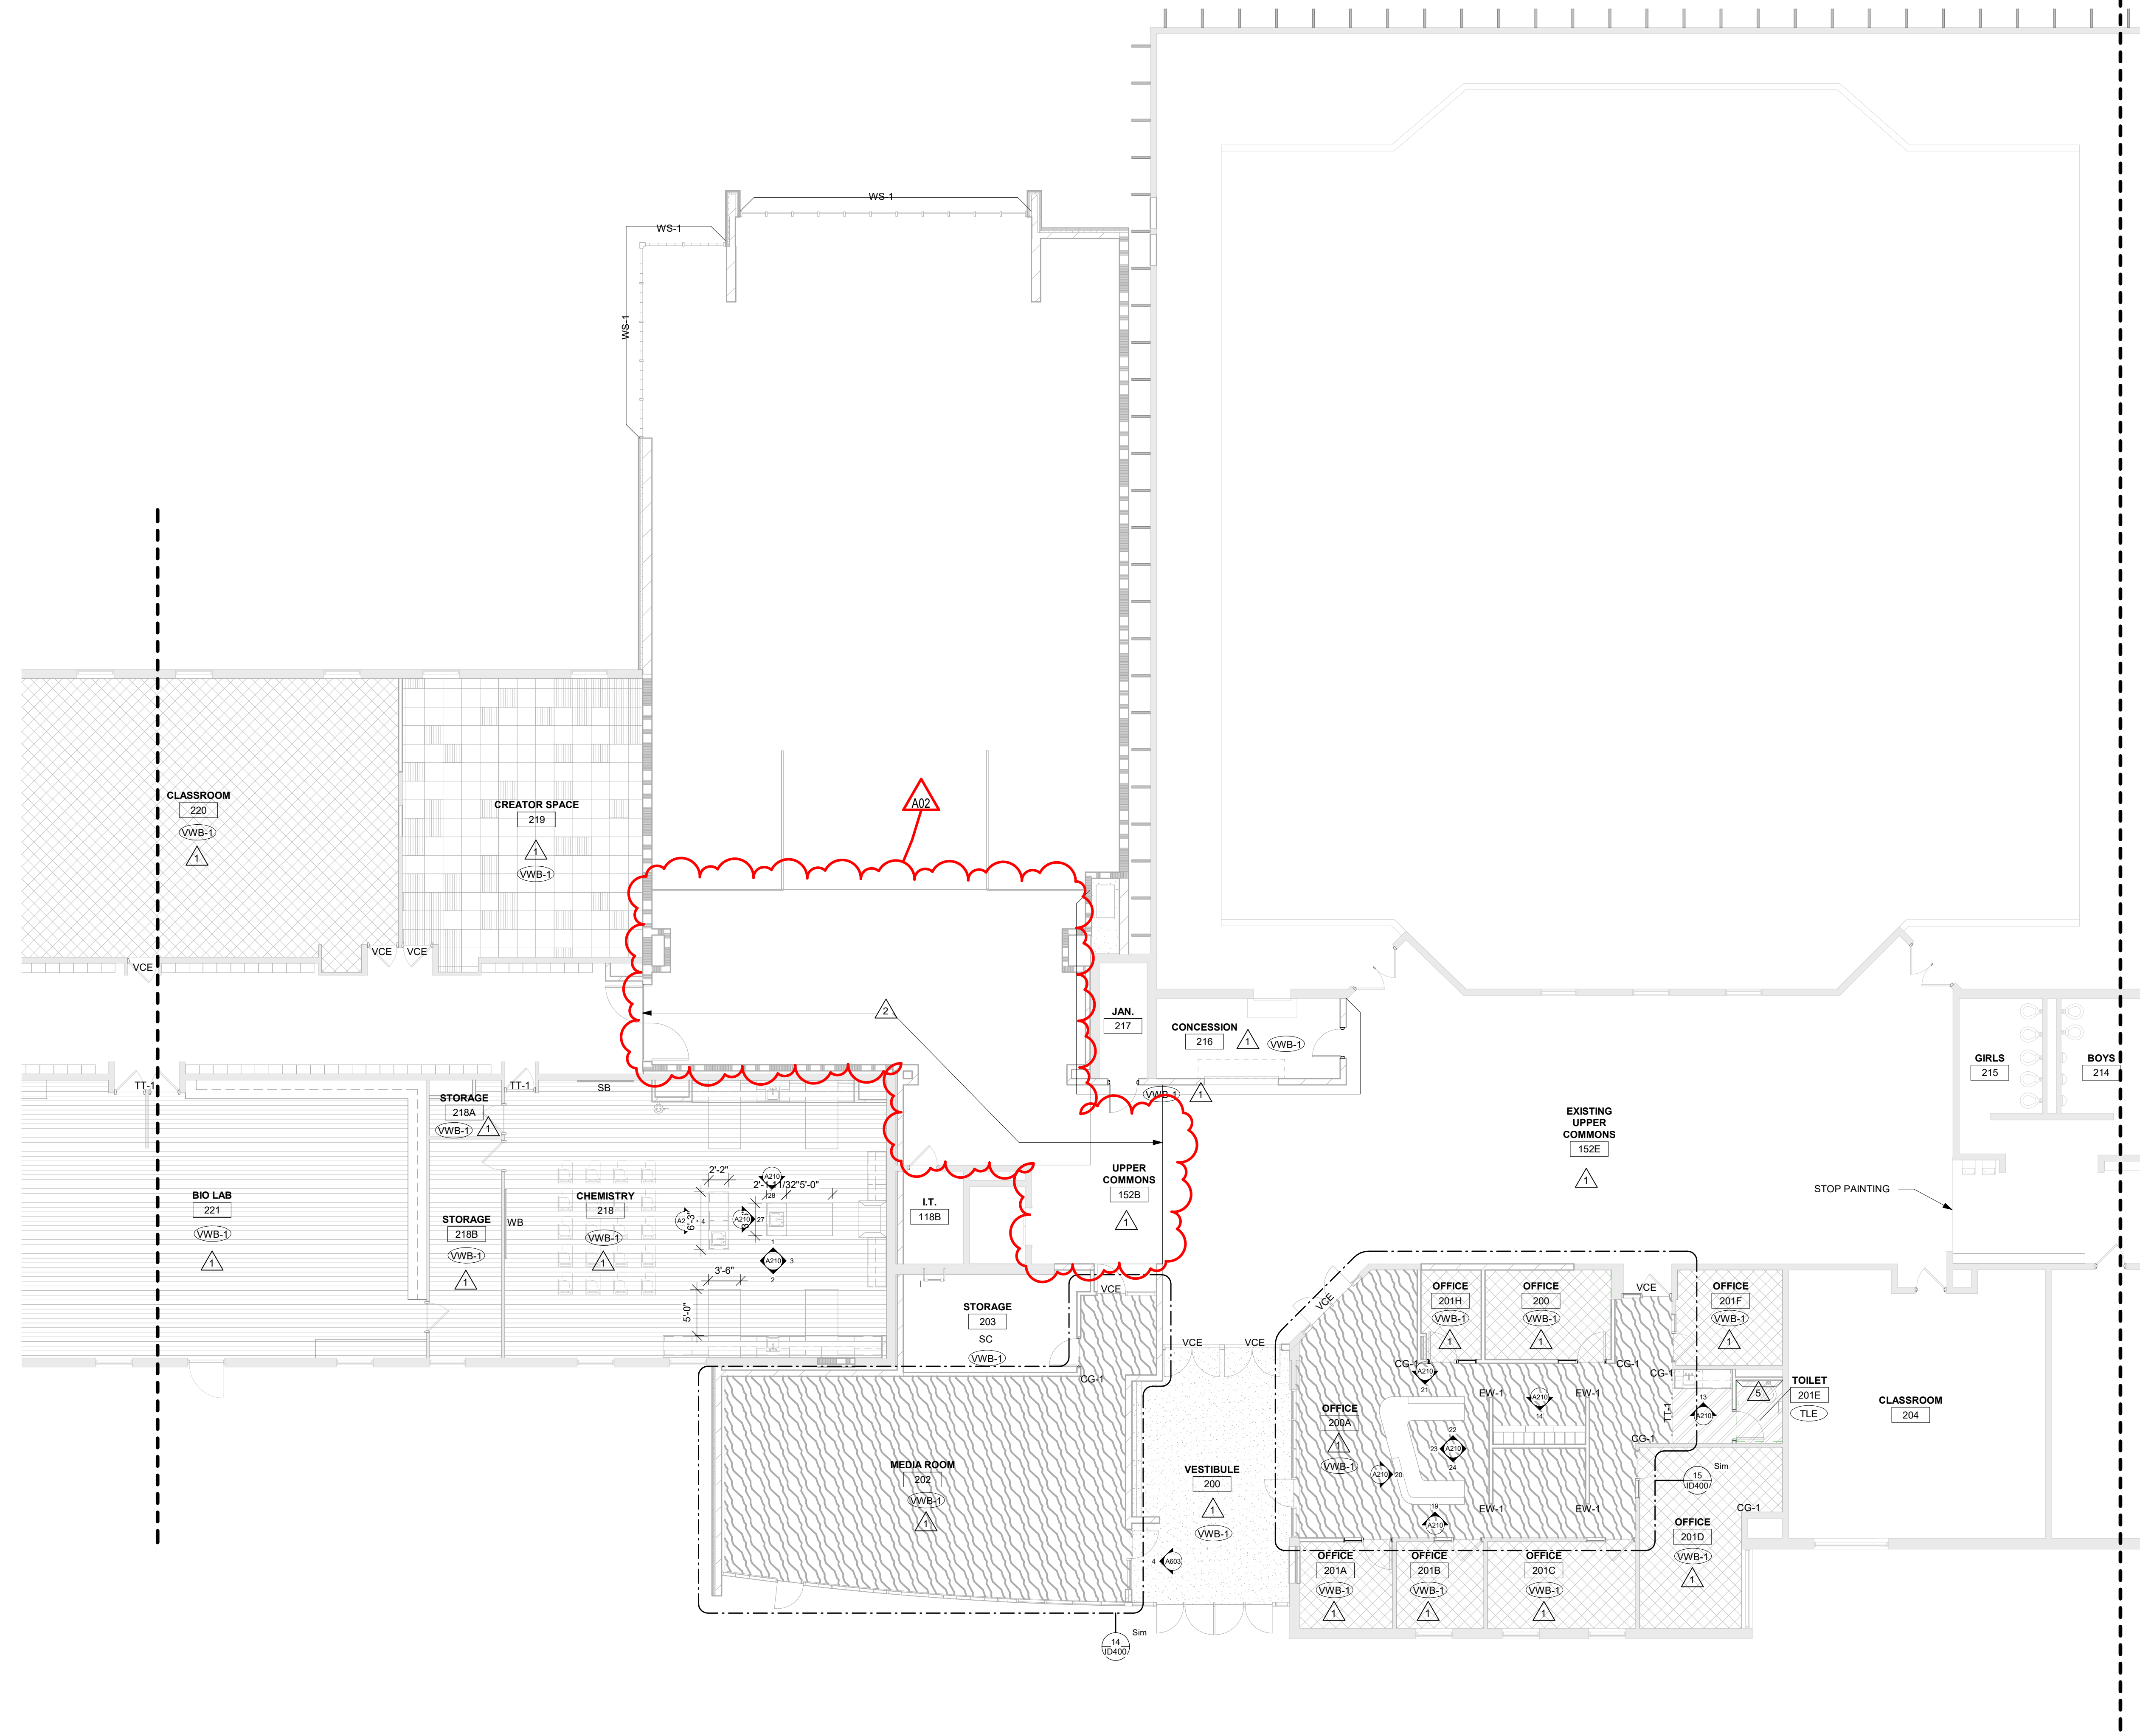

1 SEG B- UPPER LEVEL FINISH PLAN
1/8" = 1'-0"

Project Title: LANESBORO PUBLIC SCHOOLS
ADDITION & REMODEL
Project Location: 204 KIRKWOOD ST EAST
LANESBORO, MN 55949
Sheet Title: UPPER LEVEL FINISH PLAN SEGMENT B

HSR Project Number: 18063
Project Date: 7-25-19
Drawn By: K.VEERKAMP
Key Plan:

Revisions:	No.	Description	Date
	A02	ADDENDUM #02	8-19-19

Graphic Scale: VARIES
Last Update: 8/20/2019 10:53:53 AM

ID107



HSR ASSOCIATES INC.
100 MILWAUKEE STREET
LA CROSSE, WISCONSIN
PHONE: 608.784.1830
FAX: 608.782.5844
www.hsrassociates.com

Consultant:

raSmith
1520 E. Avenue D, Ste. 108
Madison, WI 53714-8342
PROJECT NUMBER: 1180777

Contractors are responsible for the means, methods, techniques, equipment and procedures of construction resulting in the finished work. Temporary supports, shoring, bracing to support imposed loads and other similar items.

ENGINEER CERTIFICATION

I hereby certify that this Plan, Specification or Report was prepared by me or under my direct supervision and that I am a duly licensed Engineer under the laws of the state of Minnesota.


Wayne W. Vandenberg
Date: July 2, 2019 Lic. No.: 43493
This drawing is conditionally issued and reproductions or use of any technical design information is strictly forbidden without written agreement from the responsible Engineer.

ARCHITECT CERTIFICATION

I hereby certify that this Plan, Specification or Report was prepared by me or under my direct supervision and that I am a duly licensed Architect under the laws of the state of Minnesota.


Paul A. ...
Date: July 2, 2019 Lic. No.: 58867
This drawing is conditionally issued and reproductions or use of any technical design information is strictly forbidden without written agreement from the responsible Architect.

FOUNDATION LEGEND

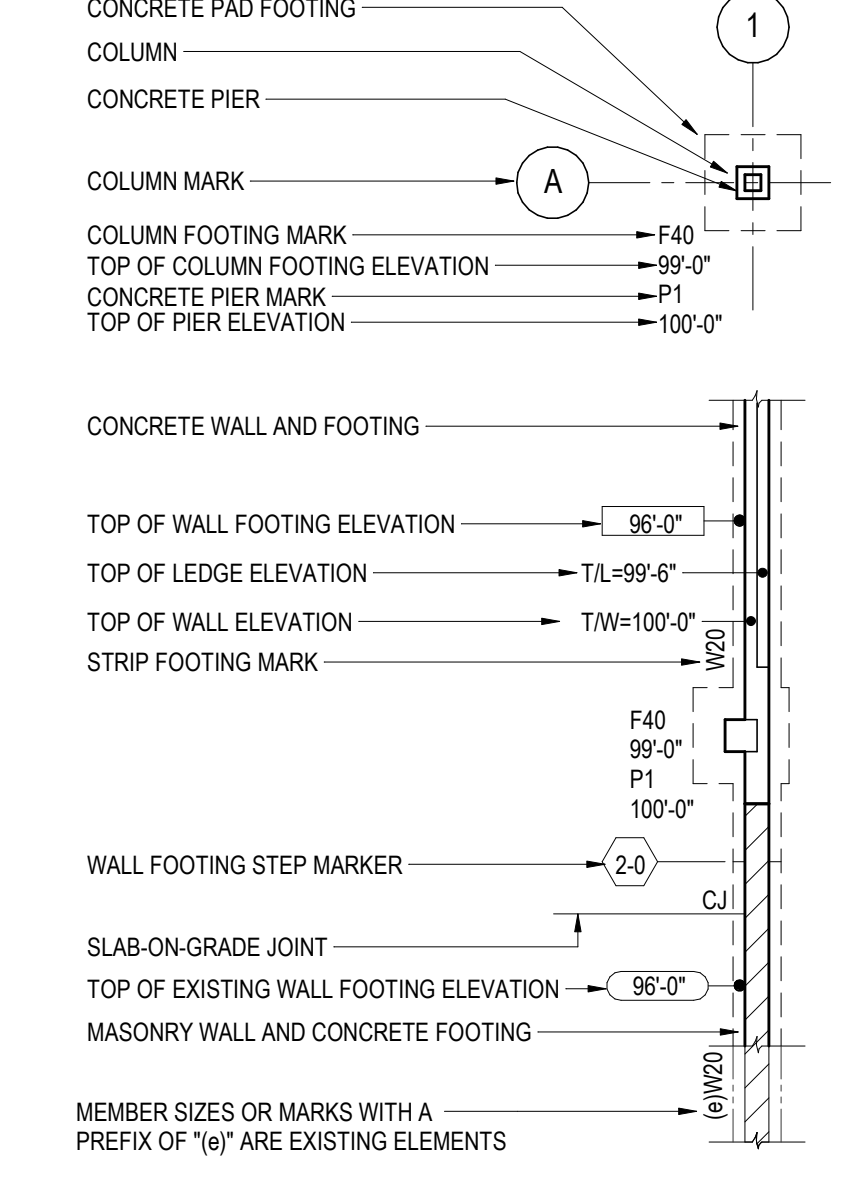

FOUNDATION PLAN NOTES

- FINISH SLAB ELEVATION + AS SHOWN ON PLANS. TOP OF FOOTING ELEVATION AT EXTERIOR WALLS + AS SHOWN ON PLANS.
- SLAB-ON-GRADE TO BE 4" THICK WITH S/CU YD MACRO POLYPROPYLENE SYNTHETIC FIBERS (REFER TO SPECIFICATION) ON 15 MIL MINIMUM VAPOR BARRIER ON 6" OF COMPACTED GRANULAR FILL UNLESS NOTED OTHERWISE.
- IN AREA SHOWN AS [] (AT GYM) SLAB-ON-GRADE TO BE 5" THICK WITH S/CU YD MACRO POLYPROPYLENE SYNTHETIC FIBERS (REFER TO SPECIFICATION) ON 15 MIL MINIMUM VAPOR BARRIER ON 6" OF COMPACTED GRANULAR FILL. TOP OF SLAB INDICATED IS APPROXIMATE AND SHOULD BE COORDINATED WITH WOOD FLOORING SUPPLIER.
- TYPICAL WHERE SLAB-ON-GRADE ABUTS WALL OR COLUMN, PROVIDE 1/4" x (50G THICKNESS) ISOLATION FILLER STRIP, SET STRIP 1/4" BELOW FINISH SLAB ELEVATION OR USE PRE-SCORED REMOVABLE TOP STRIP ISOLATION BOARD.
- OVER-EXCAVATION PER DETAIL 5/8800 MAY BE REQUIRED TO REMOVE EXISTING UNDOCUMENTED FILL AND UNSUITABLE BEARING SOIL.
- TYPICAL DETAILS THAT APPLY TO PLAN INCLUDE:
1/8800 SLAB-ON-GRADE JOINT DETAIL
2/8800 WALL/FOOTING CORNER DETAIL
3/8800 PIPE PASSING UNDER WALL/FOOTING DETAIL
10/8800 FOOTING STEP DETAIL
11/8800 ADDED REINF AT WALL OPENING DETAIL
12/8800 CONCRETE WALL JOINT DETAIL
13/8800 ISOLATION JOINT AT COLUMNS
- CONTROL JOINTS ON ALL SLABS:
12'-0" OC MAX AT 4" SLABS
15'-0" OC MAX AT 6" SLABS
- [] = MASONRY PIER ABOVE

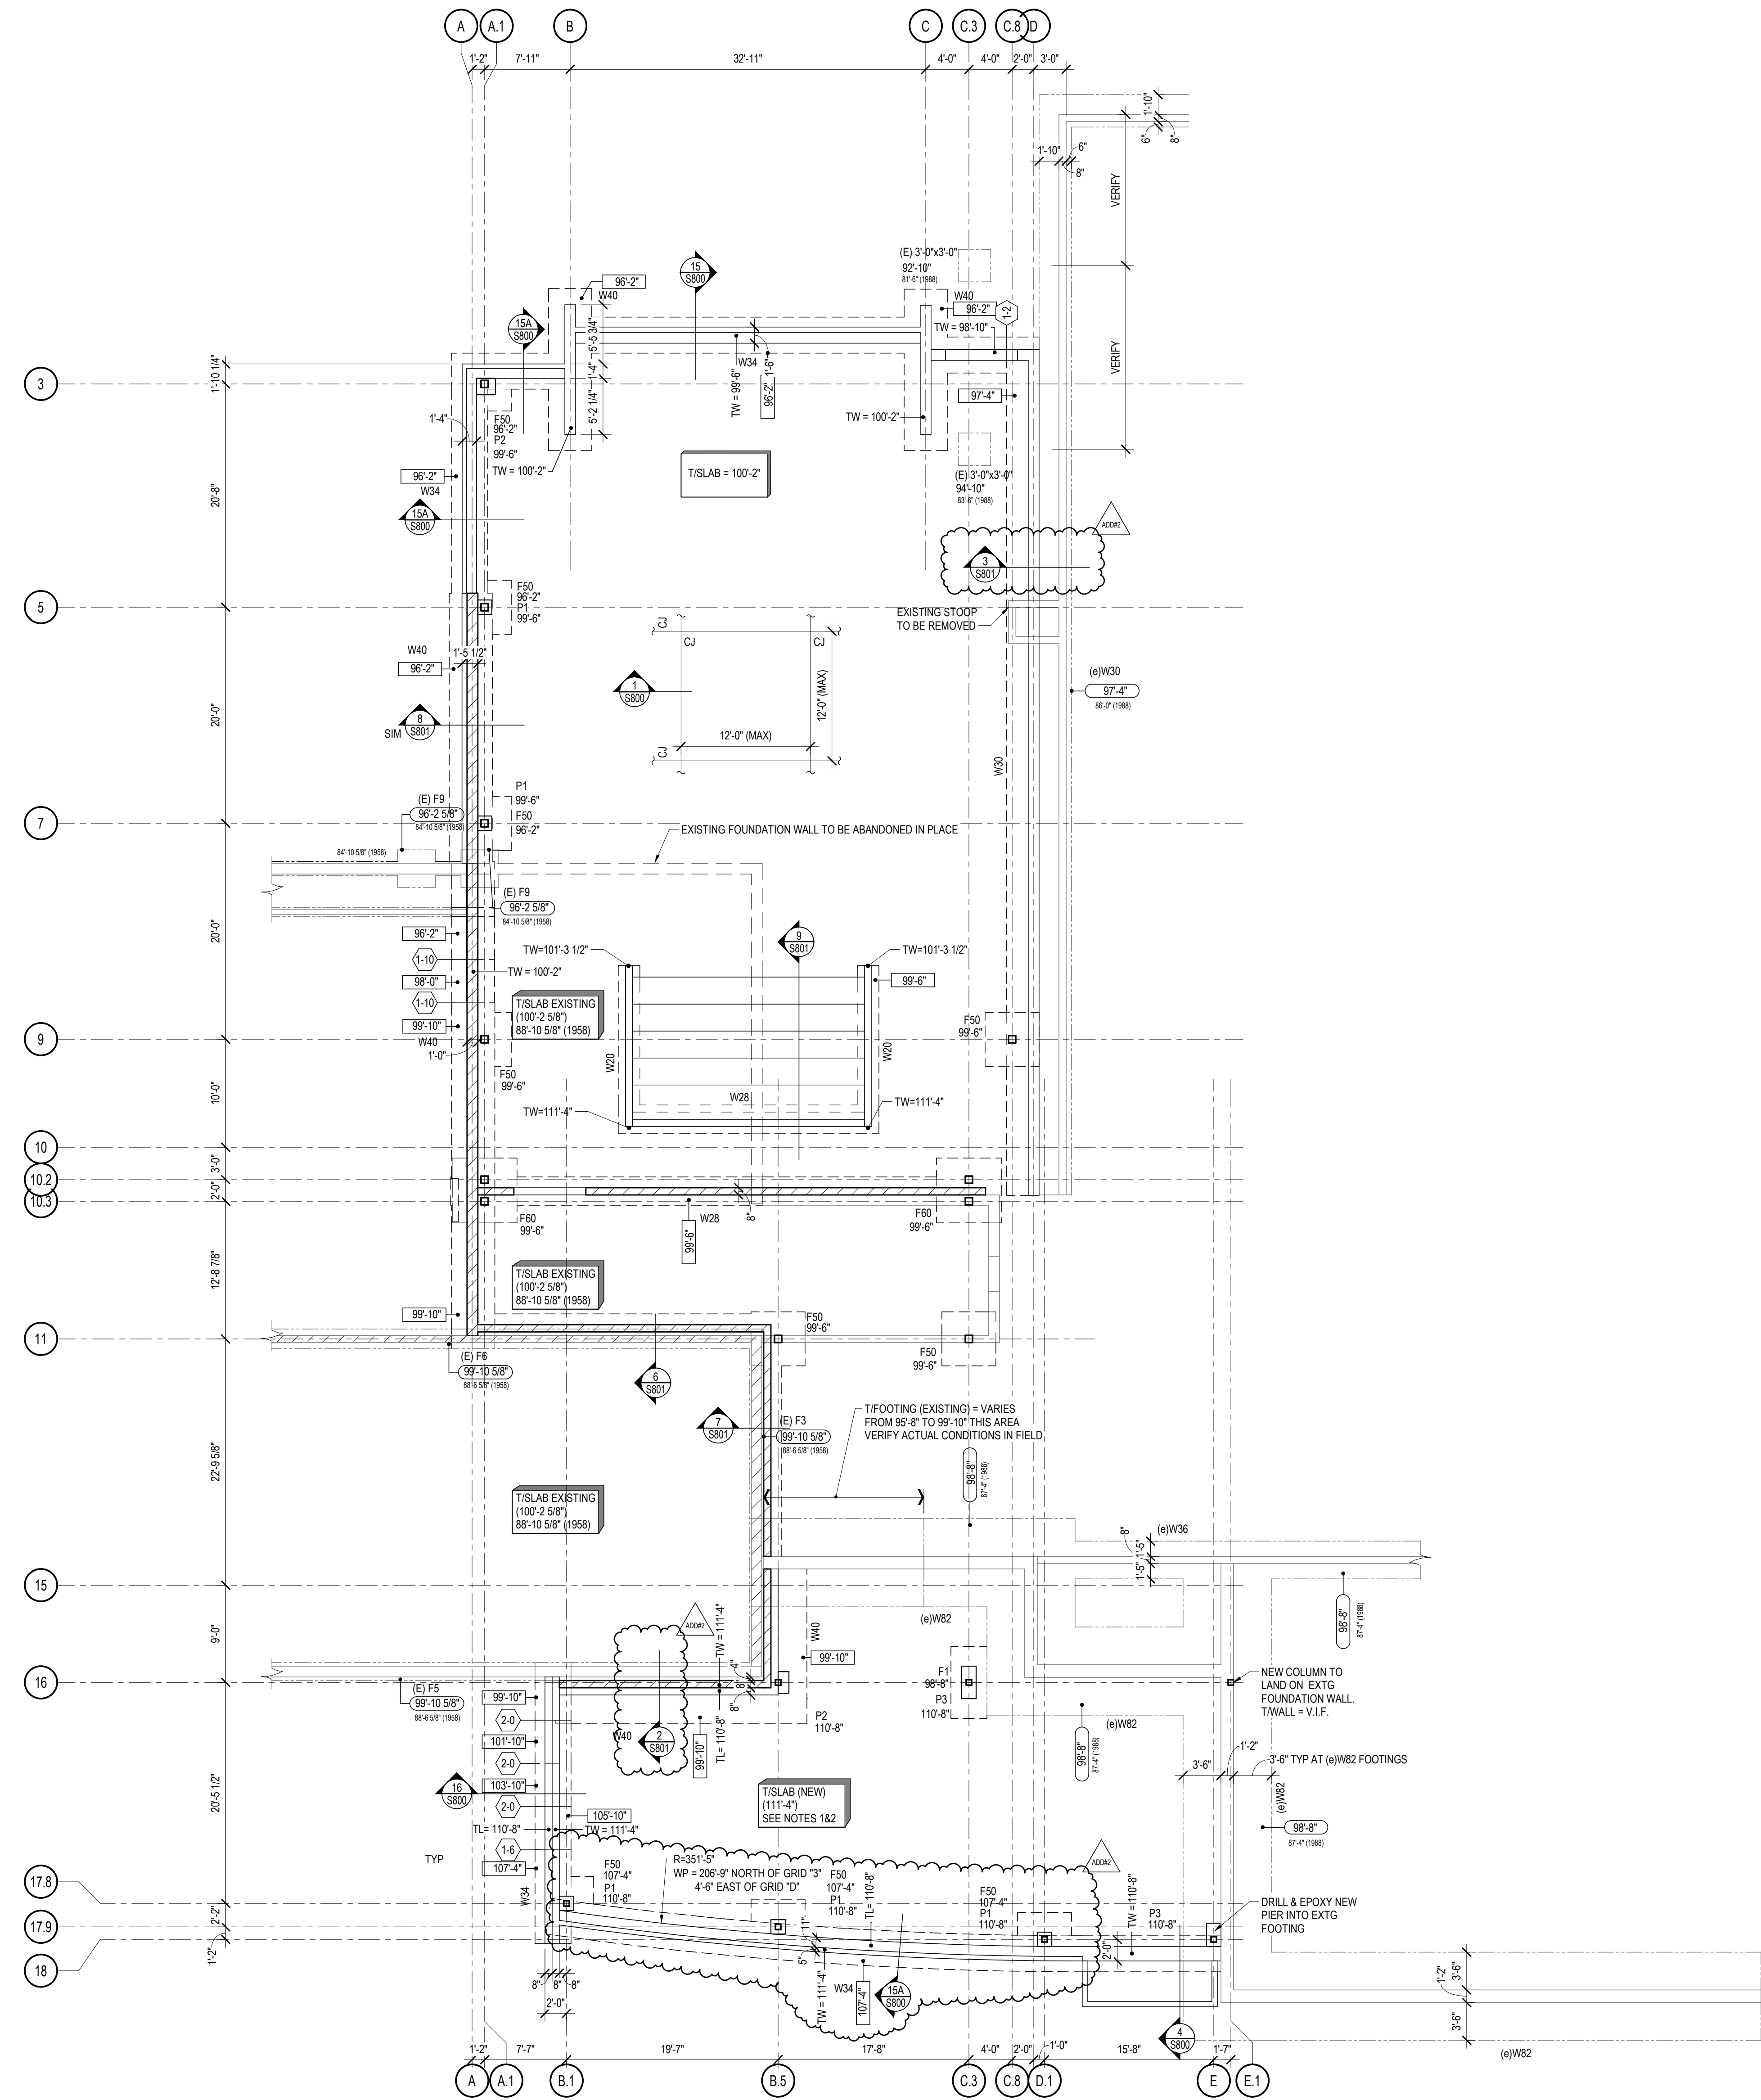

1 FOUNDATION PLAN - SEG B
SCALE: 1/8" = 1'-0"


Project Title: **LANESBORO PUBLIC SCHOOLS ADDITION & REMODEL**
Project Location: **100 KIRKWOOD ST E LANESBORO, MN 55949**
Sheet Title: **FOUNDATION PLAN - SEG B**

HSR Project Number: **18063**

Project Date: **7-25-2019**

Drawn By: **raSmith**

Key Plan:

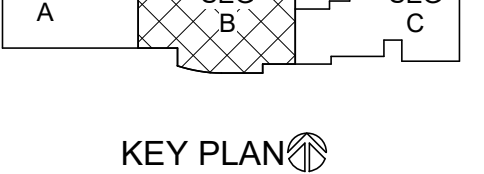

KEY PLAN

Revisions:

No.	Description	Date
ADD#2	ADDENDUM #2	8/19/2019

Graphic Scale: **VARIES**

Last Update: **8/20/2019 10:01:16 AM**

S101



HSR ASSOCIATES INC.
100 MILWAUKEE STREET
LA CROSSE, WISCONSIN
PHONE: 608.784.1830
FAX: 608.782.5844
www.hsrassociates.com

Consultant:

raSmith
1200 E. Avenue D, Ste. 108
Madison, WI 53714-8342
10/18/1001
ra@ra-smith.com
Project Number: 1180777
Contractors are responsible for the means, methods, techniques, equipment and procedures of construction resulting in no structural, temporary supports, shoring, bracing to support imposed loads and other similar items.

ENGINEER CERTIFICATION

I hereby certify that this Plan, Specification or Report was prepared by me or under my direct supervision and that I am a duly licensed Engineer under the laws of the state of Minnesota.


Wayne W. Vandenberg
Date: July 2, 2019 Lic. No.: 43193
This drawing is conditionally issued and reproductions or use of any technical design information is strictly forbidden without written agreement from the responsible Engineer.

ARCHITECT CERTIFICATION

I hereby certify that this Plan, Specification or Report was prepared by me or under my direct supervision and that I am a duly licensed Architect under the laws of the state of Minnesota.


Paul A. ...
Date: July 2, 2019 Lic. No.: 58867
This drawing is conditionally issued and reproductions or use of any technical design information is strictly forbidden without written agreement from the responsible Architect.

FOUNDATION LEGEND

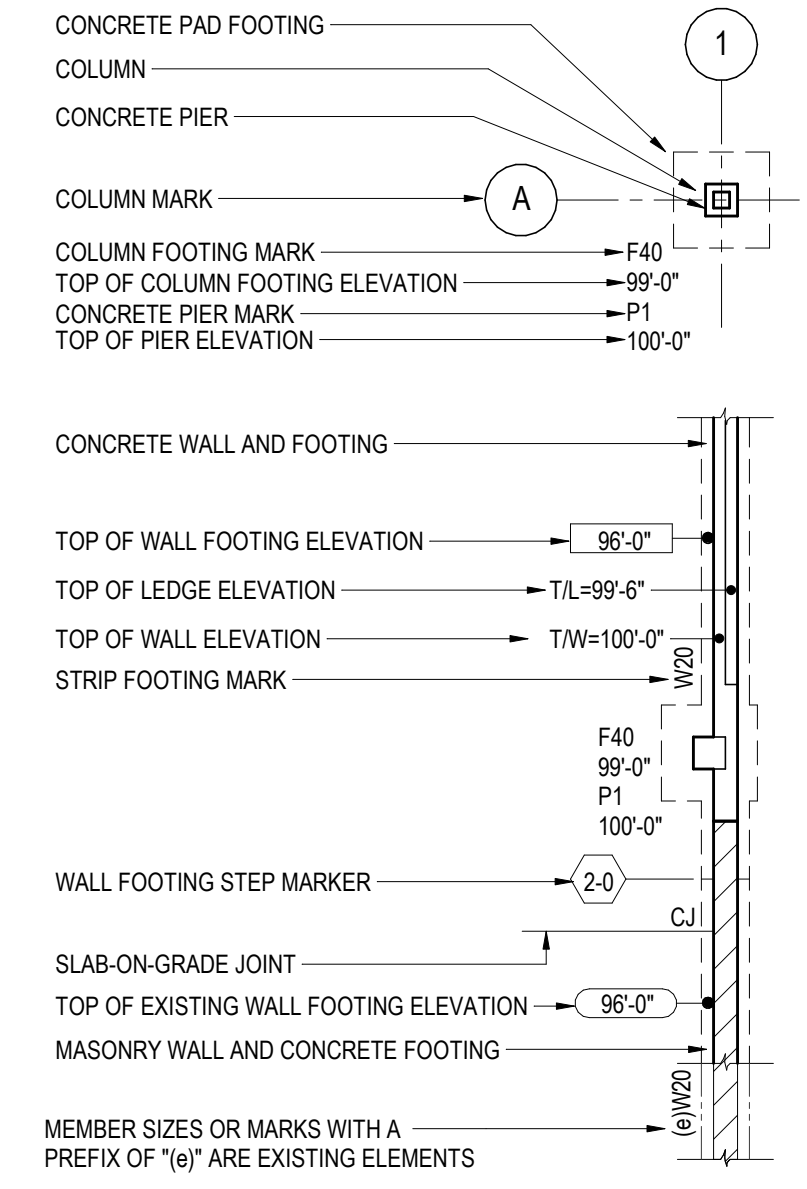

FOUNDATION PLAN NOTES

- FINISH SLAB ELEVATION = AS SHOWN ON PLANS. TOP OF FOOTING ELEVATION AT EXTERIOR WALLS = AS SHOWN ON PLANS.
- SLAB-ON-GRADE TO BE 4" THICK WITH 5000 YD MACRO POLYPROPYLENE SYNTHETIC FIBERS (REFER TO SPECIFICATION) ON 15 MIL MINIMUM VAPOR BARRIER ON 6" OF COMPACTED GRANULAR FILL UNLESS NOTED OTHERWISE.
- IN AREA SHOWN AS (AT GYM) SLAB-ON-GRADE TO BE 5" THICK WITH 5000 YD MACRO POLYPROPYLENE SYNTHETIC FIBERS (REFER TO SPECIFICATION) ON 15 MIL MINIMUM VAPOR BARRIER ON 6" OF COMPACTED GRANULAR FILL. TOP OF SLAB INDICATED IS APPROXIMATE AND SHOULD BE COORDINATED WITH WOOD FLOORING SUPPLIER.
- TYPICAL WHERE SLAB-ON-GRADE ABUTS WALL OR COLUMN, PROVIDE 1/4" x (800 THICKNESS) ISOLATION FILLER STRIP. SET STRIP 1/4" BELOW FINISH SLAB ELEVATION OR USE PRE-SCORED REMOVABLE TOP STRIP ISOLATION BOARD.
- OVER-EXCAVATION PER DETAIL S/S800 MAY BE REQUIRED TO REMOVE EXISTING UNDOCUMENTED FILL AND UNSUITABLE BEARING SOIL.
- TYPICAL DETAILS THAT APPLY TO PLAN INCLUDE:
1/S800 SLAB-ON-GRADE JOINT DETAIL
2/S800 WALL-FOOTING CORNER DETAIL
3/S800 PIPE PASSING UNDER WALL FOOTING DETAIL
10/S800 FOOTING STEP DETAIL
11/S800 ADDED REIN AT WALL OPENING DETAIL
12/S800 CONCRETE WALL JOINT DETAIL
13/S800 ISOLATION JOINT AT COLUMNS
- CONTROL JOINTS ON ALL SLABS
12'-0" OC MAX AT 4' SLABS
15'-0" OC MAX AT 5' SLABS
- = MASONRY PIER ABOVE

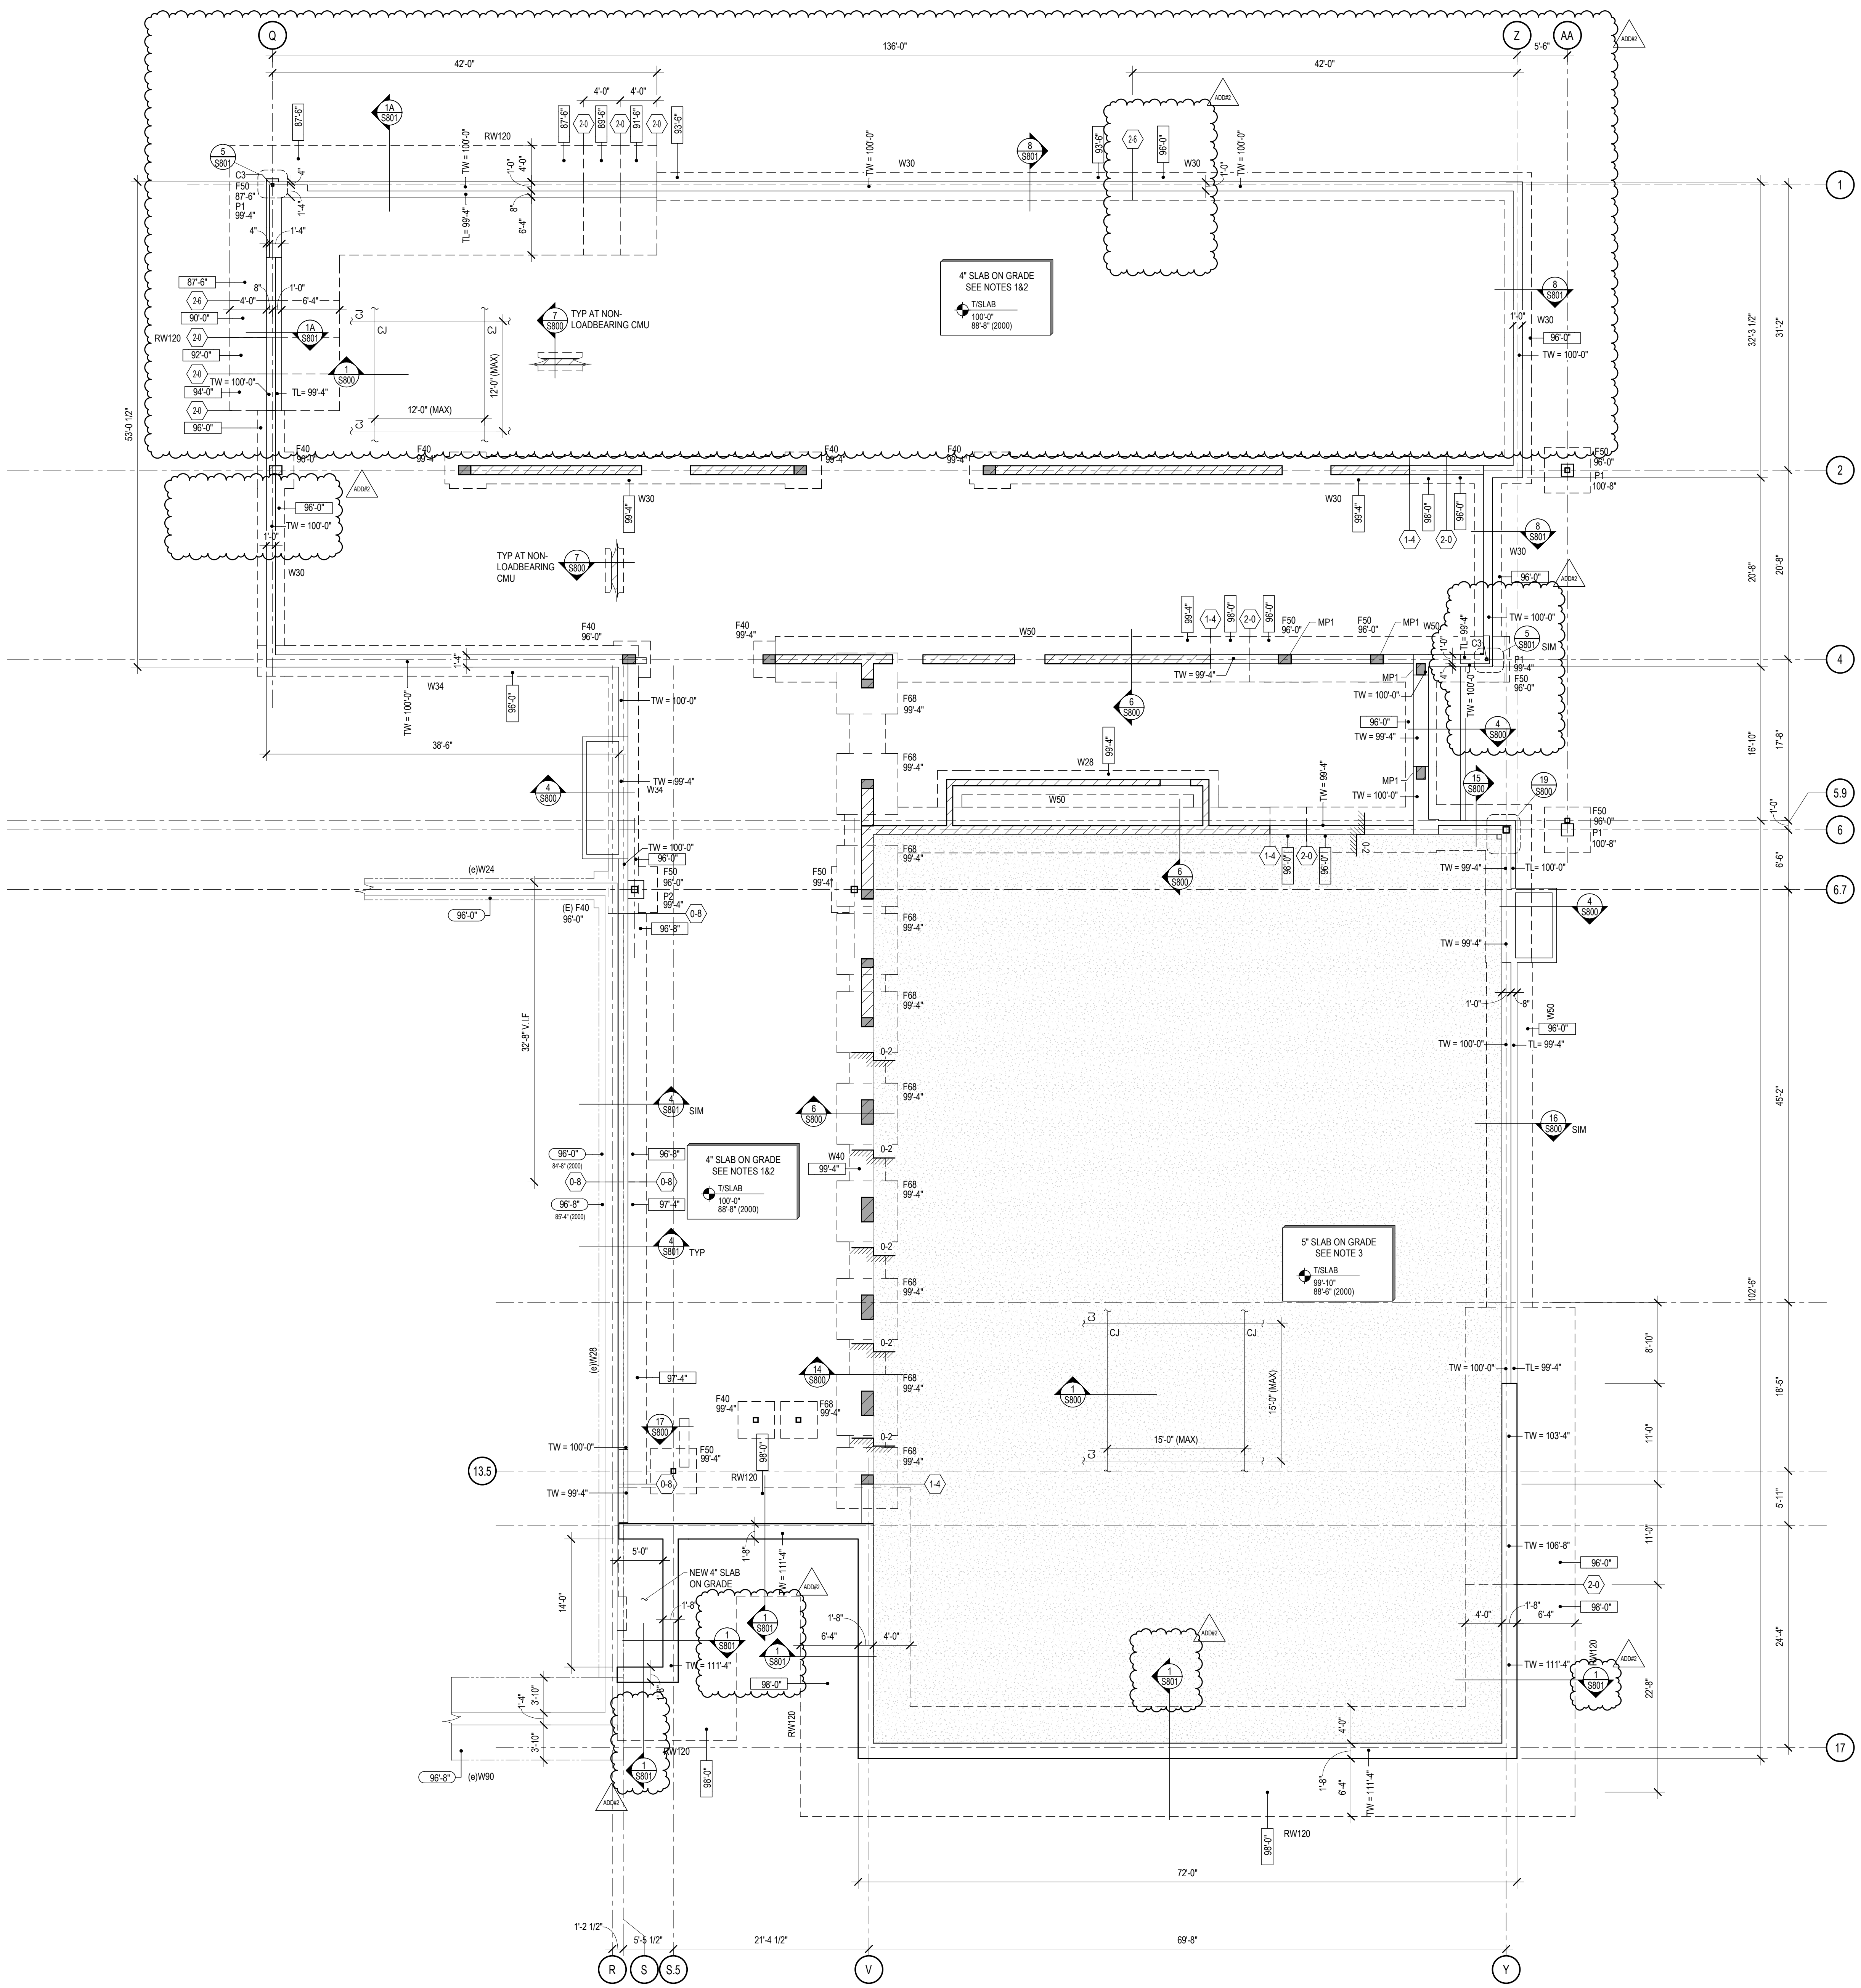

**LANESBORO PUBLIC SCHOOLS
ADDITION & REMODEL**


Project Title: LANESBORO PUBLIC SCHOOLS
ADDITION & REMODEL
Project Location: 100 KIRKWOOD ST E
LANESBORO, MN 55949

Sheet Title: FOUNDATION PLAN - SEG C

HSR Project Number: 18063

Project Date: 7-25-2019

Drawn By: raSmith

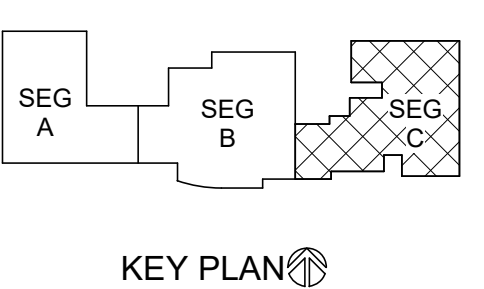

Revisions:

No.	Description	Date
ADD#2	ADDENDUM #2	8/19/2019

Graphic Scale: VARIES
Last Update: 8/20/2019 10:01:17 AM

S102



HSR ASSOCIATES INC.
100 MILWAUKEE STREET
LA CROSSE, WISCONSIN
PHONE: 608.784.1830
FAX: 608.782.5844
www.hsrassociates.com

Consultant:

raSmith
1520 E. Avenue D, Ste. 108
Madison, WI 53718-8342
608.447.2014
www.ra-smith.com
Project Number: 1180777

Contractor is responsible for the means, methods, techniques, equipment and procedures of construction resulting in the completed project. Temporary supports, shoring, bracing to support temporary loads and other similar items.

ENGINEER CERTIFICATION

I hereby certify that this Plan, Specification or Report was prepared by me or under my direct supervision and that I am a duly licensed Engineer under the laws of the state of Minnesota.

Wayne W. Vandenberg
Date: July 9, 2019 Lic. No. 43193

ARCHITECT CERTIFICATION

I hereby certify that this Plan, Specification or Report was prepared by me or under my direct supervision and that I am a duly licensed Architect under the laws of the state of Minnesota.

Paul A. [Signature]
Date: July 9, 2019 Lic. No. 58867

**LANESBORO PUBLIC SCHOOLS
ADDITION & REMODEL**

Project Title: **LANESBORO PUBLIC SCHOOLS
ADDITION & REMODEL**


Project Location: **100 KIRKWOOD ST E
LANESBORO, MN 55949**

Sheet Title: **LOW ROOF FRAMING PLAN - SEG C**

HSR Project Number: **18063**

Project Date: **7-25-2019**

Drawn By: **raSmith**

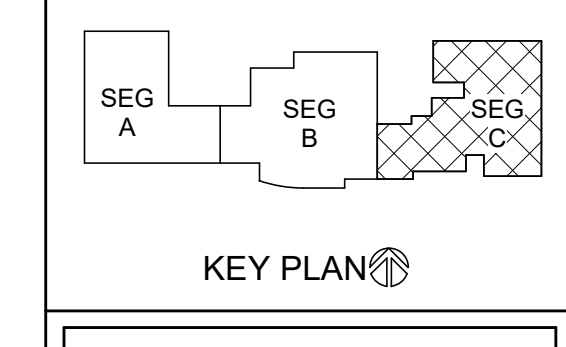


No.	Description	Date
ADD#2	ADDENDUM #2	8/19/2019

Graphic Scale: **VARIES**

Last Update: **8/20/2019 10:01:20 AM**

S121.1

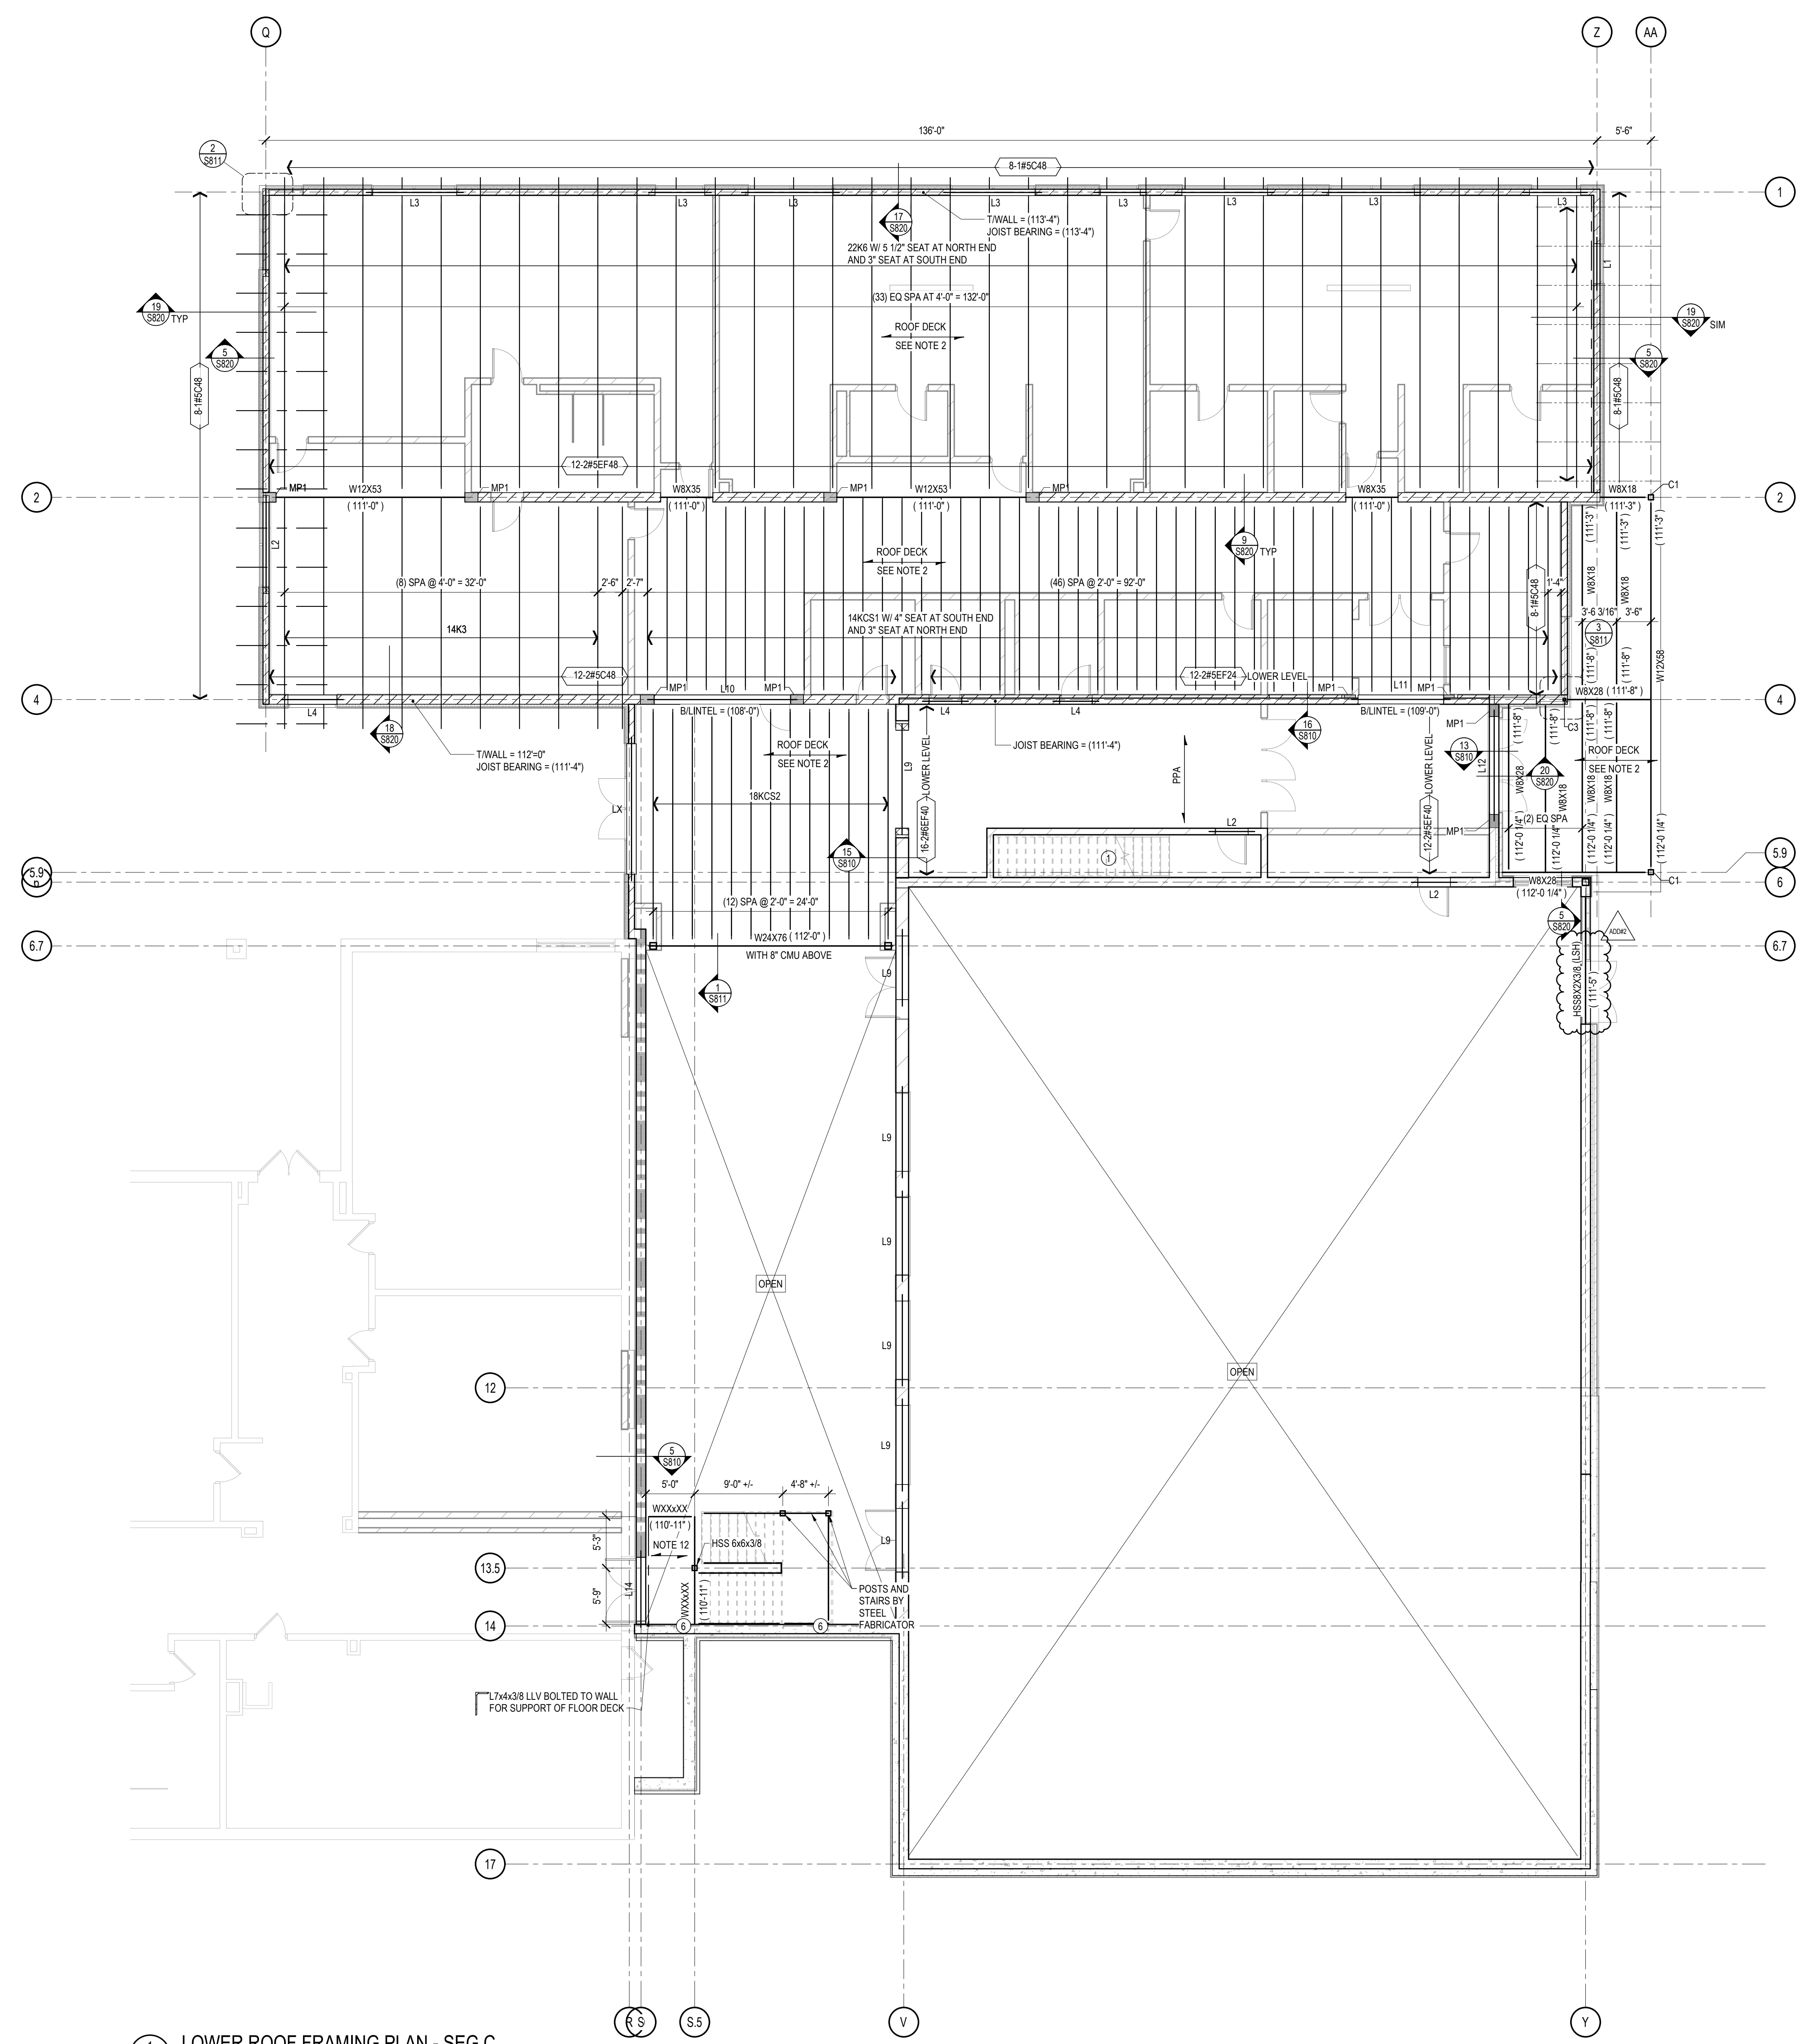


ROOF FRAMING KEY NOTES


- STAIRS BY STEEL FABRICATOR
- 4" OD 1/4 GA TUBING PER HOOP MFR
- MISCELLANEOUS STEEL ANGLES OR UNISTRUT BY HOOP INSTALLER BASED ON MFR REQUIREMENTS. JOIST DESIGNER TO ACCOUNT FOR ADDITIONAL LOADS FROM BASKETBALLS AS FOLLOWS:
 $X = 0.5K$ $X = 1K$
 PLAYING POSITION STORAGE POSITION
- LOADS ARE BASED ON ASSUMED GOAL WEIGHT OF 2500 LBS IN PLAYING POSITION, INCLUDING 750 LBS ALLOWANCE FOR PLAYERS. COORDINATE EXACT LOCATIONS, WEIGHTS AND CONNECTION REQUIREMENTS WITH ARCHITECT AND GOAL SUPPLIER. PROVIDE ADDITIONAL BRIDGING AT EACH GOAL AS REQUIRED TO RESIST LATERAL LOADS IMPOSED UPON JOISTS FROM MOVING GOAL. COORDINATE LOAD MAGNITUDES WITH GOAL SUPPLIER.
- THIS AREA DESIGNED TO ACCOMMODATE SOLAR PANELS
- NO BRICK VENEER AT THESE OPENINGS
- LEX5K38 (GALV) LOOSE VENEER LINTEL - OPENING SIZE PLUS 8" EACH END
- STEEL FABRICATOR TO PROVIDE EMBED PLATE AT CONNECTION TO FOUNDATION WALL

ROOF FRAMING PLAN NOTES

- TOP OF BASE STEEL (JOIST BEARING) ELEVATION = AS NOTED.
- ROOF DECKING SHALL BE 1/2" x 20GA WIDE RIB PRIME PAINTED METAL ROOF DECK FASTENED TO SUPPORTING STRUCTURE USING 364 PATTERN OF ANY OF THE ATTACHMENT METHODS SHOWN IN DETAIL 1S820 WITH #10 TEK SIDELAP FASTENERS AT 18" OC.
 INSTALL DECK UNDER 3 OR MORE SPAN CONDITIONS.
 AT SHADED AREAS, PROVIDE ACOUSTICAL DECKING. IN THESE AREAS, ATTACHMENT METHODS SHALL BE LIMITED TO MECHANICAL FASTENERS ONLY. WELDING OF DECK TO UNDERLYING STRUCTURE SHALL NOT BE PERMITTED.
- DECKING SHALL BE 3/8" GAGE TYPE 'NA' ACOUSTICAL WIDE RIB PRIME PAINTED METAL ROOF DECK FASTENED TO SUPPORTING STRUCTURE USING 24/4 PATTERN WITH #10 TEK SIDELAP FASTENERS AT 12" OC. PROVIDE DECK WITH THE FOLLOWING PROPERTIES:
 THICK = 0.3074 in $I = 1.334 \text{ in}^4$ $S_x = 0.688 \text{ in}^3$
 $F_y = 33 \text{ KSI}$ $S_y = 0.749 \text{ in}^3$
- INSTALL DECK CONTINUOUS OVER 3 OR MORE SPANS.
- INDICATES LOCATION OF BAR JOIST BOTTOM CHORD EXTENSION. DO NOT WELD EXTENSION TO SUPPORT FRAMING.
- PROVIDE 8" HIGH BOND BEAM WITH (2) #5 CONTINUOUS AT AND ADJACENT TO JOIST BEARING ELEVATIONS UNLESS NOTED OTHERWISE. WHERE JOIST BEARING IS NOT AT COURSING, PROVIDE PARTIAL HEIGHT BLOCK GROUDED SOLID TO TOP OF BOND BEAM. WIDTH OF BOND BEAM TO MATCH WALL THICKNESS AND IS TO RUN CONTINUOUS THROUGH CONTROL JOINTS. PROVIDE CORNER BARS WHERE THEY OCCUR AND LAP ALL BOND BEAM STEPS A MINIMUM OF 24".
- JOIST SUPPLIER TO PROVIDE CONTINUOUS TOP AND BOTTOM CHORD HORIZONTAL ANGLE BRIDGING AS REQUIRED. PROVIDE DIAGONAL X-BRIDGING WHERE INDICATED.
- PROVIDE ANGLE FRAME SUPPORT AT ALL ROOF OPENINGS IN ACCORDANCE WITH DETAIL 4S820.
- ALL BAR JOISTS AND JOIST GIRDERS TO BE DESIGNED FOR A NET UPLIFT LOAD OF 15 PSF IN ADDITION TO GRAVITY VERTICAL LOADS REQUIRED BY THE BAR JOIST DESIGNATION.
- REFER TO SHEET 5002 FOR COLUMN SCHEDULE.
- PROVIDE (2) C6 BELOW ROOFTOP UNIT CURB AND REINFORCE JOIST AS NEEDED AT CURB LOCATION IN ACCORDANCE WITH DETAIL 3S820 (TYPICAL).
- BRACE TOP OF NON-LOAD BEARING CMU WALLS IN ACCORDANCE WITH DETAILS 6S820 AND 7S820.
- TYPICAL SLAB TO BE 9" TOTAL THICKNESS CONCRETE REINFORCED WITH EITHER MACRO POLYPROPYLENE FIBERS OR WELDED WIRE FABRIC ON 15" 20 GAUGE COMPOSITE METAL DECKING SPANNING ACROSS BR JOISTS. IN AREAS MARKED ON PLAN WITH [X] (POLISHED CONCRETE) MUST USE 6"x6" W2.9xW2.9 WELDED WIRE FABRIC IN SLABS (NO FIBERS ALLOWED). VERIFY POLISHED CONCRETE LOCATIONS WITH ARCHITECTURAL PLANS. AT SIM, 8" TOTAL CONCRETE THICKNESS. REINFORCE WITH #4 BARS AT 12" OC. EACH WAY

1 LOWER ROOF FRAMING PLAN - SEG C
SCALE: 1/8" = 1'-0"

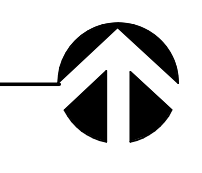

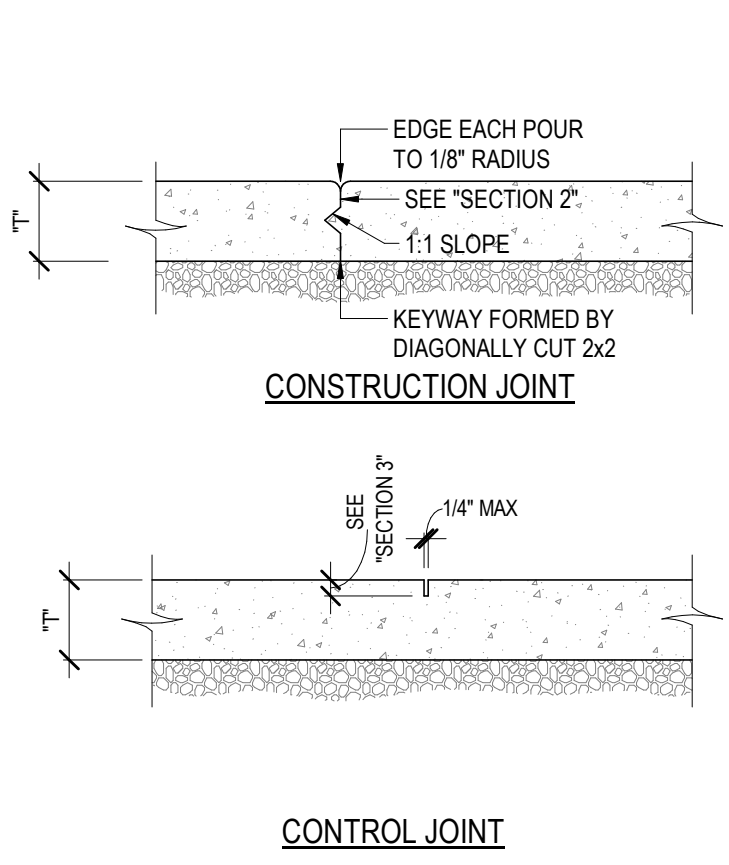

SECTION 1: SLAB-ON-GRADE NOTES

- SLAB-ON-GRADE CONSTRUCTION SHOULD CONFORM WITH THE RECOMMENDATIONS AND REQUIREMENTS SET FORTH IN THE LATEST RELEASE OF ACI 302 GUIDE FOR CONCRETE FLOOR AND SLAB CONSTRUCTION.
- REFER TO THE GENERAL NOTES, THE SPECIFICATIONS, AND THE DRAWINGS FOR SUB-FLOOR DRAINAGE SYSTEM, SUBGRADE PREPARATION, AND/OR MUD SLAB AND VAPOR RETARDER REQUIREMENTS.
- THE SUBGRADE SHALL BE FREE OF STANDING WATER AT THE TIME OF CONCRETE PLACEMENT.
- REFER TO PLANS FOR SLAB THICKNESS (T) AND REINFORCEMENT (WWF OR REINFORCEMENT BARS). REFER TO SPECIFICATIONS FOR FIBER REINFORCEMENT TO BE INCORPORATED IN CONCRETE MIX, IF ANY. WHERE PRESENT, REINFORCING BARS SHALL BE CHAIRED BY SOIL SUPPORTED SLAB BOLSTERS.
- PROVIDE (2) #5 @ 12" AT ALL RE-ENTRANT CORNERS AND OTHER SIMILAR SLAB DISCONTINUITIES.
- UNLESS SHOWN OTHERWISE ON THE DRAWINGS, PROVIDE CONTROL AND/OR CONSTRUCTION JOINTS AT EVERY COLUMN LINE AND IN BETWEEN THE COLUMNS SUCH THAT THE JOINT SPACING DOES NOT EXCEED 36"(T) UNO. THE RESULTING PANELS SHOULD BE APPROXIMATELY SQUARE.

SECTION 2: CONSTRUCTION JOINT NOTES


- BREAK THE BOND BETWEEN NEW AND PREVIOUSLY PLACED SLABS BY SPRAYING OR BY PAINTING THE EXPOSED SIDE OF THE JOINT WITH A CURING COMPOUND, ASPHALTIC EMULSION, OR FORM OIL.

SECTION 3: CONTROL JOINT NOTES


- FOR SAW-CUT CONTROL JOINTS, MAKE THE SAW-CUT AS SOON AS THE SLAB IS ABLE TO SUPPORT THE WEIGHT OF WORKERS AND SAWING EQUIPMENT WITHOUT DAMAGE TO THE FINISHED SURFACE OF THE SLAB, BUT WITHIN 24 HOURS.
- DEPTH OF SAW-CUT SHOULD BE 1-1/4" IF PRODUCED USING THE EARLY ENTRY DRY-CUT PROCESS AND 1 1/4" (1" MIN) IF PRODUCED USING THE CONVENTIONAL WET-CUT PROCESS.
- REFER TO SPECIFICATIONS REGARDING EPOXY RESIN OR ELASTOMERIC SEALANT REQUIREMENTS FILL CONTROL JOINTS.

SECTION 4: FORMED CONTROL JOINT OPTION NOTES


- FORM CONTROL JOINTS BY INSERTING A PREMOULDED STRIP INTO THE FRESH CONCRETE UNTIL THE TOP SURFACE OF THE STRIP IS FLUSH WITH THE TOP SURFACE OF THE SLAB.
- TOOL THE SLAB EDGES ROUND ON EACH SIDE OF THE INSERT, 1/8" MAX RADIUS.
- AFTER THE CONCRETE HAS CURED, REMOVE THE INSERTS AND CLEAN THE GROOVE OF LOOSE DEBRIS.

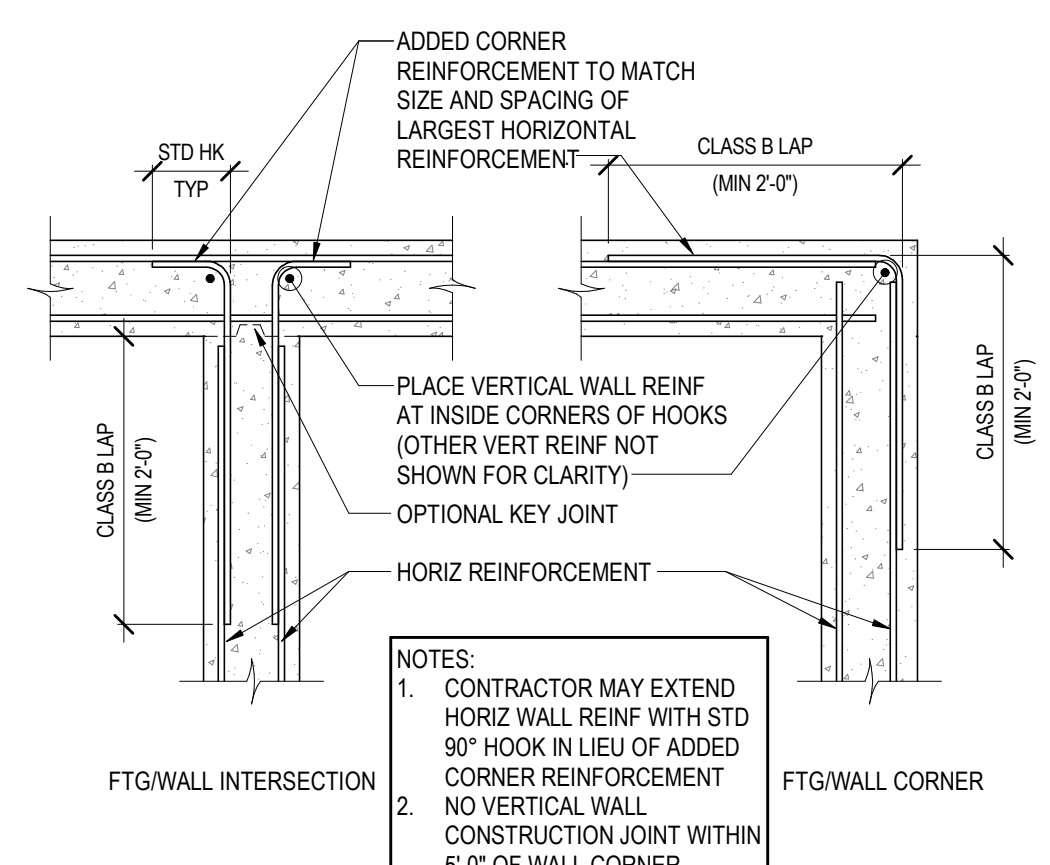


1 TYP SLAB-ON-GRADE CONSTRUCTION & CONTROL JOINT
SCALE: 1" = 1'-0"

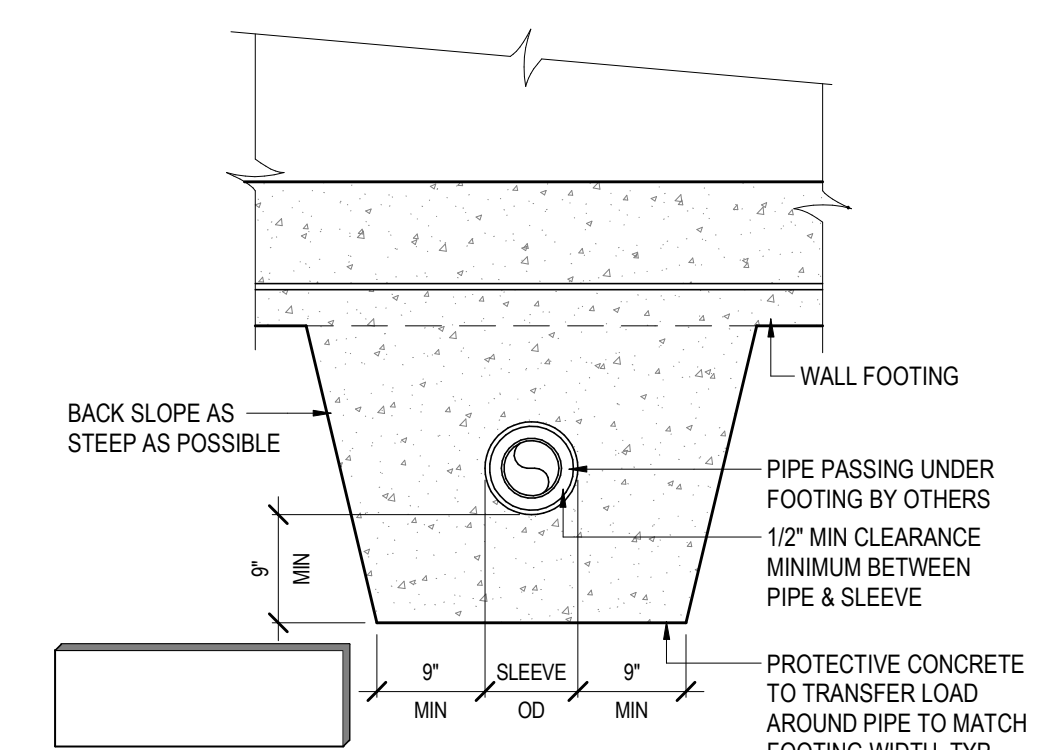

2 TYPICAL CONCRETE WALL AND FOOTING CORNER REINFORCEMENT
SCALE: 3/4" = 1'-0"

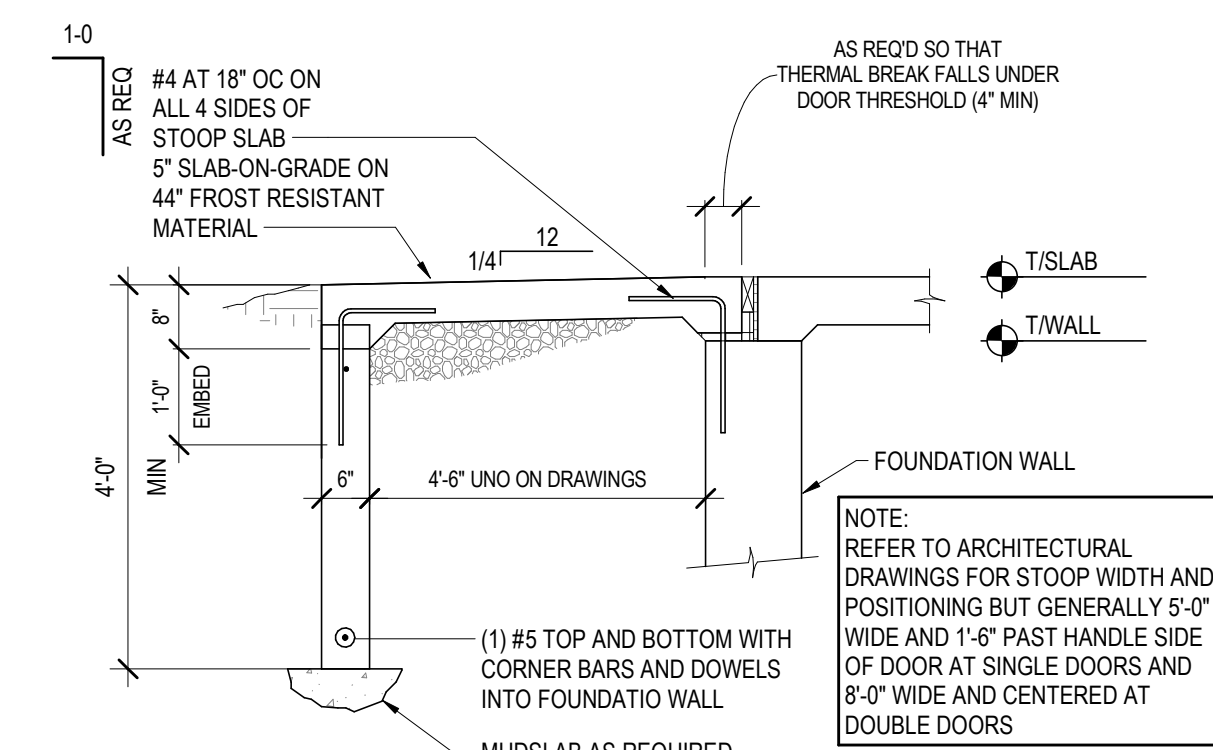


3 PIPE PASSING UNDER WALL FOOTING
SCALE: 3/4" = 1'-0"

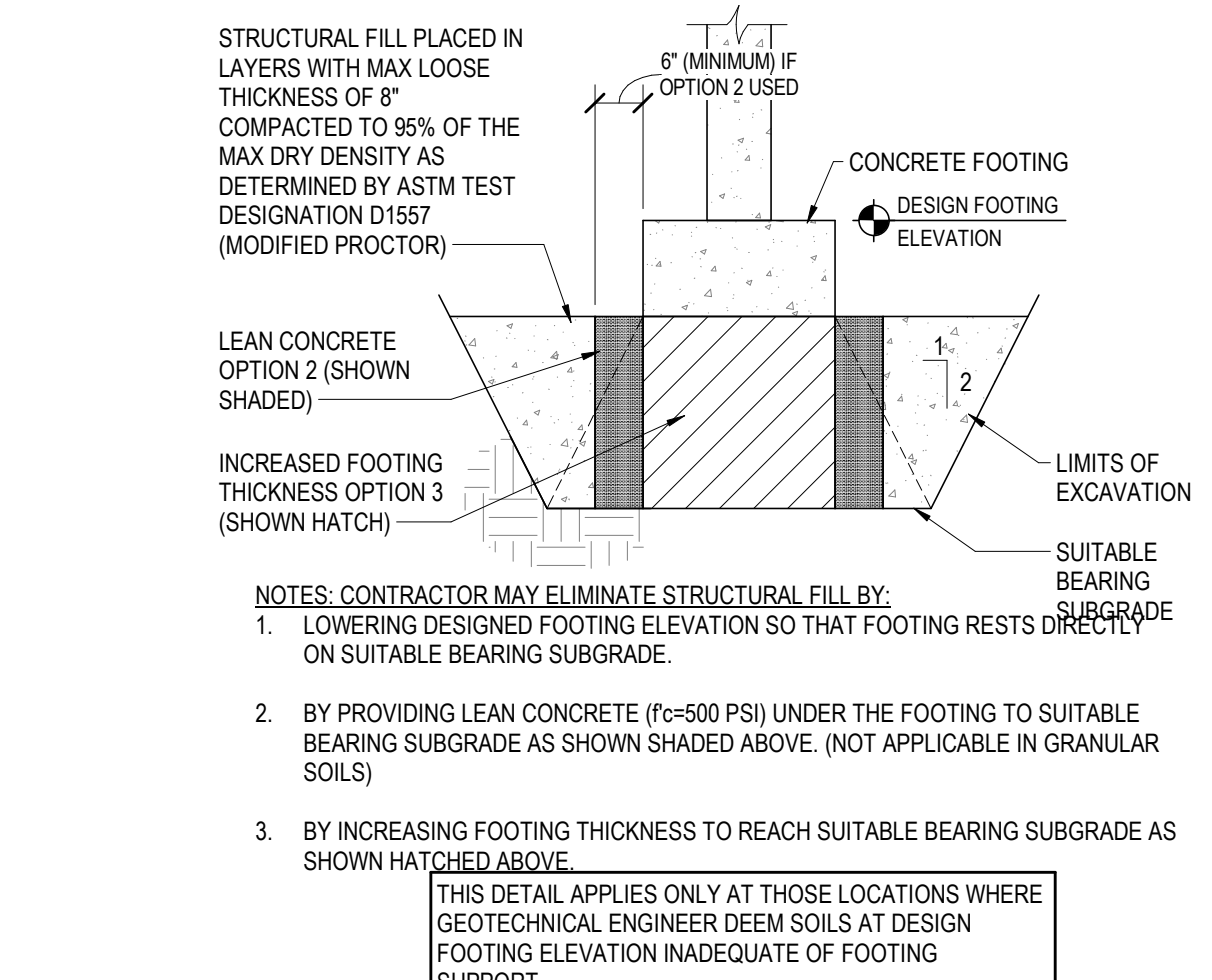


4 TYPICAL STOOP DETAIL
SCALE: 1/2" = 1'-0"




5 OVER EXCAVATION DETAIL
SCALE: 1/2" = 1'-0"

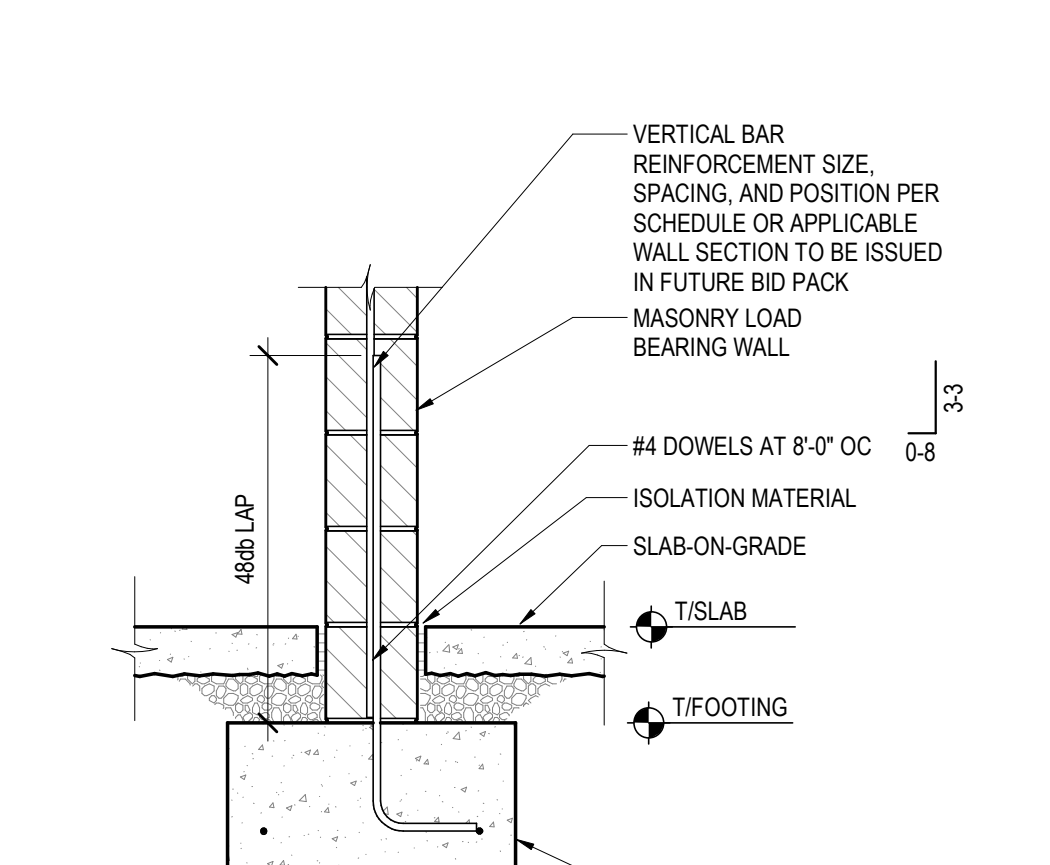


6 FOOTING AT LOAD BEARING MASONRY WALLS
SCALE: 3/4" = 1'-0"

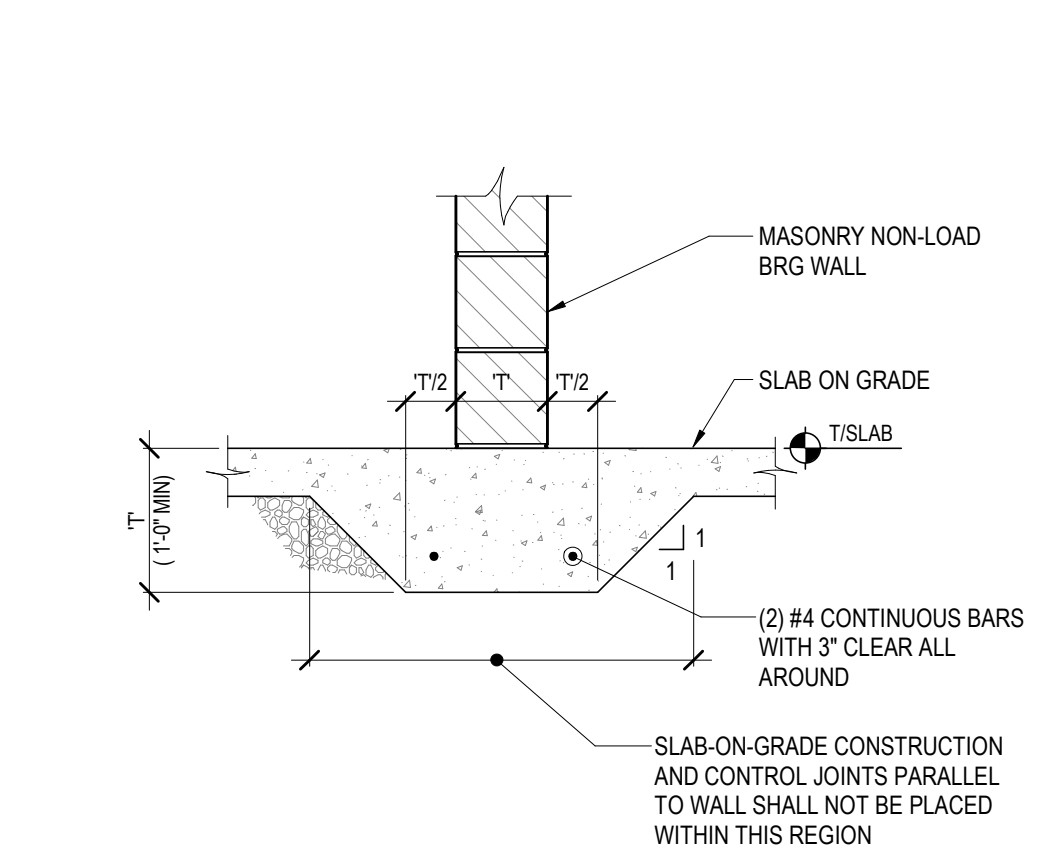


7 TYPICAL THICKENED SLAB FOR NON-LOAD BEARING WALLS
SCALE: 3/4" = 1'-0"

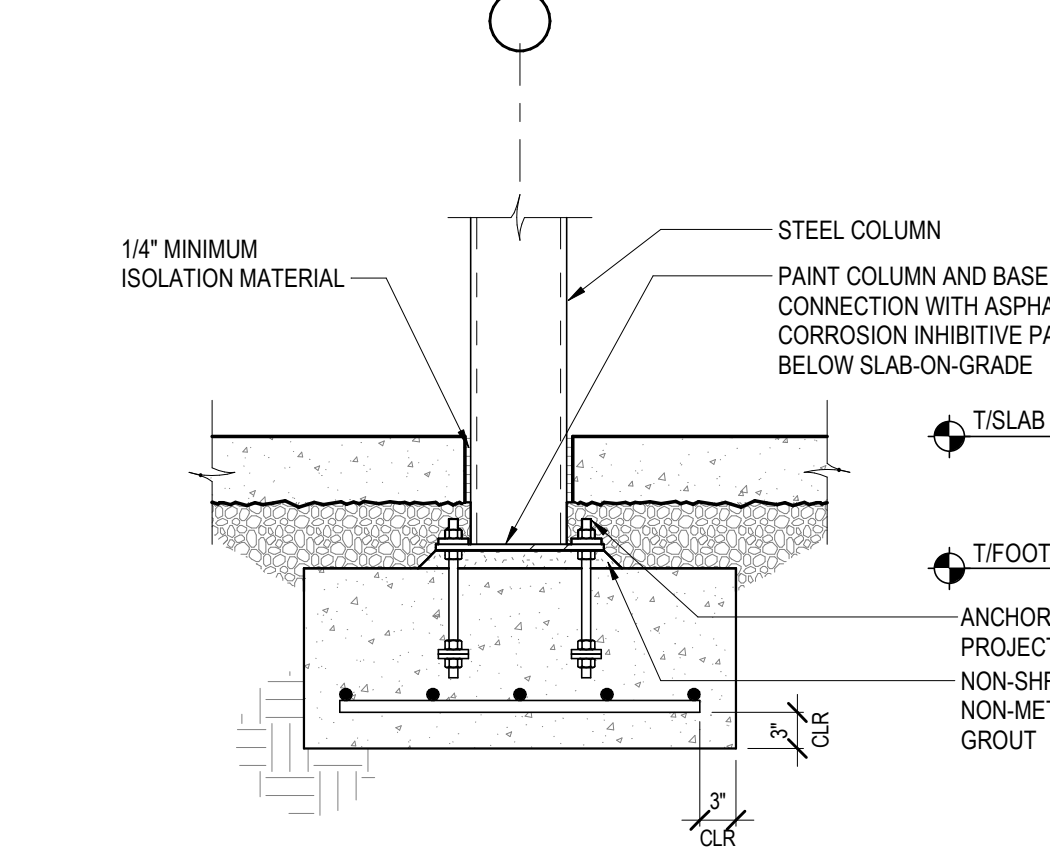


8 TYPICAL INTERIOR COLUMN FOOTING
SCALE: 3/4" = 1'-0"

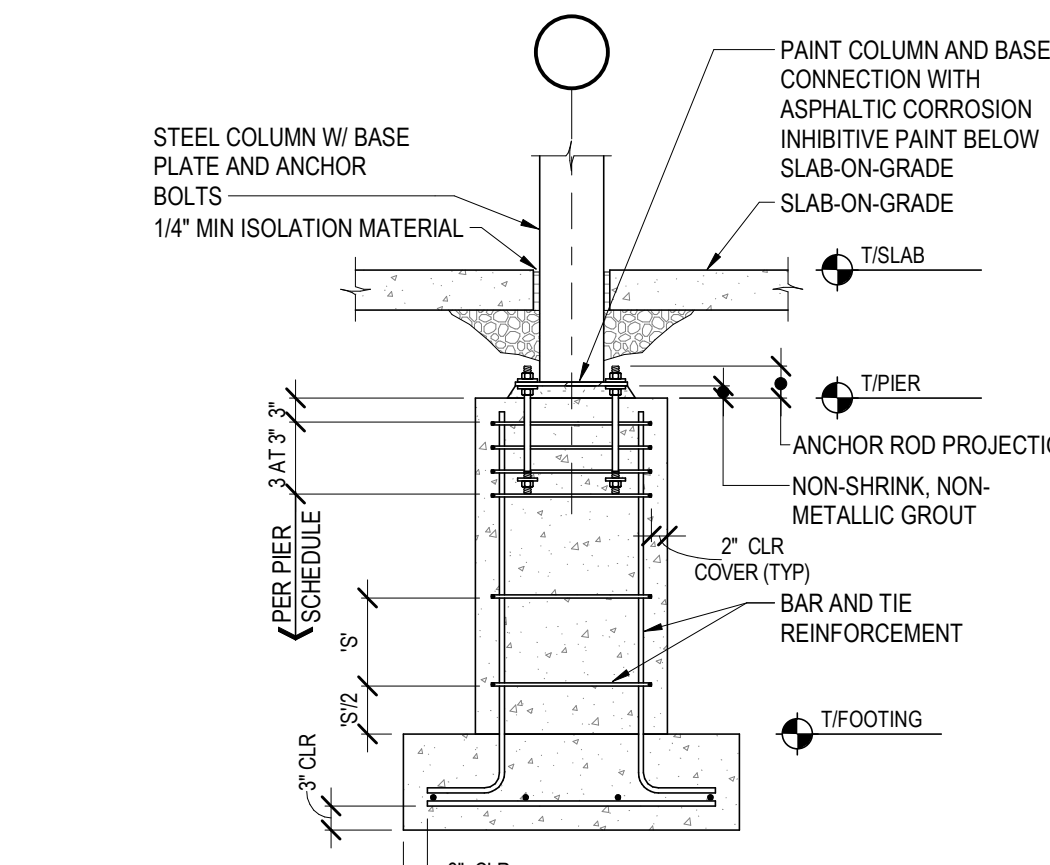


9 TYPICAL CONCRETE PIER
SCALE: 1/2" = 1'-0"

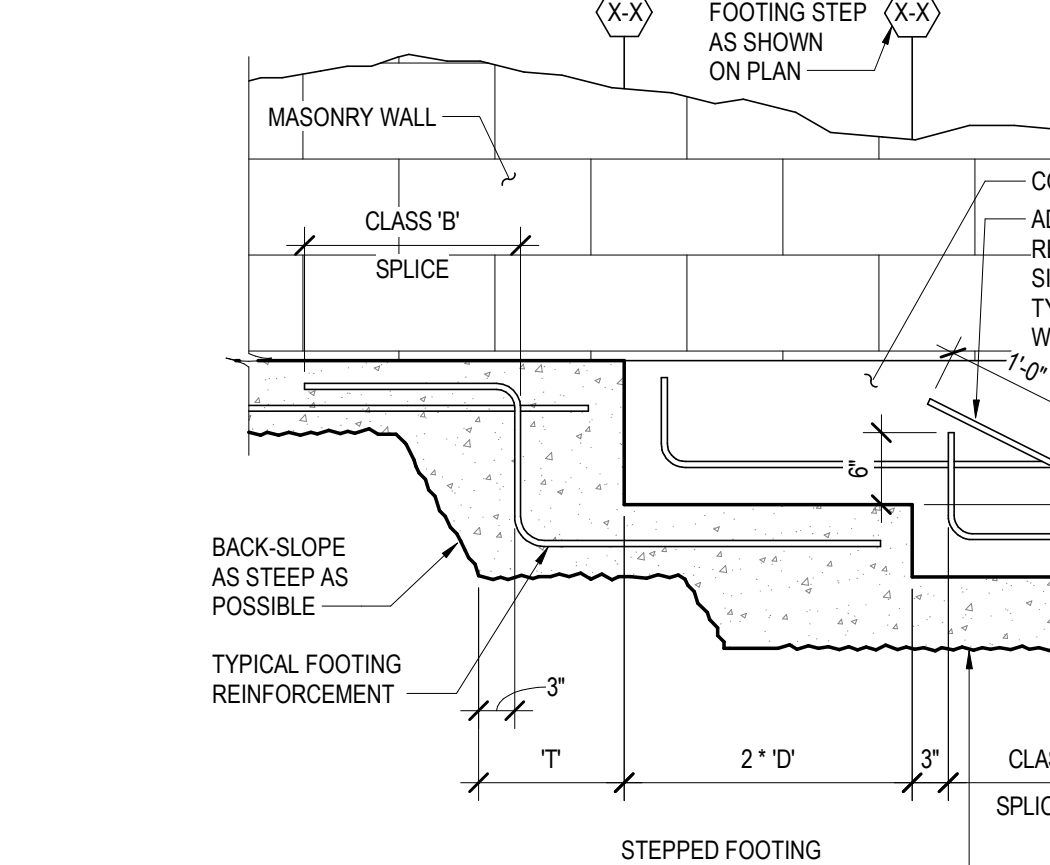


10 FOOTING STEP DETAIL-CAST-IN-PLACE TO CMU WALL
SCALE: 3/4" = 1'-0"

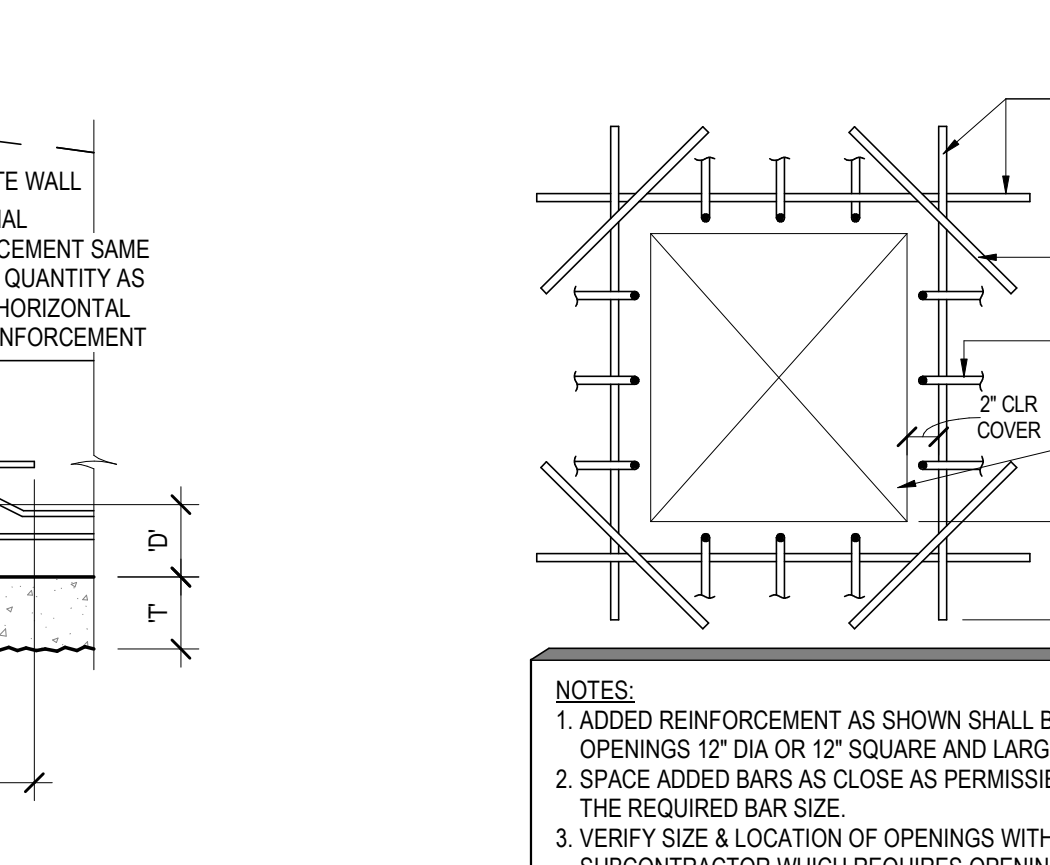


11 ADDED REINF AT WALL OPENING
SCALE: 1" = 1'-0"

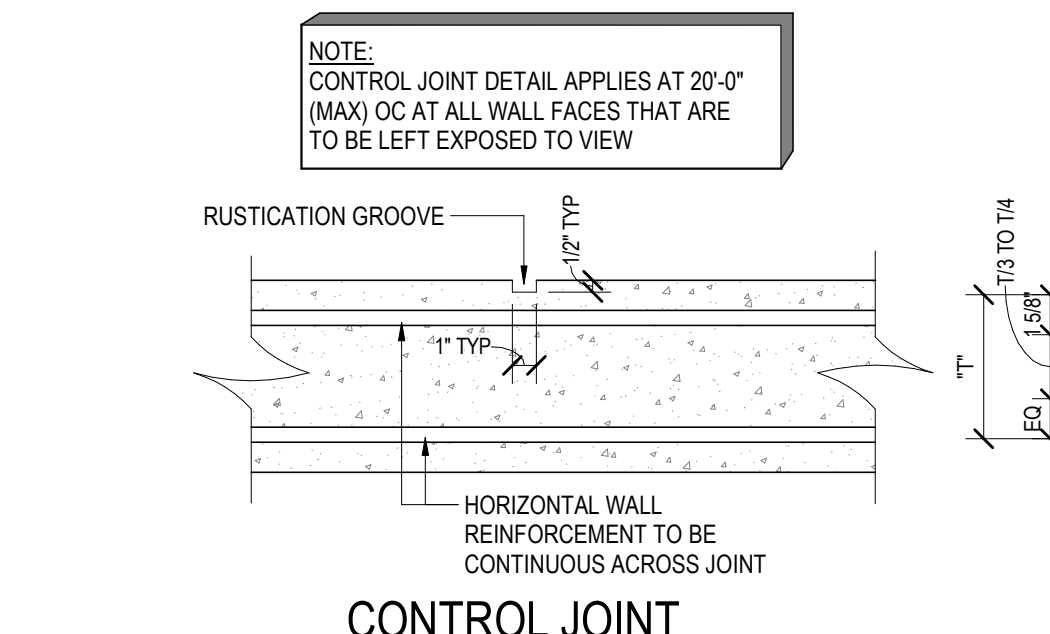


12 TYPICAL CONCRETE WALL JOINTS
SCALE: 1 1/2" = 1'-0"

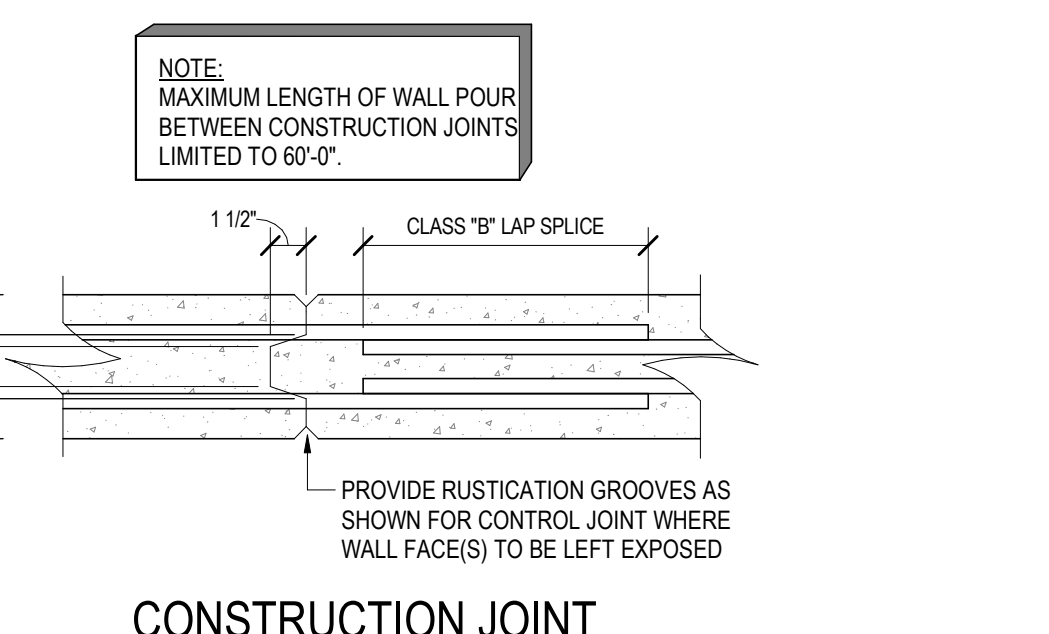


13 ISOLATION JOINT AT COLUMNS
SCALE: 3/4" = 1'-0"

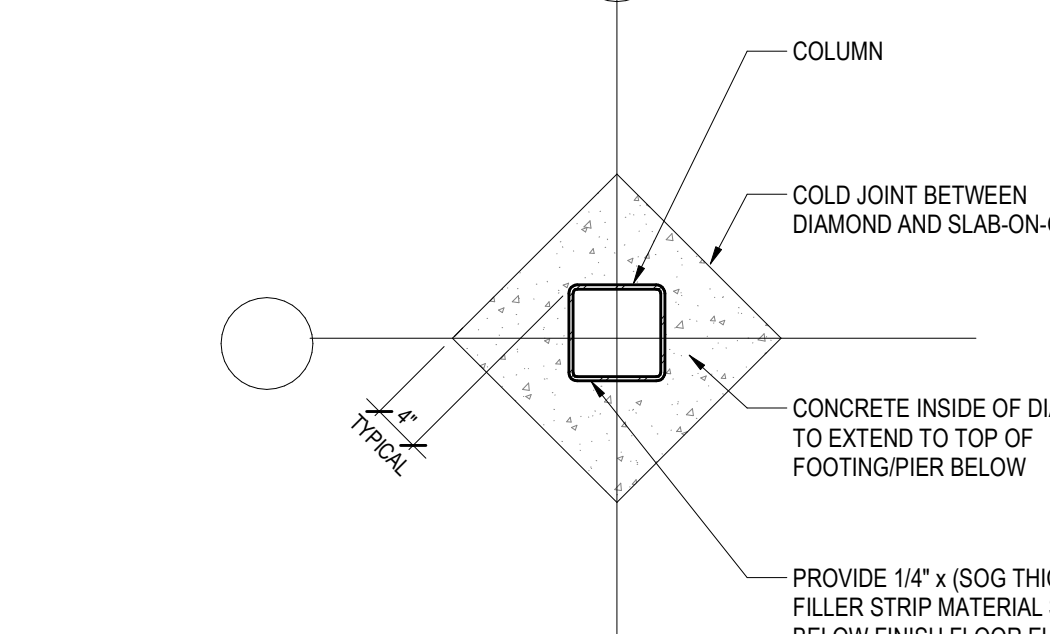


14 SLAB-ON-GRADE DEPRESSION
SCALE: 1" = 1'-0"

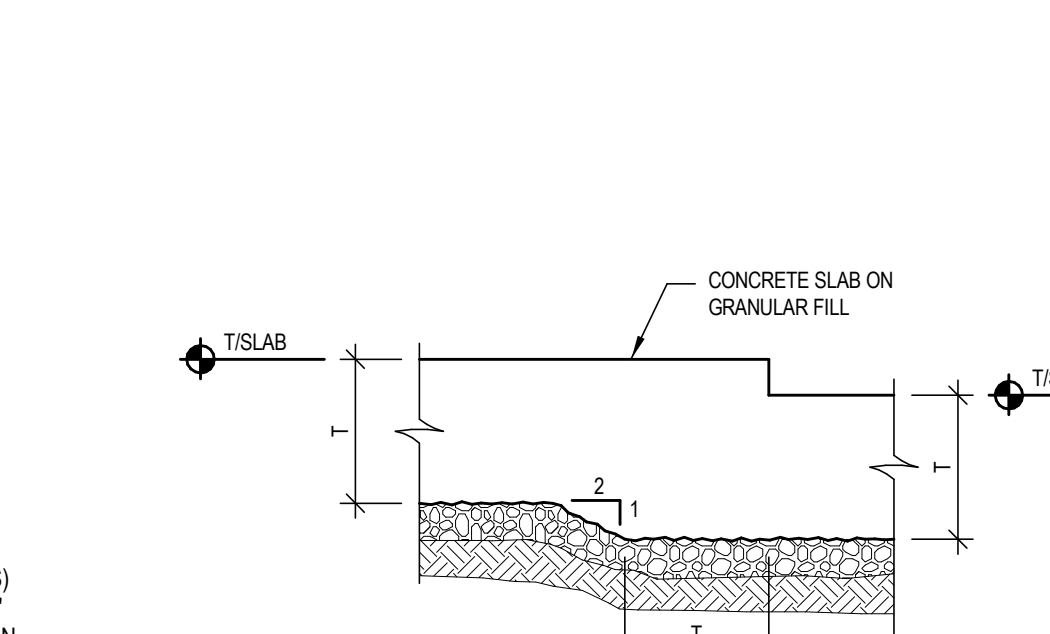


15 CONCRETE FROST AT WINDOW SYSTEM
SCALE: 3/4" = 1'-0"

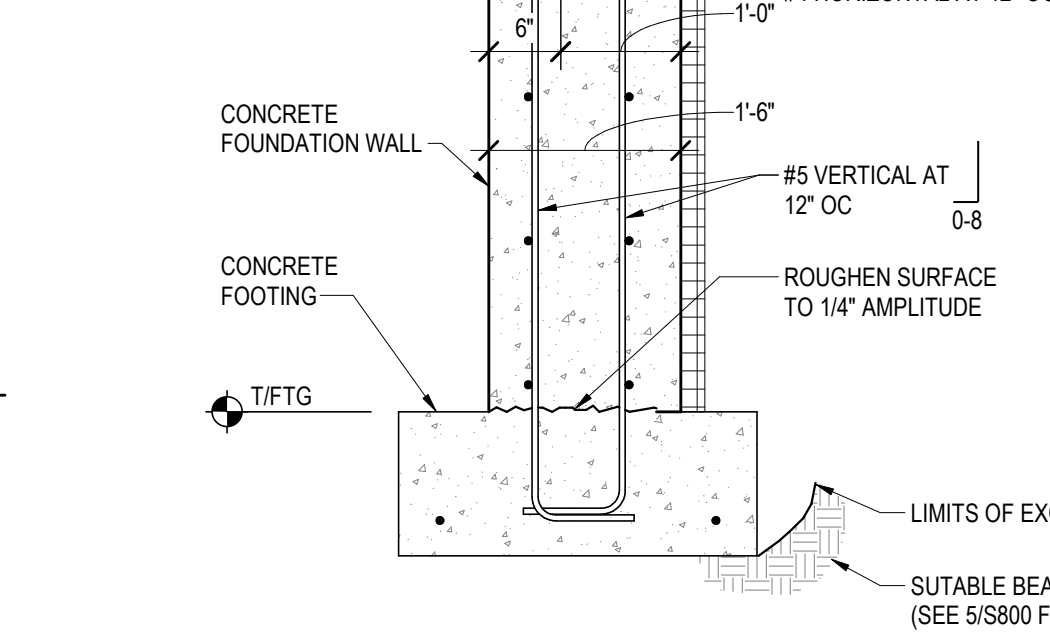


15A CONCRETE FROST AT WINDOW SYSTEM
SCALE: 3/4" = 1'-0"

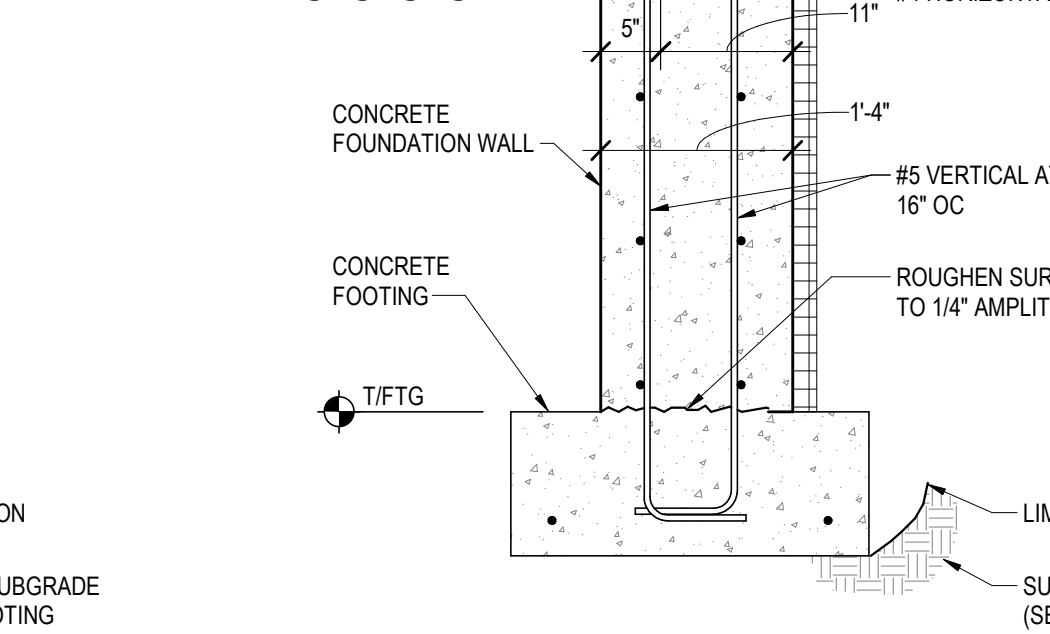


15B CONCRETE FROST AT WINDOW SYSTEM
SCALE: 3/4" = 1'-0"

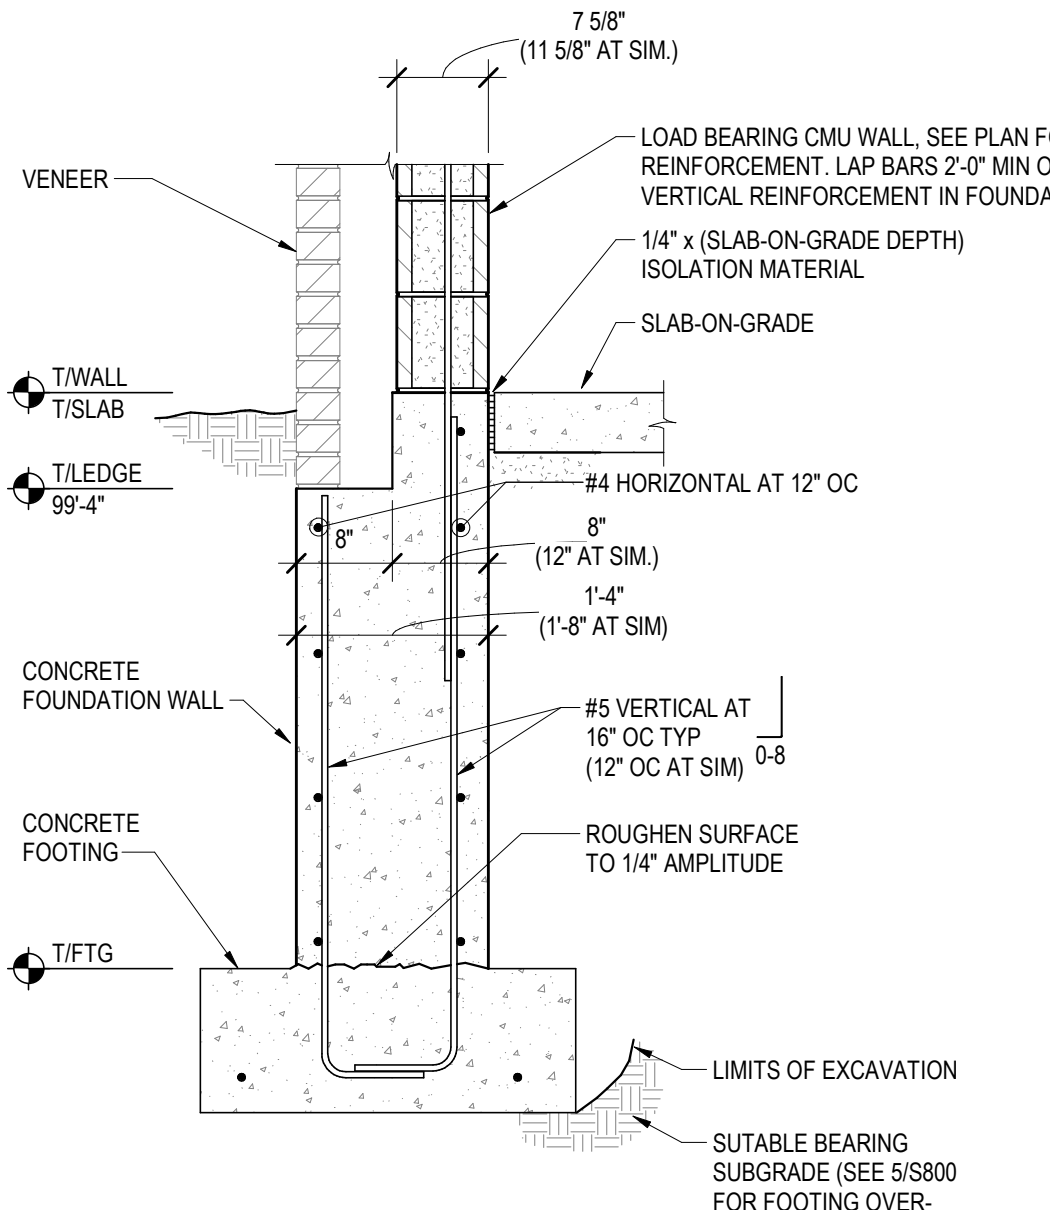


16 CONCRETE FROST DETAIL AT CMU
SCALE: 3/4" = 1'-0"

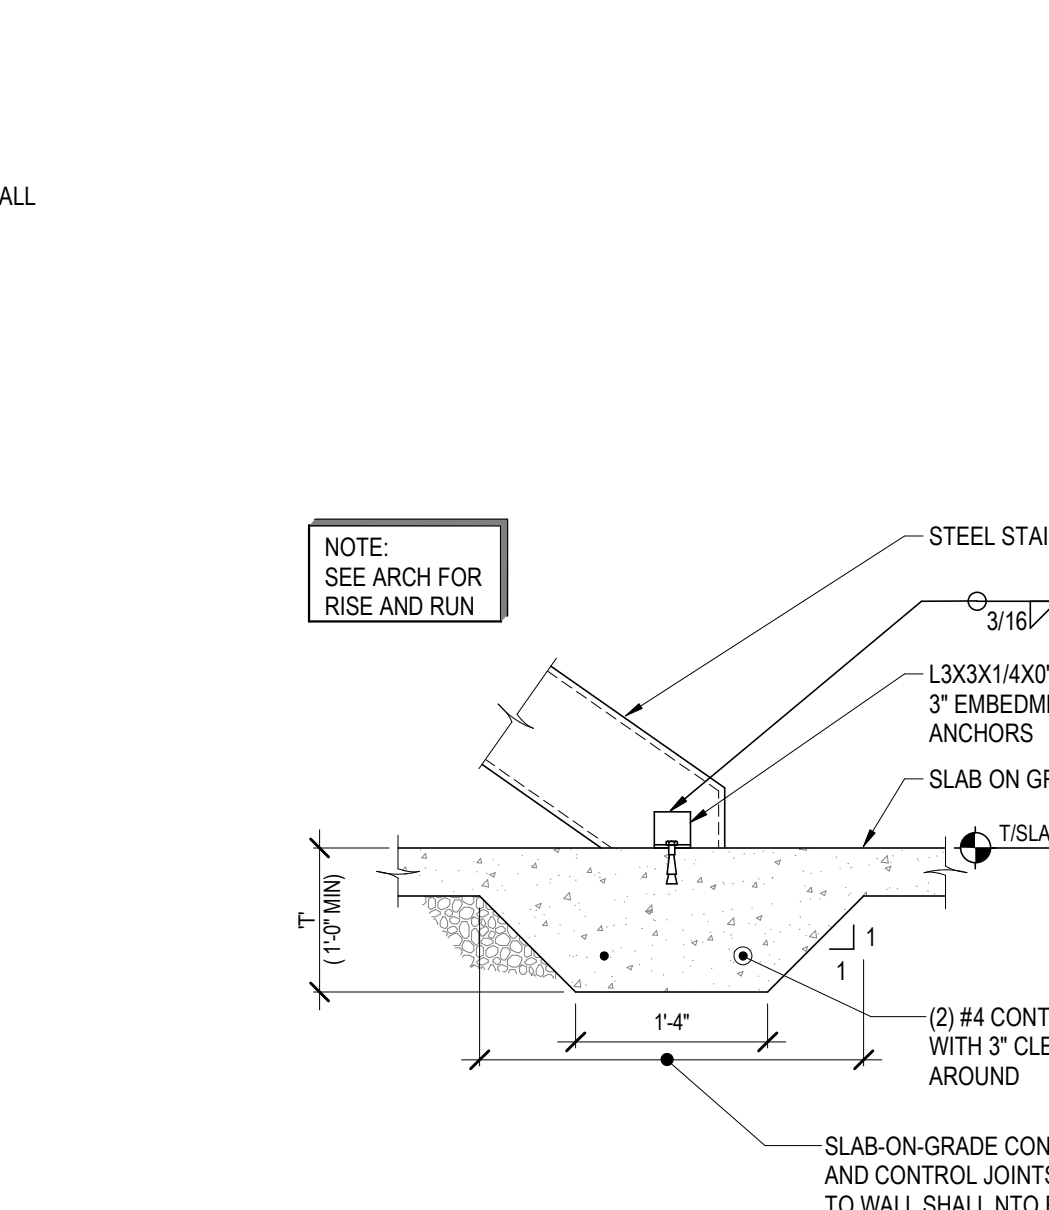

17 TYPICAL THICKENED SLAB
SCALE: 3/4" = 1'-0"

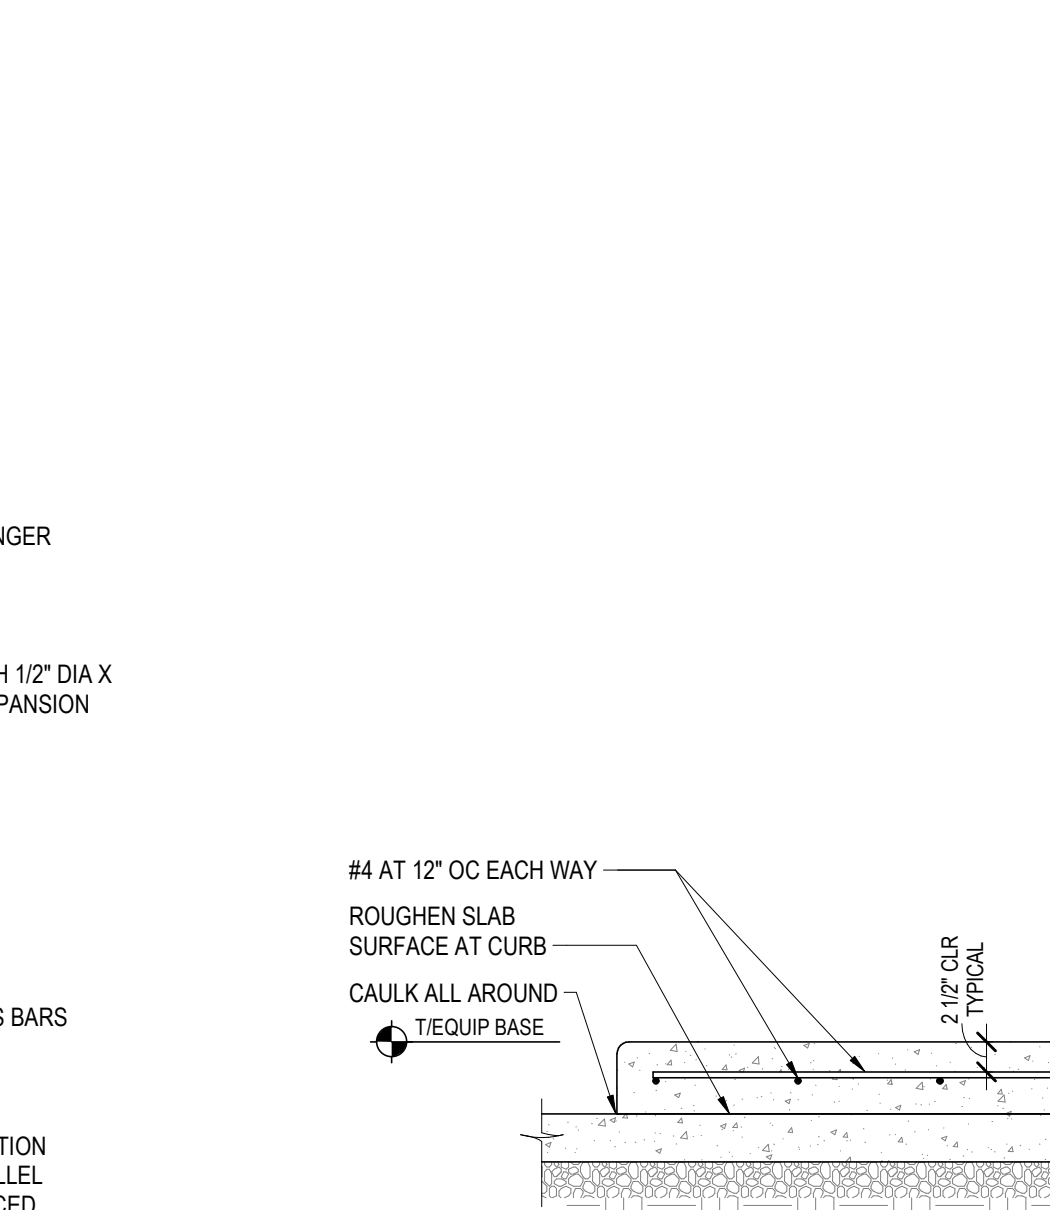

18 CONCRETE EQUIPMENT BASE
SCALE: 3/4" = 1'-0"

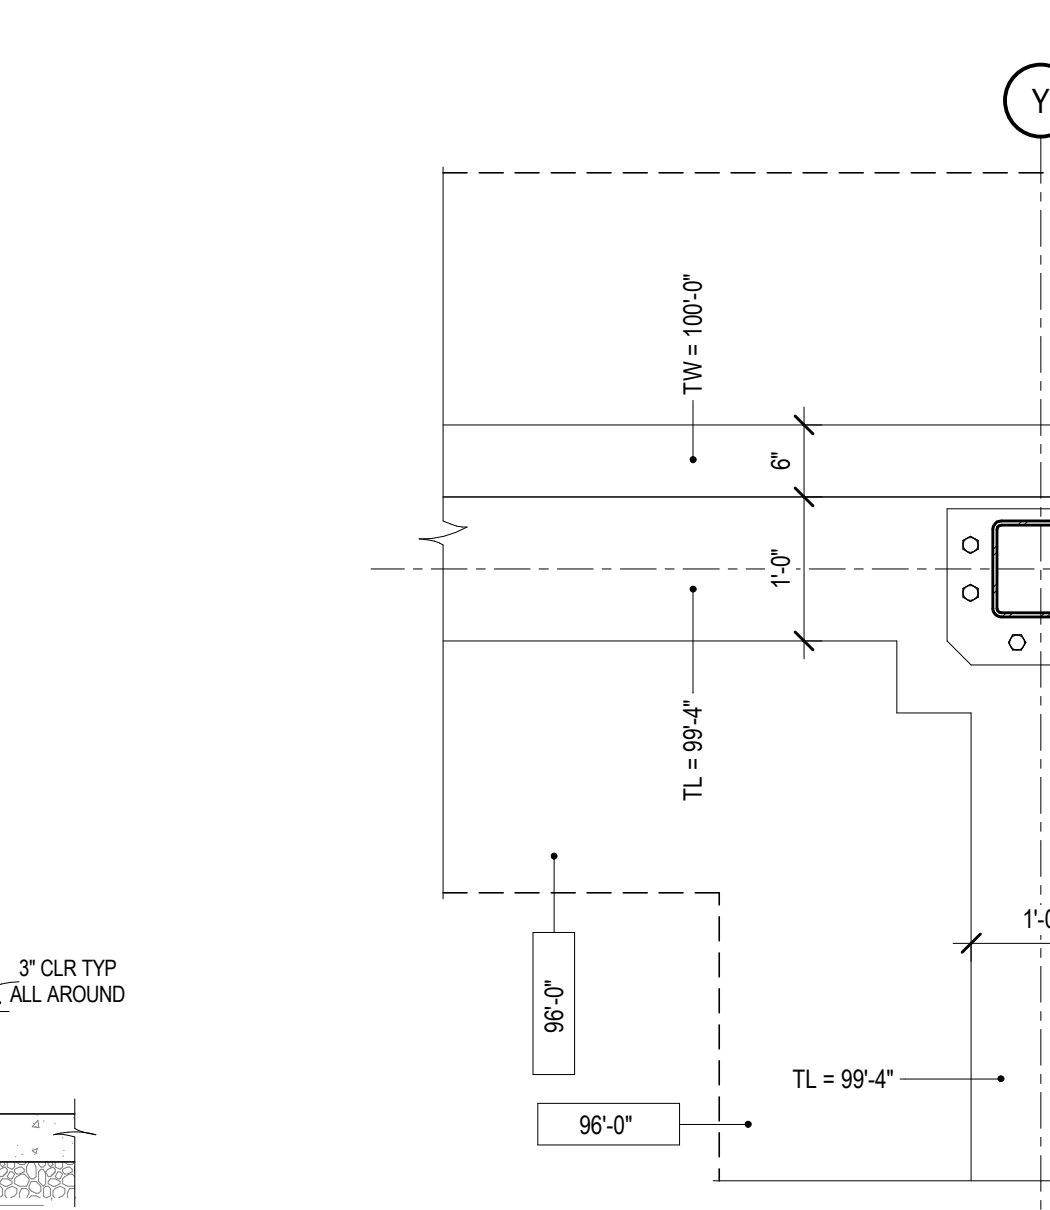

19 PIER DETAIL
SCALE: 3/4" = 1'-0"

No.	Description	Date
ADD#2	ADDENDUM #2	8/19/2019

Graphic Scale: VARIES
Last Update: 8/20/2019 10:01:24 AM



HSR ASSOCIATES INC.
100 MILWAUKEE STREET
LA CROSSE, WISCONSIN
PHONE: 608.784.1830
FAX: 608.782.5844
www.hsrasociates.com

Consultant:

raSmith
CREATIVITY AND INNOVATION
PROJECT NUMBER: 1180777
CONTRACTORS ARE RESPONSIBLE FOR THE MEANS, METHODS, TECHNIQUES, SEQUENCES AND PROCEDURES OF CONSTRUCTION INCLUDING, BUT NOT LIMITED TO, TEMPORARY SUPPORTS, SHORING, FORMING TO SUPPORT REPAIRED LOADS AND OTHER SIMILAR ITEMS.


ENGINEER CERTIFICATION
I hereby certify that this Plan, Specification or Report was prepared by me or under my direct supervision and that I am a duly licensed Engineer under the laws of the state of Minnesota.

Wayne W. Vandenberg
Date: July 2, 2019 Lic. No.: 43193
This drawing is conditionally issued and reproductions or use of any technical design information is strictly forbidden without written agreement from the responsible Engineer.


ARCHITECT CERTIFICATION
I hereby certify that this Plan, Specification or Report was prepared by me or under my direct supervision and that I am a duly licensed Architect under the laws of the state of Minnesota.

Paul A. ...
Date: July 2, 2019 Lic. No.: 58867
This drawing is conditionally issued and reproductions or use of any technical design information is strictly forbidden without written agreement from the responsible Architect.


MARK	DIMENSIONS						REINFORCEMENT							
	A	W	E	B	C	D	1	2	3	4	5	6	7A	7B
RW120	1'-8"	12'-0"	1'-8"	4'-0"	6'-4"	1'-0"	#7 @ 10"	#7 @ 10"	#5 @ 12"	(6) #6	(12) #6	#6 @ 10"	#6 @ 12"	#6 @ 10"

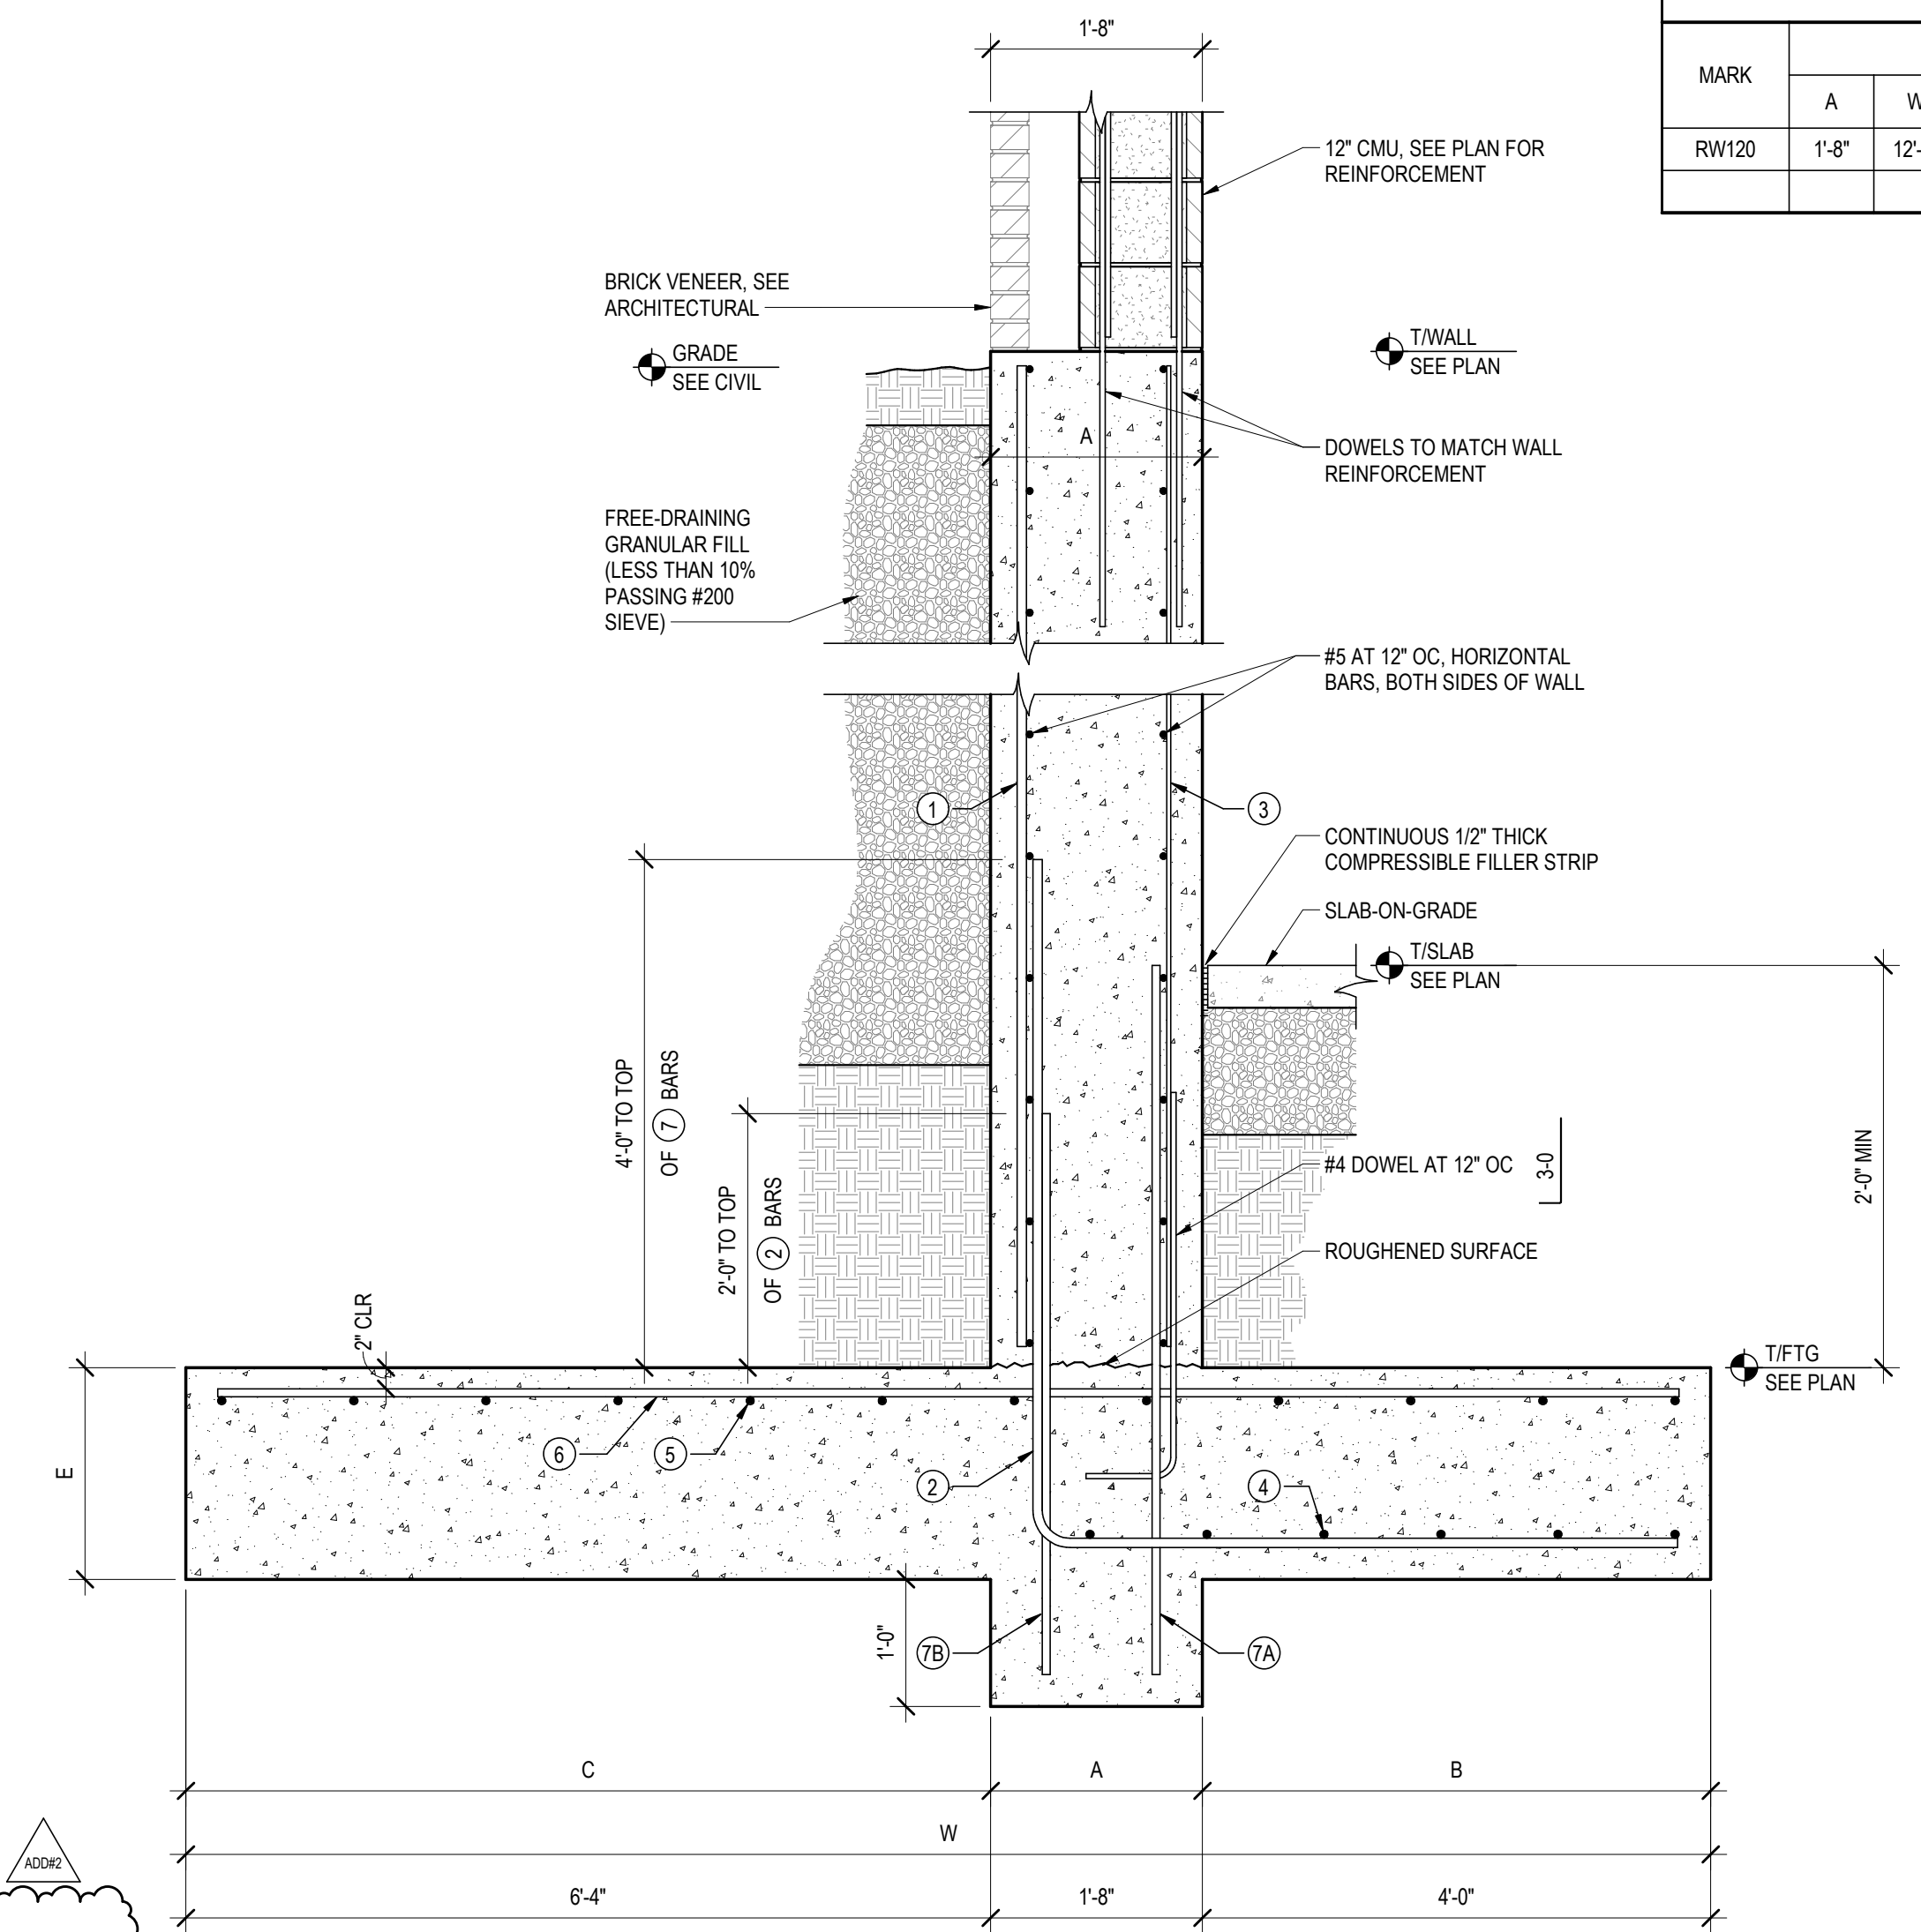


1 RETAINING WALL
SCALE: 3/4" = 1'-0"

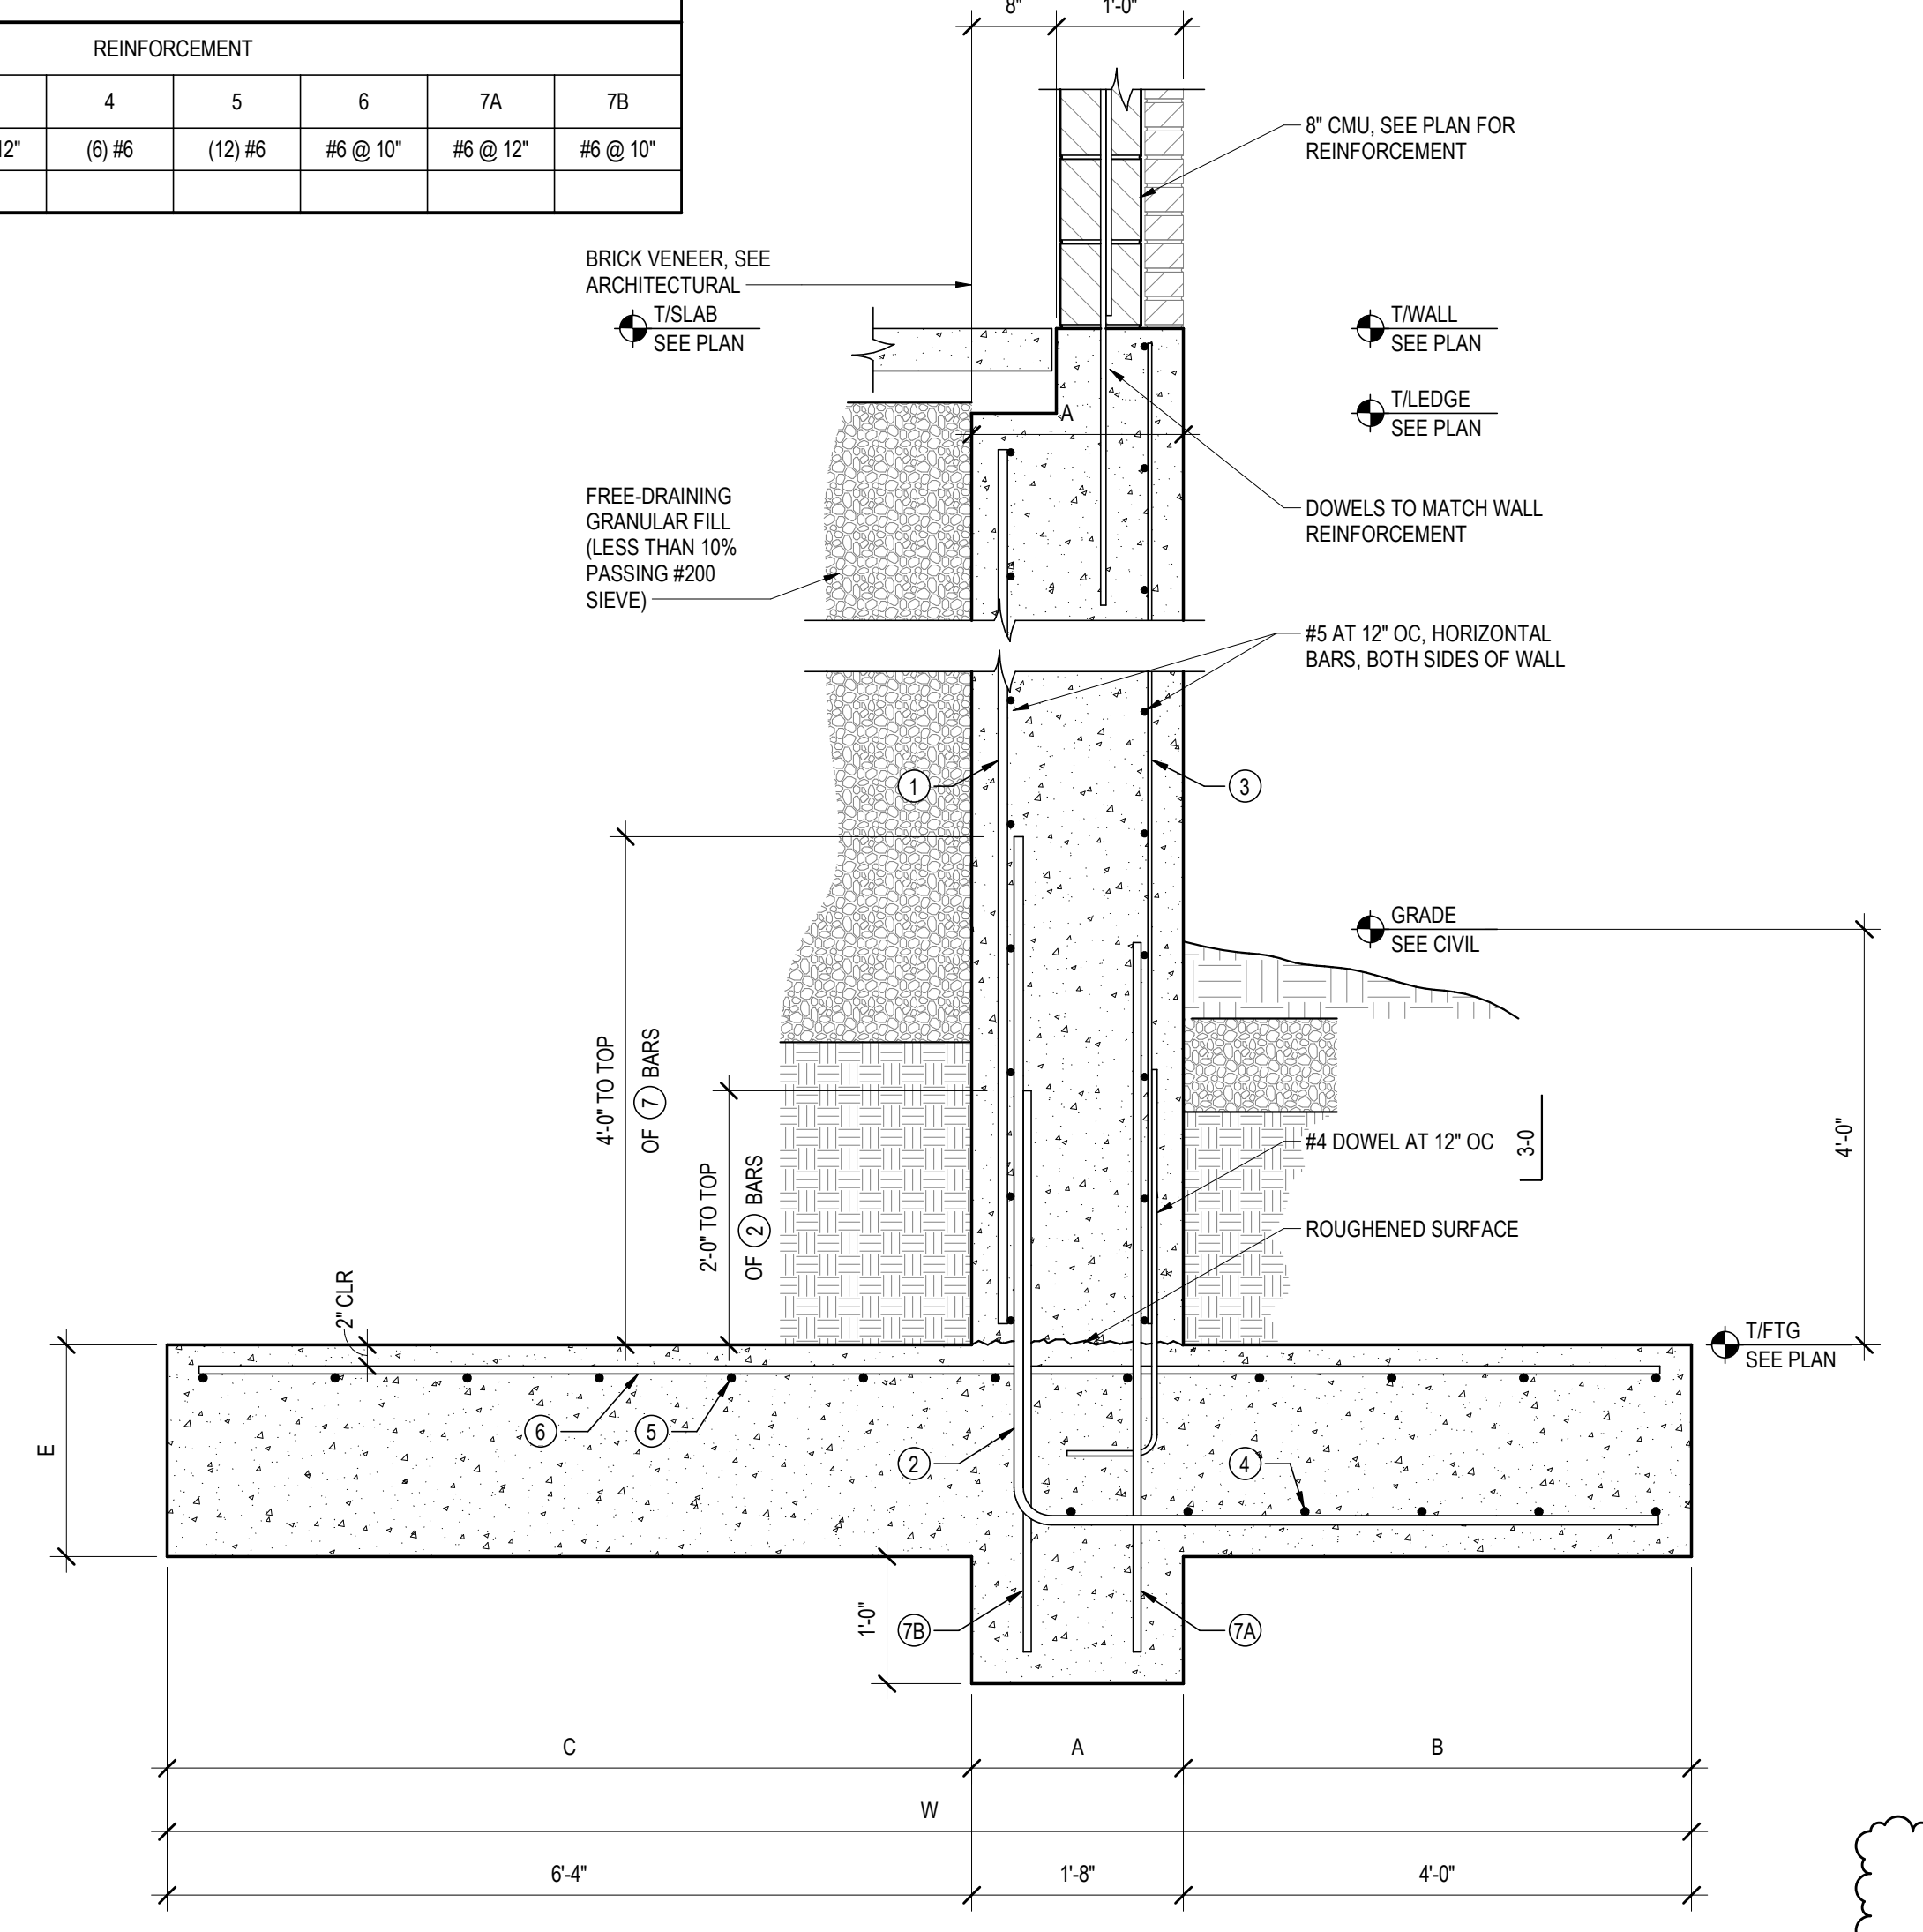


1A RETAINING WALL
SCALE: 3/4" = 1'-0"

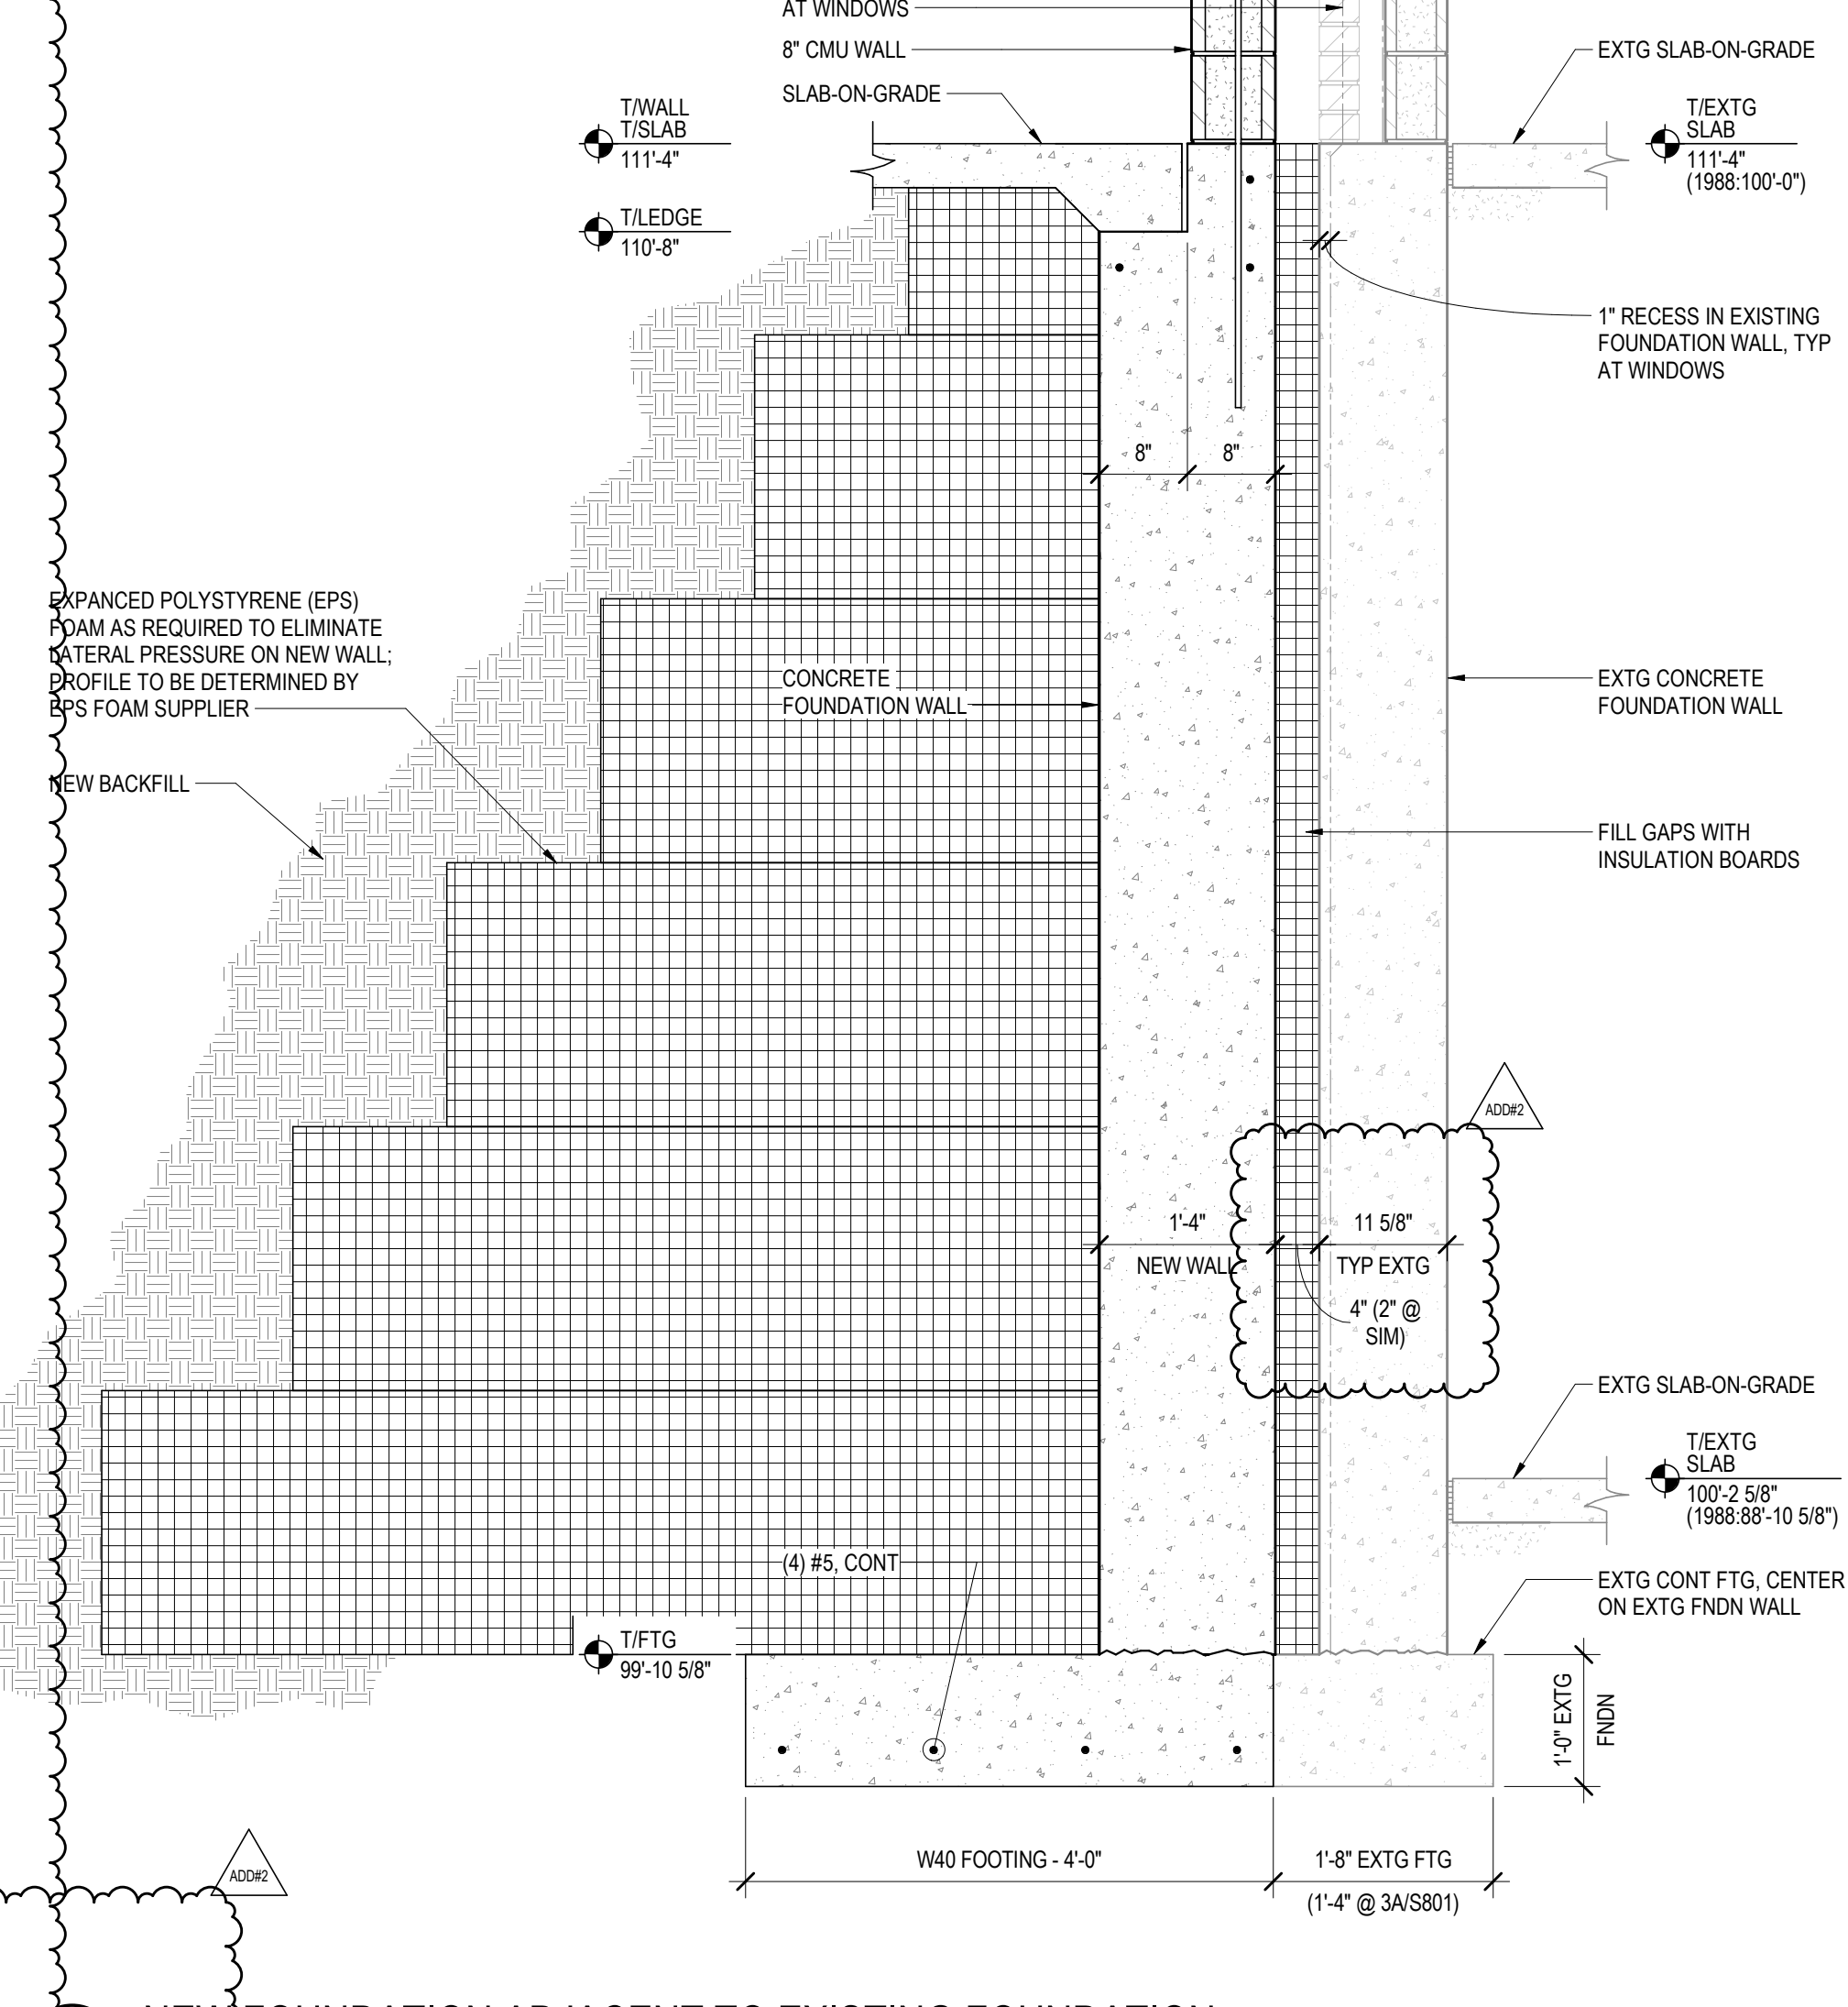


2 NEW FOUNDATION ADJACENT TO EXISTING FOUNDATION
SCALE: 3/4" = 1'-0"

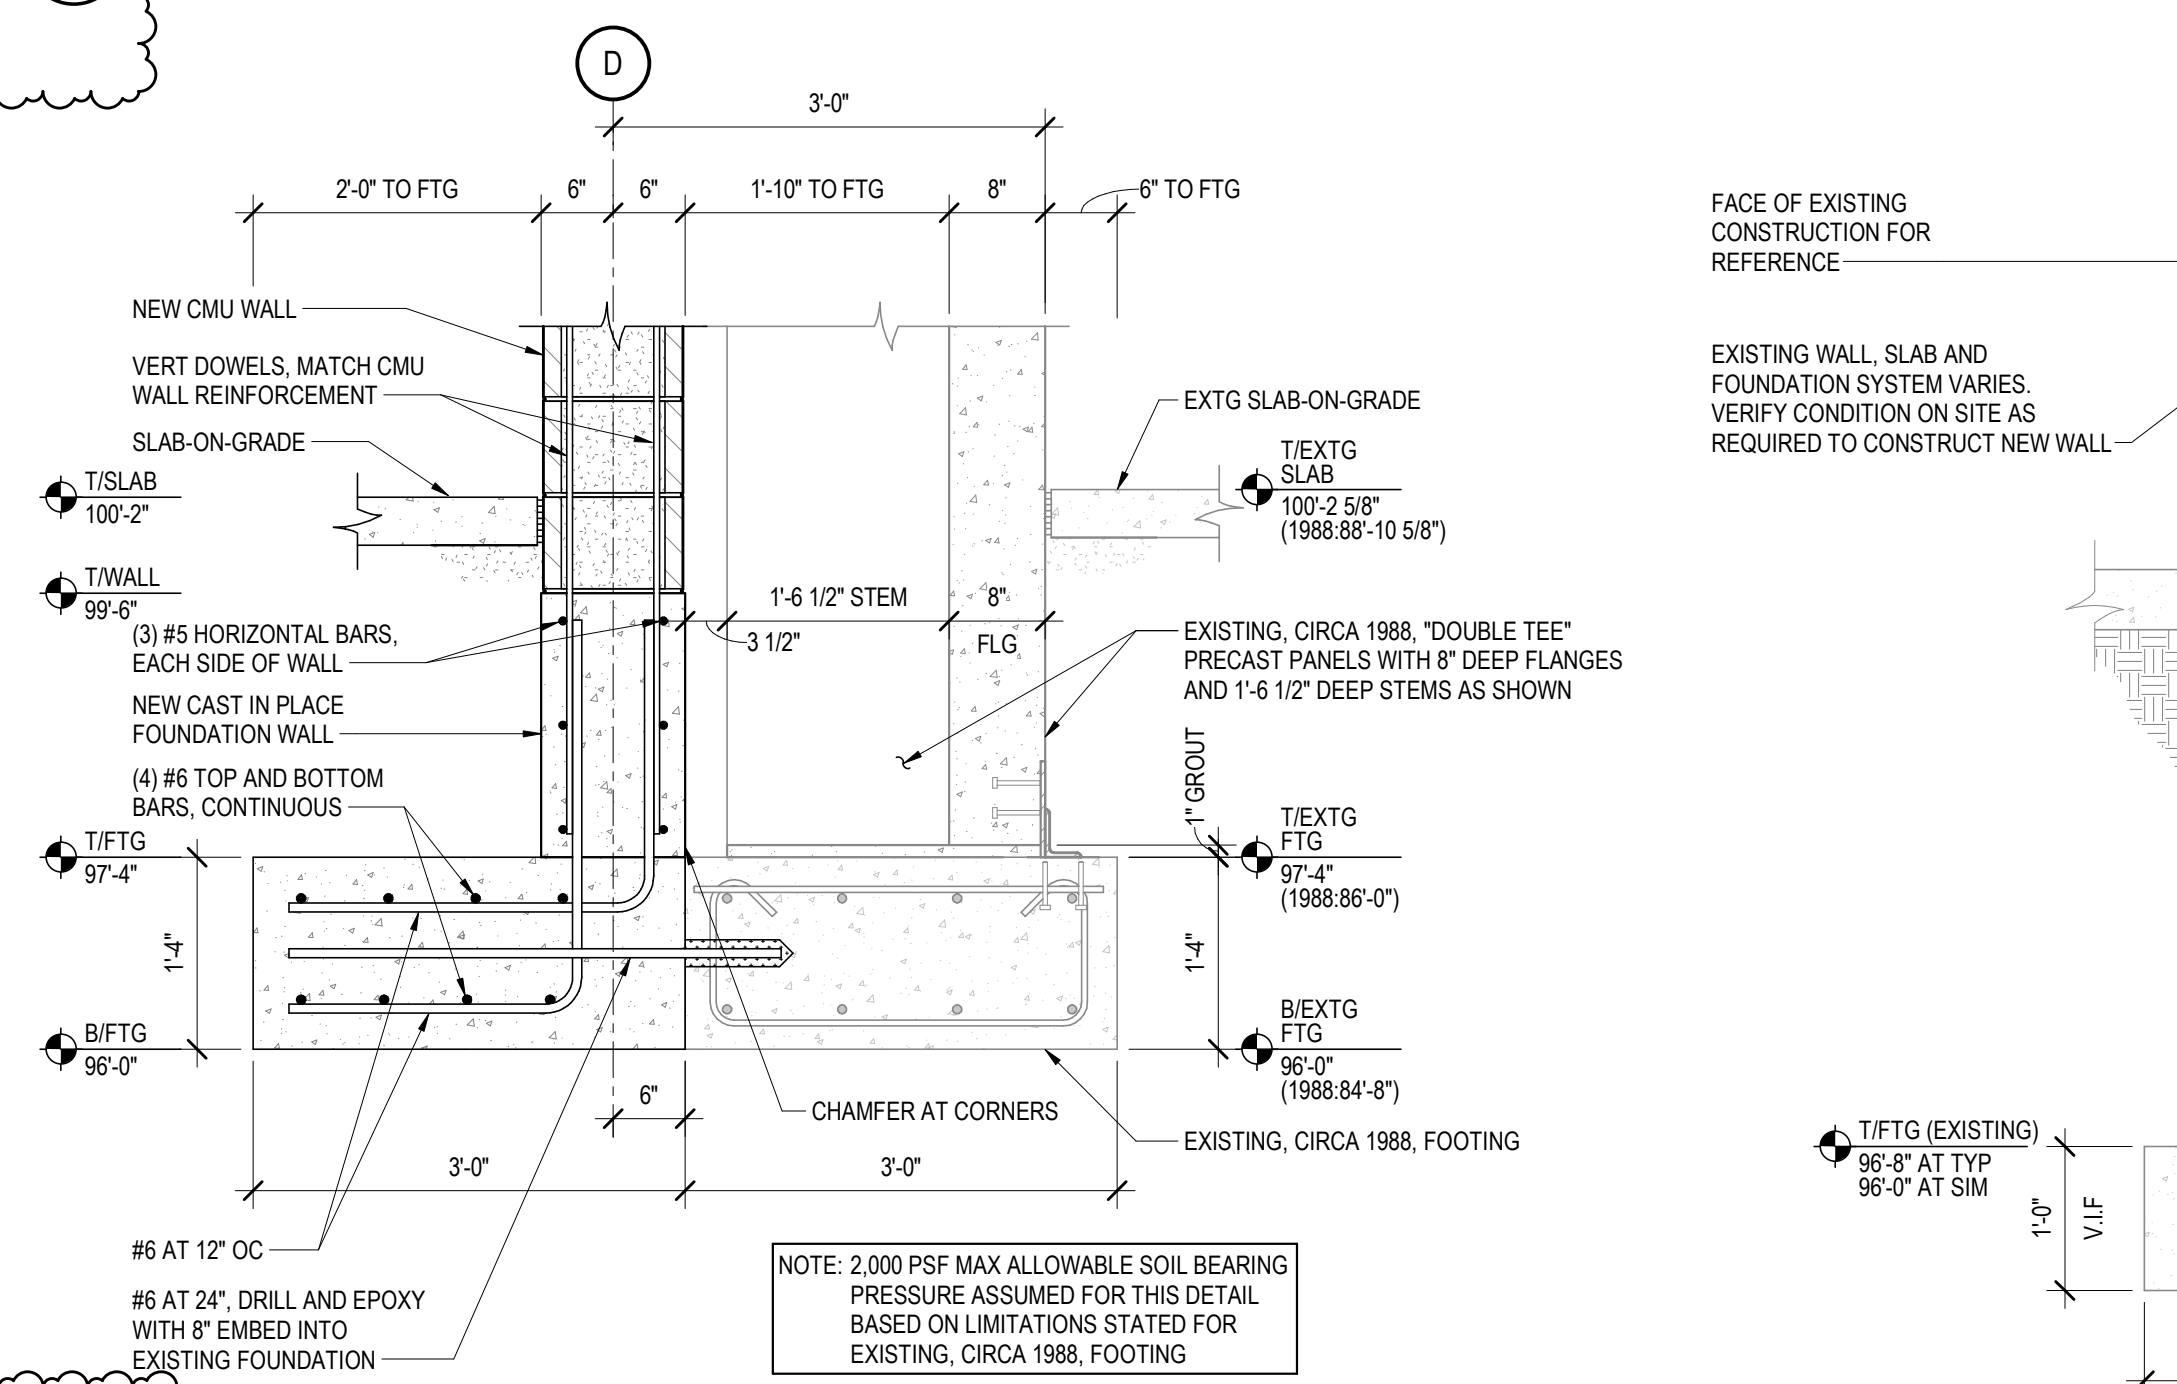

3 NEW TO EXISTING FOUNDATION WALL
SCALE: 3/4" = 1'-0"

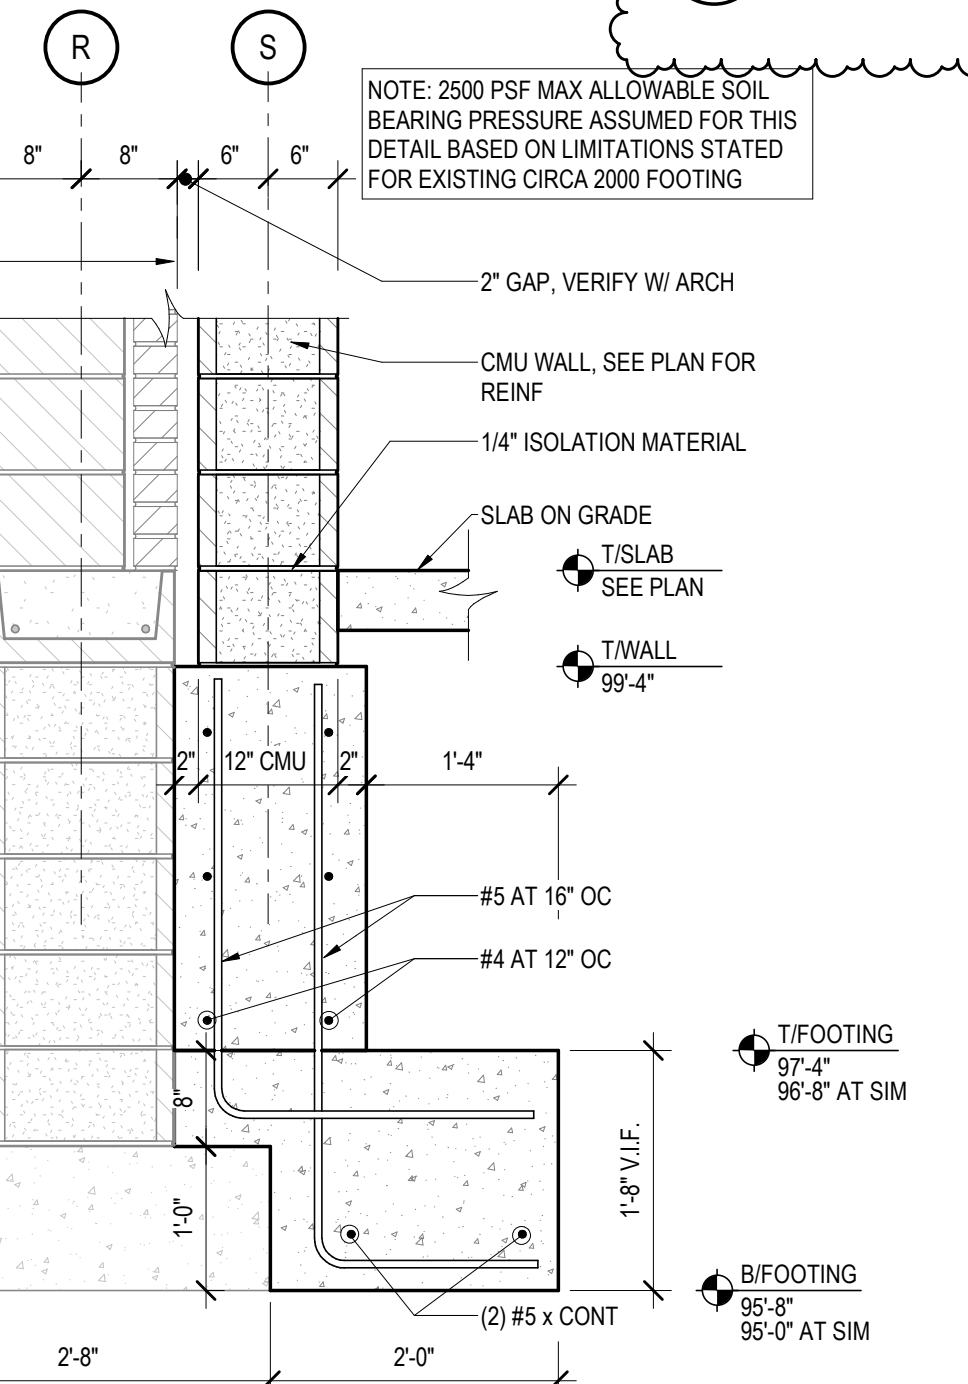


4 WALL SECTION @ EXISTING BLDG
SCALE: 3/4" = 1'-0"

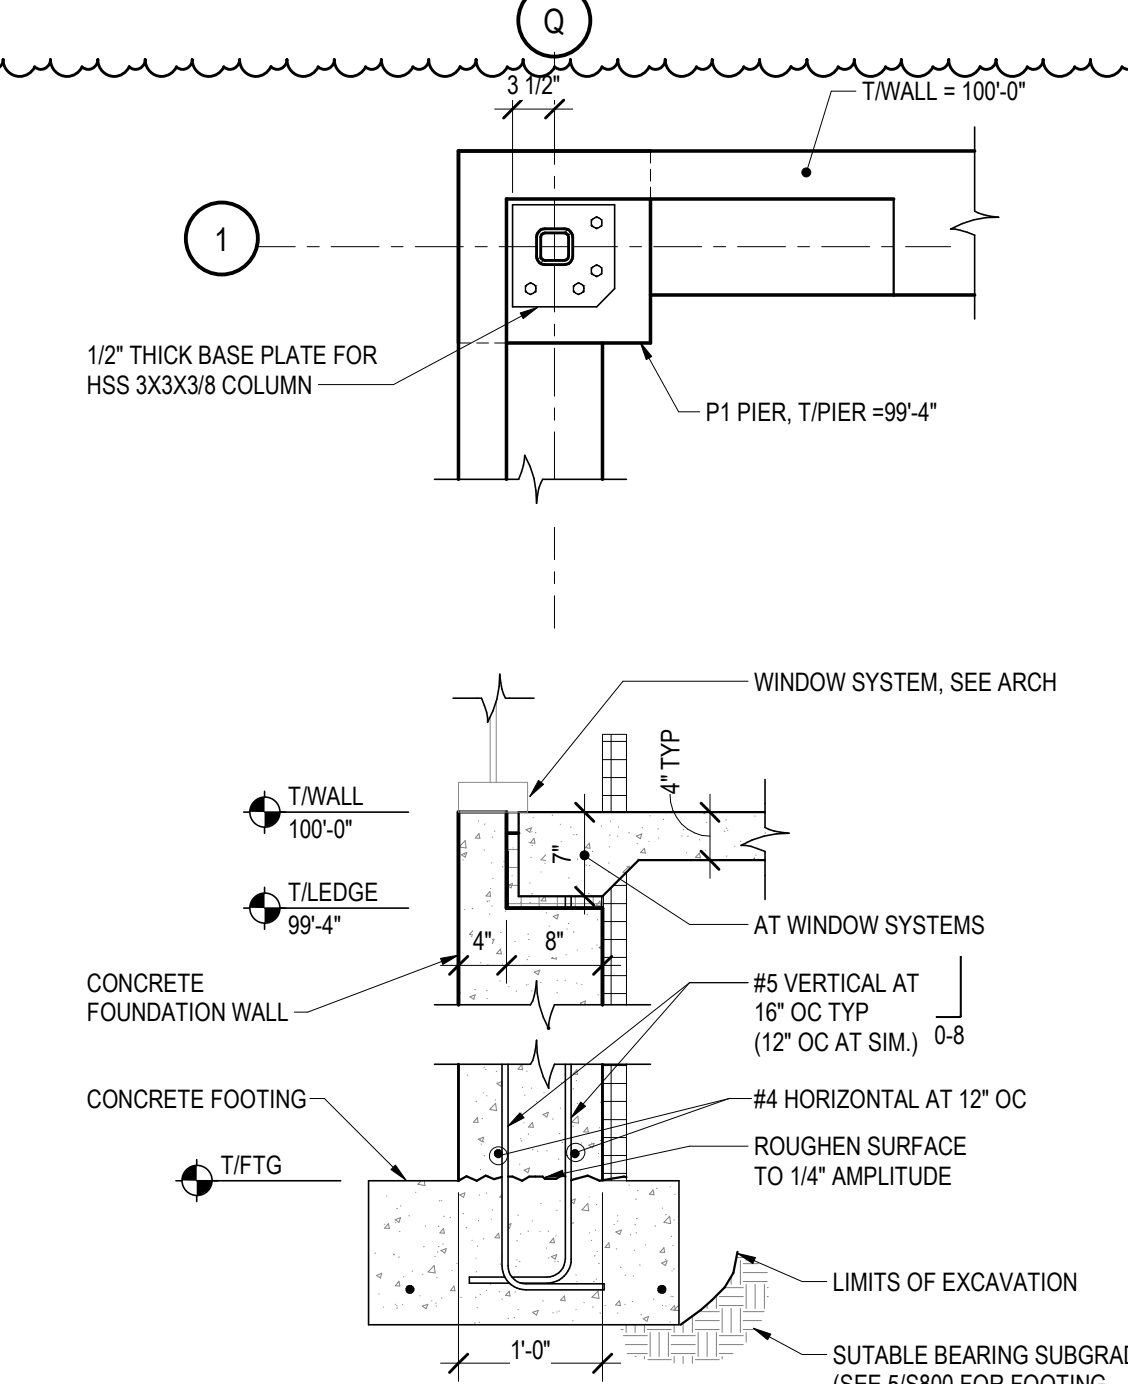


5 WALL SECTION
SCALE: 3/4" = 1'-0"




6 WALL SECTION @ EXISTING BLDG
SCALE: 3/4" = 1'-0"

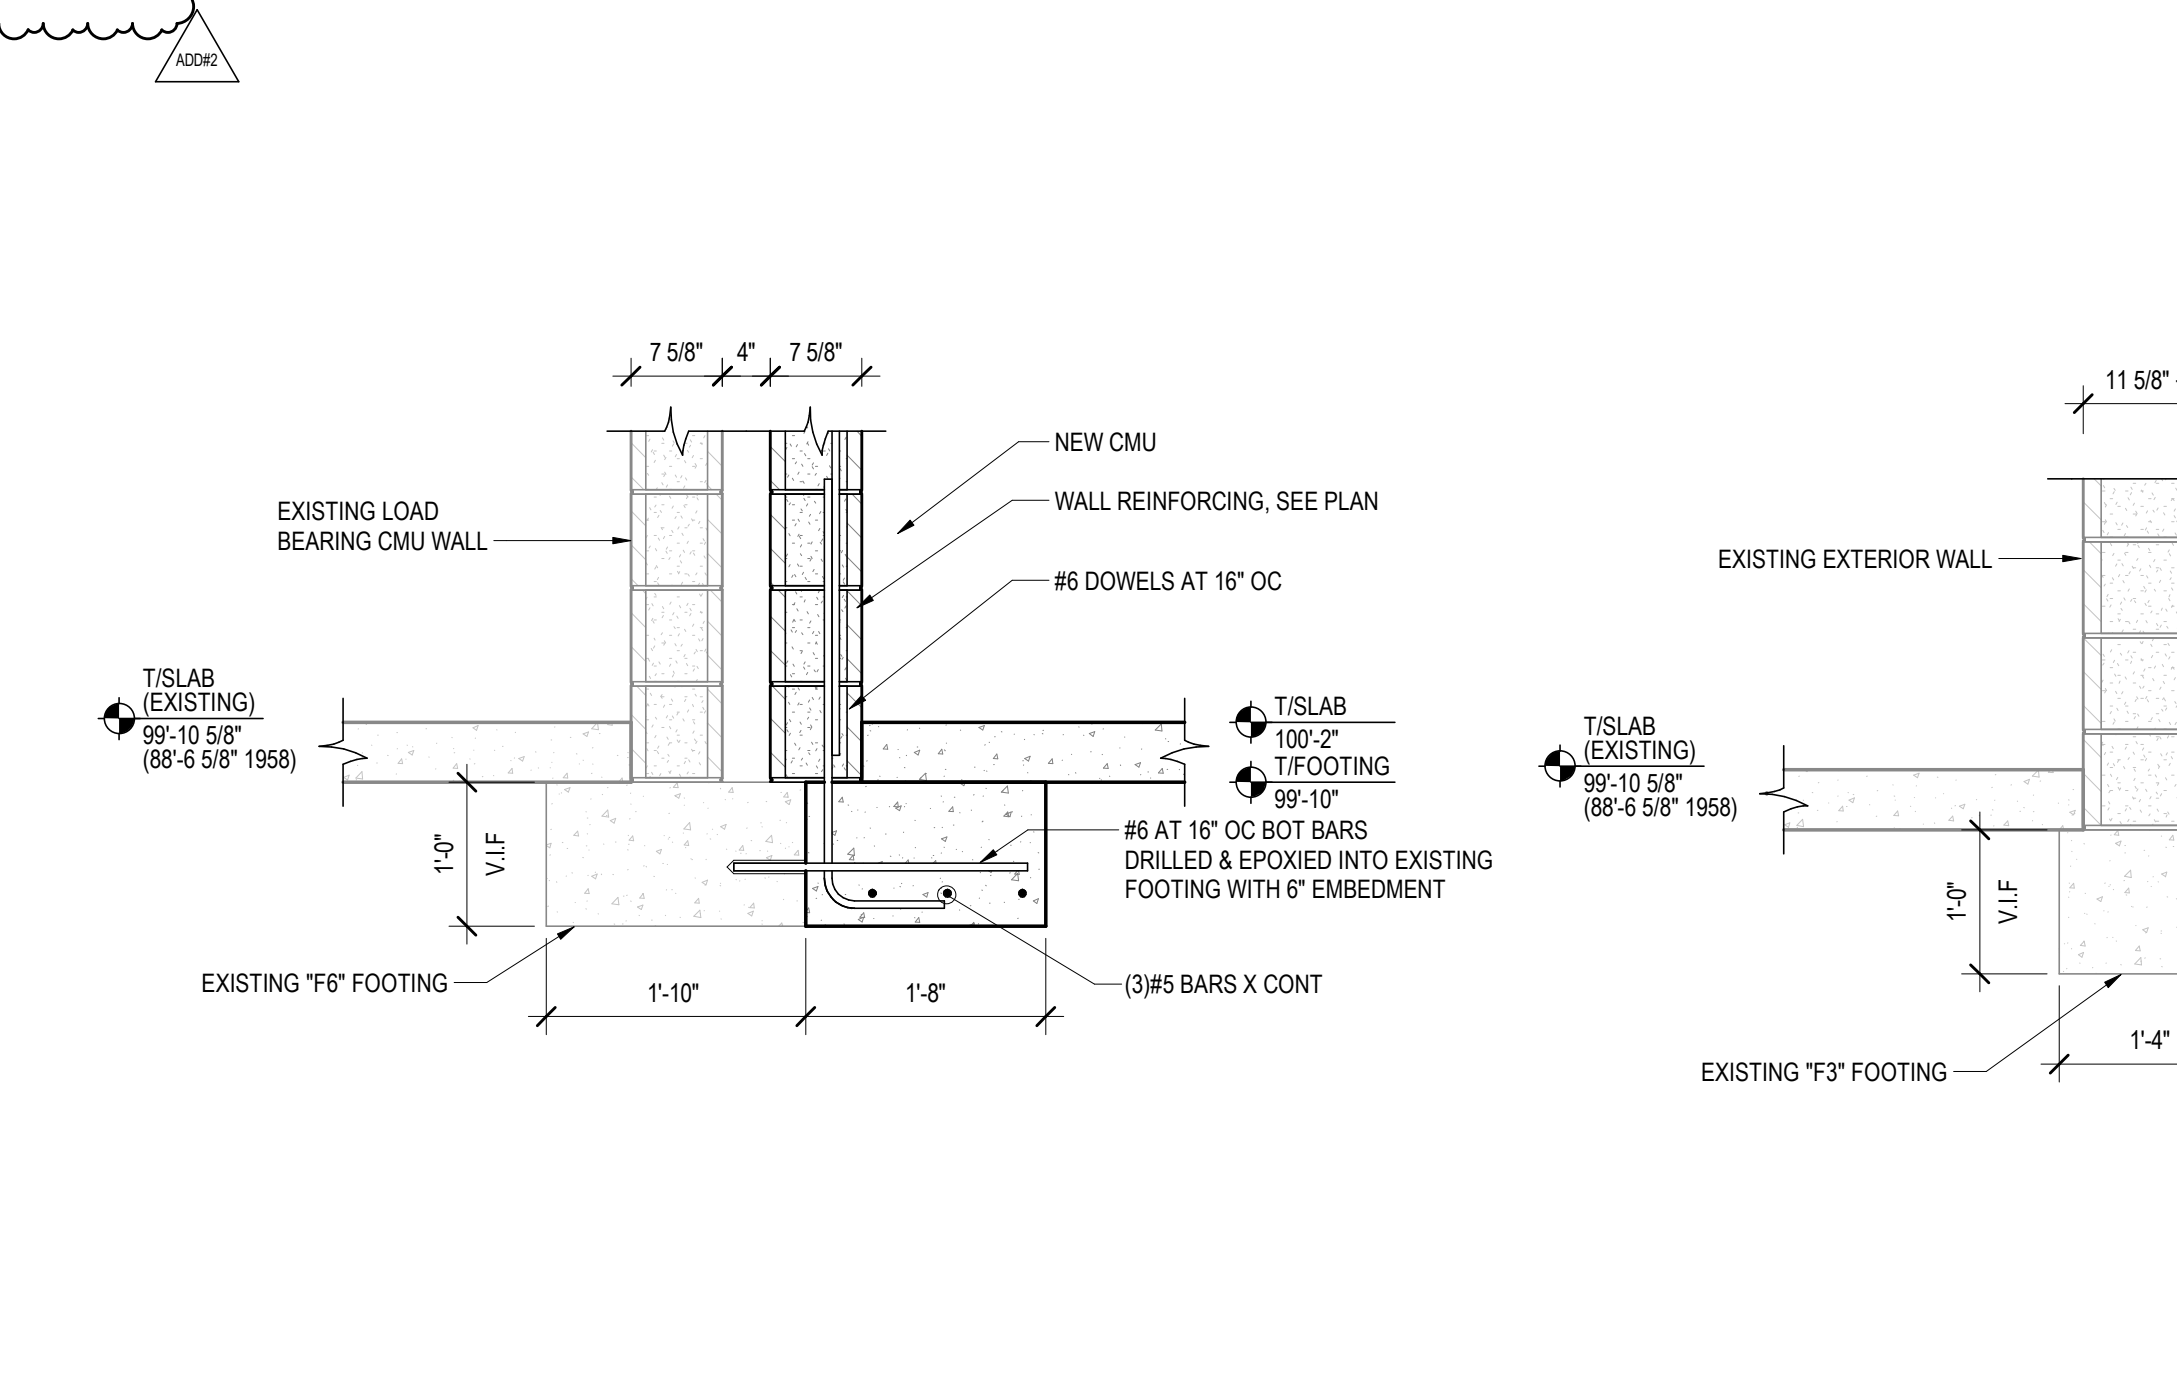


7 WALL SECTION @ EXISTING BLDG
SCALE: 3/4" = 1'-0"

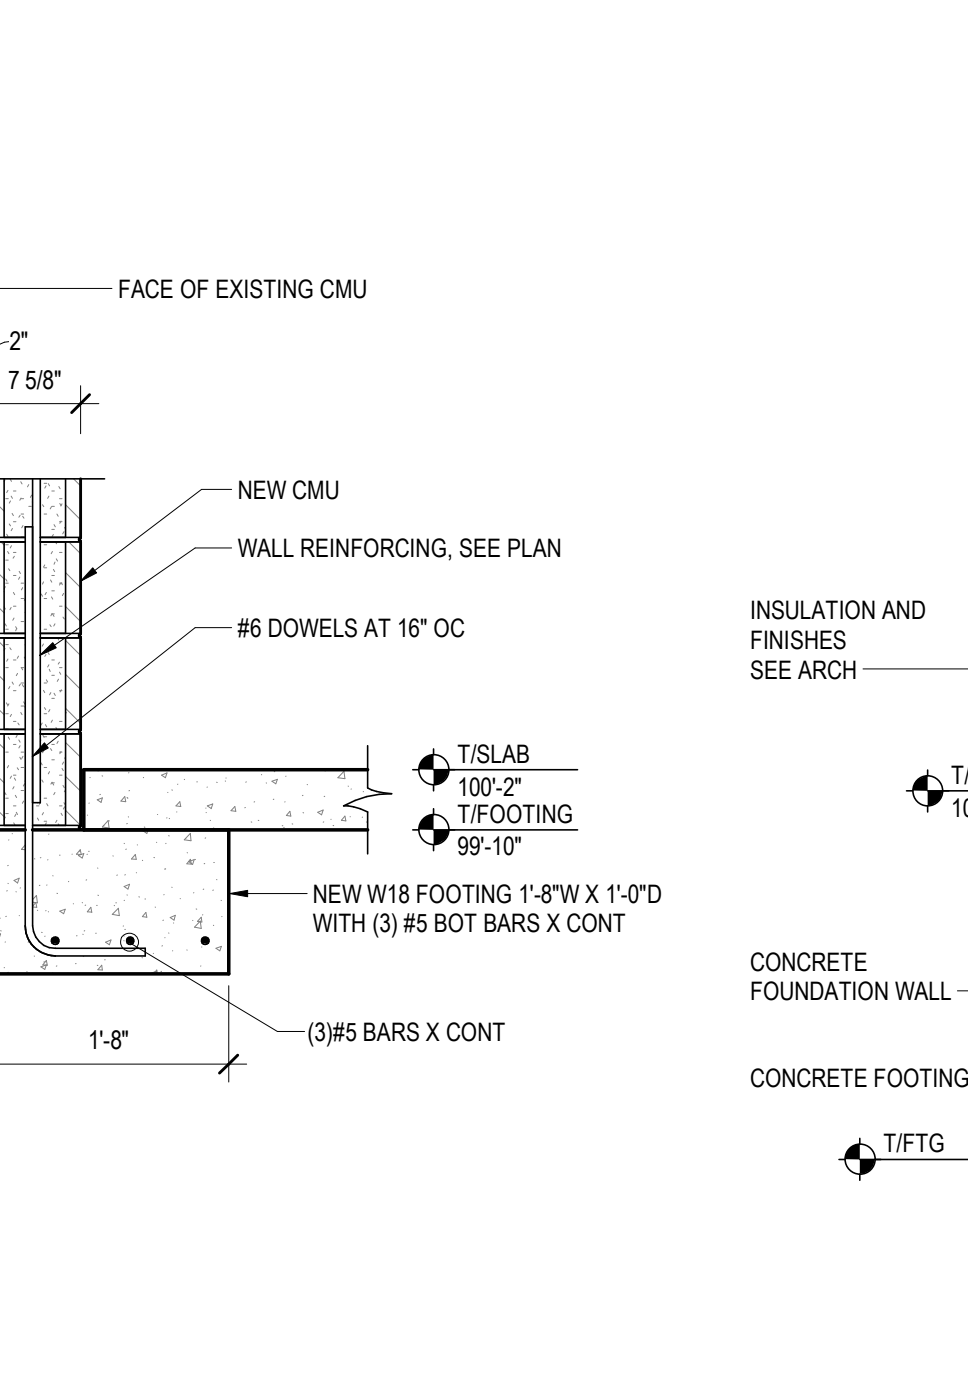

8 WALL SECTION
SCALE: 3/4" = 1'-0"

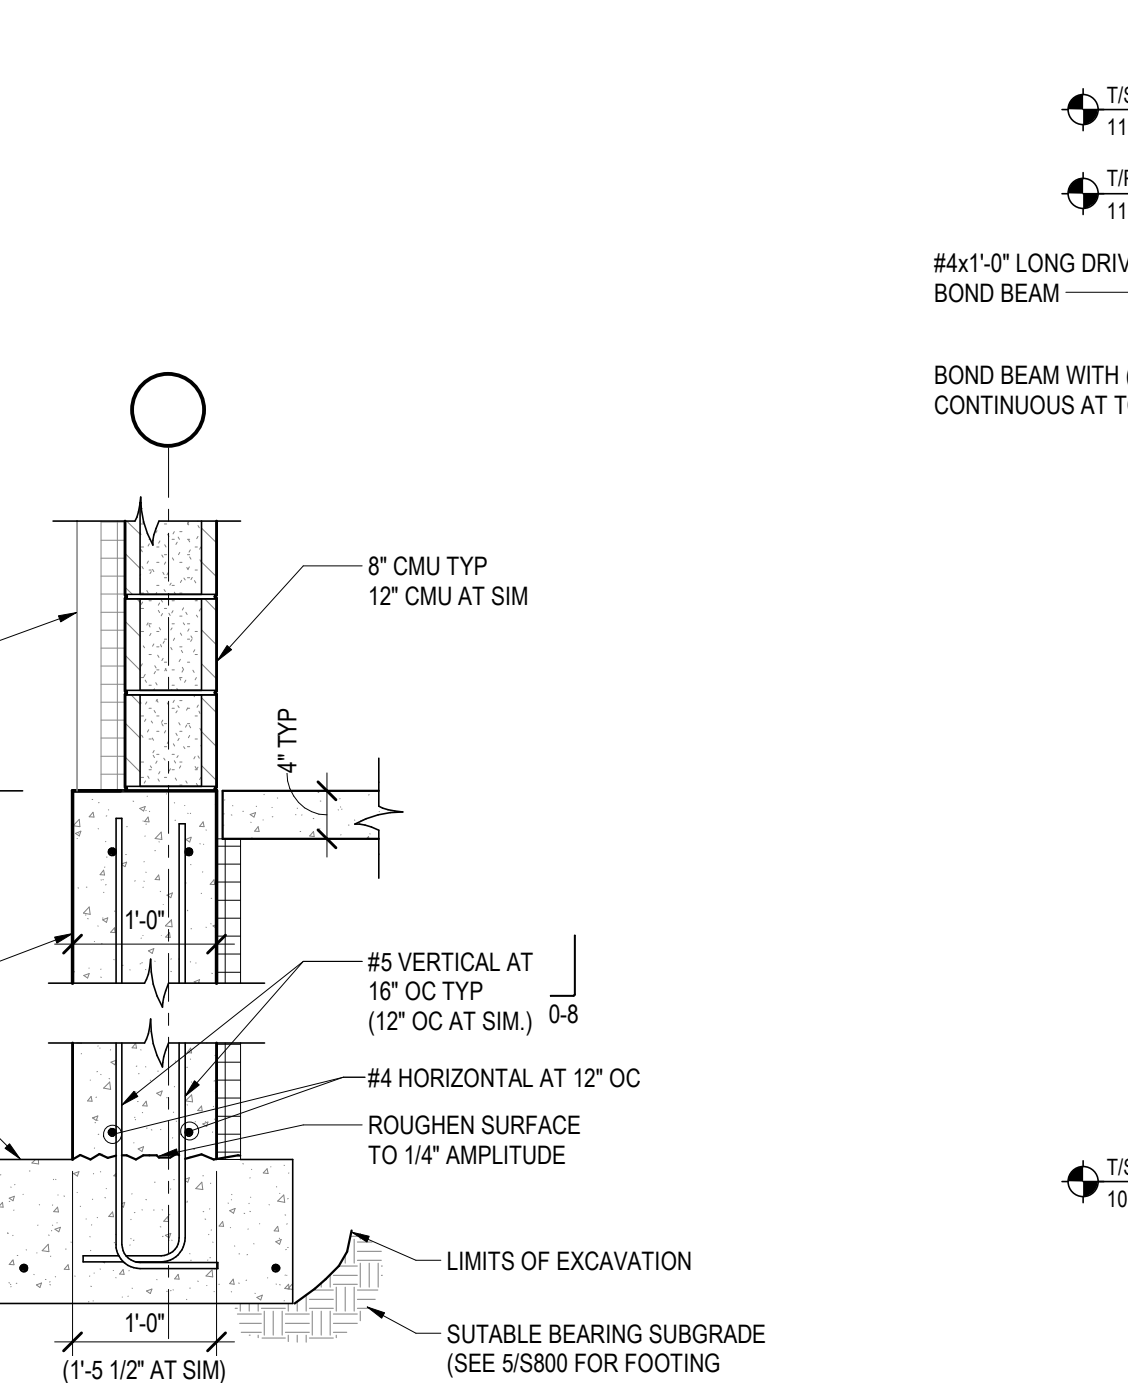

9 SECTION
SCALE: 1/2" = 1'-0"

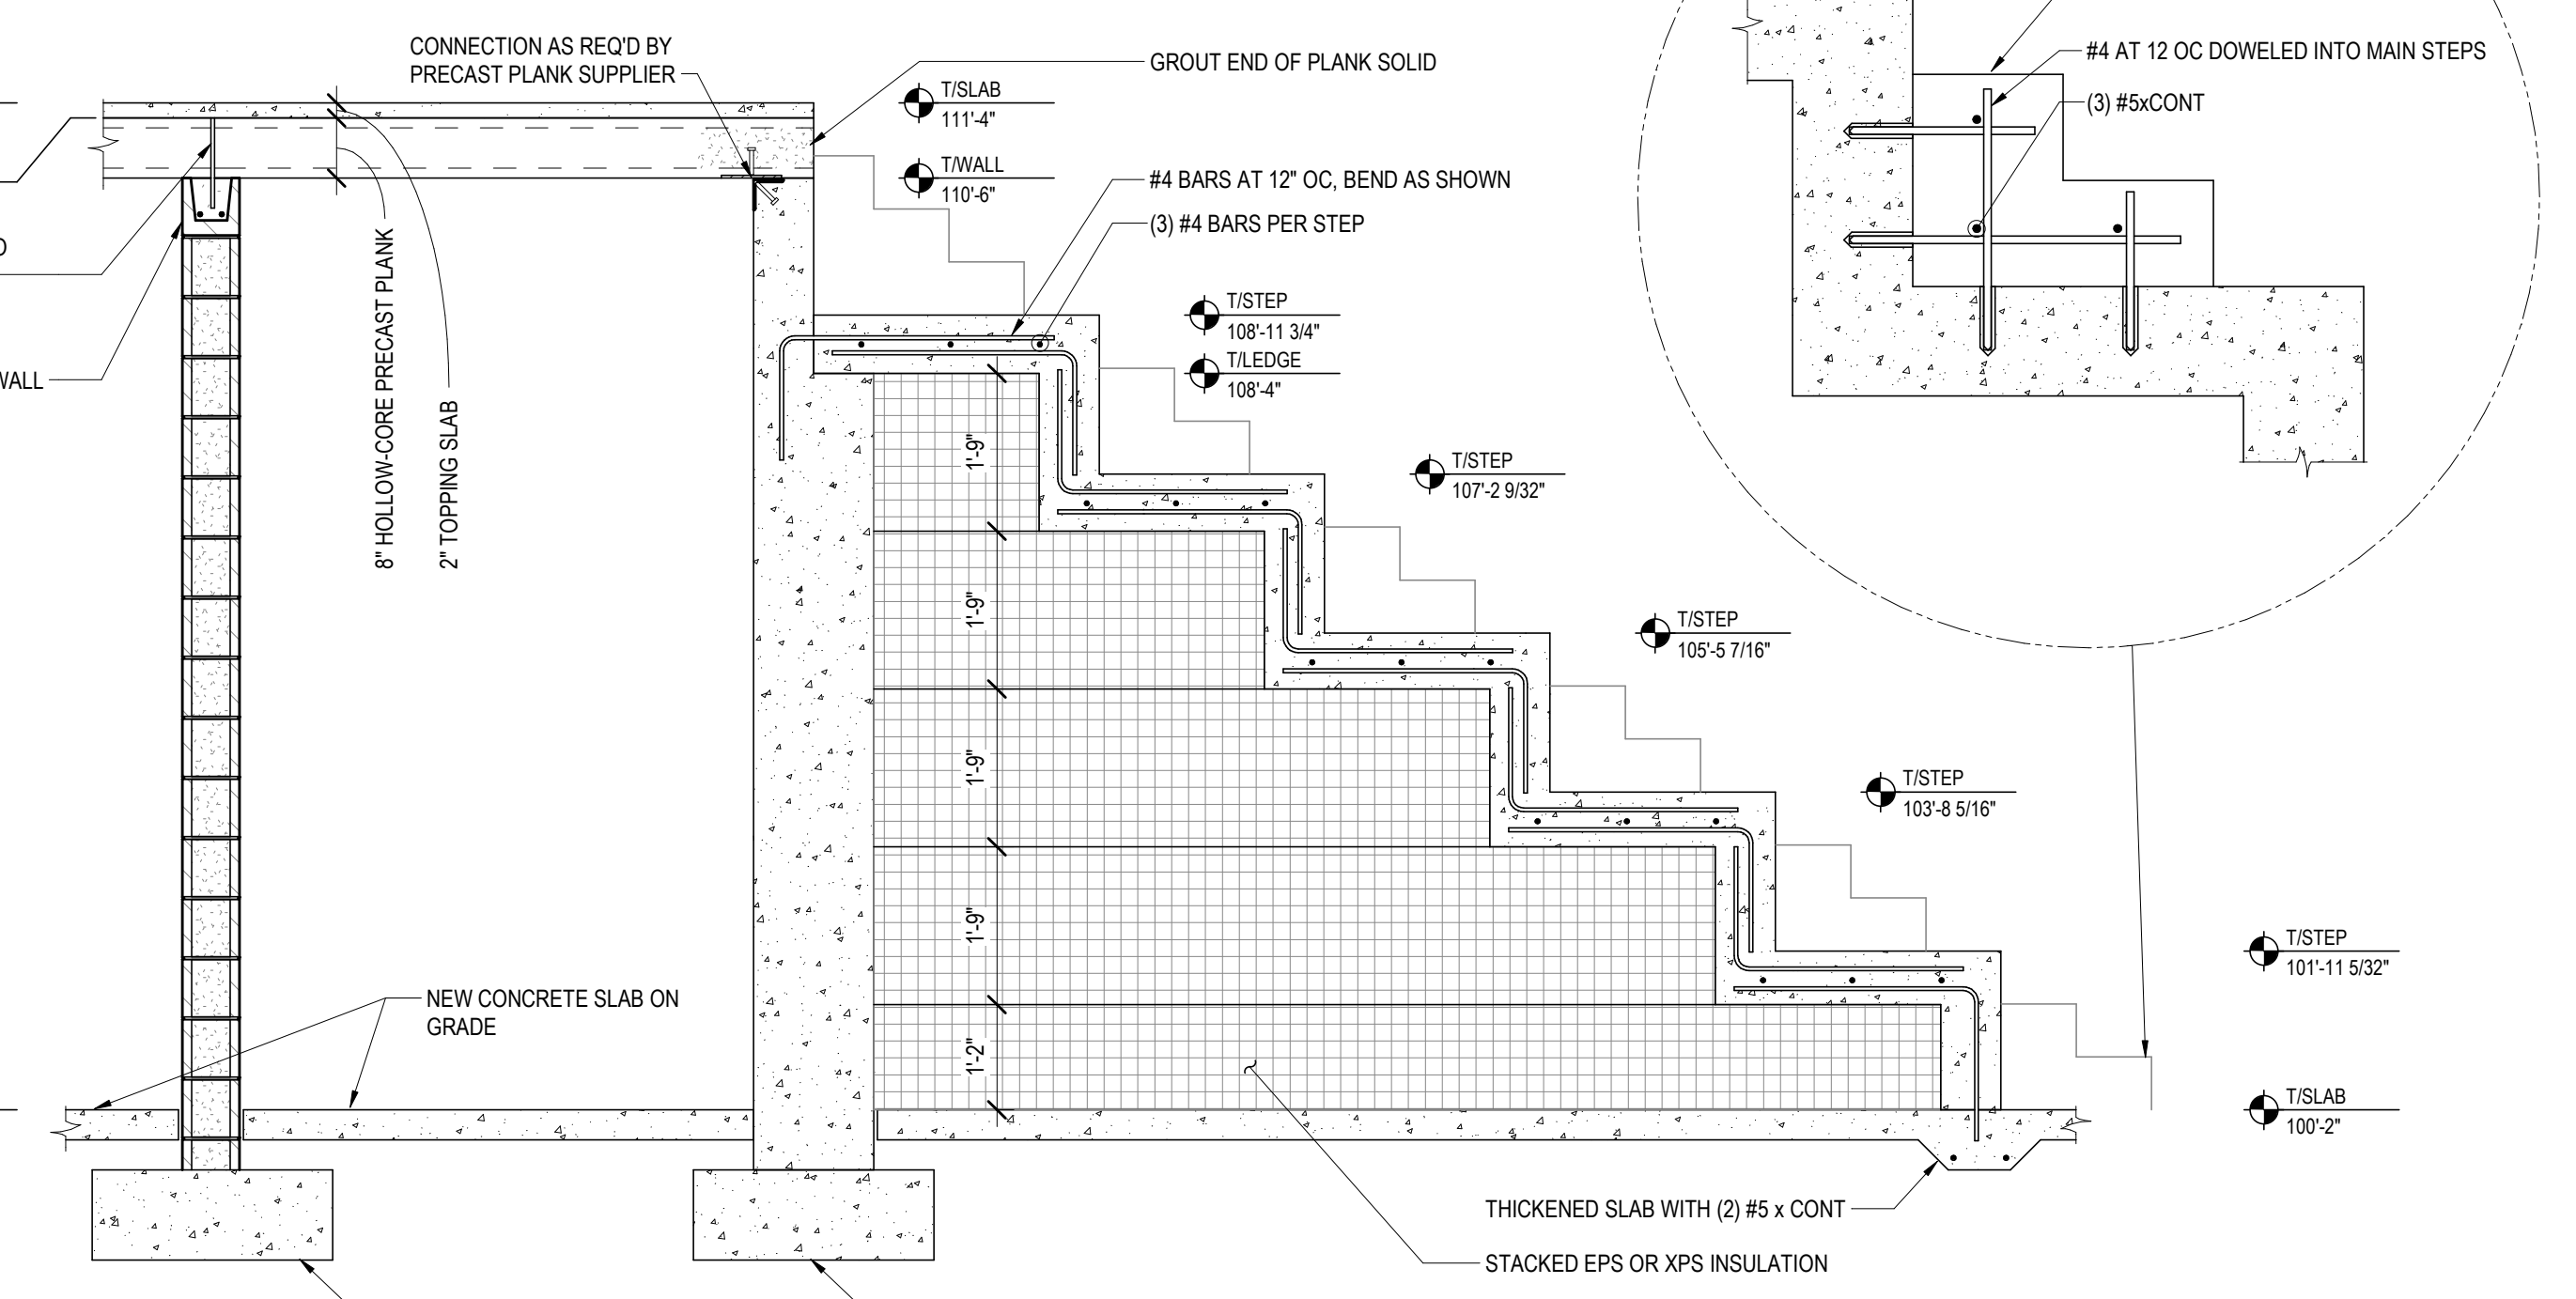

10 SECTION
SCALE: 1/2" = 1'-0"

LANESBORO PUBLIC SCHOOLS
ADDITION & REMODEL
Project Location: 100 KIRKWOOD ST E
LANESBORO, MN 55949

Project Title: HSR Project Number: 18063

Project Date: 7-25-2019

Drawn By: raSmith

Key Plan:

No.	Description	Date
ADD#2	ADDENDUM #2	8/19/2019

Graphic Scale: VARIES

Last Update: 8/20/2019 10:01:24 AM

S801