

DOCUMENT 00 90 00
ADDENDUM

ADDENDUM NO. [4] Date: August 22, 2019

RE: LANESBORO PUBLIC SCHOOLS
ADDITION AND REMODEL
100 KIRKWOOD ST EAST
LANESBORO, MN 55949
HSR 18063

FROM: HSR Associates, Inc
100 Milwaukee Street
La Crosse, WI 54603
(608) 784-1830

To: Prospective Bidders

This addendum forms a part of the Contract Documents and modifies the original Bidding Documents dated July 2019. Acknowledge receipt of this Addendum in the space provided on the bid form. Failure to do so may subject the Bidder to disqualification.

This Addendum consists of [2] pages, Revised Hardware Groups, and [4] 30 x 42 drawings.

CHANGES TO PRIOR ADDENDUM: Addendum 1

1. Delete Item 4. Replace with: **CONTRACTORS SHALL INCLUDE SALES TAX IN BID NUMBER.**
2. Sheet A601 DOOR SCHEDULE
 - a. SLAB REPLACEMENT DOOR SCHEDULE: Delete Door 172B and 189D. These doors are new doors in the Door Schedule.
 - b. Door 164A: This door material is hollow metal.
 - c. Door 161A: Change Hardware Group from "22" to "24".

Addendum 2

3. Sheet A104 UPPER LEVEL REMODELED FLOOR PLAN SEGMENT B 30 x 42 attached hereto
 - a. Revisions clouded on Drawing.
 - a. Door 152F location indicated.
4. Sheet ID101 OVERALL LOWER FLOOR FINISH PLAN 30 x 42 attached hereto
 - a. Revisions clouded on Drawing.
 - b. Clarification of floor material reference key to coincide with finish schedule.
5. Sheet ID107 UPPER LEVEL FINISH PLAN SEGMENT B 30 x 42 attached hereto
 - b. Revisions clouded on Drawing.
 - c. Toilet 201E was updated to have the correct keynote listed

CHANGES TO BIDDING REQUIREMENTS AND CONDITIONS OF THE CONTRACT:

6. See Item 1 above.

CHANGES TO SPECIFICATIONS:

7. Section 04 20 00 UNIT MASONRY
 - d. 2.01, B, 1: Change "4 x 4 x 8" to "4 x 8 x 16".
8. Section 08 71 00 DOOR HARDWARE
 - e. Revised hardware groups attached hereto. The following groups have been edited, with changes bolded, italicized and in red: 4, 7, 10, 12, 14, 15, 17, 18, 19, 20, 21, 22, 24, 25, 26, 27, 30, 31, 33, 34, 36, 38, 39, 41, 42 and 46.

CHANGES TO DRAWINGS

9. Sheet ID 104 LOWER LEVEL FINISH PLAN SEGMENT C 30 x 42 attached hereto
 - f. Revisions clouded on Drawing.
 - g. Clarification of floor material reference key to coincide with finish schedule.

PRIOR APPROVALS

1. Section 07 42 13.16 METAL PLATE WALL PANELS
 - a. CEI Materials; CLADLOK Panel System.
2. Section 32 32 23 SEGMENTED RETAINING WALLS
 - a. Versa-Lok

END OF DOCUMENT 00 90 00

3.04 HARDWARE SCHEDULE

DOOR HARDWARE SCHEDULE LANESBORO ADDITION & REMODEL

HARDWARE GROUP 1

EACH PAIR OF ALUM DOORS TO HAVE:
DR.100A/B

2 EA	CONTINUOUS HINGE	BY ALUM DR AND FRAME SUPPLIER	
1 EA	EXIT DEVICE	99NL-OP X 110MD US26D	VONDUPRIN
1 EA	EXIT DEVICE	99EO US26D	VONDUPRIN
1 EA	RIM CYLINDER	20-757 626	SCHLAGE
2 EA	OFFSET PULL	BF157 US32D	ROCKWOOD
2 EA	CLOSER	4040XP SCUSH 689	LCN
2 EA	DROP PLATE	4040XP-18 689	LCN
2 EA	CUSH SHOE SUPPORT	4040XP-30 689	LCN
2 EA	BLADE SPACER	4040XP-61 689	LCN
1 EA	ELECTRIC STRIKE	6300 US32D	VONDUPRIN
2 EA	THRESHOLD	S425A36	REESE
1 EA	RAIN DRIP	R201A120	REESE
2 EA	WEATHERSTRIP/SWEEP	BY ALUM DR AND FRAME SUPPLIER	
CARD READER ON ONE LEAF OF PAIR, READER, PWR SUPPLY AND DPS BY ACCESS CONTROL PROVIDER.			

HARDWARE GROUP 2

EACH SINGLE ALUM DOOR TO HAVE:
DR.100C

1 EA	CONTINUOUS HINGE	BY ALUM DR AND FRAME SUPPLIER	
1 EA	EXIT DEVICE	99EO US26D	VONDUPRIN
1 EA	OFFSET PULL	BF157 US32D	ROCKWOOD
1 EA	CLOSER	4040XP SCUSH 689	LCN
1 EA	DROP PLATE	4040XP-18 689	LCN
1 EA	CUSH SHOE SUPPORT	4040XP-30 689	LCN
1 EA	BLADE SPACER	4040XP-61 689	LCN
1 EA	THRESHOLD	S425A36	REESE
1 EA	WEATHERSTRIP/SWEEP	BY ALUM DR AND FRAME SUPPLIER	

HARDWARE GROUP 3

EACH PAIR OF ALUM DOORS TO HAVE:
DR.100D, 100E, 100F

1 EA	CONTINUOUS HINGE	BY ALUM DR AND FRAME SUPPLIER	
1 EA	PUSH/PULL COMBO	BF15747 US32D	ROCKWOOD
1 EA	CLOSER	4040XP SCUSH 689	LCN
1 EA	DROP PLATE	4040XP-18 689	LCN
1 EA	CUSH SHOE SUPPORT	4040XP-30 689	LCN
1 EA	BLADE SPACER	4040XP-61 689	LCN
1 EA	WEATHERSTRIP/SWEEP IF REQ	BY ALUM DR AND FRAME SUPPLIER	

HARDWARE GROUP 4

EACH SINGLE DOOR TO HAVE:

DR. 101, 102A, 107, 108A, 108B, 110, 112A, 112B, 172B, 173, 189A, 201A, 201G, 201H, 216

3 EA	BUTTS	FBB179 4.5 X 4.5 652	STANLEY
1 EA	ENTRANCE LOCK	ND53LD RHO 626	SCHLAGE
1 EA	CORE	PRIMUS 20-765	SCHLAGE
1 EA	KICKPLATE	10 X 2"LDW B4E CS US32D	ROCKWOOD
1 EA	WALL STOP	409 US32D	ROCKWOOD
1 EA	SOUND GASKET	F797B17	REESE

HARDWARE GROUP 5

EACH SINGLE DOOR TO HAVE:

DR. 103, 105, 109

3 EA	BUTTS	FBB179 4.5 X 4.5 652	STANLEY
1 EA	PASSAGE LOCK	ND10S RHO 626	SCHLAGE
1 EA	SURFACE OVERHEAD STOP	450S 652	GLYNN JOHN
1 EA	KICKPLATE	10 X 2"LDW B4E CS US32D	ROCKWOOD
3 EA	SILENCERS	608RKW GREY	ROCKWOOD

HARDWARE GROUP 6

EACH SINGLE DOOR TO HAVE:

DR. 104

3 EA	BUTTS	FBB179 4.5 X 4.5 652	STANLEY
1 EA	PASSAGE LOCK	ND10S RHO 626	SCHLAGE
1 EA	KICKPLATE	10 X 2"LDW B4E CS US32D	ROCKWOOD
1 EA	WALL STOP	409 US32D	ROCKWOOD
3 EA	SILENCERS	608RKW GREY	ROCKWOOD

HARDWARE GROUP 7

EACH PAIR OF WD DOORS TO HAVE:

DR.106A

6 EA	BUTTS	FBB168 4.5 X 4.5 652 NRP	STANLEY
1 EA	EXIT DEVICE	99NL-OP X 110MD US26D	VONDUPRIN
1 EA	EXIT DEVICE	99EO US26D	VONDUPRIN
1 EA	RIM CYLINDER	20-757 626	SCHLAGE
2 EA	OFFSET PULL	BF157 US32D	ROCKWOOD
2 EA	CLOSER	4040XP SHCUSH 689	LCN
1 EA	GASKET	F797B25	REESE
2 EA	KICKPLATE	10 X 2"LDW B4E CS US32D	ROCKWOOD
2 EA	ASTRAGAL FINIS	S771D7	PEMKO

HARDWARE GROUP 8

EACH SINGLE ALUM DR TO HAVE:
DR.106B

1 EA	CONTINUOUS HINGE	BY ALUM DR AND FRAME SUPPLIER	
1 EA	EXIT DEVICE	99NL-OP X 110MD US26D	VONDUPRIN
1 EA	RIM CYLINDER	20-757 626	SCHLAGE
1 EA	OFFSET PULL	BF157 US32D	ROCKWOOD
1 EA	CLOSER	4040XP SCUSH 689	LCN
1 EA	DROP PLATE	4040XP-18 689	LCN
1 EA	CUSH SHOE SUPPORT	4040XP-30 689	LCN
1 EA	BLADE SPACER	4040XP-61 689	LCN
1 EA	THRESHOLD	S425A36	REESE

HARDWARE GROUP 9

EACH SINGLE DOOR TO HAVE:
DR.111A, 111B

4 EA	HINGES	FBB168 4.5 X 4.5 652	STANLEY
1 EA	PUSH PLATE	70C US32D	ROCKWOOD
1 EA	PULL	110 X 70C US32D	ROCKWOOD
1 EA	CLOSER	4040XP REG 689	LCN
1 EA	KICKPLATE	10 X 2"LDW B4E CS US32D	ROCKWOOD
1 EA	WALL STOP	409 US32D	ROCKWOOD
3 EA	SILENCERS	608RKW GREY	ROCKWOOD

HARDWARE GROUP 10

EACH SINGLE DOOR TO HAVE:
DR. 113, 116, 118A, 166D, 203, 217

3 EA	BUTTS	FBB179 4.5 X 4.5 652	STANLEY
1 EA	STORERM LOCK	ND80LD RHO 626	SCHLAGE
1 EA	CORE	PRIMUS 20-765	SCHLAGE
1 EA	KICKPLATE	10 X 2"LDW B4E CS US32D	ROCKWOOD
1 EA	WALL STOP	409 US32D	ROCKWOOD
3 EA	SILENCERS	608RKW GREY	ROCKWOOD

HARDWARE GROUP 11

EACH SINGLE DOOR TO HAVE:
DR. 114, 115, 201E, 225A

3 EA	BUTTS	FBB179 4.5 X 4.5 652	STANLEY
1 EA	PRIVACY LOCK	ND40S RHO 626	SCHLAGE
1 EA	KICKPLATE	10 X 2"LDW B4E CS US32D	ROCKWOOD
1 EA	WALL STOP	409 US32D	ROCKWOOD
1 EA	GASKET	F797B17	REESE

HARDWARE GROUP 12

EACH PAIR OF DOORS TO HAVE:
DR.117

2 EA	CONTINUOUS HINGE	651HD UL 7' US32D	STANLEY
2 EA	EXIT DEVICE	99L-F X 996L-R US26D	VONDUPRIN
2 EA	RIM CYLINDER	20-757 626	SCHLAGE
2 EA	CLOSER	4040XP SCUSH 689	LCN
2 EA	KICKPLATE	10 X 1"LDW B4E CS US32D	ROCKWOOD
1 EA	GASKETS	F797B25	REESE
2 EA	ASTRAGAL FINIS	S771D7	PEMKO

HARDWARE GROUP 13

EACH PAIR OF ALUM DOORS TO HAVE:
DR.117A, 152A

2 EA	CONTINUOUS HINGE	BY ALUM DR AND FRAME SUPPLIER	
1 EA	EXIT DEVICE	99NL-OP X 110MD US26D	VONDUPRIN
1 EA	EXIT DEVICE	99EO US26D	VONDUPRIN
1 EA	RIM CYLINDER	20-757 626	SCHLAGE
2 EA	OFFSET PULL	BF157 US32D	ROCKWOOD
2 EA	CLOSER	4040XP SCUSH 689	LCN
2 EA	DROP PLATE	4040XP-18 689	LCN
2 EA	CUSH SHOE SUPPORT	4040XP-30 689	LCN
2 EA	BLADE SPACER	4040XP-61 689	LCN
2 EA	THRESHOLD	S425A48	REESE
1 EA	RAIN DRIP	R201A96	REESE
2 EA	WEATHERSTRIP/SWEEP	BY ALUM DR AND FRAME SUPPLIER	

HARDWARE GROUP 14

EACH PAIR OF DOORS TO HAVE:
DR.118B, 118G, 161B

2 EA	CONTINUOUS HINGE	651HD UL 7' US32D	STANLEY
2 EA	EXIT DEVICE	99L X 996L-RUS26D	VONDUPRIN
1 EA	KEYED REMOVABLE MULL	KR4954 SP28	VONDUPRIN
2 EA	RIM CYLINDER	20-757 626	SCHLAGE
1 EA	MORT CYL (KEYED MULL)	20-771 626	SCHLAGE
2 EA	CLOSER	4040XP SHCUSH 689	LCN
2 EA	GASKETS	F797B17	REESE

HARDWARE GROUP 15

EACH PAIR OF ALUM DOORS TO HAVE:
DR.118H

2 EA	CONTINUOUS HINGE	BY ALUM DR AND FRAME SUPPLIER	
1 EA	EXIT DEVICE	99NL-OP X 110MD US26D	VONDUPRIN
1 EA	EXIT DEVICE	99EO US26D	VONDUPRIN
1 EA	KEYED REMOVABLE MULL	KR4954 SP28	VONDUPRIN
2 EA	RIM CYLINDER	20-757 626	SCHLAGE
1 EA	MORT CYL (KEYED MULL)	20-771 626	SCHLAGE
2 EA	OFFSET PULL	BF157 US32D	ROCKWOOD
2 EA	CLOSER	4040XP SHCUSH 689	LCN
2 EA	DROP PLATE	4040XP-18 689	LCN
2 EA	CUSH SHOE SUPPORT	4040XP-30 689	LCN
2 EA	BLADE SPACER	4040XP-61 689	LCN
2 EA	THRESHOLD	S425A84	REESE
1 EA	RAIN DRIP	R201A96	REESE
2 EA	WEATHERSTRIP/SWEEP	BY ALUM DR AND FRAME SUPPLIER	

HARDWARE GROUP 16

EACH SINGLE DOOR TO HAVE:
DR. 127A

3 EA	BUTTS	FFB179 4.5 X 4.5 652	STANLEY
1 EA	PRIVACY LOCK	ND40S RHO 626	SCHLAGE
1 EA	SURFACE OHS	450S 652	GLYNN JOHN
1 EA	KICKPLATE	10 X 2"LDW B4E CS US32D	ROCKWOOD
1 EA	GASKET	F797B17	REESE

HARDWARE GROUP 17

EACH PAIR OF DOORS TO HAVE:
DR.140A, **152F**

2 EA	CONTINUOUS HINGE	651HD UL 7' US32D	STANLEY
2 EA	EXIT DEVICE	9927EO-F LBR 4' 313	VONDUPRIN
2 EA	CLOSER	4040XP EDA 695	LCN
2 EA	MAG HOLD OPENS	SEM7850 689	LCN
2 EA	KICKPLATE	10 X 1"LDW B4E CS US10B	ROCKWOOD
2 EA	WALL STOPS	409 US10B	ROCKWOOD
1 EA	GASKETS	F797B25	REESE
2 EA	ASTRAGAL FINIS	S771D7	PEMKO

HARDWARE GROUP 18

EACH PAIR OF HM DOORS TO HAVE:
DR.152B

2 EA CONTINUOUS HINGE
1 EA EXIT DEVICE
1 EA EXIT DEVICE
1 EA RIM CYLINDER
2 EA OFFSET PULL
2 EA CLOSER
2 EA THRESHOLD
2 EA WEATHERSTRIP
2 EA SWEEPS
1 EA RAIN DRIP

651HD UL 7' US32D
99NL-OP X 110MD 313
99EO 313
20-757 313
BF157 US10B
4040XP SCUSH 695
S425A48
815D4884
323D48
R201D84

STANLEY
VONDUPRIN
VONDUPRIN
SCHLAGE
ROCKWOOD
LCN
REESE
REESE
REESE
REESE

HARDWARE GROUP 19

EACH SINGLE DOOR TO HAVE:
DR. 152E

3 EA BUTTS
1 EA STORERM LOCK
1 EA CORE
1 EA CLOSER
1 EA KICKPLATE
1 EA WALL STOP
1 EA GASKET

FBB179 4.5 X 4.5 652
ND80LD RHO 626
PRIMUS 20-740
4040XP REG 689
10 X 2"LDW B4E CS US32D
409 US32D
F797B17

STANLEY
SCHLAGE
SCHLAGE
LCN
ROCKWOOD
ROCKWOOD
REESE

HARDWARE GROUP 20

EACH PAIR OF DOORS TO HAVE:
DR.152C

2 EA CONTINUOUS HINGE
2 EA EXIT DEVICE
1 EA KEYED REMOVABLE MULL
2 EA RIM CYLINDER
1 EA MORT CYL (KEYED MULL)
2 EA CLOSER
1 EA CONCEALED OHS
1 EA KICKPLATE
1 EA WALL STOP
2 EA GASKETS

651HD UL 7' US32D
99L-F X 996L-R 313 X 499F Strike
KR9954 SP313
20-757 613
20-771 613
4040XP REG 695
100S US10B
10 X 2"LDW B4E CS US10B
409 US10B
F797B17

STANLEY
VONDUPRIN
VONDUPRIN
SCHLAGE
SCHLAGE
LCN
GLYNN JOHN
ROCKWOOD
ROCKWOOD
REESE

HARDWARE GROUP 21

EACH PAIR OF DOORS TO HAVE:
DR.152D

2 EA CONTINUOUS HINGE
2 EA EXIT DEVICE
2 EA RIM CYLINDER
2 EA CLOSER
2 EA CONCEALED OHS
2 EA KICKPLATE
GASKETS

651HD UL 7' US32D
99L-F X 996L-R 313
20-757 613
4040XP REG 695
100S US10B
10 X 2"LDW B4E CS US10B
F797B17

STANLEY
VONDUPRIN
SCHLAGE
LCN
GLYNN JOHN
ROCKWOOD 2 EA
REESE

HARDWARE GROUP 22

EACH SINGLE DOOR TO HAVE:
DR. 157A, 157F

3 EA	BUTTS	FBB168 4.5 X 4.5 652	STANLEY
1 EA	ENTRANCE LOCK	ND53LD RHO 626	SCHLAGE
1 EA	CORE	PRIMUS 20-765	SCHLAGE
1 EA	CLOSER	4040XP REG 689	LCN
1 EA	KICKPLATE	10 X 2"LDW B4E CS US32D	ROCKWOOD
1 EA	WALL STOP	409 US32D	ROCKWOOD
1 EA	SMOKE GASKET	F797B17	REESE

HARDWARE GROUP 23

EACH SINGLE DOOR TO HAVE:
DR. 157D

3 EA	BUTTS	FBB168 4.5 X 4.5 652	STANLEY
1 EA	PRIVACY LOCK	ND40S RHO 626	SCHLAGE
1 EA	KICKPLATE	10 X 2"LDW B4E CS US32D	ROCKWOOD
1 EA	WALL STOP	409 US32D	ROCKWOOD
1 EA	GASKET	F797B17	REESE

HARDWARE GROUP 24

EACH PAIR OF HM DOORS TO HAVE:
DR.161A

2 EA	CONTINUOUS HINGE	651HD UL 7' US32D	STANLEY
1 EA	EXIT DEVICE	99NL-OP X 110MD US26D	VONDUPRIN
1 EA	EXIT DEVICE	99EO US26D	VONDUPRIN
1 EA	KEYED REMOVABLE MULL	KR4854 SP28 BLANK	VONDUPRIN
1 EA	ELEC STRIKE	6300 US32D	VONDUPRIN
1 EA	RIM CYLINDER	20-757 626	SCHLAGE
1 EA	MORT CYL (KEYED MULL)	20-771 626	SCHLAGE
2 EA	OFFSET PULL	BF157 US32D	ROCKWOOD
2 EA	CLOSER	4040XP SHCUSH 689	LCN
2 EA	THRESHOLD	S425A72	REESE
2 EA	WEATHERSTRIP/SWEEP	815A3684	REESE
2 EA	SWEEPS	323C36	REESE
1 EA	RAIN DRIP	R201A84	REESE

CARD READER, PWR SUPPLY, DISCONNECT FOR ELEC STK, BY CARD ACCESS VENDOR.

HARDWARE GROUP 25

EACH PAIR OF DOORS TO HAVE:
DR.164A

2 EA	CONTINUOUS HINGE	651HD UL 7' US32D	STANLEY
2 EA	EXIT DEVICE	9927EO-F LBR 4' 626	VONDUPRIN
2 EA	CLOSER	4040XP EDA 689	LCN
2 EA	MAG HOLD OPENS	SEM7850 689	LCN
2 EA	KICKPLATE	10 X 1"LDW B4E CS US32D	ROCKWOOD
2 EA	WALL STOPS	409 US32D	ROCKWOOD
1 EA	GASKETS	F797B25	REESE
2 EA	ASTRAGAL FINIS	S771D7	PEMKO

HARDWARE GROUP 26

EACH SINGLE DOOR TO HAVE:
DR. 166E

3 EA	BUTTS	FBB168 4.5 X 4.5 652	STANLEY
1 EA	STORERM LOCK	ND80LD RHO 626	SCHLAGE
1 EA	CORE	PRIMUS 20-765	SCHLAGE
1 EA	KICKPLATE	10 X 2"LDW B4E CS US32D	ROCKWOOD
1 EA	WALL STOP	409 US32D	ROCKWOOD
3 EA	SILENCERS	608RKW GREY	ROCKWOOD

HARDWARE GROUP 27

EACH PAIR OF DOORS TO HAVE:
DR.189D

2 EA	CONTINUOUS HINGE	651HD UL 7' US10B	STANLEY
2 EA	EXIT DEVICE	9927L-F X 996L-R LBR 313	VONDUPRIN
2 EA	RIM CYLINDER	20-757 626	SCHLAGE
2 EA	CLOSER	4040SE STD 695	LCN
2 EA	KICKPLATE	10 X 1"LDW B4E CS US32D	ROCKWOOD 1 EA
	GASKETS	F797B25	REESE
2 EA	ASTRAGAL FINIS	S771D7	PEMKO

HARDWARE GROUP 28

EACH PAIR OF ALUM DOORS TO HAVE:
DR.200D/C

2 EA	CONTINUOUS HINGE	BY ALUM DR AND FRAME SUPPLIER	
1 EA	EXIT DEVICE	99NL-OP X 110MD US26D	VONDUPRIN
1 EA	EXIT DEVICE	99EO US26D	VONDUPRIN
1 EA	RIM CYLINDER	20-757 626	SCHLAGE
2 EA	OFFSET PULL	BF157 US32D	ROCKWOOD
1 EA	CLOSER	4040XP SCUSH 689	LCN
1 EA	DROP PLATE	4040XP-18 689	LCN
1 EA	CUSH SHOE SUPPORT	4040XP-30 689	LCN
1 EA	BLADE SPACER	4040XP-61 689	LCN
1 EA	AUTO OPERATOR	4642 REG 689	LCN
2 EA	ACTUATORS	8310-852T	LCN
1 EA	WEATHER RING	8310-802	LCN
1 EA	ELECTRIC STRIKE	6300 US32D	VONDUPRIN
1 EA	SURFACE OHS	100S US32D	GLYNN JOHN
2 EA	THRESHOLD	S425A36	REESE
1 EA	RAIN DRIP	R201A84	REESE
2 EA	WEATHERSTRIP/SWEEP	BY ALUM DR AND FRAME SUPPLIER	

CARD READER ON ONE LEAF OF PAIR, READER, PWR SUPPLY AND DPS BY ACCESS CONTROL PROVIDER.

HARDWARE GROUP 29

EACH PAIR OF ALUM DOORS TO HAVE:
DR.200A/B

2 EA	CONTINUOUS HINGE	BY ALUM DR AND FRAME SUPPLIER	
2 EA	EXIT DEVICE	99EO US26D	VONDUPRIN
2 EA	OFFSET PULL	BF157 US32D	ROCKWOOD
2 EA	CLOSER	4040XP SCUSH 689	LCN
2 EA	DROP PLATE	4040XP-18 689	LCN
2 EA	CUSH SHOE SUPPORT	4040XP-30 689	LCN
2 EA	BLADE SPACER	4040XP-61 689	LCN
2 EA	THRESHOLD	S425A36	REESE
1 EA	RAIN DRIP	R201A84	REESE
2 EA	WEATHERSTRIP/SWEEP	BY ALUM DR AND FRAME SUPPLIER	

DPS BY ACCESS CONTROL PROVIDER.

HARDWARE GROUP 30

EACH PAIR OF HM DOORS TO HAVE:
DR.200G/H

2 EA	CONTINUOUS HINGE	651HD UL 7' US32D	STANLEY
1 EA	EXIT DEVICE	99NL-OP X 110MD US26D	VONDUPRIN
1 EA	EXIT DEVICE	99EO US26D	VONDUPRIN
1 EA	RIM CYLINDER	20-771 626	SCHLAGE
1 EA	KEYED REMOVABLE MULL	KR4954 SP28	VONDUPRIN
2 EA	OFFSET PULL	BF157 US32D	ROCKWOOD
1 EA	CLOSER	4040XP SCUSH 689	LCN
1 EA	AUTO OPERATOR	4642 REG 689	LCN
2 EA	ACTUATORS	8310-852T	LCN
1 EA	WEATHER RING	8310-802	LCN
1 EA	ELECTRIC STRIKE	6300 US32D	VONDUPRIN
1 EA	SURFACE OHS	100S US32D	GLYNN JOHN
3 EA	SILENCERS	608RKW GREY	ROCKWOOD
CARD READER ON ONE LEAF OF PAIR, READER, PWR SUPPLY AND DPS BY ACCESS CONTROL PROVIDER.			

HARDWARE GROUP 31

EACH PAIR OF HM DOORS TO HAVE:
DR.200E/F

2 EA	CONTINUOUS HINGE	651HD UL 7' US32D	STANLEY
2 EA	EXIT DEVICE	99EO US26D	VONDUPRIN
1 EA	KEYED REMOVABLE MULL	KR4954 SP28	VONDUPRIN
2 EA	OFFSET PULL	BF157 US32D	ROCKWOOD
2 EA	CLOSER	4040XP SCUSH 689	LCN
3 EA	SILENCERS	608RKW GREY	ROCKWOOD
DPS BY ACCESS CONTROL PROVIDER			

HARDWARE GROUP 32

EACH SINGLE DOOR TO HAVE:
DR.201

1 EA	CONTINUOUS HINGE	651HD UL 7' US32D	STANLEY
1 EA	EXIT DEVICE	99NL-OP X 110MD US26D	VONDUPRIN
1 EA	RIM CYLINDER	20-757 626	SCHLAGE
1 EA	OFFSET PULL	BF157 US32D	ROCKWOOD
1 EA	CLOSER	4040XP SCUSH 689	LCN
1 EA	ELECTRIC STRIKE	6300 US32D	VONDUPRIN
1 EA	SMOKE GASKET	F797B17	REESE

HARDWARE GROUP 33

EACH PAIR OF DOORS TO HAVE:
DR.201K

2 EA	CONTINUOUS HINGE	651HD UL 7' US32D	STANLEY
2 EA	EXIT DEVICE	99L- X 996L-R 4' US26D	VONDUPRIN
2 EA	RIM CYLINDER	20-757 626	SCHLAGE
2 EA	CLOSER	4040XP SCUSH 689	LCN
3 EA	SILENCERS	608RKW GREY	ROCKWOOD

HARDWARE GROUP 34

EACH SINGLE DOOR TO HAVE:
DR. 202A, 202B

3 EA	BUTTS	FBB168 4.5 X 4.5 652 NRP	STANLEY
1 EA	ENTRANCE LOCK	ND53LD RHO 626	SCHLAGE
1 EA	CORE	PRIMUS 20-765	SCHLAGE
1 EA	CLOSER	4040XP EDA 689	LCN
1 EA	KICKPLATE	10 X 2"LDW B4E CS US32D	ROCKWOOD
1 EA	WALL STOP	409 US32D	ROCKWOOD
1 EA	GASKET	F797B17	REESE

HARDWARE GROUP 35

EACH SINGLE ALUM DOOR TO HAVE:
DR.202C

1 EA	CONTINUOUS HINGE	BY ALUM DR AND FRAME SUPPLIER	
1 EA	EXIT DEVICE	99NL-OP X 110MD US26D	VONDUPRIN
1 EA	RIM CYLINDER	20-757 626	SCHLAGE
1 EA	OFFSET PULL	BF157 US32D	ROCKWOOD
1 EA	CLOSER	4040XP SCUSH 689	LCN
1 EA	DROP PLATE	4040XP-18 689	LCN
1 EA	CUSH SHOE SUPPORT	4040XP-30 689	LCN
1 EA	BLADE SPACER	4040XP-61 689	LCN
1 EA	THRESHOLD	S425A36	REESE
1 EA	RAIN DRIP	R201A48	REESE
1 EA	WEATHERSTRIP/SWEEP	BY ALUM DR AND FRAME SUPPLIER	

HARDWARE GROUP 36

EACH SINGLE DOOR TO HAVE:
DR. 234

3 EA	BUTTS	FBB191 4.5 X 4.5 630	STANLEY
1 EA	STORERM LOCK	ND80LD RHO 626	SCHLAGE
1 EA	CORE	PRIMUS 20-765	SCHLAGE
1 EA	CLOSER	4040XP REG 689	LCN
1 EA	THRESHOLD	S425A36	REESE
1 EA	DR BOTTOM	DB595A36	REESE
1 EA	WEATHERSTRIP	815A3684	REESE

HARDWARE GROUP 37

EACH SINGLE FIRE RESISTIVE DOOR TO HAVE:
DR.210

1 EA	CONTINUOUS HINGE	BY DR AND FRAM	
1 EA	EXIT DEVICE	99L-F X 996L-R US26D	VONDUPRIN
1 EA	RIM CYLINDER	20-757 626	SCHLAGE
1 EA	CLOSER	4040XP SCUSH 689	LCN
1 EA	DROP PLATE	4040XP-18 689	LCN
1 EA	CUSH SHOE SUPPORT	4040XP-30 689	LCN
1 EA	BLADE SPACER	4040XP-61 689	LCN
1 EA	GASKETING	BY DR/FR SUPPLIER	

VERIFY DOOR THICKNESS FOR EXIT DEVICE PRIOR TO ORDERING

HARDWARE GROUP 38

EACH SINGLE DOOR TO HAVE:

DR. 129, 123, 120, 121, 142, 205, 206, 207, 208, 212, 213B

3 EA	BUTTS	FBB179 4.5 X 4.5 652	STANLEY
1 EA	ENTRANCE LOCK	ND53LD RHO 626	SCHLAGE
1 EA	CORE	PRIMUS 20-765	SCHLAGE
1 EA	KICKPLATE	10 X 2"LDW B4E CS US32D	ROCKWOOD
1 EA	WALL STOP	409 US32D	ROCKWOOD
1 EA	SOUND GASKET	F797B17	REESE

ALL EXISTING DRS/FRS MUST BE FIELD VERIFIED BY CONTRACTOR/SUPPLIER PRIOR TO PROCEEDING WITH ORDERS.

HARDWARE GROUP 39

EACH SINGLE DOOR TO HAVE:

DR.128, 162, 163A, 163B, 165, 165A, 166, 167, 168, 172A, 175A, 175B, 182, 183, 184, 187, 188, 218, 219, 220A, 220B, 221A, 221B, 222, 223, 223B, 224A, 229, 229B, 230, 231, 232

3 EA	BUTTS	FBB179 4.5 X 4.5 652	STANLEY
1 EA	ENTRANCE LOCK	ND53LD RHO 626	SCHLAGE
1 EA	CORE	PRIMUS 20-765	SCHLAGE
1 EA	KICKPLATE	10 X 2"LDW B4E CS US32D	ROCKWOOD
1 EA	WALL STOP	409 US32D	ROCKWOOD
1 EA	SOUND GASKET	F797B17	REESE

ALL EXISTING DRS/FRS MUST BE FIELD VERIFIED BY CONTRACTOR/SUPPLIER PRIOR TO PROCEEDING WITH ORDERS.

HARDWARE GROUP 40

EACH SINGLE DOOR TO HAVE:

DR.169, 171, 226, 227

4 EA	HINGES	FBB168 4.5 X 4.5 652	STANLEY
1 EA	PUSH PLATE	70C US32D	ROCKWOOD
1 EA	PULL	110 X 70C US32D	ROCKWOOD
1 EA	CLOSER	4040XP REG 689	LCN
1 EA	KICKPLATE	10 X 2"LDW B4E CS US32D	ROCKWOOD
1 EA	WALL STOP	409 US32D	ROCKWOOD
3 EA	SILENCERS	608RKW GREY	ROCKWOOD

ALL EXISTING DRS/FRS MUST BE FIELD VERIFIED BY CONTRACTOR/SUPPLIER PRIOR TO PROCEEDING WITH ORDERS.

HARDWARE GROUP 41

EACH SINGLE DOOR TO HAVE:

DR. 170, 176, 179, 189B, ~~189D~~

3 EA	BUTTS	FBB179 4.5 X 4.5 652	STANLEY
1 EA	STORERM LOCK	ND80PD RHO 626	SCHLAGE
1 EA	CORE	PRIMUS 20-765	SCHLAGE
1 EA	KICKPLATE	10 X 2"LDW B4E CS US32D	ROCKWOOD
1 EA	WALL STOP	409 US32D	ROCKWOOD
3 EA	SILENCERS	608RKW GREY	ROCKWOOD

ALL EXISTING DRS/FRS MUST BE FIELD VERIFIED BY CONTRACTOR/SUPPLIER PRIOR TO PROCEEDING WITH ORDERS.

HARDWARE GROUP 42

EACH SINGLE DOOR TO HAVE:
DR. 228

3 EA	BUTTS	FBF179 4.5 X 4.5 652	STANLEY
1 EA	STORERM LOCK	ND80LD RHO 626	SCHLAGE
1 EA	CORE	PRIMUS 20-765	SCHLAGE
1 EA	SURFACE OHS	450S 652	GLYNN JOHN
1 EA	KICKPLATE	10 X 2"LDW B4E CS US32D	ROCKWOOD
3 EA	SILENCERS	608RKW GREY	ROCKWOOD

ALL EXISTING DRS/FRS MUST BE FIELD VERIFIED BY CONTRACTOR/SUPPLIER PRIOR TO PROCEEDING WITH ORDERS.

HARDWARE GROUP 43

EACH SINGLE DOOR TO HAVE:
DR. 230C

3 EA	BUTTS	FBF179 4.5 X 4.5 652	STANLEY
1 EA	PRIVACY LOCK	ND40S RHO 626	SCHLAGE
1 EA	KICKPLATE	10 X 2"LDW B4E CS US32D	ROCKWOOD
1 EA	WALL STOP	409 US32D	ROCKWOOD
3 EA	SILENCERS	608RKW GREY	ROCKWOOD

ALL EXISTING DRS/FRS MUST BE FIELD VERIFIED BY CONTRACTOR/SUPPLIER PRIOR TO PROCEEDING WITH ORDERS.

HARDWARE GROUP 44

EACH PAIR OF HM DOORS TO HAVE:
DR.138, 140B, 181A, 186A, 234A

2 EA	CONTINUOUS HINGE	651HD UL 7' US32D	STANLEY
1 EA	EXIT DEVICE	99NL-OP X 110MD US26D	VONDUPRIN
1 EA	EXIT DEVICE	99EO US26D	VONDUPRIN
1 EA	RIM CYLINDER	20-757 626	SCHLAGE
2 EA	OFFSET PULL	BF157 US32D	ROCKWOOD
2 EA	CLOSER	4040XP SHCUSH 689	LCN
2 EA	THRESHOLD	S425A72	REESE
2 EA	WEATHERSTRIP/SWEEP	815A3684	REESE
2 EA	SWEEPS	323C36	REESE
1 EA	RAIN DRIP	R201A84	REESE

ALL EXISTING DRS/FRS MUST BE FIELD VERIFIED BY CONTRACTOR/SUPPLIER PRIOR TO PROCEEDING WITH ORDERS.

HARDWARE GROUP 45

EACH PAIR OF HM DOORS TO HAVE:
DR.188A

1 EA	CONTINUOUS HINGE	651HD UL 7' US32D	STANLEY
1 EA	EXIT DEVICE	99NL-OP X 110MD US26D	VONDUPRIN
1 EA	RIM CYLINDER	20-757 626	SCHLAGE
1 EA	OFFSET PULL	BF157 US32D	ROCKWOOD
1 EA	CLOSER	4040XP SHCUSH 689	LCN
1 EA	THRESHOLD	S425A36	REESE
1 EA	WEATHERSTRIP/SWEEP	815A3684	REESE
1 EA	SWEEPS	323C36	REESE
1 EA	RAIN DRIP	R201A48	REESE

ALL EXISTING DRS/FRS MUST BE FIELD VERIFIED BY CONTRACTOR/SUPPLIER PRIOR TO PROCEEDING WITH ORDERS.


HARDWARE GROUP 46

EACH PAIR OF DOORS TO HAVE:
DR.209

6 EA	BUTTS	FBB179 4.5 X 4.5 652	STANLEY
2 EA	EXIT DEVICE	9927L X 996L-V LBR 4'	VONDUPRIN
2 EA	RIM CYLINDER	20-757 626	SCHLAGE
2 EA	CLOSER	4040XP SHCUSH 689	LCN
2 EA	KICKPLATE	10 X 1"LDW B4E CS US32D	ROCKWOOD
2 EA	WALL STOPS	409 US32D	ROCKWOOD
1 EA	GASKETS	F797B25	REESE
2 EA	ASTRAGAL FINIS	S771D7	PEMKO

ALL EXISTING DRS/FRS MUST BE FIELD VERIFIED BY CONTRACTOR/SUPPLIER PRIOR TO PROCEEDING WITH ORDERS.

END OF SECTION 08 71 00

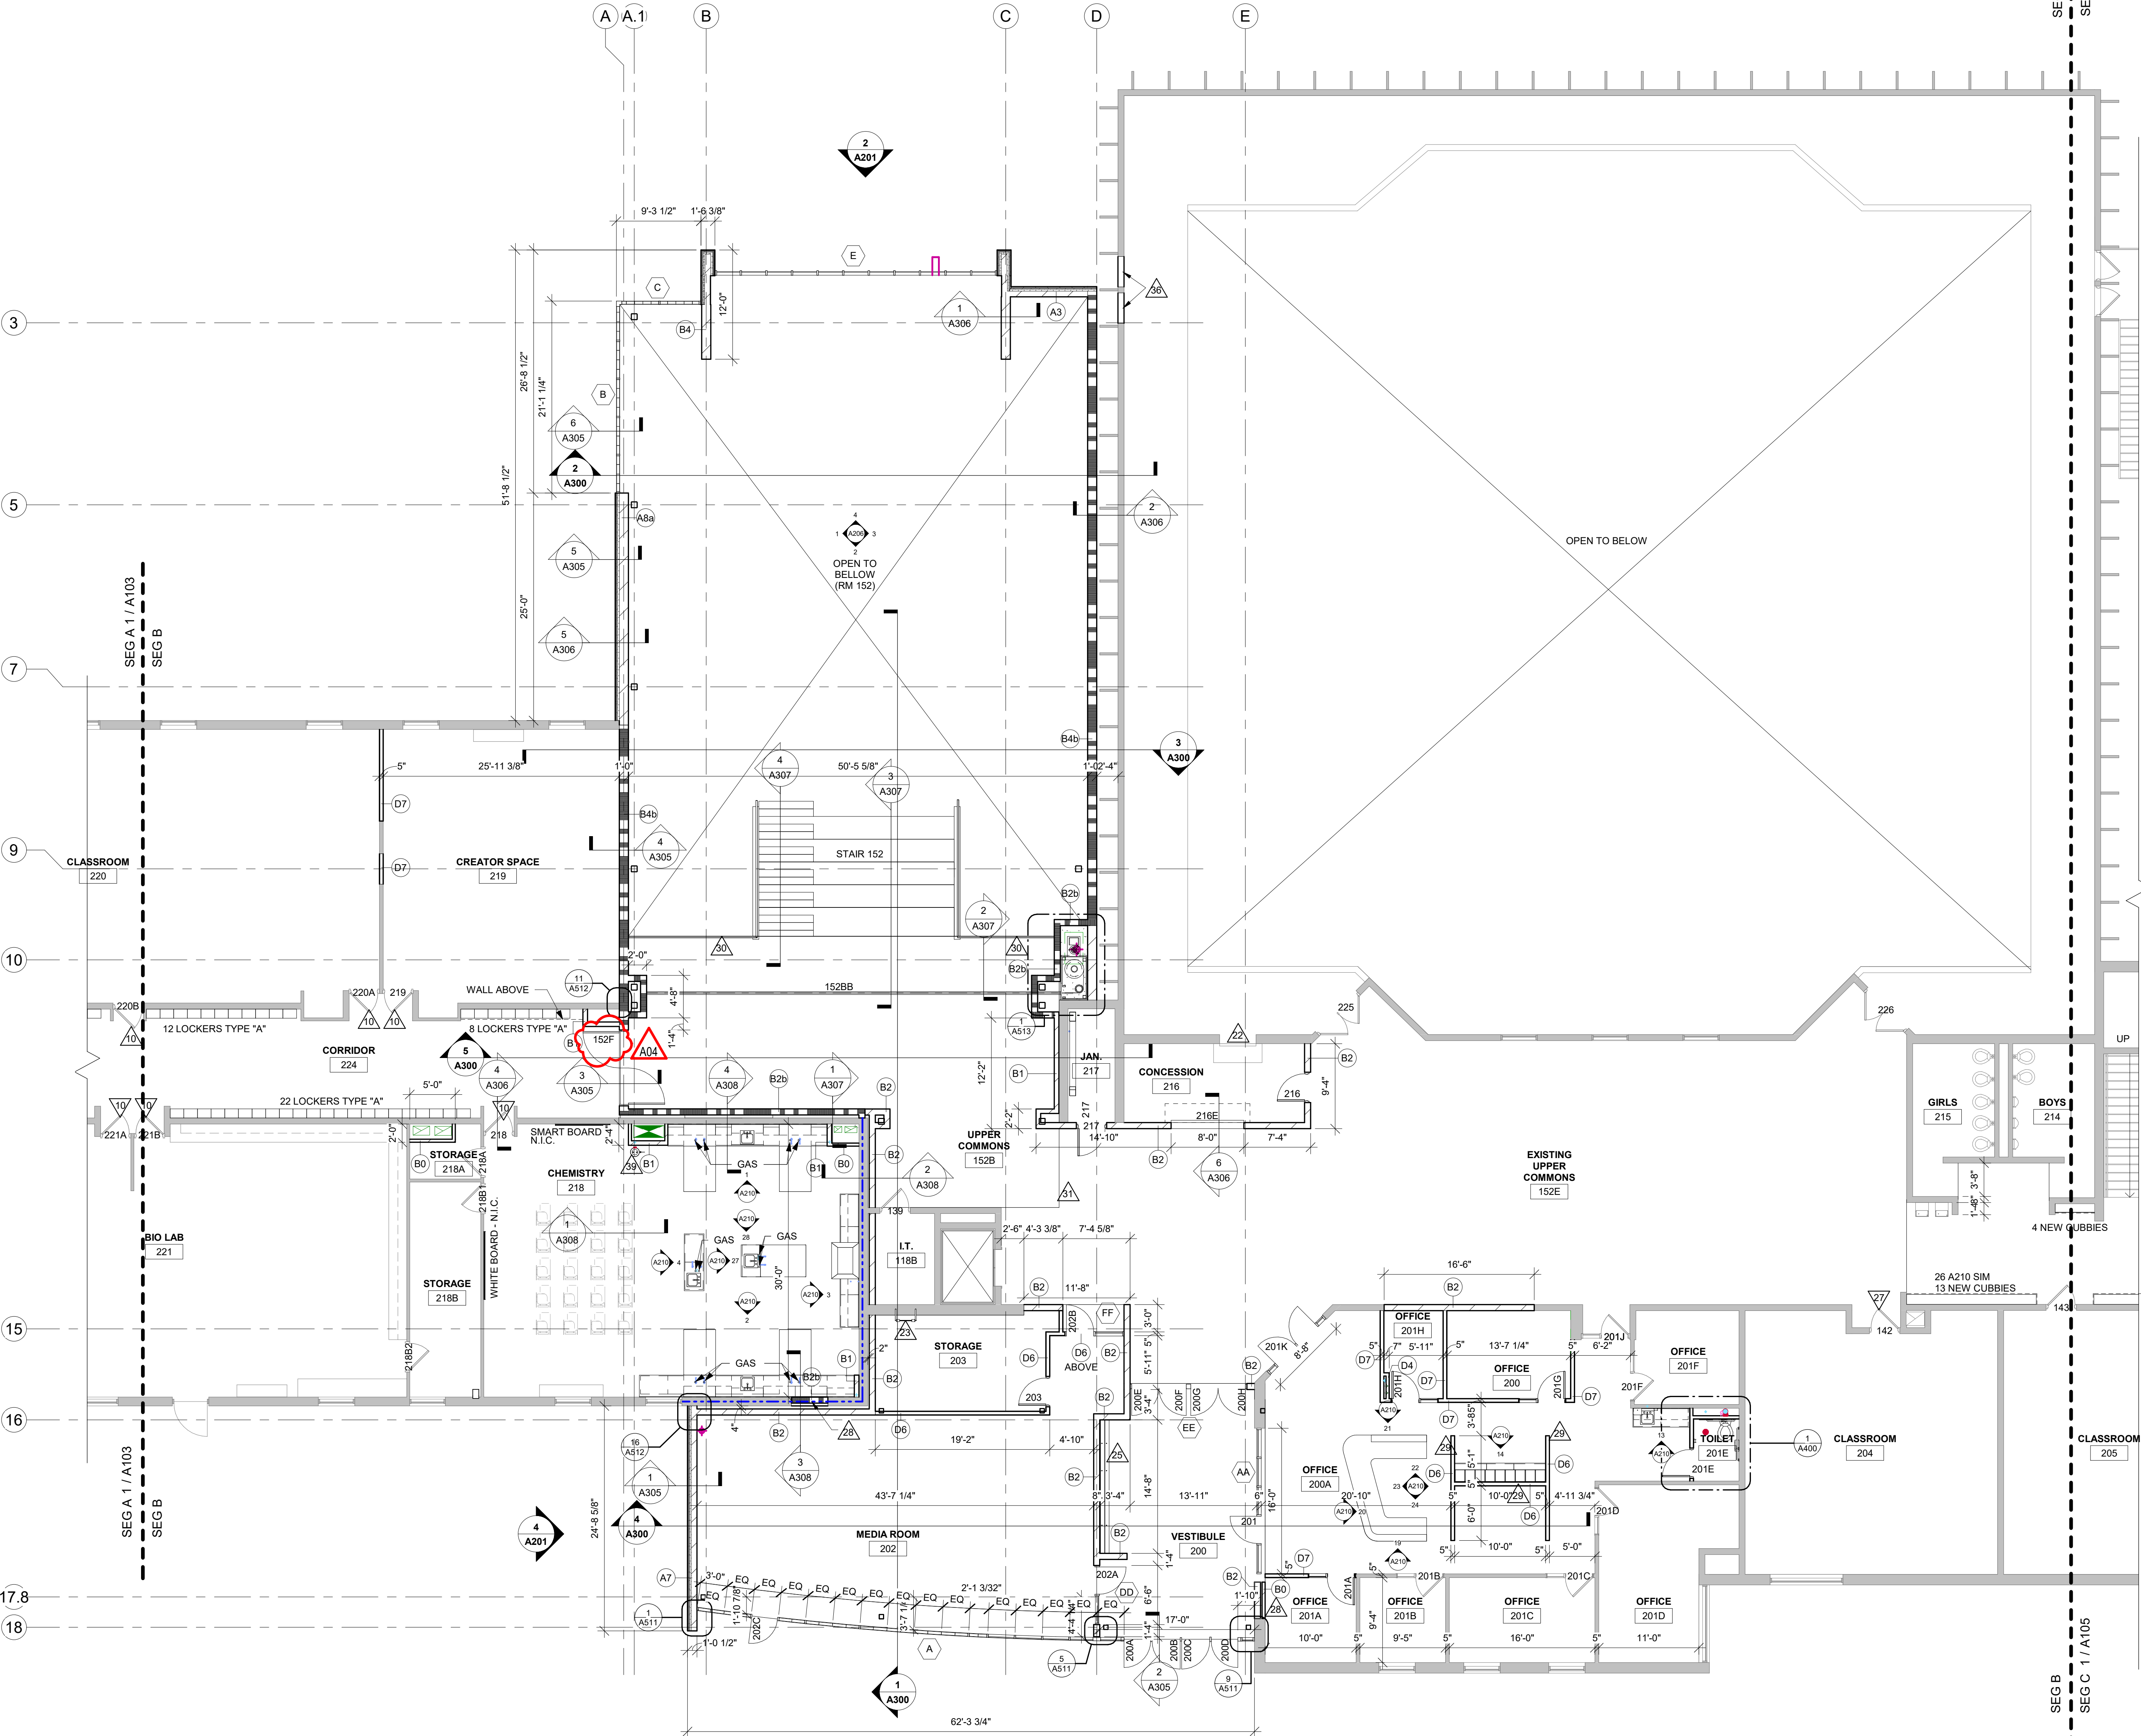

GENERAL NOTES:	
A	SEE ID SHEETS FOR FLOOR AND WALL FINISH LAYOUTS.
B	LOOSE FURNISHINGS EXCEPT AS NOTED SHALL BE PROVIDED AND INSTALLED BY THE OWNER.
C	VERIFY EXACT SIZE AND LOCATION OF ALL MECHANICAL / PLUMB AND ELEC. OPENINGS - GENERAL CONTRACTOR SHALL BE RESPONSIBLE FOR FINISH AT ALL VISIBLE AREAS. ALL OPENING SHALL BE SEALED AFTER UTILITY INSTALLATION.
D	PAINT ALL EXPOSED STEEL LINTELS.
E	SEE STRUCTURAL FOR SLAB CONTROL JOINTS.
F	SEE A510 FOR WALL CONTROL JOINT DETAILS. SEE PLANS AND ELEVATIONS FOR C/J LOCATIONS. C/J = CONTROL JOINTS.
G	REFER TO OVERALL PLANS FOR FIRE RATING LOCATIONS AND ACCESSIBILITY ROUTES.
H	EXTEND ALL WALLS TO DECK UNLESS NOTED OTHERWISE. SEE A500 FOR TOP OF WALL DETAILS.
I	UNLESS NOTED OTHERWISE RESTROOM FLOORS SHALL BE SLOPED A MIN. 1/16" TO FLOOR DRAINS - TO "CENTER". IF NO FLOOR DRAINS.
J	FIXED EQUIPMENT IS SHOWN ON THIS PLAN FOR COORDINATION. SEE SHEETS A304-A313 FOR ALL EQUIPMENT NOTES.
K	SEE A500 FOR TYPICAL HEAD FLASHING AND THROUGH-WALL FLASHING ISOMETRIC DETAILS.
L	GEN. CONTRACTOR TO PROVIDE CONC. EQUIP. PADS/CURBS AS REQUIRED FOR MECH/ELECTRICAL EQUIP. - VERIFY SIZE/PROFILE/LOCATION WITH MECH/ELECTRICAL.
M	ALL DOORS TO BE LOCATED 4" FROM WALL AT HINGE UNLESS NOTED OTHERWISE.

LEGEND:	
(A)	SYMBOL INDICATES WALL TYPE - SEE SHEET A600 FOR WALL TYPE DETAILS.
(A)	SYMBOL INDICATES WINDOW TYPE. SEE SHEET A601 FOR WINDOW FRAME ELEVATIONS.
(A)	SYMBOL INDICATES CONSTRUCTION NOTE THIS SHEET
1 HOUR WALL	
2 HOUR WALL	

KEY NOTES PLAN	
1	PATCH AND PREP FLOOR AS REQUIRED FOR NEW FLOOR FINISH - SEE ID SHEETS
2	CONCRETE STOOP - SEE STRUCTURAL
3	3'-6" HIGH WALL WITH SOLID SURFACE CAP
4	SEE ROOM 108 FOR CASEWORK ELEVATION TAG
5	BUILDING OUTLINE ABOVE
6	NOP BASIN - SEE PLUMBING
7	NEW PLUMBING FIXTURE - SEE PLUMBING
8	PATCH WALL TO MATCH ADJACENT FINISH
9	INDOOR PLAY AREA EQUIPMENT AND PADDED FLOORING BY OTHERS
10	REPLACE DOOR SLAB AND HARDWARE
11	LADDER TO BE INSTALLED FOR EGRESS
12	VENDING MACHINES (N.I.C.)
13	DRINKING FOUNTAIN HIGH - LOW - SEE PLUMBING
14	ROOFTOP MECHANICAL EQUIPMENT - SEE MECH
15	SOLID SURFACE SILL
16	4" GUARDRAIL
17	MECHANICAL PIPING TO ROOF - SEE MECH
18	GALVANIZED GRATE OVER AREA WELL
19	MECHANICAL AREA WELL - SEE STRUCTURAL
20	REMOVE MECHANICAL EQUIPMENT AND CONCRETE PAD - SEE MECH AND CIVIL
21	NEW HOLLOW METAL DOOR AND FRAME - SEE DOOR SCHEDULE
22	EXISTING CONCESSION OPENING AND O.H. DOOR
23	SHIPS LADDER TO BE INSTALLED FOR ROOF ACCESS
24	ANDORIZED HSS TO MATCH MULLION COLOR - SEE STRUCT FOR DETAIL
25	WOOD TOP BENCH WITH WALL MOUNTED BRACKETS 9' O.C. MAX
26	NEW CONCRETE SLAB AS REQUIRED TO INSTALL NEW FOOTINGS - SEE STRUCTURAL
27	REPLACE DOOR HARDWARE - SEE DOOR SCHEDULE
28	INFILL OPENING WITH CMU BLOCKING
29	PARTIAL HEIGHT WALLS (8'-0" WALLS)
30	METAL MESH RAILING
31	EXTENTS OF PRECAST PLANT AND CONCRETE TOPPING
32	RAIN LEADER - SEE PLUMBING
33	MEZZANINE FLOOR TO GET TRAFFIC COATING
34	4" CONCRETE PAD - SEE MECH/PLUMB. FOR EQUIP. SIZE.
35	BULLNOSE CORNERS
36	FILL OPENING. STIKE MORTAR JOINTS FLUSH AND PARGE BLOCK SURFACE SMOOTH FOR INTERIOR AND EXTERIOR
37	NEW O.H. DOOR - SEE DOOR SCHEDULE
38	WATER METER - SEE PLUMBING
39	EYE WASH - SEE PLUMBING

ARCHITECTURE
ENGINEERING
INTERIOR DESIGN



HSR ASSOCIATES INC.
100 MILWAUKEE STREET
LA CROSSE, WISCONSIN
PHONE: 608.784.1830
FAX: 608.782.5844
www.hsrassociates.com

Consultant:

ENGINEER CERTIFICATION

I hereby certify that this Plan, Specification or Report was prepared by me or under my direct supervision and that I am a duly licensed Engineer under the laws of the state of Minnesota.

Date: July 9, 2019 Lic. No. 11314

This drawing is conditionally issued and reproductions or use of any technical design information is strictly forbidden without written agreement from the responsible Engineer.

ARCHITECT CERTIFICATION

I hereby certify that this Plan, Specification or Report was prepared by me or under my direct supervision and that I am a duly licensed Architect under the laws of the state of Minnesota.

Date: July 9, 2019 Lic. No. 58867

This drawing is conditionally issued and reproductions or use of any technical design information is strictly forbidden without written agreement from the responsible Architect.

LANESBORO PUBLIC SCHOOLS
ADDITION & REMODEL
204 KIRKWOOD ST EAST
LANESBORO, MN 55949
UPPER LEVEL REMODELED FLOOR PLAN - SEG B

HSR Project Number:

18063

Project Date:

7-25-19

Drawn By:

TBS/SRW

Key Plan:

SEG A SEG B SEG C

KEY PLAN

Revisions:

No. Description Date

A02 ADDENDUM #02 8-19-19

B01 BULLETIN #1 Date

A04 ADDENDUM #04 8-21-19


Graphic Scale:

0' 2' 4' 8' 12'

Last Update:

8/22/2019 10:37:31 AM

A104

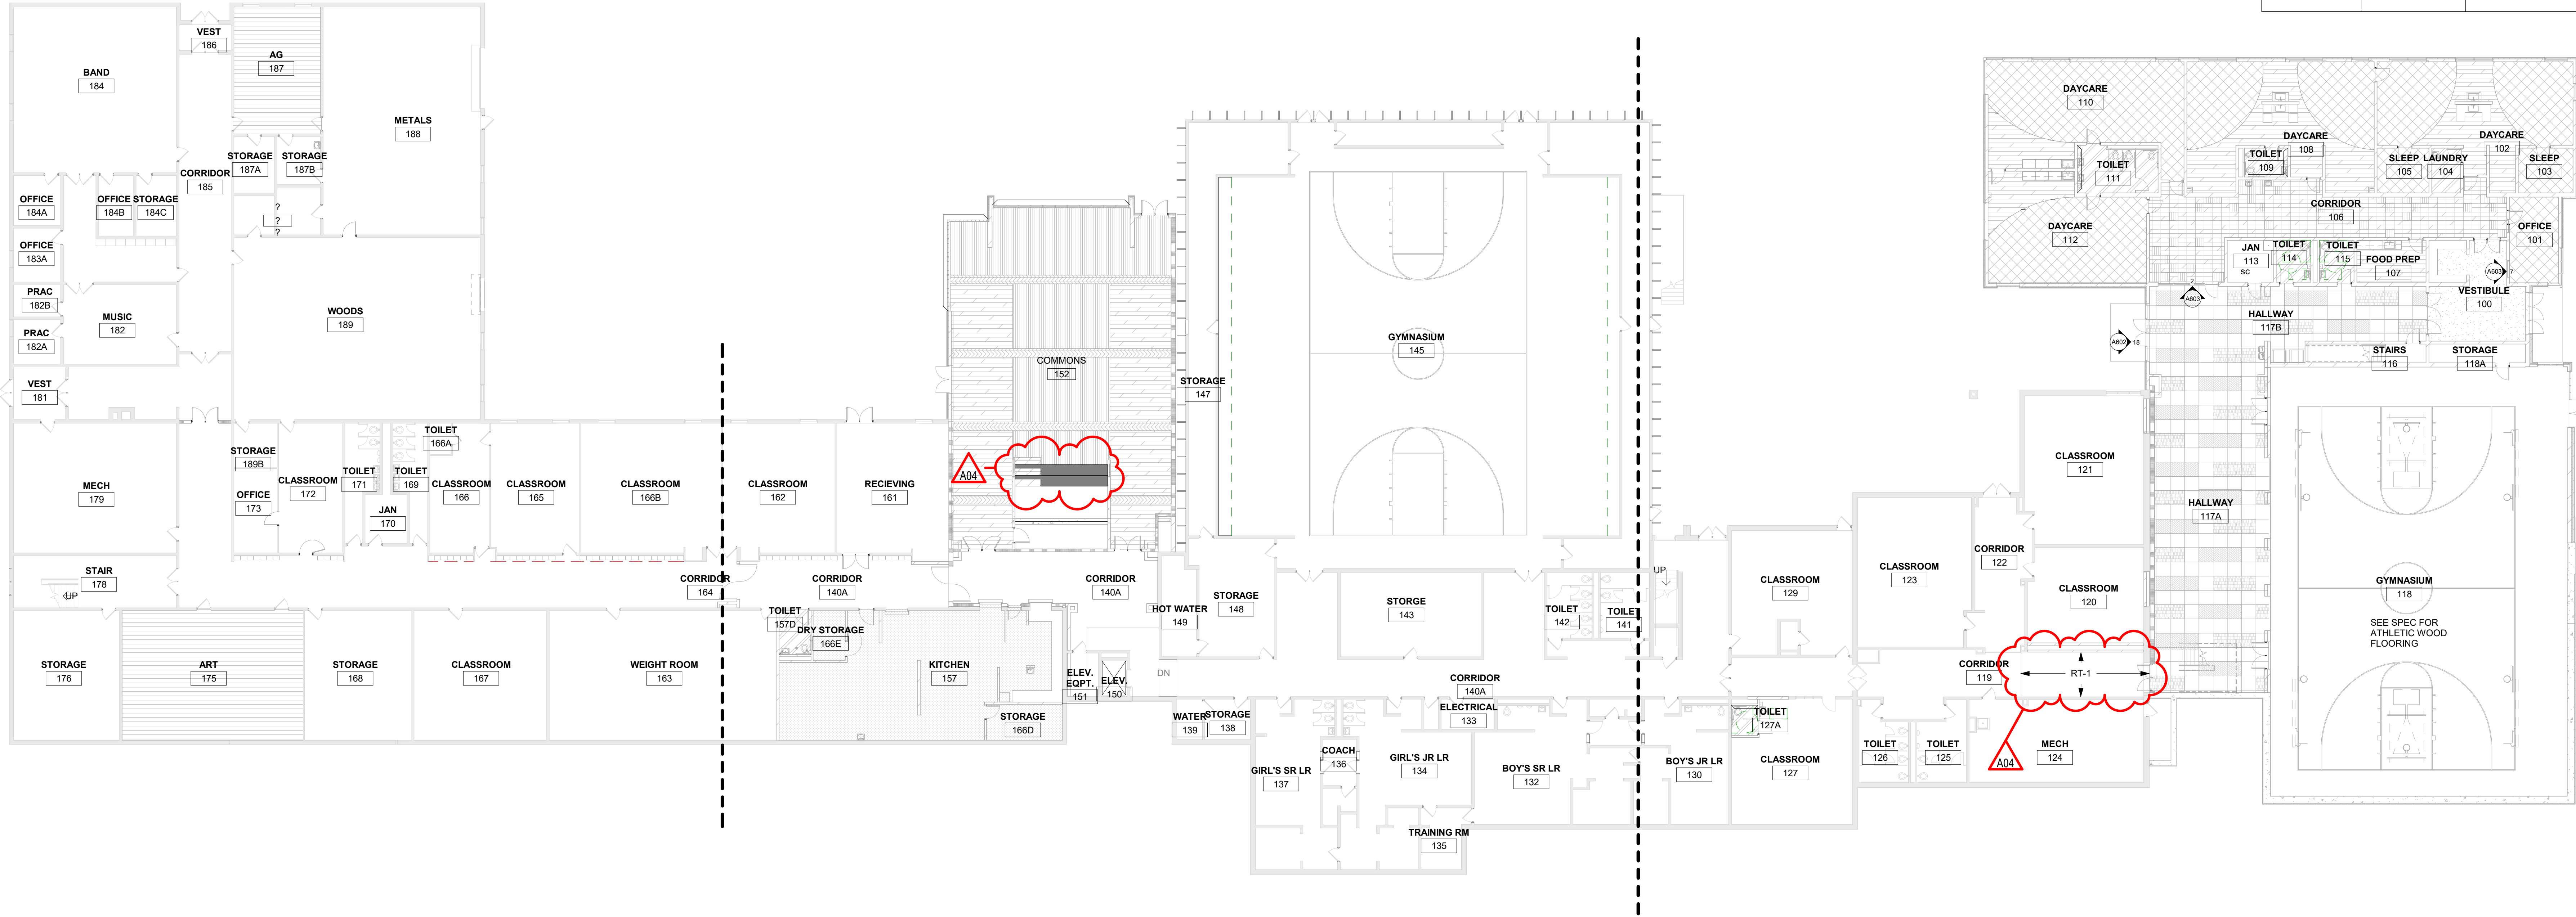

1 LOWER LEVEL OVERALL FINISH PLAN

1/16" = 1'-0"

INTERIOR GENERAL NOTES:	
A	REFERENCES TO PAINT PERTAIN TO COLOR ONLY. PAINT TYPE SHALL BE IDENTIFIED IN THE ARCHITECTURAL SPECIFICATIONS.
B	PNT-1 FIELD PAINT; ACCENT PAINT AS INDICATED. SEE ID SHEETS.
C	REFER TO MASTER COLOR SCHEDULE ON ID600 FOR MATERIAL FINISH SPECIFICATIONS, ANNOTATIONS, AND ADDITIONAL INFORMATION.
D	TOILET ROOM WALL AND FLOOR GROUT LINES SHALL ALIGN TO CONTINUE PATTERN THROUGHOUT. SEE ID400 FOR ELEVATED PATTERNING.
E	VINYL COMPOSITE EDGE (VCE) TO BE INSTALLED AT DISSIMILAR FINISH AREAS. REFER TO ID SHEETS. INSTALL APPROPRIATE EDGE PROFILE TO PROTECT FINISH EDGES. COLOR AS SELECTED BY A/E.
F	AT DISSIMILAR FLOORING FINISHES, SET JOINT OF MATERIALS AT CENTER OF DOOR. TRANSITIONS TO BE ADA COMPLIANT.

FINISH KEY PLAN:	
	SEE ROOM FINISH REMARKS
	WALL BASE
	ACCENT PAINT

FINISH LEGEND:			
	TLE-1		LVT-1
	TLE-2		LVT-2
	SEE ID400 TLE-3		LVT-3
	TLE-4		RST-1
	TLE-5		SEE ID SHEET RST-2
	TLE-6		SEE ID SHEET RT-1
	SEE ID400 TLE-7		RT-2
			RT-3
			RS-1
			VCT-1
			CPT-1
			CPT-2
			WCPT-1
			SEE ID400 FOR CARPET PATTERN
			FAF-1 SEE SPEC

ARCHITECTURE
ENGINEERING
INTERIOR DESIGN

HSR ASSOCIATES INC.
100 MILWAUKEE STREET
LA CROSSE, WISCONSIN
PHONE: 608.784.1830
FAX: 608.782.5844
www.hsrassociates.com

Consultant:

ENGINEER CERTIFICATION
I hereby certify that this Plan, Specification or Report was prepared by me or under my direct supervision and that I am a duly licensed Engineer under the laws of the state of Minnesota.
Date: July 9, 2019 Lic No: 11314
This drawing is conditionally issued and reproductions or use of any technical design information is strictly forbidden without written agreement from the responsible Engineer.
ARCHITECT CERTIFICATION
I hereby certify that this Plan, Specification or Report was prepared by me or under my direct supervision and that I am a duly licensed Architect under the laws of the state of Minnesota.
Date: July 9, 2019 Lic No: 56867
This drawing is conditionally issued and reproductions or use of any technical design information is strictly forbidden without written agreement from the responsible Architect.

LANESBORO PUBLIC SCHOOLS
ADDITION & REMODEL

Project Title: 204 KIRKWOOD ST EAST
Location: LANESBORO, MN 55949

Sheet Title: OVERALL LOWER LEVEL FINISH PLAN

HSR Project Number: 18063

Project Date: 7-25-19

Drawn By: K.VEERKAMP

Key Plan:

KEY PLAN

Revisions:

No.	Description	Date
A02	ADDENDUM #02	8-19-19
A04	ADDENDUM #04	8-21-19

Graphic Scale:
VARIES

Last Update:
8/21/2019 2:37:20 PM

ID101



HSR ASSOCIATES INC.
100 MILWAUKEE STREET
LA CROSSE, WISCONSIN
PHONE: 608.784.1830
FAX: 608.782.5844
www.hsrassociates.com

Consultant:

ENGINEER CERTIFICATION

I hereby certify that this Plan, Specification or Report was prepared by me or under my direct supervision and that I am a duly licensed Architect under the laws of the state of Minnesota.

Jan Tompkins Date: July 9, 2019 Lic No: 13334

This drawing is conditionally issued and reproductions or use of any technical design information is strictly forbidden without written agreement from the responsible Engineer.

ARCHITECT CERTIFICATION

I hereby certify that this Plan, Specification or Report was prepared by me or under my direct supervision and that I am a duly licensed Architect under the laws of the state of Minnesota.

Paul A. Date: July 9, 2019 Lic No: 56867

This drawing is conditionally issued and reproductions or use of any technical design information is strictly forbidden without written agreement from the responsible Architect.

LANESBORO PUBLIC SCHOOLS
ADDITION & REMODEL

Project Title: 204 KIRKWOOD ST EAST
Location: LANESBORO, MN 55949

Sheet Title: LOWER LEVEL FINISH PLAN SEGMENT C

HSR Project Number: 18063

Project Date: 7-25-19

Drawn By: Author

Key Plan:

SEG A SEG B SEG C

KEY PLAN

Revisions:

No.	Description	Date
A02	ADDENDUM #02	8-19-19
A04	ADDENDUM #04	8-21-19

Graphic Scale:

VARIES

Last Update:

8/21/2019 2:28:34 PM

ID104

INTERIOR GENERAL NOTES:

- A REFERENCES TO PAINT PERTAIN TO COLOR ONLY. PAINT TYPE SHALL BE IDENTIFIED IN THE ARCHITECTURAL SPECIFICATIONS.
- B PNT-1 FIELD PAINT. ACCENT PAINT AS INDICATED. SEE ID SHEETS.
- C REFER TO MASTER COLOR SCHEDULE ON ID600 FOR MATERIAL FINISH SPECIFICATIONS, ANNOTATIONS, AND ADDITIONAL INFORMATION.
- D TOILET ROOM WALL AND FLOOR GROUT LINES SHALL ALIGN TO CONTINUE PATTERN THROUGHOUT. SEE ID400 FOR ELEVATED PATTERNING.
- E VINYL COMPOSITE EDGE (VCE) TO BE INSTALLED AT DISSIMILAR FINISH AREAS. REFER TO ID SHEETS. INSTALL APPROPRIATE EDGE PROFILE TO PROTECT FINISH EDGES. COLOR AS SELECTED BY A/E.
- F AT DISSIMILAR FLOORING FINISHES, SET JOINT OF MATERIALS AT CENTER OF DOOR. TRANSITIONS TO BE ADA COMPLIANT.

FINISH KEY PLAN:

- SEE ROOM FINISH REMARKS
- XXX WALL BASE
- PNT-X ACCENT PAINT

FINISH LEGEND:

- | | | |
|-------|-------------|------------------------------|
| TLE-1 | LVT-1 | RS-1 |
| TLE-2 | LVT-2 | VCT-1 |
| TLE-3 | LVT-3 | CPT-1 |
| TLE-4 | RST-1 | CPT-2 |
| TLE-5 | SEE IDSHEET | WCPT-1 |
| TLE-6 | SEE IDSHEET | SEE ID400 FOR CARPET PATTERN |
| TLE-7 | RT-1 | FAP-1 |
| | RT-2 | SEE SPEC |
| | RT-3 | |

ROOM FINISH REMARKS

- PAINT ALL WALLS PNT-1. ACCENT AS INDICATED ON PLANS.
- PATCH FLOORING TO MATCH EXISTING TERRAZZO.
- EXISTING FLOORING REMAINS. PATCH AS NEEDED.
- PAINT ALL WALLS PNT-1. EPOXY.
- FULL HEIGHT TILE ON WET WALLS. 4'-0" TILE WITH 3" BULLNOSE ON REMAINING WALLS. SEE ID400.
- TOUCH UP PAINT AS NEEDED.
- FULL HEIGHT TILE ON WET WALLS. 8" TILE BASE WITH SCHLUTER CAPPING TRIM ON REMAINING WALLS. SEE ID400.
- SEE ELEVATIONS FOR ACCENT PAINT DESIGN.



1 SEG C- LOWER LEVEL FINISH PLAN

1/8" = 1'-0"



HSR ASSOCIATES INC.
100 MILWAUKEE STREET
LA CROSSE, WISCONSIN
PHONE: 608.784.1830
FAX: 608.782.5844
www.hsrassociates.com

Consultant:

ENGINEER CERTIFICATION

I hereby certify that this Plan, Specification or Report was prepared by me or under my direct supervision and that I am a duly licensed Engineer under the laws of the state of Minnesota.

Jan Tompkins
Date: July 9, 2019 Lic No: 11314

This drawing is conditionally issued and reproductions or use of any technical design information is strictly forbidden without written agreement from the responsible Engineer.

ARCHITECT CERTIFICATION

I hereby certify that this Plan, Specification or Report was prepared by me or under my direct supervision and that I am a duly licensed Architect under the laws of the state of Minnesota.

Quill On
Date: July 9, 2019 Lic No: 58867

This drawing is conditionally issued and reproductions or use of any technical design information is strictly forbidden without written agreement from the responsible Architect.

Project Title: LANESBORO PUBLIC SCHOOLS

ADDITION & REMODEL

Project Location: 204 KIRKWOOD ST EAST
LANESBORO, MN 55949


Sheet Title: UPPER LEVEL FINISH PLAN SEGMENT B

HSR Project Number: 18063

Project Date: 7-25-19

Drawn By: K.VEERKAMP

Key Plan:

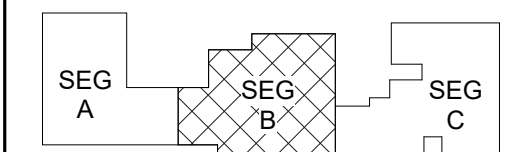

KEY PLAN

Revisions:

No.	Description	Date
A02	ADDENDUM #02	8-19-19
A04	ADDENDUM #04	8-21-19

Graphic Scale: VARIES

Last Update: 8/21/2019 2:28:34 PM

ID107

INTERIOR GENERAL NOTES:

- REFERENCES TO PAINT PERTAIN TO COLOR ONLY. PAINT TYPE SHALL BE IDENTIFIED IN THE ARCHITECTURAL SPECIFICATIONS.
- PNT-1 FIELD PAINT. ACCENT PAINT AS INDICATED. SEE ID SHEETS.
- REFER TO MASTER COLOR SCHEDULE ON ID000 FOR MATERIAL FINISH SPECIFICATIONS, ANNOTATIONS, AND ADDITIONAL INFORMATION.
- TOILET ROOM WALL AND FLOOR GROUT LINES SHALL ALIGN TO CONTINUE PATTERN THROUGHOUT. SEE ID400 FOR ELEVATED PATTERNING.
- VINYL COMPOSITE EDGE (VCE) TO BE INSTALLED AT DISSIMILAR FINISH AREAS. REFER TO ID SHEETS. INSTALL APPROPRIATE EDGE PROFILE TO PROTECT FINISH EDGES. COLOR AS SELECTED BY A/E.
- AT DISSIMILAR FLOORING FINISHES, SET JOINT OF MATERIALS AT CENTER OF DOOR. TRANSITIONS TO BE ADA COMPLIANT.

FINISH KEY PLAN:


- SEE ROOM FINISH REMARKS
- XXX WALL BASE
- PNT-X ACCENT PAINT

FINISH LEGEND:

TLE-1	LVT-1	RS-1
TLE-2	LVT-2	VCT-1
SEE ID400	LVT-3	CPT-1
TLE-4	RST-1	CPT-2
TLE-5	SEE IDSHEET	WCPT-1
TLE-6	SEE IDSHEET	SEE ID400 FOR CARPET PATTERN
SEE ID400	RT-1	FAF-1 SEE SPEC
	RT-2	
	RT-3	

ROOM FINISH REMARKS

- PAINT ALL WALLS PNT-1. ACCENT AS INDICATED ON PLANS.
- PATCH FLOORING TO MATCH EXISTING TERRAZZO
- EXISTING FLOORING REMAINS. PATCH AS NEEDED
- PAINT ALL WALLS PNT-1 EPOXY.
- FULL HEIGHT TILE ON WET WALLS. 4'-0" TILE WITH 3" BULLNOSE ON REMAINING WALLS. SEE ID400
- TOUCH UP PAINT AS NEEDED
- FULL HEIGHT TILE ON WET WALLS. 8" TILE BASE WITH SCHLUTER CAPPING TRIM ON REMAINING WALLS. SEE ID400
- SEE ELEVATIONS FOR ACCENT PAINT DESIGN

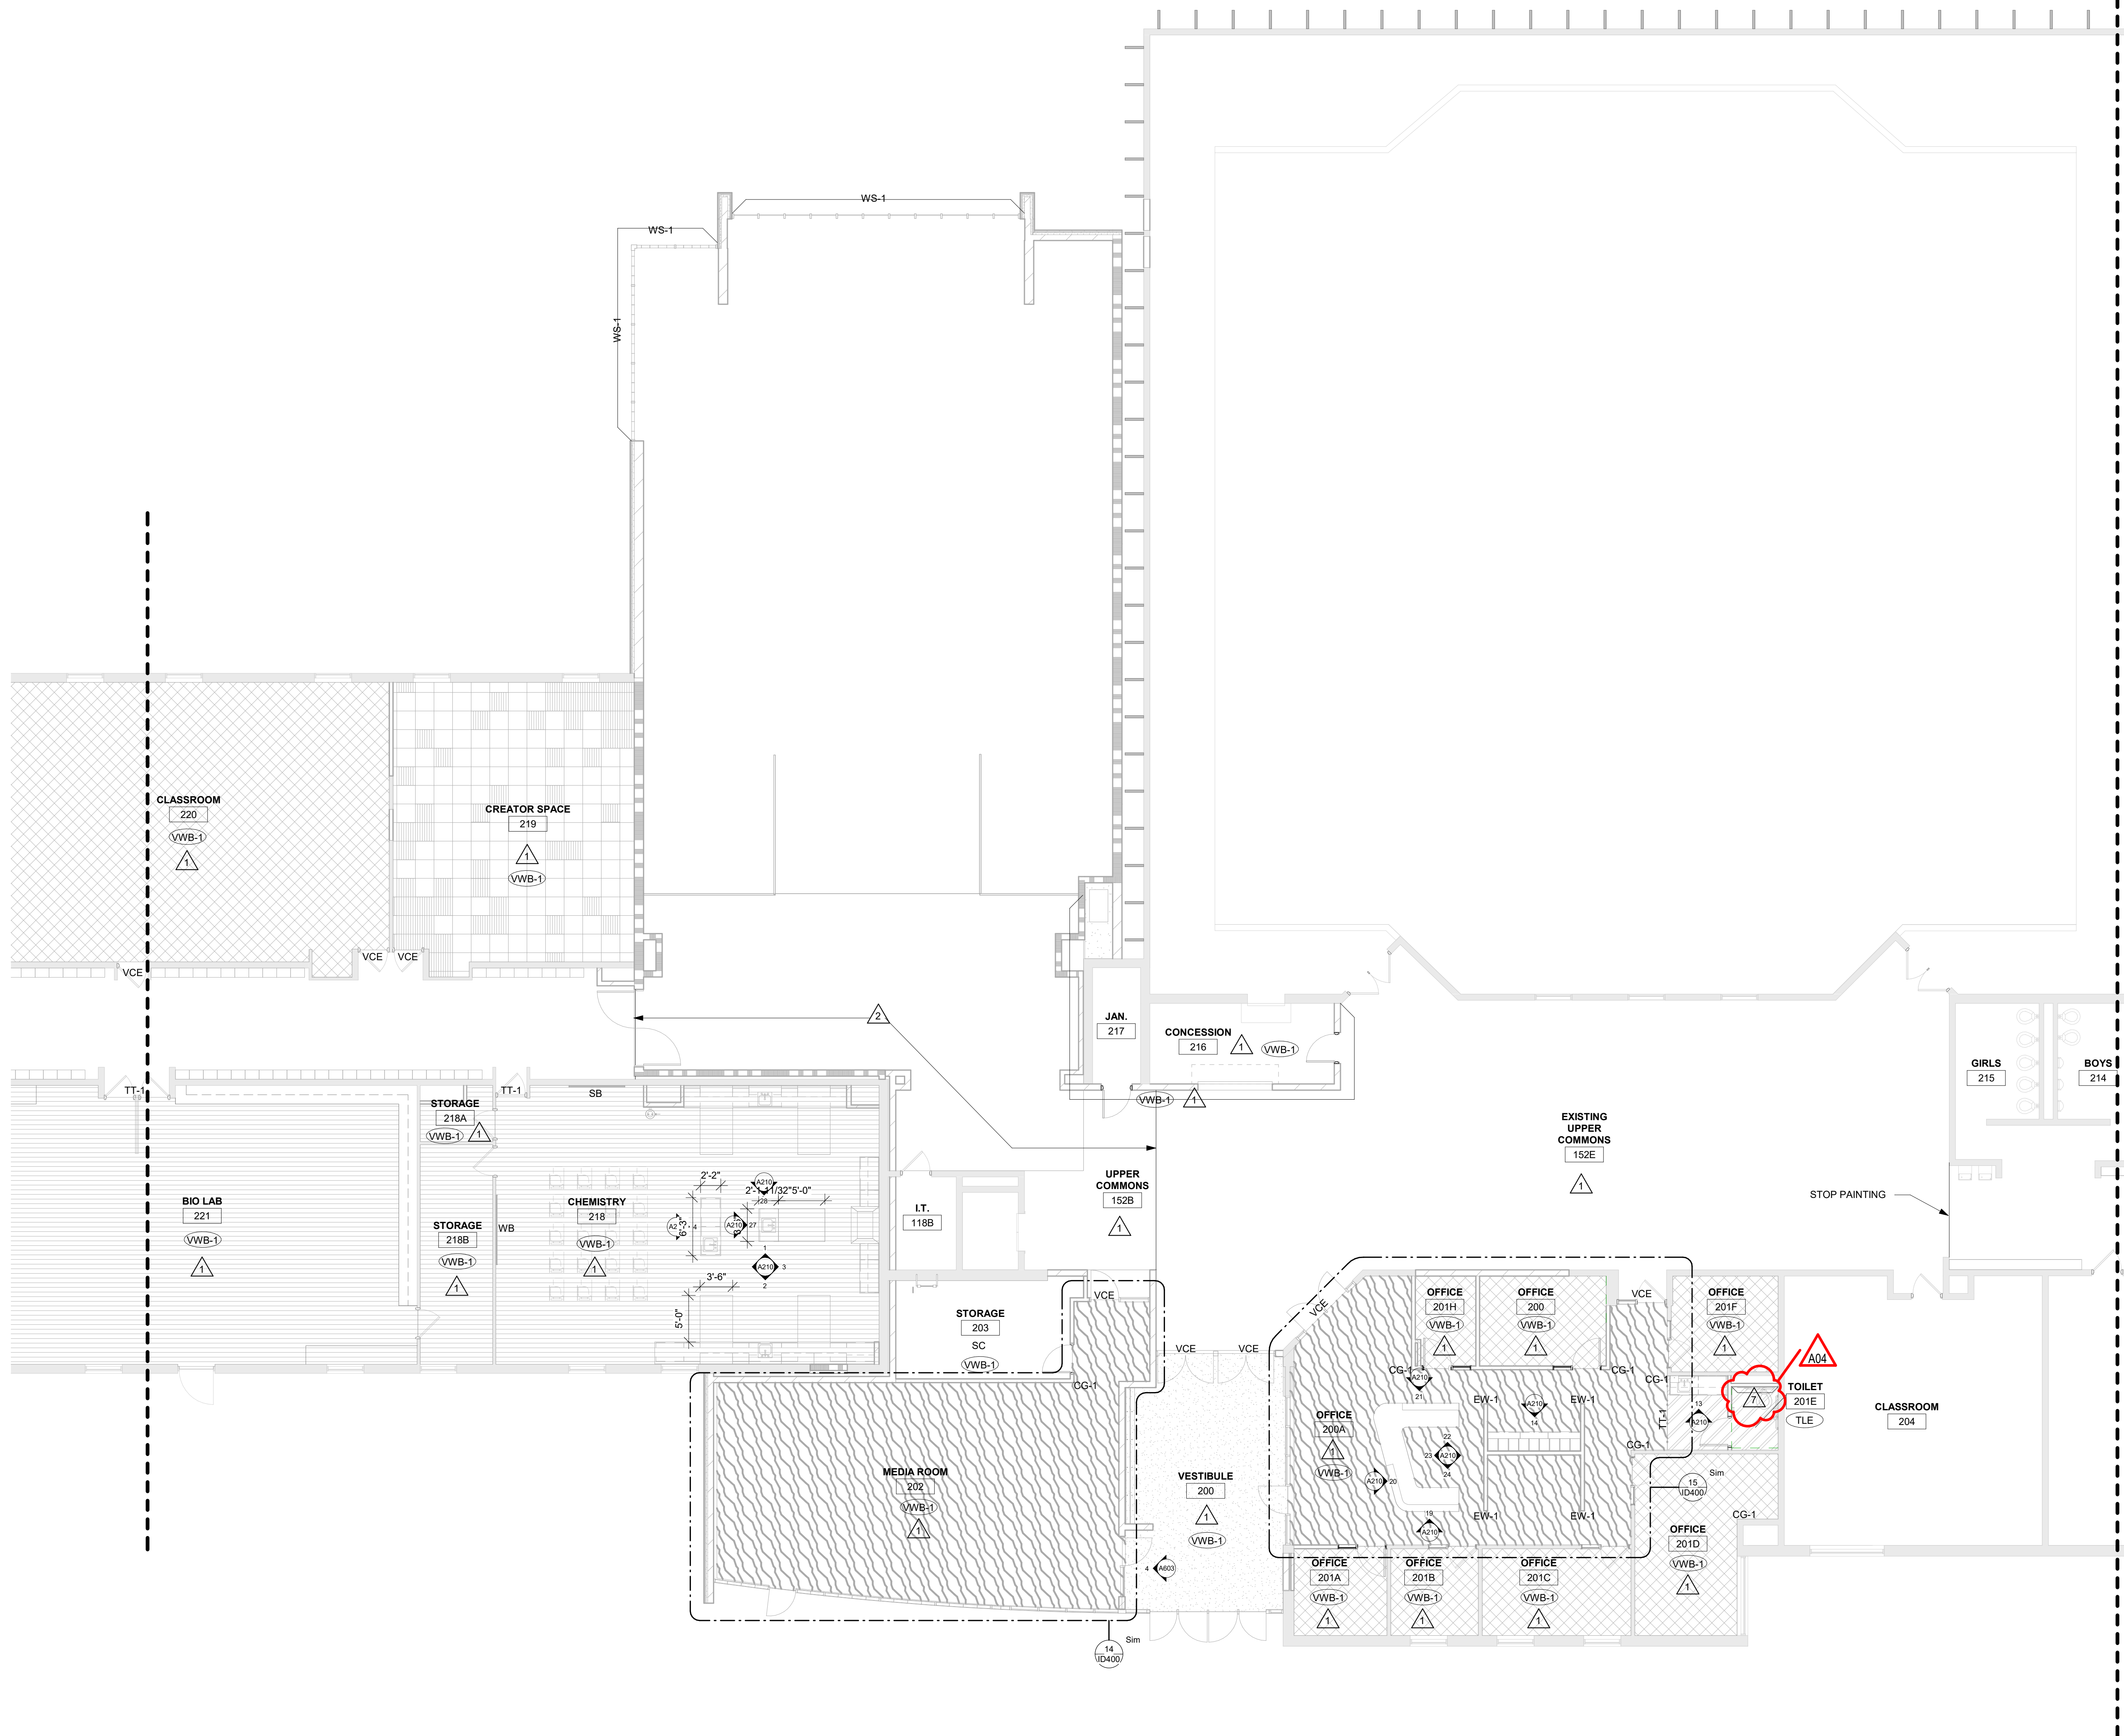

1 SEG B- UPPER LEVEL FINISH PLAN

1/8" = 1'-0"