## DOCUMENT 00 90 00 ADDENDUM

ADDENDUM NO. [1] Date: January 21, 2020

- RE: SCHOOL DISTRICT OF HOLMEN VIKING ELEMENTARY SECURE ENTRY 500 EAST WALL ST. HOLMEN, WISCONSIN 54636 HSR PROJECT NO. 19022
- FROM: HSR Associates, Inc 100 Milwaukee Street La Crosse, WI 54603 (608) 784-1830

To: Prospective Bidders

This addendum forms a part of the Contract Documents and modifies the original Bidding Documents dated January 2020. Acknowledge receipt of this Addendum in the space provided on the bid form. Failure to do so may subject the Bidder to disqualification.

This Addendum consists of [2] pages, Pre-bid attendance, and [12] 30 x 42 drawings.

## CHANGES TO BIDDING REQUIREMENTS AND CONDITIONS OF THE CONTRACT:

1. Pre-bid attendance attached hereto

## **CHANGES TO SPECIFICATIONS:**

- 2. Section 07 81 00 APPLIED FIREPROOFING
  - a. 2.03, rated systems as follows:
    - i. 1-hour fire rated spray fire proofing UL P742 with 1  $\frac{1}{2}$  of thickness.
    - ii. 2-hour fire rated spray fire proofing UL P742 with 2 ½" of thickness.
- 3. Section 08 51 13 ALUMINNUM WINDOWS
  - a. 2.02, A, 1: Change 4 1/2 to 2 3/4.
- 4. Section 09 30 00 TILING
  - a. 2.02, A: Delete "Satin Brass Anodized". Refer to master Color Schedule for finish of trim.

## CHANGES TO DRAWINGS

- 5. <u>Sheet A090 DEMOLITION PLAN</u> 30 x 42 attached hereto
  - a. Revisions clouded on Drawing
  - b. Keynote 3 should read "REMOVE WALL BELOW WINDOW OPENING TO FOUNDATION."
  - c. Keynote 13 should read "REMOVE EXISTNIG CASEWORK. SALVAGE TO OWNER."
- 6. Sheet A300 SECTIONS 30 x 42 attached hereto
  - a. Revisions clouded on Drawing

- 7. Sheet A400 ENLARGED PLANS 30 x 42 attached hereto
  - a. Revisions clouded on Drawing
- 8. <u>Sheet A600 WALL TYPES</u> 30 x 42 attached hereto
  - a. Revisions clouded on Drawing
  - b. Add Wall Type D7.
- 9. <u>Sheet A601 DOOR SCHEDULE 30 x 42 attached hereto</u>
  - a. Revisions clouded on Drawing
  - b. At doors 114A, 114B, 114C, 114D delete Door Schedule Remark 4. There is no work on these doors.
- 10. Sheet ID101 FINISH FLOOR PLAN 30 x 42 attached hereto
  - a. Revisions clouded on Drawing.
- 11. Sheet ID600 MASTER COLOR SCHEDULE 30 x 42 attached hereto
  - a. Revisions clouded on Drawing
- 12. Sheet M101 MECHANICAL PIPING REMODEL PLAN 30 x 42 attached hereto
  - a. Revisions clouded on Drawing.
  - b. Revised HWS&R piping going to all Radiant Panels (RP).
  - c. Revised RP-1, RP-3, RP-4 and RP-5 lengths.
- 13. Sheet M600 HVAC SCHEDULES 30 x 42 attached hereto
  - a. Revisions clouded on Drawing.
  - b. Revised Radiant Panel Schedule.
  - c. Revised MBH for Cabinet Unit Heater (CUH-2) in Cab Heater Schedule.
- 14. <u>Sheet E090 ELECTRICAL REMOVAL PLAN</u> 30 x 42 attached hereto
  - a. Revisions clouded on Drawing.
- 15. Sheet E100 ELECTRICAL LIGHTING PLAN 30 x 42 attached hereto
  - a. Revisions clouded on Drawing.
- 16. Sheet E101 ELECTRICAL POWER PLAN 30 x 42 attached hereto
  - a. Revisions clouded on Drawing.

## **PRIOR APPROVALS**

1. <u>Section 08 33 23 OVERHEAD COILING DOORS</u>: Overhead Door, FireKing.

## END OF DOCUMENT 00 90 00



Pre-Bid Meeting Sign-In Sheet


January 14, 2020

PROJECT: SCHOOL DISTRICT OF HOLMEN VIKING ELEMENTARY SECURE ENTRY 500 EAST WALL ST. HOLMEN, WISCONSIN 54636 HSR 19022


BID OPENING: 2:00 PM, January 28, 2020

Name Company 1000 American 3. No the ason Ychn KIMP. E BV; Dess Mish Eleconic 5. +B Electric A erel Onon 6 Brick Bros. Inc Diel 7. .. 8. 9. than 10. H+R Electric 11. Brian Frinn <u>12.</u> 13. 14. 15. 16. <u>17.</u> 18. 19.

Page Intentionally Left Blank

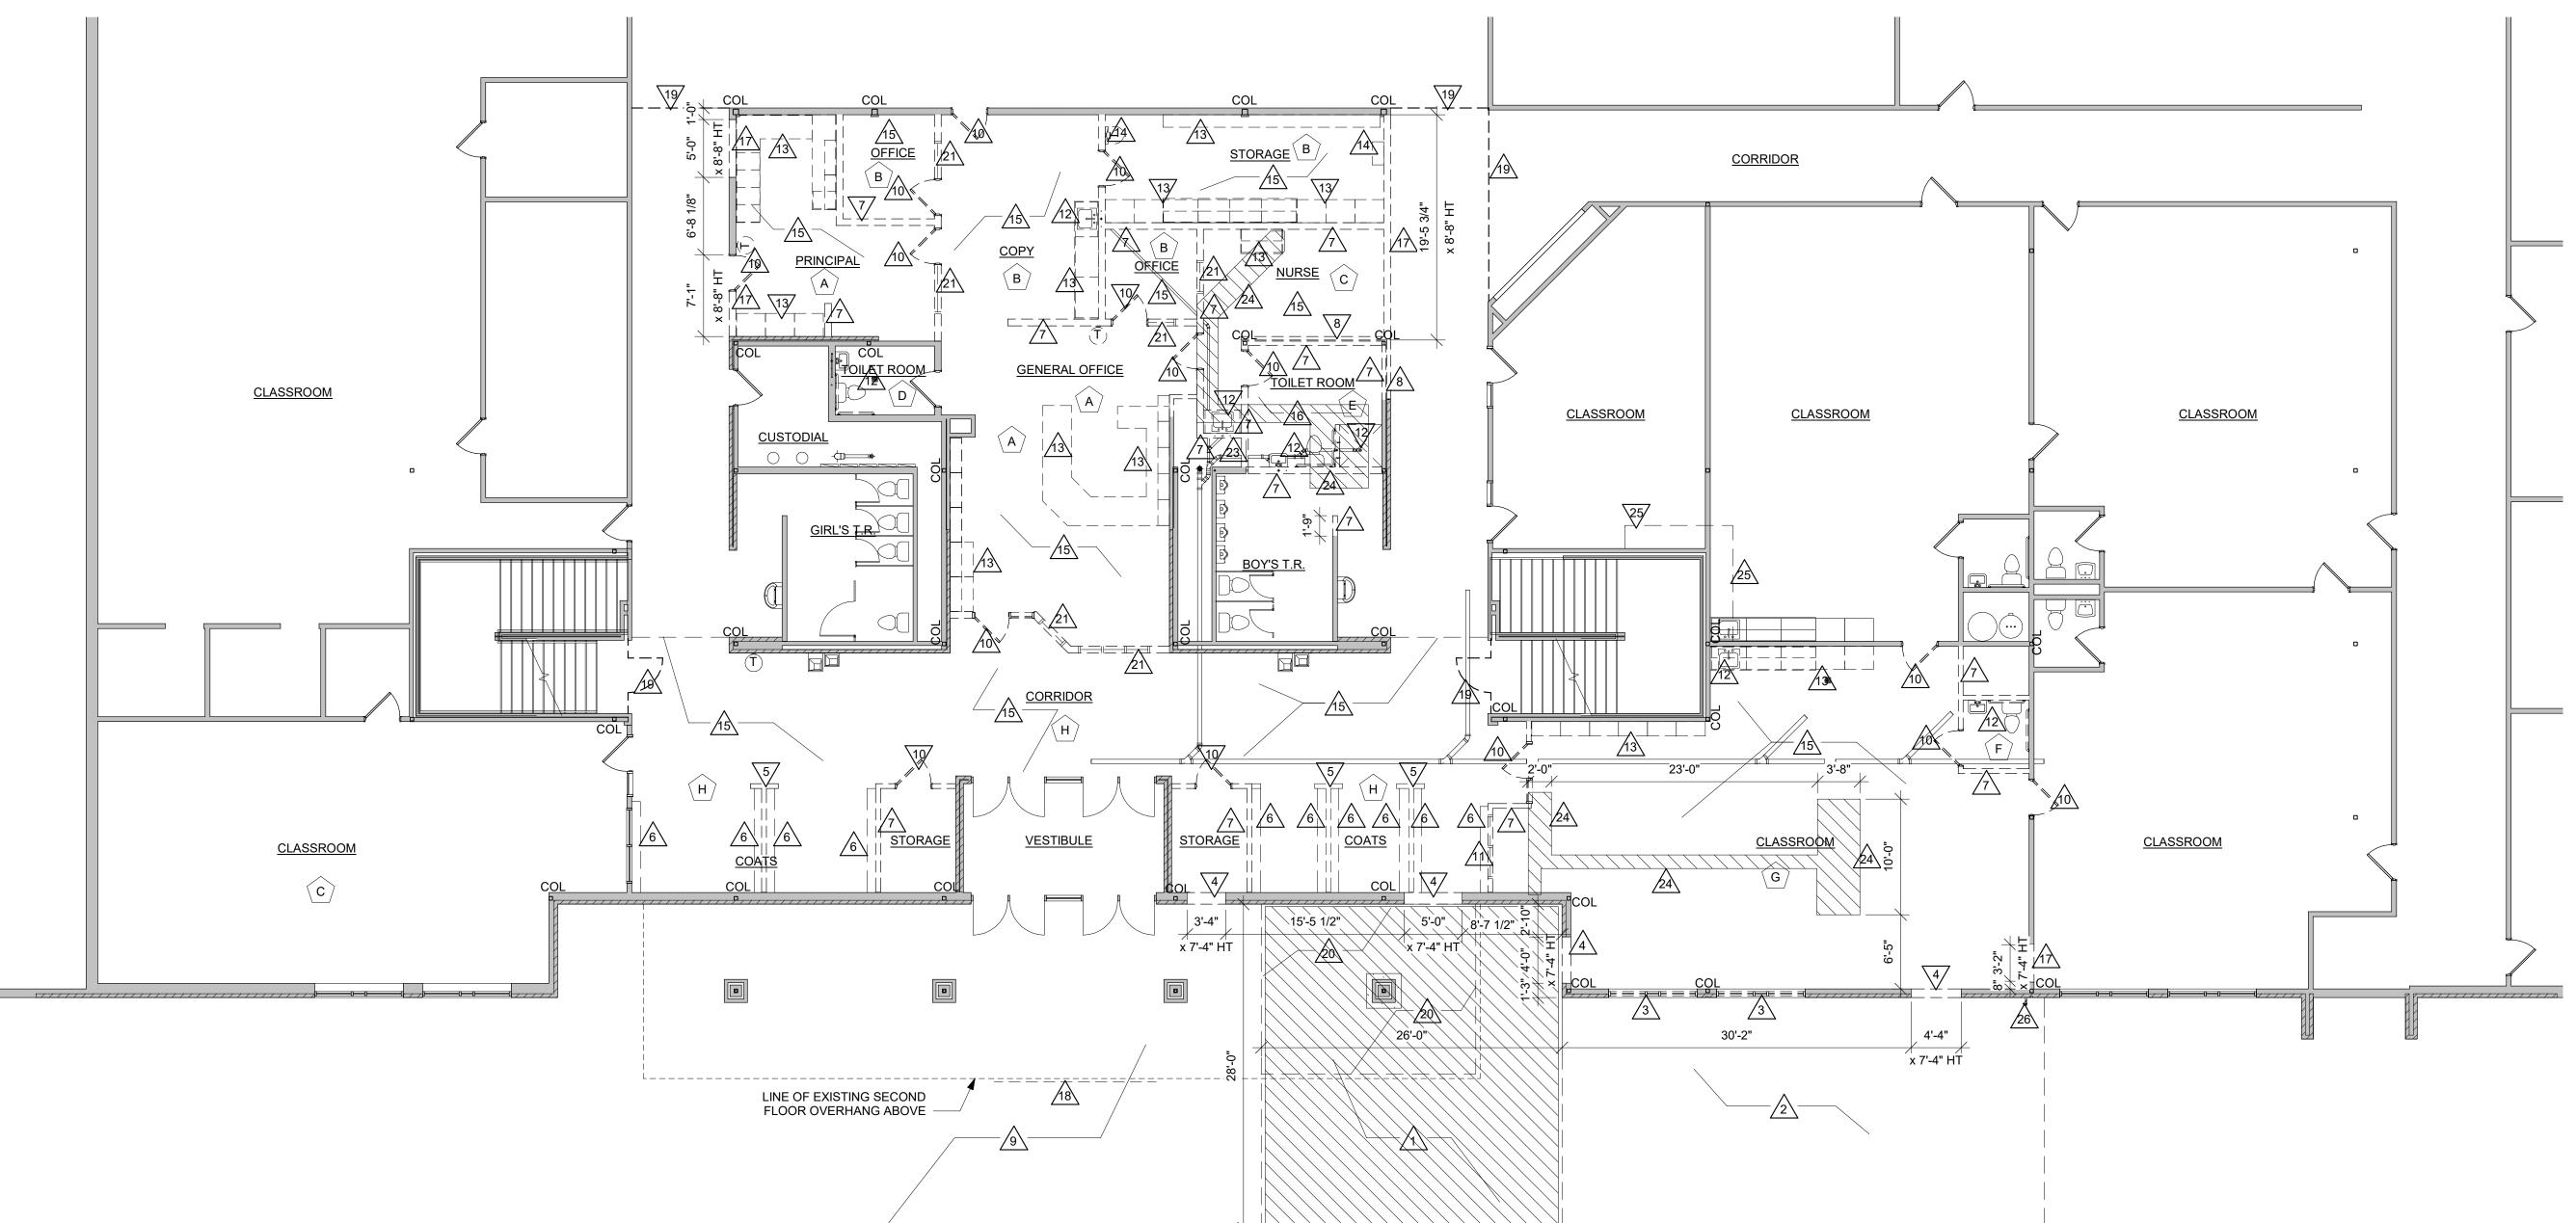



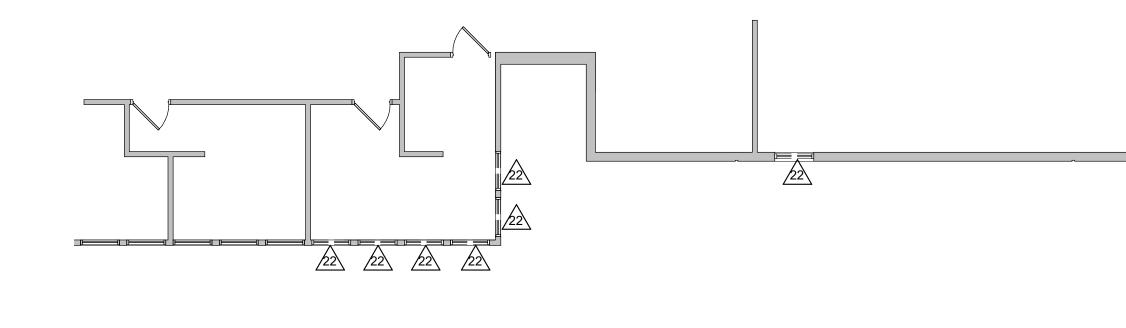




## **DEMOLITION PLAN- SECOND FLOOR** 1/8" = 1'-0"

## **REMOVAL GENERAL NOTES:** A ALL ITEMS SHOWN DASHED ON THIS PLAN SHALL BE COMPLETELY REMOVED FROM THE SITE AND DISPOSED OF BY THE CONTRACTOR UNLESS OTHERWISE NOTED. REFERENCE MEP SHEETS FOR ALL EQUIPMENT REMOVALS AND MODIFICATIONS. TIME AND METHODS SHALL BE COORDINATED WITH AND AGREED TO BY THE OWNER AND ARCHITECT. THIS SHALL INCLUDE ALL ELECTRICAL. MECHANICAL OR PLUMBING WITHIN THE REMOVED STRUCTURE. TERMINATE AND CAP MEP AS REQUIRED. DO NOT ABANDON IN PLACE UNUSED CONDUIT, PIPE, ETC. REMOVE COMPLETELY. VERIFY GENERAL CONDITIONS IN FIELD PRIOR TO BIDDING. B PREPARATION FOR NEW FINISHES SHALL INCLUDE BUT NOT LIMITED TO REMOVAL OF EXISTING FINISHES, REMOVAL OF TAPES, GLUES (MASTIC), NAILS, ETC. PATCHING OF HOLES AND CRACKS TO PROVIDE AN ACCEPTABLE SURFACE FOR NEW FINISH INSTALLATION. OWNER WILL REMOVE LOOSE FURNISHINGS AND EQUIPMENT FROM THE WORK AREA PRIOR TO START OF CONSTRUCTION. CONTRACTORS SHALL BE REQUIRED TO USE EFFECTIVE MEASURES TO AVOID SPREADING/TRACKING DUST AND DEBRIS OUTSIDE THE WORK SPACE. MAINTAIN ALL EXIT DOORS AND CORRIDORS IN UNOBSTRUCTED OPERABLE CONDITION WITH SAFE PASSAGE AWAY FROM THE BUILDING. COORDINATE WITH LOCAL FIRE MARSHAL AS REQUIRED. CONTRACTOR SHALL BE RESPONSIBLE FOR ALL SHORING, BRACING, ETC. AS REQUIRED FOR THE WORK. G SEE MECHANICAL, PLUMBING AND ELECTRICAL SHEETS FOR ADDITIONAL REMOVAL NOTES AND ITEMS. H COORDINATE REMOVAL AND PATCHING WITH MEP DRAWINGS. PATCH TO MATCH EXISTING ADJACENT CONDITIONS. BIDDERS SHALL MAKE EVERY EFFORT TO VERIFY EXISTING CONDITIONS PRIOR TO BIDDING. INSPECTION HOLES, ETC. CAN BE COORDINATED WITH THE OWNER. COORDINATE STORAGE LOCATIONS FOR SALVAGED EQUIPMENT, ACCESSORIES, ETC. WITH THE OWNER. SALVAGED ITEMS SHALL BE PLACED AT A COMMON LOCATION INDICATED BY OWNER. CONTRACTOR TO INSTALL AND MAINTAIN A DUST ENCLOSURE FOR REMOVAL AND NEW CONSTRUCTION WORK. M PROVIDE FLOOR PROTECTION AS SPECIFIED AT DEBRIS REMOVAL PATHS THROUGH BUILDING. N ALL WALLS SHOWN TO BE REMOVED ARE CONSTRUCTED FROM FLOOR TO DECK ABOVE, UNLESS OTHERWISE NOTED. **REMOVAL PLAN LEGEND:** COL EXISTING COLUMN TO REMAIN SYMBOL INDICATES CONSTRUCTION NOTE THIS SHEET SYMBOL INDICATES FININSH REMOVAL NOTES THIS SHEET - --- REMOVE ITEMS NOTED WITH DASHED LINES - \_\_\_ \_\_ ==== SYMBOL INDICATES REMOVAL OF DOOR AND FRAME UNLESS NOTED OTHERWISE AREA OF CONCRETE SLAB REMOVAL

VWB VINYL WALL BASE VCT VINYL COMPOSITION TILE CPT CARPET

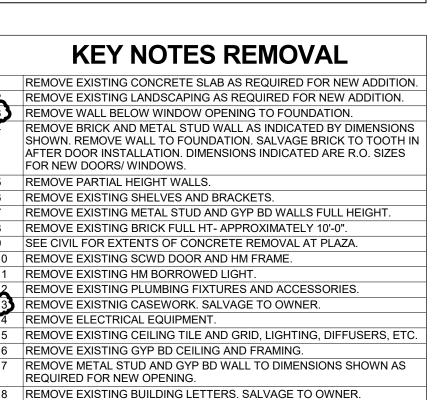

PROVIDE EGESS DOORS AT STAIR LOCATIONS. REMOVE PLASTER CEILING ABOVE AS REQUIRED FOR NEW EXTERIOR WALLS AND FIRE PROOFING. REMOVE EXISTING HM BORROWED LIGHTS. REMOVE EXISTING ALUMINUM FRAME WINDOWS AND SILLS. REMOVE EXISTING PLUMBING ACCESS PANEL. REMOVE EXISTING CONCRETE SLAB FOR TRENCHING. COORDINATE EXACT LOCATIONS WITH PLUMBING. CAREFULLY REMOVE EXISTING CEILING TILE AND GRID AS REQUIRED FOR ABOVE CEILING WORK. REPLACE WHEN WORK IS COMPLETE.


REMOVE EXISTING WALL HYDRANT- SEE PLUMBING.


FINISH REMOVAL NOTE
CARPET, VWB, BRICK/ GYP BD, 2x2 ACT
CARPET, VWB, GYP BD 2x2 ACT
VCT, VWB, GYP BD, 2x2 ACT
PORCELAIN TILE, PORCELAIN TILE, PORCELAIN TILE, GYP
PORCELAIN TILE,, PORCELAIN TILE, GYP BD, GYP BD

CPT/VCT, VWB, GYP BD, 2x4 ACT


TERRAZO, BRICK/VWB, GYP BD/BRICK, 2x4 ACT




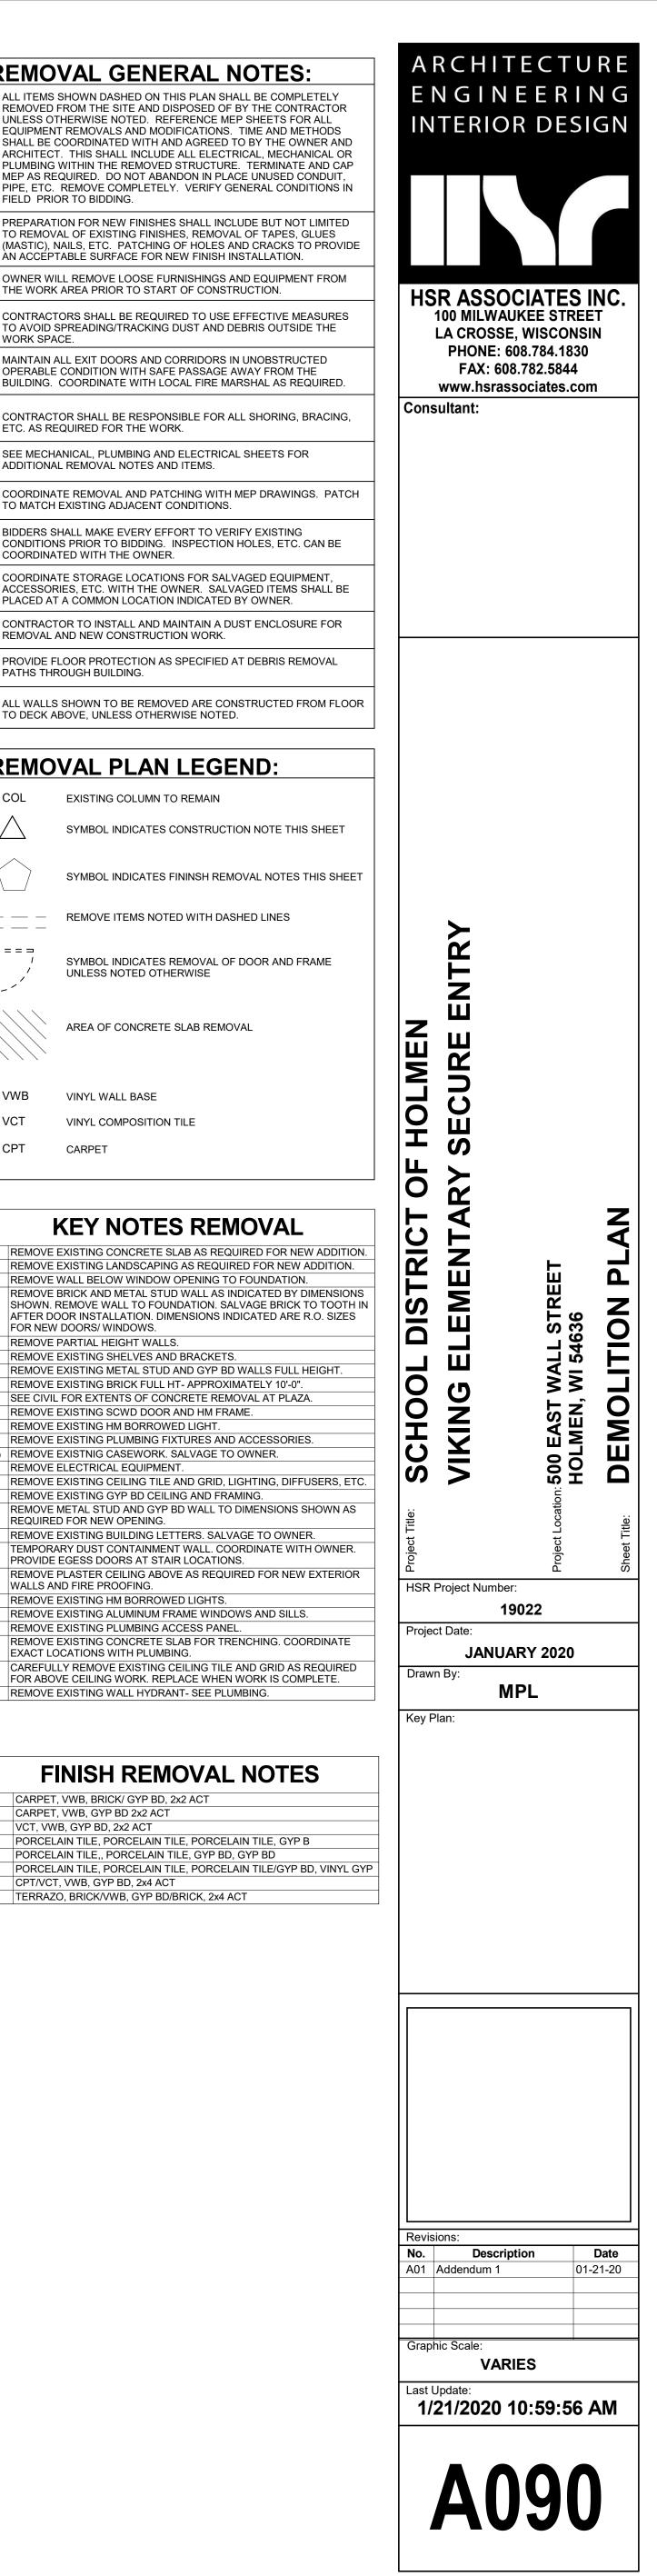


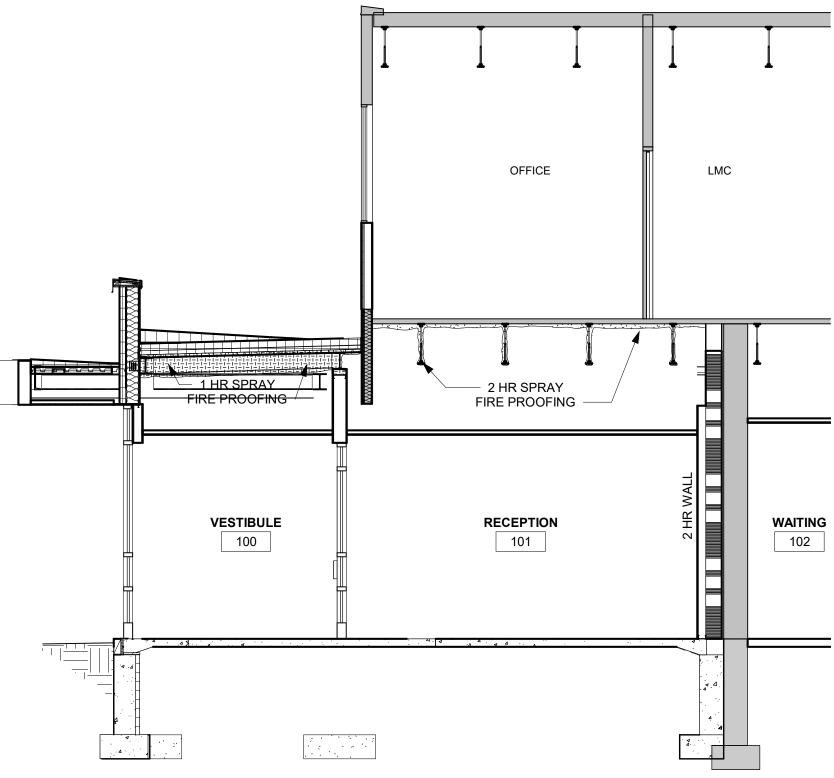




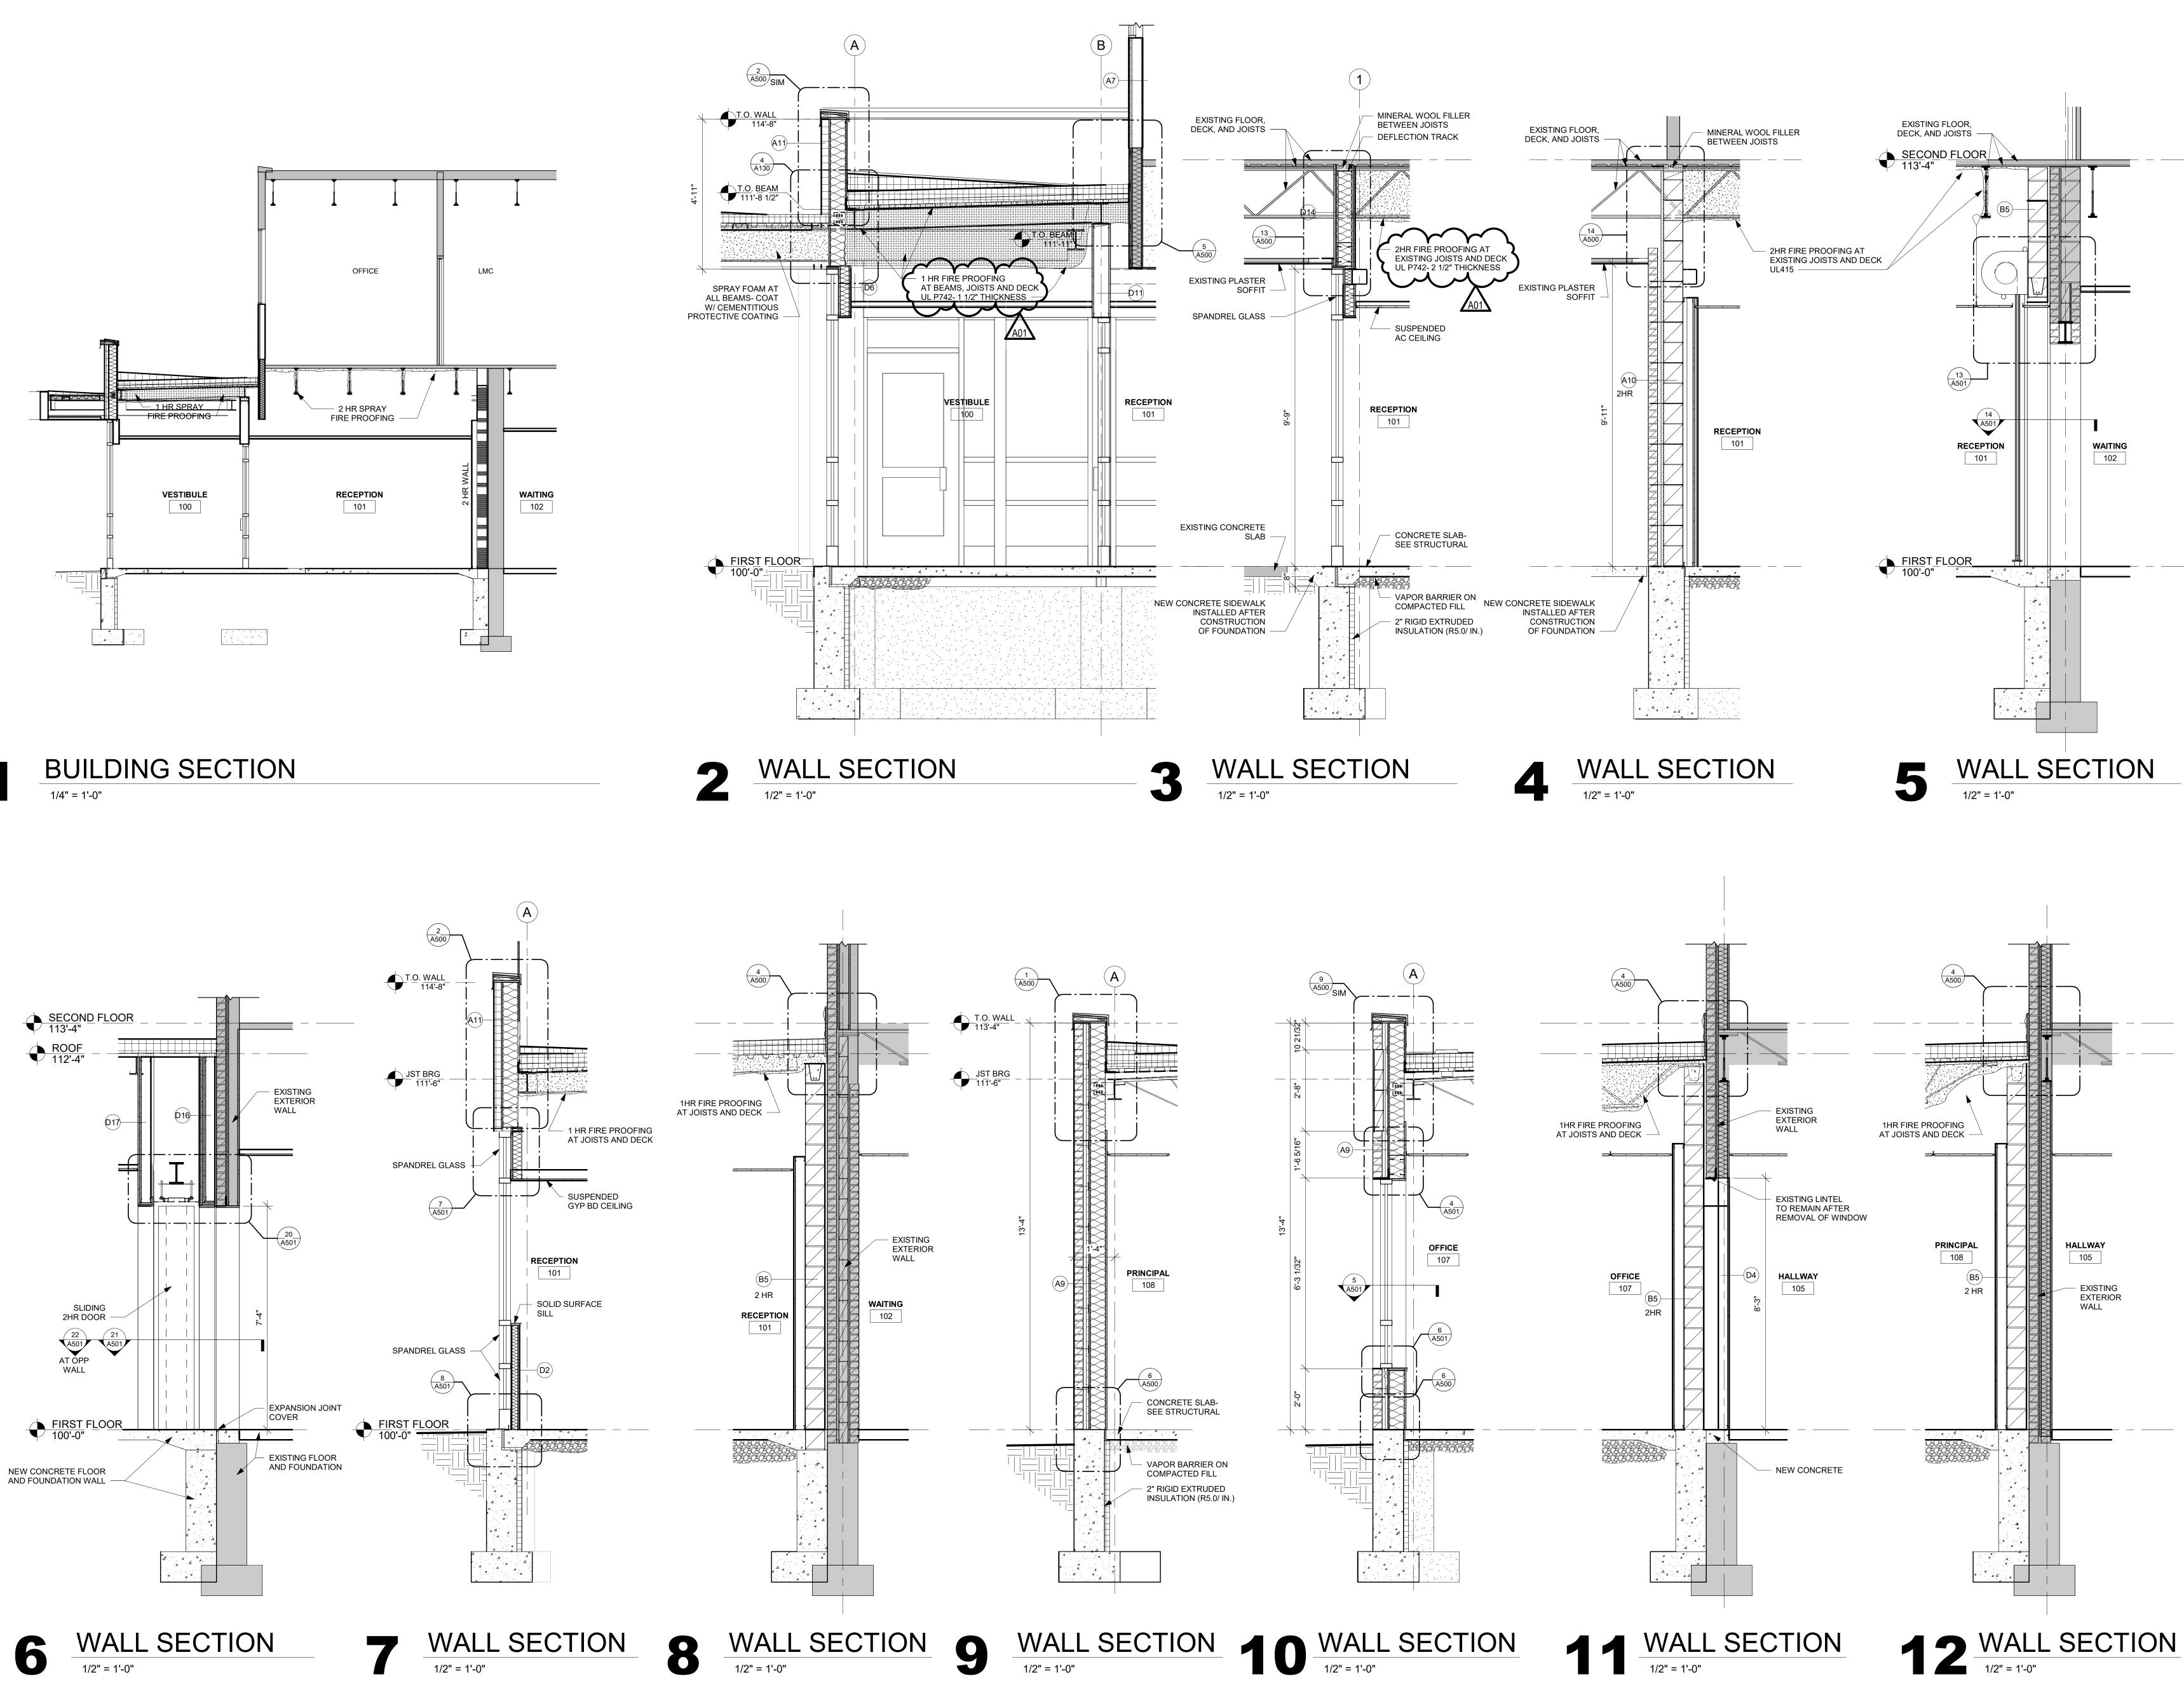


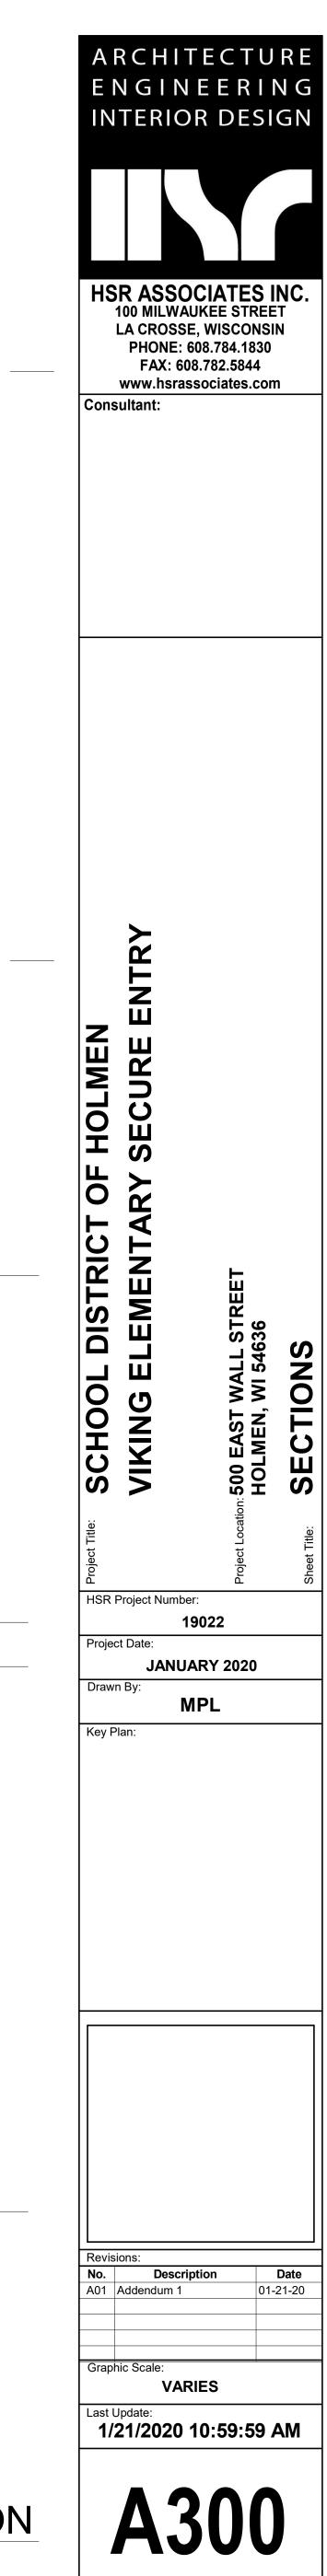

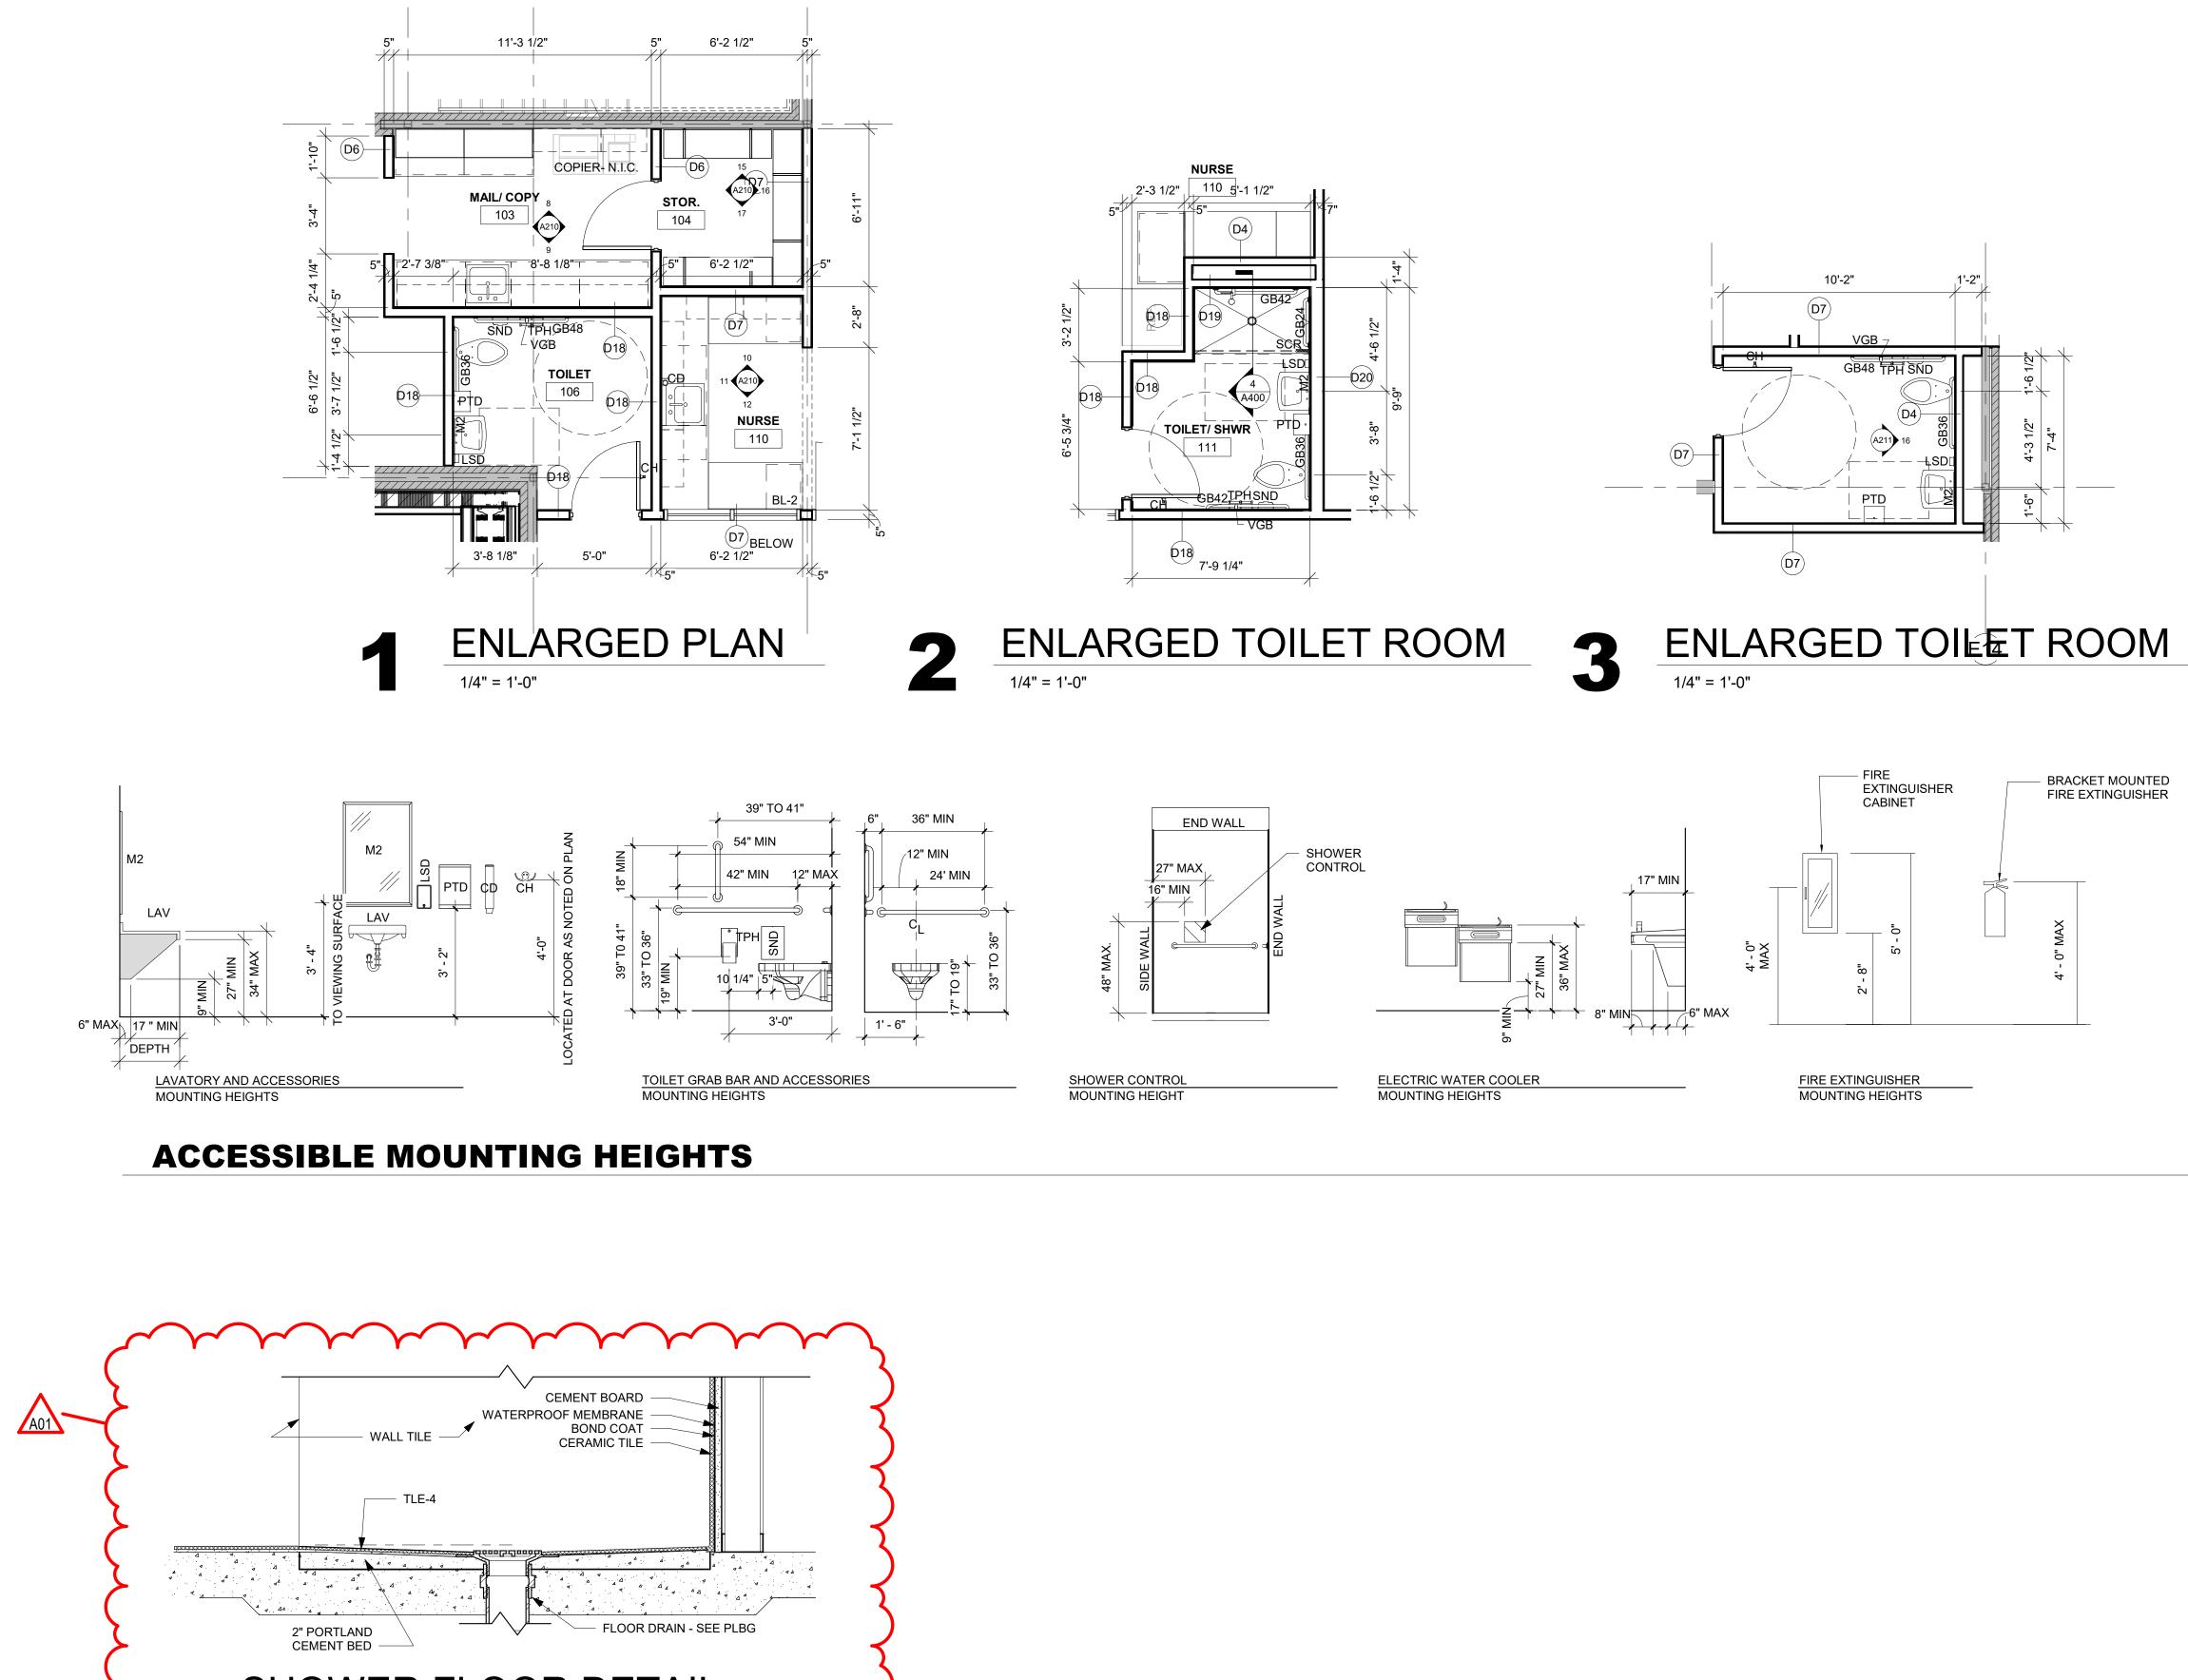


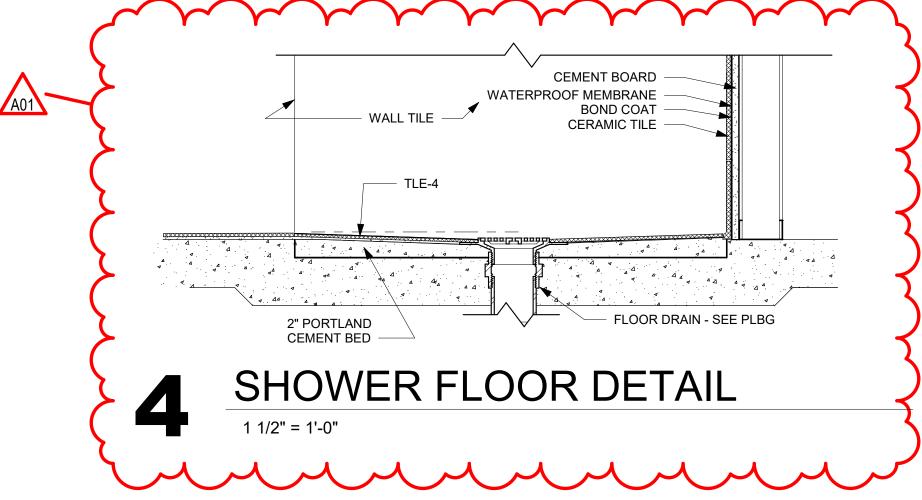

ACCESSORY SCHEDULE					CONTRAC. INSTALLED
ABBREVIATION	ITEM				
CD	CUP DISPENSER	X			x
СН	COAT HOOK (DOUBLE)		x		x
GB-36	1 1/2" DIA. GRAB BAR- 36" LONG- SEE PLAN FOR CONFIGURATION		x		x
GB-48	1 1/2" DIA. GRAB BAR- 48" LONG- SEE PLAN FOR CONFIGURATION		x		x
LSD	LIQUID SOAP DISPENSER	X			x
M2	18"W x 36"H MIRROR WITH FRAME		x		х
PTD	PAPER TOWEL DISPENSER	X			x
SCR	SHOWER CURTAIN AND ROD	x			x
SND	SANITARY NAPKIN DISPOSAL- SURFACE MOUNT		x		х
TPH	TOILET PAPER HOLDER	X			х
VGB-18	1 1/2" DIA. VERTICAL GRAB- 18" LONG		x		х
ACCESSORY SCH	IEDULE GENERAL NOTES:				
<ol> <li>SEE ELEVATIONS FOR MOUNTING HEIGHTS.</li> <li>CONFIRM EXACT LOCATION OF EACH ACCESSORY WITH OWNER PRIOR TO INSTALLATION.</li> <li>SURFACE MOUNTED ACCESSORIES SHALL BE INSTALLED OVER WALL TILE.</li> <li>PROVIDE INSULATION WRAP AT EXPOSED PIPING AT SINKS WHERE NO OTHER PROTECTION IS PROVIDED</li> <li>COORDINATE ALL OWNER PROVIDED FIXTURES FOR BLOCKING, MOUNTING HEIGHTS, POWER AND PLUMBING REQUIREMENTS.</li> <li>INSTALL BLOCKING AT ALL WALL MOUNTED ACCESSORIES.</li> </ol>					

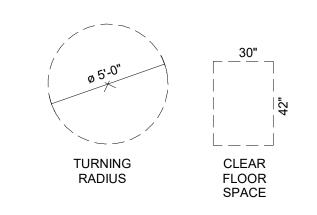



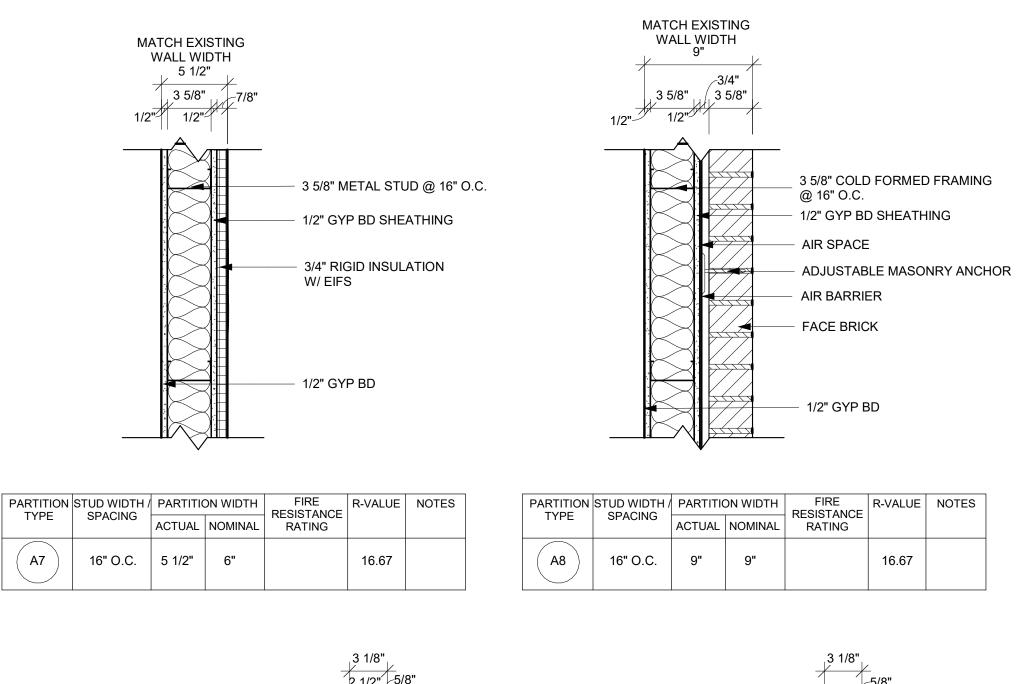


(A7)	16" O.C.	5 1/2"	6"		16.67		<b>A8</b>
				7	3 1/8" 2 1/2" 5/	8"	

3 1/8" 5/8"	
	——5/8" GYP BD 2 1/2" METAL STUD @ 24" O.C. — 2 1/2" BATT INSULATION

		<u> </u>				
	STUD WIDTH /	PARTITION WIDTH		FIRE RESISTANCE	UL #	STC
TYPE	SPACING	ACTUAL	NOMINAL	RATING		RATING

-	STUD WIDTH /	PARTITIC	ON WIDTH	FIRE RESISTANCE	U
TYPE	SPACING	ACTUAL	NOMINAL	RATING	
D3	16" O.C.	3 1/8"	3"		

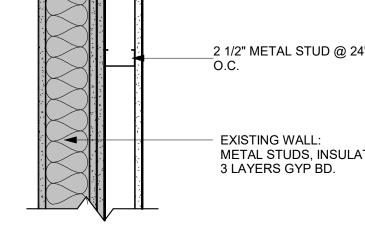

-5/8" GYP BD

METAL STUD @ 24"	
TING WALL: AL STUDS, INSULATION, 'ERS GYP BD.	

		PARTITION WIDTH		FIRE RESISTANCE	UL #	
TYPE	SPACING	ACTUAL	NOMINAL	RATING		RATIN
	16" O C	3 1/8"	3"			

STC		STUD WIDTH /	PARTITIC	ON WIDTH
ATING	TYPE	SPACING	ACTUAL	NOMINAL
84	<b>D3</b>	16" O.C.	3 1/8"	3"

PARTITION TYPE	STUD WIDTH / SPACING	PARTITION WIDTH		FIRE RESISTANCE	UL #	
TTPE		ACTUAL	NOMINAL	RATING		RATING
D2	16" O.C.	3 1/8"	3"			84

	RTITION STUD WIDTH / PARTITION WIDTH		FIF
TYPE SPACING	ACTUAL	NOMINAL	RESIST RAT
D3 16" O.C.	3 1/8"	3"	

	ION STUD WIDTH / PARTITION WIE SPACING ACTUAL NOMI	ON WIDTH	WIDTH FIRE RESISTANCE		STC	
TYPE		ACTUAL	NOMINAL	RATING		RATING
D2	16" O.C.	3 1/8"	3"			84


7 1/4"	5/8"	
-^		—5/8" GYP BD
•		—6" METAL STU
		—5/8" GYP BD
-^		

—6" METAL STUD @ 16" O.C.

7 1/4" 5/8" 6" 5/8"	
	—5/8" GYP BD
	—6" METAL STUD @ 16" O.C.
	- SOUND ATTENUATION BLANKET
	—5/8" GYP BD


	STUD WIDTH /	PARTITIC	ON WIDTH	FIRE RESISTANCE	UL #	- • •
TYPE	SPACING	ACTUAL	NOMINAL	RATING		RATING
D10	16" O.C.	7 1/4"	7"			

ACTUAL NOMINAL RATING		STUD WIDTH /	PARTITIC	ON WIDTH	FIRE RESISTANCE	UL #	STC
	TYPE	SPACING	ACTUAL	NOMINAL	-		RATING
	D11	16" O.C.	7 1/4"	7"			47

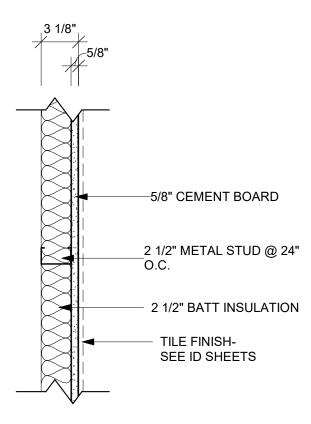

$\smile$							
	_/	1/4" 6" 5/8"	-				,
				5/8" GYP BD			
				–6" METAL ST	UD @	2 16" O.C	'-
				SOUND ATTE	INUA	FION BL/	ANKET
			L	-5/8" CEMENT	BOA	RD	
			<b>▲</b>	TILE FINISH- SEE ID SHEE	TS		
		v					


TYPE SPACII			FIRE	UL #	-			PARTITI	ON WIDTH	FIRE RESISTANCE	UL #	STC
		NOMINAL	RATING		RATING	TYPE	SPACING	ACTUAL	NOMINAL	RATING		RATING
D19 16" C	.C. 3 1/8"	3"				D20	16" O.C.	7 1/4"	7"			47

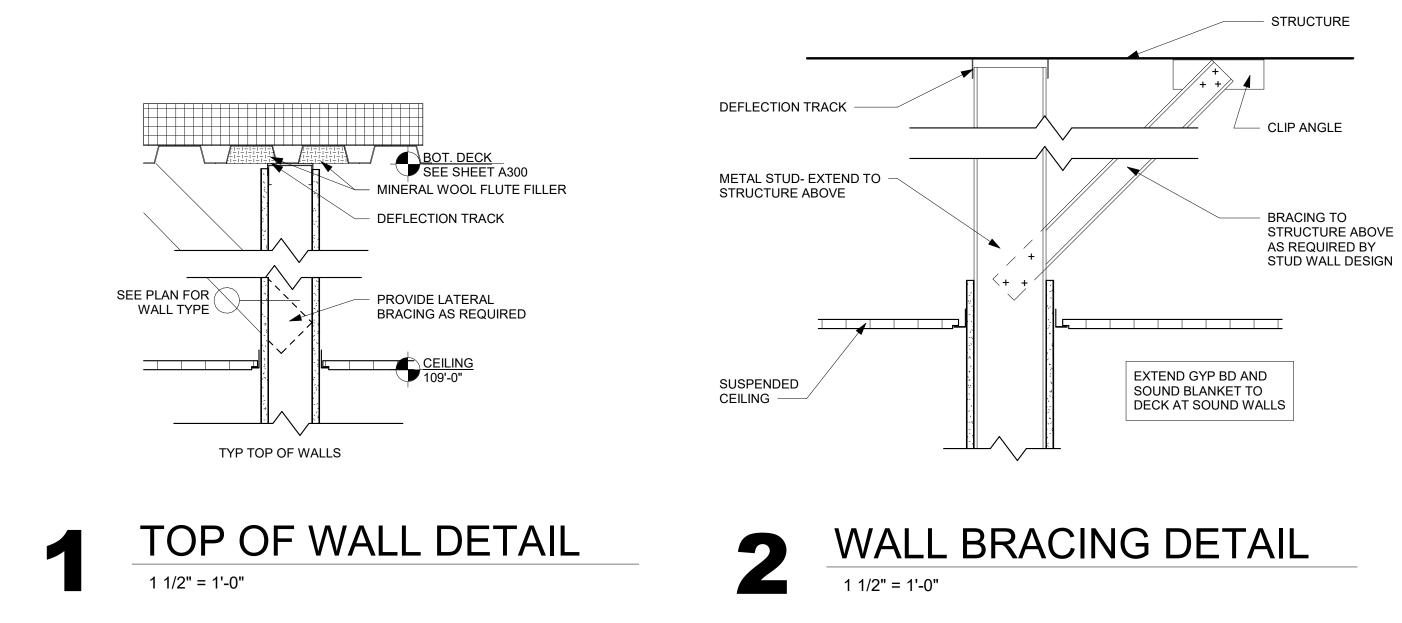


ACTUAL NOMINAL RATING ACTUAL NOMINAL RATING ACTUAL NOMINAL RATING ACTUAL	-		PARTITI	ON WIDTH	FIRE RESISTANCE	R-VALUE	-	STUD WIDTH /	PARTITI	ON WIDTH	FIRE RESISTANCE	R-VALUE	-	STUD WIDTH	PARTITI	л ис
	ITPE	SPACING	ACTUAL	NOMINAL			ITPE	SPACING	ACTUAL	NOMINAL			ITPE	SPACING	ACTUAL	NO
	D14	16" O.C.	8 1/2"	8"		21.93	D15	16" O.C.	6 1/8"	6"			D16	16" O.C.	6 1/8"	


						_							_				
	STUD WIDTH /	PARTITIC	N WIDTH	FIRE RESISTANCE	R-VALUE		-	STUD WIDTH /	PARTITIC	ON WIDTH	FIRE RESISTANCE	R-VALUE				PARTITIC	NC
TYPE	SPACING	ACTUAL	NOMINAL	RATING			TYPE	SPACING	ACTUAL	NOMINAL				TYPE	SPACING	ACTUAL	NC
D14	16" O.C.	8 1/2"	8"	2 hr UL- V419	21.93		D15	16" O.C.	6 1/8"	6"	2 hr UL- V419			D16	16" O.C.	6 1/8"	


PARTITION TYPE	STUD WIDTH / SPACING	PARTITIC	ON WIDTH	FIRE	R-VALUE	]	PARTITION	STUD WIDTH		ON WIDTH	FIRE	R-VALUE	]	PARTITION TYPE	STUD WIDTH / SPACING	PARTIT
TIPE	SPACING	ACTUAL	NOMINAL	RATING			ITPE	SPACING	ACTUAL	NOMINAL	RATING			TTPE	SPACING	ACTUAI
				2 hr							2 hr					

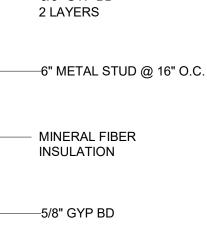

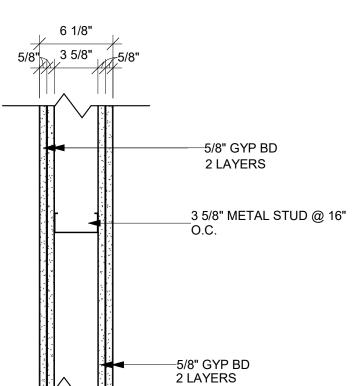



TYPE     SPACING     ACTUAL     NOMINAL     RESISTANCE RATING     RATING       D5     16" O.C.     4 1/4"     4"     4"	-	STUD WIDTH /	PARTITIC	ON WIDTH	FIRE RESISTANCE	UL #	STC
D5 16" O.C. 4 1/4" 4"	TTPE	SPACING	ACTUAL	NOMINAL	-		RATING
	D5	16" O.C.	4 1/4"	4"			

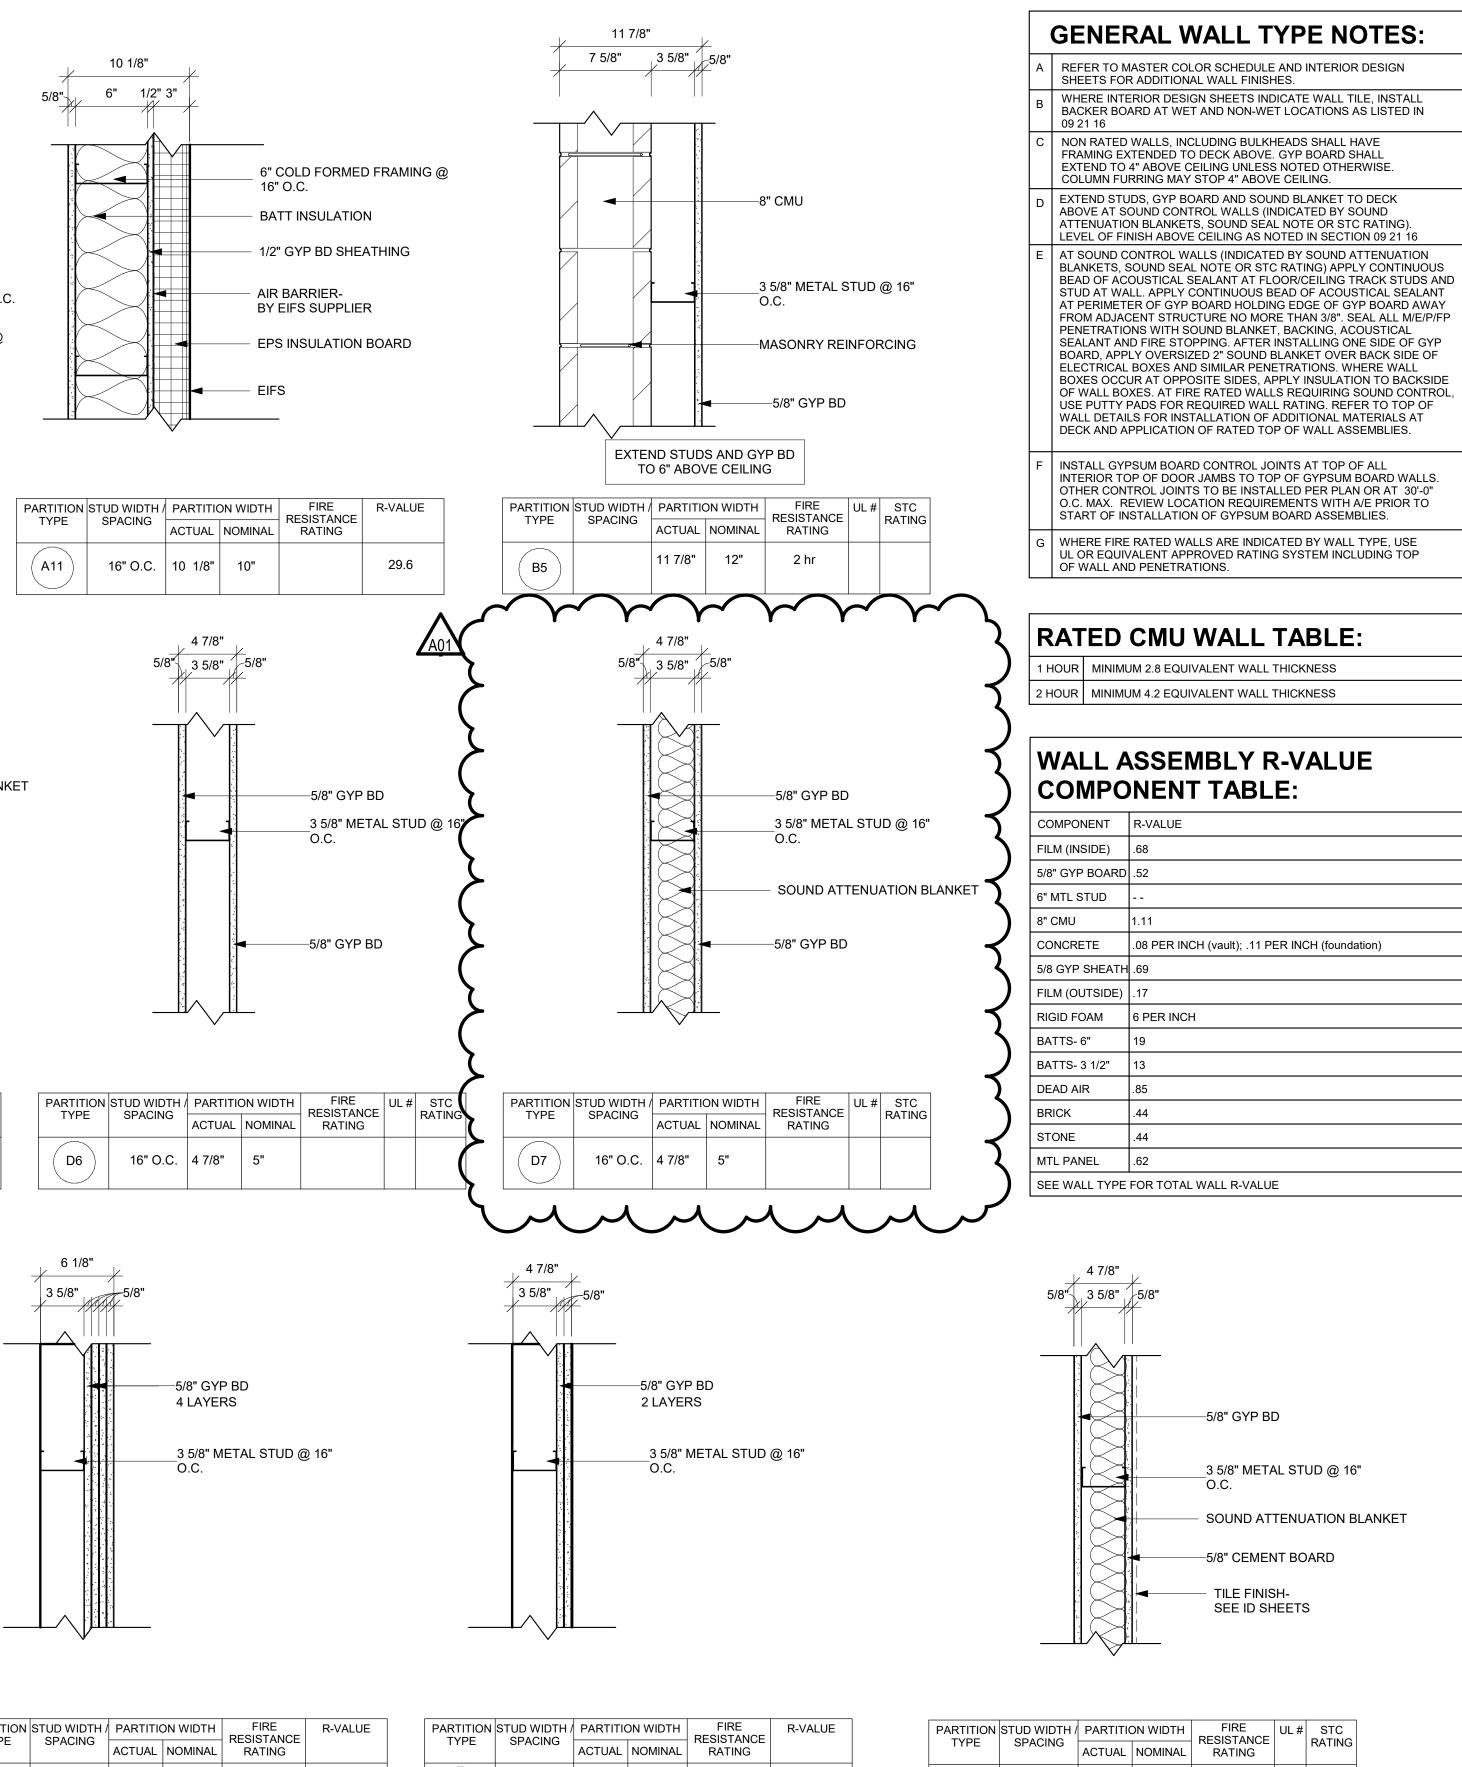


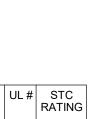

	STUD WIDTH /	PARTITIC	ON WIDTH	FIRE RESISTANCE	UL #	-
TYPE	SPACING	ACTUAL	NOMINAL	RATING		RATING
<b>D4</b>	16" O.C.	4 1/4"	4"			

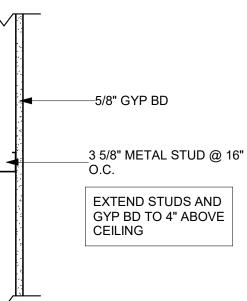

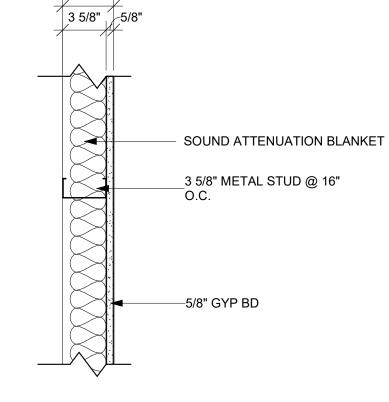

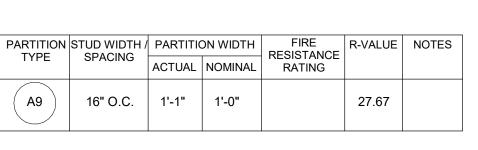

8 1/2"

6"

5/8"

4 1/4"


3 5/8" 5/8"

1'-1"


5/8"-

1 1/4"

6" <u>1</u>" 3 5/8"

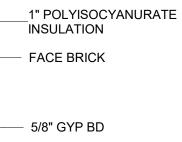

6" COLD FORMED FRAMING @ 16" O.C. 1/2" GYP BD SHEATHING AIR BARRIER AIR SPACE ADJUSTABLE MASONRY ANCHOR

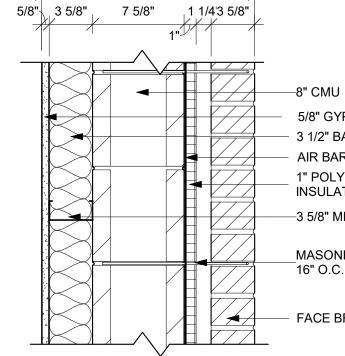

PARTITION STUD WIDTH / PARTITION WIDTH / FIRE R-VALUE

1'-5 3/4" 1'-6"

ACTUAL NOMINAL RATING

4 1/4"

TYPE

(A10)

SPACING

RESISTANCE

2 hr

23.94

1'-5 3/4"

5/8" GYP BD - 3 1/2" BATT INSULATION AIR BARRIER 1" POLYISOCYANURATE INSULATION —3 5/8" METAL STUD @ 16" O.C. MASONRY REINFORCING @ 16" O.C. VERTICAL FACE BRICK

	/	10 1/0						
/ 3"/ /	¥	6"	1/2"	3'				
				Y				
		$\geq$		-				
		$\leq$						
		$\overline{\langle}$						
			<u> </u>					

2 hr

UL- V497


6"


(D17)

16" O.C. | 4 7/8" | 5"


(D18)


16" O.C. | 4 7/8" | 5"

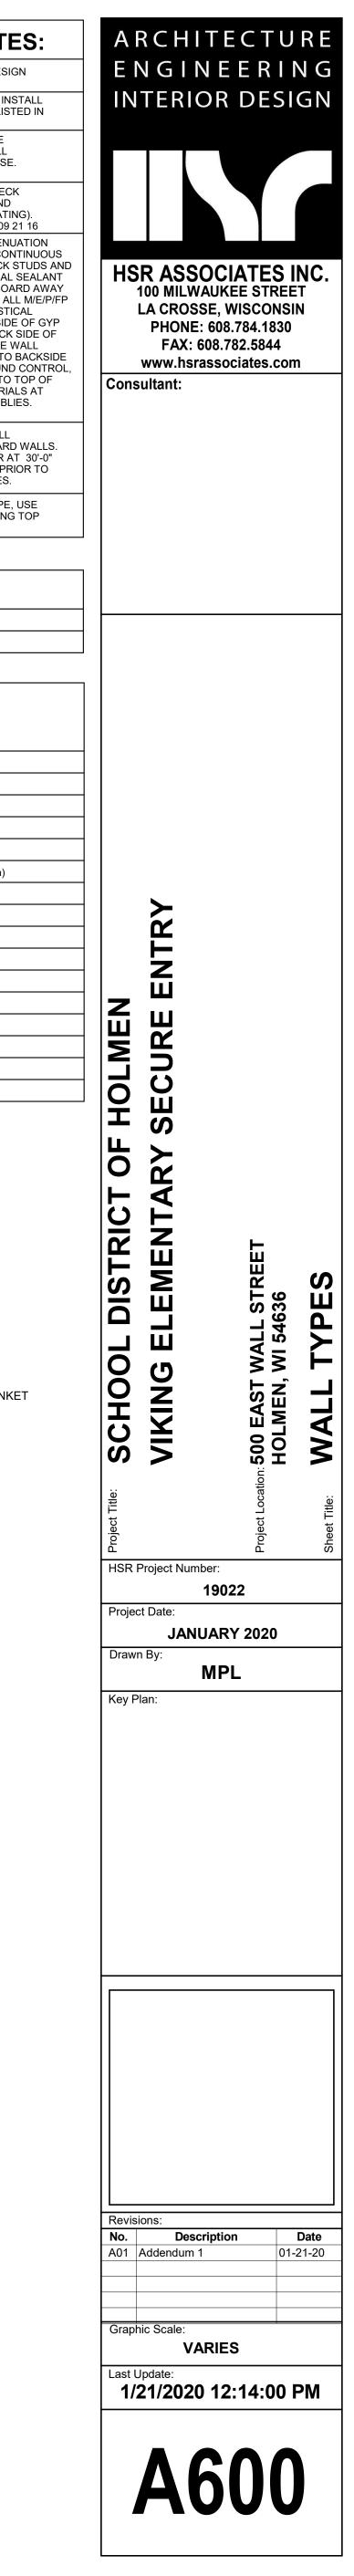


 

								DOOR	SCHEDUL	E					
				DOC	DR					FRA	ME				
		SIZE					U-CUT					DETAILS			
DOOR NO.	W	Н	т	MAT'L	DOOR TYPE	GLASS TYPE	OR LOUVER	MAT'L	FRAME ELEV	DEPTH	HEAD	JAMB	SILL	FIRE LABEL	HDWR GROUP REMARKS
100A	3' - 0"	7' - 0"	1 3/4"	ALUM	E	GLT-12		ALUM	7A200	4 1/2"					1 1,2
100B	3' - 0"	7' - 0"	1 3/4"	ALUM	E	GLT-4		ALUM	9A200	4 1/2"	3A501				1 1,2
101A	5' - 0"	8' - 8"		COILING FIRE DR	G			STL			13A501	14A501			6,7
101B	4' - 0"	7' - 4"	1' - 2"	ACCORDIAN FIRE DR							20A501	21&22A501		90 Minute Fire Rating	3
102	3' - 0"	7' - 0"	1 3/4"	SCWD	A			НМ	JJ						2
104	3' - 0"	7' - 0"	1 3/4"	SCWD	A			HM	AA	5 7/8"	1A501				3
105	3' - 0"	7' - 0"	1 3/4"	SCWD	A			HM	AA	6 3/4"	2A501				4 5
106	3' - 0"	7' - 0"	1 3/4"	SCWD	A		3/4" U-CUT	HM	AA	5 7/8"	1A501				5
107A	3' - 0"	7' - 0"	1 3/4"	SCWD	С	GLT-21		HM	BB	5 3/4"	9A501	10&11A501	12A501	90 MIN	6 8
107B	3' - 0"	7' - 0"	1 3/4"	SCWD	В	GLT-4		HM	AA	8 1/4"	1A501				12
108	3' - 0"	7' - 0"	1 3/4"	SCWD	С	GLT-21		HM	BB	5 3/4"	9A501	10&11A501	12A501	90 MIN	6 8
109	3' - 0"	7' - 0"	1 3/4"	SCWD	С	GLT-21		HM	BB	5 3/4"	9A501	10&11A501	12A501	90 MIN	6 8
110	3' - 0"	7' - 0"	1 3/4"	SCWD	A			HM	GG	5 7/8"	1A501				7
111	3' - 0"	7' - 0"	1 3/4"	SCWD	A		3/4" U-CUT	HM	AA	5 7/8"	1A501				5
112	3' - 0"	7' - 0"	1 3/4"	SCWD	A			HM	КК	5 7/8"	1A501				7
113A	3' - 0"	7' - 0"	1 3/4"	IHM	A			НМ	BB	5 3/4"	15A501	16A501	17A501		9
113B	3' - 0"	7' - 0"	1 3/4"	SCWD	A			НМ	AA	5 7/8"	1A501				8
114A	3' - 0"	7' - 0"	1 3/4"	EXISTG ALUM											
114B	3' - 0"	7' - 0"	1 3/4"	EXISTG ALUM											
114C	3' - 0"	7' - 0"	1 3/4"	EXISTG ALUM											
114D	3' - 0"	7' - 0"	1 3/4"	EXISTG ALUM											10
119	3' - 0"	7' - 0"	1 3/4"	SCWD	A			PNT sable	GG	5 7/8"	1A501				7
120	3' - 0"	7' - 0"	1 3/4"	SCWD	A		3/4" U-CUT	НМ	AA	5 7/8"	1A501				5
121	3' - 0"	7' - 0"	1 3/4"	EXISTG SCWD	A			EXISTG HM	AA						11 4

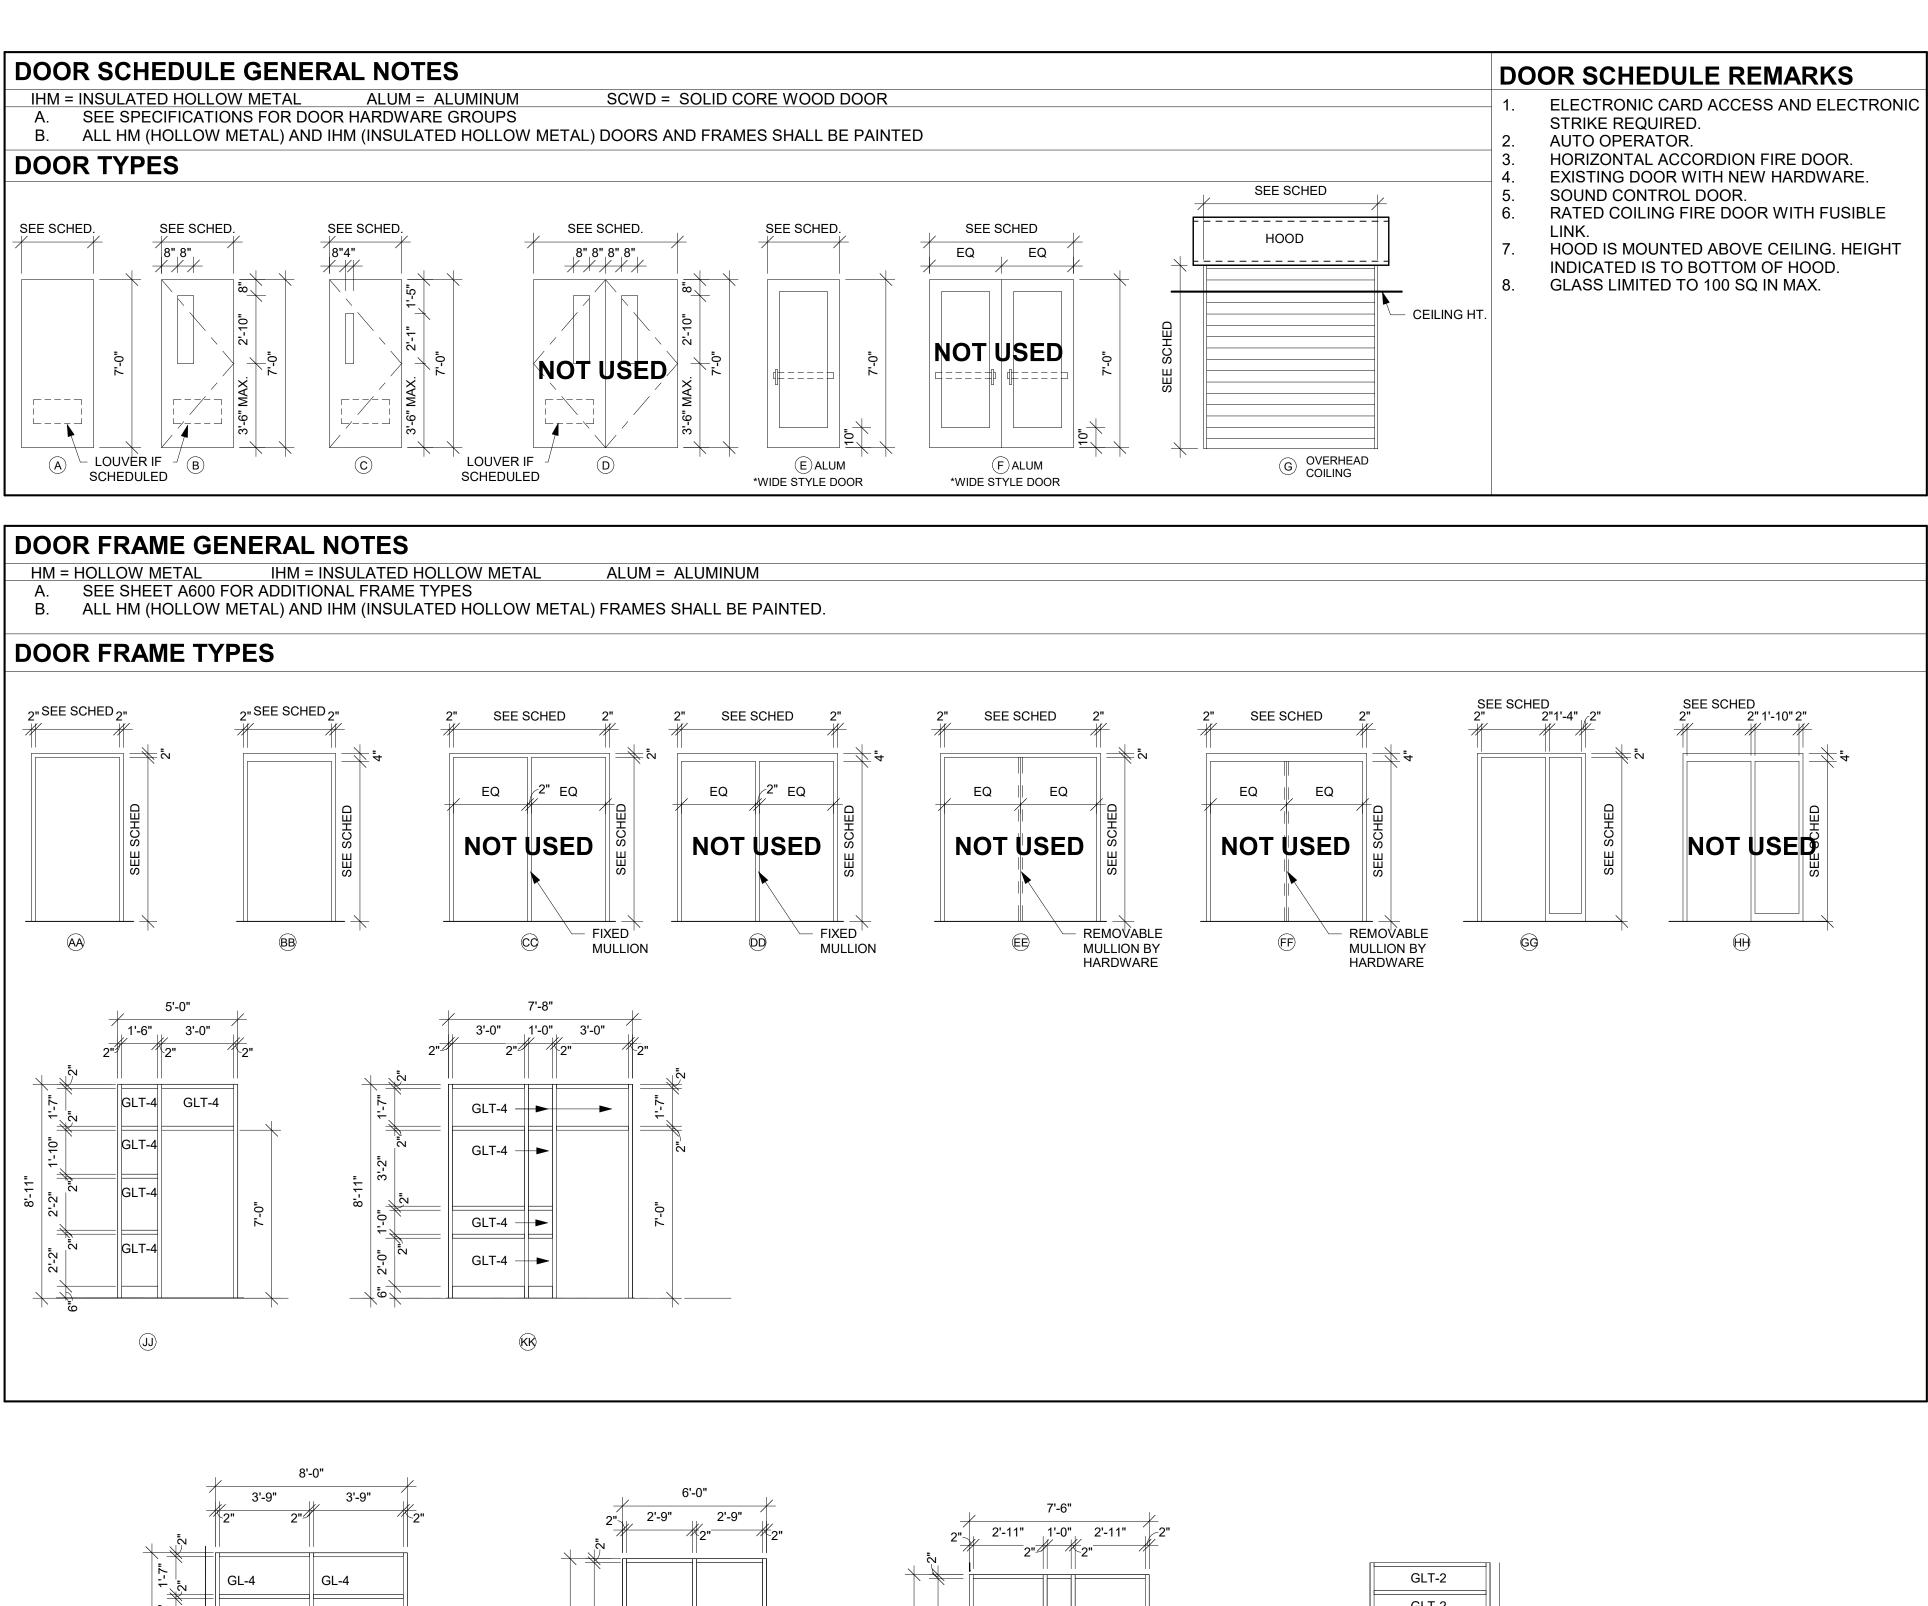

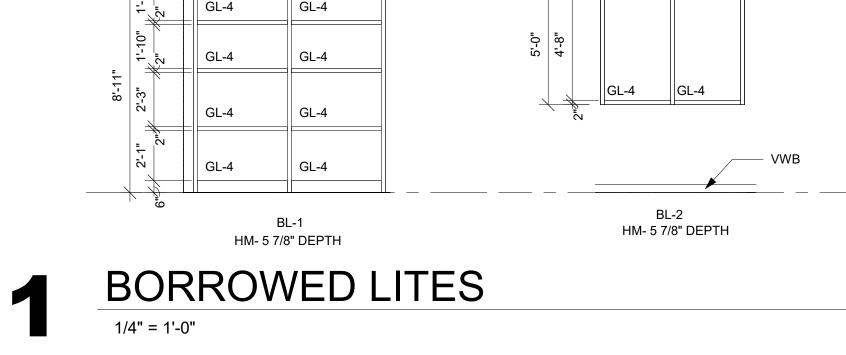

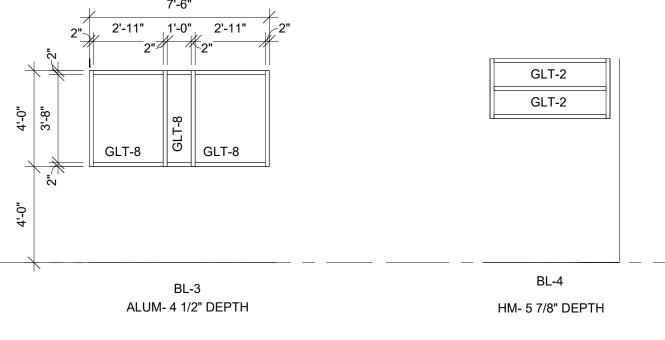








	INTERIOR	GENE	<b>&gt;</b>	
A	REFERENCES TO PA BE IDENTIFIED IN TH	INT PERTAIN TO	COLOR O	nly; paint
В	PNT-1 FIELD PAINT; A	ACCENT PAINT A	S INDICAT	ED. SEE ID S
с	REFER TO MASTER SPECIFICATIONS, AI			
D	TOILET ROOM WALL PATTERN THROUGH			
E	VINYL COMPOSITE E AREAS; REFER TO II TO PROTECT FINISH	D SHEETS. INST	ALL APPRO	OPRIATE ED
F	AT DISSIMILAR FLOO CENTER OF DOOR.			
	FINISH KE	OOM FINISH R		
/	—PNT-X— ACCEI	NT PAINT		
	FINISH LE	GEND:		
	TLE-1		LVT-1	
	TLE-4			
1	ROOI PAINT ALL WALLS F			
3	FLOORING TO CON		ASEWORK	

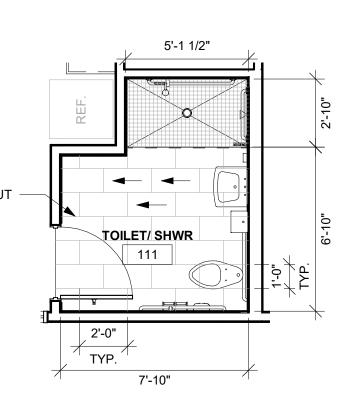


ALIGN FLOOR GROUT -LINES WITH WALL GROUT LINES




ENLARGED TILE PATTERN



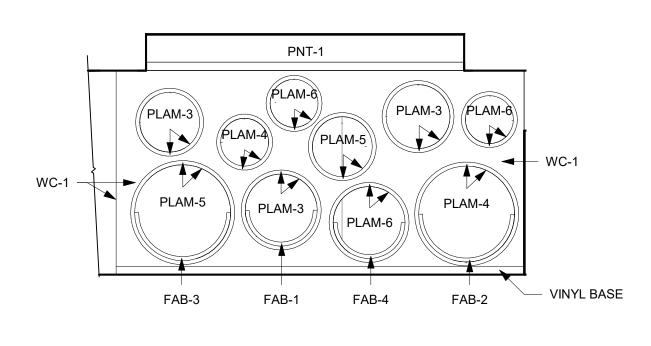




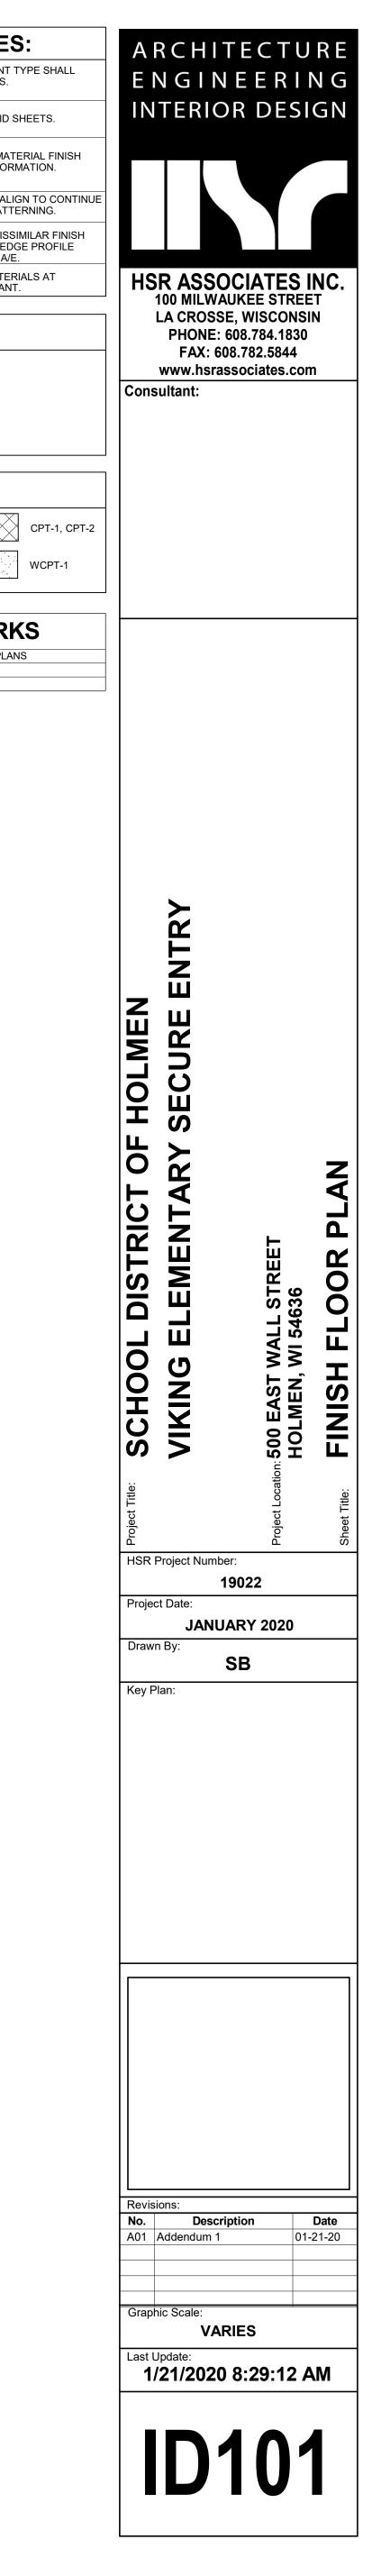






				MAS	STER COLOR SCHEDULE						
MAN	UFACTURER / COLOR	GENERAL LOCATION	REMARKS	MANUFAG	CTURER / COLOR	GENERAL LOCATION	REMARKS	MANUFACTURE	R / COLOR	GENERAL LOCATION	REMARKS
06 41 00 CUSTOM CABINETS				09 68 50 CARPETING				10 21 23 CUBICLE CURTAIN			
PLAM-1 (Plastic Laminate)	<u>Manufacturer:</u> Nevamar <u>Color:</u> Clear Maple <u>Finish:</u> Armored Protection	Casework See Casework Elevations	Comparable by Approval	CPT-1 (Carpet Tile)	<u>Manufacturer:</u> Shaw Contract <u>Collection:</u> Assembly <u>Style Name:</u> Convene	See ID Sheet Field Carpet Tile	Comparable by Approval	Privacy Curtains & Track	<u>Manufacturer:</u> DL Couch <u>Product:</u> Privacy Curtain <u>Color:</u> As selected by	Nurse RM 110	Comparable by Approval
PLAM-2	<u>Manufacturer:</u> Nevamar <u>Color:</u> Crown Cherry	Countertops See Casework Elevations	Comparable by Approval		Color Name:Dynamic InteractionConstruction:Mullti-level patternSize:12"x48"Installation:Ashlar	CPT-1 and CPT-2 random mix 50-50			Pattern: As selected by Contents: 100% polyester		$\sim$
	Finish: Armored Protection			CPT-2	Manufacturer: Shaw Contract	See ID Sheet	Comparable	10 26 01 WALL AND DOOR PROTECTIO			
PLAM-3	<u>Manufacturer:</u> Nevamar <u>Color:</u> Sunray S4022T <u>Finish:</u> Armored Protection	Reading Nook See ID Sheets	Comparable by Approval		Collection:AssemblyStyle Name:EstaablishColor Name:InteractionConstruction:Multi-level pattern cut/loopSize:12"x48"	Field Carpet Tile CPT-1 and CPT-2 random mix	by Approval	CG-1 (Corner Guards)	<u>Color:</u> TBD <u>Size:</u> 4' high, 2" wing	See ID sheets Install on top of wall	Comparable by Approval
PLAM-4	Manufacturer:NevamarColor:Passionfruit SR5240-TFinish:Armored Protection	Reading Nook See ID Sheets	Comparable by Approval		Installation: Ashlar	50-50		12 05 00 FABRICS			
				WCPT-1 (Walk Off	Manufacturer: EF Contract Collection: Access	See ID Sheet	Comparable by Approval	FAB-1	<u>Manufacturer:</u> Carnegie	See ID sheets	Comparable
PLAM-5	<u>Manufacturer:</u> Formica <u>Color:</u> Matrix Blue 8795-58 <u>Finish:</u> Matte finish	Reading Nook See ID Sheets	Comparable by Approval	Carpet)	Style Name:Access AXColor Name:Channel AX903Construction:Textured Loop PatternSize:24"x24"	Vestibules		(Fabric)	<u>Style:</u> Vibe <u>Color:</u> 51	Reading Nook (yellow)	by Approval
PLAM-6	<u>Manufacturer:</u> Formica <u>Color:</u> Spectrum Green 7897-58 <u>Finish:</u> Matte Finish	Reading Nook See ID Sheets	Comparable by Approval		<u>Gauge:</u> 1/10 in <u>Installation:</u> Monolithic			FAB-2	<u>Manufacturer:</u> Carnegie <u>Style:</u> Vibe <u>Color:</u> 54	See ID sheets Reading Nook (pink)	Comparable by Approval
	<u>Finish:</u> Matte Finish			09 90 00 PAINTS AND COATINGS							
06 61 00 SIMULATED STONE				PNT-1 (Paint)	<u>Manufacturer:</u> Sherwin Williams <u>Color:</u> Colonnade Gray 7641	Field Paint	*Or Equal	FAB-3	<u>Manufacturer:</u> Carnegie <u>Style:</u> Vibe <u>Color:</u> 55	See ID sheets Reading Nook (blue)	Comparable by Approval
SS-1 (Solid Surface)	<u>Manufacturer:</u> Avonite <u>Color:</u> Sandstorm F1-9036 <u>Finish:</u> Satin	Window Sills	Comparable by Approval	PNT-2	Color Code: 283-C2 <u>Manufacturer:</u> Sherwin Williams	Accent	*Or Equal	FAB-4	<u>Manufacturer:</u> Carnegie <u>Style:</u> Vibe <u>Color:</u> 56	See ID sheets Reading Nook (green)	Comparable by Approval
09 30 00 TILE					Color:Brittlebush 6684Color Code:135-C6	Rms 118, 122					
								12 24 00 WINDOW SYSTEMS			
TLE-1 (Tile)	Manufacturer:       Ceramic Tile Works         Product:       Modern         Color:       Black         Size:       12"x24"	See ID Sheet Floor Tile	Comparable by Approval	PNT-3	Manufacturer:Sherwin WilliamsColor:Custom Color MatchColor Code:5 gal formula B20w2653Pro Mar 200 0 ES Deep	Accent Blue color	*Or Equal	WS-1 (Window Shades)	<u>Manufacturer:</u> Mecho <u>Product:</u> Mecho/5 System <u>Color:</u> TBD	See ID Sheet Exterior Windows	Comparable by Approval
TLE-2	Installation: Manufacturer: Ceramic Tile Works	See ID Sheet	Comparable		CCE Color Cast Mix Formula as on recor Holmen Sherwin Williams	Prophetic Sea Match (Accent blue color at Holmen Office)		WS-2	Openness: 5%	See ID Sheet	Comparable
	Product:OlympiaColor:Almond (Natural)Size:12"x24"Installation:See Elevation 16A211	Wall Tile	by Approval	PNT-4	<u>Manufacturer:</u> Sherwin Williams <u>Color:</u> Custom Color Match <u>Color Code:</u> 5 gal formula B20w2653 Pro Mar 200 E/S Deep	Accent Green color	*Or Equal		<u>Product:</u> Mecho/5 System <u>Color:</u> TBD <u>Openness:</u> 1%		by Approval
TLE-3	<u>Manufacturer:</u> Lunada Baytile <u>Product:</u> Haisen <u>Color:</u> Sorrel (Natural)	See ID Sheet Accent Wall Tile	Comparable by Approval		CCE Color Cast Mix Formula as on recor Holmen Sherwin Williams	Edamame Match (Accent green color at Holmen District Office)		WS-3	Manufacturer:MechoProduct:Mecho/5 SystemColor:TBDOpenness:1%	See ID Sheet Conference Room	Comparable by Approval
TLE-4	<u>Size:</u> Barcode <u>Manufacturer:</u> Ceramic Tile Works <u>Product:</u> Modern	See ID Sheet Shower floor tile	Comparable by Approval	PNT-5	<u>Manufacturer:</u> Sherwin Williams <u>Color:</u> Sable 6083 <u>Color Code:</u> 198-C7	Hollow Metal Door & Window	*Or Equal				
A01	Color: Black Size: 2"x2"			PNT-6	<u>Manufacturer:</u> Sherwin Williams <u>Color:</u> Apple Peel <u>Color Code:</u> Custom Manual Match	Match existing Cooridor Paint	*Or Equal				
TT-1 (Tile Transition)	Manufacturer:         Schluter           Collection:         Edge-protection and transition           Style:         Reno-U	Apply to all tile transitions otherwise noted	Comparable by Approval	10 11 24 TACKABLE WALL							
TT-2	Color:       Bright Chrome Anodized Aluminum         Manufacturer:       Schluter         Collection:       Cove Shaped Profile         Style:       DILEX-AHK	wall base cove trim	Comparable by Approval	WC-1 (Wall Covering)	<u>Manufacturer:</u> Koroseal <u>Product:</u> Walltalkers Tac-Wall <u>Color:</u> Sandalwood	Reading Nook, Classroom 119 Floor to Ceiling	Comparable by Approval				
( п-3	Color. Brushed chrome Anochred Manufacturer: Schluter	Wall Corner Edge	Comparable								
09 65 00 RESILIENT FLOORING/BASE	Collection:       Finishing and Edge Protection         Style:       Rondec         Color:       Brushed Chrome Anodized		by Approval	3							
LVT-1 (Luxury Vinyl Tile)	Manufacturer:PatcraftCollection:Mark MakingColor:AlmondSize:5.96"x48"Thickness:5 mm	See ID Sheet Field LVT	Comparable by Approval								
	<u>Inickness:</u> 5 mm <u>Wear Layer:</u> 20 mil <u>Install:</u> Stagger / Glue Down										
VWB-1 (Vinyl Wall Base)	Manufacturer:       Johnsonite         Size:       4"         Color:       Brown 47	Field Base Apply to all walls calling for unless otherwise noted	Comparable by Approval	_							
VCE-1 (Vinyl Carpet Edge)	Manufacturer:Johnsonite TarkettProduct:Slim Line TransitionsColor:Brown 47Size:varies by location, see ID sheets	See ID Sheet	Comparable by Approval								

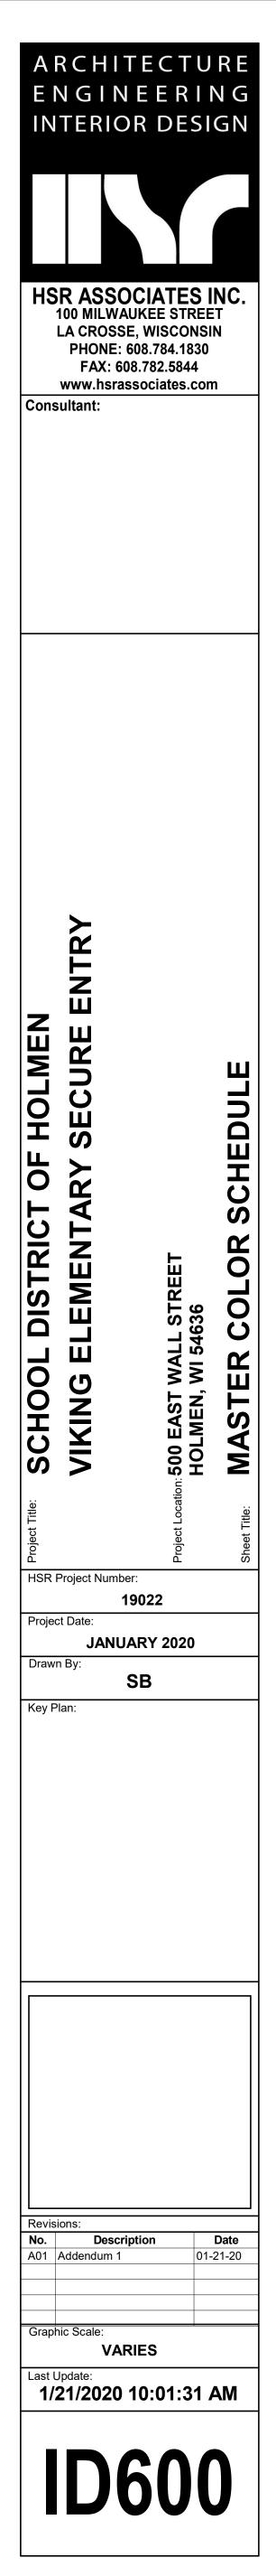

A01

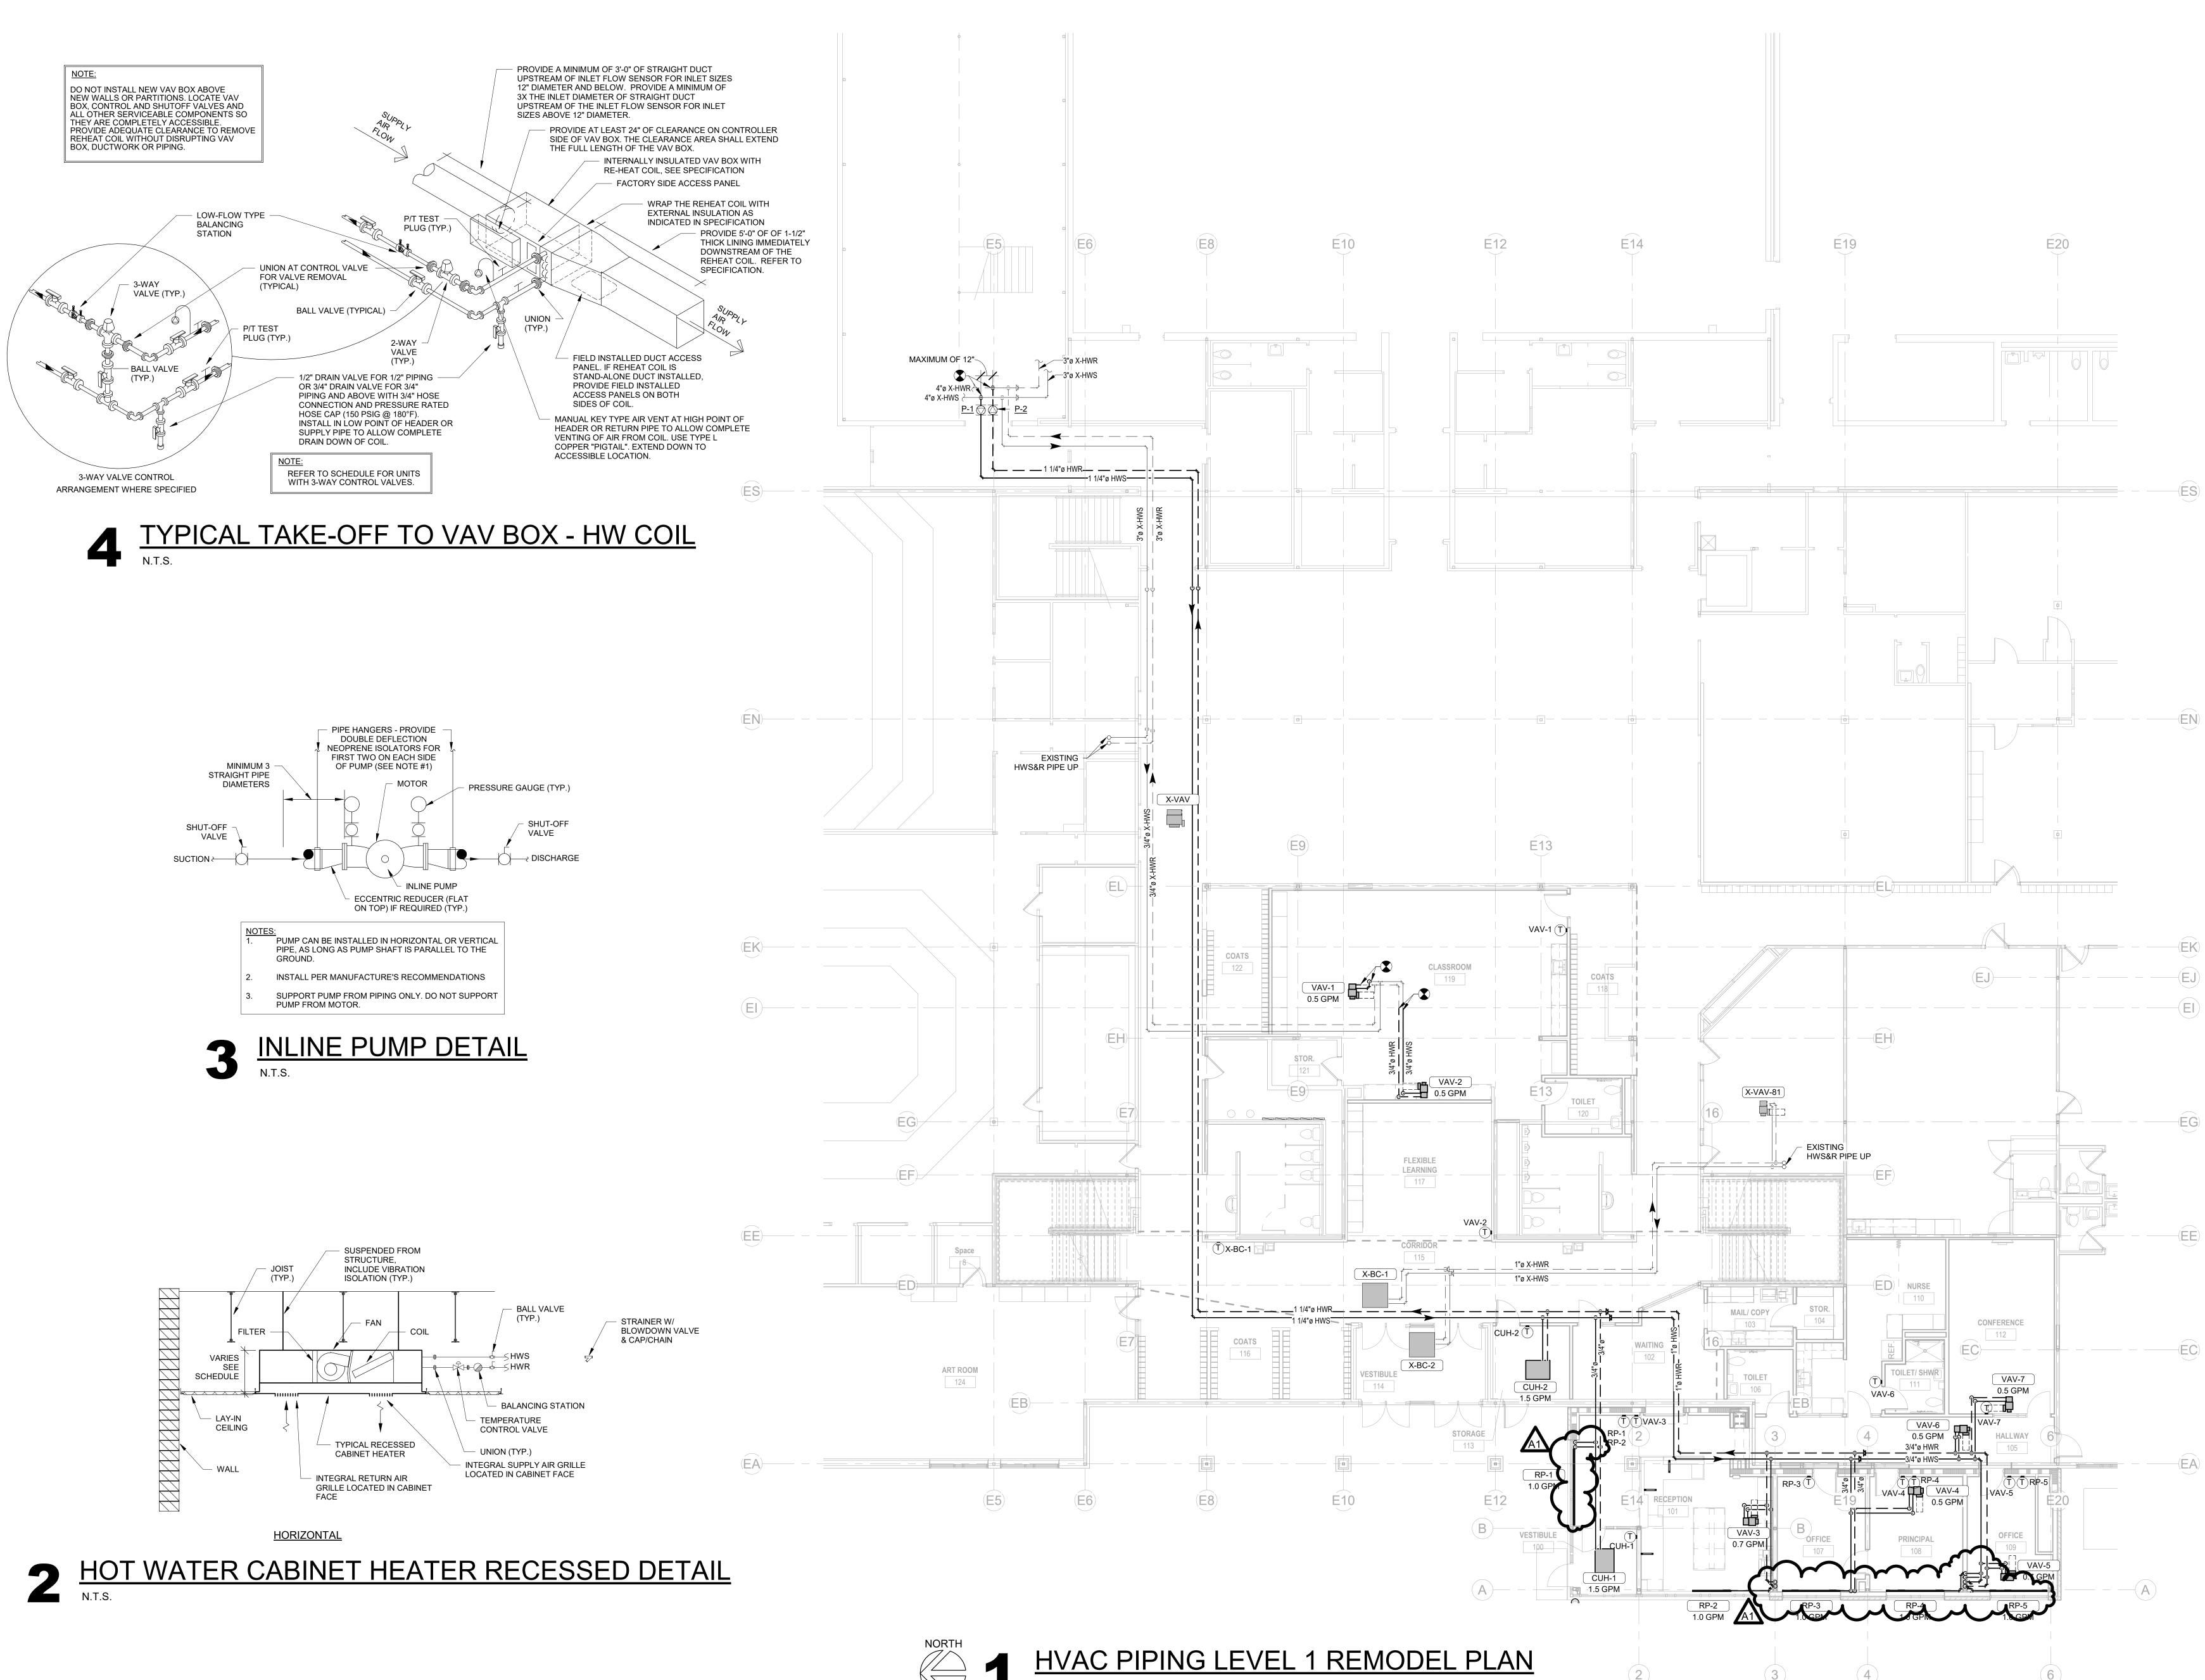

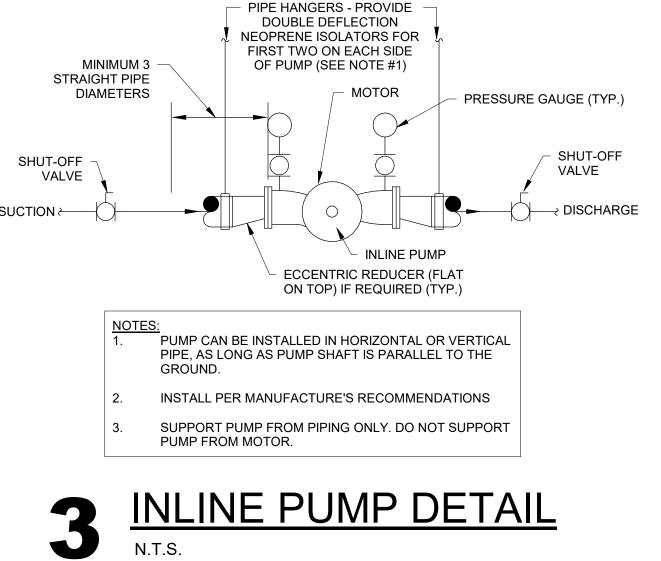


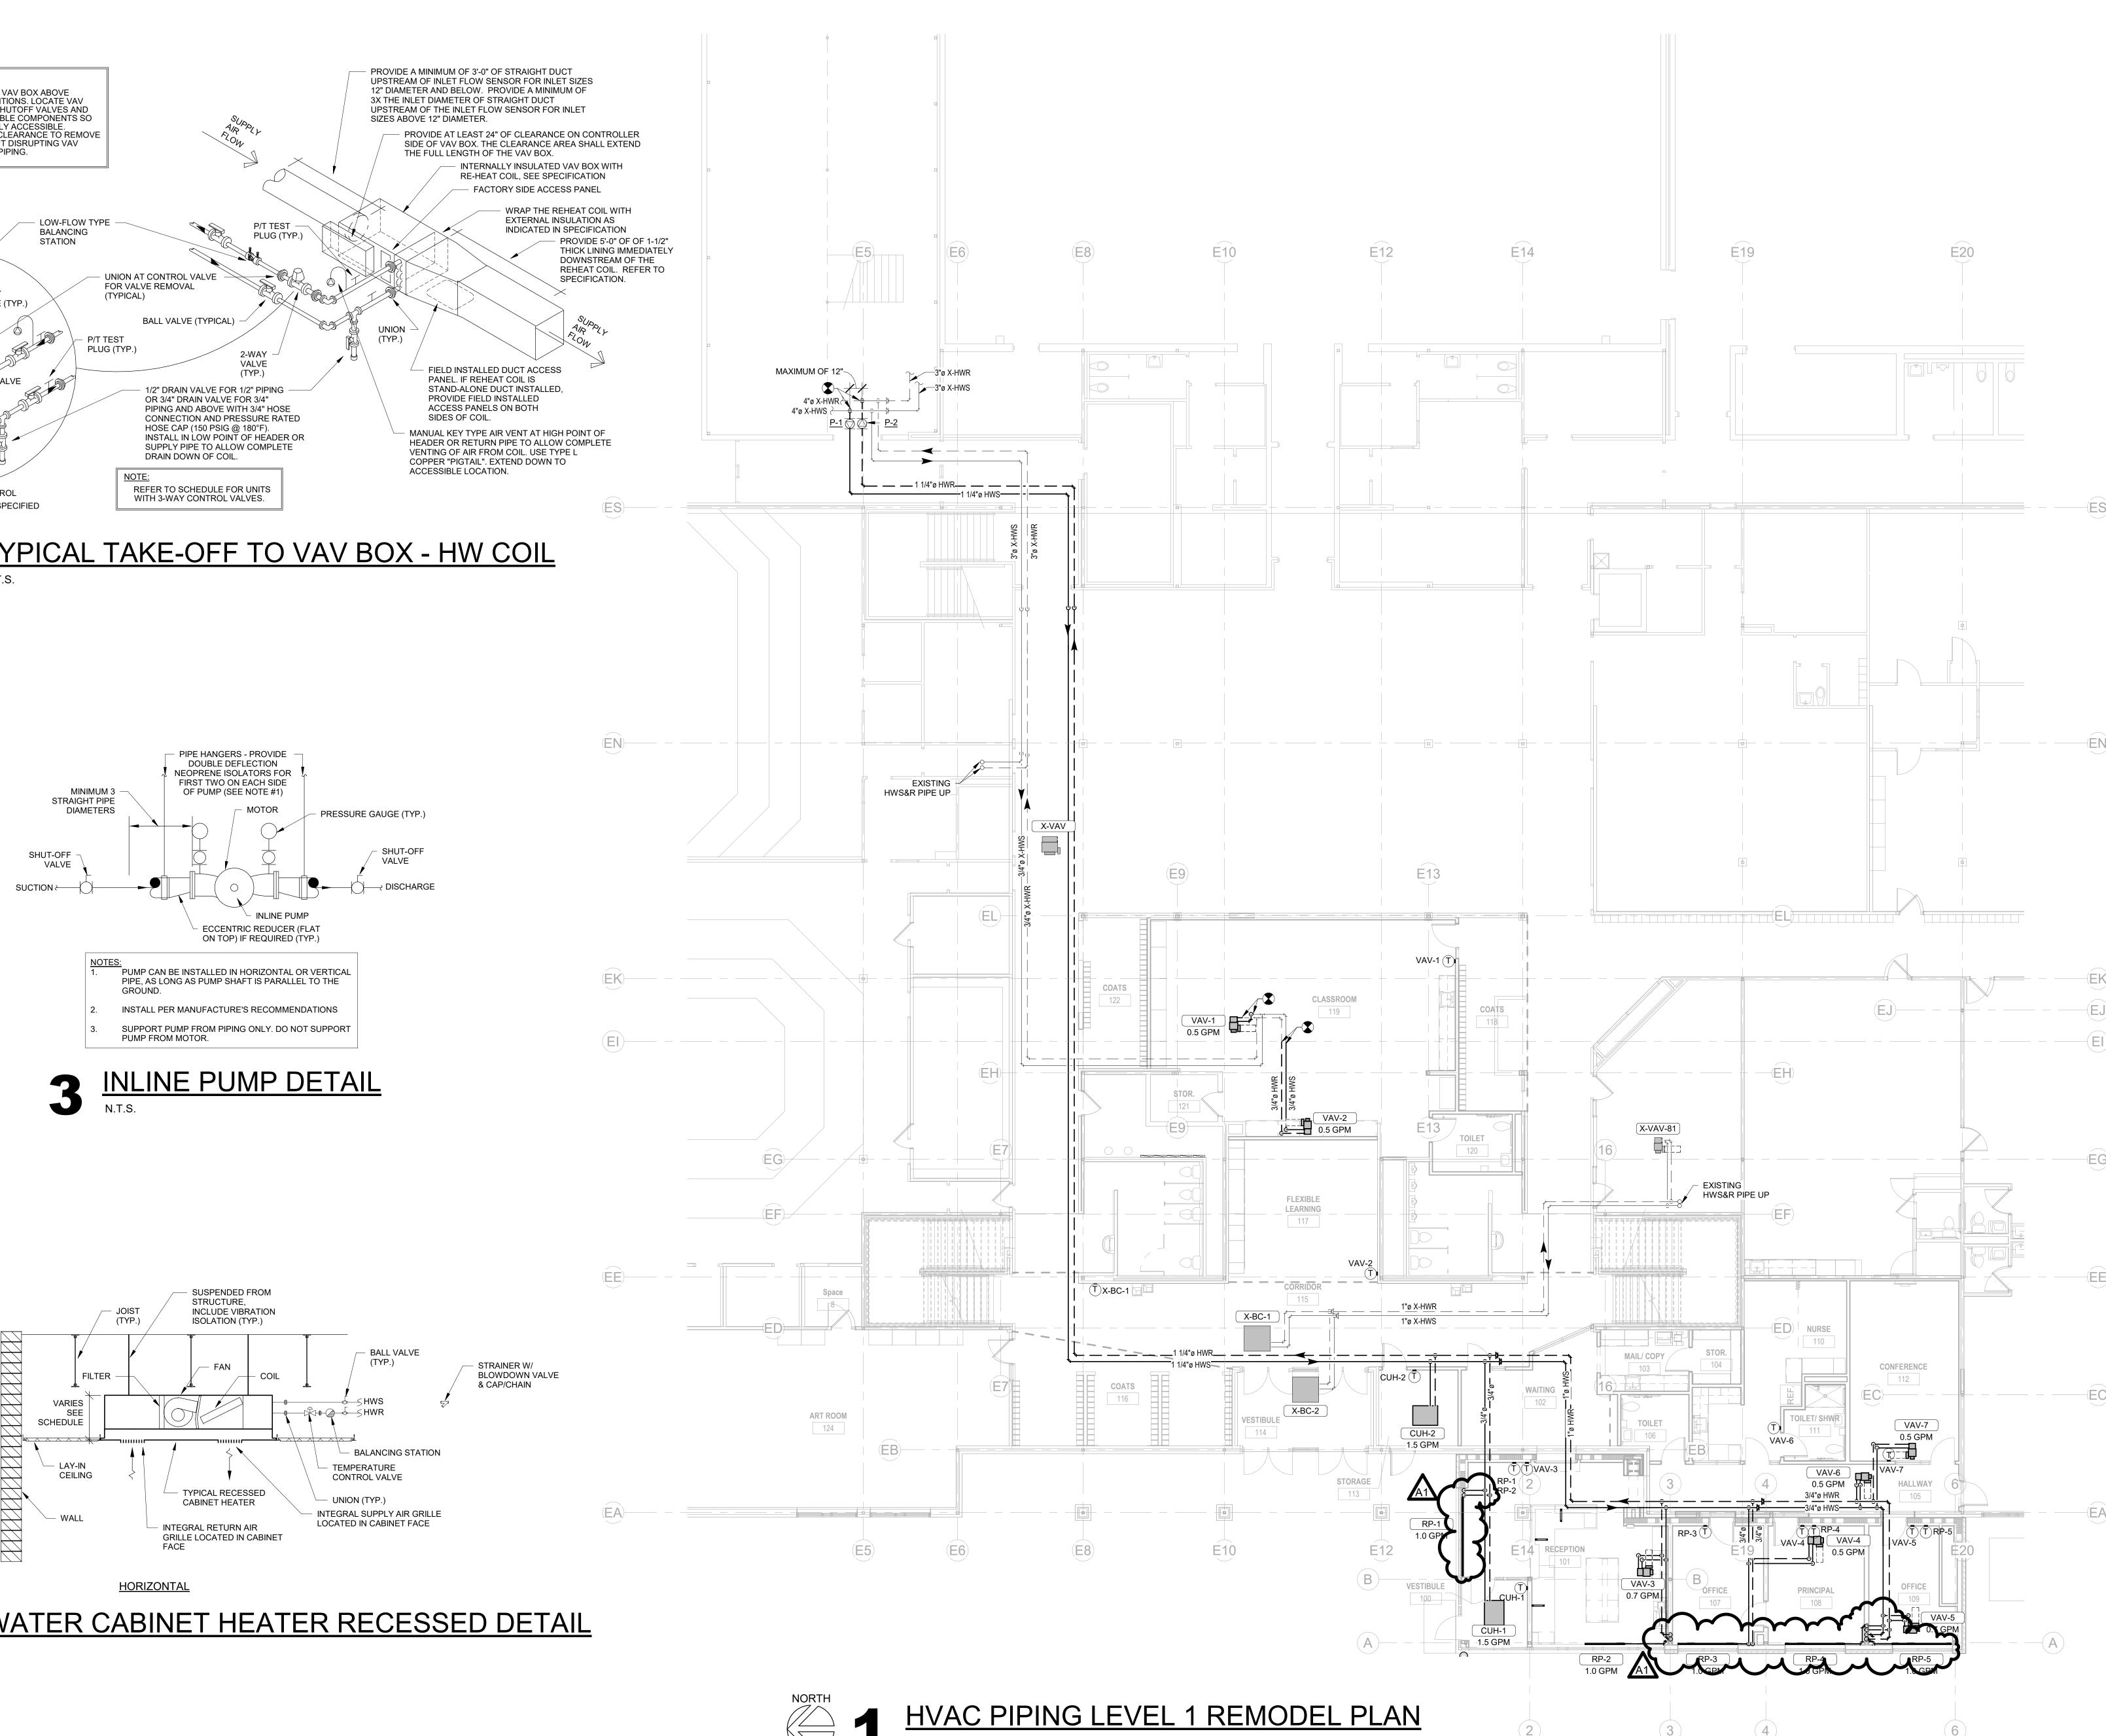





# 1/8" = 1'-0"

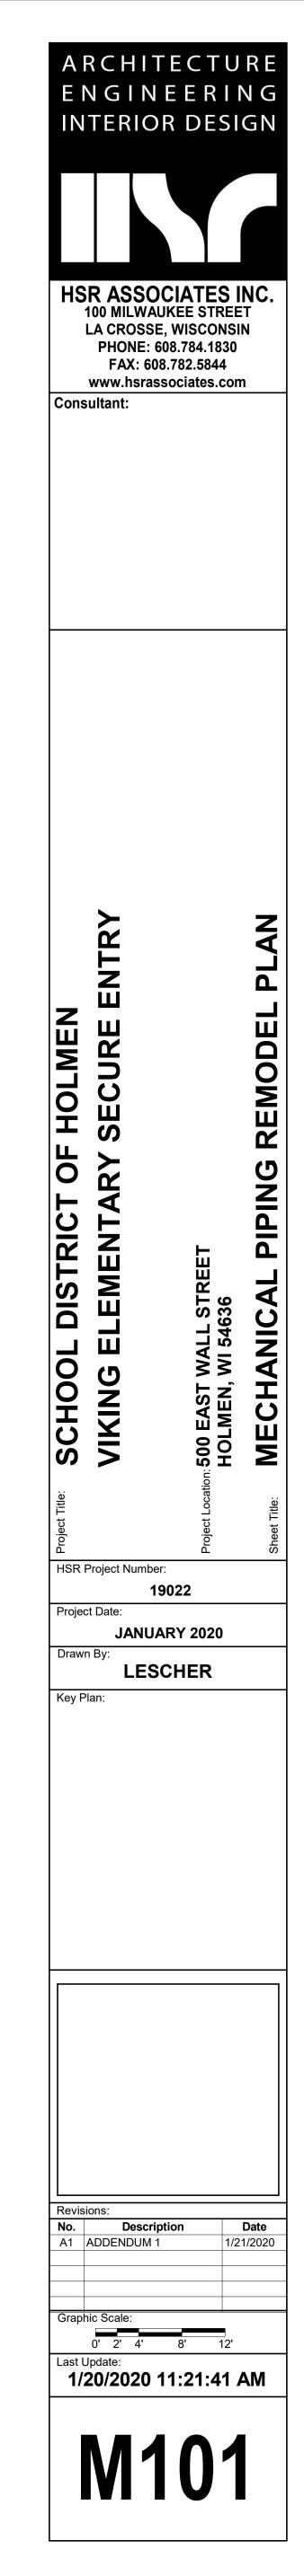

	R
UNIT NO.	NU
CUH-1	VES
CUH-2	ST
	<u>TS:</u>
1. SELEC 2. COLOF 3. ENTER	R TO

						MAX UNIT						COIL S	IZING AND CAPAC	ITY DATA			
						STATIC	MINIMUM INLET		NC LEVEL			COIL	ENTERING HOT	ENTERING AIR			
				MINIMUM	MINIMUM	PRESSURE	STATIC	INLET DUCT	(BOX)	COIL	MAX	PRESSURE	WATER	TEMPERATURE	TOTAL MBH	ROOM HEAT	
Mark	SERVES ROOM	MODEL NO.	MAX CFM	COOLING CFM	HEATING CFM	DROP	PRESSURE	SIZE	RADIATED	TYPE	GPM	DROP	TEMPERATURE	(DRY BULB)	INSTALLED	LOSS (MBH)	REMARKS
VAV-1	CLASSROOM 119	VCWF08	680	205	260	0.250		8"Ø	26	1 ROW	0.50	0.67	180°F	55°F	8.48	4.82	1 & 2
VAV-2	GALLERY 117	VCWF06	280	85	200	0.140		6"Ø	26	1 ROW	0.50	0.50	180°F	55°F	6.62	3.80	1 & 2
VAV-3	RECEPTION 101, WAITING 102 & MAIL / COPY 103	VCWF08	690	210	280	0.440		8"Ø	26	2 ROW	0.70	0.05	180°F	55°F	11.14	7.20	1 & 2
VAV-4	OFFICE 107 & PRINCIPAL 108	VCWF08	480	145	225	0.230		8"Ø	22	2 ROW	0.50	0.03	180°F	55°F	8.67	5.50	1 & 2
VAV-5	OFFICE 109	VCWF06	240	75	180	0.110		6"Ø	26	1 ROW	0.70	0.87	180°F	55°F	6.84	4.30	1 & 2
VAV-6	HALLWAY 105 & NURSE 110	VCWF06	200	60	200	0.07		6"Ø	24	1 ROW	0.50	0.50	180°F	55°F	6.62	3.80	1 & 2
VAV-7	CONFERENCE 112	VCWF06	270	80	200	0.130		6"Ø	26	1 ROW	0.50	0.50	180°F	55°F	6.62	3.80	1, 2, 3

SELECTION BASED ON PRODUCT BY TRANE.
 REFER TO DETAIL <u>4M101</u> FOR INSTALLATION.
 PROVIDE 3-WAY CONTROL VALVE

ROOM					FULL	CAB	BINET				
NUMBER	QUANTITY	MBH	MODEL	SIZE	DEPTH	HEIGHT	LENGTH	GPM	CFM	HP (VOLT/PHASE)	COMMENTS
ESTIBULE 100	1	22.53	FFEB040	040	11"	30"	38"	1.5	300	58W (115/1)	1, 2, 3
STORAGE 113	1	17.58	FFEB040	040	11"	30"	33"	1.5	220	58W (115/1)	1, 2, 3
<u>3:</u>	L L		41								


				FAN	S					
UNIT NO.	SERVES ROOM	LOCATION	MODEL	SOUND LEVEL MAX SPEED	CFM	S.P. DROP INCHES W.G.	FULL LOAD AMPS	WATTS (VOLT/PHASE)	WEIGHT	COMMENTS
EF-1	TOILET ROOMS	CEILING (INLINE)	CSP-B150	2.0 SONES	150	0.1	1.7	142 W (115/1)	11 LBS	1
COMMENTS:										

1. SELECTION BASED ON PRODUCT BY GREENHECK.

	AIR DISTRIBUTION DEVICES												
UNIT NO.	SYSEM CLASSIFICATION	SIZES	LOCATION	DAMPER	INLET SIZE	MODEL NUMBER	MOUNTING	COMMENTS					
G-1	Supply Air	24"x24"	CEILING	-	6"Ø	SERIES PLQ 4-WAY	LAY-IN	1 & 2					
G-2	Supply Air	24"x24"	CEILING	-	8"Ø	SERIES PLQ 4-WAY	LAY-IN	1 & 2					
G-3	Supply Air	24"x24"	CEILING	-	10"Ø	SERIES PLQ 4-WAY	LAY-IN / SURFACE	1 & 2					
G-4	Supply Air	24"x24"	CEILING	-	12"Ø	SERIES PLQ 4-WAY	LAY-IN	1 & 2					
G-5	Supply Air	48" LINEAR	CEILING	-	6"Ø	DFL-10-1	LAY-IN	1 & 2					
G-6	Return Air	24"x6"	CEILING	-	22"x4"	EGC-5 1/2" EGG CRATE	LAY-IN	1 & 2					
G-7	Return Air	24"x12"	CEILING	-	22"x10"	EGC-5 1/2" EGG CRATE	LAY-IN	1 & 2					
G-8	Exhaust Air	12"x12"	CEILING	-	REFER TO PLANS	S580	LAY-IN	1 & 2					

COMMENTS:

SELECTION BASED ON PRODUCT BY KRUEGER.
 COLOR TO BE SELECTED BY ARCHITECT.

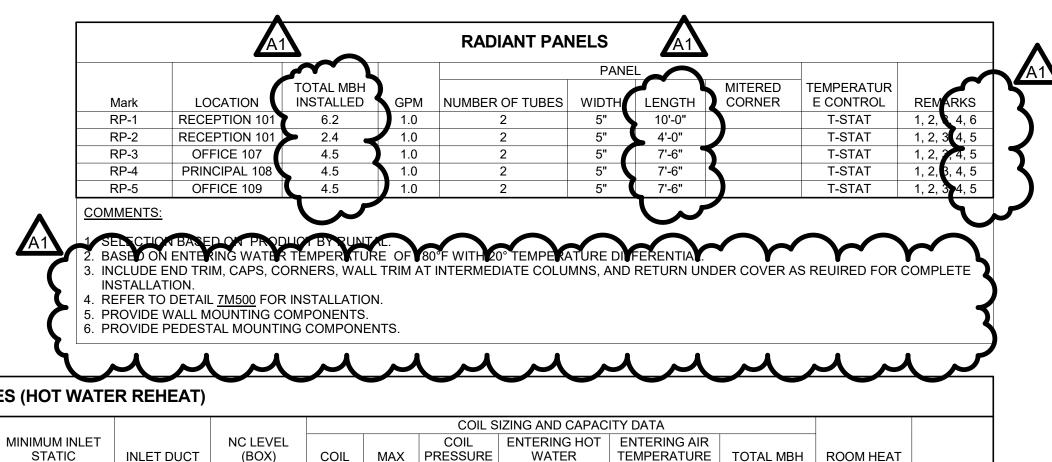

	ROOFTOP HEATING/COOLING UNITS														
MODEL	TONS	TOTAL SEN CLG MBH NET	AMB. TEMP.	ENT. TEMP. DB/WB	REFR. TYPE	CFM	E.S.P.	FILTER TYPE	SUPPLY FAN HP	INPUT MBH	OUTPUT MBH	MIN. O.A. %	COMMENTS		
C072F4*MA**KE	6.0	71.56	95°F	80°F / 67°F	R-410A	2220 CFM	0.250	MERV 8	2.75	120	97.20	10%	1, 2, 3, 4, 5		

OUTSIDE AIR ECONOMIZER (MODULATION 0-100%)
 UNIT SHALL BE A SIDE-FLOW CONFIGURATIO.

YZC

UNIT NO. MANUFACTURER RTU-1 Trane

COMMENTS:

UNIT SHALL INCLUDE POWERED CONVENIENCE OUTLET, CLOGGED FILTER/FAN FAILURE SWITCH AND HINGED ACCESS DOOR.
 INCLUDE FUSED DISCONNECT SWITCH.


5. HOUSEKEEPING PAD PROVIDED BY GENERAL CONTRACTOR.

				Р	UMPS				
			Ϋ́	YPE					
				FLOOR				HP	
UNIT NO.	LOCATION	SERVES	INLINE	MOUNTED	MODEL	GPM	TOTAL HEAD	(VOLTS/PHASE)	COMMENTS
P-1	CUSTODIAN	REFER TO PLANS	YES		CRE 3-5	11.0 GPM	80	1 HP (200-240/1)	1
P-2	CUSTODIAN	REFER TO PLANS	YES		CRE 3-5	11.0 GPM	80	1 HP (200-240/1)	1
COMMENTE							•	· · · · · ·	

COMMENTS:

1. SELECTION BASED ON PRODUCT BY GRUNDFOS.




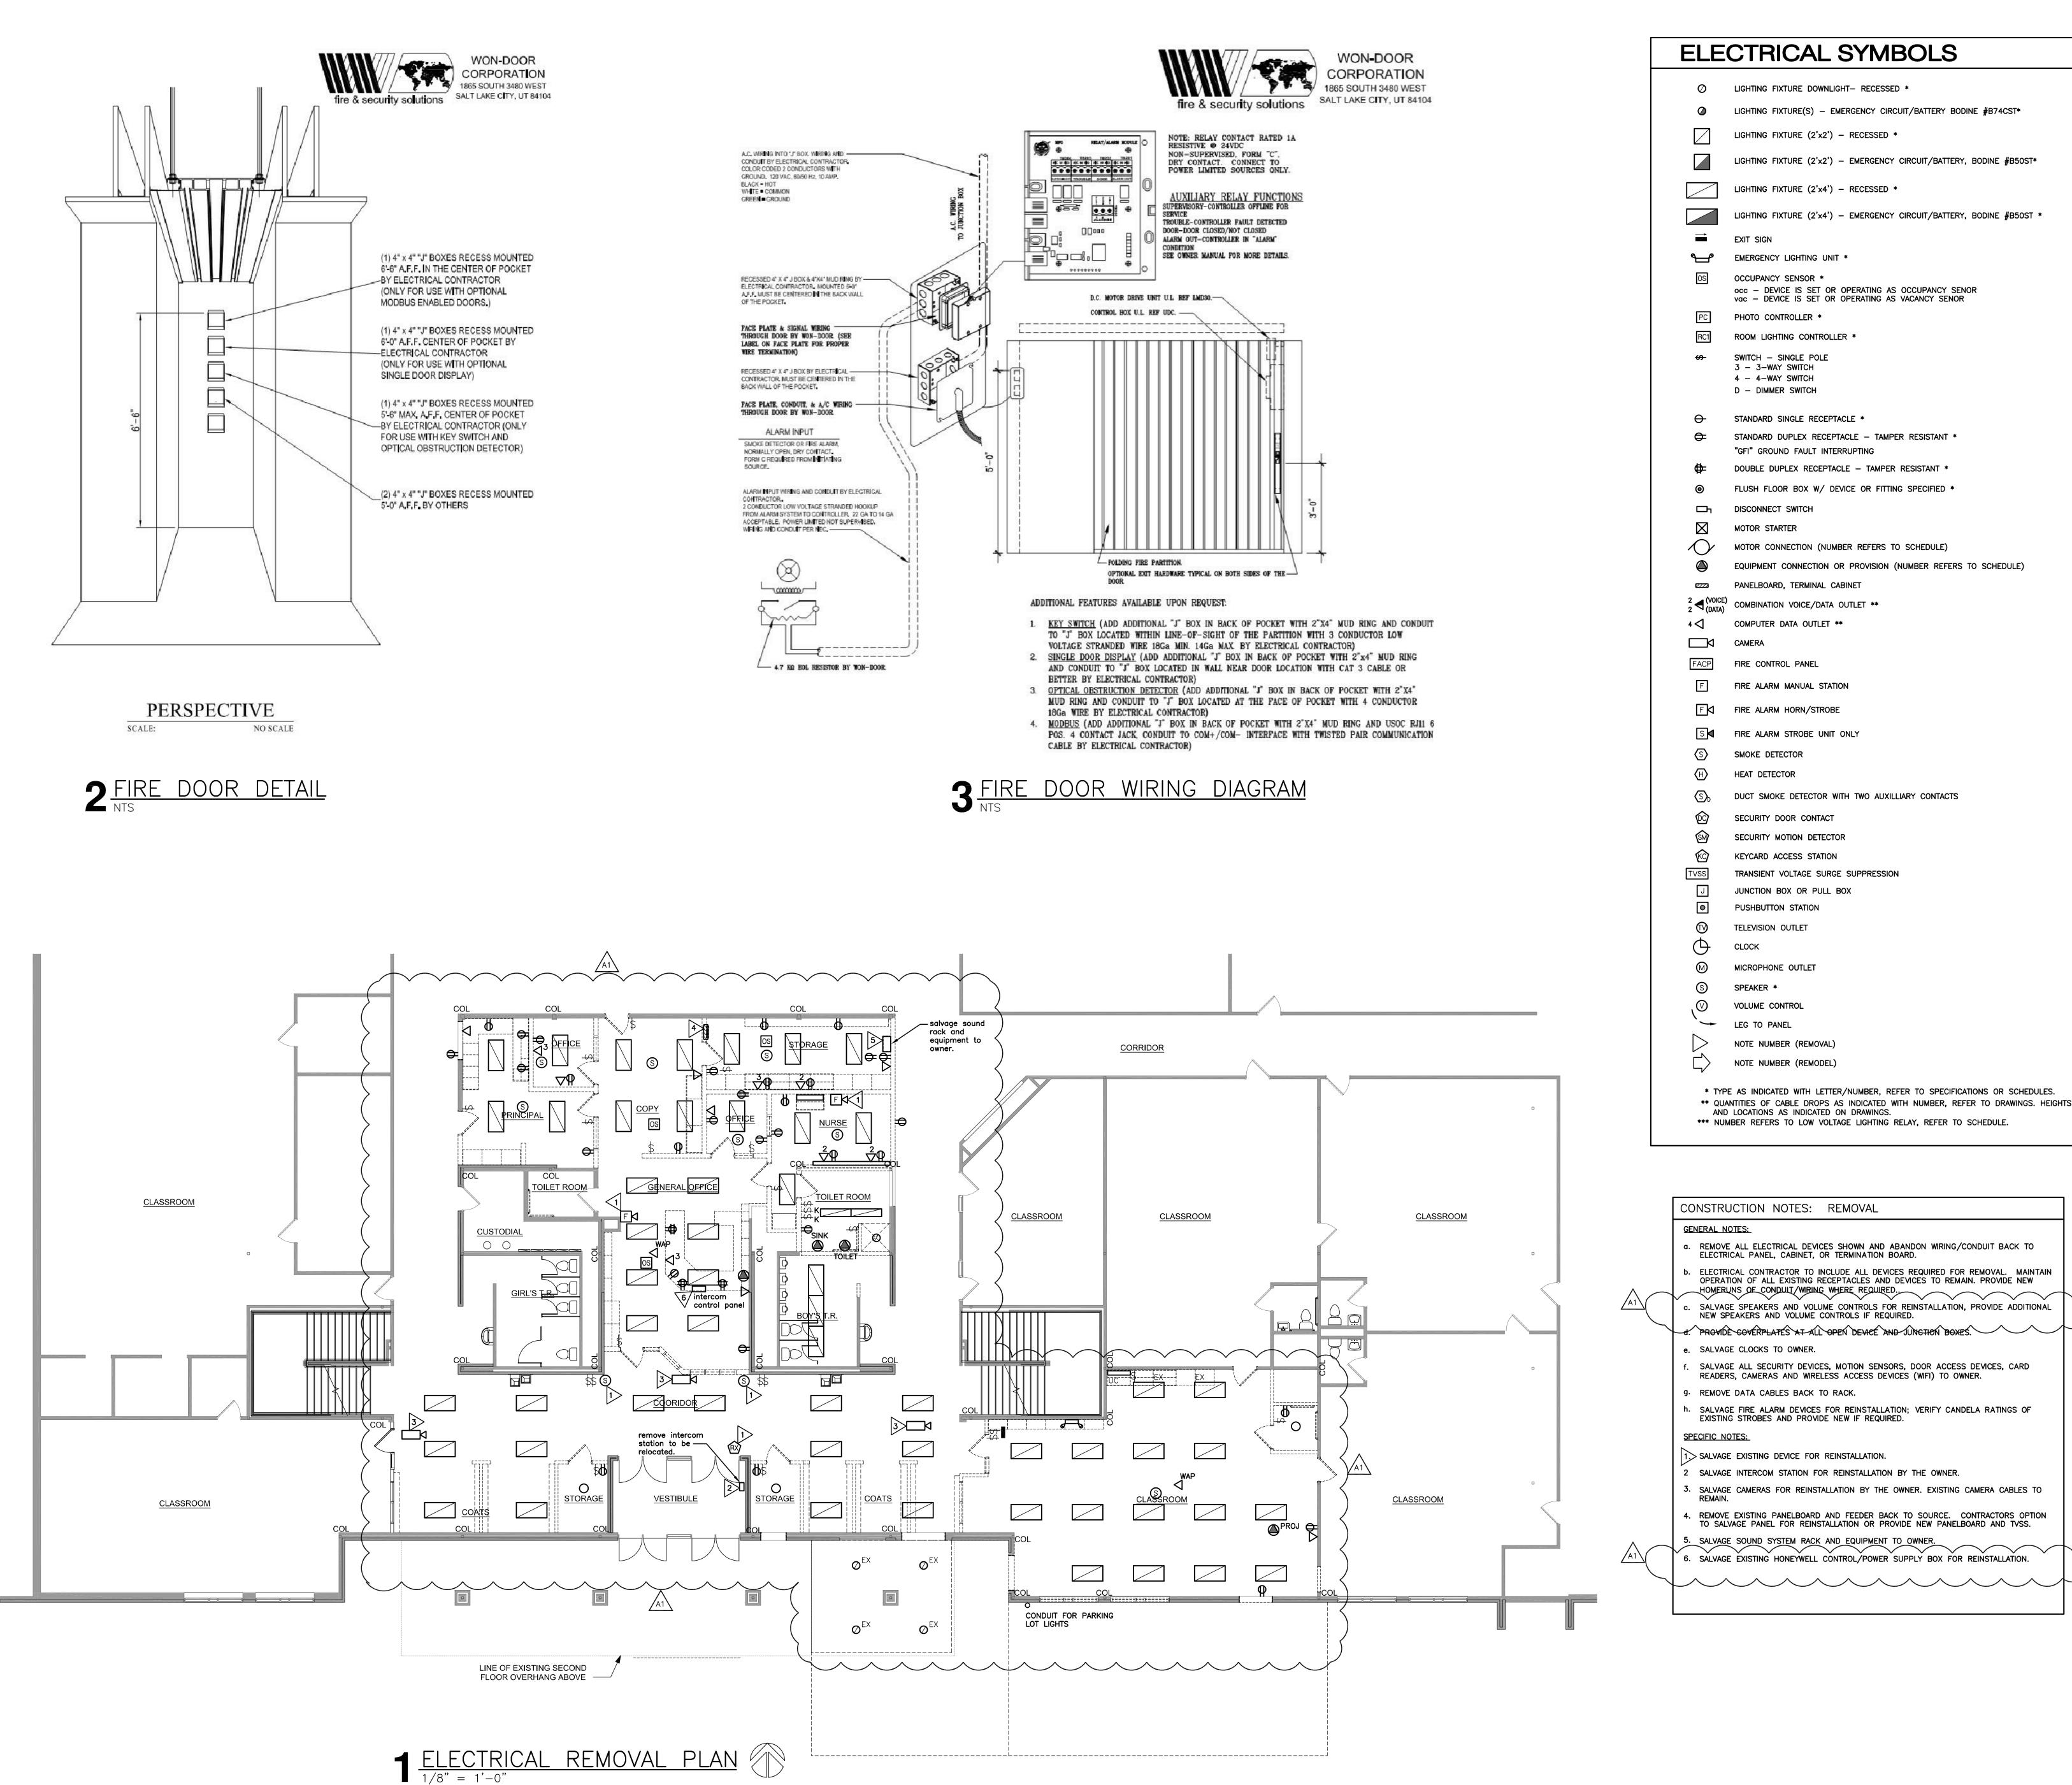







ELE	CTRICAL SYMBOLS
Ø	LIGHTING FIXTURE DOWNLIGHT- RECESSED *
Ø	LIGHTING FIXTURE(S) - EMERGENCY CIRCUIT/BATTERY BODINE #B74CST*
	LIGHTING FIXTURE (2'x2') - RECESSED *
	LIGHTING FIXTURE (2'x2') - EMERGENCY CIRCUIT/BATTERY, BODINE #B50ST*
	LIGHTING FIXTURE (2'x4') - RECESSED *
	LIGHTING FIXTURE (2'x4') - EMERGENCY CIRCUIT/BATTERY, BODINE #B50ST *
$\rightarrow$	EXIT SIGN
	EMERGENCY LIGHTING UNIT *
OS	OCCUPANCY SENSOR * occ — DEVICE IS SET OR OPERATING AS OCCUPANCY SENOR vac — DEVICE IS SET OR OPERATING AS VACANCY SENOR
PC	PHOTO CONTROLLER *
RC1	ROOM LIGHTING CONTROLLER *
<del>69-</del>	SWITCH – SINGLE POLE 3 – 3–WAY SWITCH 4 – 4–WAY SWITCH D – DIMMER SWITCH
θ-	STANDARD SINGLE RECEPTACLE *
<del>C</del>	STANDARD DUPLEX RECEPTACLE – TAMPER RESISTANT * "GFI" GROUND FAULT INTERRUPTING
₽	DOUBLE DUPLEX RECEPTACLE - TAMPER RESISTANT *
۲	FLUSH FLOOR BOX W/ DEVICE OR FITTING SPECIFIED *
	DISCONNECT SWITCH
$\boxtimes$	MOTOR STARTER
$\sim$	MOTOR CONNECTION (NUMBER REFERS TO SCHEDULE)
	EQUIPMENT CONNECTION OR PROVISION (NUMBER REFERS TO SCHEDULE)
	PANELBOARD, TERMINAL CABINET
$\binom{2}{2} \triangleleft (VOICE)$ (DATA)	COMBINATION VOICE/DATA OUTLET **
4 <	COMPUTER DATA OUTLET **
	CAMERA
FACP	FIRE CONTROL PANEL
F	FIRE ALARM MANUAL STATION
Fd	FIRE ALARM HORN/STROBE
S	FIRE ALARM STROBE UNIT ONLY
$\langle S \rangle$	SMOKE DETECTOR
$\langle H \rangle$	HEAT DETECTOR
S	DUCT SMOKE DETECTOR WITH TWO AUXILLIARY CONTACTS
	SECURITY DOOR CONTACT
ŚM	SECURITY MOTION DETECTOR
KC	KEYCARD ACCESS STATION
TVSS	TRANSIENT VOLTAGE SURGE SUPPRESSION
	JUNCTION BOX OR PULL BOX PUSHBUTTON STATION
	TELEVISION OUTLET
Ğ	CLOCK
$\odot$	MICROPHONE OUTLET
6	SPEAKER *
	VOLUME CONTROL
,©	LEG TO PANEL
$\triangleright$	NOTE NUMBER (REMOVAL)
$\Box$	NOTE NUMBER (REMODEL)
	E AS INDICATED WITH LETTER/NUMBER, REFER TO SPECIFICATIONS OR SCHEDULES. NTITIES OF CABLE DROPS AS INDICATED WITH NUMBER, REFER TO DRAWINGS, HEIG

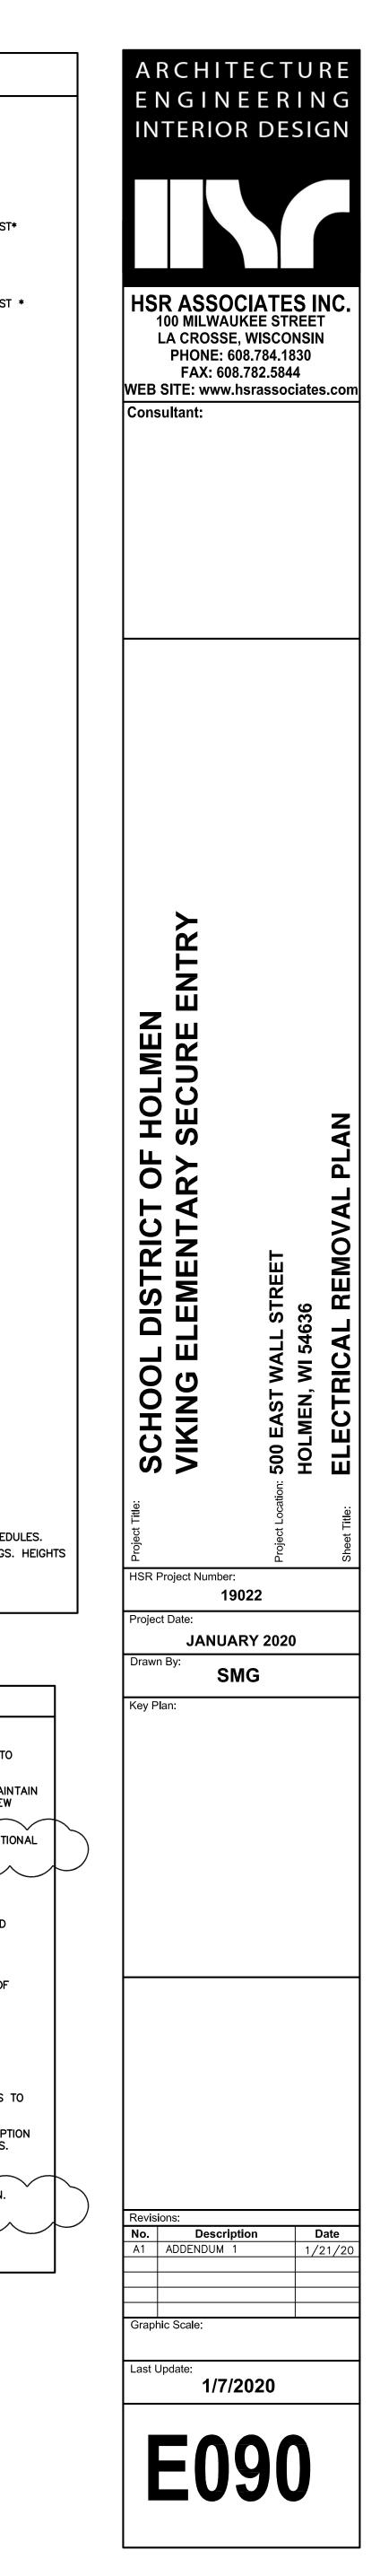



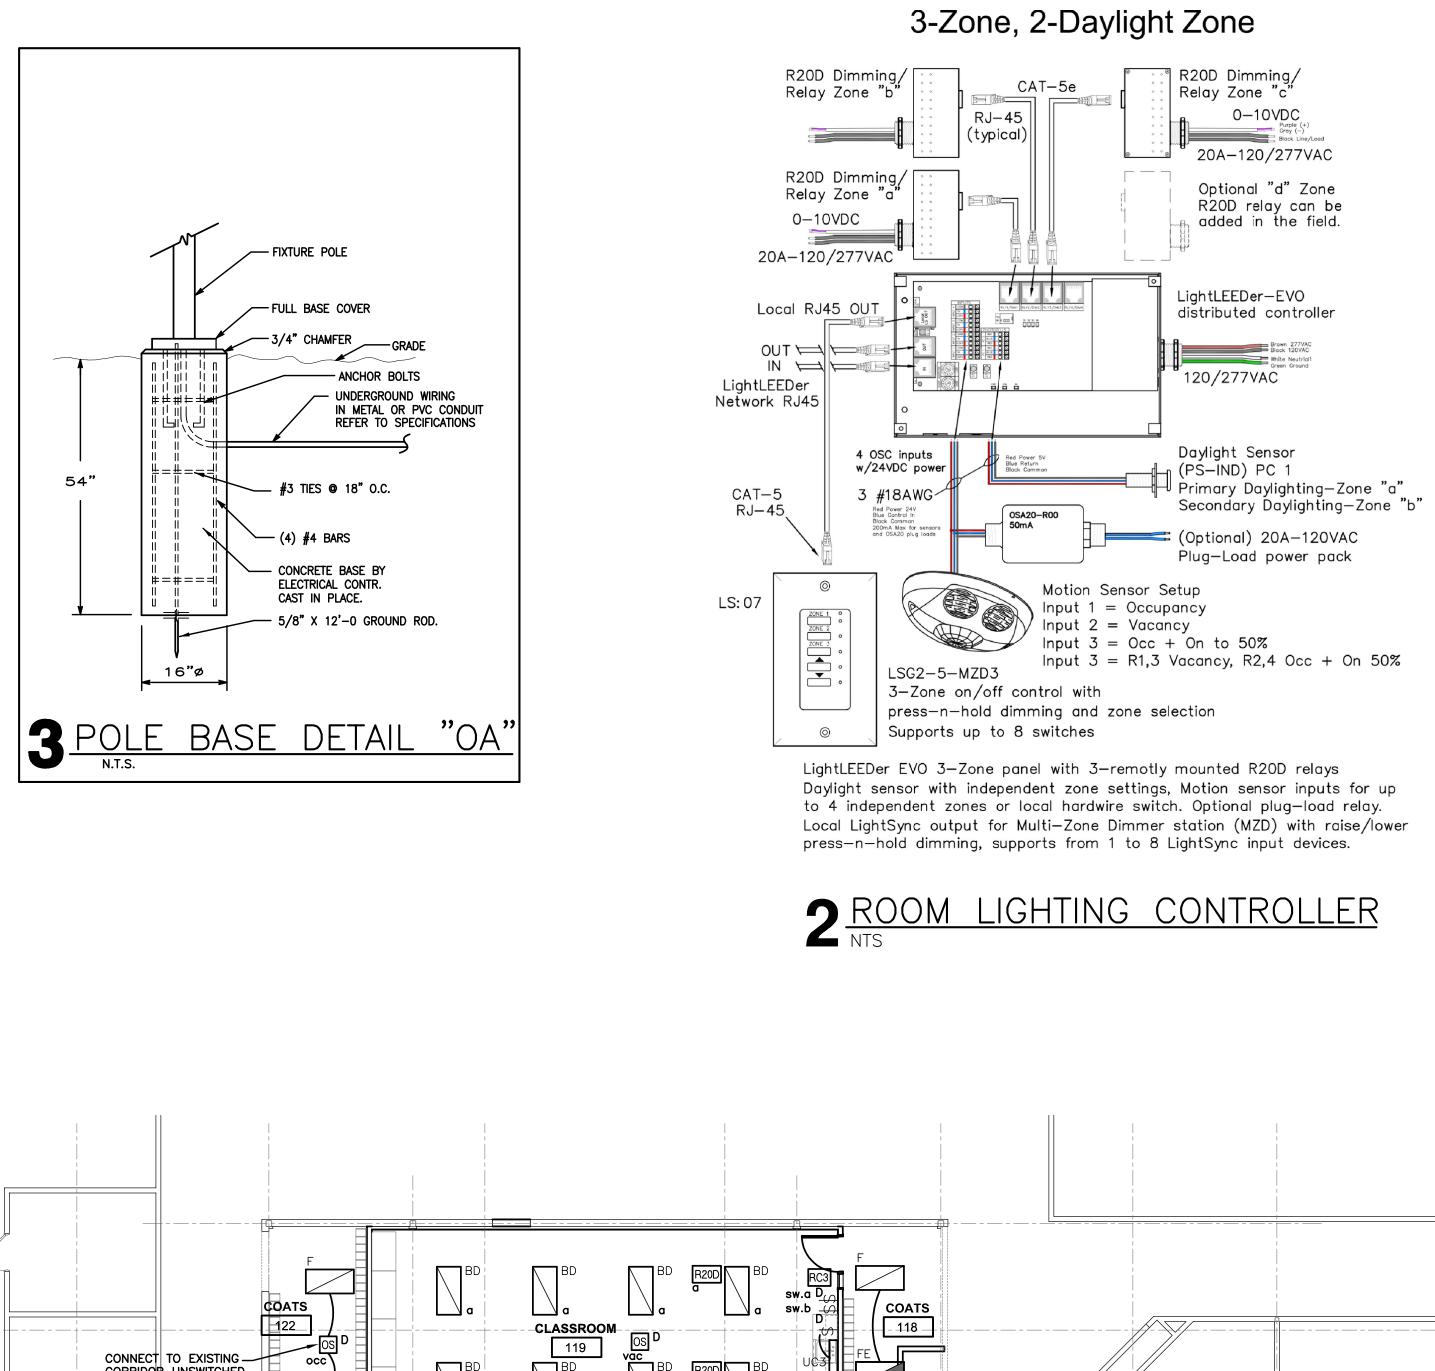

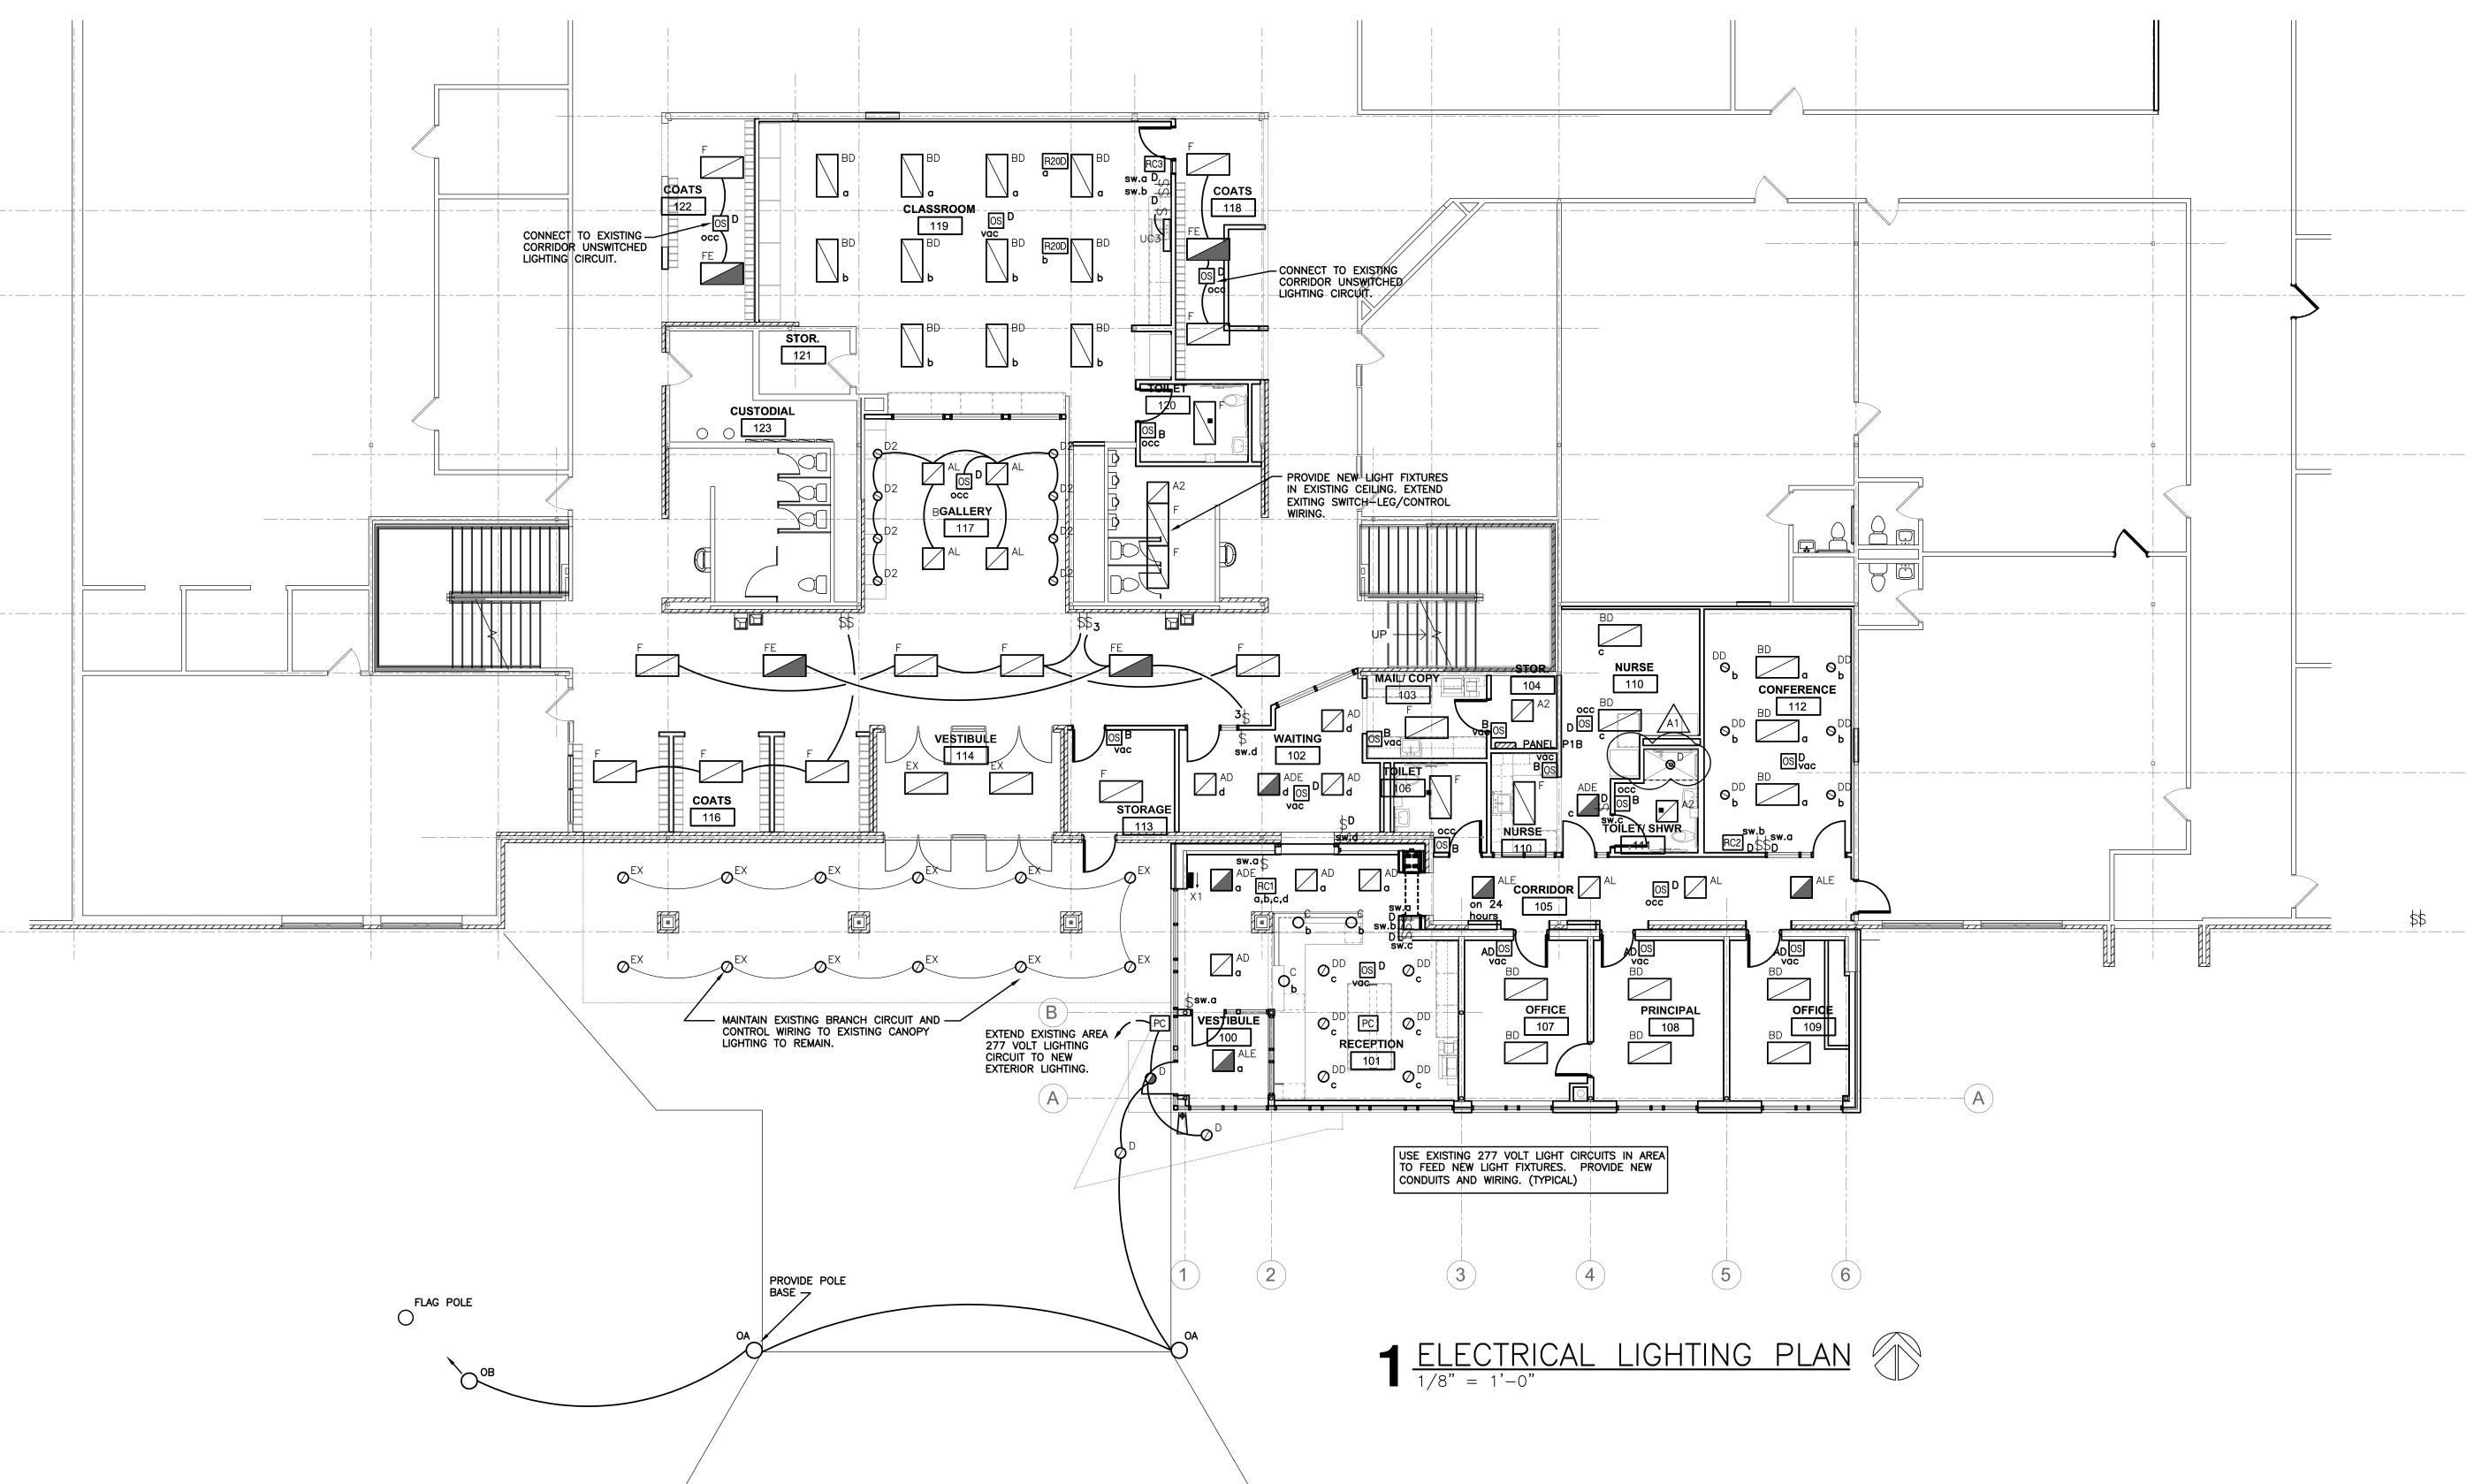

					\	IOUNT	'ING *	**			LAMPS	
TYPE	MANUFACTURER	CATALOG NUMBER	DESCRIPTION	VOLT	F	s	Р	0	NO.	WATT	TYPE	REMA NUMB
A2	COLUMBIA	LJT22-40MWG-FSA12EU	2' X 2' LAY IN TROFFER	MVOLT	*				-	18	LED 4000K	1
AD	COLUMBIA	LSER22-40MLGC-ED1	2' X 2' LAY IN TROFFER, DIMMING TO 1%	MVOLT	*				-	31	LED 4000K	1,4
ADE	COLUMBIA	LSER22-40MLGC-ED1-ELL14	2' X 2' LAY IN TROFFER, DIMMING/EMERG. BATTERY	MVOLT	*				-	31	LED 4000K	1,4
AL	COLUMBIA	LSER22-40LWGC-F	2' X 2' LAY IN TROFFER,	MVOLT	*				-	24	LED 4000K	1
ALE	COLUMBIA	LSER22-40LWGC-F-ELL14	2' X 2' LAY IN TROFFER, EMERGENCY BATTERY	MVOLT	*				-	24	LED 4000K	1
BD	COLUMBIA	LSER24-40MLGC-ES1	2' X 4' LAY IN TROFFER, DIMMING TO 1%	MVOLT	*				-	42	LED 4000K	2,4
С	HALO	H2SCNAH4WH	PENDANT WITH FIELD ADJUSTABLE CORD	120/24			*		1	10	10MR16 4000K	5
D	PRESCOLTIE	LF4LS-4LFSL11L40K	4" LED DOWNLIGHT	MVOLT	*				-	15.5	4000K	6
D2	PRESCOLTIE	D2LED-EDM-2D9LED940KWFL45	2" LED DOWNLIGHT	MVOLT	*				-	13	4000K	6
DD	PRESCOLTIE	LF4LSDM1-4LFSL11L40K	4" LED DOWNLIGHT, DIMMING TO 1%	MVOLT	*				-	15.5	4000K	6,4
EM	DUAL-LITE	PGR-Z	EMERGENCY EGRESS LIGHT	MVOLT		*			_	445LU	4000K	
4	COLUMBIA	LJT24-40MWG-FSA12EU	2 X 4' LAY IN TROFFER	MVOLT	*		$\geq$		y	31	LED 4000K	2
FE	COLUMBIA	LJT24-40MWG-FSA12EU-ELL14	2' X 4' LAY IN TROFFER WITH EMERG. BATTERY	MVOLT	*				1	31	LED 4000K	2
UC3	FAIL-SAFE	UCL3LD4-40A12125	UNDER CABINET LIGHT	NVOLT		*			-	18.3	4000K	
X1	COMPASS	CER	EXIT LIGHT, RED LETTERS AND BATTERY	MVOLT		*			1	2.6		7
EX	EXISTING		EXISTING LIGHT FIXTURE TO REMAIN									3
OA	STERNBERG LIGHTING	SL660 SOLONA: 12L40TMDL018	AREA LIGHT WITH 10' POLE AND BRONZE FINISH	MVOLT				*	1	61	4000K	8
OB	BEACON	CDT24NB-554K-5X3-HV-YK-BZT	FLAG POLE LIGHTING	MVOLT				*	1	55	4000K	9

1. 2' X 2' LENSED LED LAY-IN TROFFER.

2. 2' X 4' LENSED LED LAY-IN TROFFER.

3. EXISTING LIGHT FIXTURE TO REMAIN. EXTEND BRANCH CIRCUIT WIRING AND SWITCH-LEG WIRING AS REQUIRED TO KEEP LIGHTS ACTIVATED.

4. PROVIDE WITH DIMMING DRIVER DOWN TO 1%.

5. WHITE GLASS PENDANT WITH LED MR16 LAMP AND FIELD ADJUSTABLE CORD.


6. LED DOWNLIGHT,


7. EXIT LIGHT, WITH EMERGENCY BATTERY, RED LETTERS, WHITE FINISH.

8. SL660-12L40T5MDL018-SV1-UB. PROVIDE 10' POLE WITH MATCHING FINISH.

9. PROVIDE WITH HALF VISOR AND BRONZE FINISH. YOKE MOUNTED TO TOP OF CAST BOX AS REQUIRED.

EQUAL FIXTURES BY COOPER LIGHTING, HUBBELL LIGHTING, LITHONIA AND PHILLIPS/DAY-BRITE ARE ACCEPTABLE.

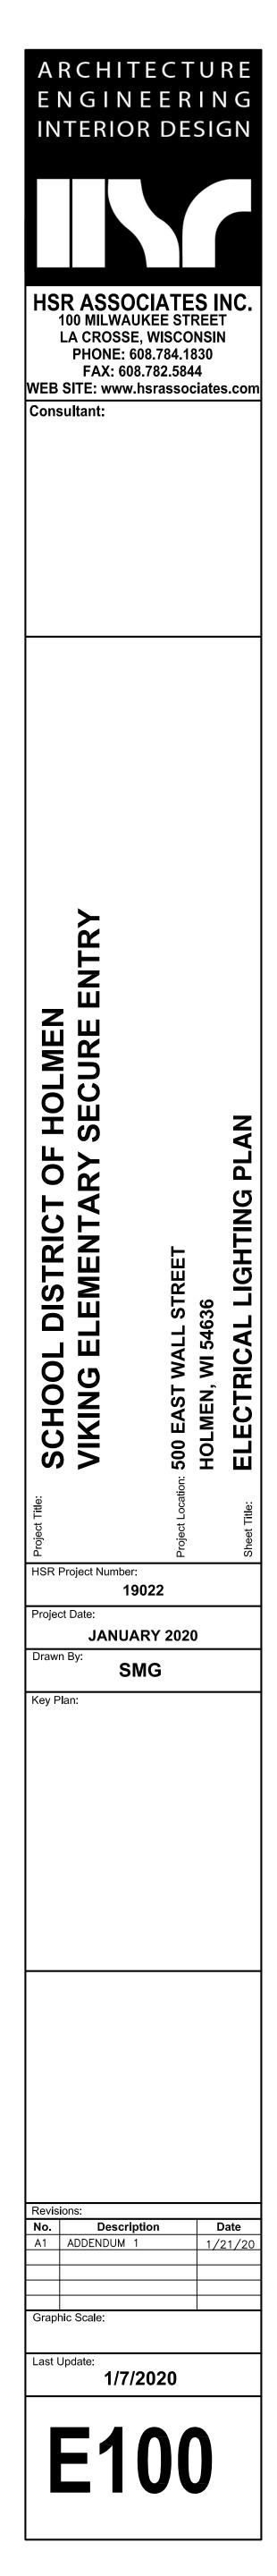

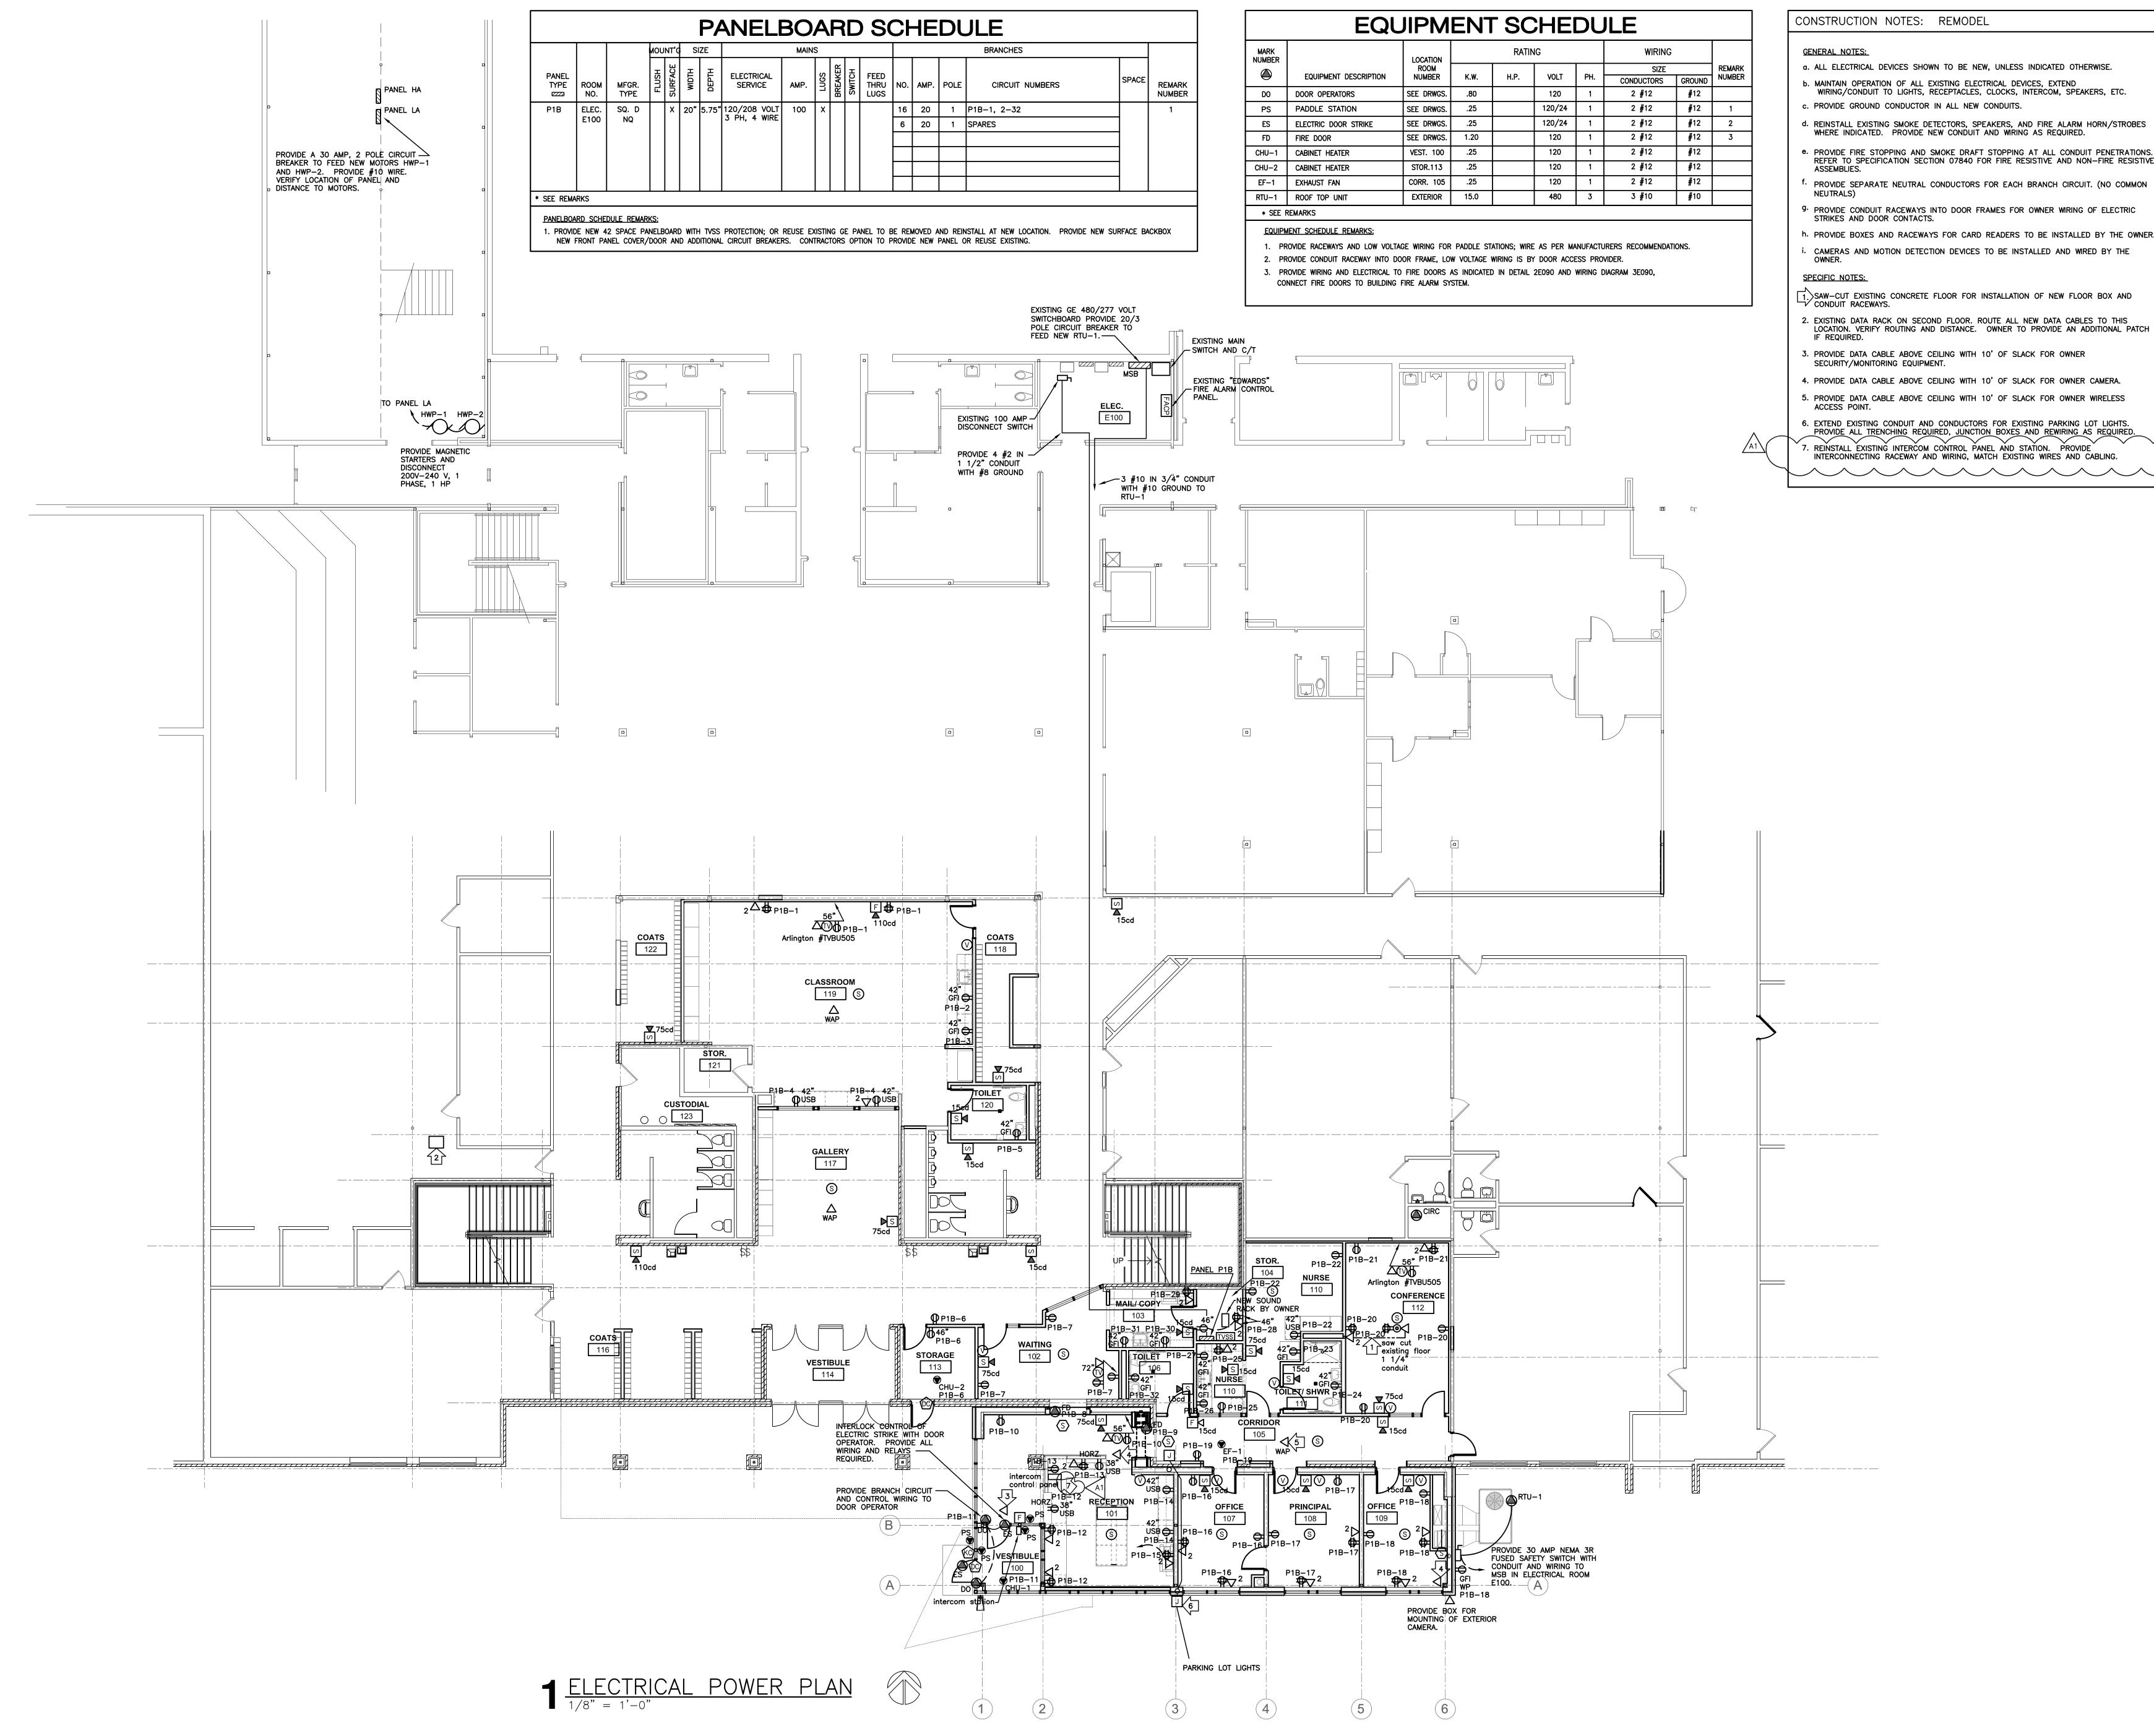

Location Room NUMBER	RATING				WIRING		
	K.W.	H.P.	VOLT	PH.	SIZE		REMARK NUMBER
					CONDUCTORS	GROUND	
SEE DRWGS.	.80		120	1	2 #12	<b>#</b> 12	
SEE DRWGS.	.25		120/24	1	2 #12	<b>#</b> 12	1
SEE DRWGS.	.25		120/24	1	2 #12	<b>#</b> 12	2
SEE DRWGS.	1.20		120	1	2 #12	<b>#</b> 12	3
VEST. 100	.25		120	1	2 #12	#12	
STOR.113	.25		120	1	2 #12	<b>#</b> 12	
CORR. 105	.25		120	1	2 #12	<b>#</b> 12	
EXTERIOR	15.0		480	3	3 #10	<b>#</b> 10	

## CONSTRUCTION NOTES: REMODEL

- a. ALL ELECTRICAL DEVICES SHOWN TO BE NEW, UNLESS INDICATED OTHERWISE.
- b. MAINTAIN OPERATION OF ALL EXISTING ELECTRICAL DEVICES, EXTEND WIRING/CONDUIT TO LIGHTS, RECEPTACLES, CLOCKS, INTERCOM, SPEAKERS, ETC. c. PROVIDE GROUND CONDUCTOR IN ALL NEW CONDUITS.
- d. REINSTALL EXISTING SMOKE DETECTORS, SPEAKERS, AND FIRE ALARM HORN/STROBES
- WHERE INDICATED. PROVIDE NEW CONDUIT AND WIRING AS REQUIRED.
- e. PROVIDE FIRE STOPPING AND SMOKE DRAFT STOPPING AT ALL CONDUIT PENETRATIONS. REFER TO SPECIFICATION SECTION 07840 FOR FIRE RESISTIVE AND NON-FIRE RESISTIVE PROVIDE SEPARATE NEUTRAL CONDUCTORS FOR EACH BRANCH CIRCUIT. (NO COMMON
- 9. PROVIDE CONDUIT RACEWAYS INTO DOOR FRAMES FOR OWNER WIRING OF ELECTRIC STRIKES AND DOOR CONTACTS.
- h. PROVIDE BOXES AND RACEWAYS FOR CARD READERS TO BE INSTALLED BY THE OWNER. CAMERAS AND MOTION DETECTION DEVICES TO BE INSTALLED AND WIRED BY THE

SAW-CUT EXISTING CONCRETE FLOOR FOR INSTALLATION OF NEW FLOOR BOX AND CONDUIT RACEWAYS.

- 2. EXISTING DATA RACK ON SECOND FLOOR. ROUTE ALL NEW DATA CABLES TO THIS LOCATION. VERIFY ROUTING AND DISTANCE. OWNER TO PROVIDE AN ADDITIONAL PATCH 3. PROVIDE DATA CABLE ABOVE CEILING WITH 10' OF SLACK FOR OWNER SECURITY/MONITORING EQUIPMENT.
- 4. PROVIDE DATA CABLE ABOVE CEILING WITH 10' OF SLACK FOR OWNER CAMERA. 5. PROVIDE DATA CABLE ABOVE CEILING WITH 10' OF SLACK FOR OWNER WIRELESS
- 6. EXTEND EXISTING CONDUIT AND CONDUCTORS FOR EXISTING PARKING LOT LIGHTS. PROVIDE ALL TRENCHING REQUIRED, JUNCTION BOXES AND REWIRING AS REQUIRED. REINSTALL EXISTING INTERCOM CONTROL PANEL AND STATION. PROVIDE
- INTERCONNECTING RACEWAY AND WIRING, MATCH EXISTING WIRES AND CABLING.

