

DOCUMENT 00 90 00
ADDENDUM

ADDENDUM NO. [2] **Date: June 15, 2020**

RE: WESTERN TECHNICAL COLLEGE
CLEARY COURTYARD BRICK PAVER REPLACEMENT
400 6th STREET NORTH
LA CROSSE, WISCONSIN 54601
HSR PROJECT NO. 20007

FROM: HSR Associates, Inc
100 Milwaukee Street
La Crosse, WI 54603
(608) 784-1830

To: Prospective Bidders

This addendum forms a part of the Contract Documents and modifies the original Bidding Documents dated May 2020. Acknowledge receipt of this Addendum in the space provided on the bid form. Failure to do so may subject the Bidder to disqualification.

This Addendum consists of [2] pages, [2] specification sections and [2] 30 x 42 DrawingS.

CHANGES TO PREVIOUS ADDENDUM

1. Addendum 1: Item 1, e; Delete aggregate gradation chart. Void filler shall be 1/4 – 3/8 inch Dresser Trap clean chips.

CHANGES TO BIDDING REQUIREMENTS, CONTRACT FORMS, AND CONDITIONS OF THE CONTRACT

2. Section 00 41 00 BID FORM
 - a. Revised Bid Form attached hereto.

CHANGES TO GENERAL REQUIREMENTS

3. Section 01 23 00 ALTERNATE BIDS
 - a. Section attached hereto as part of Contract Documents.

CHANGES TO DRAWINGS

4. Sheet C101 LAYOUT PLAN 30 x 42 attached hereto.
 - a. Revisions clouded on Drawing.
5. Paver Sand Bed and Fabric: The following specification is for the sand bed to be replaced in accordance with Alternate #1.
SETTING BED SAND
 - (1) Provide setting bed sand as follows:
 - 2) Washed, clean, non-plastic, free from deleterious or foreign matter, symmetrically shaped, natural or manufactured from crushed rock.
 - 3) Do not use limestone screenings, stone dust, or sand for bedding sand material that do not conform to the gradation requirements of ASTM C 33.
 - 4) Do not use mason sand or sand conforming to ASTM C 144 for bedding sand.

- 5) Use sands that are as hard as practically available.
 - 6) Sieve according to ASTM C 136.
 - B. Gradation Requirements for Setting Bed Sand - ASTM C33:

Sieve Size	Percent Passing
3/8 inch (9.5 mm)	100
No. 4 (4.75 mm)	95 to 100
No. 8 (2.36 mm)	80 to 100
No. 16 (1.18 mm)	50 to 85
No. 30 (0.600 mm)	25 to 60
No. 50 (0.300 mm)	10 to 30
No. 100 (0.150 mm)	2 to 10
No 200 (0.075 mm)	0 to 1
 - 7) Engineering Fabric: Acceptable knit fabrics: WS DOT 645.2.4 Geotextile Fabric, Type DF (Drainage Filtration).
6. Sheet C102 DETAILS 30 x 42 attached hereto.
- a. Revisions clouded on Drawing.

END OF DOCUMENT 00 90 00

DOCUMENT 00 41 00

BID FORM

BIDDER: _____

BID FOR SINGLE PRIME CONTRACT

PROJECT: **WESTERN TECHNICAL COLLEGE
CLEARY COURTYARD BRICK PAVER REPLACEMENT
400 6th STREET NORTH
LA CROSSE, WISCONSIN 54601
HSR PROJECT NO. 20007**

TO: **WESTERN TECHNICAL COLLEGE
400 7TH STREET NORTH
LA CROSSE, WISCONSIN 54601**

BASE BID

The undersigned, having examined the site where the Work is to be executed and become familiar with local conditions affecting the cost of the Work and carefully examined the Project Manual, the Project Drawings, all other Bidding Documents and Addenda thereto prepared by the AE, HSR Associates, Inc., hereby agrees to provide all labor, materials, equipment and services necessary for the complete and satisfactory execution of the ENTIRE WORK, in the time frame stipulated in these contract documents, for the Base Bid stipulated sum of:

_____ Dollars (\$_____ .00)

ALTERNATE BIDS

The undersigned further agrees to perform the alternative portions of the Work as described in the Project Manual, Section 01 23 00 Alternates, for the following additions to or deductions from the Base Bid sum stipulated above:

Alternate No. 1 Paver Bed and Fabric Replacement

Add _____ Dollars (\$_____ .00)

In submitting this Bid, the undersigned agrees to:

1. Hold this Bid open for **60** days.
2. Accept the provisions of Instructions to Bidders regarding disposition of Bid Security.
3. Enter into and execute an Agreement, if awarded on the basis of this Bid, and to furnish Performance and Labor and Material Payment Bonds according to the Supplementary Conditions.
4. Accomplish work according to the Contract Documents.
5. Complete the work by the time stated in Section 01 10 00 Summary of the Work.

Page Intentionally Left Blank

Receipt of the following Addenda and inclusion of their provisions in this Bid is hereby acknowledged:

Addendum No. _____ Dated _____

Addendum No. _____ Dated _____

Addendum No. _____ Dated _____

Attached hereto are the required:

- a. () Bid Security
- b. () Certificate of Organization and Authority
- c. () Non-Collusive Affidavit: An affidavit in proof that the undersigned has not entered into any collusion with any person in respect to this Bid or any other bid or the submitting of bids for the contract for which this bid is submitted.
- d. () Certification of Non-segregated Facilities

FIRM NAME: _____

(Affix seal if Corporation)

By: _____

Title: _____

By: _____

Title: _____

Date: _____

Official Address: _____

Telephone: _____

END OF DOCUMENT 00 41 00

Page Intentionally Left Blank

**SECTION 01 23 00
ALTERNATES**

PART 1 GENERAL

1.01 SECTION INCLUDES

- A. Description of Alternates.

1.02 RELATED REQUIREMENTS

- A. Document 00 21 13 - Instructions to Bidders: Instructions for preparation of pricing for Alternates.

1.03 DESCRIPTION

- A. Conditions of the Contract and pertinent portions of Sections in Division One of this Project Manual, apply to the Work of this Section as fully as though repeated herein.
- B. This Section describes the alternates to the project. Refer to the Product/Execution Articles of the Contract Documents for information pertaining to the work of each alternate.
- C. Each proposal under an alternate shall include all incidental work and all adjustments necessary to accommodate the changes. All work shall meet the requirements of the Contract Documents.
- D. Each alternate proposal shall be submitted as an individual cost for the particular alternate and shall be proposed under the premise that no other alternates have been accepted. Should the work of an alternate called for by the Bid Form not affect the cost of the work, "No Change" shall be stated.
- E. Owner may, at his option, vary the scope of the work by authorizing alternates which will add to the work, deduct from the work or substitute materials, equipment or methods.
- F. Immediately following Award of Contract, awarded Contractor shall prepare and distribute to each party involved, notification of the status of each alternate. Indicate whether alternates have been accepted, rejected, or deferred for consideration at a later date. Include a complete description of negotiated modifications to alternates, if any.

1.04 ACCEPTANCE OF ALTERNATES

- A. Alternates quoted on Bid Forms will be reviewed and accepted or rejected at Owner's option. Accepted Alternates will be identified in the Owner-Contractor Agreement.

1.05 SCHEDULE OF ALTERNATES

- A. Alternate No. 1: Paver Setting Bed and Fabric Replacement
 - 1. The following work shall be priced under Alternate No. 1: State the amount to be added to the base bid to remove existing sand setting bed and geotextile fabric and replace with new sand bed and fabric.

PART 2 PRODUCTS - NOT USED

PART 3 EXECUTION - NOT USED

END OF SECTION

Page Intentionally Left Blank



HSR ASSOCIATES INC.
100 MILWAUKEE STREET
LA CROSSE, WISCONSIN
PHONE: 608.784.1830
FAX: 608.782.8844
www.hsrassociates.com

Consultant:
POB
Point of Beginning

WESTERN TECHNICAL COLLEGE
CLEARLY PLAZA
400 6TH STREET
LA CROSSE, WI 54601
DETAILS

Project Title: WESTERN TECHNICAL COLLEGE CLEARLY PLAZA

HSR Project Number: 00000

Project Date: 5/22/2020

Drawn By: M.K.


Key Plan:

Revisions:
6/15/2020 ADDENDUM #2


Graphic Scale: NTS

Last Update: 5/22/2020


C102

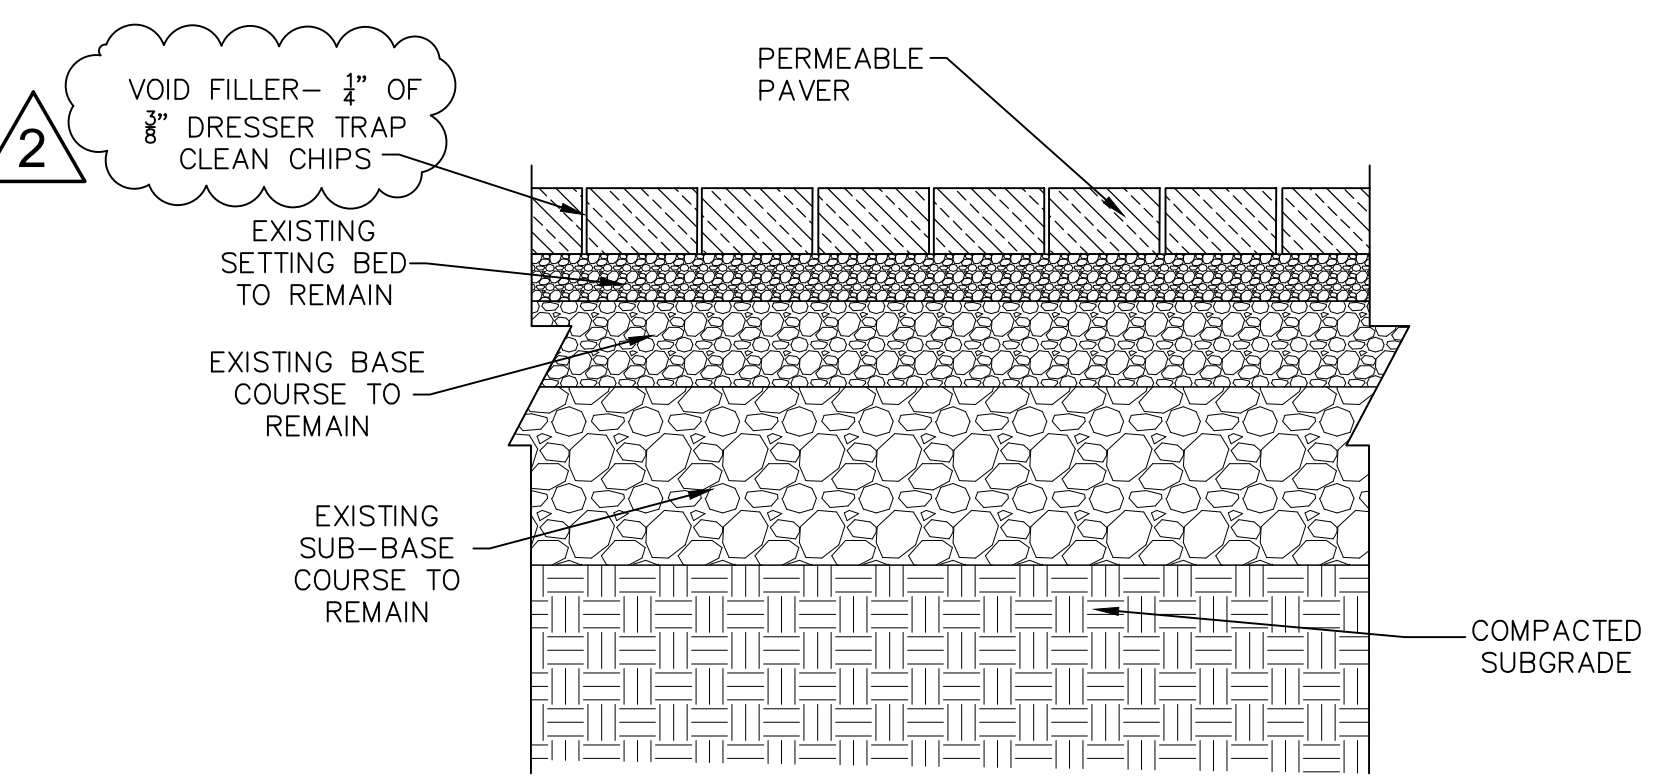


PERMEABLE PAVERS
(TYP. SECTION) 1
C102

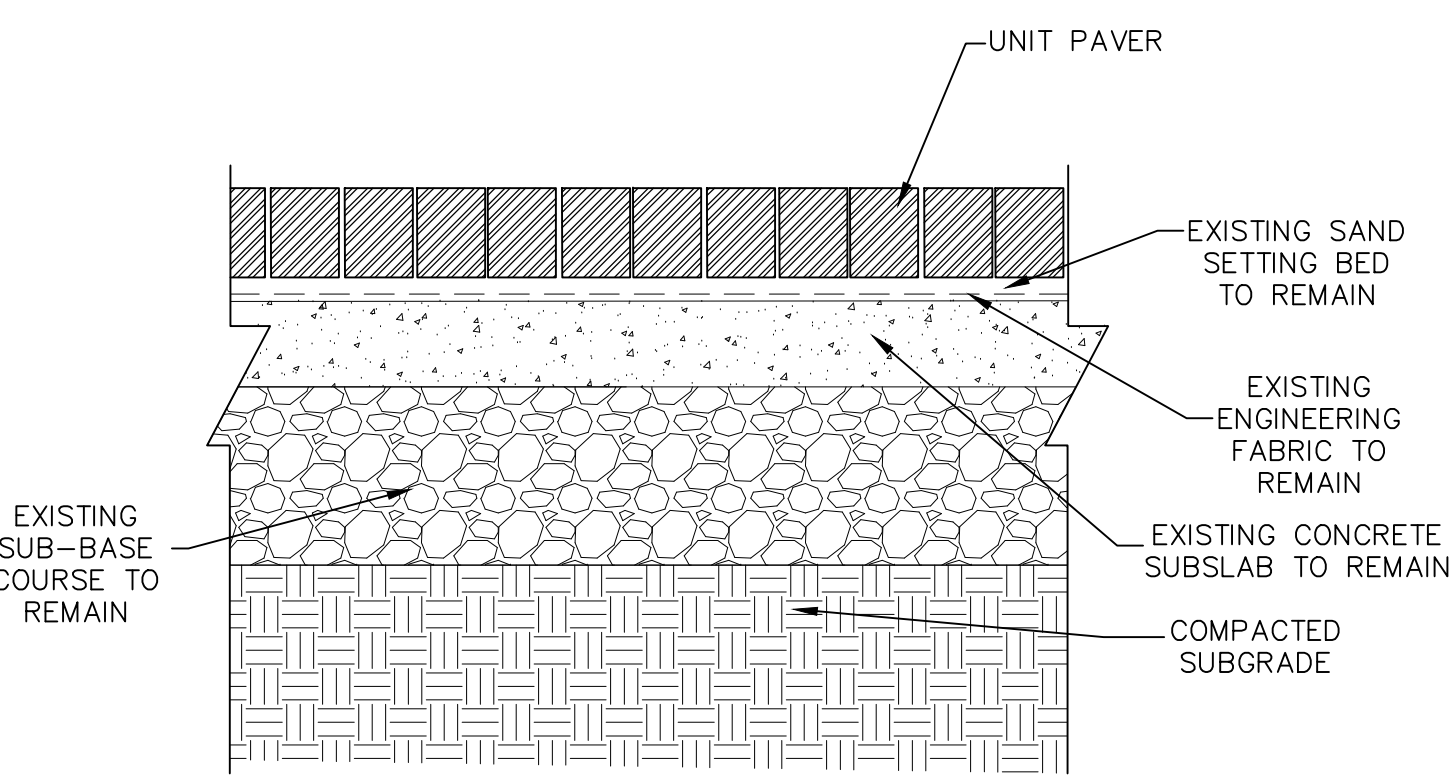


UNIT PAVERS
(TYP. SECTION) 2
C102

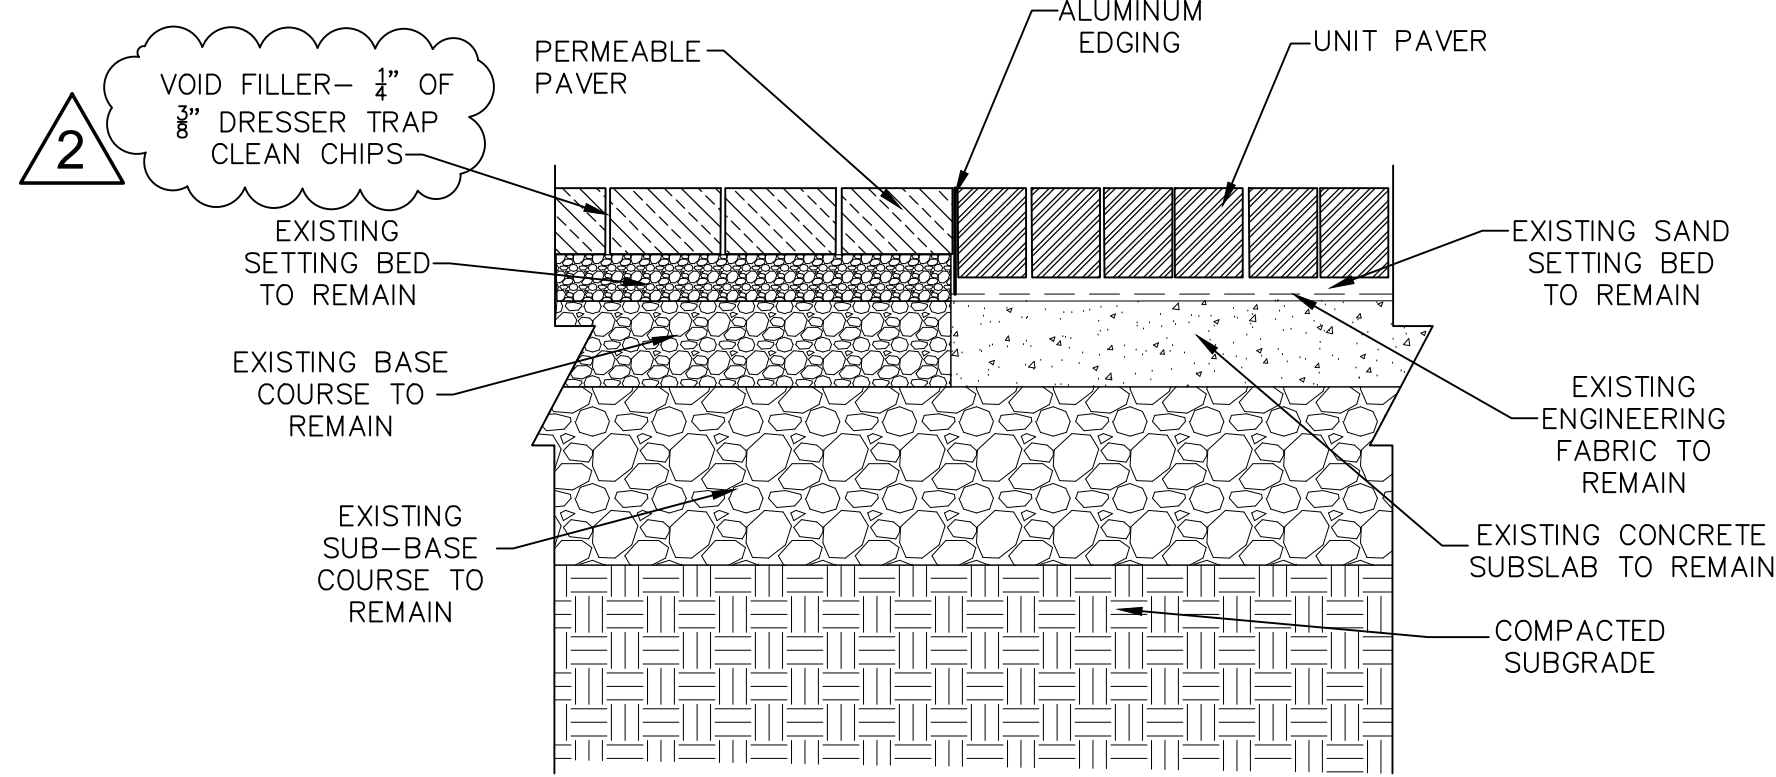


PERMEABLE PAVERS
@ UNIT PAVERS 3
C102

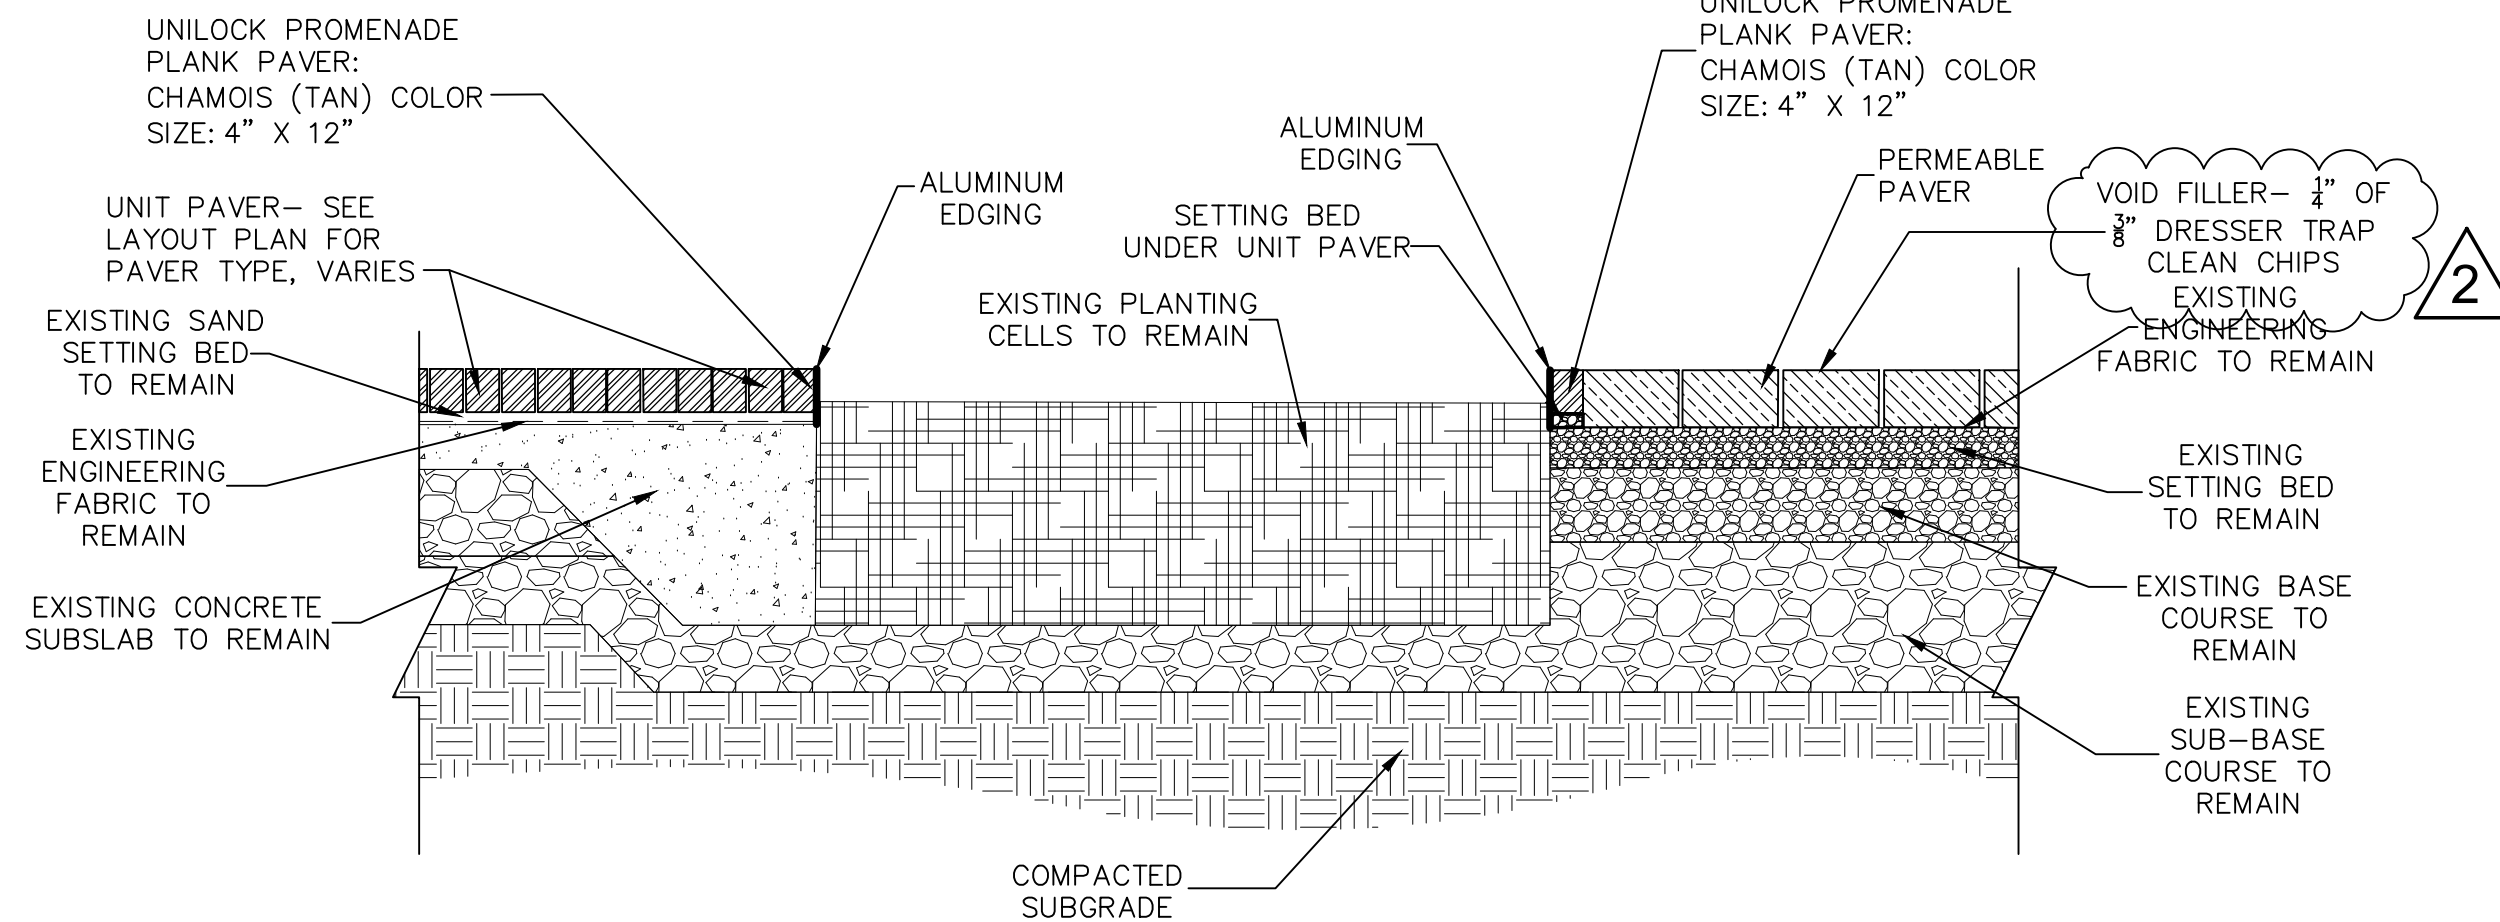


PERMEABLE & UNIT PAVERS
@ PLANTING CELLS 4
C102

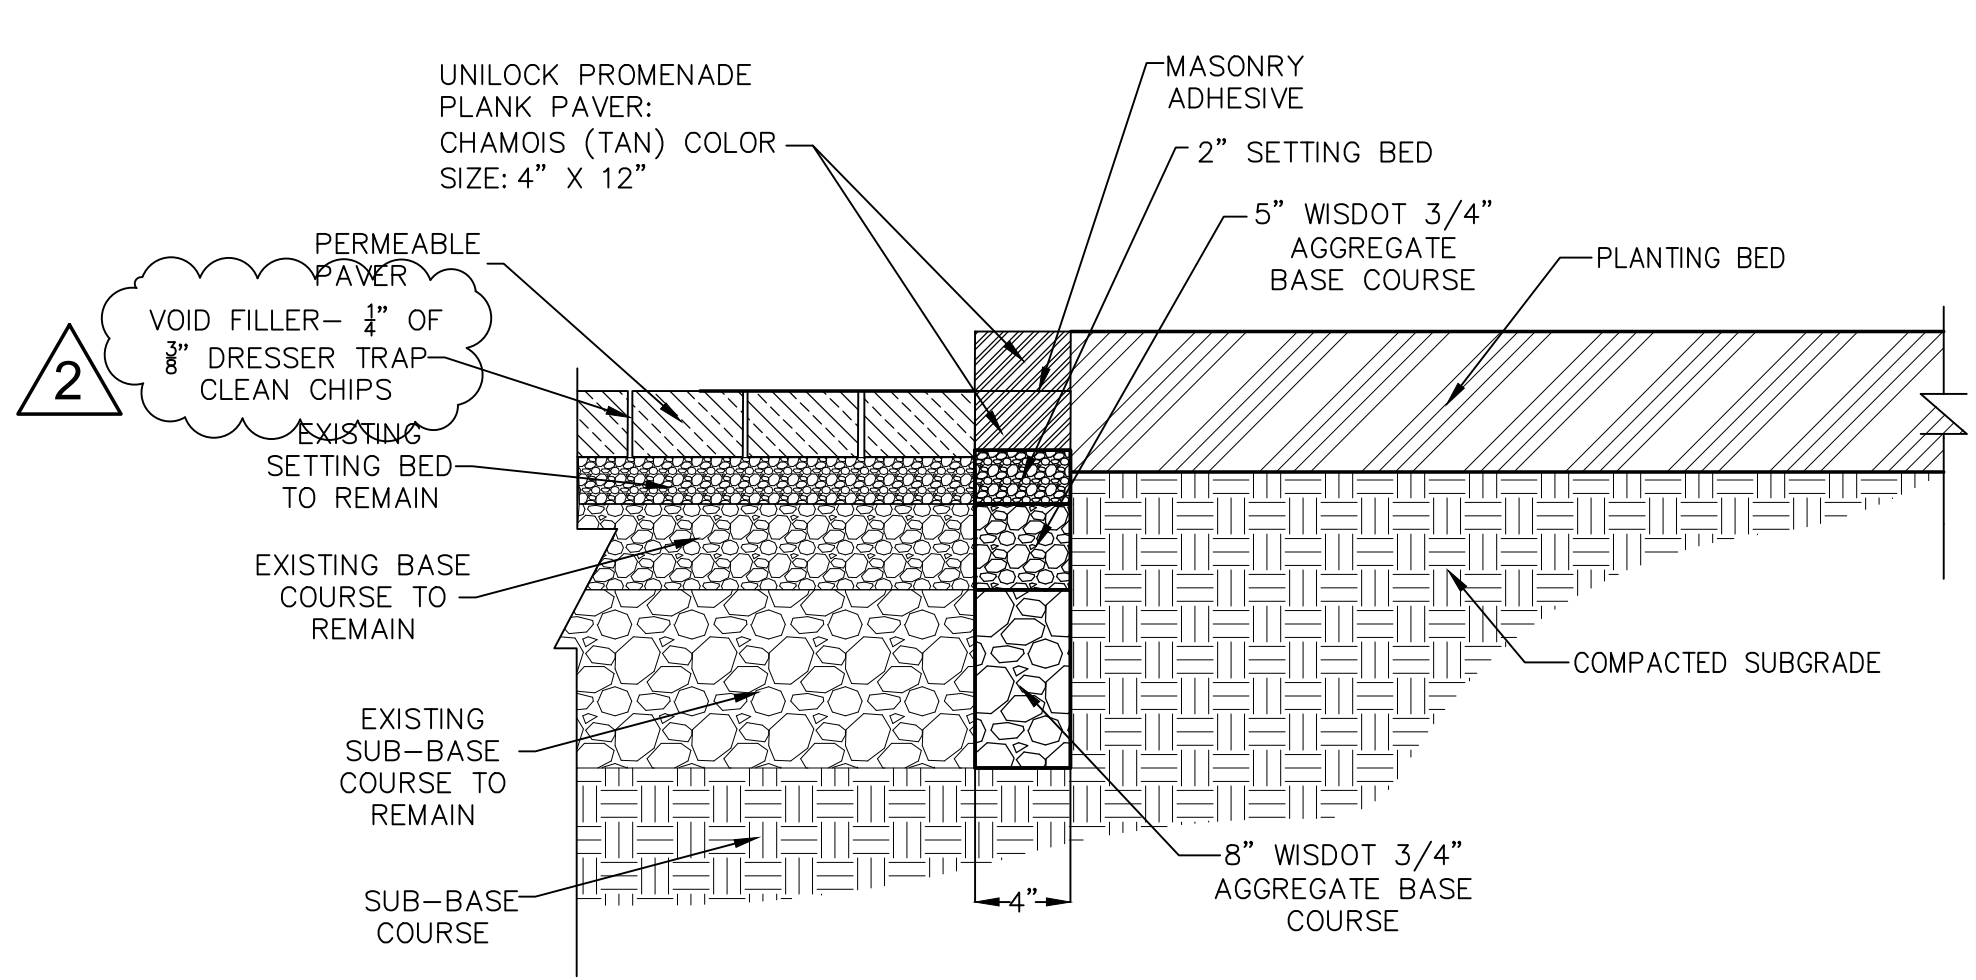


PERMEABLE PAVERS
@ PAVER EDGING 5
C102

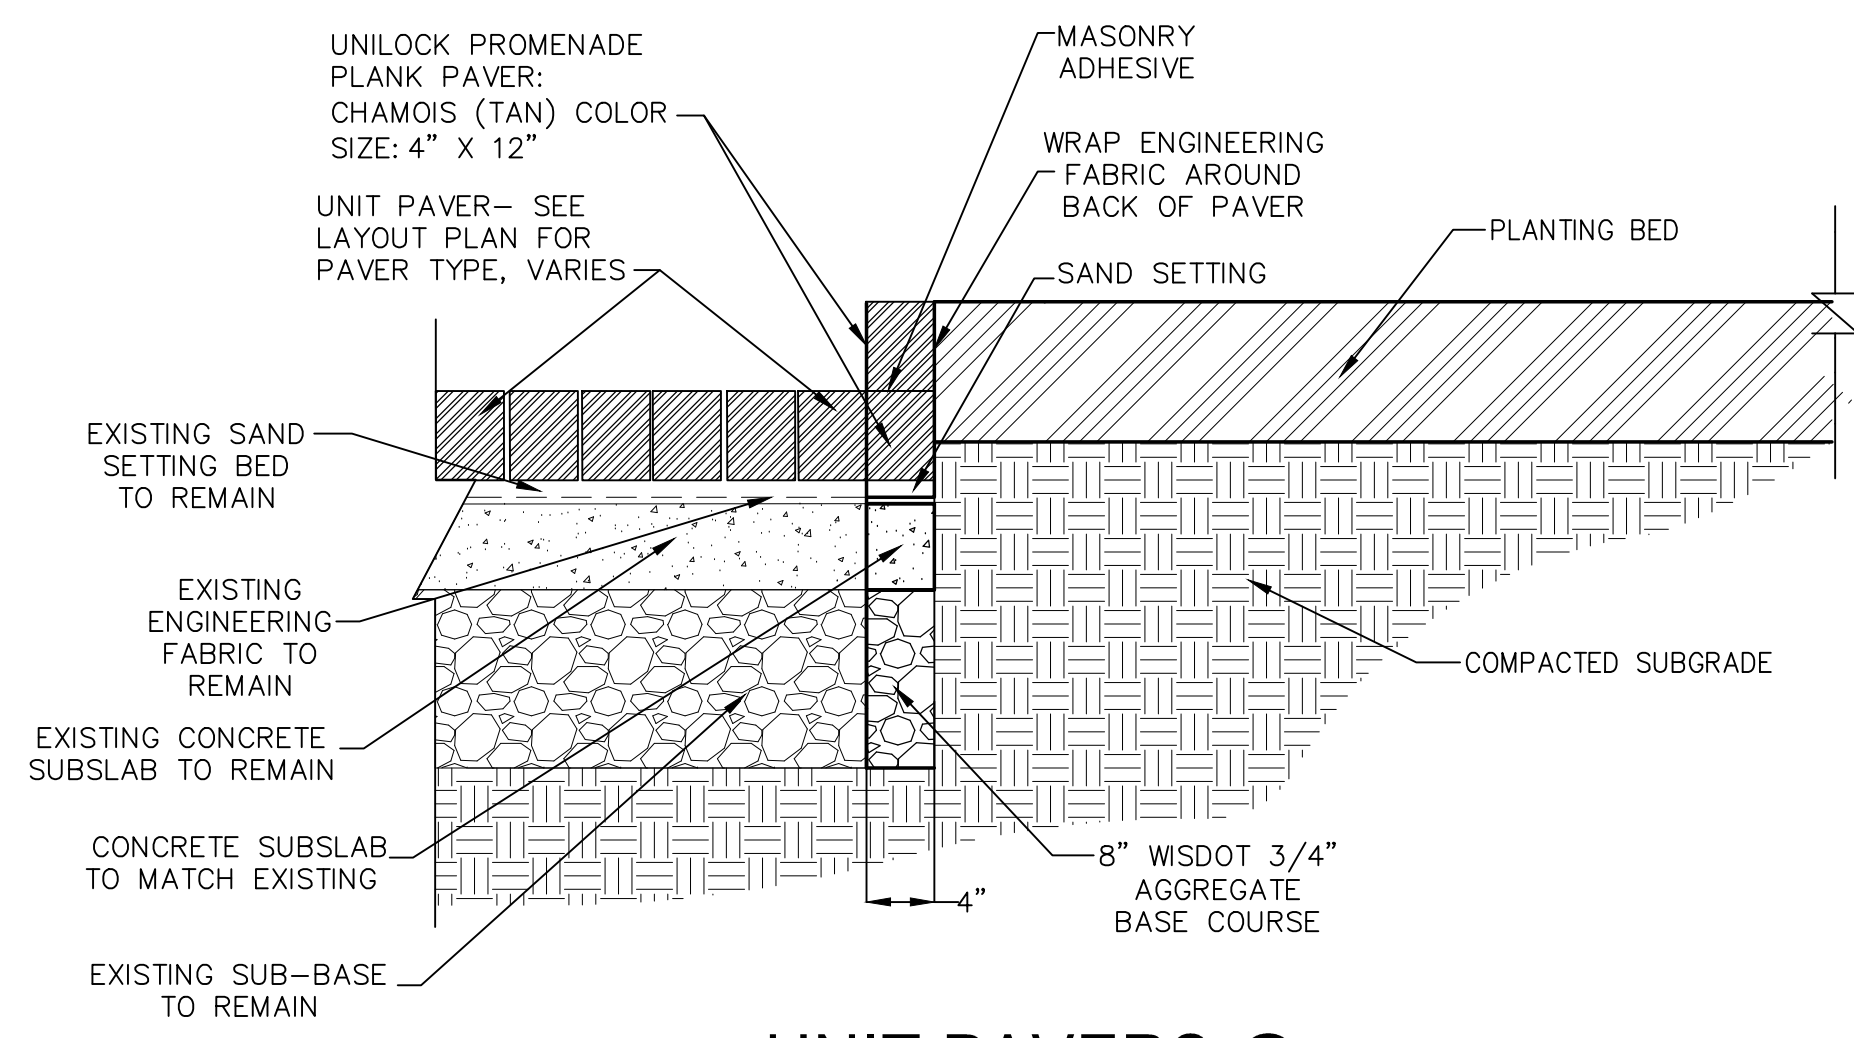

UNIT PAVERS @
PAVER EDGING 6
C102

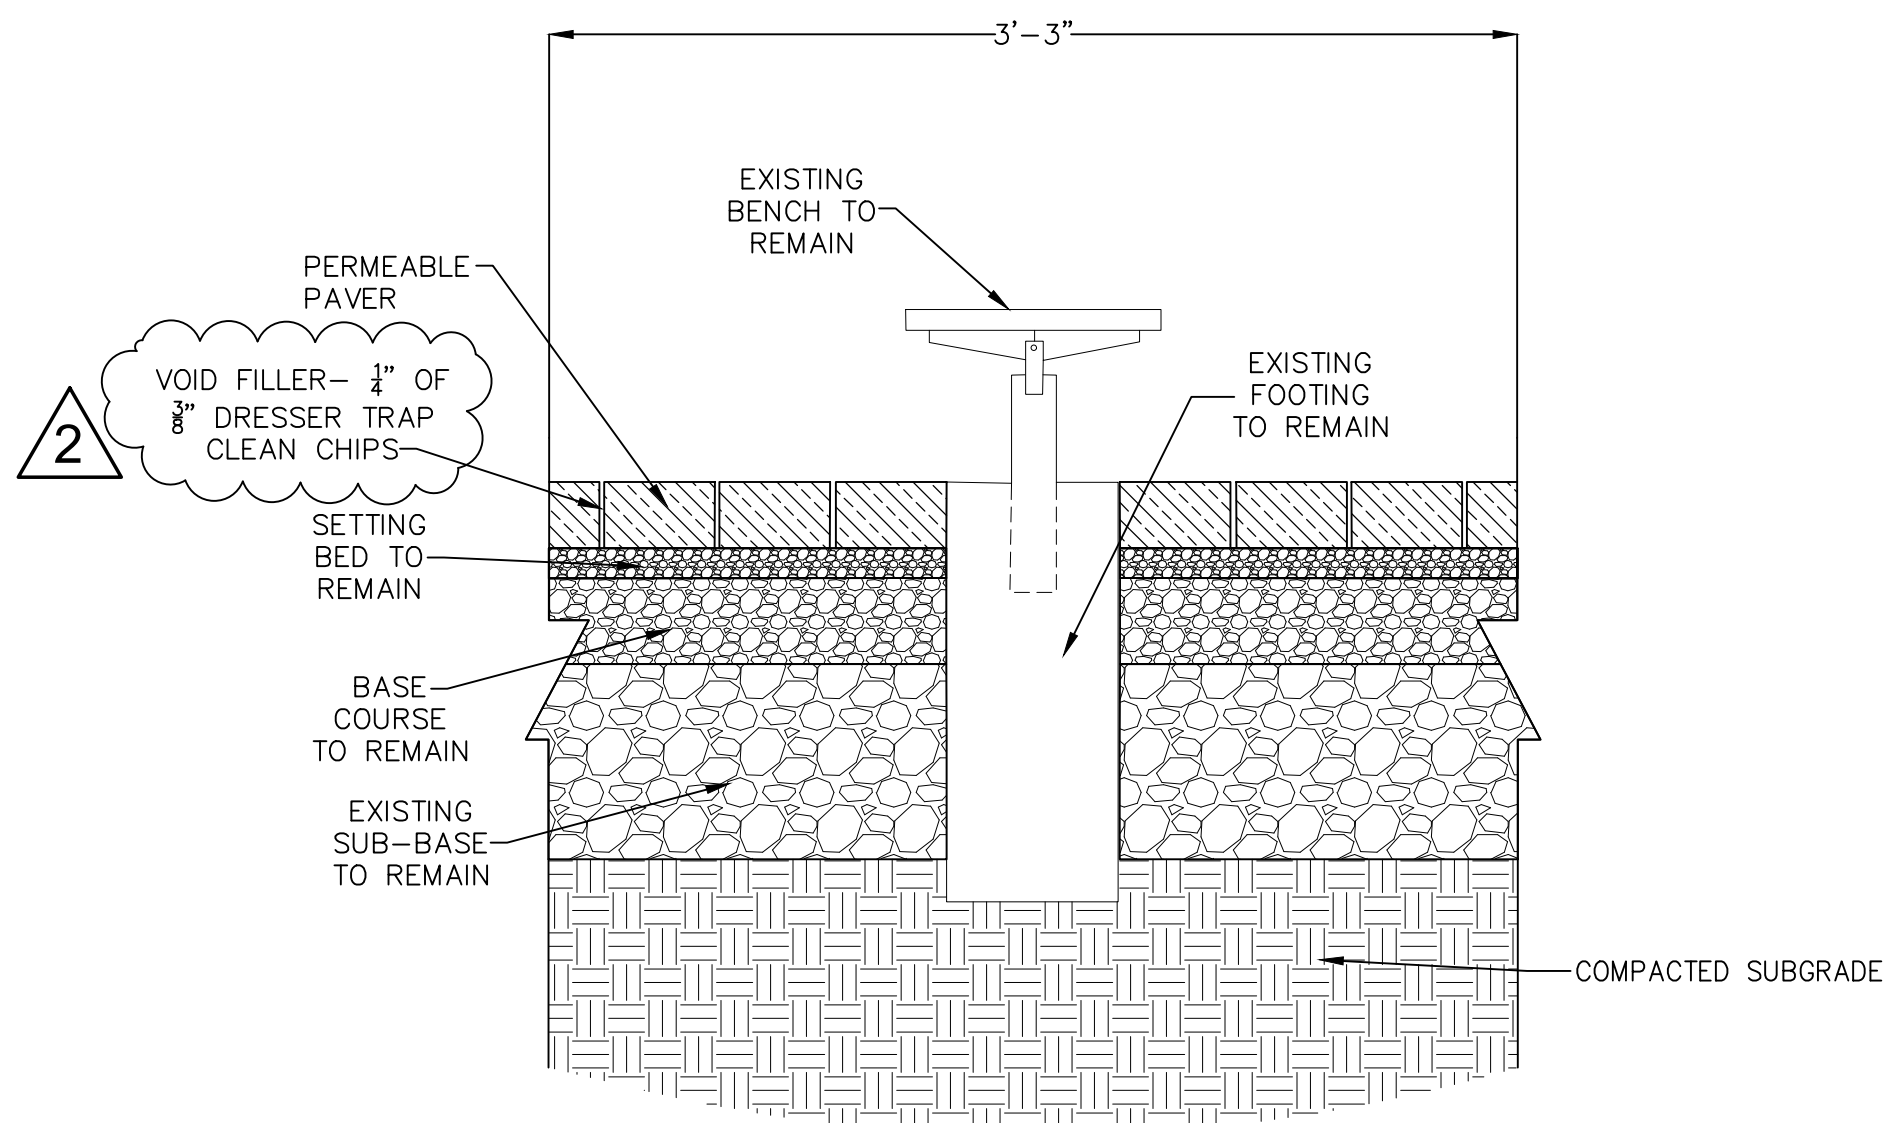

PERMEABLE PAVERS
@ BENCH 7
C102

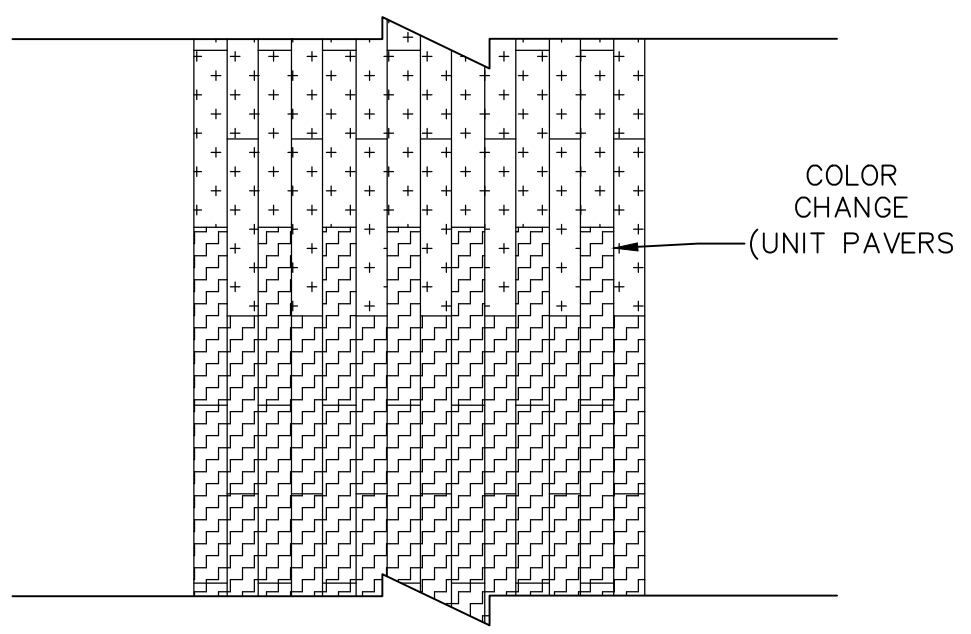

UNIT PAVER
COLOR CHANGE 8
C102