

**DOCUMENT 00 90 00
ADDENDUM**

ADDENDUM NO. [2] Date: October 1, 2020

**RE: LA CROSSE HOUSING AUTHORITY
 2020 CAPITAL IMPROVEMENT PROJECTS - BID PKG 2
 1307 BADGER STREET
 LA CROSSE, WISCONSIN 54601
 HSR PROJECT NO. 20040**

**FROM: HSR Associates, Inc
 100 Milwaukee Street
 La Crosse, WI 54603
 (608) 784-1830**

To: Prospective Bidders

This addendum forms a part of the Contract Documents and modifies the original Bidding Documents dated September 2020. Acknowledge receipt of this Addendum in the space provided on the bid form. Failure to do so may subject the Bidder to disqualification.

This Addendum consists of [1] page and [2] 30 x 42 drawings.

CHANGES TO SPECIFICATIONS

1. Section
 - a. 2.02, B:

CHANGES TO DRAWINGS

2. Sheet A600 SITE PLAN 30 x 42 attached hereto
 - a. Revision to number of buildings to receive Work scope.
3. Sheet A621 ELEVATIONS & DETAILS 30 x 42 attached hereto
 - a. Revisions clouded on Drawing.

END OF DOCUMENT 00 90 00

Page Intentionally Left Blank



Consultant:

Project Title: HOUSING AUTHORITY OF THE CITY OF LA CROSSE
2020 CAPITAL IMPROVEMENT PROJECTS

Project Location: WINNESHEIK RD. & ST. JAMES ST.

Sheet Title: SITE PLAN

HSR Project Number: 20040

Project Date: SEPTEMBER 2020

Drawn By: MPL

Key Plan:

No.	Description	Date
A02	ADDENDUM 2	10-01-2020

Graphic Scale:

VARIES

Last Update:

10/1/2020 11:00:24 AM

LEGEND:

ALL UNITS ARE 2 STORY

- A- 4 UNITS (TYP OF 2)
- B- 6 UNITS (TYP OF 4)
- C- 4 UNITS (TYP OF 2)
- D- 4 UNITS (TYP OF 1)
- E- NOT BUILT
- F- 4 UNITS (TYP OF 2)
- G- 2 UNITS (TYP 2)

WOOD STREET



SCHUH-MULLEN
COMMUNITY CENTER
- SEE SHEET A610

ST. JAMES STREET

WINNESHEIK ROAD


THESE BUILDINGS
REMOVED FROM SCOPE

ST. CLOUD STREET

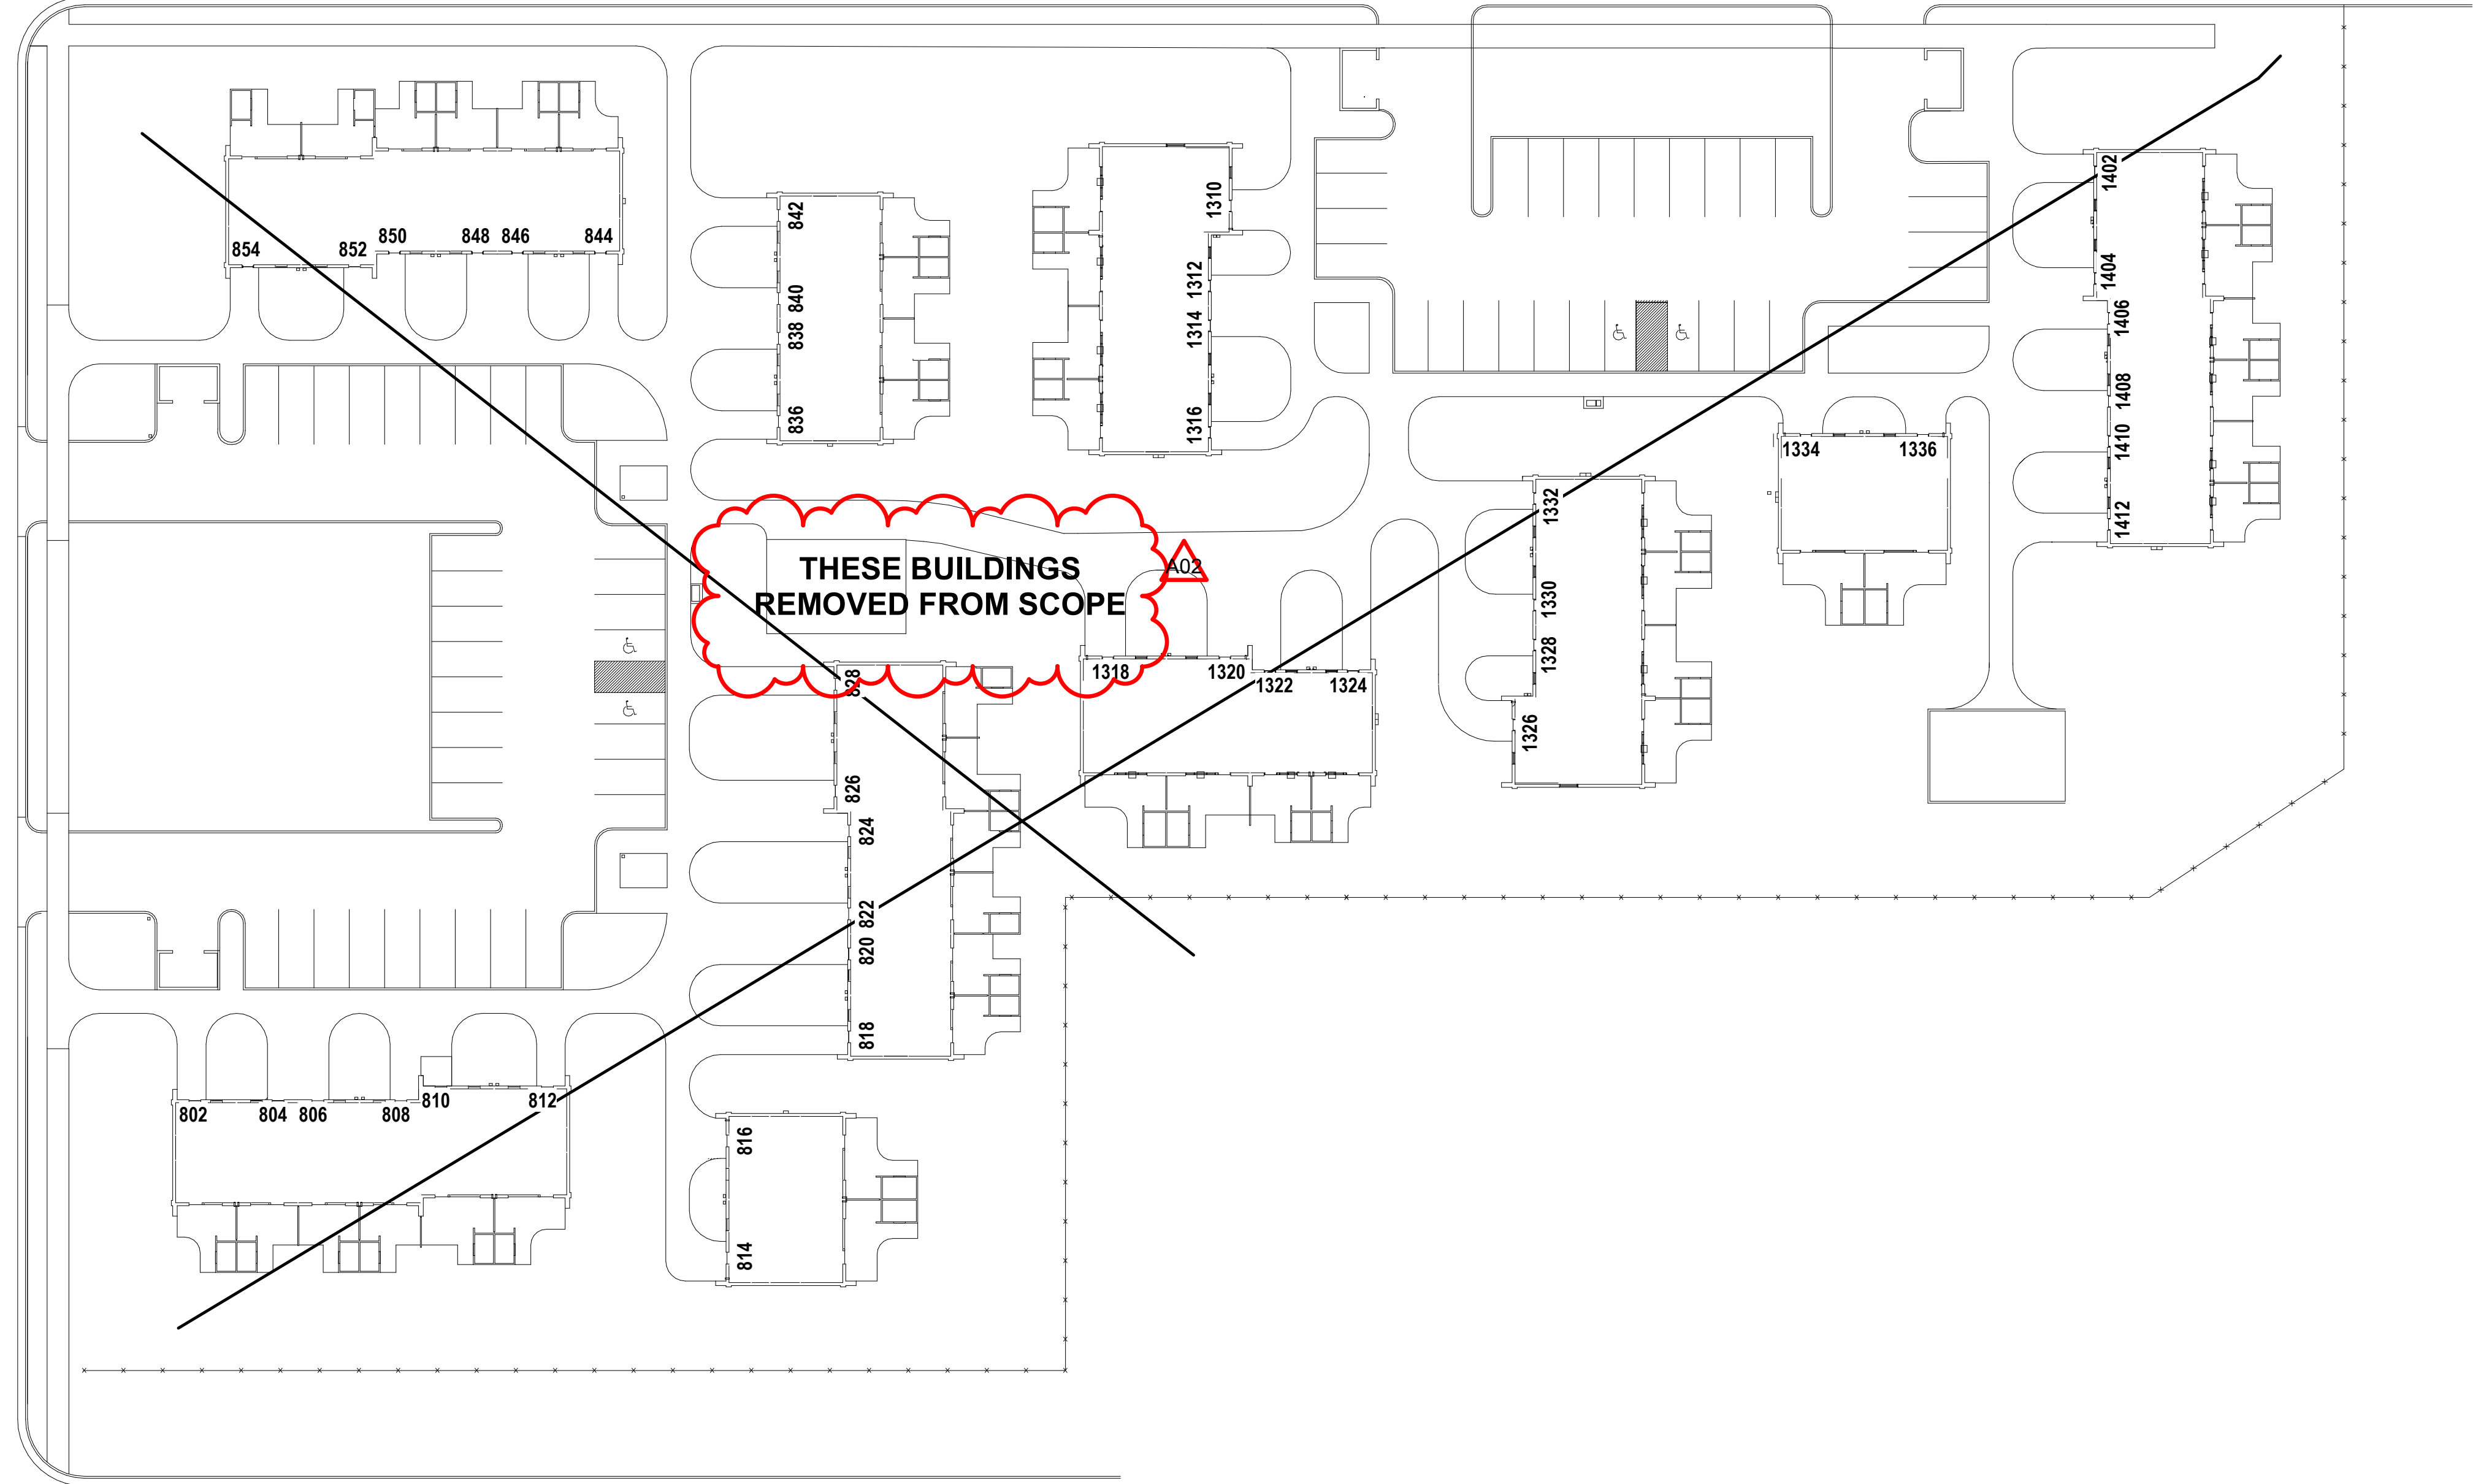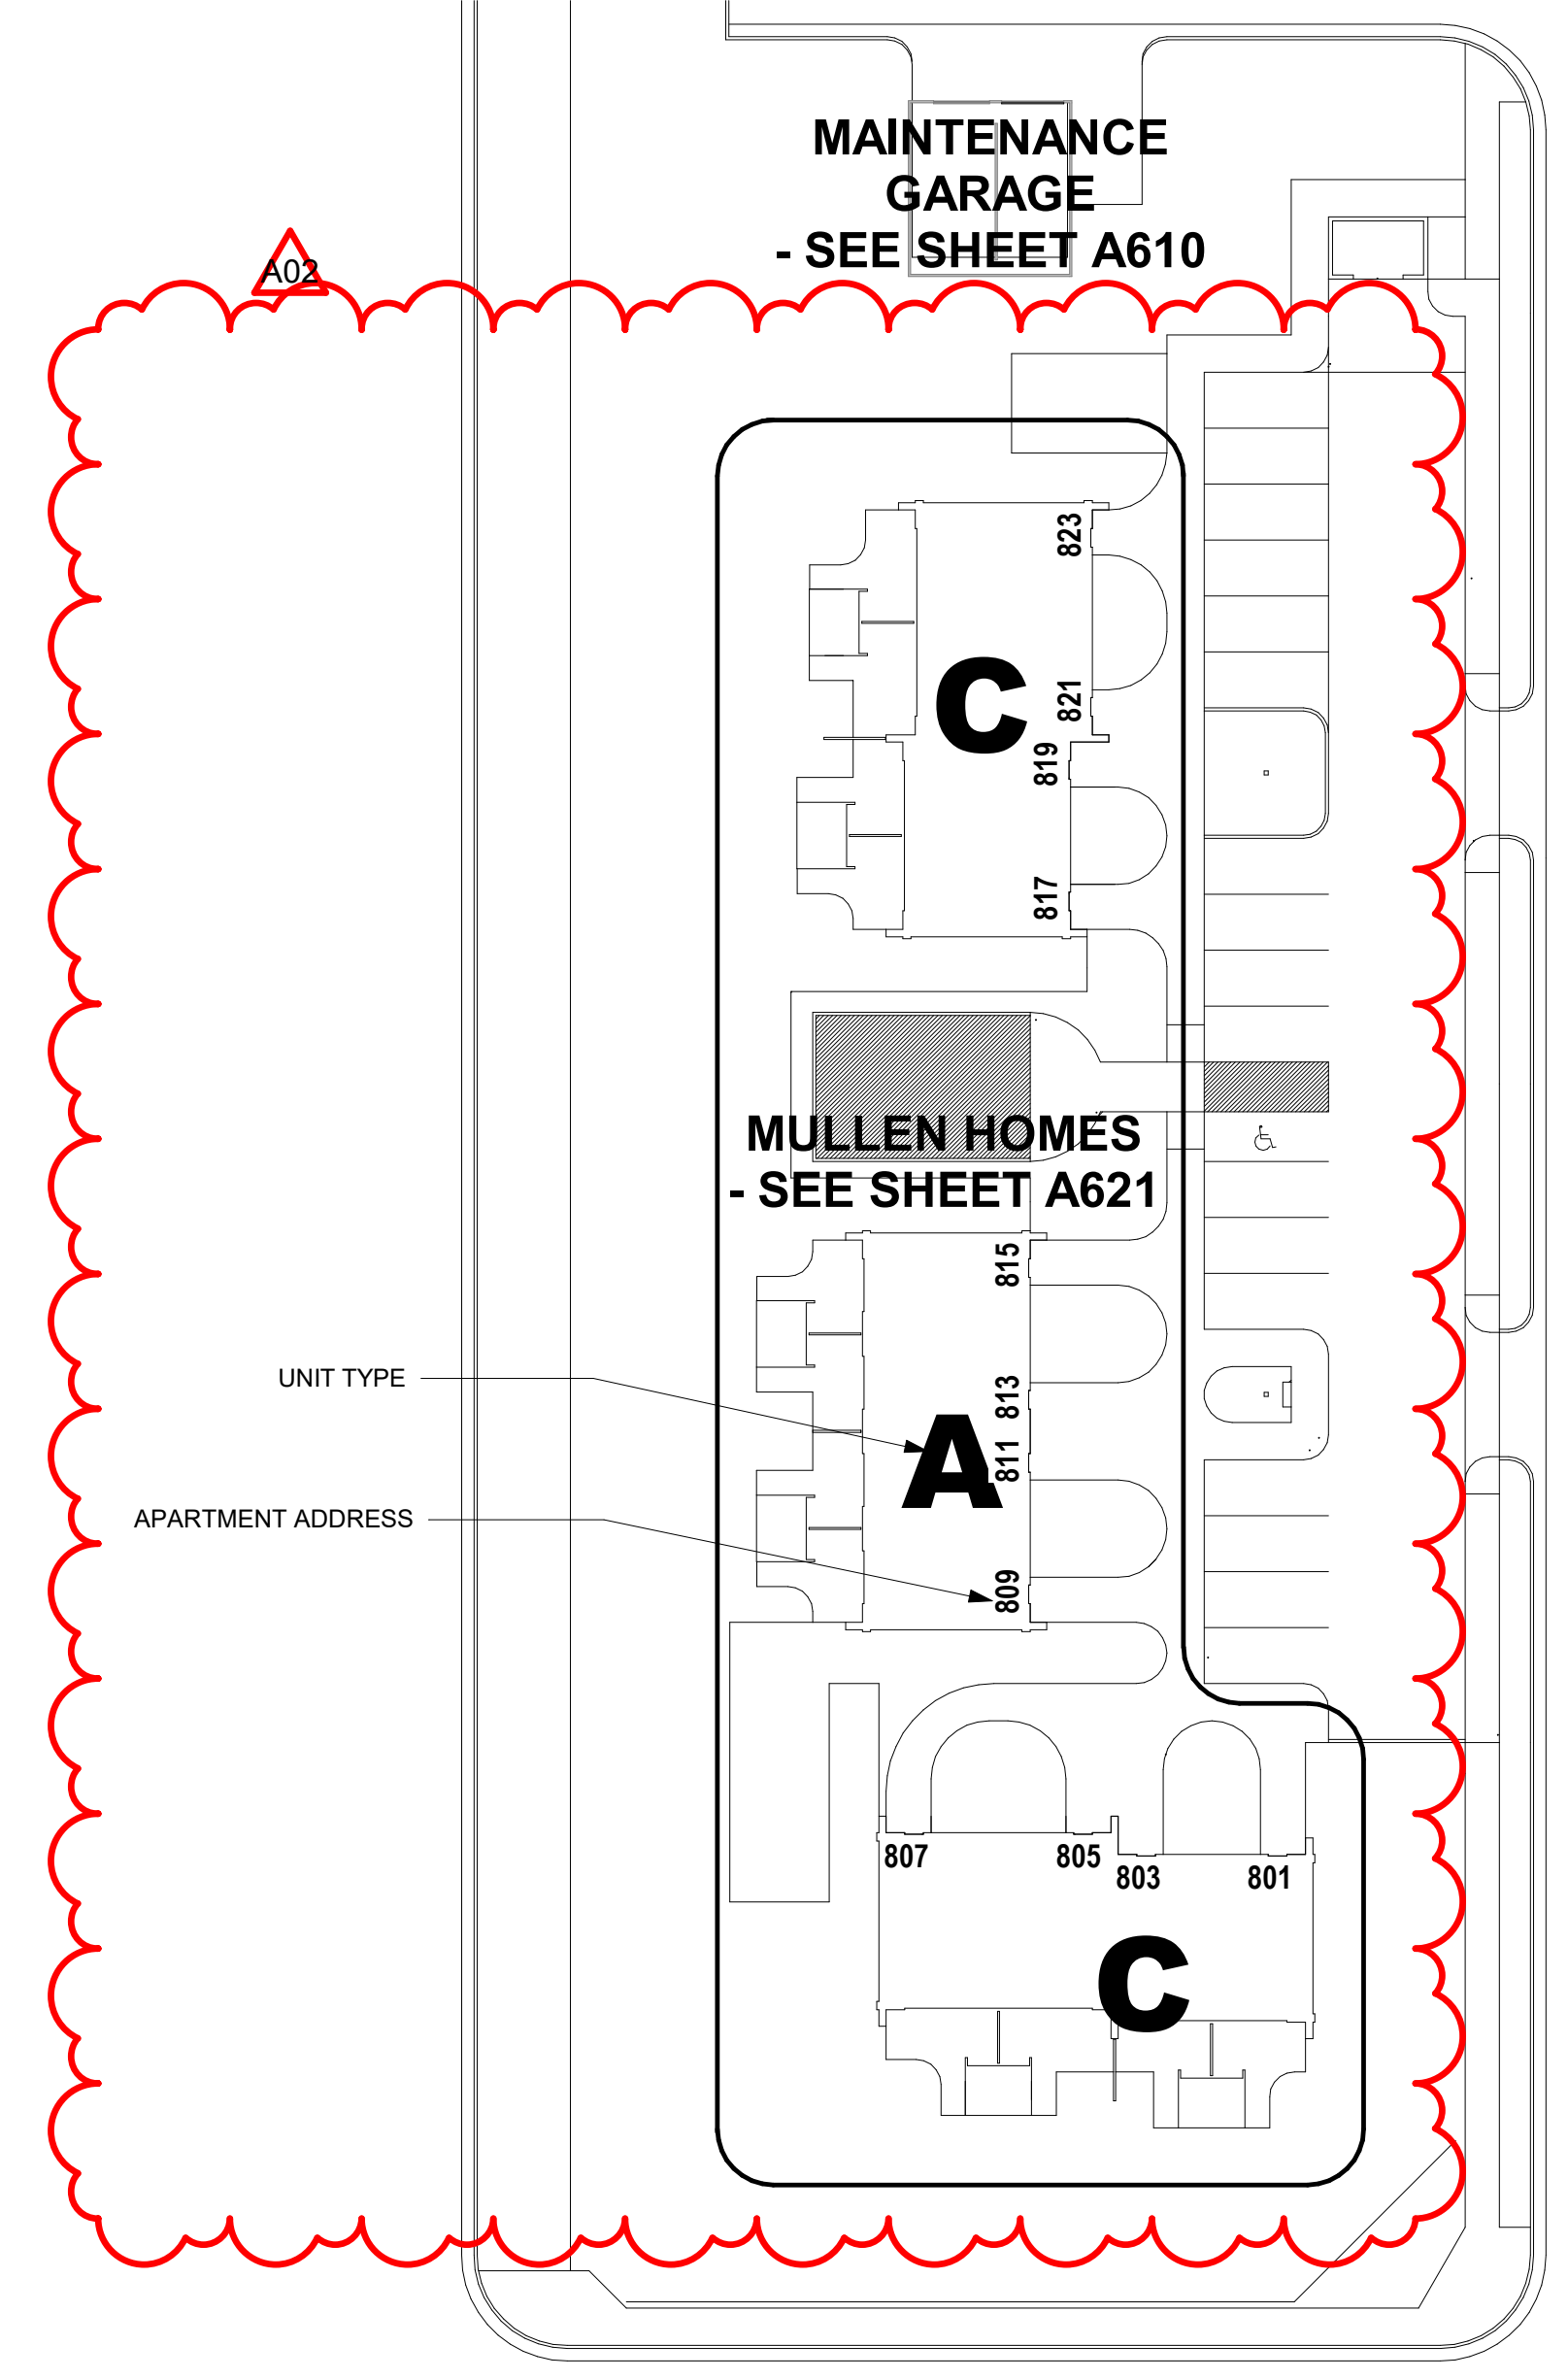

1 SITE PLAN

1" = 30'-0"

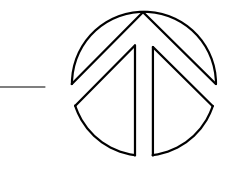

MULLEN HOMES

A600



Consultant:

HOUSING AUTHORITY OF THE CITY OF LA CROSSE
2020 CAPITAL IMPROVEMENT PROJECTS
Project Location: WINNESHEIK RD. & ST JAMES ST.
ELEVATIONS- DETAILS

Project Title:
Project Number:
Project Date:
Drawn By:
Key Plan:

HSR Project Number: 20040
Project Date: SEPTEMBER 2020
Drawn By: MPL

Key Plan:

No.	Description	Date
A01	ADDENDUM 1	09-29-2020
A02	ADDENDUM 2	10-01-2020

Graphic Scale:
VARIES

Last Update:
10/1/2020 11:00:24 AM

A621

GENERAL NOTES:

A REMOVE ALL WINDOWS, AND INTERIOR TRIM, AND SILLS.

B ALL SECOND FLOOR WINDOWS HAVE SIDING BUTTING INTO ONE JAMB (8A621). CONTRACTOR SHALL DETERMINE THE MOST EFFECTIVE WAY TO REMOVE/INSTALL WINDOW WITHOUT DAMAGE TO SIDING. RETENTION OF SIDING IS PREFERRED. IF REMOVAL OF CEMENT BOARD IS REQUIRED, AND PIECES DAMAGED SHALL BE REPLACED WITH NEW. TOUCH UP PAINT AT CHIPS 1/2" IN DIAMETER OR LESS WITHOUT INDENTATIONS ALLOWED.

C WHERE SOFFIT PANELS ARE BELOW THE HEAD OF FIRST FLOOR WINDOWS (8A621 APPROX. 12"), REMOVE SOFFIT FOR WINDOW REPLACEMENT AND REINSTALL SALVAGED SOFFIT. DAMAGED PANELS SHALL BE REPLACED WITH NEW.



1 TYPE 'A' UNIT- REAR ELEVATION
1/8" = 1'-0"




2 TYPE 'C' UNIT- REAR ELEVATION
1/8" = 1'-0"



3 TYPE 'A' UNIT- FRONT ELEVATION
1/8" = 1'-0"




4 TYPE 'C' UNIT- FRONT ELEVATION
1/8" = 1'-0"

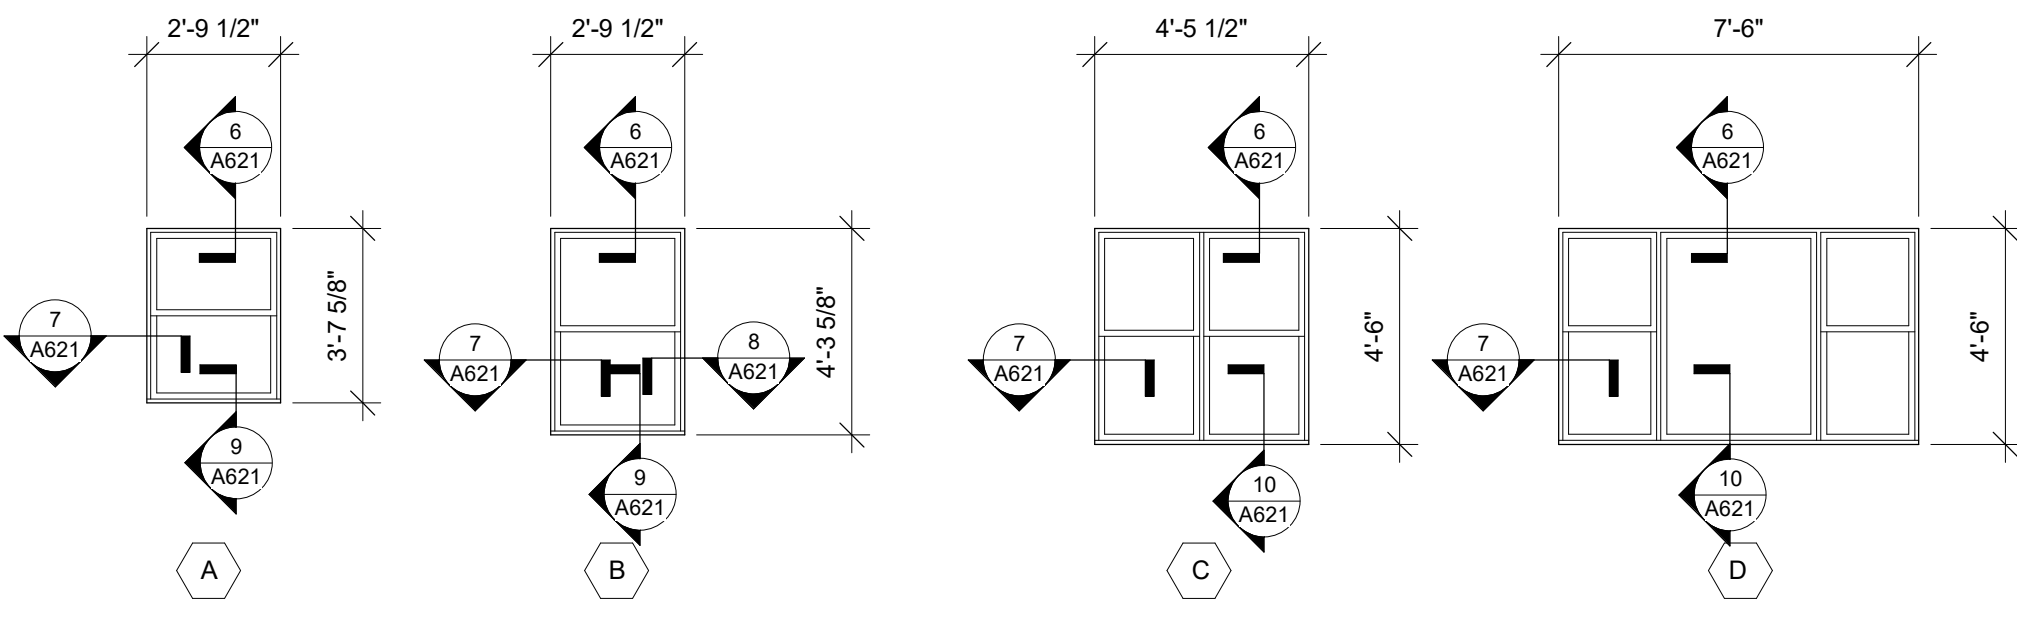


5 WINDOW TYPES- MULLEN
1/4" = 1'-0"

FIBERGLASS DOUBLE-HUNG WINDOWS


NOTE:
FIELD VERIFY FINAL ROUGH OPENINGS PRIOR TO ORDERING WINDOWS.

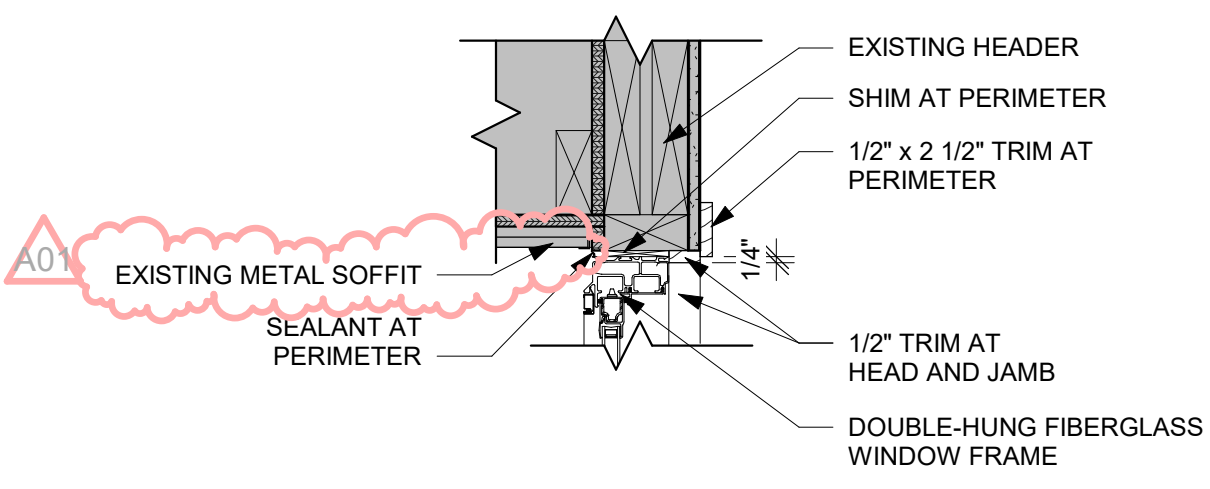


6 WDW HEAD
1 1/2" = 1'-0"

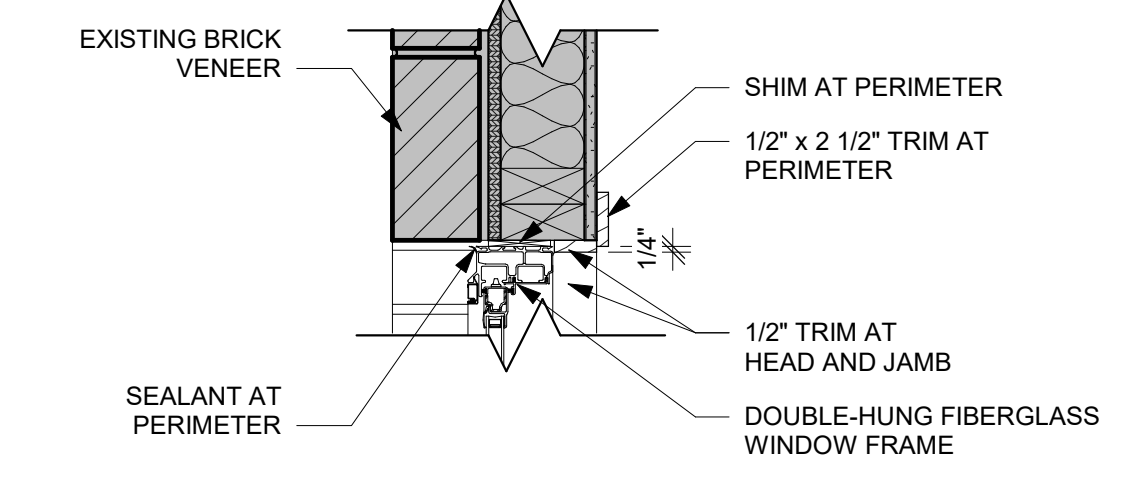


7 WDW JAMB
1 1/2" = 1'-0"

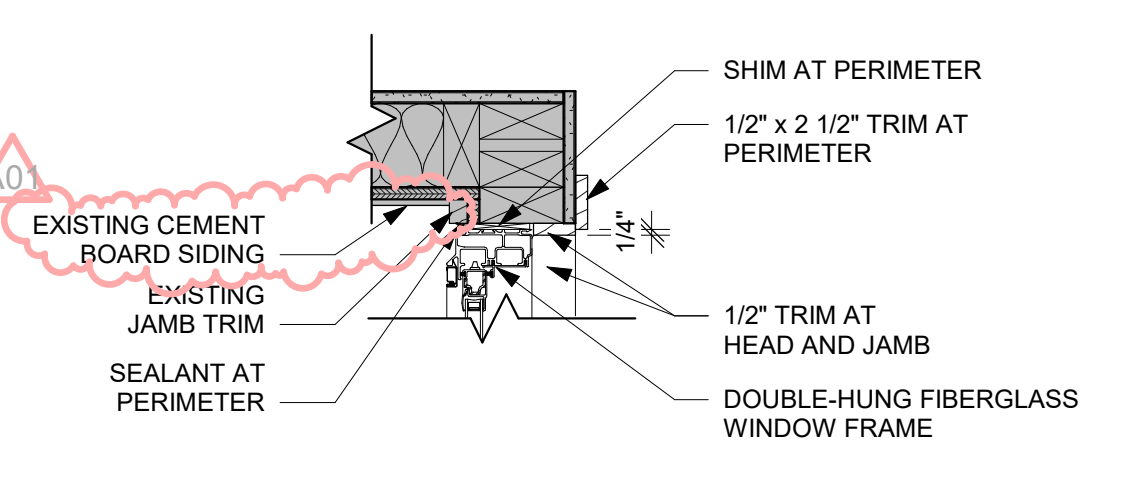

8 WDW JAMB
1 1/2" = 1'-0"

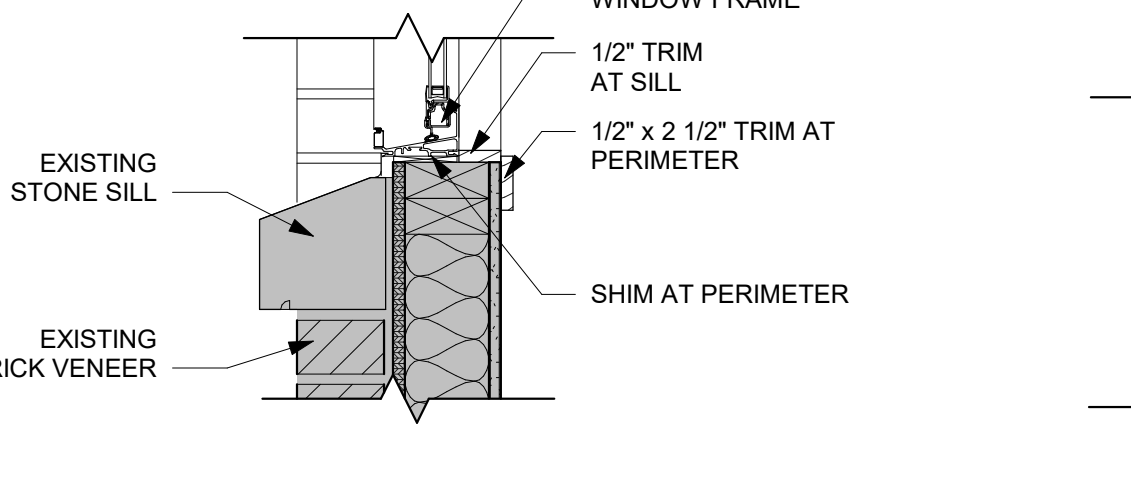

9 WDW SILL
1 1/2" = 1'-0"

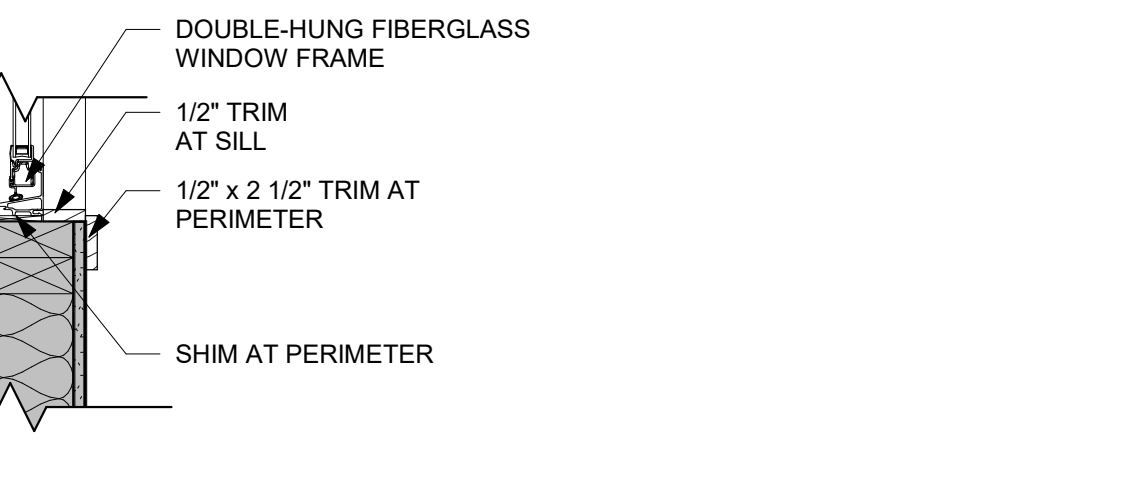

10 WDW SILL
1 1/2" = 1'-0"



SOFFIT AT FIRST FLOOR WINDOWS

(GENERAL NOTE C)



TYPICAL SECOND FLOOR WINDOW

(GENERAL NOTE B)

MULLEN HOMES