

**DOCUMENT 00 90 00
ADDENDUM**

ADDENDUM NO. [2] Date: October 11, 2022

**RE: New Richmond Kitchen & Canine Rm Renovation
 Northwood Technical College
 HSR Project 21066-1**

**FROM: HSR Associates, Inc
 100 Milwaukee Street
 La Crosse, WI 54603
 (608) 784-1830**

To: Prospective Bidders

This addendum forms a part of the Contract Documents and modifies the original Bidding Documents dated September 28, 2022. Acknowledge receipt of this Addendum in the space provided on the bid form. Failure to do so may subject the Bidder to disqualification.

This Addendum consists of [1] page and [2] drawings.



DRAWINGS:

1. Sheet P003:
 - a. Revise existing conditions per site verification at walk-through.
 - b. Revise new 3" floor drain pipe routing and connection location to existing 3" sanitary main.
 - c. Add 1 ½" relief vent for floor drain circuit venting for canine room.

2. Sheet P004:
 - a. Revise Sanitary Plumbing Isometric per changes to plans in this Addendum.



END OF DOCUMENT 00 90 00

Page Intentionally Left Blank

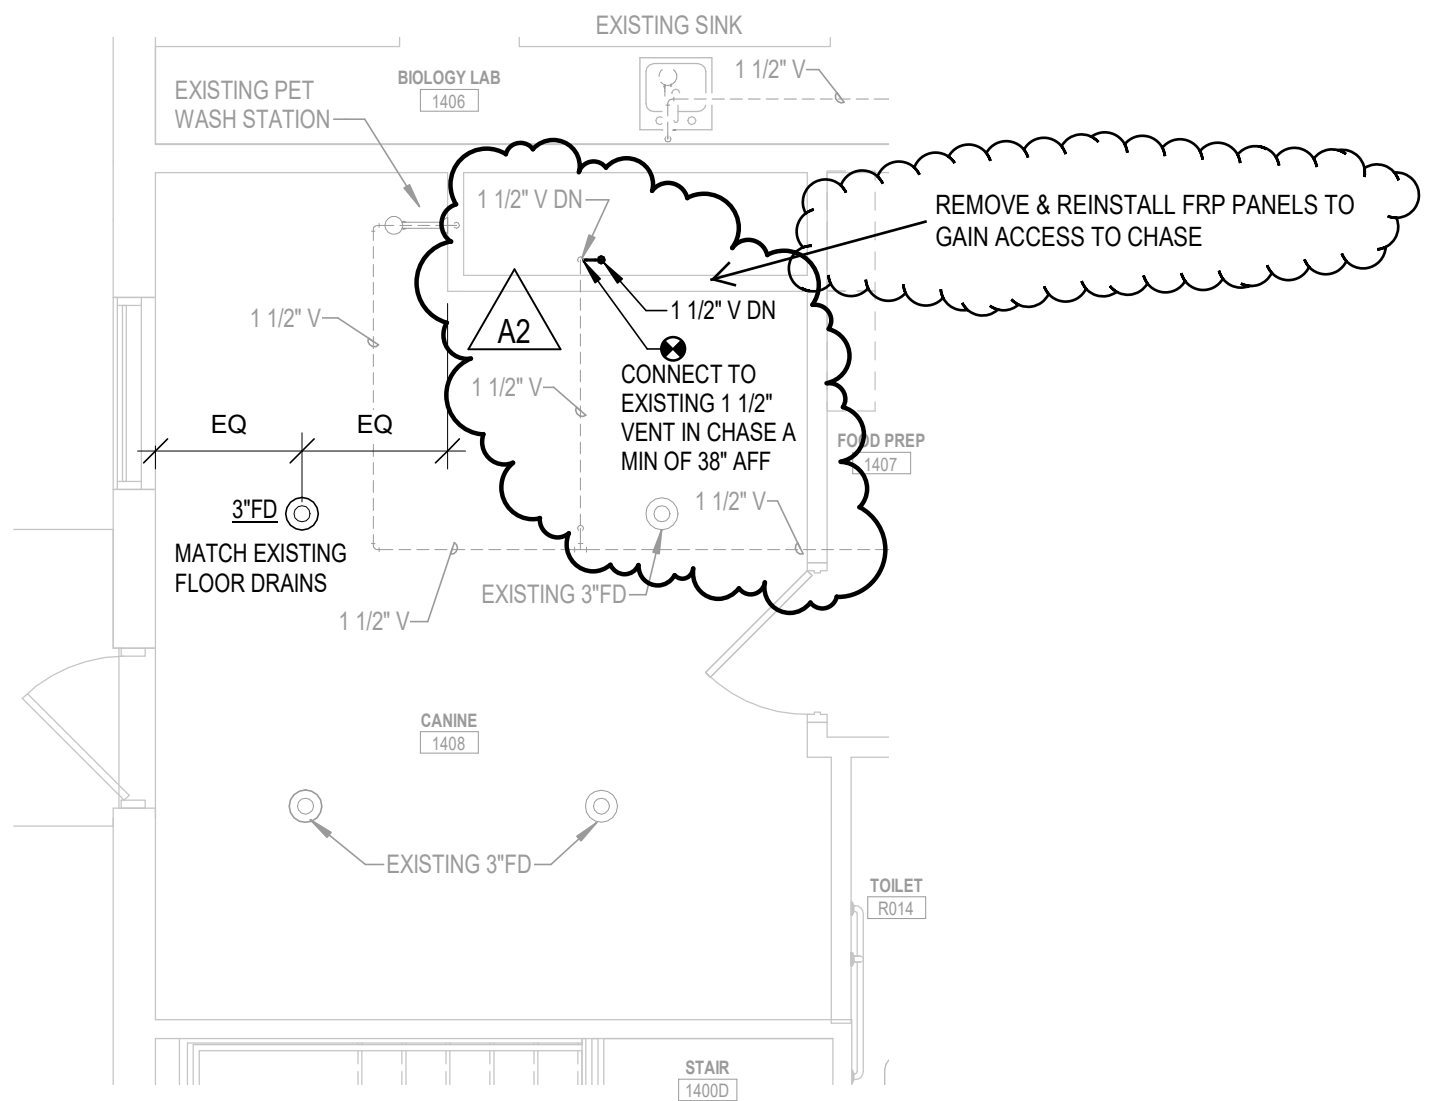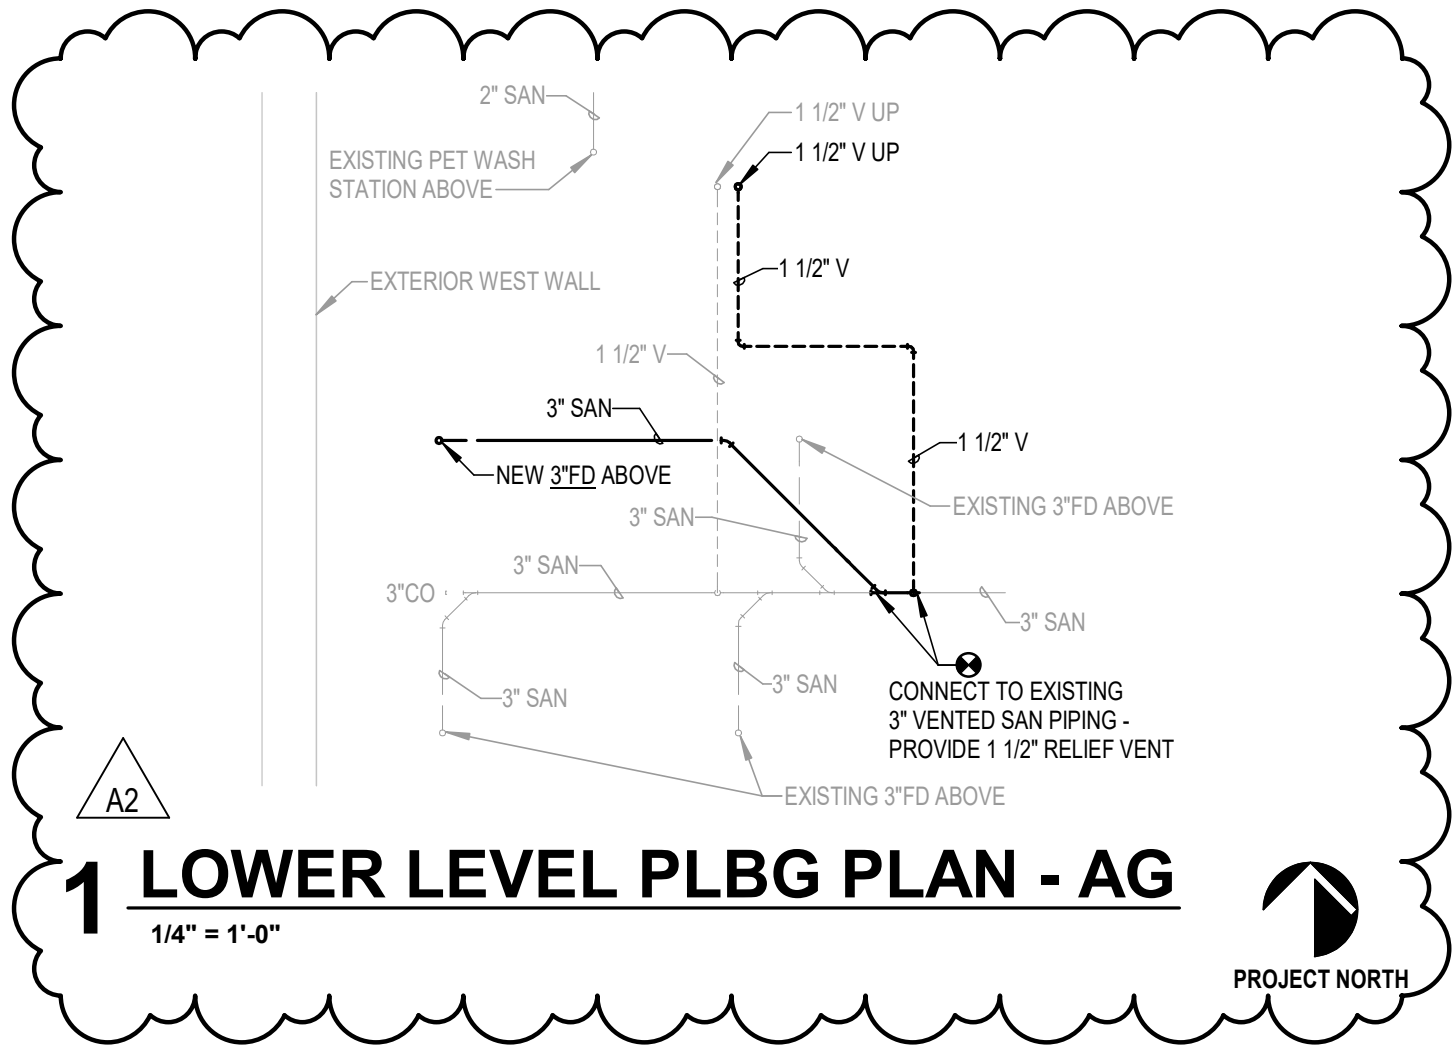

REFER TO ARCHITECTURAL SHEETS A001 AND A002 FOR MORE INFORMATION AND PROJECT LOCATION

CANINE RM PROJECT - BASE BID

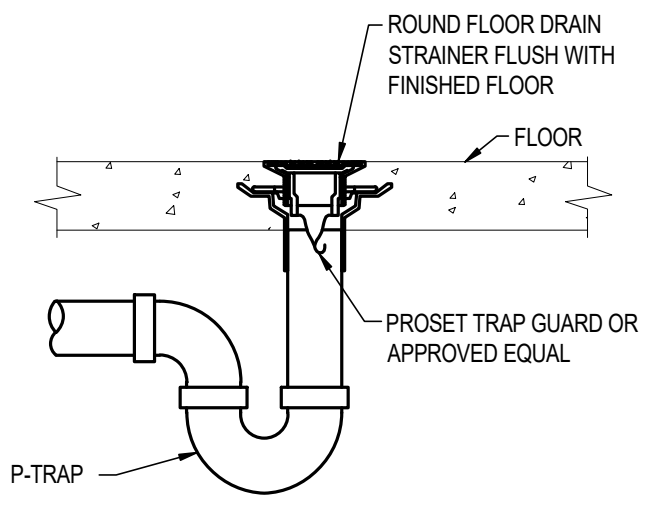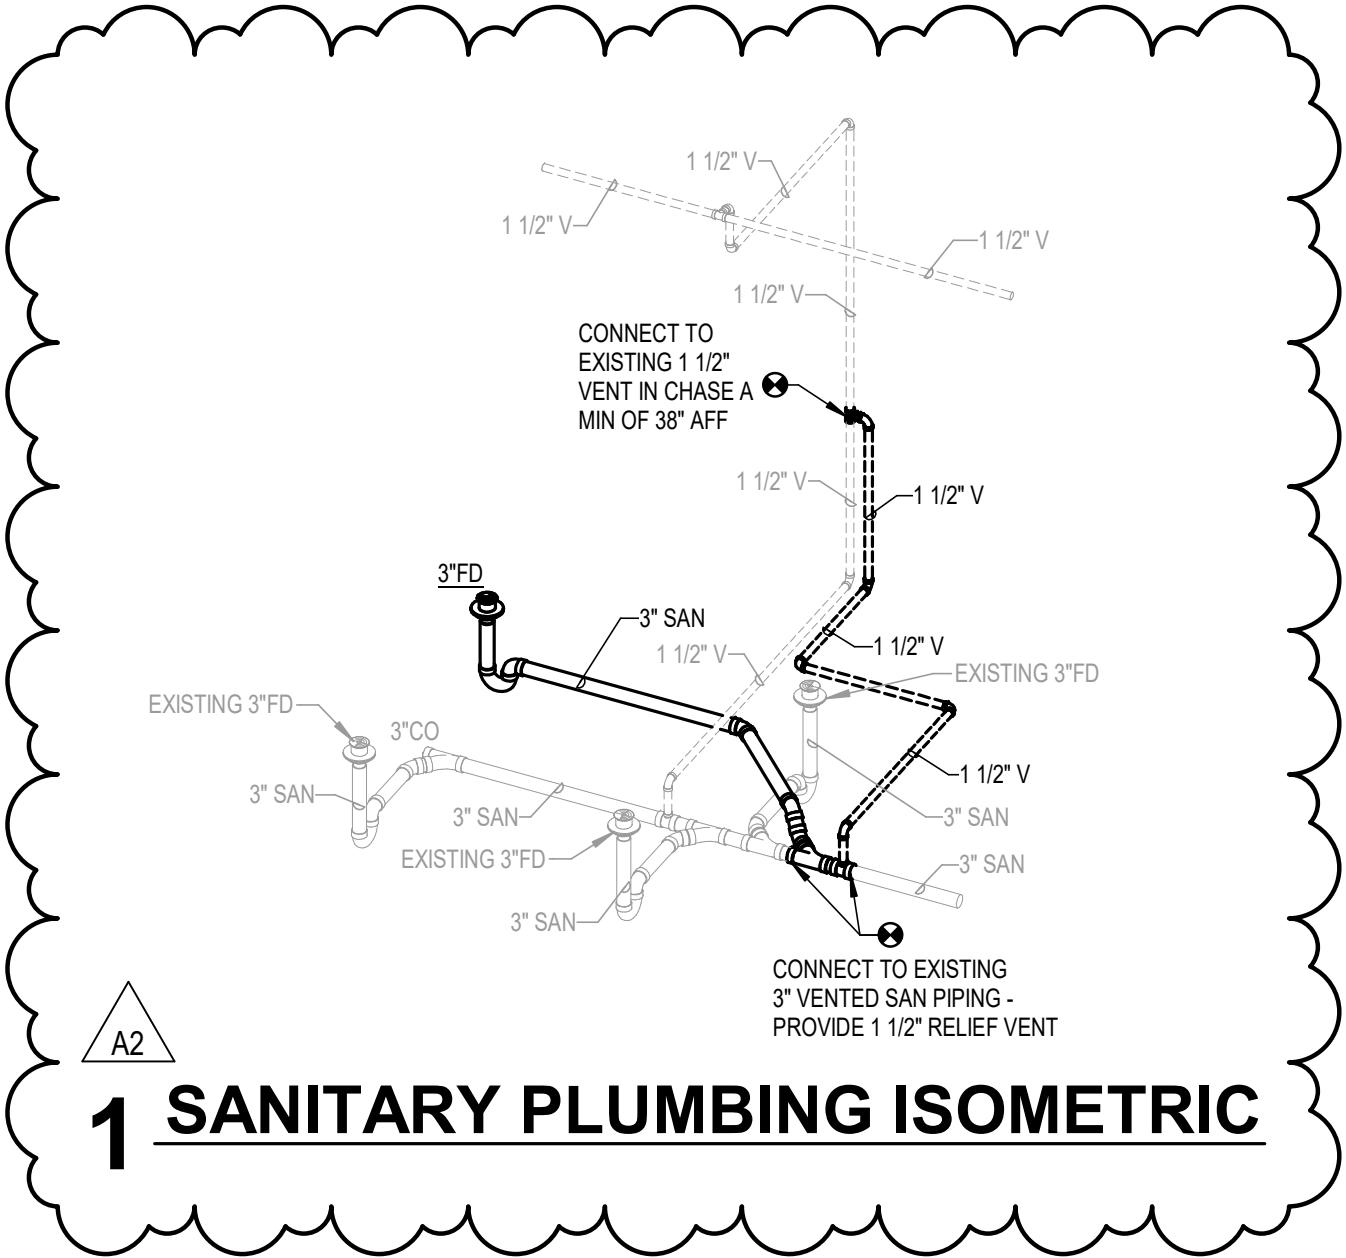

2 FLOOR DRAIN DETAIL

NOT TO SCALE